



File Path: \\DWG\DWG\2007\1817-R-1\1817-R-1.dwg Plot Date: 11-30-2011
File Name: 71857-SH19-R4.DWG Plot Time: 07:20 am

A1 WEST SIDE STABILIZATION AND IMPROVEMENTS GRADING PLAN
SCALE: 1" = 20'

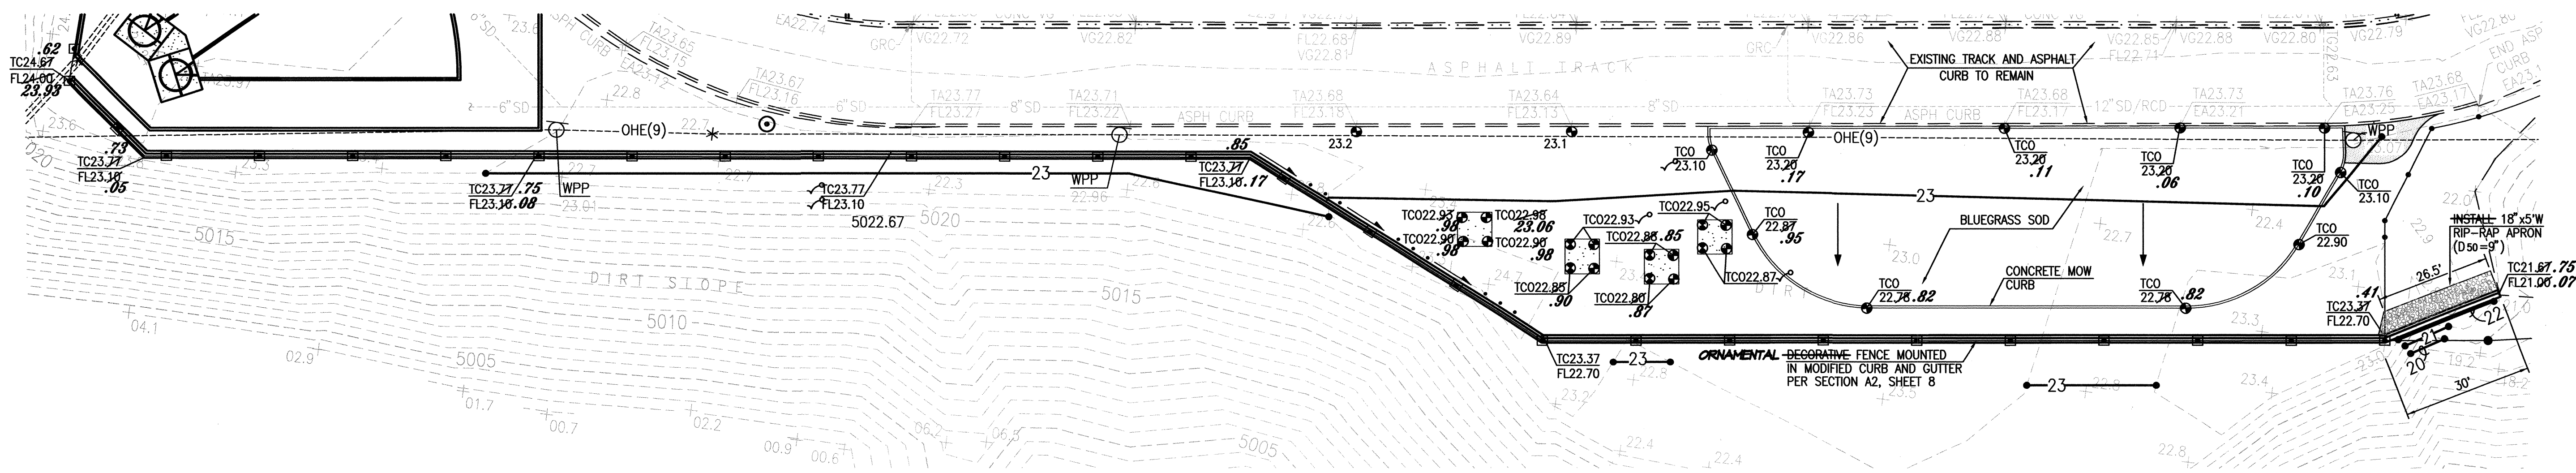

D1 WEST SIDE STABILIZATION AND IMPROVEMENTS SITE PLAN
SCALE: 1" = 20'

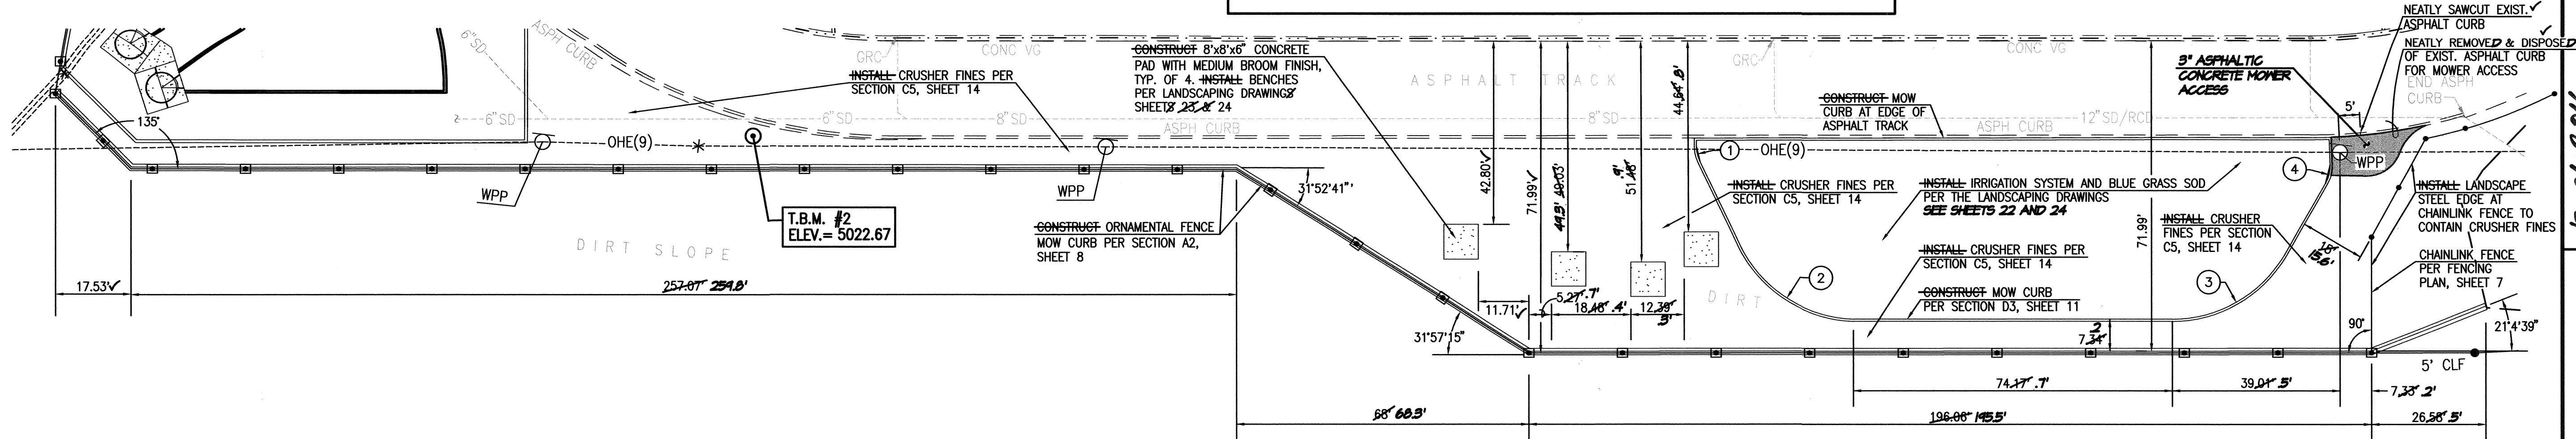

RECORD DRAWING LEGEND

CONSTRUCT	RECORD INFORMATION (VERIFIED BY ENGINEER)
✓	AS-CONSTRUCTED = AS-DESIGNED (VERIFIED BY ENGINEER)
38' 42"	RECORD INFORMATION (VERIFIED BY ENGINEER)
+25.2	RECORD INFORMATION (VERIFIED BY ENGINEER)
28.98.42	RECORD INFORMATION (VERIFIED BY ENGINEER)
✓	AS-CONSTRUCTED = AS-DESIGNED (VERIFIED BY AS-BUILT SURVEY)
31.8	RECORD INFORMATION FROM AS-BUILT SURVEY
+26.9	RECORD INFORMATION FROM AS-BUILT SURVEY
31.25.22	RECORD INFORMATION FROM AS-BUILT SURVEY

CURVE TABLE

CURVE	RADIUS	ARC LENGTH	CHORD LENGTH	CHORD BEARING	DELTA ANGLE
1	8.00'	3.35'	3.32'	S 3°00'54" W	23°58'58"
2	30.00'	32.70'	31.10'	N 42°22'00" E	62°26'53"
3	30.00'	31.09'	29.72'	N 19°22'01" W	59°22'48"
4	8.00'	4.48'	4.42'	S 23°48'32" E	32°03'18"

TRACK AND FIELD RENOVATIONS ALBUQUERQUE HIGH SCHOOL

NO.	DATE	BY	REVISIONS
1	08/08	GRB	ADD THIS SHEET
2	11/11	JGM	AS-BUILT, RECORD DRAWING
PROJECT No. 2007-1817			
DESIGNED BY G.R.B.			
DRAWN BY CFA/JLP/BLE/DWH			
APPROVED BY J.G.M.			
SHEET TITLE			
WEST SIDE STABILIZATION & IMPROVEMENTS SITE PLAN, AND GRADING PLAN			