


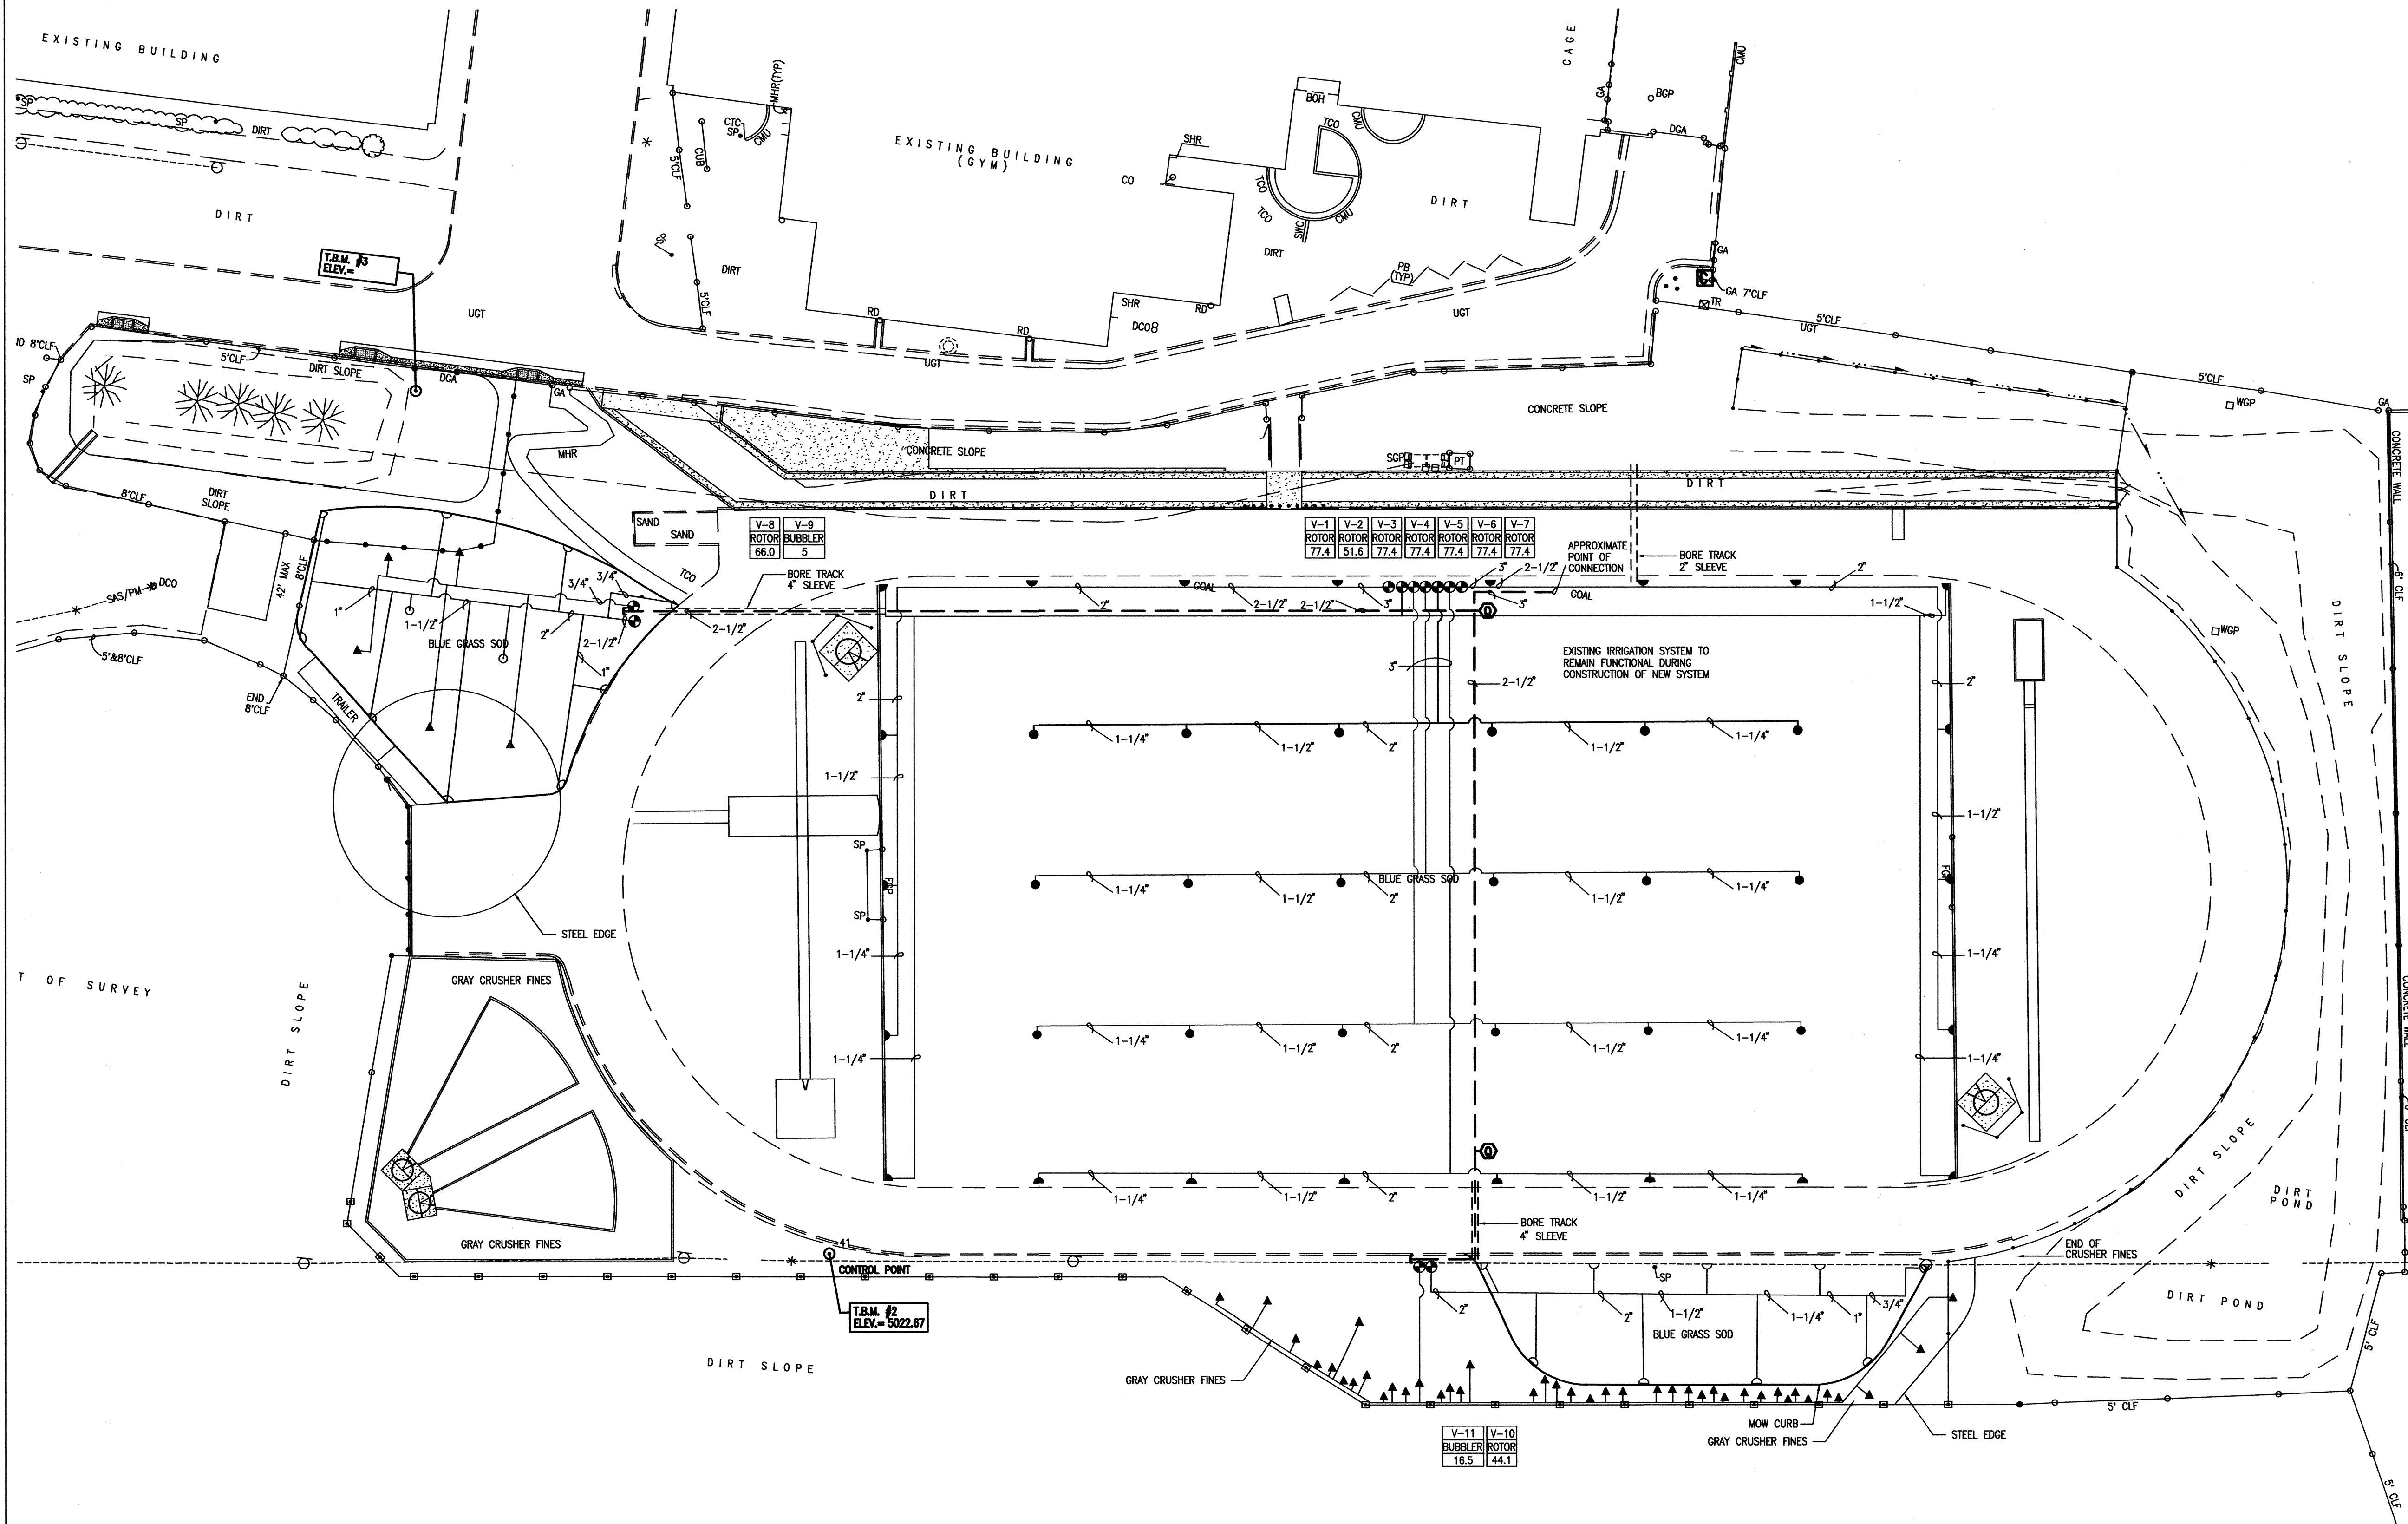


IRRIGATION LEGEND

|                                                                                                                                                                           |     |
|---------------------------------------------------------------------------------------------------------------------------------------------------------------------------|-----|
| IRRIGATION MAINLINE—SCHEDULE 40 SOLVENT WELD PVC<br>SIZE PER PLAN                                                                                                         | --- |
| IRRIGATION LATERAL PIPING—SCHEDULE 40 SOLVENT<br>SIZE PER PLAN                                                                                                            | --- |
| AUTOMATIC VALVE ASSEMBLY—WEATHERMATIC AUTOMATIC VALVE                                                                                                                     | ⊕   |
| HUNTER I-25 ROTORHEAD #10 NOZZLE                                                                                                                                          | ••• |
| HUNTER I-20 W/#6 NOZZLE                                                                                                                                                   | ••• |
| FIXED BUBBLER ASSEMBLY—RAINBIRD 1400 SERIES<br>PRESSURE COMPENSATING BUBBLER, INSTALL 1-1404 (1 GPM)<br>BUBBLER PER TREE AND 1-1401 (.25 GPM) PER SHRUB<br>SIZE PER PLAN. | ▲   |
| IRRIGATION CONTROLLER—IRINET 32 STATION CONTROLLER<br>(EXISTING). UTILIZE UNUSED STATIONS FOR NEW<br>IRRIGATION VALVE ADDITIONS. ADD 16 STATION EXPANSION<br>MODULE       | Ⓢ   |
| TEMPORARY QUICK COUPLER TO BE REMOVED FOLLOWING<br>CONSTRUCTION                                                                                                           | Ⓢ   |

NOTES:

- ALL WORK SHOWN ON THIS SHEET TO BE INSTALLED PER ALBUQUERQUE PUBLIC SCHOOLS - STANDARD SPECIFICATIONS
- REPAIR SOD AT NEW TRENCHES

4 RECORD DRAWING

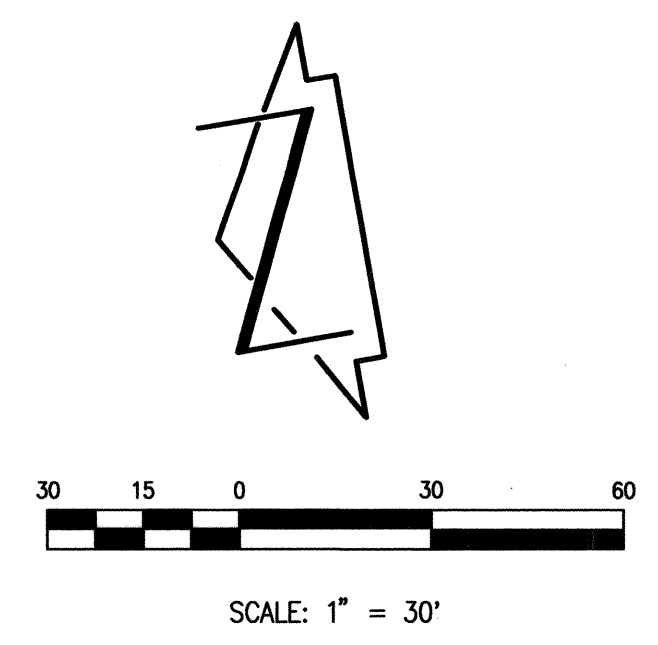

ALBUQUERQUE HIGH SCHOOL  
IRRIGATION PLAN

|              |                |
|--------------|----------------|
| REVISIONS    | RECORD DRAWING |
| DRAWN BY:    | WLCI           |
| DESIGNED BY: | WLCI           |
| CHECKED BY:  | WLCI           |
| DATE:        | N/A            |

WESTWIND LANDSCAPE  
CONSTRUCTION INC.

2739 VASSAR PLACE NE  
ALBUQUERQUE, NEW MEXICO  
8 TEL 505.881.0825  
FAX 505.881.7052

L-122

SHEET 22 OF 25