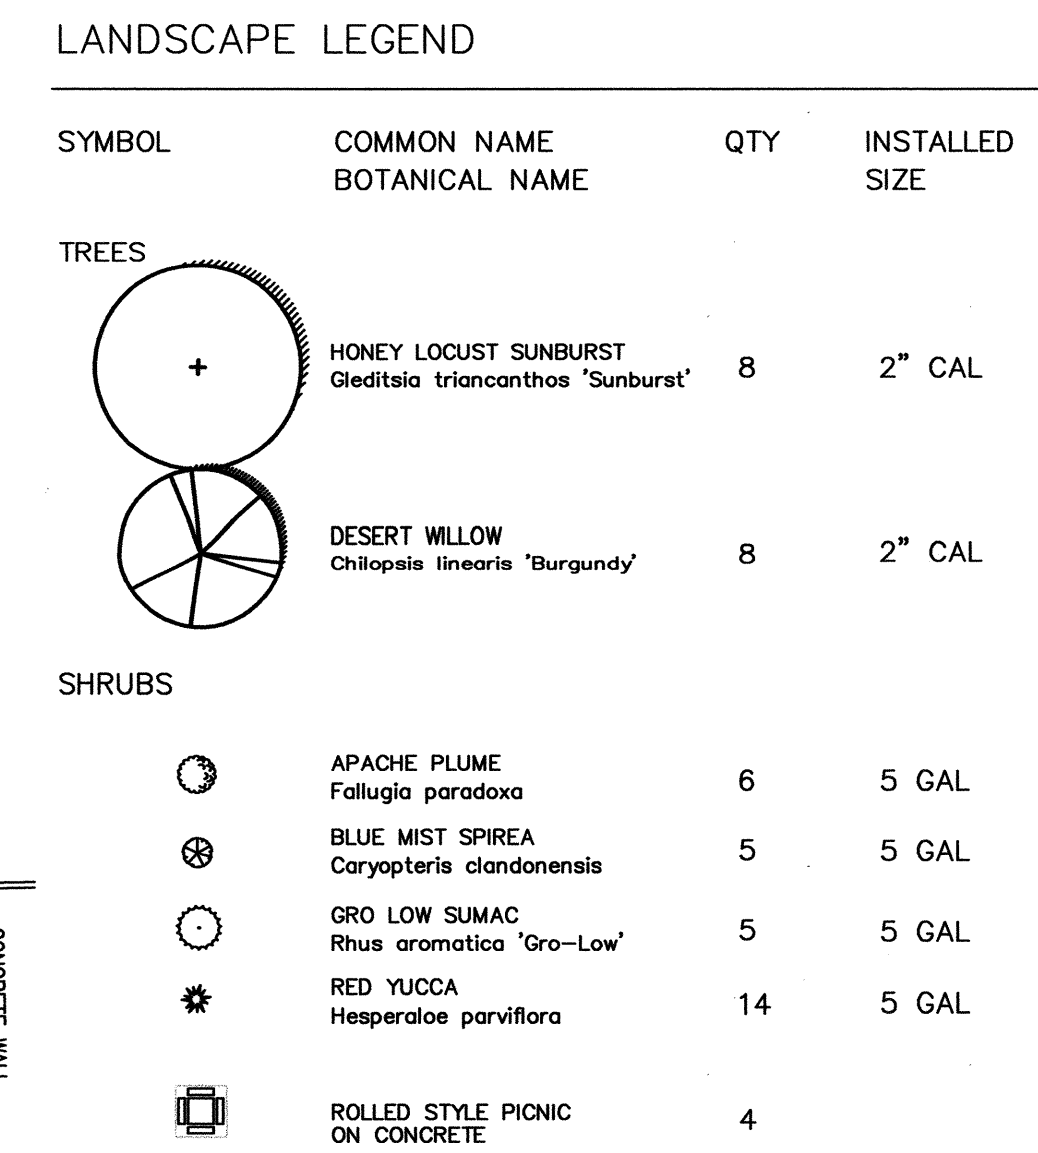


SCALE: 1" = 30'

4

RECORD DRAWING

	REVISIONS
	A RECORD DRAWING

DRAWN BY: WLCI

DESIGNED BY: WLCI

CHECKED BY: WLCI

DATE:	N/A
-------	-----

**WESTWIND LANDSCAPE
CONSTRUCTION INC.**
2739 VASSAR PLACE NE
ALBUQUERQUE, NEW MEXICO
87107
TEL 505.881.0892
FAX 505.883.7052

 L-124

SHEET 24 OF 25