



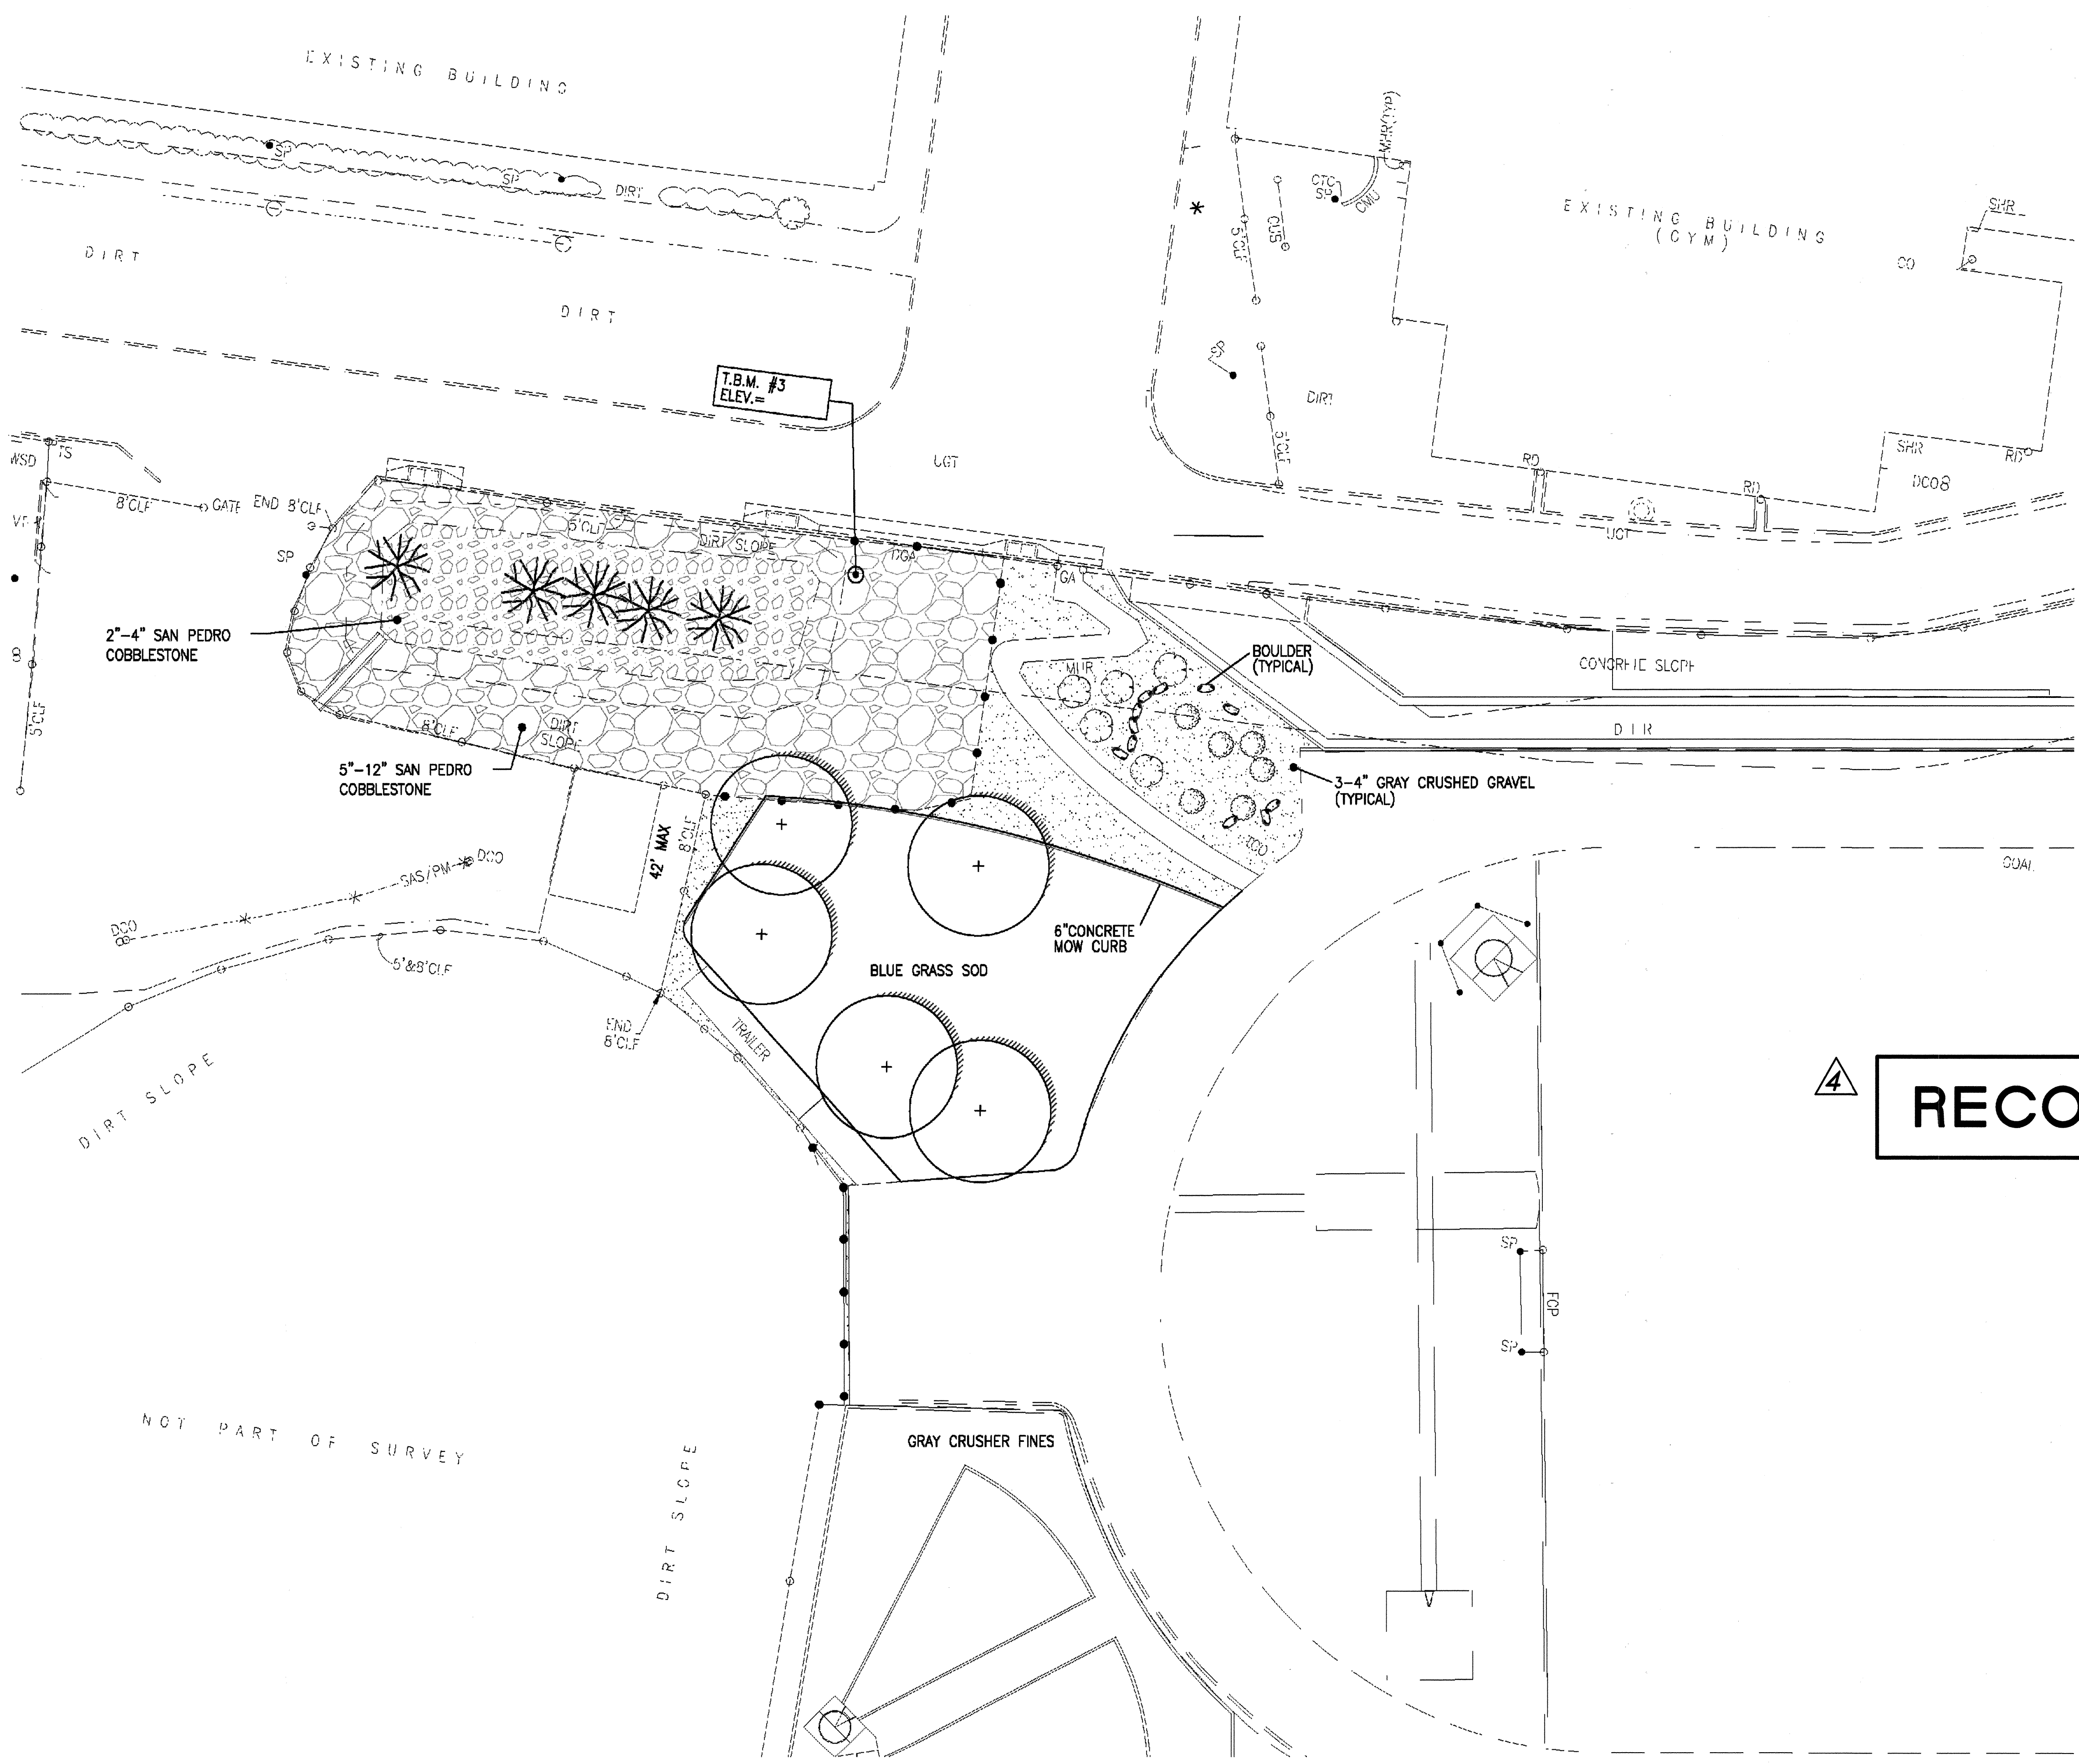

LANDSCAPE LEGEND			
SYMBOL	COMMON NAME BOTANICAL NAME	QTY	INSTALLED SIZE
TREES			
	HONEY LOCUST SUNBURST <i>Gleditsia triacanthos 'Sunburst'</i>	8	2" CAL
	DESERT WILLOW <i>Chilopsis linearis 'Burgundy'</i>	8	2" CAL
SHRUBS			
	APACHE PLUME <i>Fouquieria paradoxa</i>	11	5 GAL
	BLUE MIST SPIREA <i>Caryopteris clandonensis</i>	5	5 GAL
	BUTTERFLY BUSH <i>Buddleja davidii</i>	5	5 GAL
	GRO LOW SUMAC <i>Rhus aromatica 'Gro-Low'</i>	5	5 GAL
	RED YUCCA <i>Hesperaloe parviflora</i>	14	5 GAL
	ROLLED STYLE PICNIC ON CONCRETE	4	

4 RECORD DRAWING

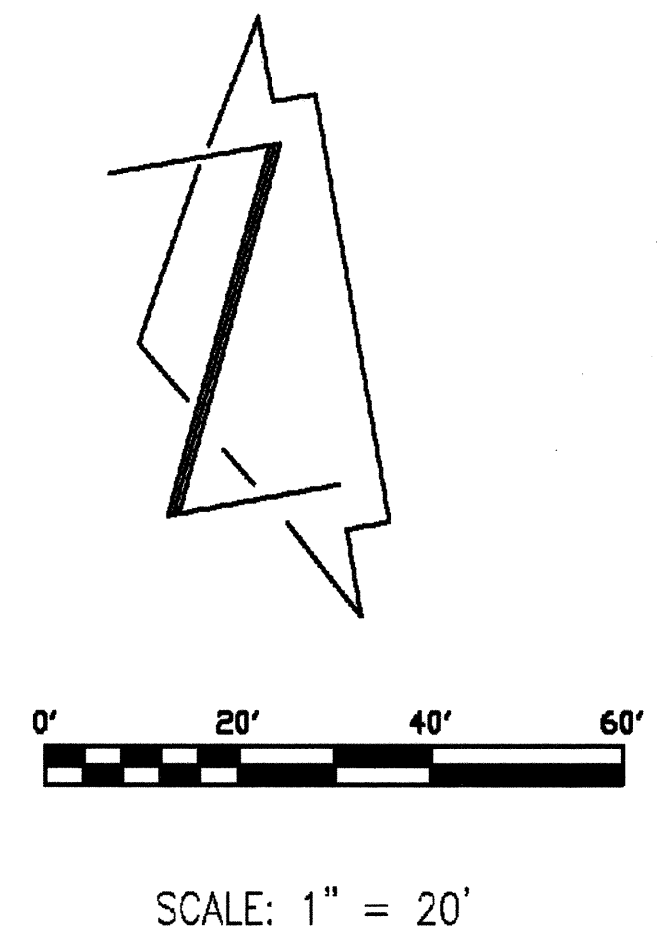

ALBUQUERQUE HIGH SCHOOL
LANDSCAPE PLAN-NORTHEAST CORNER

REVISIONS	RECORD DRAWING
DRAWN BY:	WLCI
DESIGNED BY:	WLCI
CHECKED BY:	WLCI
DATE:	N/A

WESTWIND LANDSCAPE
CONSTRUCTION INC.

2739 VASSAR PLACE NE
ALBUQUERQUE, NEW MEXICO
TEL 505.881.0892
FAX 505.883.7052

4 L-125

SHEET 25 OF 25