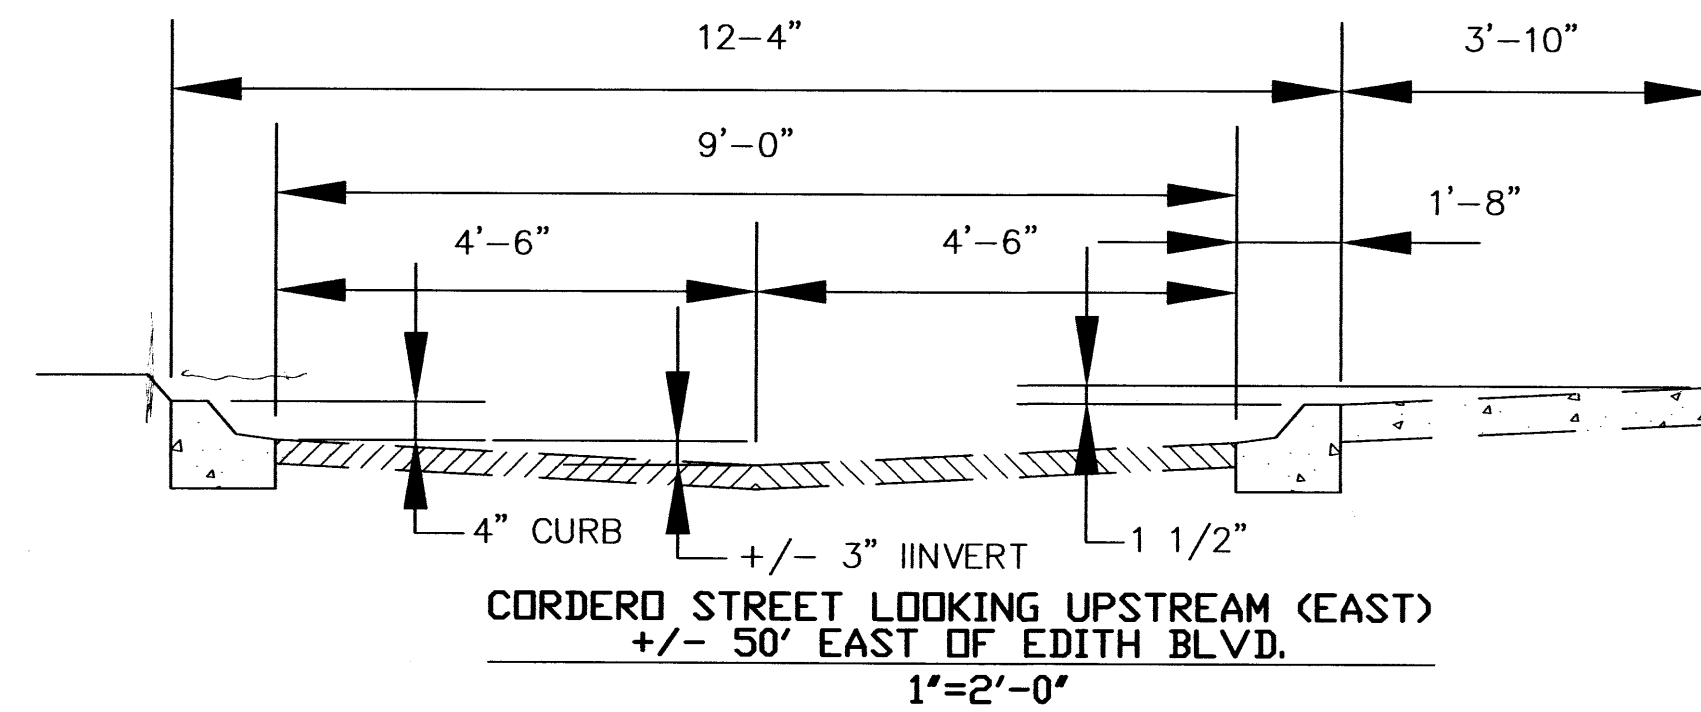





CITY OF ALBUQUERQUE
PUBLIC WORKS DEPARTMENT
ENGINEERING DEVELOPMENT GROUP

Mo./Day/Yr.

Sheet Of

[illegible]

UTILITY LEGEND	
⊗	= FIRE HYDRANT
☆	= LIGHT POLE
—○—	= OVERHEAD UTILITY LINE
●	= POWER POLE
○	= SEWER CLEANOUT
⊙	= SEWER MANHOLE
—SEWER—	= UNDERGROUND SEWER LINE
—WATER—	= UNDERGROUND WATER LINE
■	= WATER METER
□	= WATER VALVE

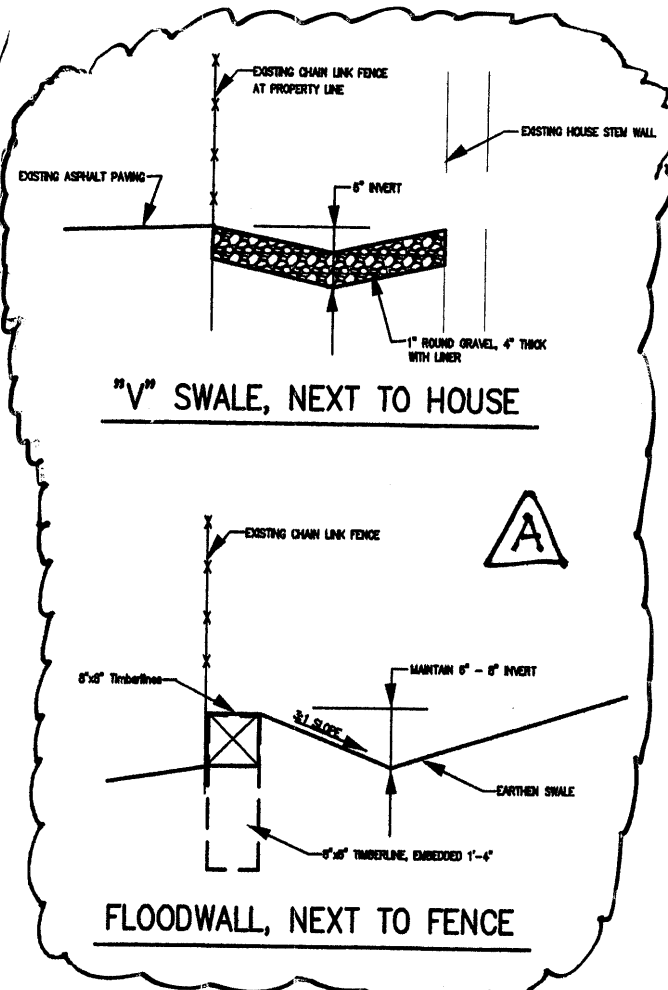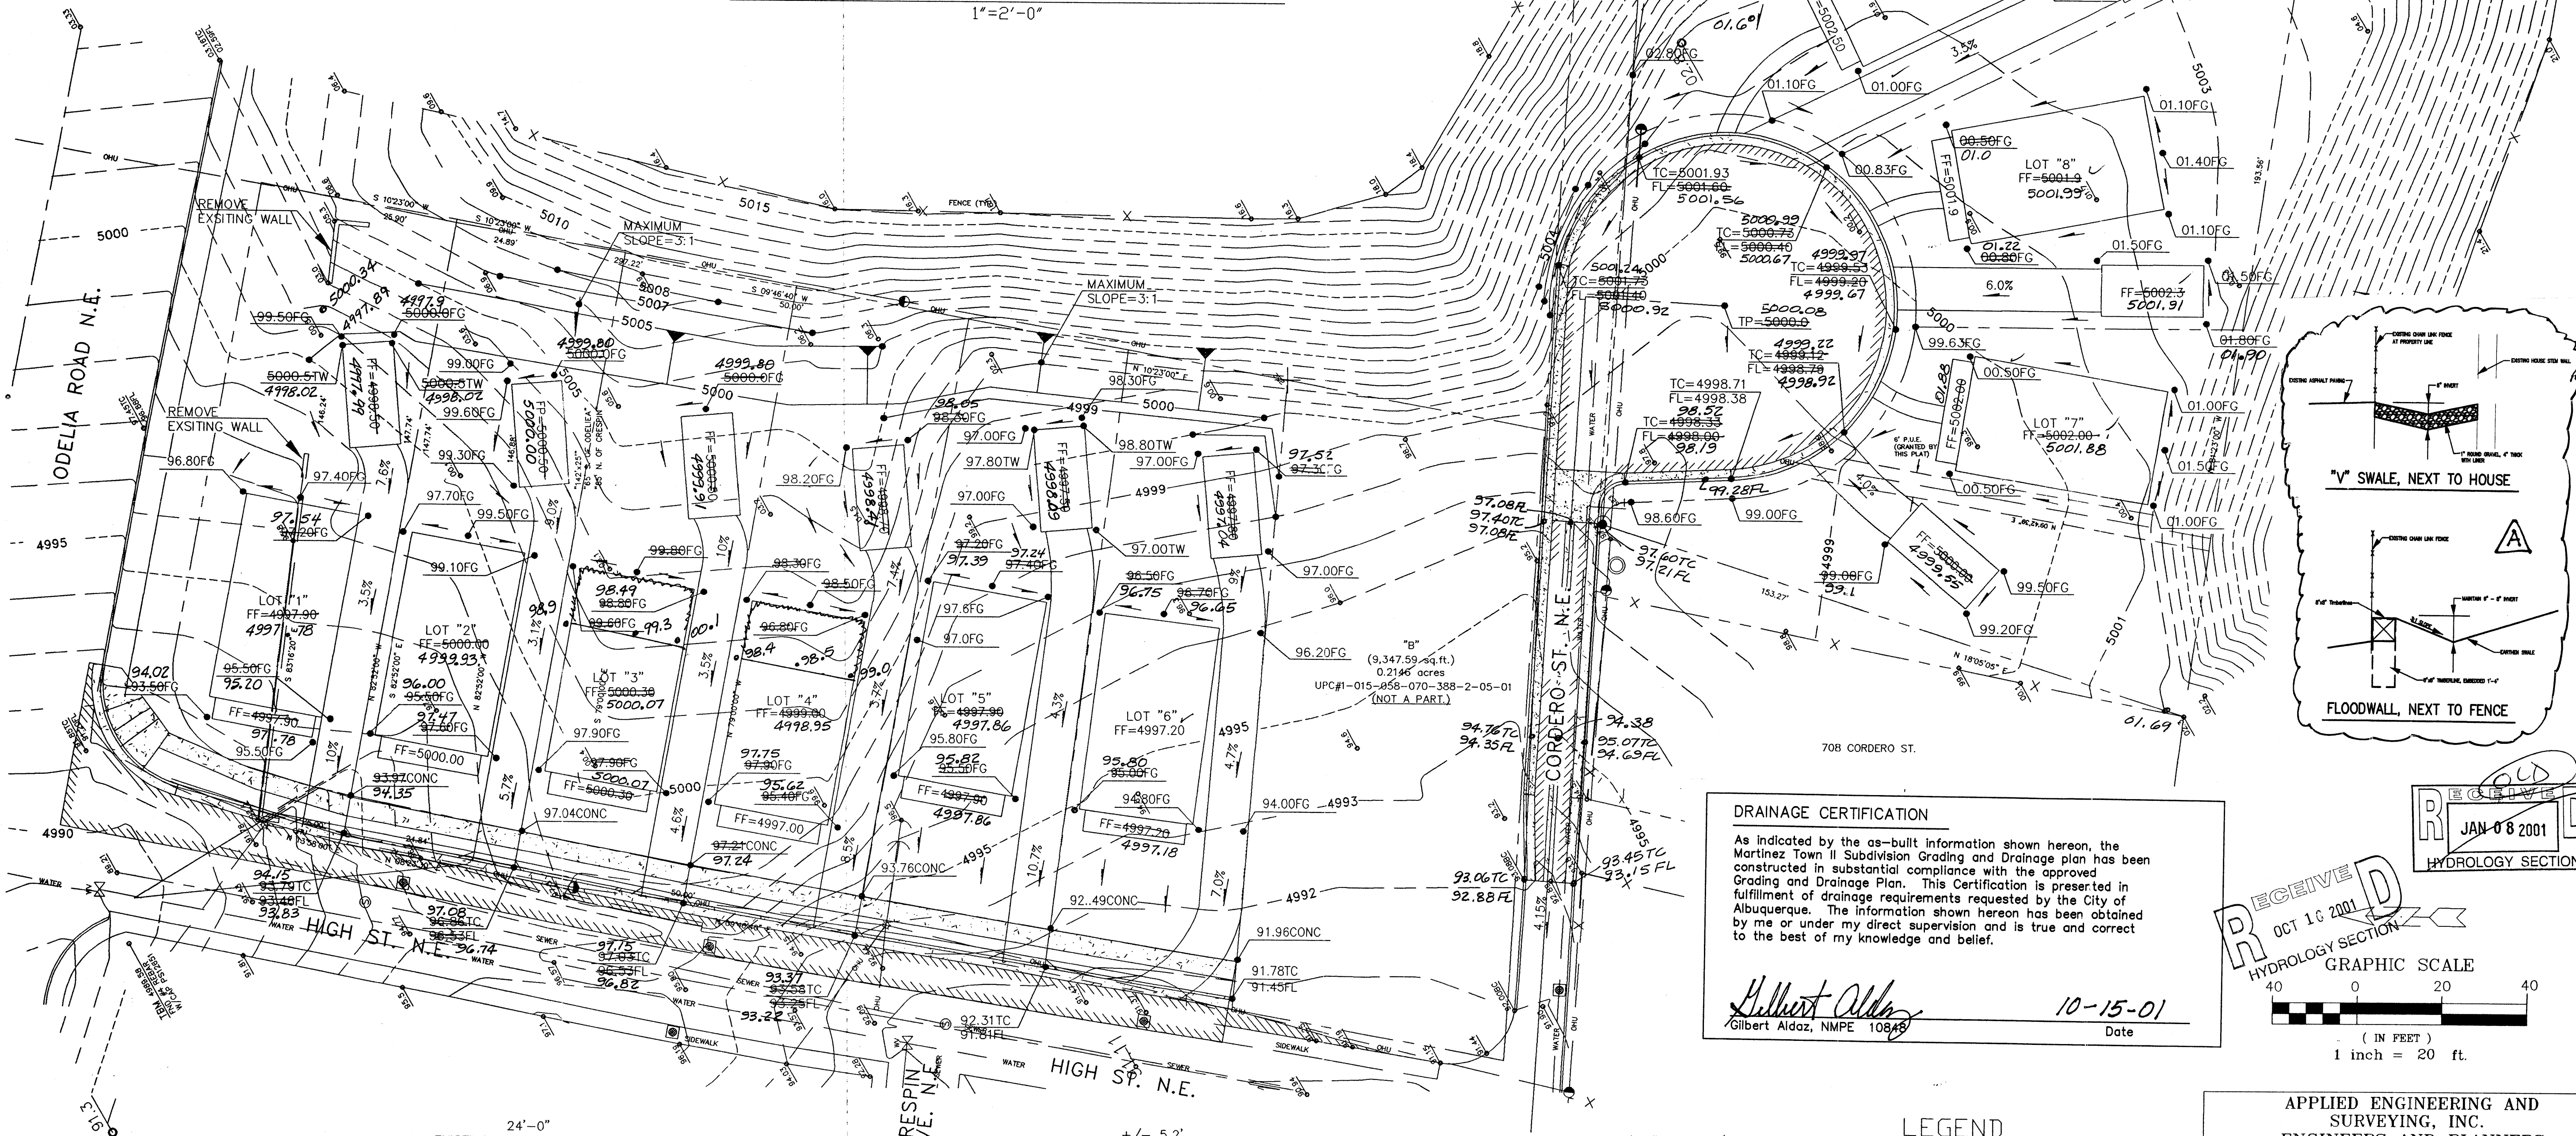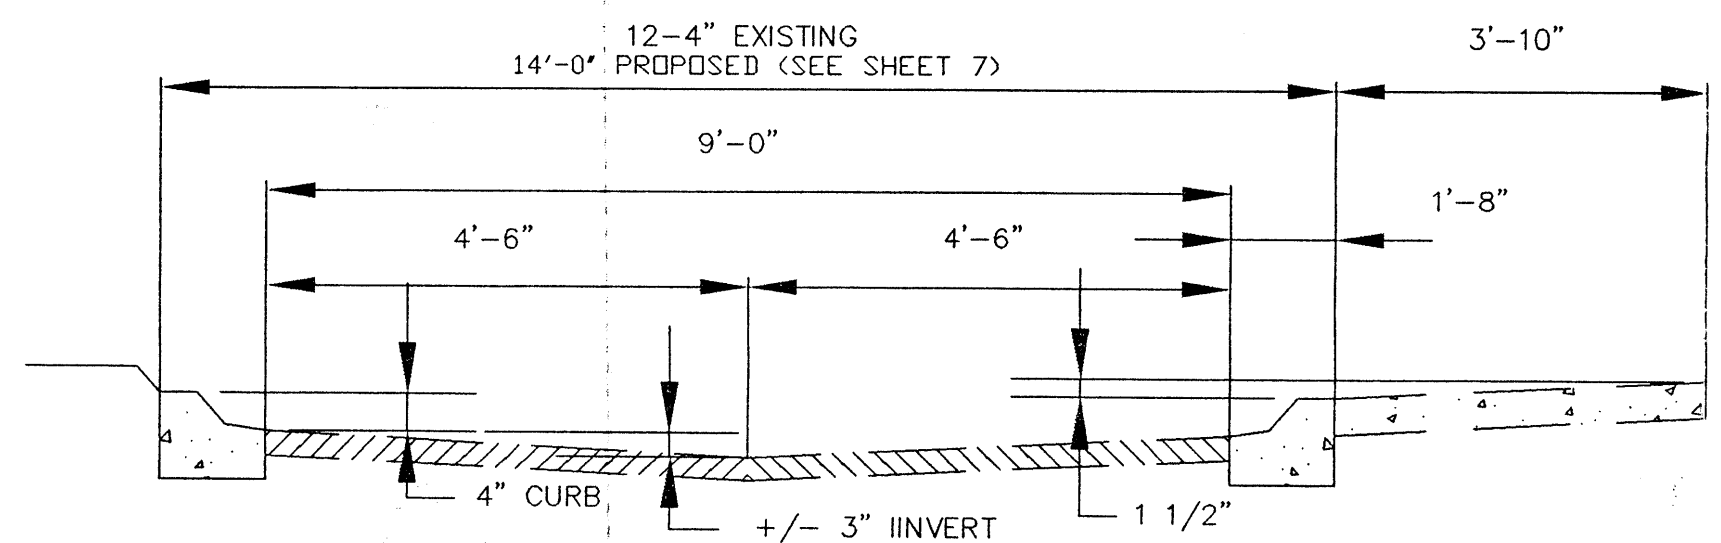


DRAINAGE CERTIFICATION

As indicated by the as-built information shown hereon, the Martinez Town II Subdivision Grading and Drainage plan has been constructed in substantial compliance with the approved Grading and Drainage Plan. This Certification is presented in fulfillment of drainage requirements requested by the City of Albuquerque. The information shown hereon has been obtained by me or under my direct supervision and is true and correct to the best of my knowledge and belief.

Gilbert Aldaz
Gilbert Aldaz, NMPE 10848

10-15-01
Date

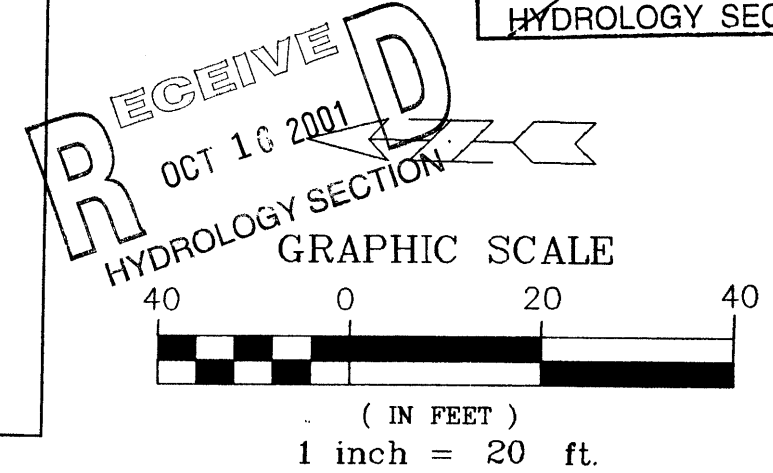

LEGEND	
99.1 99.20FG	AS-BUILT FINISHED GRADE
99.21 99.12TC	AS-BUILT TOP OF CURB ELEVATION
99.80 99.80FL	AS-BUILT FLOW LINE OF CURB ELEVATION
98.80 98.80TW	AS-BUILT TOP OF RETAINING WALL ELEVATION
FF = 4997.00	AS-BUILT FINISHED FLOOR ELEVATION OF STRUCTURE
— 4995 —	FINISH GRADE CONTOUR ELEVATION
— — —	PROPOSED DIRECTED OF FLOW
--- 4995 ---	EXISTING CONTOUR ELEVATION

APPLIED ENGINEERING AND SURVEYING, INC.
ENGINEERS AND PLANNERS
1600 Blue Drive NE
Albuquerque, NM 87112
Phone: (505) 271-1456

CITY OF ALBUQUERQUE
PUBLIC WORKS DEPARTMENT
ENGINEERING DEVELOPMENT GROUP



TITLE: **GRADING PLAN**

Design Review Committee: _____ City Engineer Approval: _____

City Project No. 651281 Zone Map No. J-12 Sheet 3 of 9

AS-BUILT INFORMATION		BENCH MARKS		SURVEY INFORMATION		FIELD NOTES		ENGINEER'S SEAL		REVISIONS		DESIGN		MICRO-FILM INFORMATION	
CONTRACTOR	DATE	WORK	DATE	NO.	BY	DATE	NO.	DATE	NO.	DATE	DATE	DATE	DATE	NO.	DATE
WORKED BY	DATE	INSPECTED BY	DATE												
ACCEPTANCE BY	DATE	VERIFICATION BY	DATE												
DRAWINGS	DATE	REVISIONS	DATE												
RECORDED BY	DATE														

10-15-01 These improvements added to Sideyards of Lots 1-5 to keep drainage within each lot.

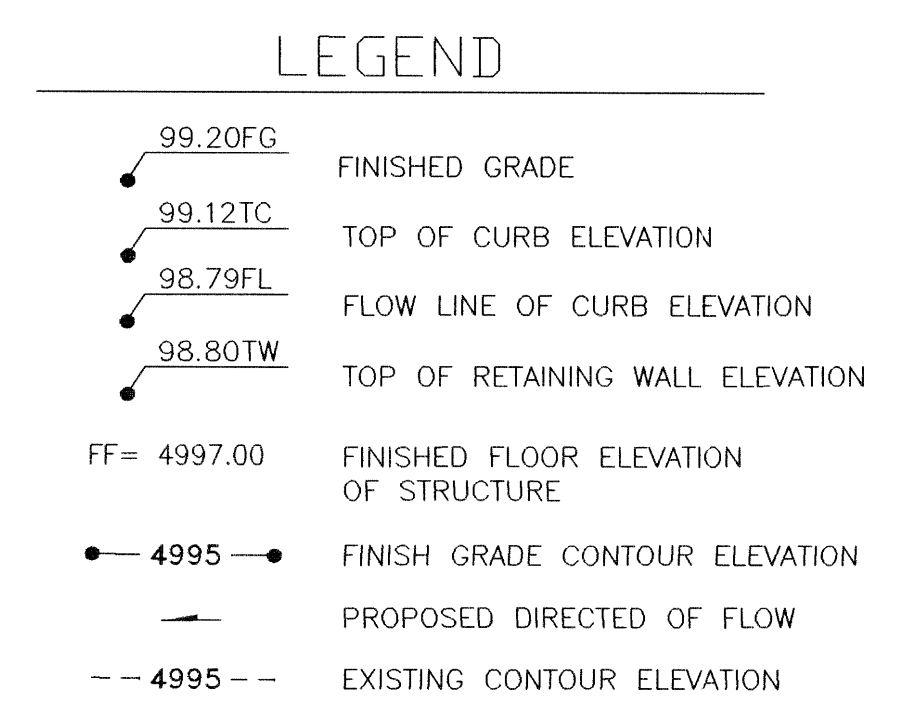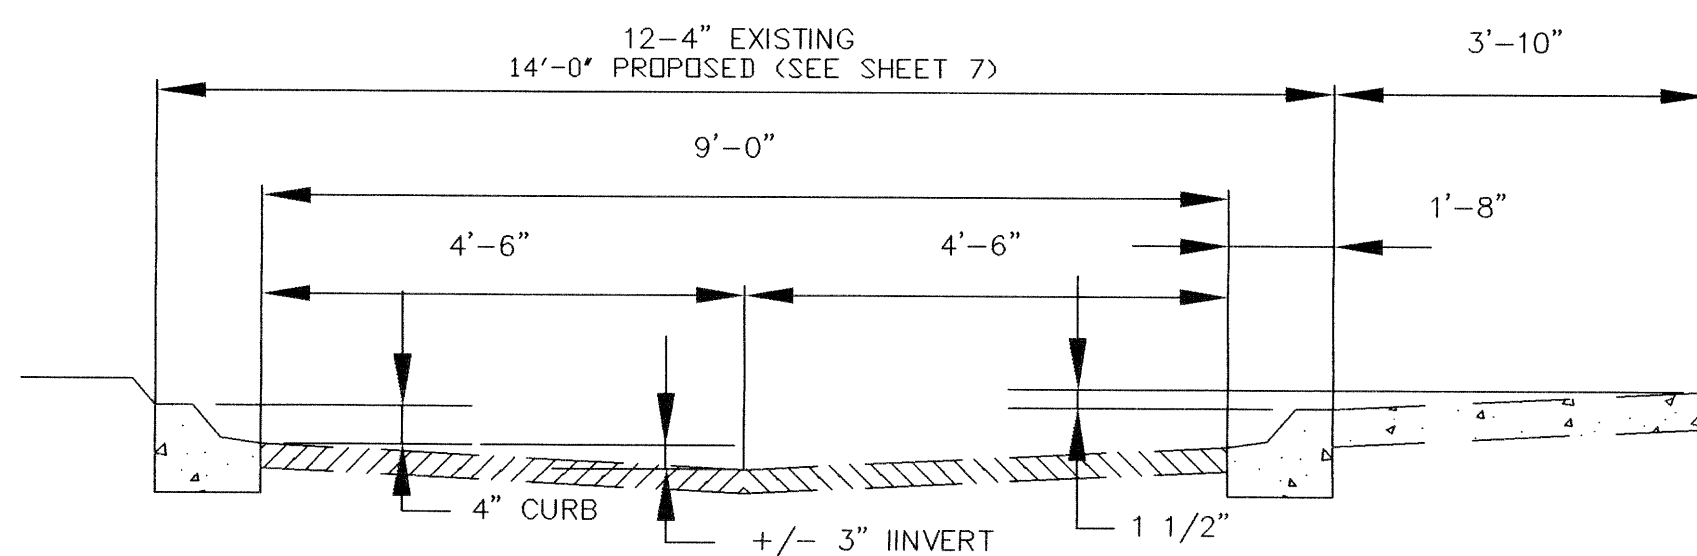

GRAPHIC SCALE



(IN FEET)
1 inch = 20 ft.

**APPLIED ENGINEERING AND
SURVEYING, INC.
ENGINEERS AND PLANNERS**

1605 Blak Drive NE
Office: (505) 237-1456


Albuquerque, New Mexico 87112
Facsimile: (505) 237-1456

CITY OF ALBUQUERQUE
PUBLIC WORKS DEPARTMENT
ENGINEERING DEVELOPMENT GROUP

GRADING PLAN

Design Review Committee	City Engineer Approval	Last Design Update	Mo./Day/Yr.	Mo./Day/Yr.			
City Project No.	651281	Zone Map No.	J-12	Sheet	Of	3	9

ENGINEER'S SEAL	SURVEY INFORMATION		BENCH MARKS	AS-BUILT INFORMATION	
	NO.	FIELD NOTES		CONTRACTOR	DATE
		BY		DATE	WORK
				DATE	STAKED BY
				DATE	FIELD
				DATE	ACCEPTANCE BY
				DATE	FIELD
				DATE	REVISION BY
				DATE	DRAWING
				DATE	CORRECTED BY
				MICRO-FILM INFORMATION	
				RECORDED BY	DATE
				NO.	

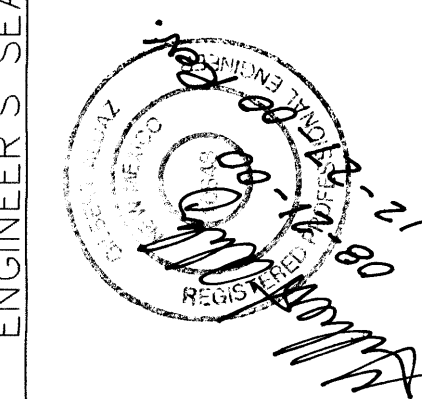

NO.		DATE	REMARKS	BY
			<i>REVISIONS</i>	
			<i>DESIGN</i>	
DESIGNED BY A.E.S.			DATE	12/00
DRAWN BY A.E.S.			DATE	12/00