



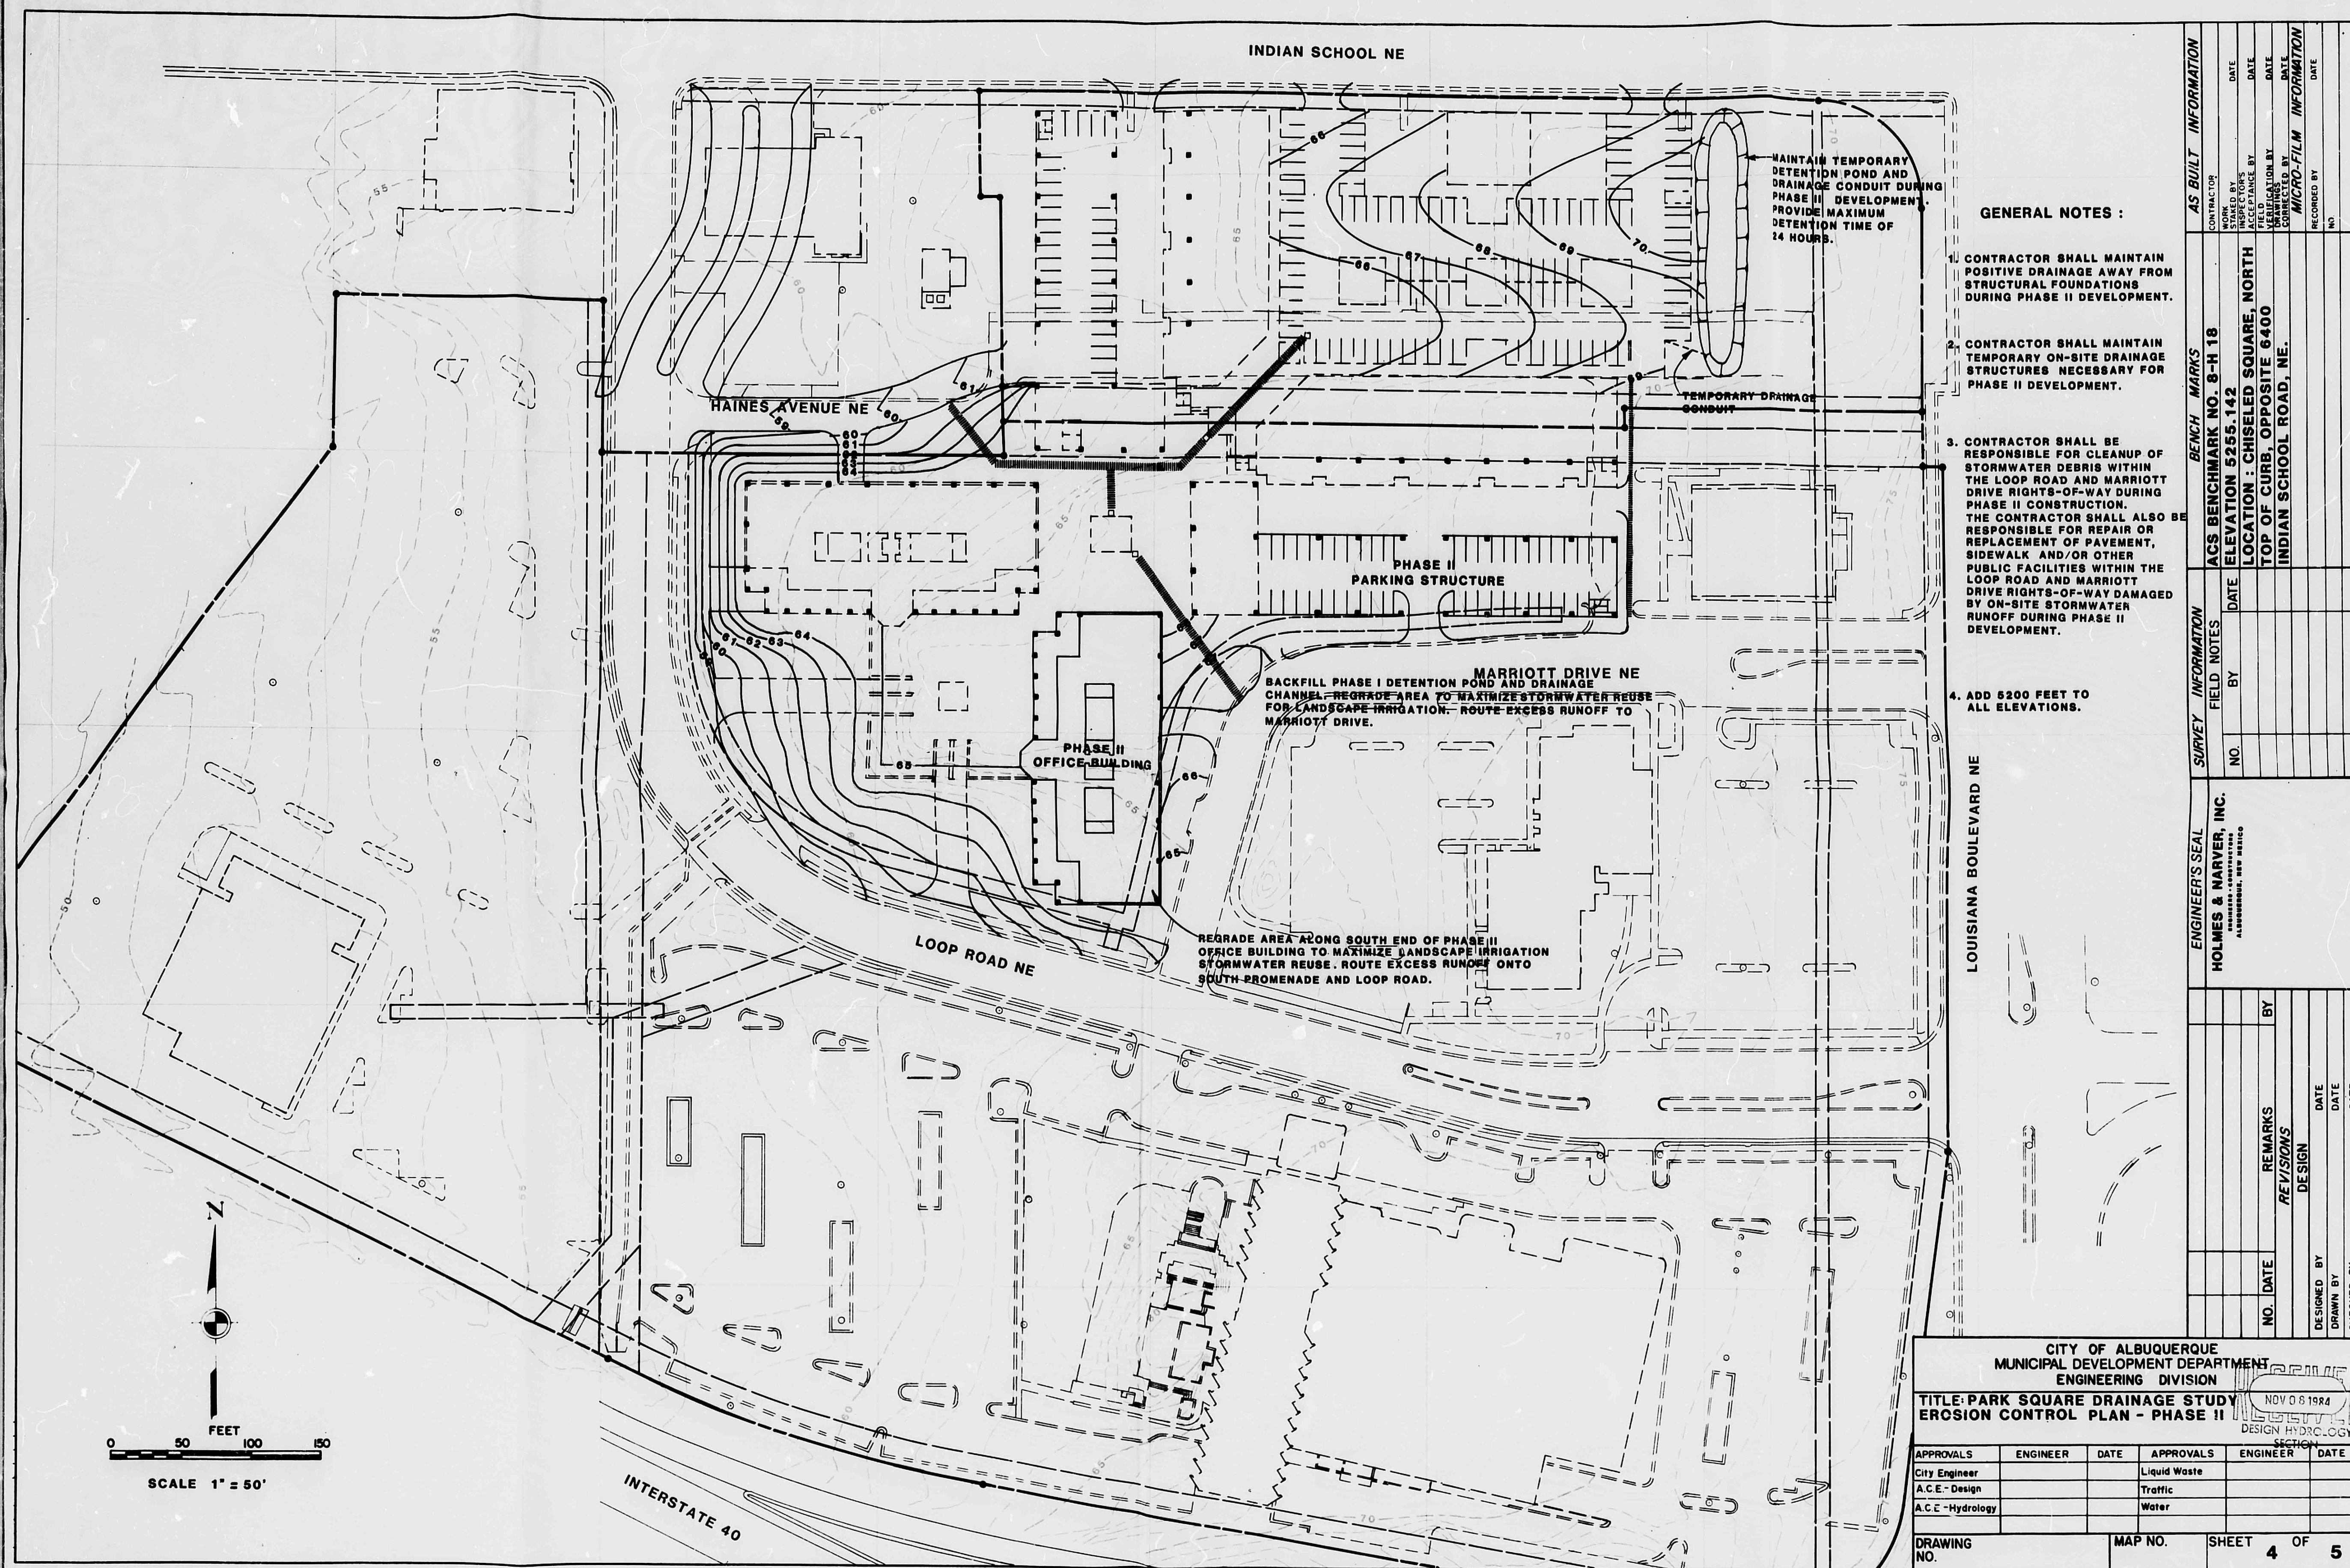

CITY OF ALBUQUERQUE
THIS MICROIMAGE IS THE BEST
POSSIBLE REPRODUCTION DUE
TO THE POOR QUALITY OF THE
ORIGINAL DOCUMENT

CITY OF ALBUQUERQUE

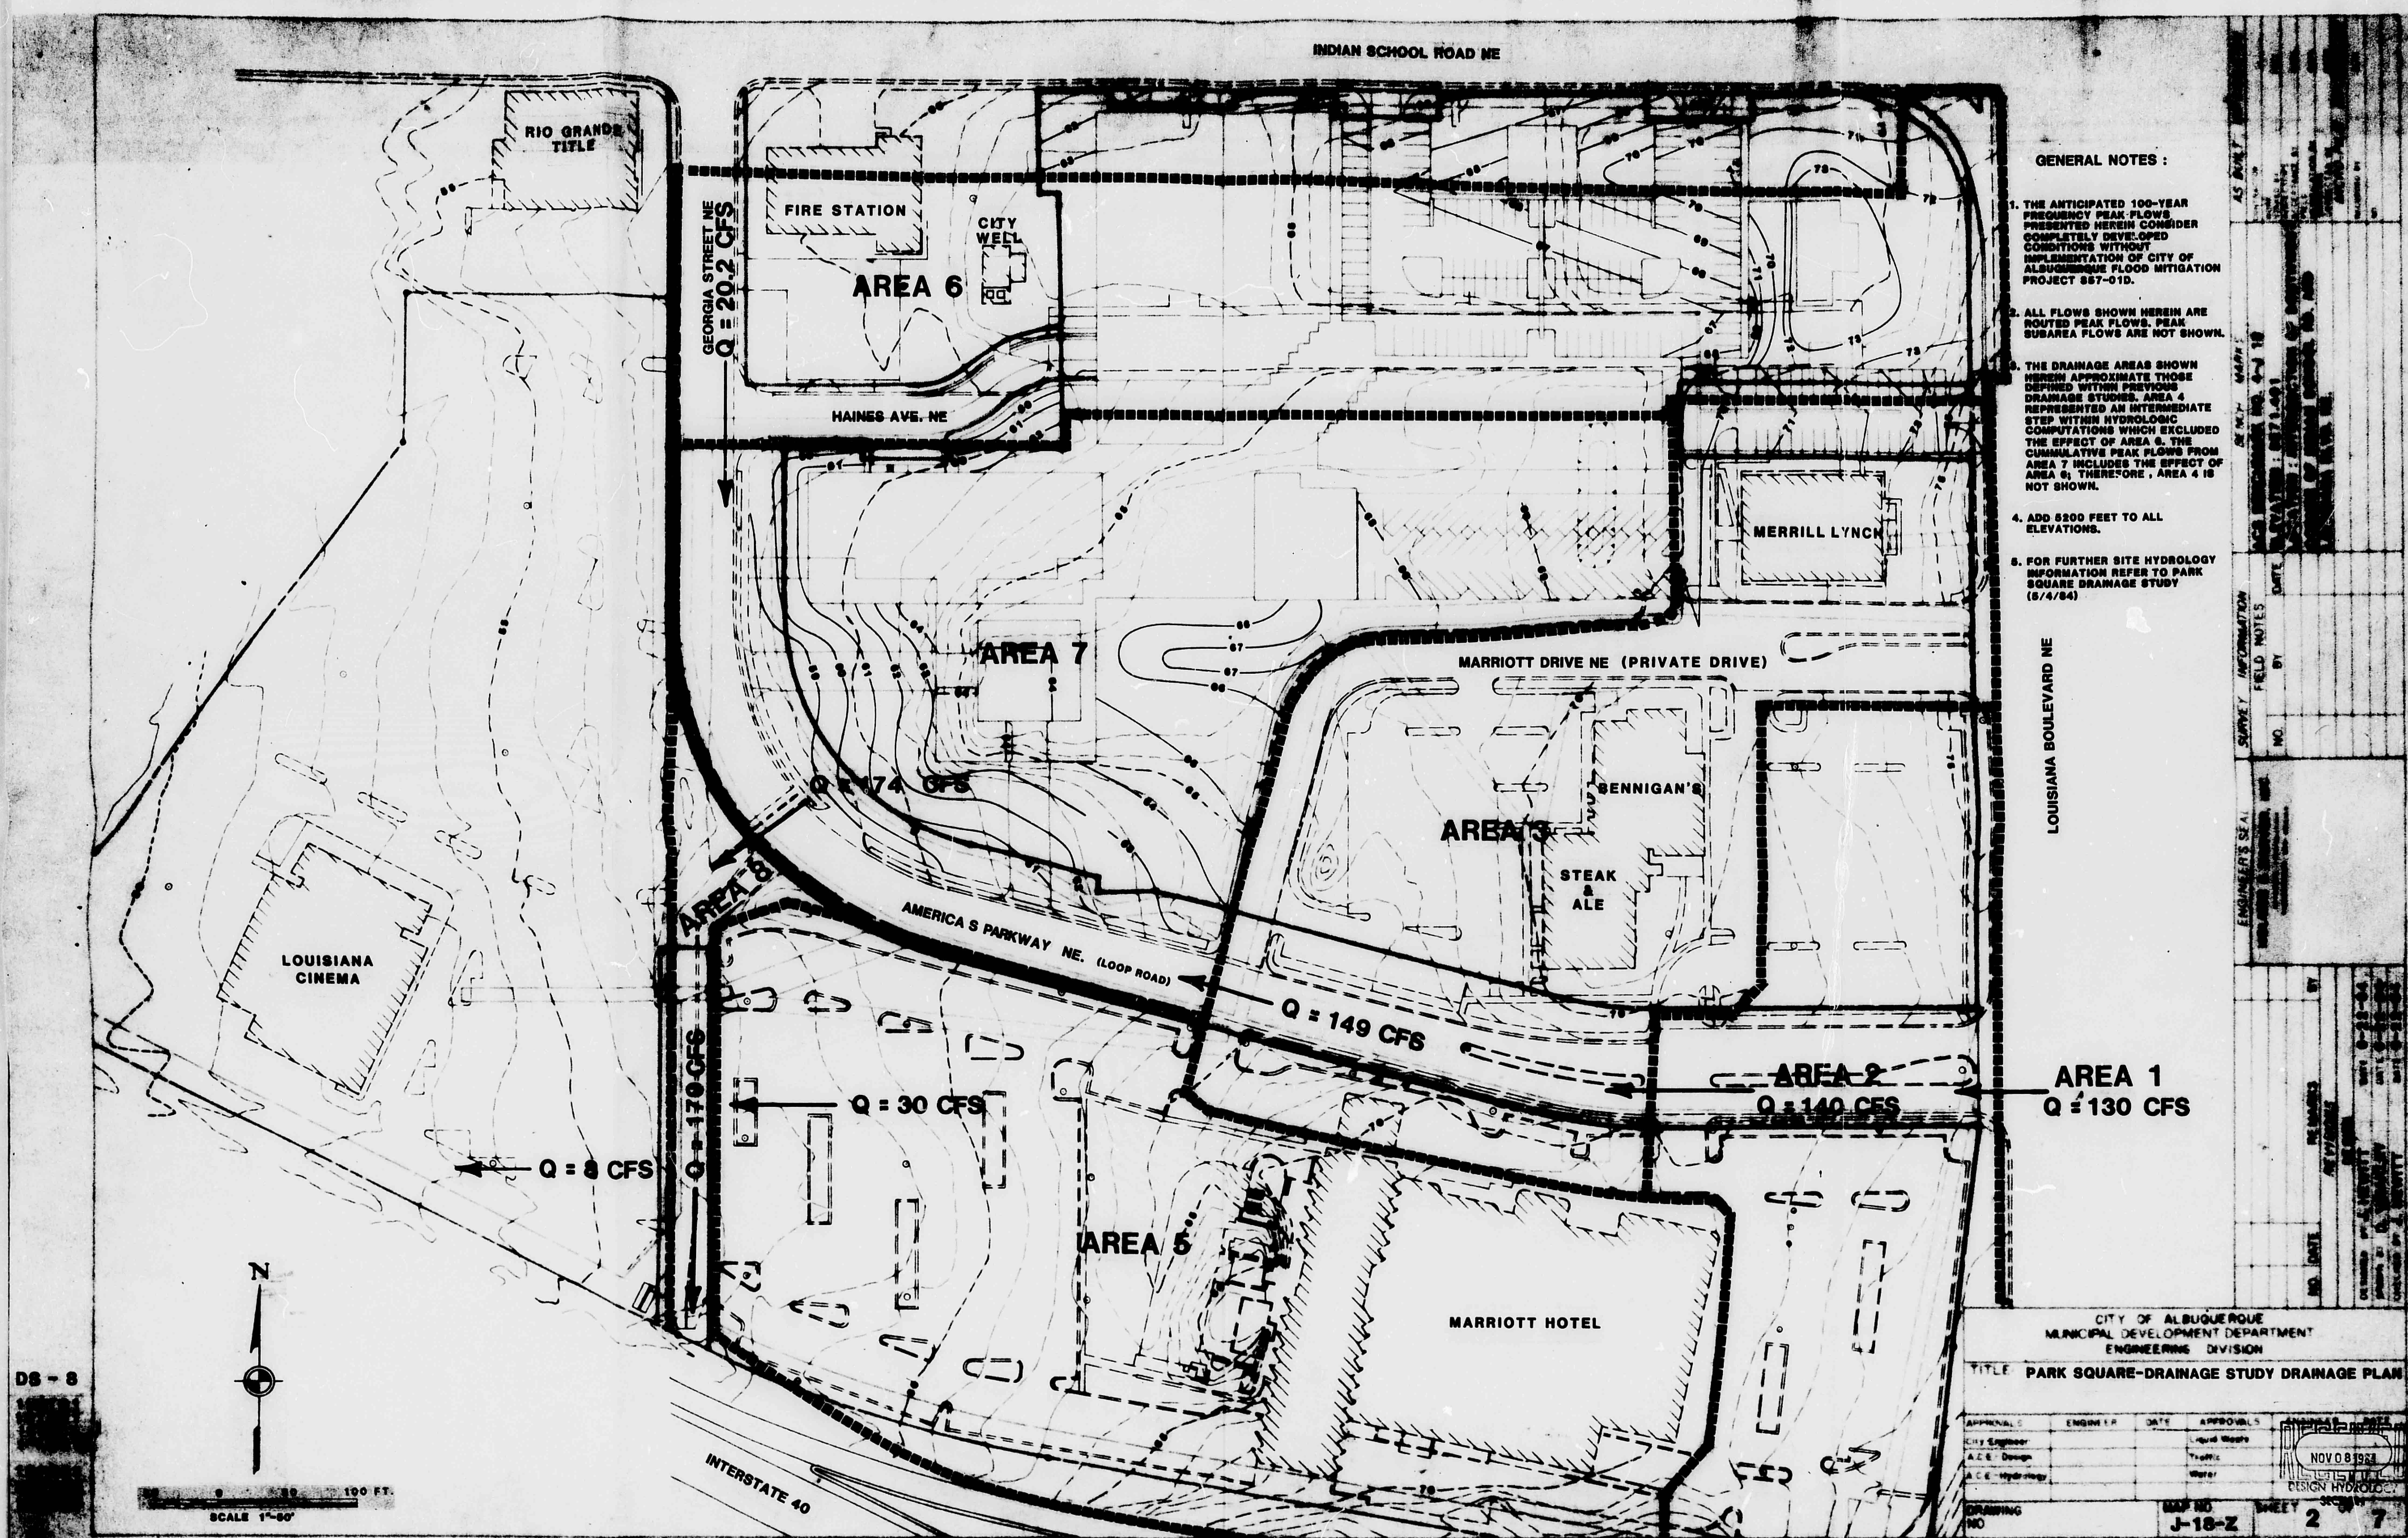

D
24

C
20

B
16


A
12

CITY OF ALBUQUERQUE

C

D

CITY OF ALBUQUERQUE
THIS MICROIMAGE IS THE BEST
POSSIBLE REPRODUCTION DUE
TO THE POOR QUALITY OF THE
ORIGINAL DOCUMENT

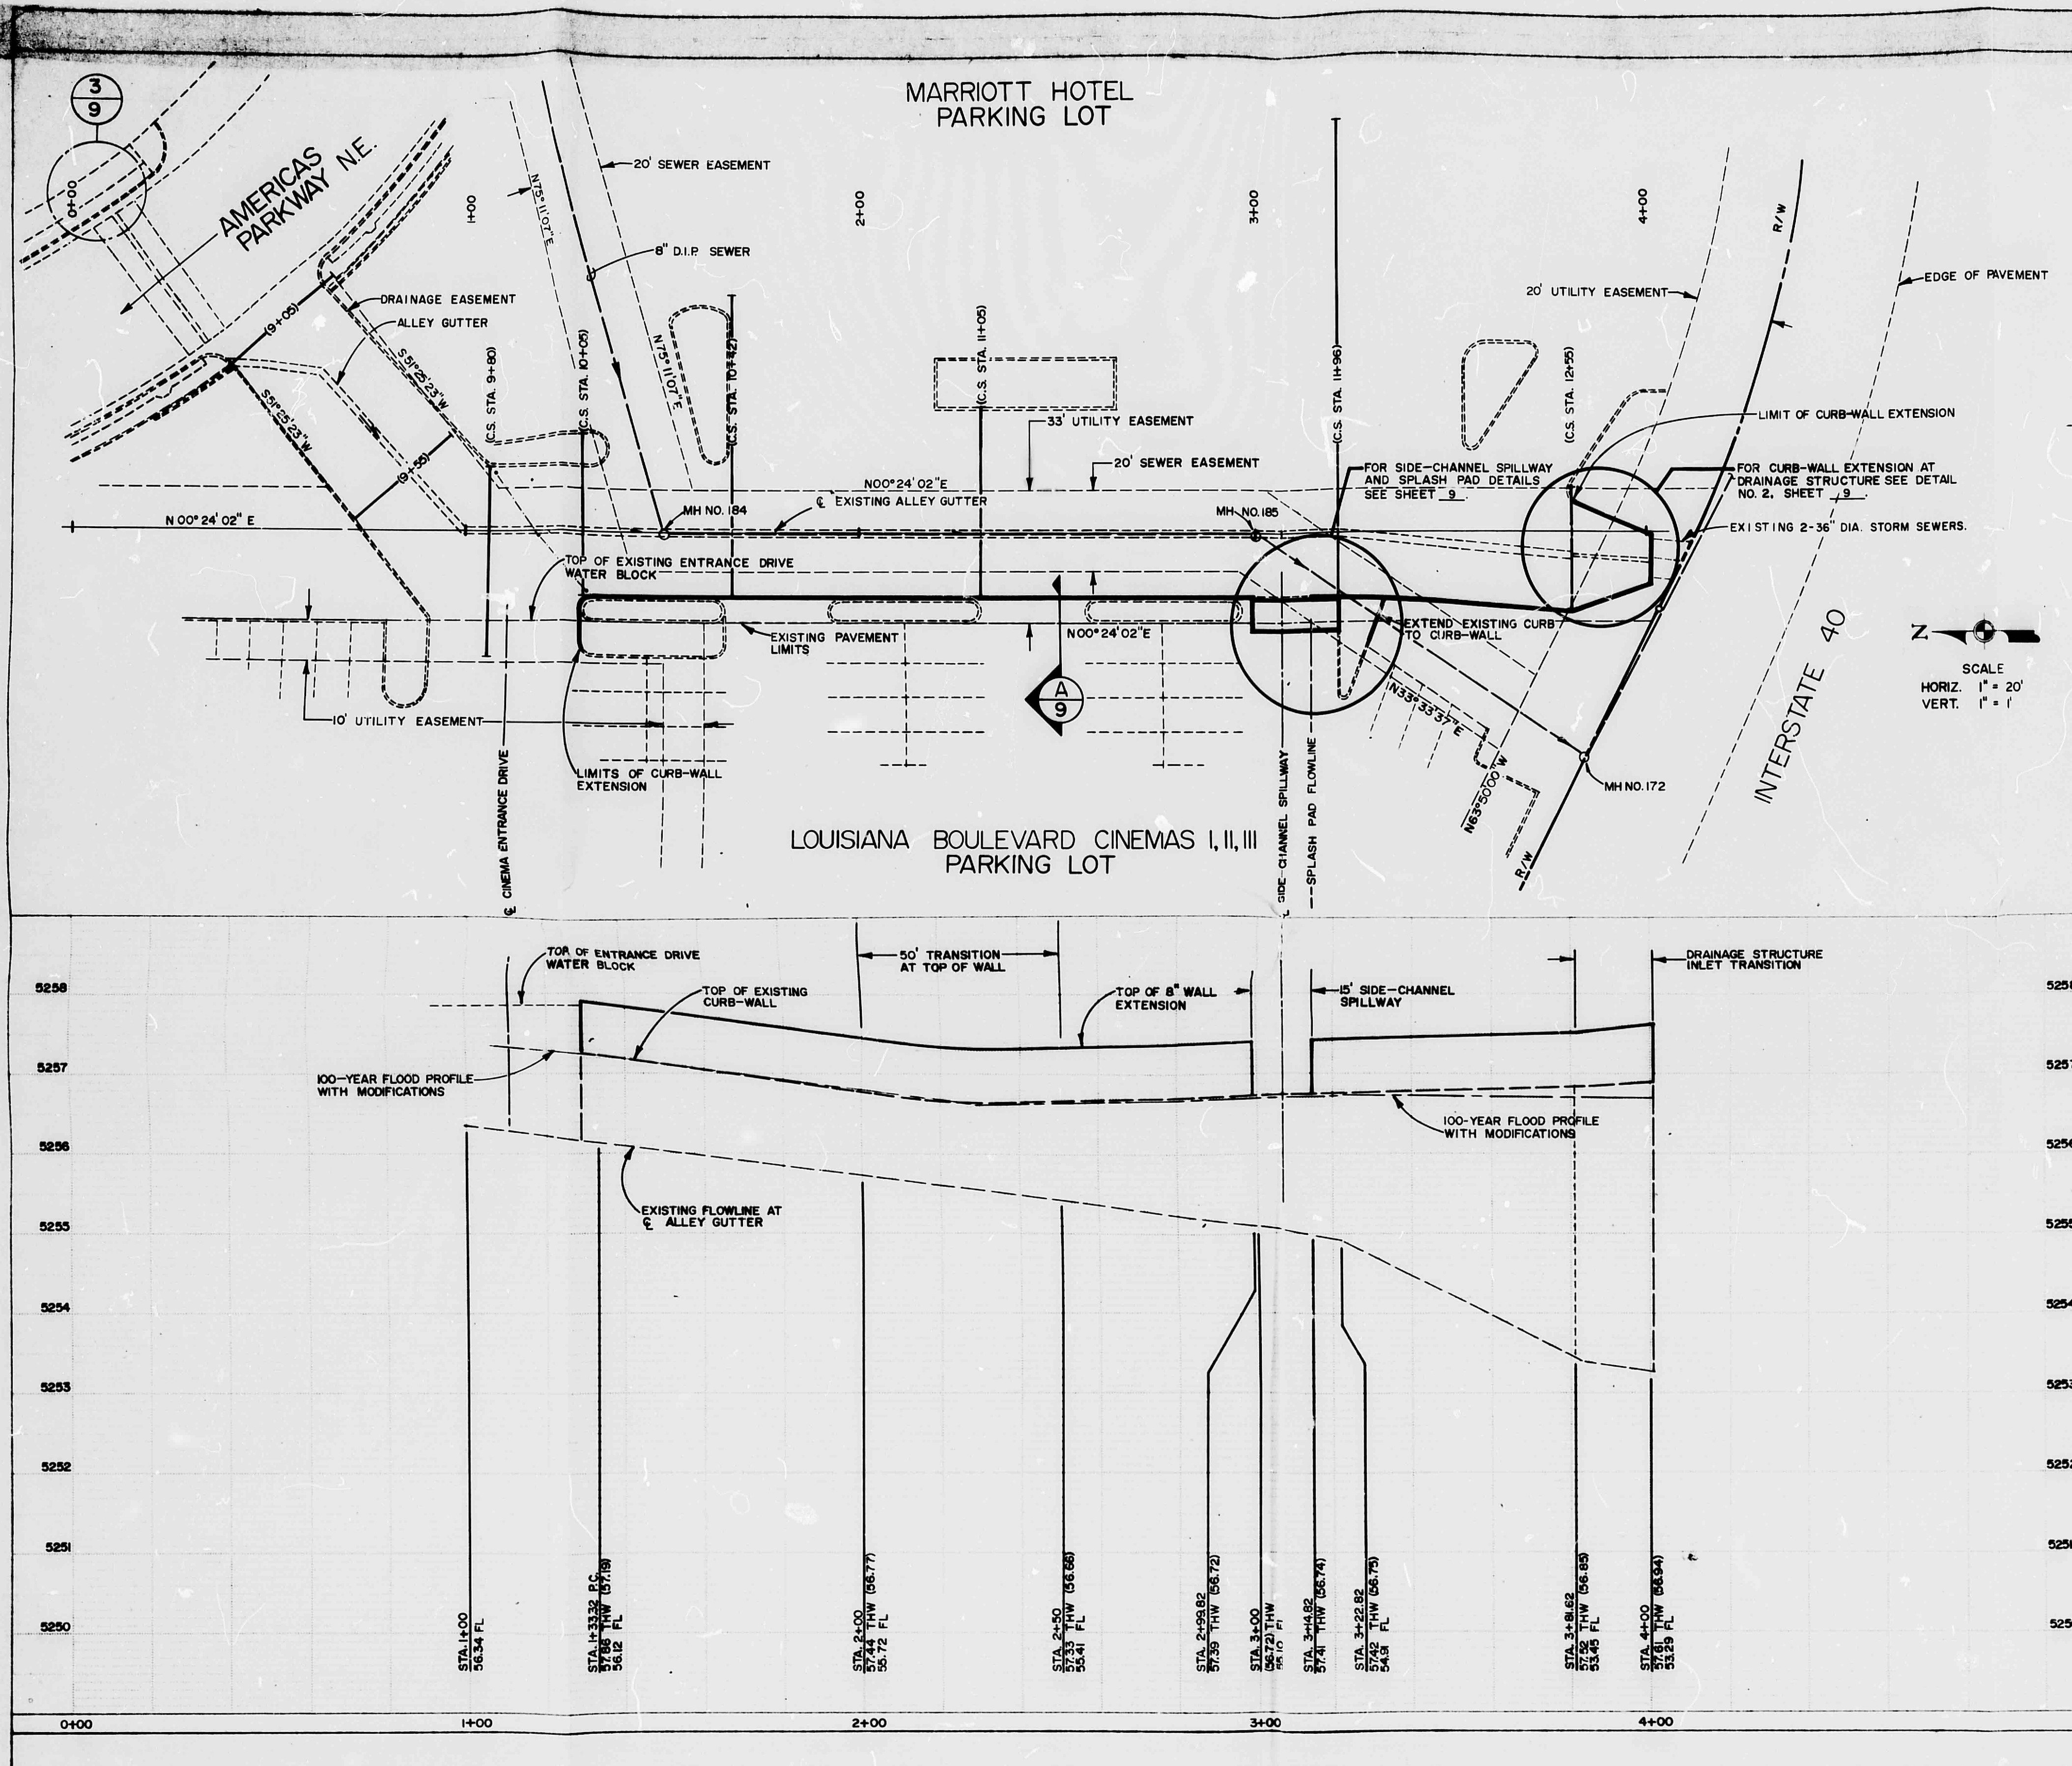


- GENERAL NOTES**
1. CROSS-SECTION LOCATIONS SHOWN IN PLAN VIEW RELATE TO DESCRIPTIONS USED IN COMPUTER ANALYSIS OF 100-YEAR FLOOD PROFILE. FOR FURTHER DETAILS REFER TO PARK SQUARE DRAINAGE STUDY (5/4/84).
 2. PROFILE STATIONING CORRESPONDS TO ORIGINAL DESIGN BY GORDON HERKENHOFF & ASSOC. INC. (11/79).
 3. ADD 5200 FEET TO ALL ELEVATIONS.


SCALE
HORIZ. 1" = 20'
VERT. 1" = 1'

AS BUILT INFORMATION		BENCH MARKS	
DATE	BY	NO.	DATE
ACS BENCHMARK NO. 4-J 18 ELEVATION: 5271.491 LOCATION: INTERSECTION OF SOUTHWEST CORNER OF INDIAN SCHOOL RD. AND LOUISIANA BLVD. NE.			
SURVEY INFORMATION		ENGINEER'S SEAL	
DATE	BY	HOLMES & NARVER, INC. REGISTERED PROFESSIONAL ENGINEERS STATE OF NEW MEXICO	
NO.	DATE	REMARKS	
DESIGNED BY J. HEWITT DATE 5-1-84		BY	
DRAWN BY D. WEAKLEY DATE 5-1-84		CHECKED BY J. HEWITT DATE 5-3-84	
CITY OF ALBUQUERQUE MUNICIPAL DEVELOPMENT DEPARTMENT ENGINEERING DIVISION			
TITLE PARK SQUARE - DRAINAGE EASEMENT PLAN AND PROFILE			
APPROVALS	ENGINEER	DATE	APPROVALS
CITY ENGINEER			LIQUID WASTE
A.C.E. DESIGN			TRAFFIC
A.C.E. HYDROLOGY			WATER
DRAWING NO. J-18-2		MAP NO. J-18-2	
SHEET 6 OF 7		SECTION 6 OF 7	



CITY OF ALBUQUERQUE
THIS MICROIMAGE IS THE BEST
POSSIBLE REPRODUCTION DUE
TO THE POOR QUALITY OF THE
ORIGINAL DOCUMENT

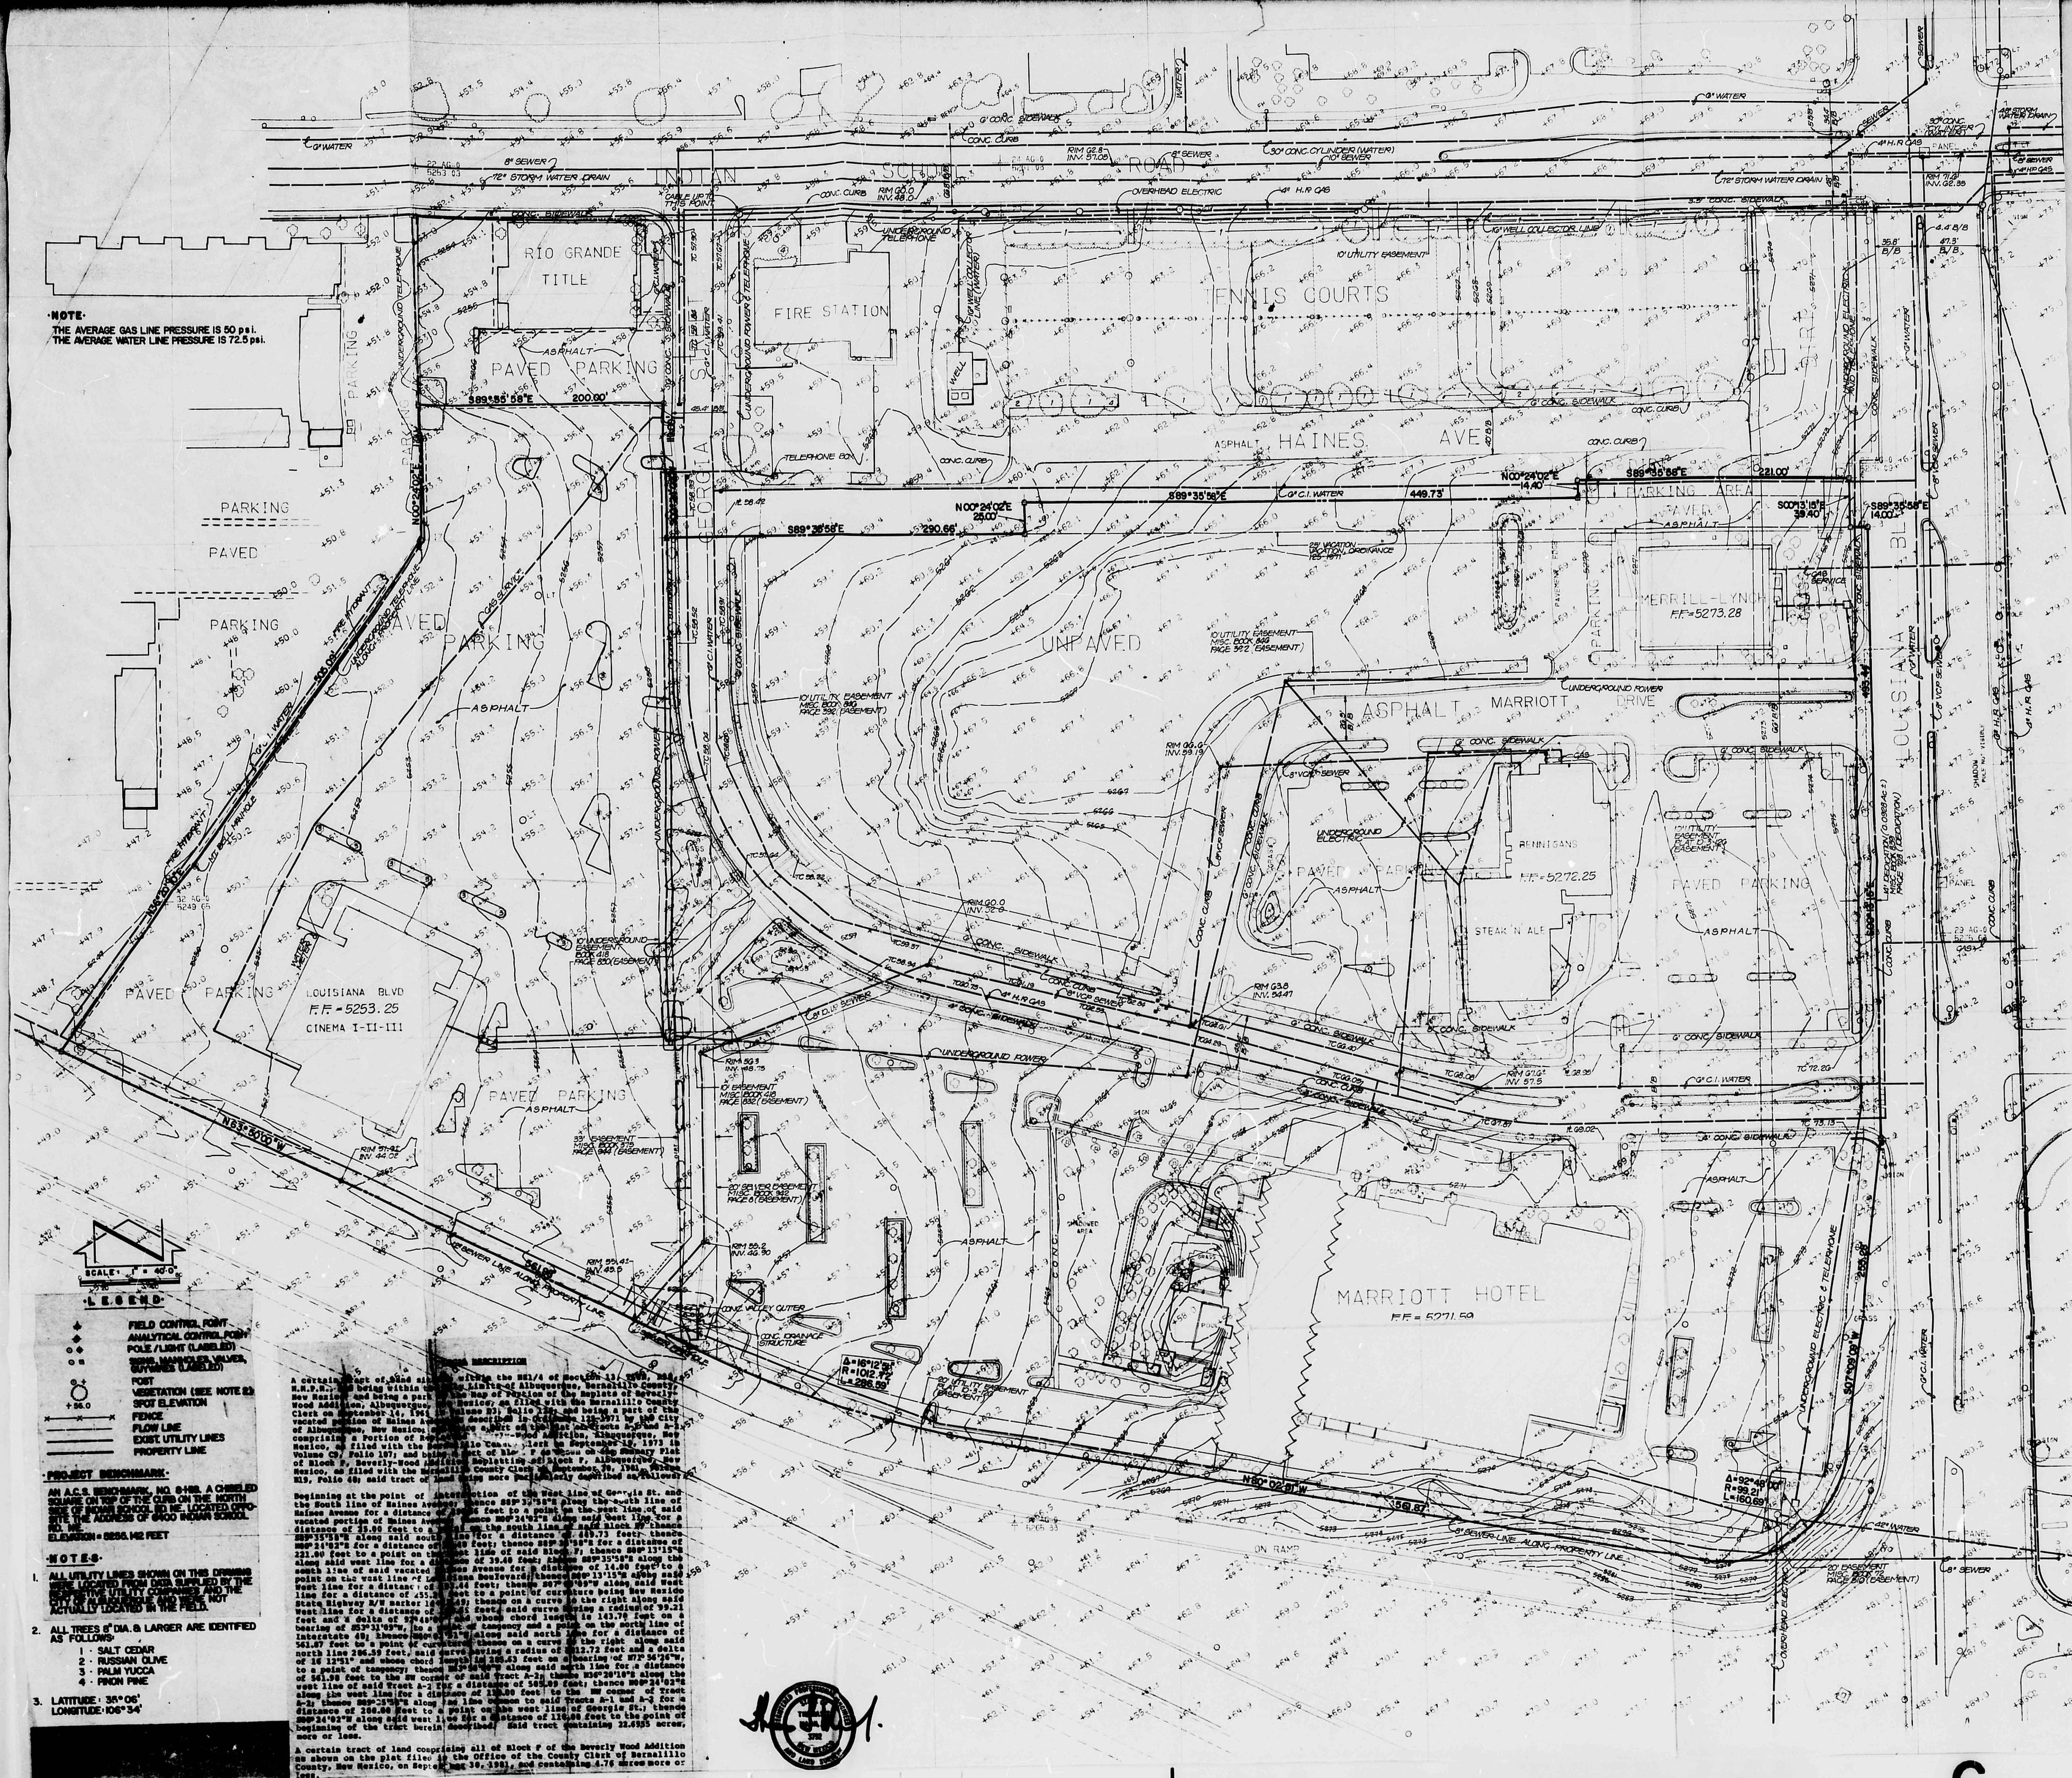


CITY OF ALBUQUERQUE
THIS MICROIMAGE IS THE BEST
POSSIBLE REPRODUCTION DUE
TO THE POOR QUALITY OF THE
ORIGINAL DOCUMENT

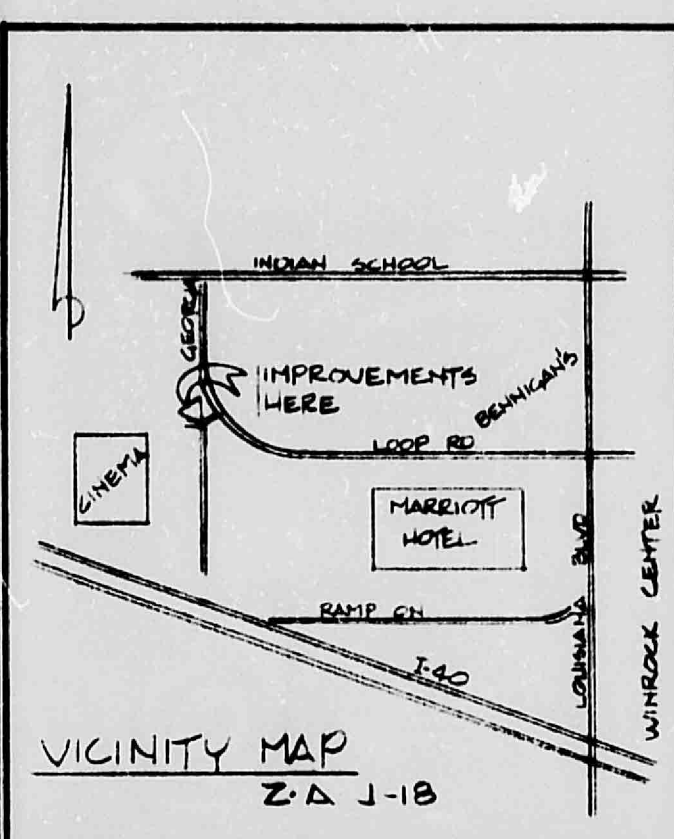


- LEGEND**
- ==== EXIST. CURB
 - 57.123 EXIST. ELEV
 - 70.88.00 PROPOSED ELEV
 - PROPOSED CURB
 - PROPOSED ASPHALT BERM

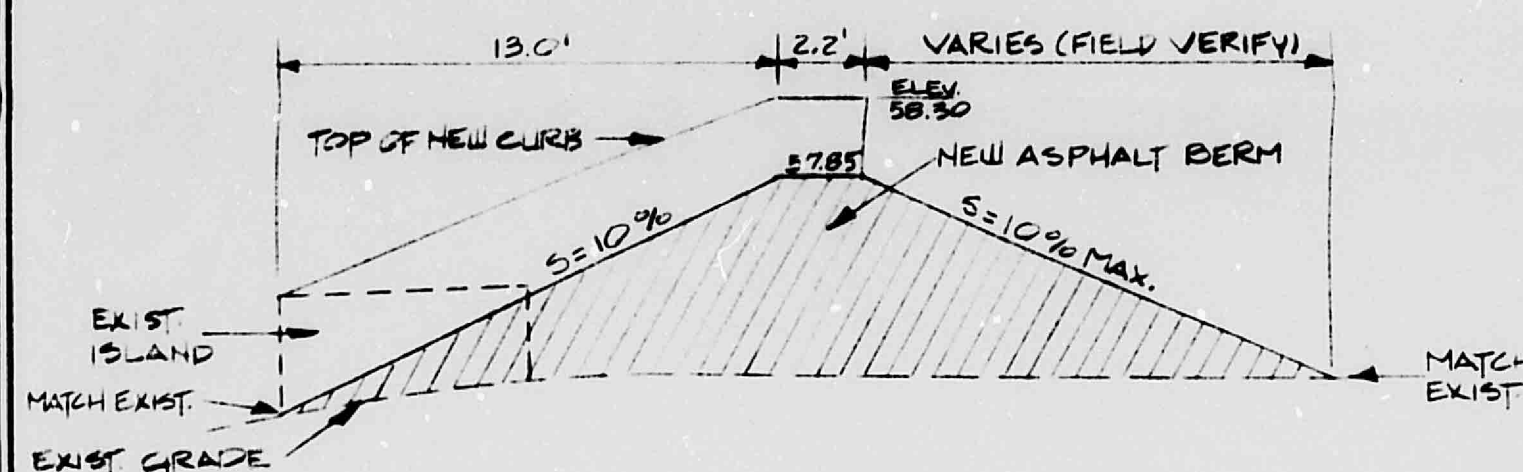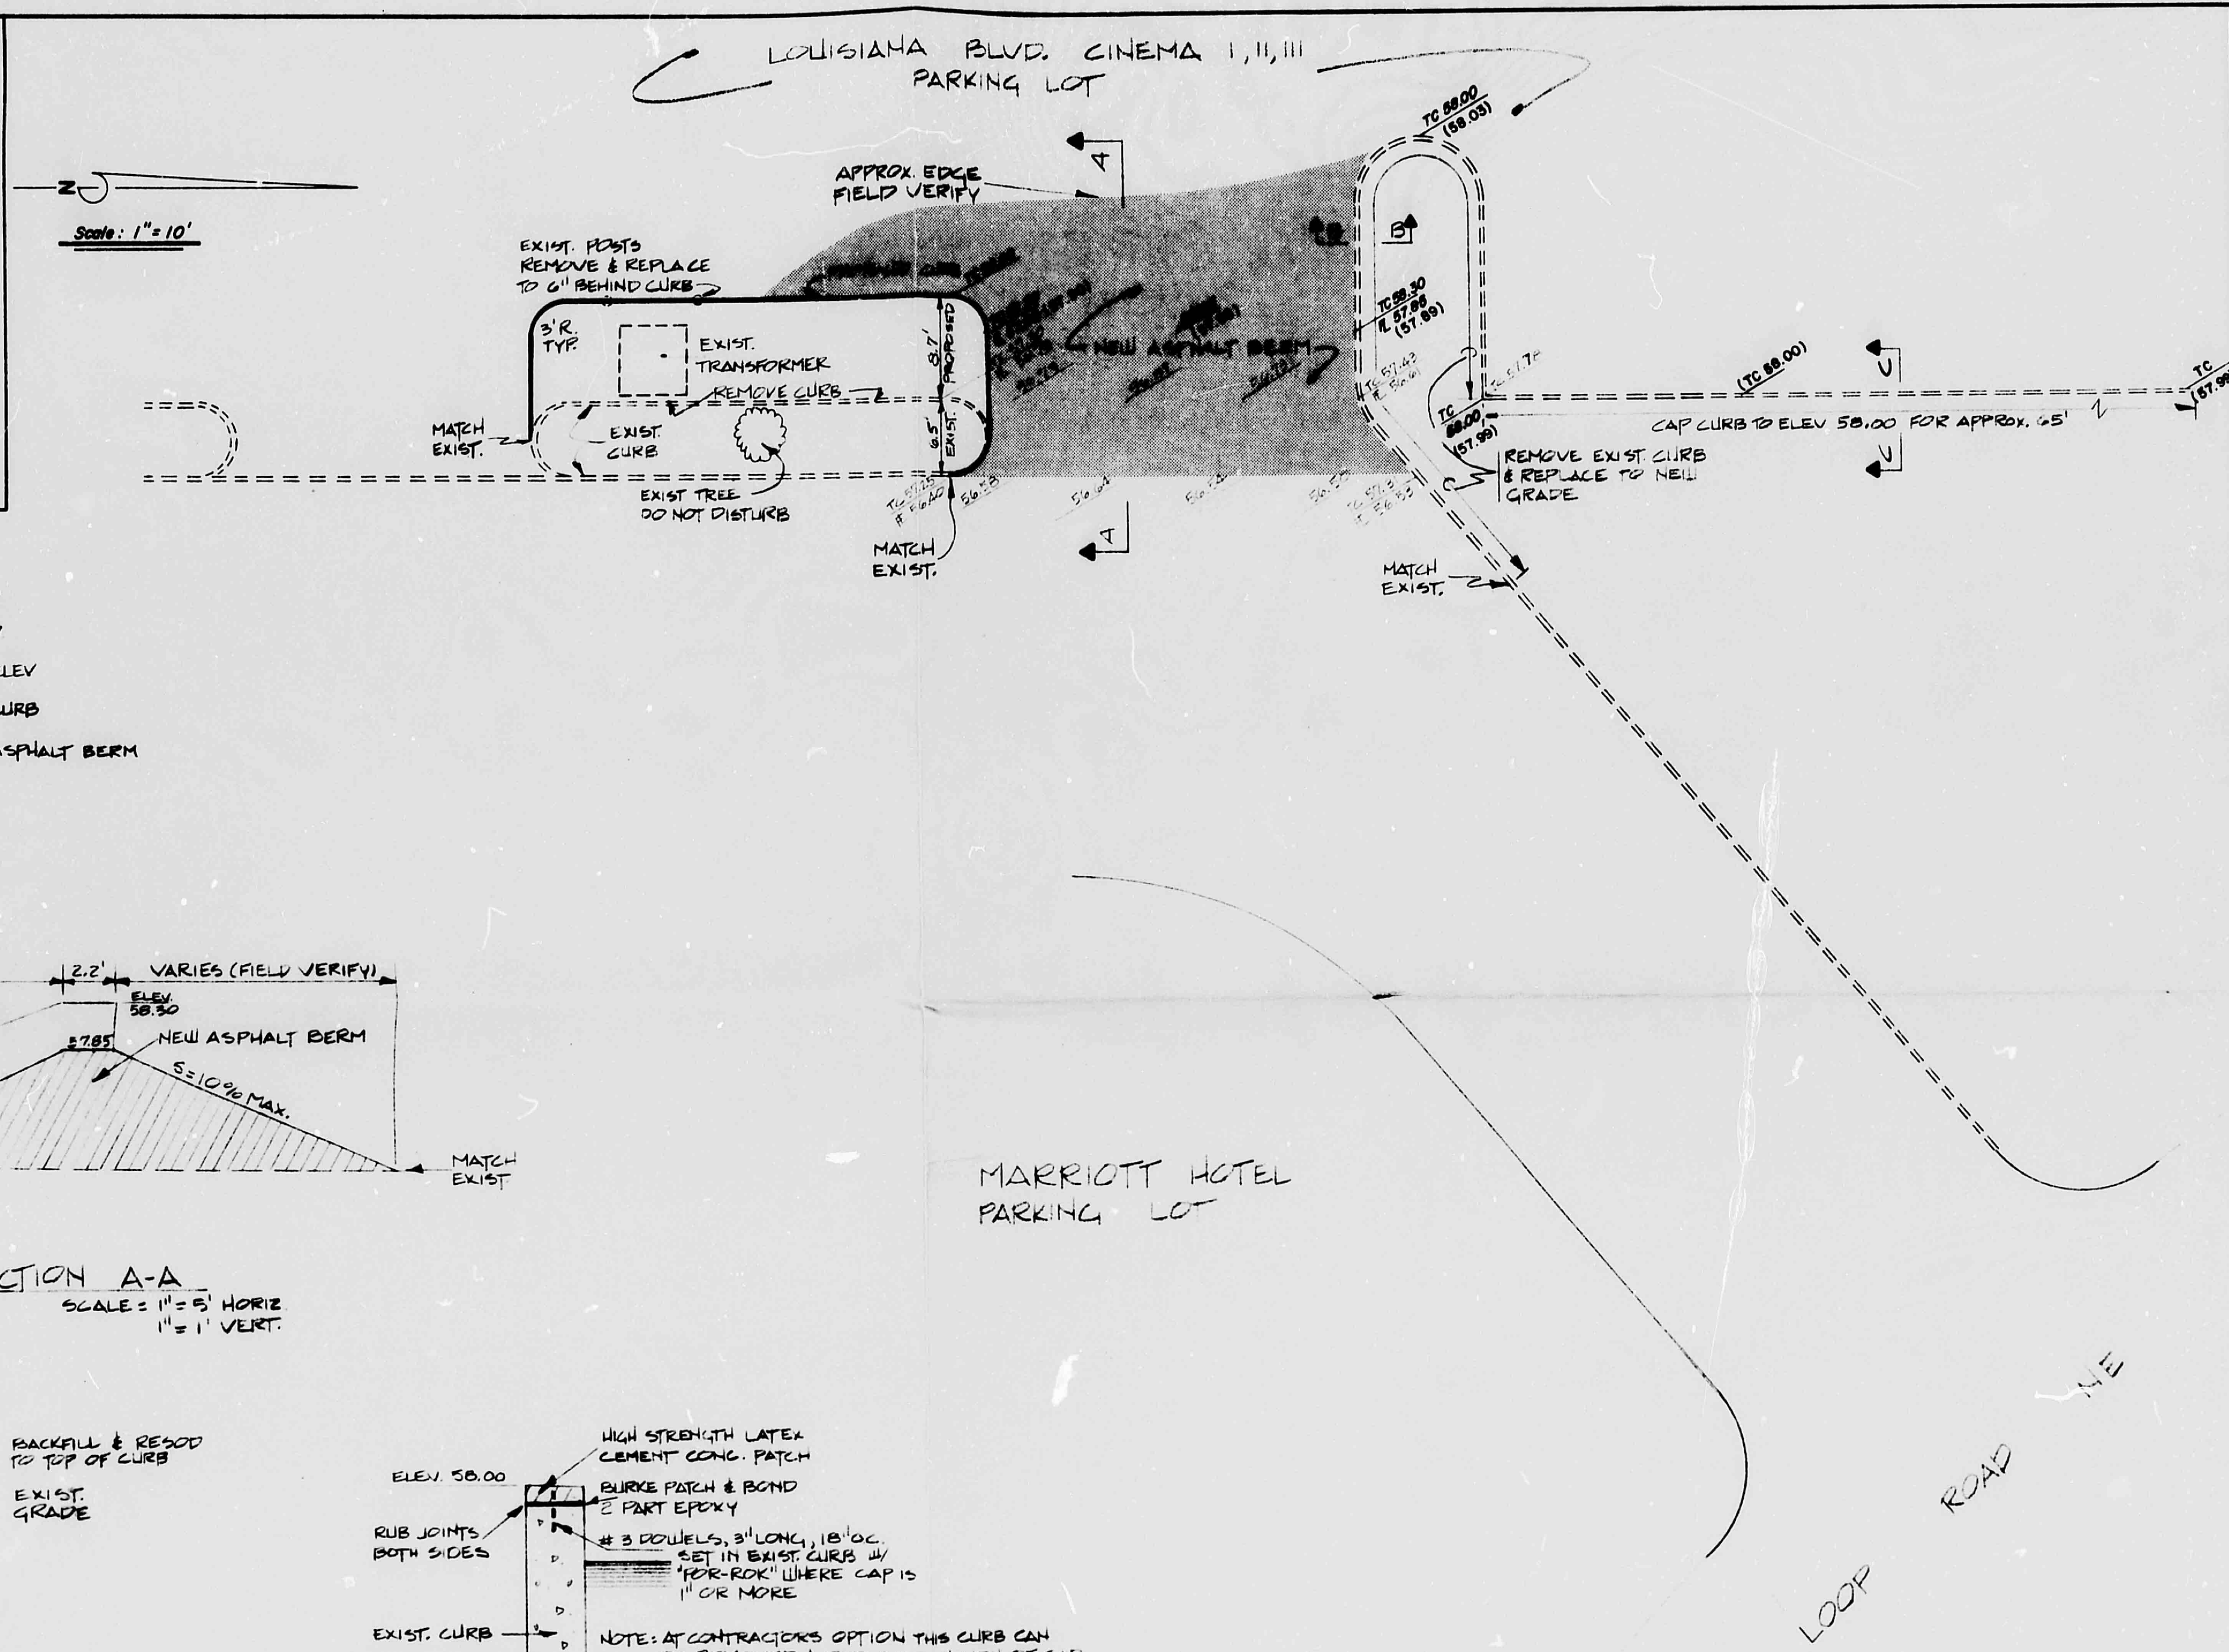

SECTION A-A
SCALE: 1" = 5' HORIZ
1" = 1' VERT.

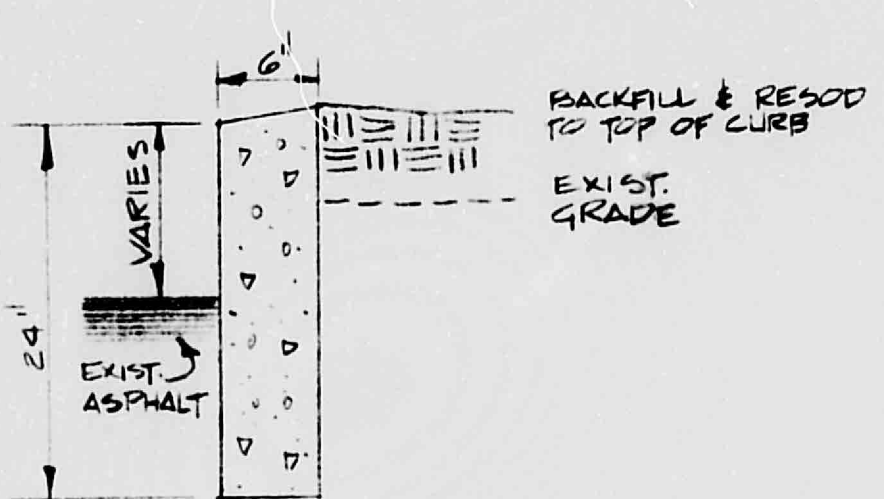


SECTION B-B
SCALE: 1" = 1'

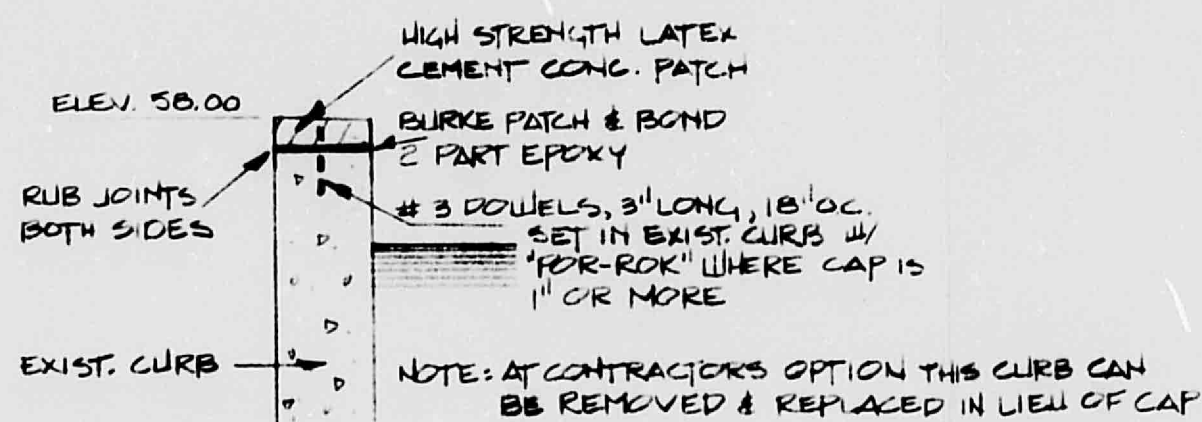

SECTION C-C
SCALE: 1" = 1'

AS - BUILT AS-BUILT GRADES IN PARENTHESIS FROM FIELD SURVEY NOV. 23, 1982

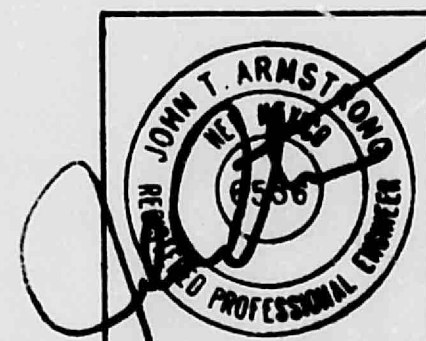

PROPOSED WATER BLOCK THRU DRIVEWAY FOR
PARK SQUARE
ARMSTRONG ENGINEERING, INC. AUGUST, 1982

CITY OF ALBUQUERQUE
THIS MICROIMAGE IS THE BEST
POSSIBLE REPRODUCTION DUE
TO THE POOR QUALITY OF THE
ORIGINAL DOCUMENT

CITY OF ALBUQUERQUE