


LEGEND

- AS BUILT ELEVATIONS
- EXISTING ELEVATIONS
- FINISHED ELEVATIONS
- EXISTING CONTOUR LINES
- FINISHED CONTOUR LINES
- LIMITS OF EXISTING BUILDING
- CURB & GUTTER
- AIRWAY OPEN TO BASEMENT

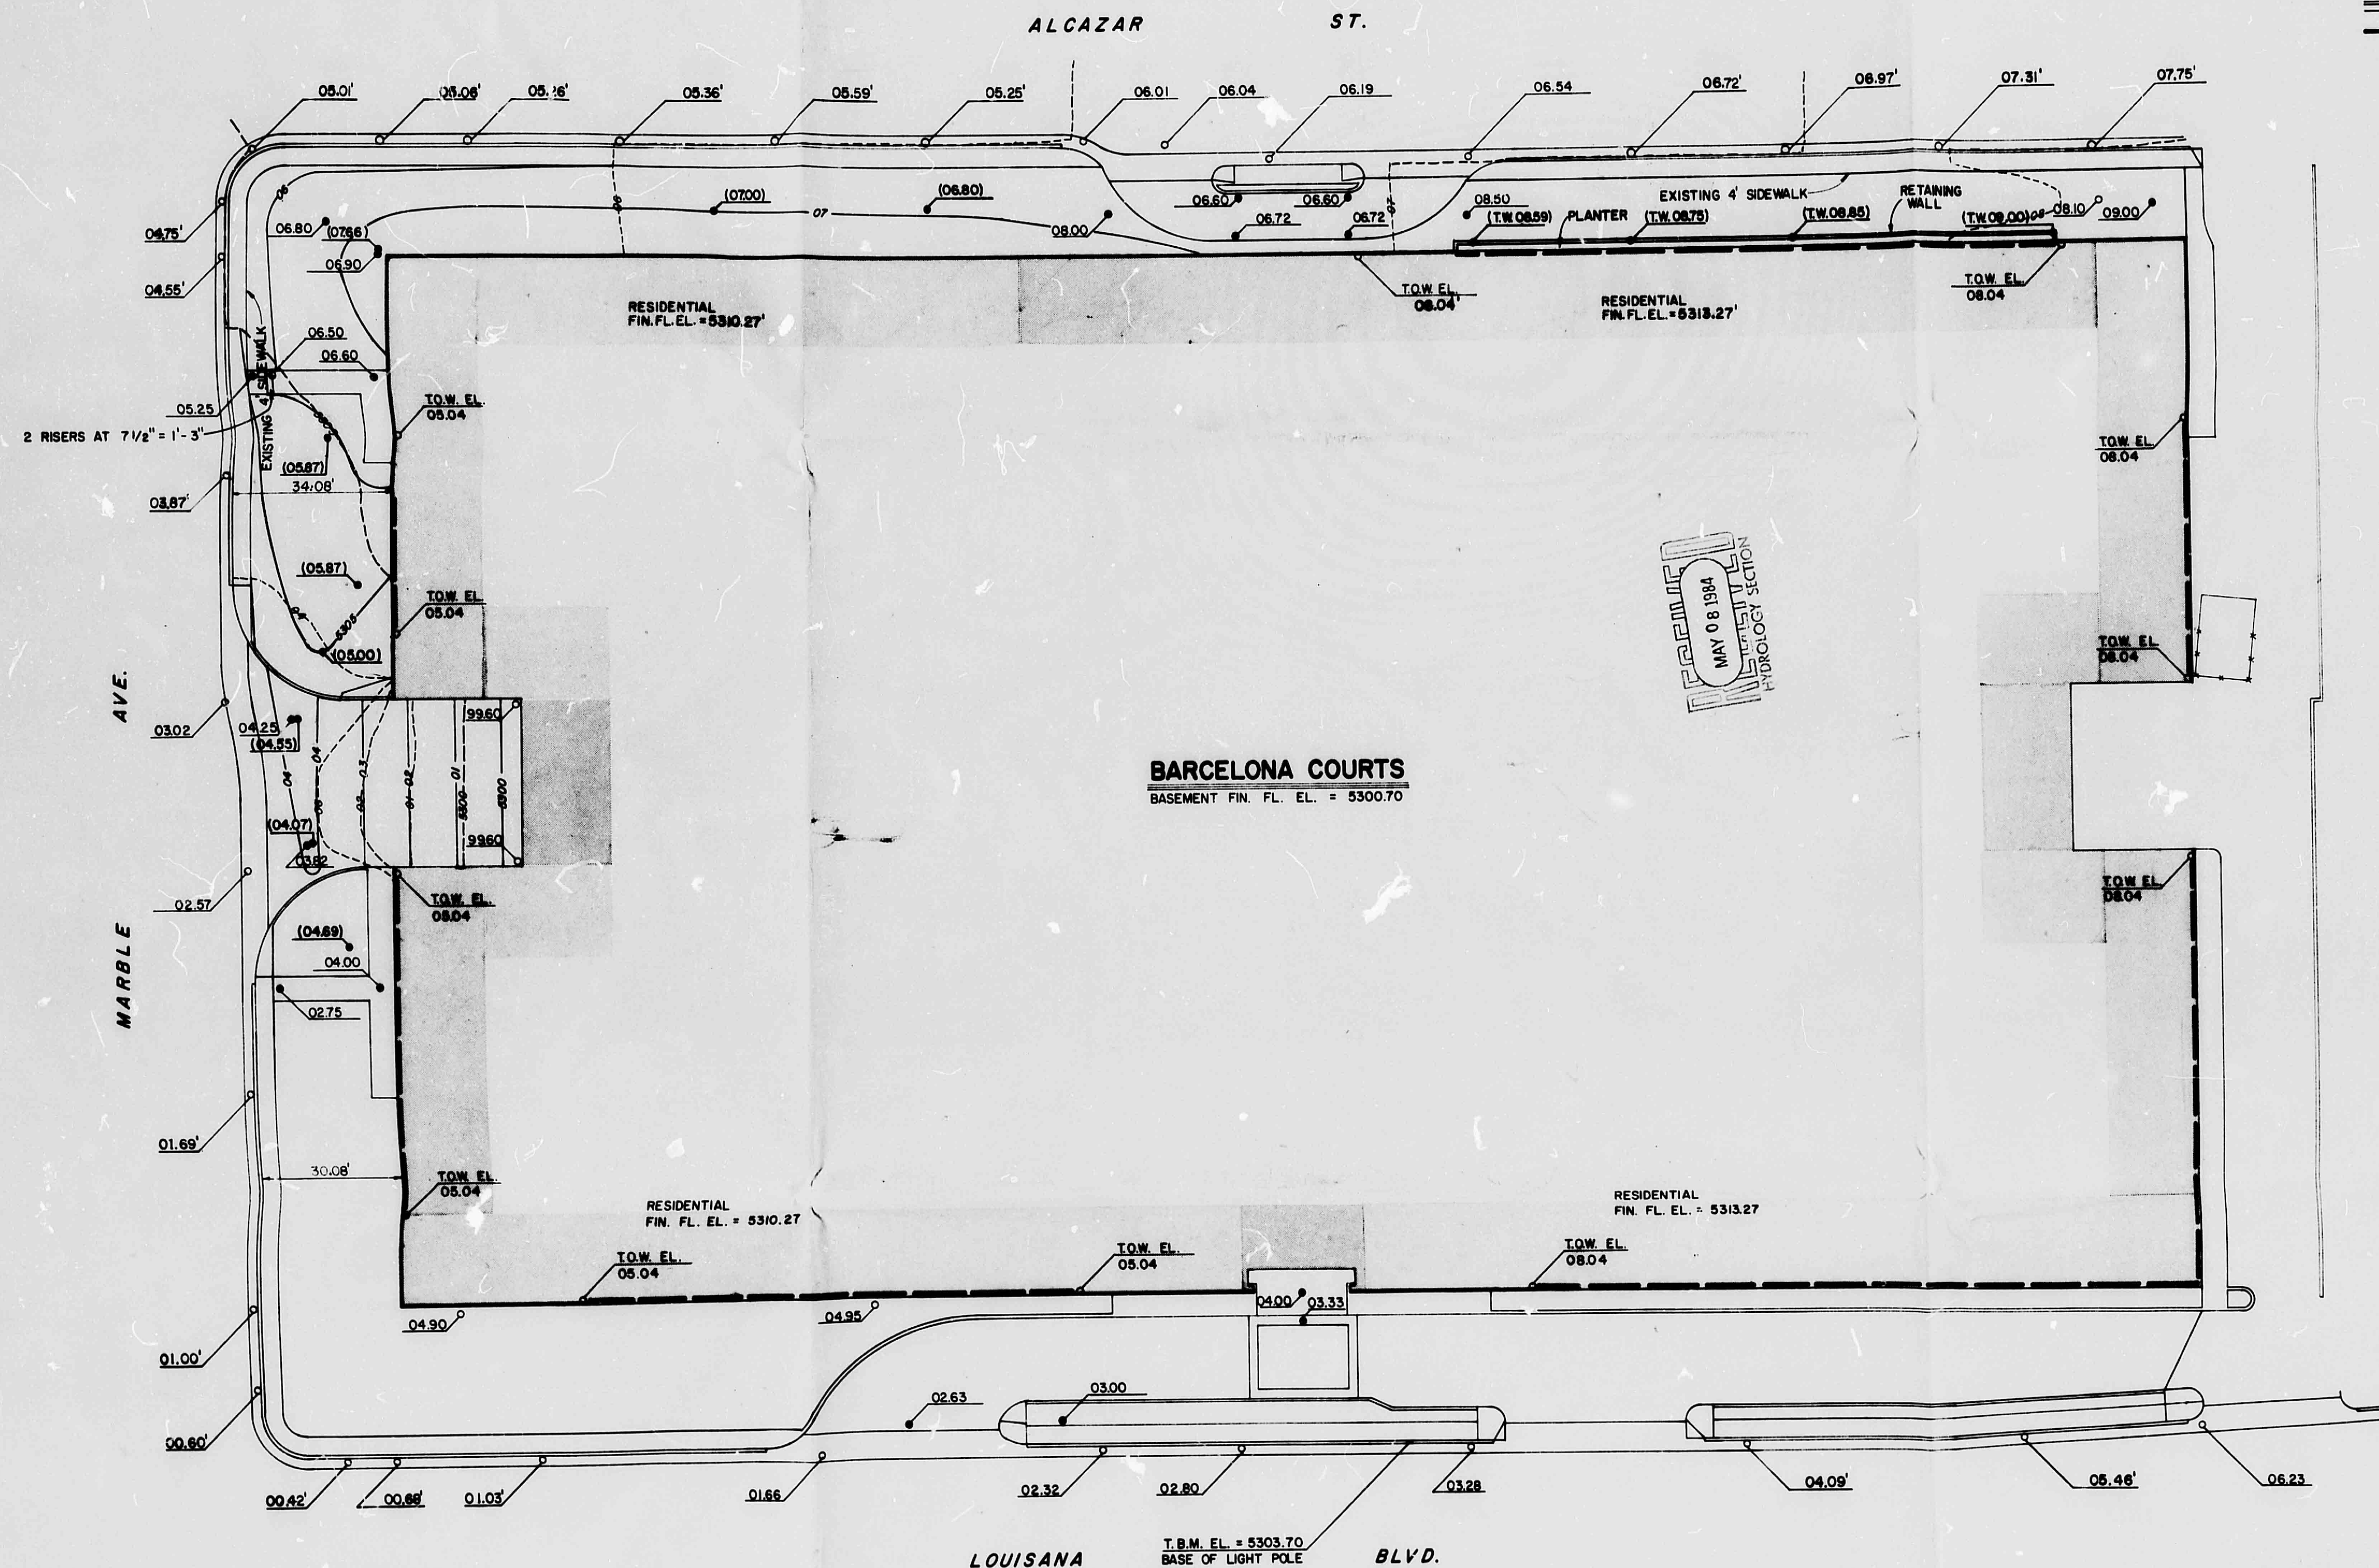

FLOOD PROOFING PLAN

SCALE: 1" = 20' - 0"



CHAVEZ GRIEVES / CONSULTING ENGINEERS, INC.
 6121 INDIAN SCHOOL RD. N.E.
 SUITE 220
 ALBUQUERQUE, N.M. 87110
 PH. (505) 881-7376

CITY OF ALBUQUERQUE
 THIS MICROIMAGE IS THE BEST
 POSSIBLE REPRODUCTION DUE
 TO THE POOR QUALITY OF THE
 ORIGINAL DOCUMENT

CITY OF ALBUQUERQUE

C

D