

# CITY OF ALBUQUERQUE



Richard J. Berry, Mayor

May 25, 2017

Scott Eddings, P.E.  
Huitt-Zollars  
333 Rio Rancho Blvd., Suite 101  
Rio Rancho, NM 87124

**RE: Winrock Redevelopment Sections 2 & 4 – 2100 Louisiana Blvd**  
**Request for Permanent C.O. - Accepted**  
**Grading and Drainage Plan, Engineer's Stamp Date: 7/20/15**  
**Engineer's Drainage Certification Dates: 3/21/17 & 4/10/17**  
**Public Work Order Set: 4553.84**  
**Hydrology File: J19D058C**

Dear Mr. Eddings:

PO Box 1293

Based on the information provided in your Engineer's Drainage Certification received 3/21/17, updated information received on 5/25/17, and Public Work Order Record Drawings certified on 1/5/17, the closeout of the Public Work Order and Release of Permanent Certificate of Occupancy (CO-Perm) are approved for Hydrology.

Albuquerque

If you have any questions, please contact me at 924-3695 or Totten Elliott at 924-3982.

New Mexico 87103

Sincerely,

[www.cabq.gov](http://www.cabq.gov)

Dana Peterson, P.E.  
Senior Engineer, Planning Dept.  
Development Review Services

TE/DP

CC email: Tena, Victoria; Fox, Debbie; Serna, Yvette; Sandoval, Darlene.



# City of Albuquerque

Planning Department

Development & Building Services Division

## DRAINAGE AND TRANSPORTATION INFORMATION SHEET (REV 10/2015)

**Project Title:** Winrock Town Center-Section 2 and 4 Building Permit #: \_\_\_\_\_ Hydrology File #: J19D058C

DRB#: \_\_\_\_\_ EPC#: \_\_\_\_\_ Work Order#: \_\_\_\_\_

Legal Description: Parcel A-1-A-1-A-1 Winrock Town Center

City Address: 2100 Louisiana Blvd NE

**Applicant:** Huitt-Zollars, Inc Contact: Scott Eddings

Address: 333 Rio Rancho Blvd, Rio Rancho NM, 87124

Phone#: 505-892-5141 Fax#: 505-892-3259 E-mail: [seddings@huitt-zollars.com](mailto:seddings@huitt-zollars.com)

**Other Contact:** Goodman Realty Contact: Fred Gorenz

Address: 100 Sun Avenue

Phone#: 881-0100 Fax#: NA E-mail: NA

Check all that Apply:

### DEPARTMENT:

☒ HYDROLOGY/ DRAINAGE  
☐ TRAFFIC/ TRANSPORTATION  
☐ MS4/ EROSION & SEDIMENT CONTROL

### TYPE OF SUBMITTAL:

☒ ENGINEER/ARCHITECT CERTIFICATION  
☐ CONCEPTUAL G & D PLAN  
☒ GRADING PLAN  
☐ DRAINAGE MASTER PLAN  
☐ DRAINAGE REPORT  
☐ CLOMR/LOMR  
☐ TRAFFIC CIRCULATION LAYOUT (TCL)  
☐ TRAFFIC IMPACT STUDY (TIS)  
☐ EROSION & SEDIMENT CONTROL PLAN (ESC)  
☐ OTHER (SPECIFY) \_\_\_\_\_

### TYPE OF APPROVAL/ACCEPTANCE SOUGHT:

☐ BUILDING PERMIT APPROVAL  
☒ CERTIFICATE OF OCCUPANCY  
☐ PRELIMINARY PLAT APPROVAL  
☐ SITE PLAN FOR SUB'D APPROVAL  
☐ SITE PLAN FOR BLDG. PERMIT APPROVAL  
☐ FINAL PLAT APPROVAL  
☐ SIA/ RELEASE OF FINANCIAL GUARANTEE  
☐ FOUNDATION PERMIT APPROVAL  
☐ GRADING PERMIT APPROVAL  
☐ SO-19 APPROVAL  
☐ PAVING PERMIT APPROVAL  
☐ GRADING/ PAD CERTIFICATION  
☐ WORK ORDER APPROVAL  
☐ CLOMR/LOMR

### ☐ PRE-DESIGN MEETING?

IS THIS A RESUBMITTAL?: ☒ Yes ☐ No

☐ OTHER (SPECIFY) \_\_\_\_\_

DATE SUBMITTED: May 23, 2017

By: Scott Eddings

DRAINAGE NARRATIVE

**PURPOSE**  
THE PURPOSE OF THIS DRAINAGE PLAN ADDRESSES STORM WATER RUNOFF AND PROPOSED INFRASTRUCTURE NECESSARY TO CONVEY RUNOFF FROM THE PROPOSED SECTION 2 AND SECTION 4 WINROCK TOWN CENTER SITE PLAN. THESE SECTIONS ARE THE SOUTHEAST AND SOUTHWEST PORTIONS OF THE EXISTING MALL AND ALSO INCLUDE SURFACE PARKING AREAS. THE PLAN WILL EXHIBIT COMPLIANCE WITH THE CITY OF ALBUQUERQUE DPM CHAPTER 22 AND THE DRAINAGE MASTER PLAN (DMP) FOR WINROCK TOWN CENTER PREPARED BY ISAACSON AND ARFMAN, P.A. DATED JUNE 26, 2015.

**EXISTING CONDITIONS**  
THE WINROCK SITE IS A COMPLEX OF BUILDINGS THAT INCLUDES THE MAIN MALL, A NUMBER OF OUTLYING RESTAURANTS, THE TOYS 'R' US, AND A RECENTLY COMPLETED MOVIE THEATER. THE EXISTING MALL BUILDING IS COMPOSED OF A NUMBER OF INDIVIDUAL BUILDINGS THAT WERE ENCLOSED BY AN OVERALL STRUCTURE.

THE SITE IS BOUNDED BY INDIAN SCHOOL ROAD TO THE NORTH, AMERICA'S PARKWAY (AKA UPTOWN LOOP) TO THE NORTHWEST, LOUISIANA BLVD TO THE WEST, I-40 AND THE EMBUDO ARROYO TO THE SOUTH, THE WINROCK VILLAS CONDO COMPLEX TO THE EAST, AND PENNSYLVANIA AVE TO THE NORTHEAST. THE SITE GENERALLY SLOPES FROM THE EAST TOWARDS THE SOUTHWEST CORNER.

EXISTING DRAINAGE PATTERNS DIRECT STORM WATER TOWARDS ONE OF THE EXISTING STORM DRAINS, OR TO THE SURROUNDING ROADS. THE SITE IS COMPLETELY DEVELOPED WITH ABOUT 88% IMPERVIOUS AREA.

- RELATED REPORTS**
- "DRAINAGE MASTER PLAN" FOR WINROCK TOWN CENTER BY ISAACSON AND ARFMAN, P.A. DATED 6/26/2015
  - "PHASE 1 AMENDMENT TO THE FINAL DRAINAGE STUDY FOR WINROCK REDEVELOPMENT" BY HUITT- ZOLLARS, INC. DATED 09/07/2011 (H-Z AMENDMENT)
  - "FINAL DRAINAGE STUDY FOR WINROCK REDEVELOPMENT WINROCK MARKET CENTER" BY HUITT- ZOLLARS, INC. DATED 03/13/2006 (H-Z DRAINAGE STUDY)

IN THE EXISTING CONDITION THE SITE IS FULLY DEVELOPED AND DOESN'T PROVIDE ANY ONSITE DETENTION, RESULTING IN A HISTORIC FREE-DISCHARGE FROM THE OVERALL WINROCK SITE. DOWNSTREAM DRAINAGE INFRASTRUCTURE IS SIZED TO ACCEPT THE EXISTING FLOWS FROM EACH EXISTING DISCHARGE POINT.

- DMP DRAINAGE BASINS & SUB BASINS INCLUDED IN THIS PROJECT:**
- **SUB BASIN 301** BASIN 400 BASIN 400 BASIN 500 ROOF TOP
  - **SUB BASIN 302** BASIN 500 BASIN 610 BASIN 530

- DMP REQUIREMENTS INCLUDE THE FOLLOWING:**
- DESIGN EACH PROJECT USING THE LAND TREATMENTS CALLED OUT FOR EACH BASIN IN THE HYDROLOGY CALCULATIONS IN APPENDIX B.
  - EVERY NEW DEVELOPMENT IS REQUIRED TO BUILD DOWNSTREAM STORM DRAINS THAT ARE SHOWN IN THIS DMP. THE IMPROVEMENTS MUST MEET CITY OF ALBUQUERQUE STANDARDS.
  - THE DEVELOPMENTS ARE ALSO REQUIRED TO DESIGN HOW FLOWS ARE DIRECTED TO THAT INFRASTRUCTURE.
  - EXAMPLES INCLUDE NUMBER AND LOCATION OF STORM INLETS, ROOF DRAIN CONNECTIONS, SIDEWALK CULVERTS, STREET FLOW CAPACITY, ETC.
  - AS PART OF THE INDIVIDUAL GRADING & DRAINAGE PLANS, EVERY NEW DEVELOPMENT WITHIN THE PROJECT IS REQUIRED TO TREAT "FIRST FLUSH" STORM WATER PER CITY OF ALBUQUERQUE DPM REQUIREMENTS.
  - "ROOFTOP" BASINS WILL BE DIRECTED TO THE WATER FEATURE IN BASIN 500P FOR TREATMENT.
  - EXISTING STORM DRAINS THAT ARE UNDER PROPOSED BUILDINGS MUST BE REMOVED. OTHER EXISTINGSTORM DRAINS THAT ARE NOT TO BE USED MAY BE ABANDONED IN-PLACE.

- SUMMARY**  
**STORM DRAIN 1 - 36" RCP**  
FIVE BASINS WILL DISCHARGE STORM WATER INTO STORM DRAIN 1.
- **BASINS 500 (ROOFTOP) AND 500 A4**
  - **FIRST FLUSH FOR THE SERVICE AREA WILL BE THE UNDERGROUND STORM CHAMBERS.**

- STORM DRAIN 2 - 36" HPPP**  
ONE BASINS PLUS STORM DRAIN 1 WILL DISCHARGE STORM WATER INTO STORM DRAIN 2.
- **BASIN 500 A1** AT INLET NO. 2.

- STORM DRAIN 3 - 24" HPPP**  
ONE BASIN DISCHARGES INTO STORM DRAIN 3.  
**BASIN 530** DISCHARGES INTO STORM DRAIN 3 IN A BANK OF INLETS AT ANALYSIS POINT 3 (**AP 3**).

- STORM DRAIN 4 - 36" HPPP**  
STORM DRAIN 3 DISCHARGES INTO STORM DRAIN 4.
- **BASIN 500 A5**
  - **BASIN 500 A6**

**STORM DRAINS 2 AND 4 DISCHARGE INTO THE EXISTING 42" STORM DRAIN WHICH DISCHARGES INTO THE I-40 CHANNEL.**

- STORM DRAIN 5 - 24" RCP**  
TWO BASINS WILL DISCHARGE INTO STORM DRAIN 5.
- **BASIN 500 ROOFTOP** IS A ROOF TOP BASIN AND THE ROOF DRAINS WILL BE TIED INTO STORM DRAIN 5.
  - **BASIN 500 ROOFTOP** IS A ROOF TOP BASIN AND THE ROOF DRAINS WILL BE TIED INTO STORM DRAIN 5.

- STORM DRAIN 6 - 42" HPPP**  
DMP STORM DRAIN FOR BASIN 300. STORM DRAIN DISCHARGES TO EXISTING 84" STORM DRAIN.

- STORM DRAIN 7 - 36" HPPP**  
DMP STORM DRAIN FOR BASIN 300. STORM DRAIN DISCHARGES INTO STORM DRAIN 6.

- STORM DRAIN 8 - 24" HPPP**  
DMP STORM DRAIN FOR BASIN 300. STORM DRAIN DISCHARGES INTO STORM DRAIN 7.

**"FIRST FLUSH" TREATMENT**  
BASINS WITH PARKING FIELDS HAVE DEPRESSED LANDSCAPE PARKING ISLANDS AND ARE GRADED TO ACCEPT SURFACE FLOWS ON THE HIGH SIDE AND EXCESS WATER WILL SPILL OVER THE HIGH SIDE CURBING IN ORDER TO TREAT THE "FIRST FLUSH" EVENT. SEE SHEET C103 FOR ADDITIONAL FIRST FLUSH INFORMATION.

HYRDOLOGY

Basin	Sub-Basin	Description	Land Treatments (DEVELOPED)				AREA	AREA	10-YR Peak Discharge				100-YR Peak Discharge							Drainage Master Plan
			Percentage						CFS/ACRE				CFS/ACRE				10-YR PEAK FLOW	100-YR PEAK FLOW	100-YR PEAK FLOW	
			A	B	C	D	SF	AC	A	B	C	D	A	B	C	D	CFS	CFS	CFS	
301	A1	Road	0	9	0	91	16,365	0.376	0.58	1.19	2.00	3.39	1.87	2.60	3.45	5.02	1.2	1.8		
301	A2	Road	0	9	0	91	15,859	0.364	0.58	1.19	2.00	3.39	1.87	2.60	3.45	5.02	1.2	1.7		
TOTAL								0.740									2.361	3.552	120.1	
302	A1	Road	0	9	0	91	25,502	0.585	0.58	1.19	2.00	3.39	1.87	2.60	3.45	5.02	1.9	2.8		
302	A2	Roads and Parking Field	0	17	0	83	39,398	0.904	0.58	1.19	2.00	3.39	1.87	2.60	3.45	5.02	2.7	4.2		
TOTAL								1.490									4.597	6.980	120.1	
400	A1	Roads and Parking Field	0	9	0	91	140,415	3.223	0.58	1.19	2.00	3.39	1.87	2.60	3.45	5.02	10.3	15.5		
TOTAL								3.223									10.3	15.5	15.2	
500	A1	Road	0	9	0	91	54,006	1.240	0.58	1.19	2.00	3.39	1.87	2.60	3.45	5.02	4.0	6.0		
500	A2	Exposed Parking Structure	0	0	0	100	74,442	1.709	0.58	1.19	2.00	3.39	1.87	2.60	3.45	5.02	5.8	8.6		
500	A3	Road	0	9	0	91	11,021	0.253	0.58	1.19	2.00	3.39	1.87	2.60	3.45	5.02	0.8	1.2		
500	A4	Concrete Service Area	0	0	0	100	43,255	0.993	0.58	1.19	2.00	3.39	1.87	2.60	3.45	5.02	3.4	5.0		
500	A5	Parking Field	0	17	0	83	47,634	1.094	0.58	1.19	2.00	3.39	1.87	2.60	3.45	5.02	3.3	5.0		
500	A6	Parking Field	0	17	0	83	116,179	2.667	0.58	1.19	2.00	3.39	1.87	2.60	3.45	5.02	8.0	12.3		
TOTAL								7.955									25.3	38.1	38.3	
610	A1	Roads	0	3	12	85	11,646	0.267	0.58	1.19	2.00	3.39	1.87	2.60	3.45	5.02	0.8	1.3		
TOTAL								0.267									0.8	1.3	5.5	
SITE TOTAL								13.676									43.358	65.348		

FIRST FLUSH REQUIRED VOLUME

Basin	Sub-Basin	Description	Land Treatments (DEVELOPED)				AREA	AREA	FIRST FLUSH RATES				FIRST FLUSH VOLUME REQUIRED	8" DEEP DEPRESSED LANDSCAPE AREA PROVIDED
			Percentage						CF/ACRE					
			A	B	C	D	SF	AC	A	B	C	D	VOLUME	CUBIC FEET
301	A1	Road	0	9	0	91	16,365	0.376	399	545	762	1416	502.52	
301	A2	Road	0	9	0	91	15,859	0.364	399	545	762	1416	486.99	
TOTAL								0.740					989.51	0.00
302	A1	Road	0	9	0	91	25,502	0.585	399	545	762	1416	783.10	
302	A2	Roads and Parking Field	0	17	0	83	39,398	0.904	399	545	762	1416	1,146.78	
TOTAL								1.490					1,929.88	0.00
400	A1	Roads and Parking Field	0	9	0	91	140,415	3.223	399	545	762	1416	4,311.77	5,370.00
TOTAL								3.223					4,311.77	5,370.00
500	A1	Road	0	9	0	91	54,006	1.240	399	545	762	1416	1,658.38	3,800.00
500	A2	Exposed Parking Structure	0	0	0	100	74,442	1.709	399	545	762	1416	2,419.88	0.00
500	A3	Road	0	9	0	91	11,021	0.253	399	545	762	1416	338.43	500.00
500	A4	Concrete Service Area	0	0	0	100	43,255	0.993	399	545	762	1416	1,406.09	0.00
500	A5	Parking Field	0	17	0	83	47,634	1.094	399	545	762	1416	1,386.51	5,390.00
500	A6	Parking Field	0	17	0	83	116,179	2.667	399	545	762	1416	3,381.70	3,100.00
TOTAL								7.955					10,590.98	12,790.00
610	A1	Roads	0	3	12	85	11,646	0.267	399	545	762	1416	350.61	
TOTAL								0.267					350.61	0.00
SITE TOTAL								13.676					18,172.75	18,160.00

\*BASIN 530 TO BE DEVELOPED IN THE FUTURE AND WILL BE ALLOWED TO DISCHARGE DIRECTLY TO INLETL NO. 3  
FIRST FLUSH WILL BE CAPTURED AS PART OF FUTURE DEVELOPMENT.

ANALYSIS POINT

	BASIN	301		302		400	500						530 (DMP)	610
		A1	A2	A1	A2		A1	A2	A3	A4	500 Rooftop (DMP)	A5	A6	A1
	<b>SUB-BASIN</b>	1.2	1.2	1.9	2.7	15.5	6	8.6	1.2	5	17	5	12.3	10
	<b>100-YR PEAK FLOW</b>													1.3
ANALYSIS POINT														
AP1	22									5	17			
AP2	2						2							
AP3	10												10	
AP4	5											5		
AP5	12.3												12.3	
AP6	32				2.7	15.5	4	8.6	1.2					
AP7	1.9			1.9										
AP8	2.4	1.2	1.2											
AP9	1.3													1.3

DRAINAGE CERTIFICATION

I, SCOTT A. EDDINGS, NMPE 12856, OF THE FIRM HUITT-ZOLLARS, INC. HEREBY CERTIFY THAT THIS PROJECT HAS BEEN GRADED AND WILL DRAIN IN SUBSTANTIAL COMPLIANCE WITH AND IN ACCORDANCE WITH THE DESIGN INTENT OF THE APPROVED PLAN DATED 7/20/15. THE RECORD INFORMATION EDITED ON TO THE ORIGINAL DESIGN DOCUMENT HAS BEEN OBTAINED FROM THE SURVEY DATED 10/4/16 PROVIDED BY JOSEPH M. SOLOMON, JR., NMPS 15075 OF THE FIRM HIGH MESA CONSULTING GROUP. I FURTHER CERTIFY THAT I HAVE PERSONALLY VISITED THE PROJECT SITE ON 10/5/16 AND HAVE DETERMINED BY VISUAL INSPECTION THAT THE SURVEY DATA PROVIDED IS REPRESENTATIVE OF ACTUAL SITE CONDITIONS AND IS TRUE AND CORRECT TO THE BEST OF MY KNOWLEDGE AND BELIEF. THIS CERTIFICATION IS SUBMITTED IN SUPPORT OF A REQUEST FOR A PERMANENT CERTIFICATE OF OCCUPANCY AT WINROCK SECTION 2 AND 4 WINROCK TOWN CENTER.

THE RECORD INFORMATION PRESENTED HEREON IS NOT NECESSARILY COMPLETE AND INTENDED ONLY TO VERIFY SUBSTANTIAL COMPLIANCE OF THE GRADING AND DRAINAGE ASPECTS OF THIS PROJECT. THOSE RELYING ON THIS RECORD DOCUMENT ARE ADVISED TO OBTAIN INDEPENDENT VERIFICATION OF ITS ACCURACY BEFORE USING IT FOR ANY OTHER PURPOSE.

*Scott A. Eddings*  
SCOTT A. EDDINGS, NMPE 12856


3/21/17  
DATE



**HUITT-ZOLLARS**  
Huitt-Zollars, Inc. Rio Rancho  
333 Rio Rancho Drive NE, Suite 101  
Rio Rancho, New Mexico 87124  
Phone (505) 892-5141 Fax (505) 892-3259


REV	DATE	BY	REVISION
△			
△			
△	3/18/15	SAE	FIRST FLUSH PHASING

**MODULUS ARCHITECTS**  
220 COPPER AVE. N.W. SUITE 350  
ALBUQUERQUE, NEW MEXICO 87102  
PHONE (505) 338-1499 FAX (505) 338-1498

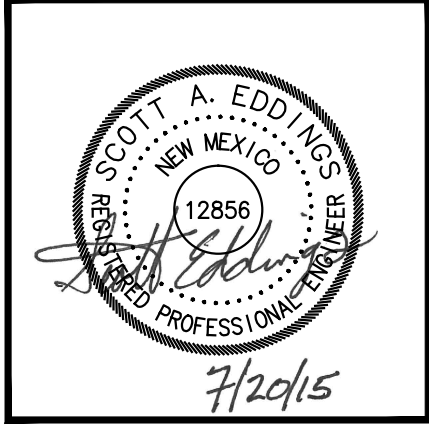


PROJECT TITLE <b>WINROCK SECTION 2 AND 4</b> WINROCK TOWN CENTER ALBUQUERQUE, NEW MEXICO		DRAWN BY: KLS	
PROJECT MANAGER SCOTT EDDINGS P.E.		JOB NO. 303689.01	
SHEET TITLE <b>DRAINAGE NARRATIVE / SUMMARY</b>			

DATE: 07/14/15	sheet- 1
SCALE: 1"=100'	C100 of- 13

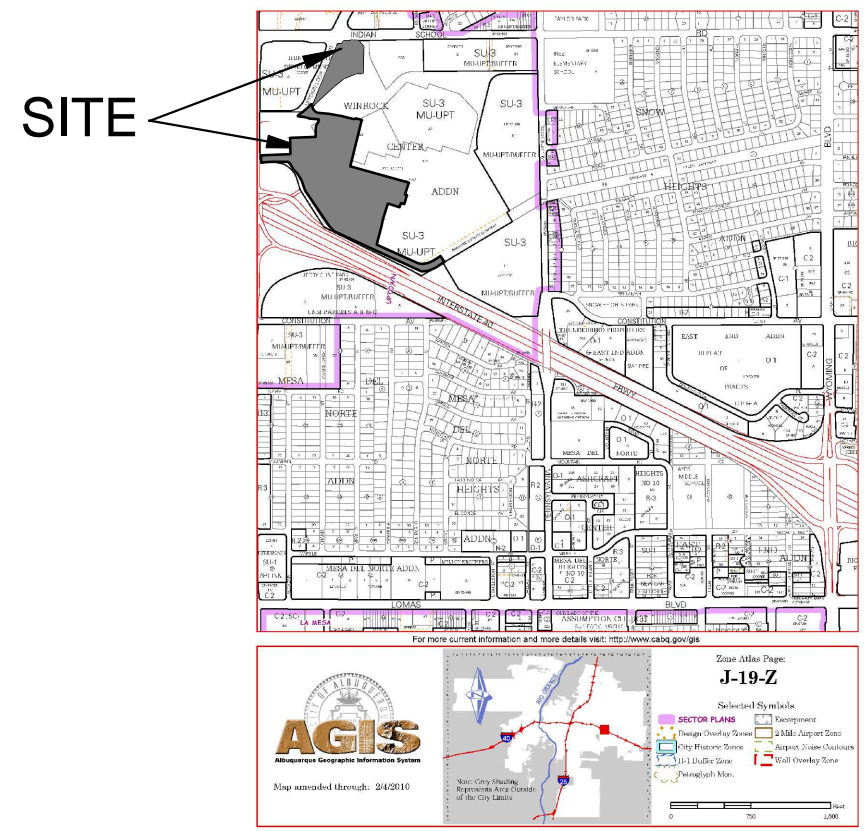

ZONE ATLAS PAGE J-19-Z

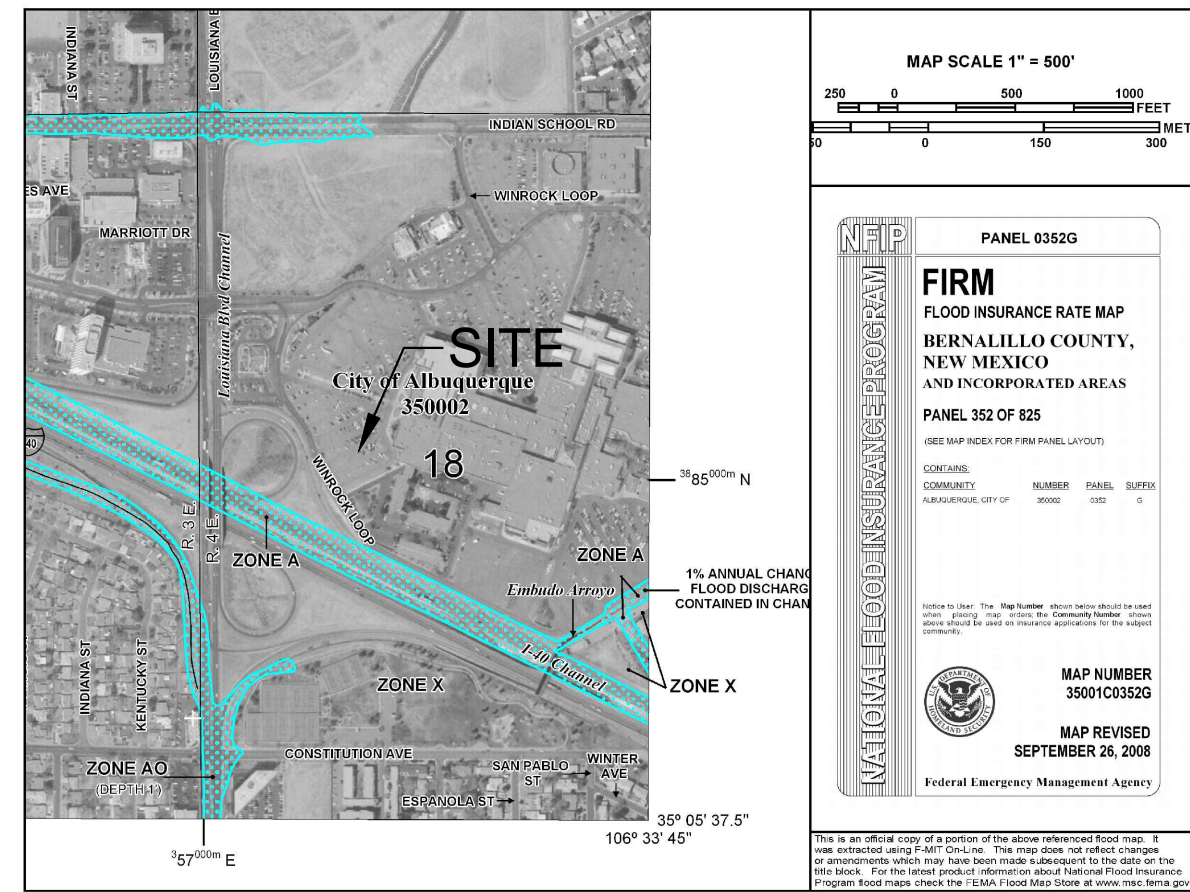

LEGEND

- OUTSIDE OF CONSTRUCTION LIMITS (NOT INCLUDED)
- BASIN BOUNDARY
- DRAINAGE MASTER PLAN BASIN BOUNDARY
- DISCHARGE LOCATION
- SECTION 2 & 4 DRAINAGE SUB BASIN
- DMP SUB BASIN

FLOOD ZONE

PER THE FEMA MAP NUMBER 35001 C0352G DATED SEPTEMBER 26, 2008 SHOWS THE SITE IS NOT LOCATED WITHIN A FLOOD HAZARD ZONE AREA.

DRAINAGE CERTIFICATION

I, SCOTT A. EDDINGS, NMPE 12856, OF THE FIRM HUITT-ZOLLARS, INC. HEREBY CERTIFY THAT THIS PROJECT HAS BEEN GRADED AND WILL DRAIN IN SUBSTANTIAL COMPLIANCE WITH AND IN ACCORDANCE WITH THE DESIGN INTENT OF THE APPROVED PLAN DATED 7/20/15. THE RECORD INFORMATION EDITED ON TO THE ORIGINAL DESIGN DOCUMENT HAS BEEN OBTAINED FROM THE SURVEY DATED 10/4/16 PROVIDED BY JOSEPH M. SOLOMON, JR., NMPS 15075 OF THE FIRM HIGH MESA CONSULTING GROUP. I FURTHER CERTIFY THAT I HAVE PERSONALLY VISITED THE PROJECT SITE ON 10/5/16 AND HAVE DETERMINED BY VISUAL INSPECTION THAT THE SURVEY DATA PROVIDED IS REPRESENTATIVE OF ACTUAL SITE CONDITIONS AND IS TRUE AND CORRECT TO THE BEST OF MY KNOWLEDGE AND BELIEF. THIS CERTIFICATION IS SUBMITTED IN SUPPORT OF A REQUEST FOR A PERMANENT CERTIFICATE OF OCCUPANCY AT WINROCK SECTION 2 AND 4 WINROCK TOWN CENTER.

THE RECORD INFORMATION PRESENTED HEREON IS NOT NECESSARILY COMPLETE AND INTENDED ONLY TO VERIFY SUBSTANTIAL COMPLIANCE OF THE GRADING AND DRAINAGE ASPECTS OF THIS PROJECT. THOSE RELYING ON THIS RECORD DOCUMENT ARE ADVISED TO OBTAIN INDEPENDENT VERIFICATION OF ITS ACCURACY BEFORE USING IT FOR ANY OTHER PURPOSE.

SCOTT A. EDDINGS, NMPE 12856


3/21/17  
DATE



**HUITT-ZOLLARS**  
Huitt-Zollars, Inc.  
333 Rio Rancho Drive NE, Suite 101  
Rio Rancho, New Mexico 87124  
Phone (505) 892-5141 Fax (505) 892-3259



REV	DATE	BY	REVISION
1			
2			
3			
4			
5			

**MODULUS ARCHITECTS**  
220 COPPER AVE. N.W. SUITE 350  
ALBUQUERQUE, NEW MEXICO 87102  
PHONE (505) 338-1499 FAX (505) 338-1498

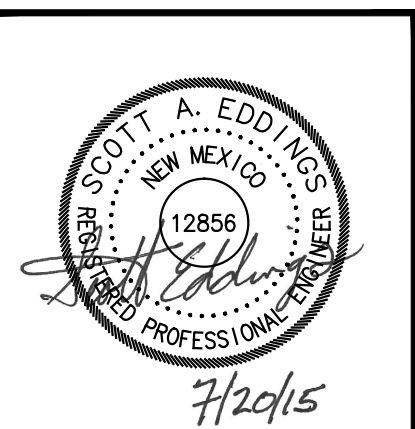


PROJECT TITLE <b>WINROCK SECTION 2 AND 4</b> WINROCK TOWN CENTER ALBUQUERQUE, NEW MEXICO	DRAWN BY: KLS
PROJECT MANAGER SCOTT EDDINGS P.E.	JOB NO. 307689.01
SHEET TITLE <b>BASIN MAP</b>	

DATE 07/20/15	SHEET 2
SCALE 1"=100'	<b>C101</b>

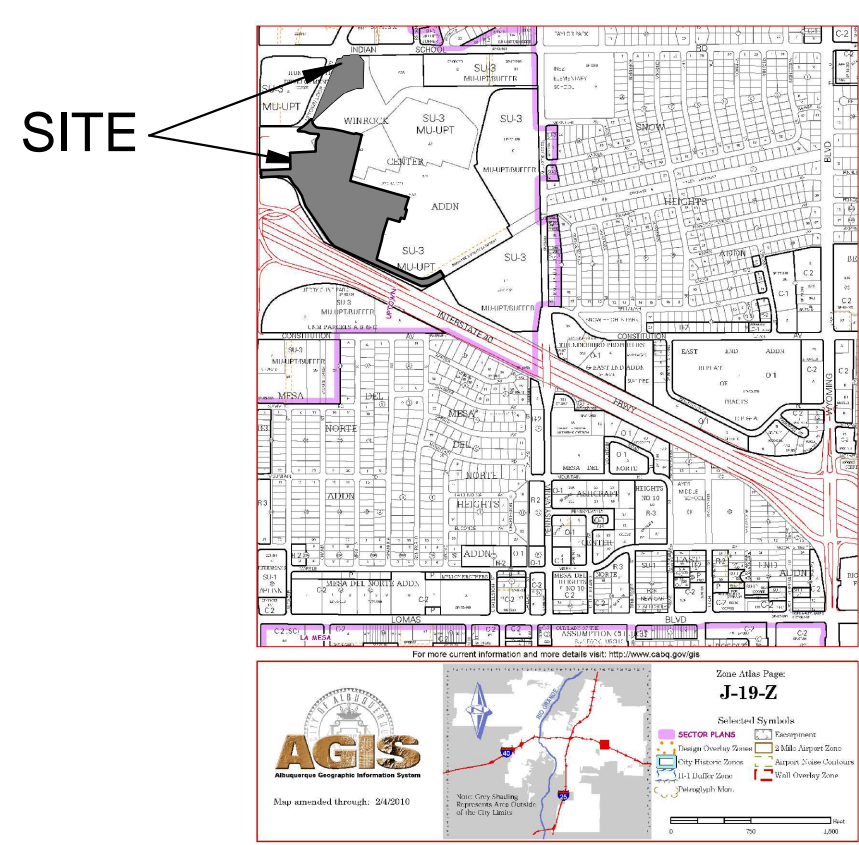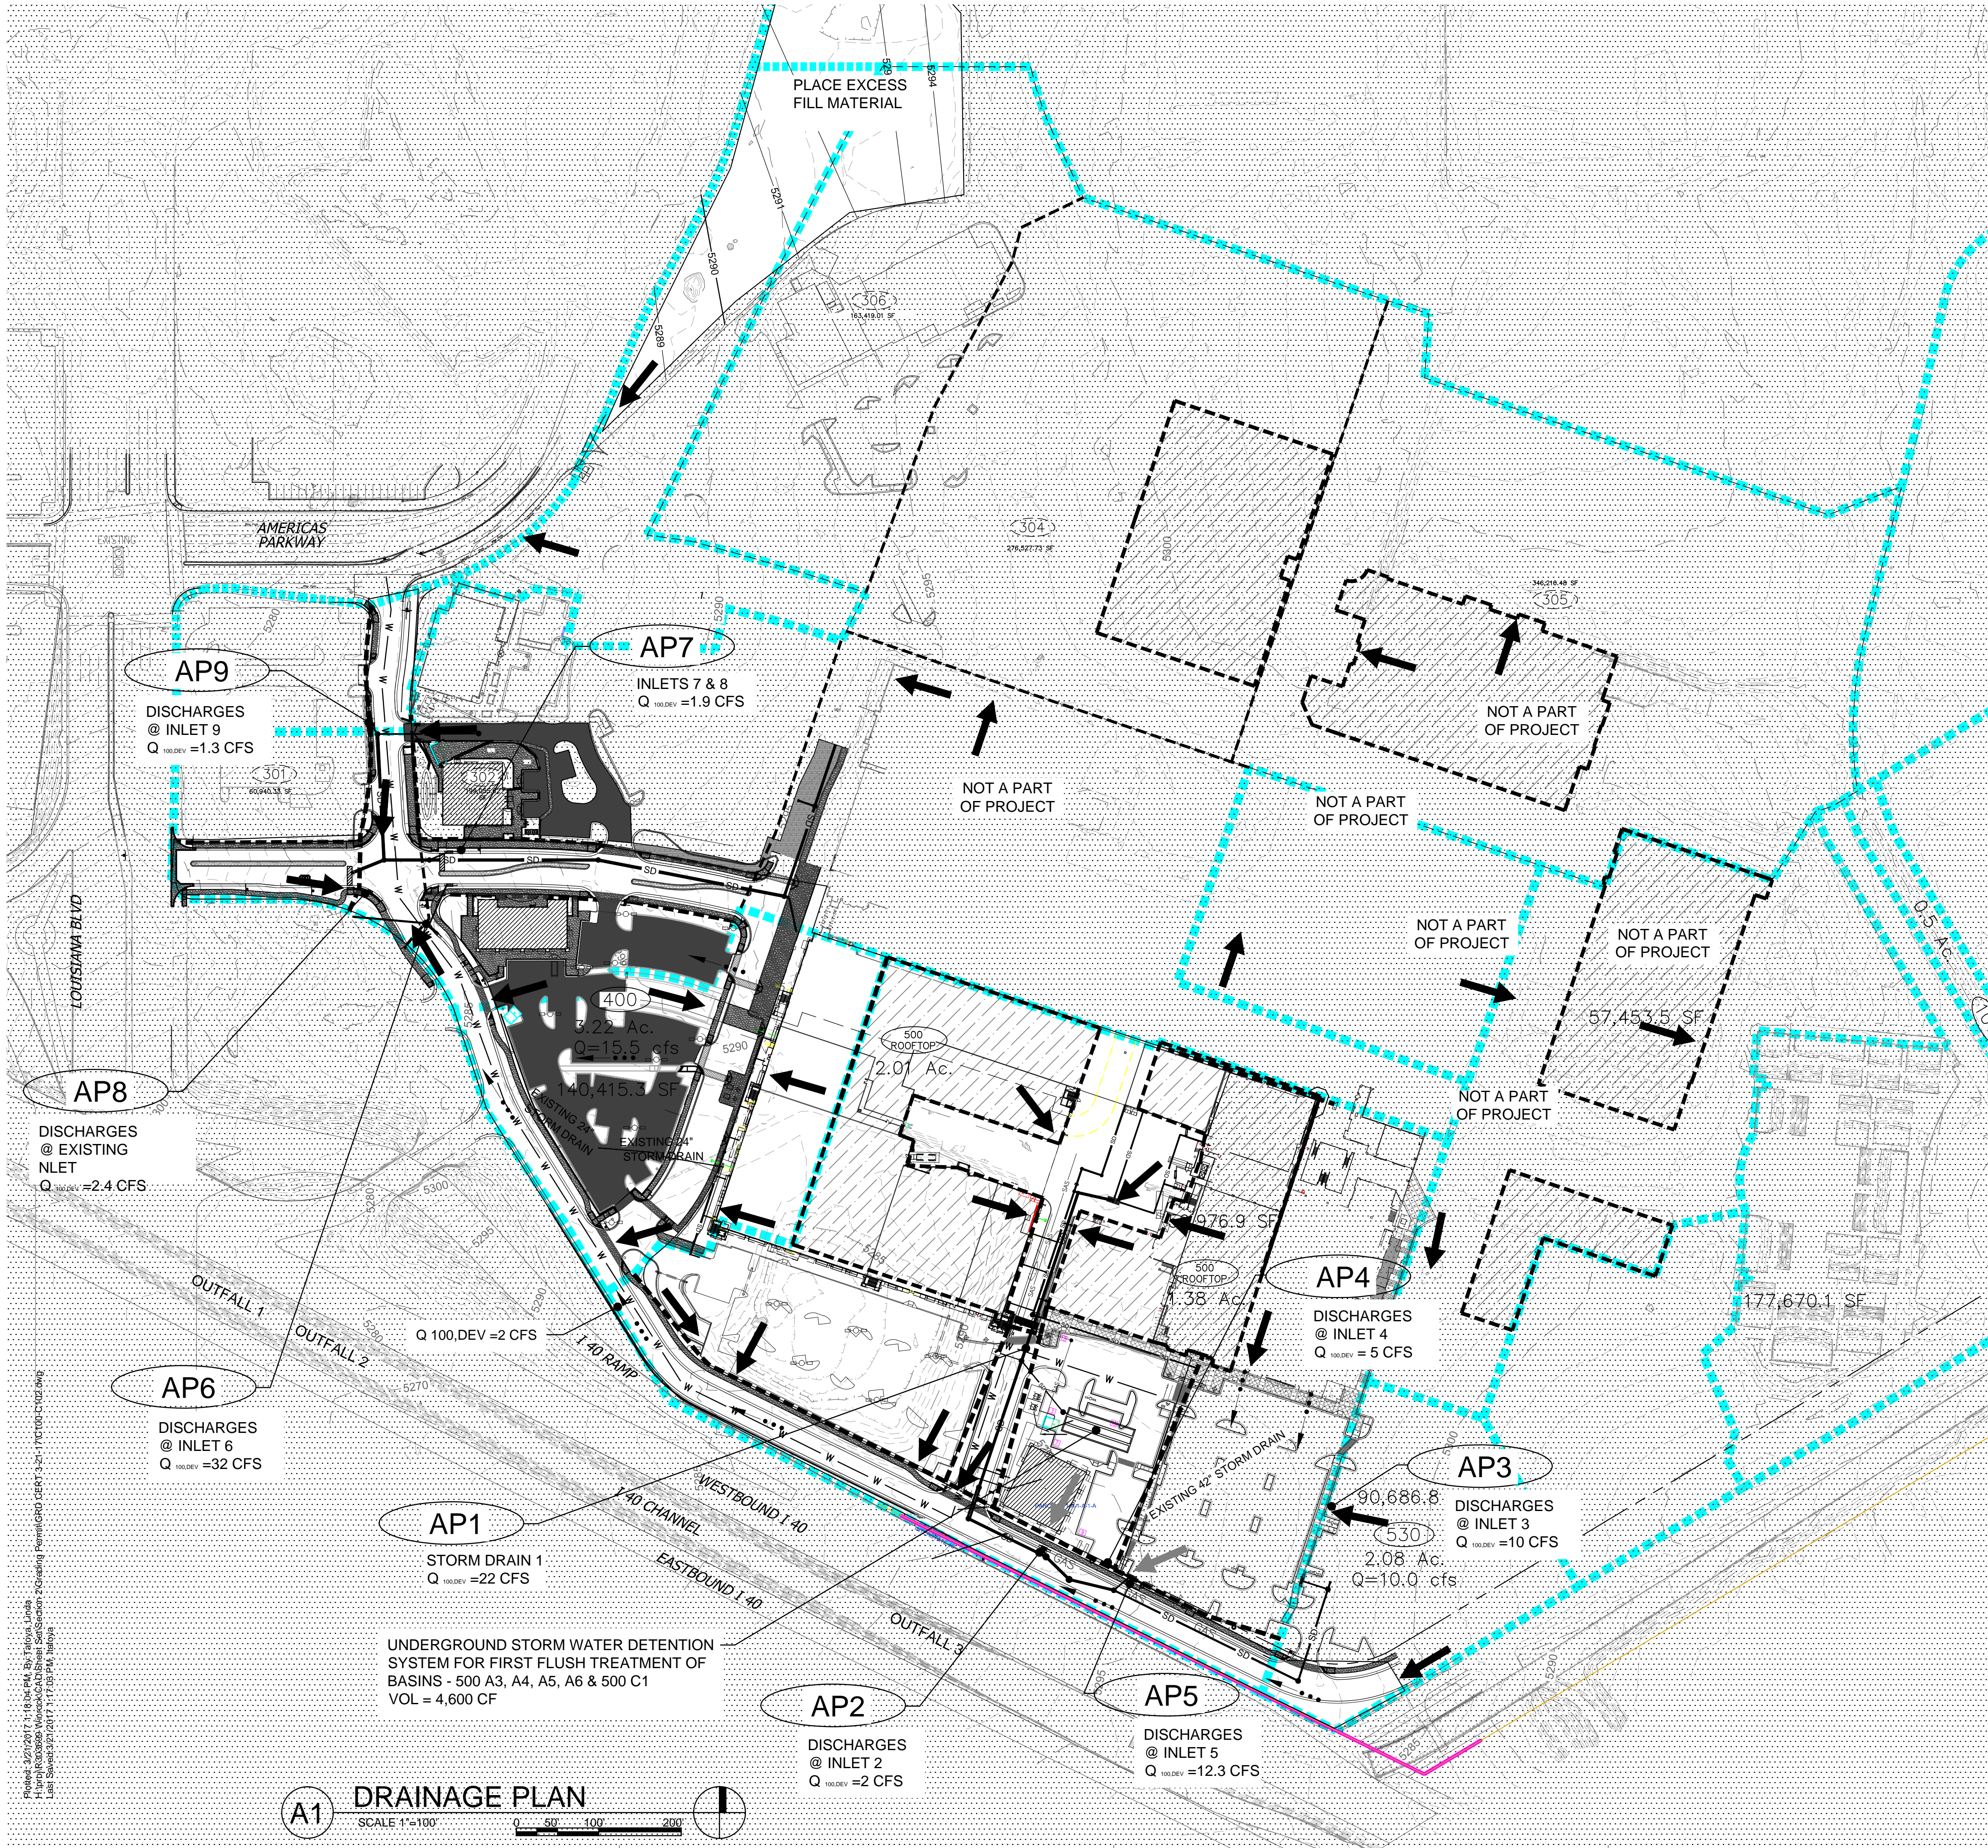

ZONE ATLAS PAGE J-19-Z

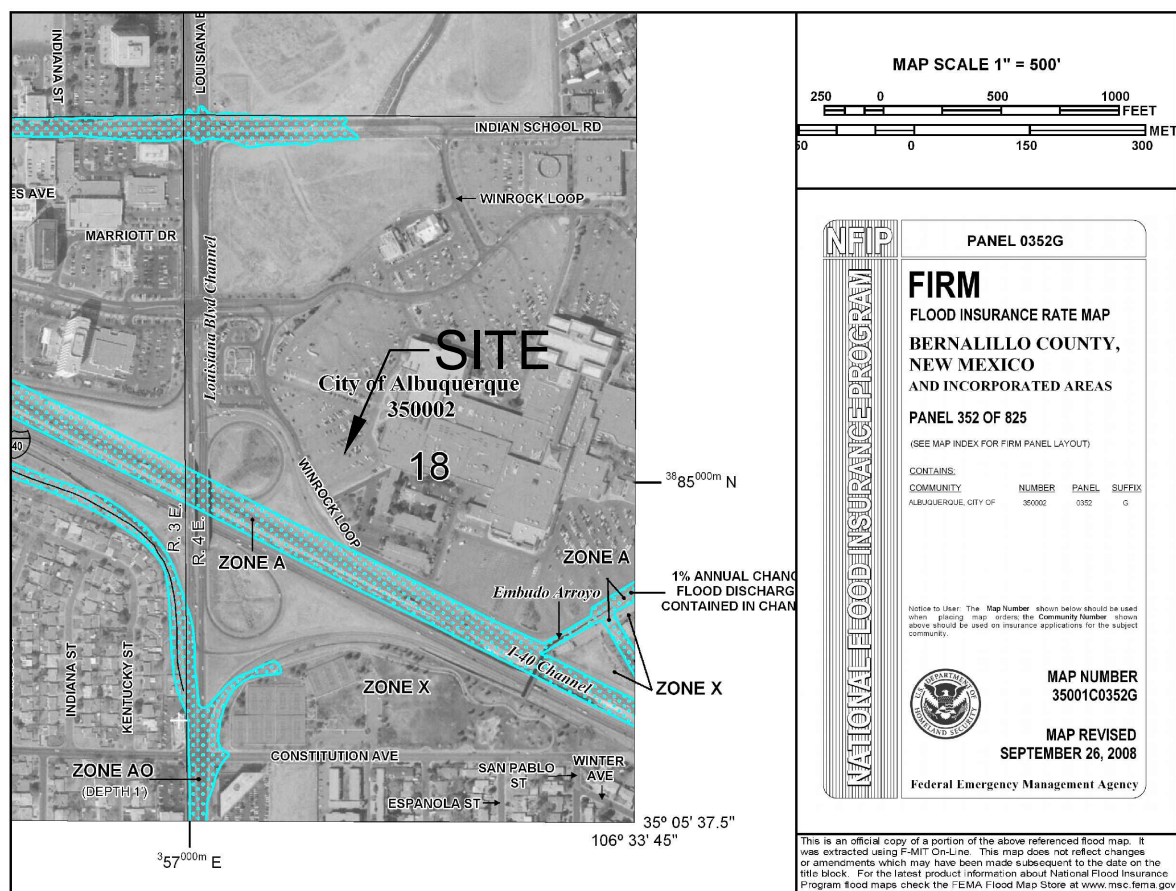

FIRM PANEL 35001C0352G

LEGEND

- CONSTRUCTION LIMITS
- BASIN BOUNDARY
- DISCHARGE LOCATION
- FLOW DIRECTION

FLOOD ZONE

PER THE FEMA MAP NUMBER 35001 C0352G DATED SEPTEMBER 26, 2008 SHOWS THE SITE IS NOT LOCATED WITHIN A FLOOD HAZARD ZONE AREA.

NOTE:

STORM DRAIN SYSTEM IS INCLUDED IN COA PROJECT NUMBER 4553.84

DRAINAGE CERTIFICATION

I, SCOTT A. EDDINGS, NMPE 12856, OF THE FIRM HUITT-ZOLLARS, INC. HEREBY CERTIFY THAT THIS PROJECT HAS BEEN GRADED AND WILL DRAIN IN SUBSTANTIAL COMPLIANCE WITH AND IN ACCORDANCE WITH THE DESIGN INTENT OF THE APPROVED PLAN DATED 7/20/15. THE RECORD INFORMATION EDITED ON TO THE ORIGINAL DESIGN DOCUMENT HAS BEEN OBTAINED FROM THE SURVEY DATED 10/4/16 PROVIDED BY JOSEPH M. SOLOMON, JR., NMPS 15075 OF THE FIRM HIGH MESA CONSULTING GROUP. I FURTHER CERTIFY THAT I HAVE PERSONALLY VISITED THE PROJECT SITE ON 10/5/16 AND HAVE DETERMINED BY VISUAL INSPECTION THAT THE SURVEY DATA PROVIDED IS REPRESENTATIVE OF ACTUAL SITE CONDITIONS AND IS TRUE AND CORRECT TO THE BEST OF MY KNOWLEDGE AND BELIEF. THIS CERTIFICATION IS SUBMITTED IN SUPPORT OF A REQUEST FOR A PERMANENT CERTIFICATE OF OCCUPANCY AT WINROCK SECTION 2 AND 4 WINROCK TOWN CENTER.

THE RECORD INFORMATION PRESENTED HEREON IS NOT NECESSARILY COMPLETE AND INTENDED ONLY TO VERIFY SUBSTANTIAL COMPLIANCE OF THE GRADING AND DRAINAGE ASPECTS OF THIS PROJECT. THOSE RELYING ON THIS RECORD DOCUMENT ARE ADVISED TO OBTAIN INDEPENDENT VERIFICATION OF ITS ACCURACY BEFORE USING IT FOR ANY OTHER PURPOSE.

Scott A. Eddings

SCOTT A. EDDINGS, NMPE 12856

3/21/17


DATE



HUITT-ZOLLARS  
Huitt-Zollars, Inc. Rio Rancho  
333 Rio Rancho Drive NE, Suite 101  
Rio Rancho, New Mexico 87124  
Phone (505) 892-5141 Fax (505) 892-3259

REV	DATE	BY	REVISION
1			
2			
3			
4			
5			

**MODULUS ARCHITECTS**  
220 COPPER AVE. N.W. SUITE 350  
ALBUQUERQUE, NEW MEXICO 87102  
PHONE (505) 338-1499 FAX (505) 338-1498

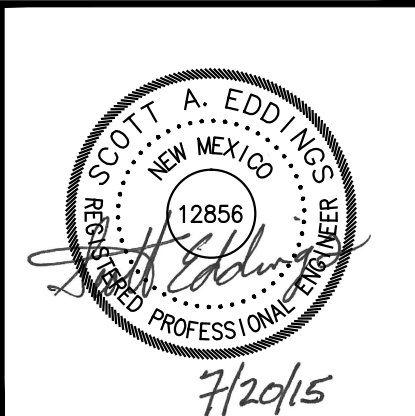

PROJECT TITLE WINROCK SECTION 2 AND 4 WINROCK TOWN CENTER ALBUQUERQUE, NEW MEXICO	DRAWN BY KLS
PROJECT MANAGER SCOTT EDDINGS P.E.	JOB NO. 303689.01
SHEET TITLE DRAINAGE PLAN	SHEET NO. C102

DATE 07/20/15	SHEET 3
SCALE 1"=100'	of 13

Plotted: 3/21/2017 1:37:51 PM, By: Talaya, Linda  
H:\proj\R303699 Winrock\CAD\Sheet Set\Section 2\Grading Permit\GRD CERT 3-21-17\C103-C105.dwg  
Last Saved: 3/21/2017 1:35:58 PM, Italoaya




I, SCOTT A. EDDINGS, NMPE 12856, OF THE FIRM HUITT-ZOLLARS, INC. HEREBY CERTIFY THAT THIS PROJECT HAS BEEN GRADED AND WILL DRAIN IN SUBSTANTIAL COMPLIANCE WITH AND IN ACCORDANCE WITH THE DESIGN INTENT ON THE APPROVED PLAN DATED 7/20/15. THE RECORD INFORMATION EDITED ON TO THE ORIGINAL DESIGN DOCUMENT HAS BEEN OBTAINED FROM THE SURVEY DATED 10/4/16 PROVIDED BY JOSEPH M. SOLOMON, JR, NMPS 15075 OF THE FIRM HIGH MESA CONSULTING GROUP. I FURTHER CERTIFY THAT I HAVE PERSONALLY CONDUCTED THE SURVEY ON 10/5/16 AND HAVE DETERMINED BY VISUAL INSPECTION THAT THE SURVEY DATA PROVIDED IS REPRESENTATIVE OF ACTUAL SITE CONDITIONS AND IS TRUE AND CORRECT TO THE BEST OF MY KNOWLEDGE AND BELIEF. THIS CERTIFICATION IS SUBMITTED IN SUPPORT OF A REQUEST FOR A PERMANENT CERTIFICATE OF OCCUPANCY AT WINROCK SECTION 2 AND 4 WINROCK TOWN CENTER.

THE RECORD INFORMATION PRESENTED HEREON IS NOT NECESSARILY COMPLETE AND INTENDED ONLY TO VERIFY SUBSTANTIAL COMPLIANCE OF THE GRADING AND DRAINAGE ASPECTS OF THIS PROJECT. THOSE RELYING ON THIS RECORD DOCUMENT ARE ADVISED TO OBTAIN INDEPENDENT VERIFICATION OF IT'S ACCURACY BEFORE USING IT FOR ANY OTHER PURPOSE.

Scott Eddings

3/21/17  
DATE

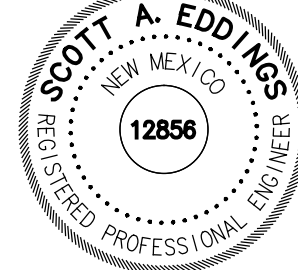

**HUITT-ZOLLARS**  
Huitt-Zollars, Inc. Rio Rancho  
333 Rio Rancho Drive NE, Suite 101  
Rio Rancho, New Mexico 87124  
Phone (505) 892-5141 Fax (505) 892-3259


BUILDING PERMIT

DATE: 07/20/15	sheet- 4
SCALE: 1"=100'	<b>C103</b> of- 13



# MODULUS ARCHITECTS

220 COPPER AVE. N.W. SUITE 350  
ALBUQUERQUE, NEW MEXICO 87102  
PHONE (505) 338-1499 FAX (505) 338-1498

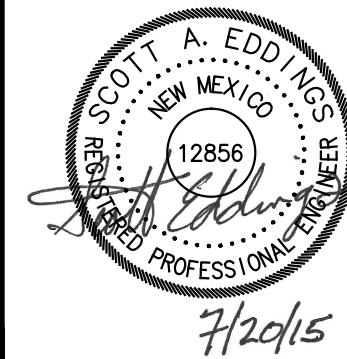

## D

**C**

**B**

A


INLET 1

**Worksheet (Sump Condition) for Inlet 1**

**Objective:** Design a Type C Inlet in Sump Condition for a 100-year flow of 23 cfs

1 Inlet to collect peak flow amount before overflowing headwall.

2 Grate Dimensions

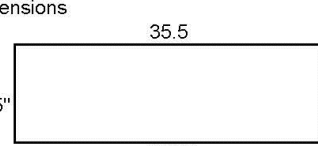

35.5"

18.5"

\*\*Net dimensions of open area of a single grate.  
(Total Area less Area of Bars)

Weir Perimeter = 14.9 ft  
Area of Orifice = 9.1 sf


3 Calculate Orifice and Weir Flow into Grate at Design Depth (0.9 ft)

Orifice Equation	Weir Equation
$Q = 0.6 \times A \times (2 g \times h)^{1/2}$ Where $A = 9.1 \text{ sq. ft.}$ $g = 32.2 \text{ ft}^2/\text{sec}$ $h = 0.9 \text{ ft.}$	$Q = 2.65 \times P \times H^{3/2}$ Where $P = 14.9 \text{ ft.}$ $H = 0.9 \text{ ft.}$
Therefore $Q = 417 \text{ cfs.}$	Therefore $Q = 37.5 \text{ cfs.}$
Orifice Equation controls Grate Capacity =	38 cfs

4 Apply 25% Clogging Factor to determine allowable design flow into inlet

38 x
0.75
**28 cfs**

Therefore Capacity of Double C Inlet in Sump Condition = 28 cfs

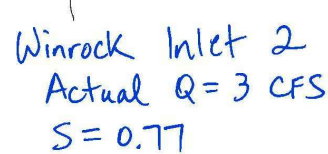

May 2001

22-144

I, SCOTT A. EDDINGS, NMPE 12856, OF THE FIRM HUITZ-ZOLLARS, INC. HEREBY CERTIFY THAT THIS PROJECT HAS BEEN GRADED AND WILL DRAIN IN SUBSTANTIAL COMPLIANCE WITH AND IN ACCORDANCE WITH THE DESIGN INTENT OF THE APPROVED PLAN DATED 7/20/15. THE RECORD INFORMATION EDITED ON TO THE ORIGINAL DESIGN DOCUMENT HAS BEEN OBTAINED FROM THE SURVEY DATED 10/4/16 PROVIDED BY JOSEPH M. SOLOMON, JR., NMPS 15075 OF THE FIRM HIGH MESA CONSULTING GROUP. I FURTHER CERTIFY THAT I HAVE PERSONALLY VISITED THE PROJECT SITE ON 10/5/16 AND HAVE DETERMINED BY VISUAL INSPECTION THAT THE SURVEY DATA PROVIDED IS REPRESENTATIVE OF ACTUAL SITE CONDITIONS AND IS TRUE AND CORRECT TO THE BEST OF MY KNOWLEDGE AND BELIEF. THIS CERTIFICATION IS SUBMITTED IN SUPPORT OF A REQUEST FOR A PERMANENT CERTIFICATE OF OCCUPANCY AT WINROCK SECTION 2 AND 4 WINROCK TOWN CENTER.

THE RECORD INFORMATION PRESENTED HEREON IS NOT NECESSARILY COMPLETE AND INTENDED ONLY TO VERIFY SUBSTANTIAL COMPLIANCE OF THE GRADING AND DRAINAGE ASPECTS OF THIS PROJECT. THOSE RELYING ON THIS RECORD DOCUMENT ARE ADVISED TO OBTAIN INDEPENDENT VERIFICATION OF IT'S ACCURACY BEFORE USING IT FOR ANY OTHER PURPOSE.

3/21/17  
DATE




BUILDING PERMIT

DATE: 07/20/15	sheet- 5
SCALE: 1"=100'	C104 of- 13


# MODULUS ARCHITECTS

220 CUPPER AVE. N.W. SUITE 350  
ALBUQUERQUE, NEW MEXICO 87102  
PHONE (505) 338-1499 FAX (505) 338-1498

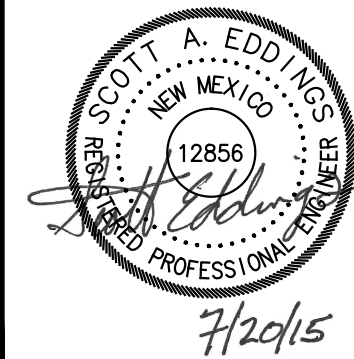


REV	DATE	BY	REVISION
△6			
△5			
△4			
△3			
△2			
△1			


INLET 3

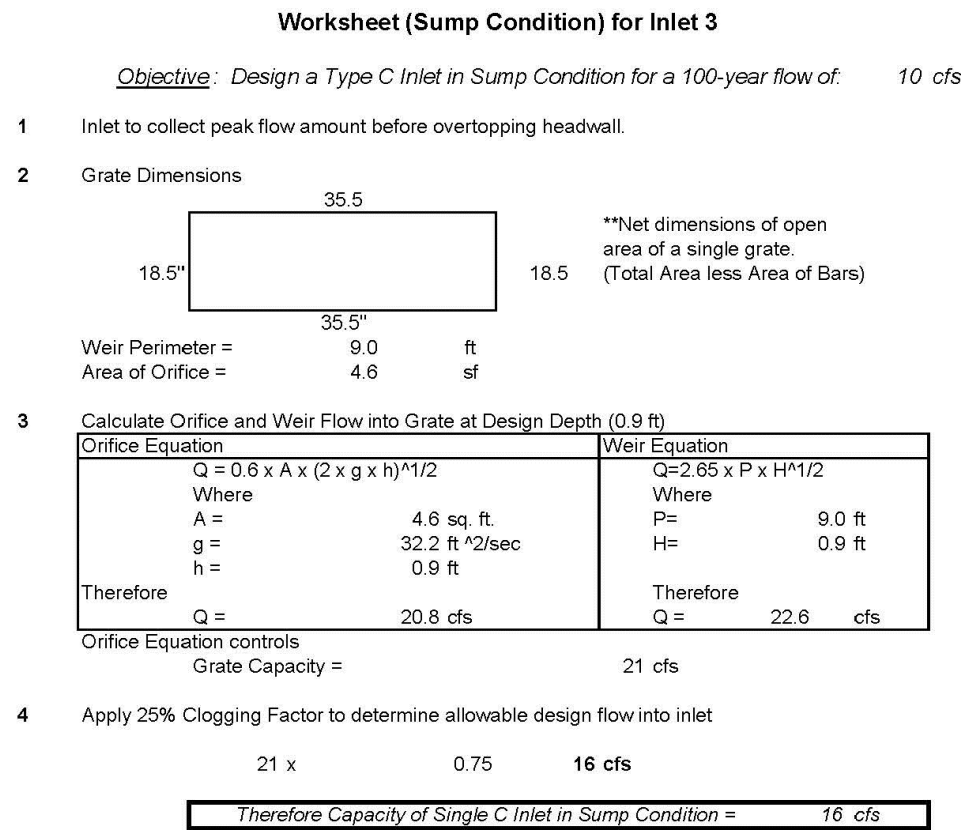


INLET 5

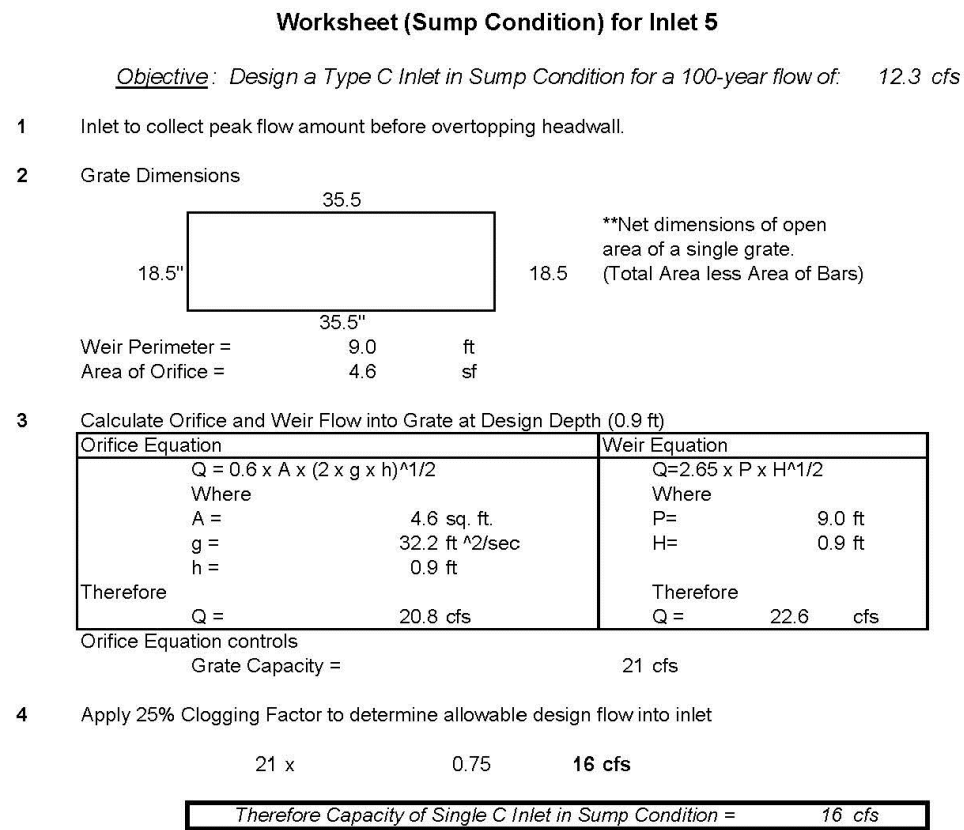


INLET 7

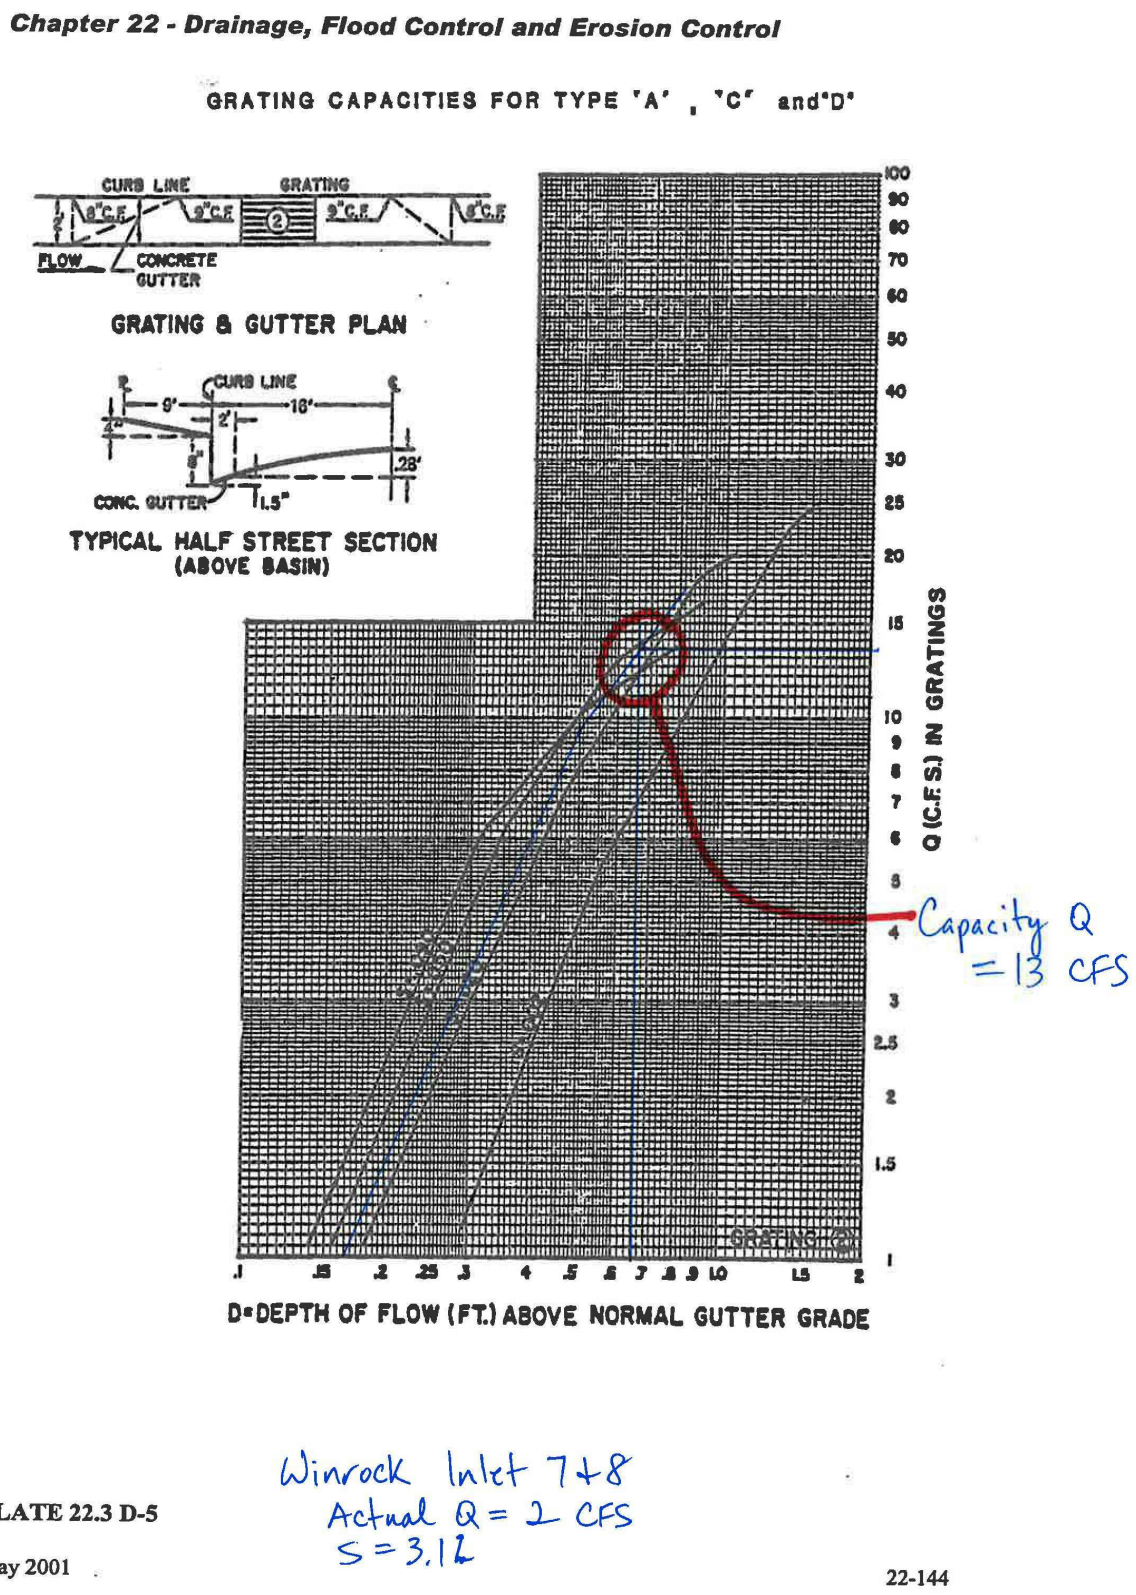


INLET 4

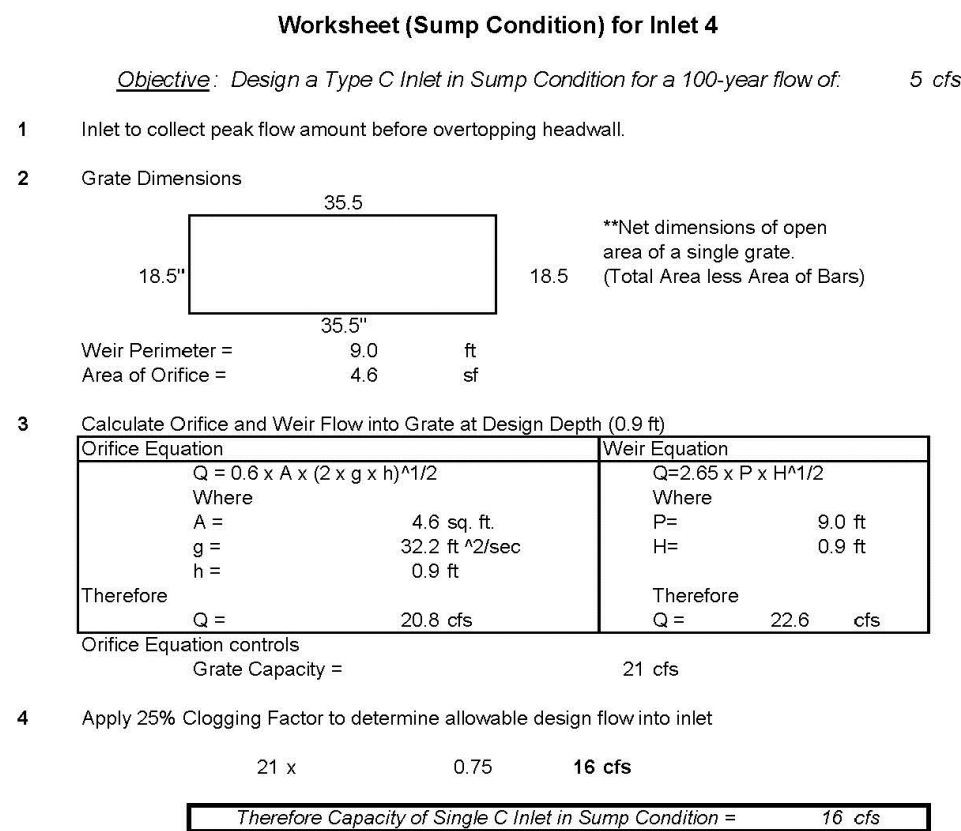

INLET 6

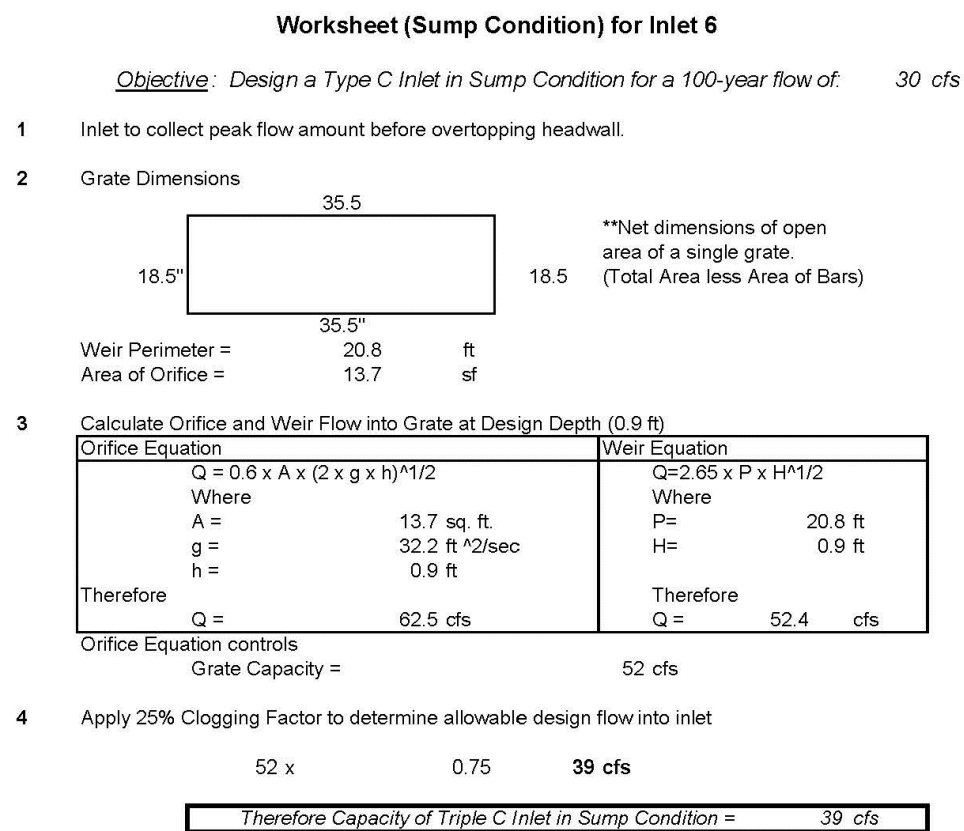

INLET 8

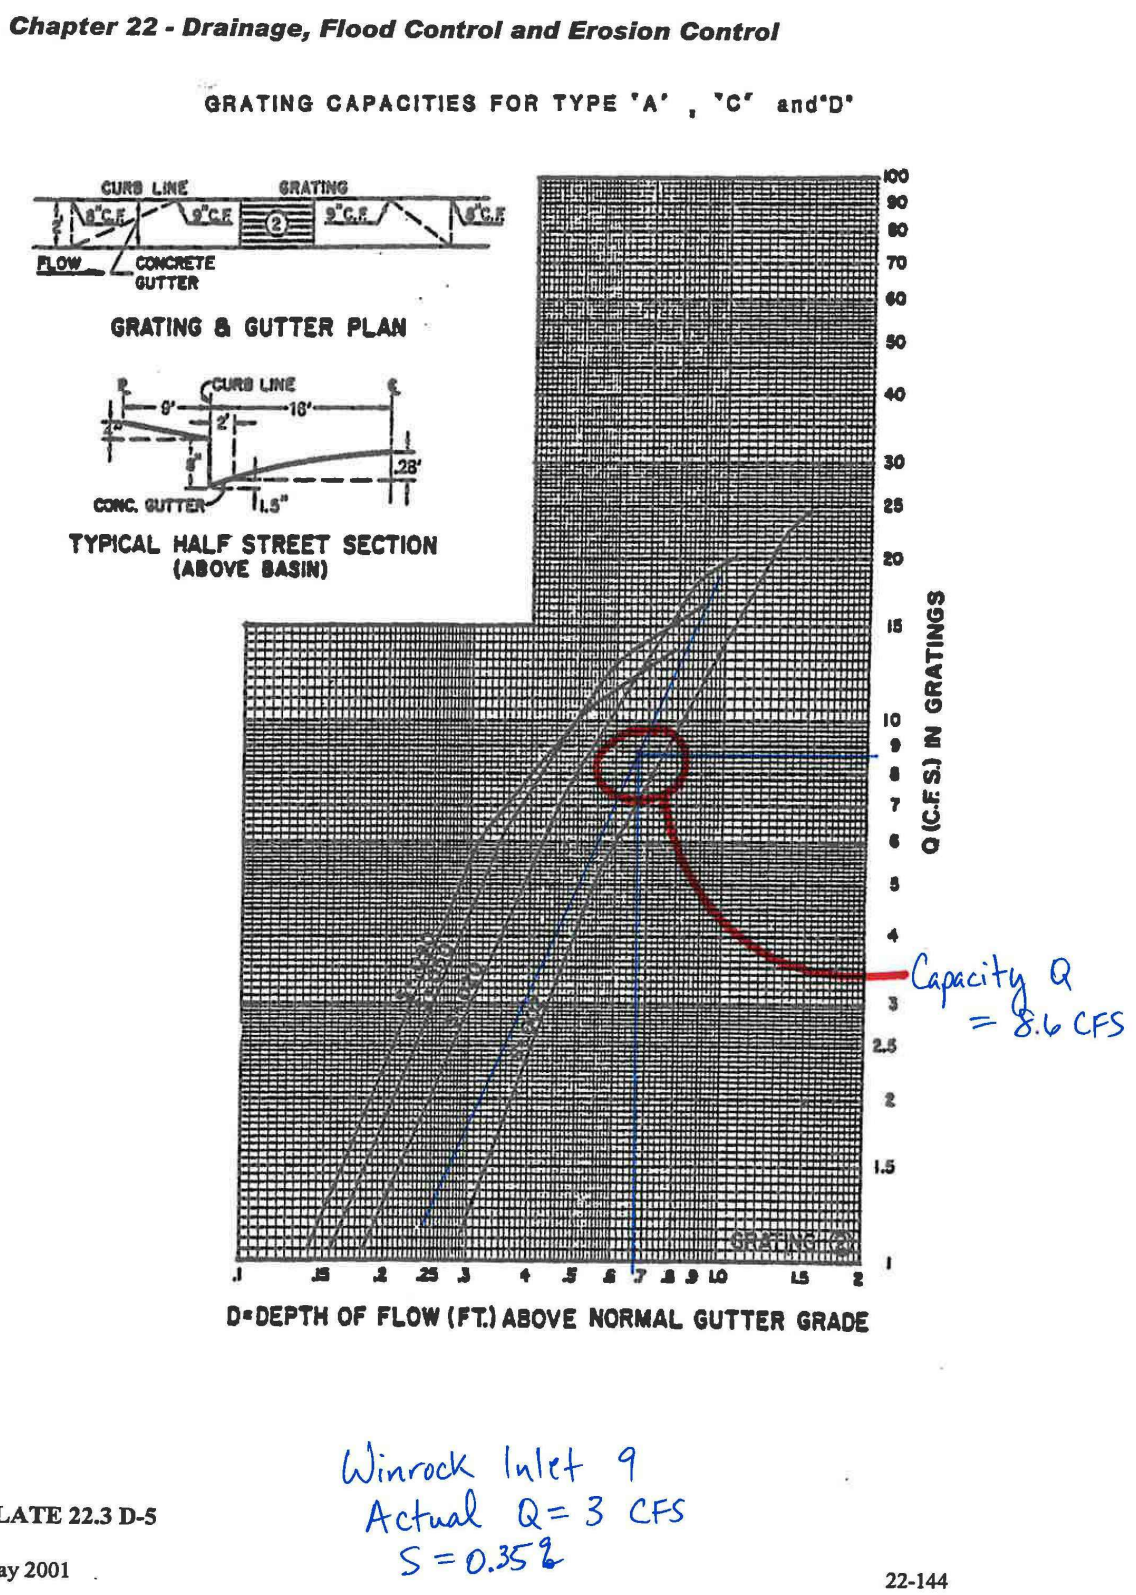

DRAINAGE CERTIFICATION

I, SCOTT A. EDDINGS, NMPE 12856, OF THE FIRM HUITT-ZOLLARS, INC. HEREBY CERTIFY THAT THIS PROJECT HAS BEEN GRADED AND WILL DRAIN IN SUBSTANTIAL COMPLIANCE WITH AND IN ACCORDANCE WITH THE DESIGN INTENT OF THE APPROVED PLAN DATED 7/20/15. THE RECORD INFORMATION EDITED ON TO THE ORIGINAL DESIGN DOCUMENT HAS BEEN OBTAINED FROM THE SURVEY DATED 10/4/16 PROVIDED BY JOSEPH M. SOLOMON, JR., NMPS 15075 OF THE FIRM HIGH MESA CONSULTING GROUP. I FURTHER CERTIFY THAT I HAVE PERSONALLY VISITED THE PROJECT SITE ON 10/5/16 AND HAVE DETERMINED BY VISUAL INSPECTION THAT THE SURVEY DATA PROVIDED IS REPRESENTATIVE OF ACTUAL SITE CONDITIONS AND IS TRUE AND CORRECT TO THE BEST OF MY KNOWLEDGE AND BELIEF. THIS CERTIFICATION IS SUBMITTED IN SUPPORT OF A REQUEST FOR A PERMANENT CERTIFICATE OF OCCUPANCY AT WINROCK SECTION 2 AND 4 WINROCK TOWN CENTER.

THE RECORD INFORMATION PRESENTED HEREON IS NOT NECESSARILY COMPLETE AND INTENDED ONLY TO VERIFY SUBSTANTIAL COMPLIANCE OF THE GRADING AND DRAINAGE ASPECTS OF THIS PROJECT. THOSE RELYING ON THIS RECORD DOCUMENT ARE ADVISED TO OBTAIN INDEPENDENT VERIFICATION OF ITS ACCURACY BEFORE USING IT FOR ANY OTHER PURPOSE.


Scott A. Eddings  
SCOTT A. EDDINGS, NMPE 12856

3/21/17  
DATE



HUITT-ZOLLARS  
Huitt-Zollars, Inc.  
333 Rio Rancho Drive NE, Suite 101  
Rio Rancho, New Mexico 87124  
Phone (505) 892-5141 Fax (505) 892-3259

MODULUS ARCHITECTS  
220 COPPER AVE. N.W. SUITE 350  
ALBUQUERQUE, NEW MEXICO 87102  
PHONE (505) 338-1499 FAX (505) 338-1498

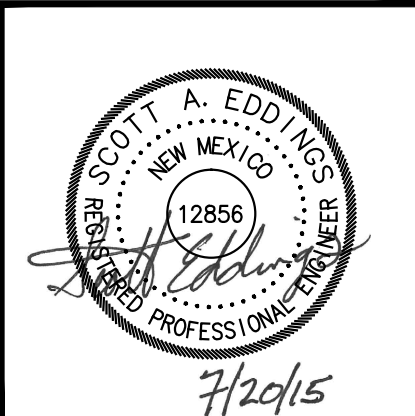


BUILDING PERMIT  
PROJECT TITLE  
WINROCK SECTION 2 AND 4  
WINROCK TOWN CENTER  
ALBUQUERQUE, NEW MEXICO  
PROJECT MANAGER  
SCOTT EDDINGS P.E.  
JOB NO.  
303669.01  
DRAWN BY  
KLS  
SHEET TITLE  
HYDROLICS - INLET CAPACITY

DATE  
07/20/15  
SCALE  
1"=100'  
SHEET  
6  
C105  
of 13



Project: 6/23/2017 6:02:15 AM, By: Eddings, Scott  
H:\Projects\2017\60215 AM, By: Eddings, Scott  
Last Saved: 6/23/2017 6:18:24 AM, Eddings, Scott

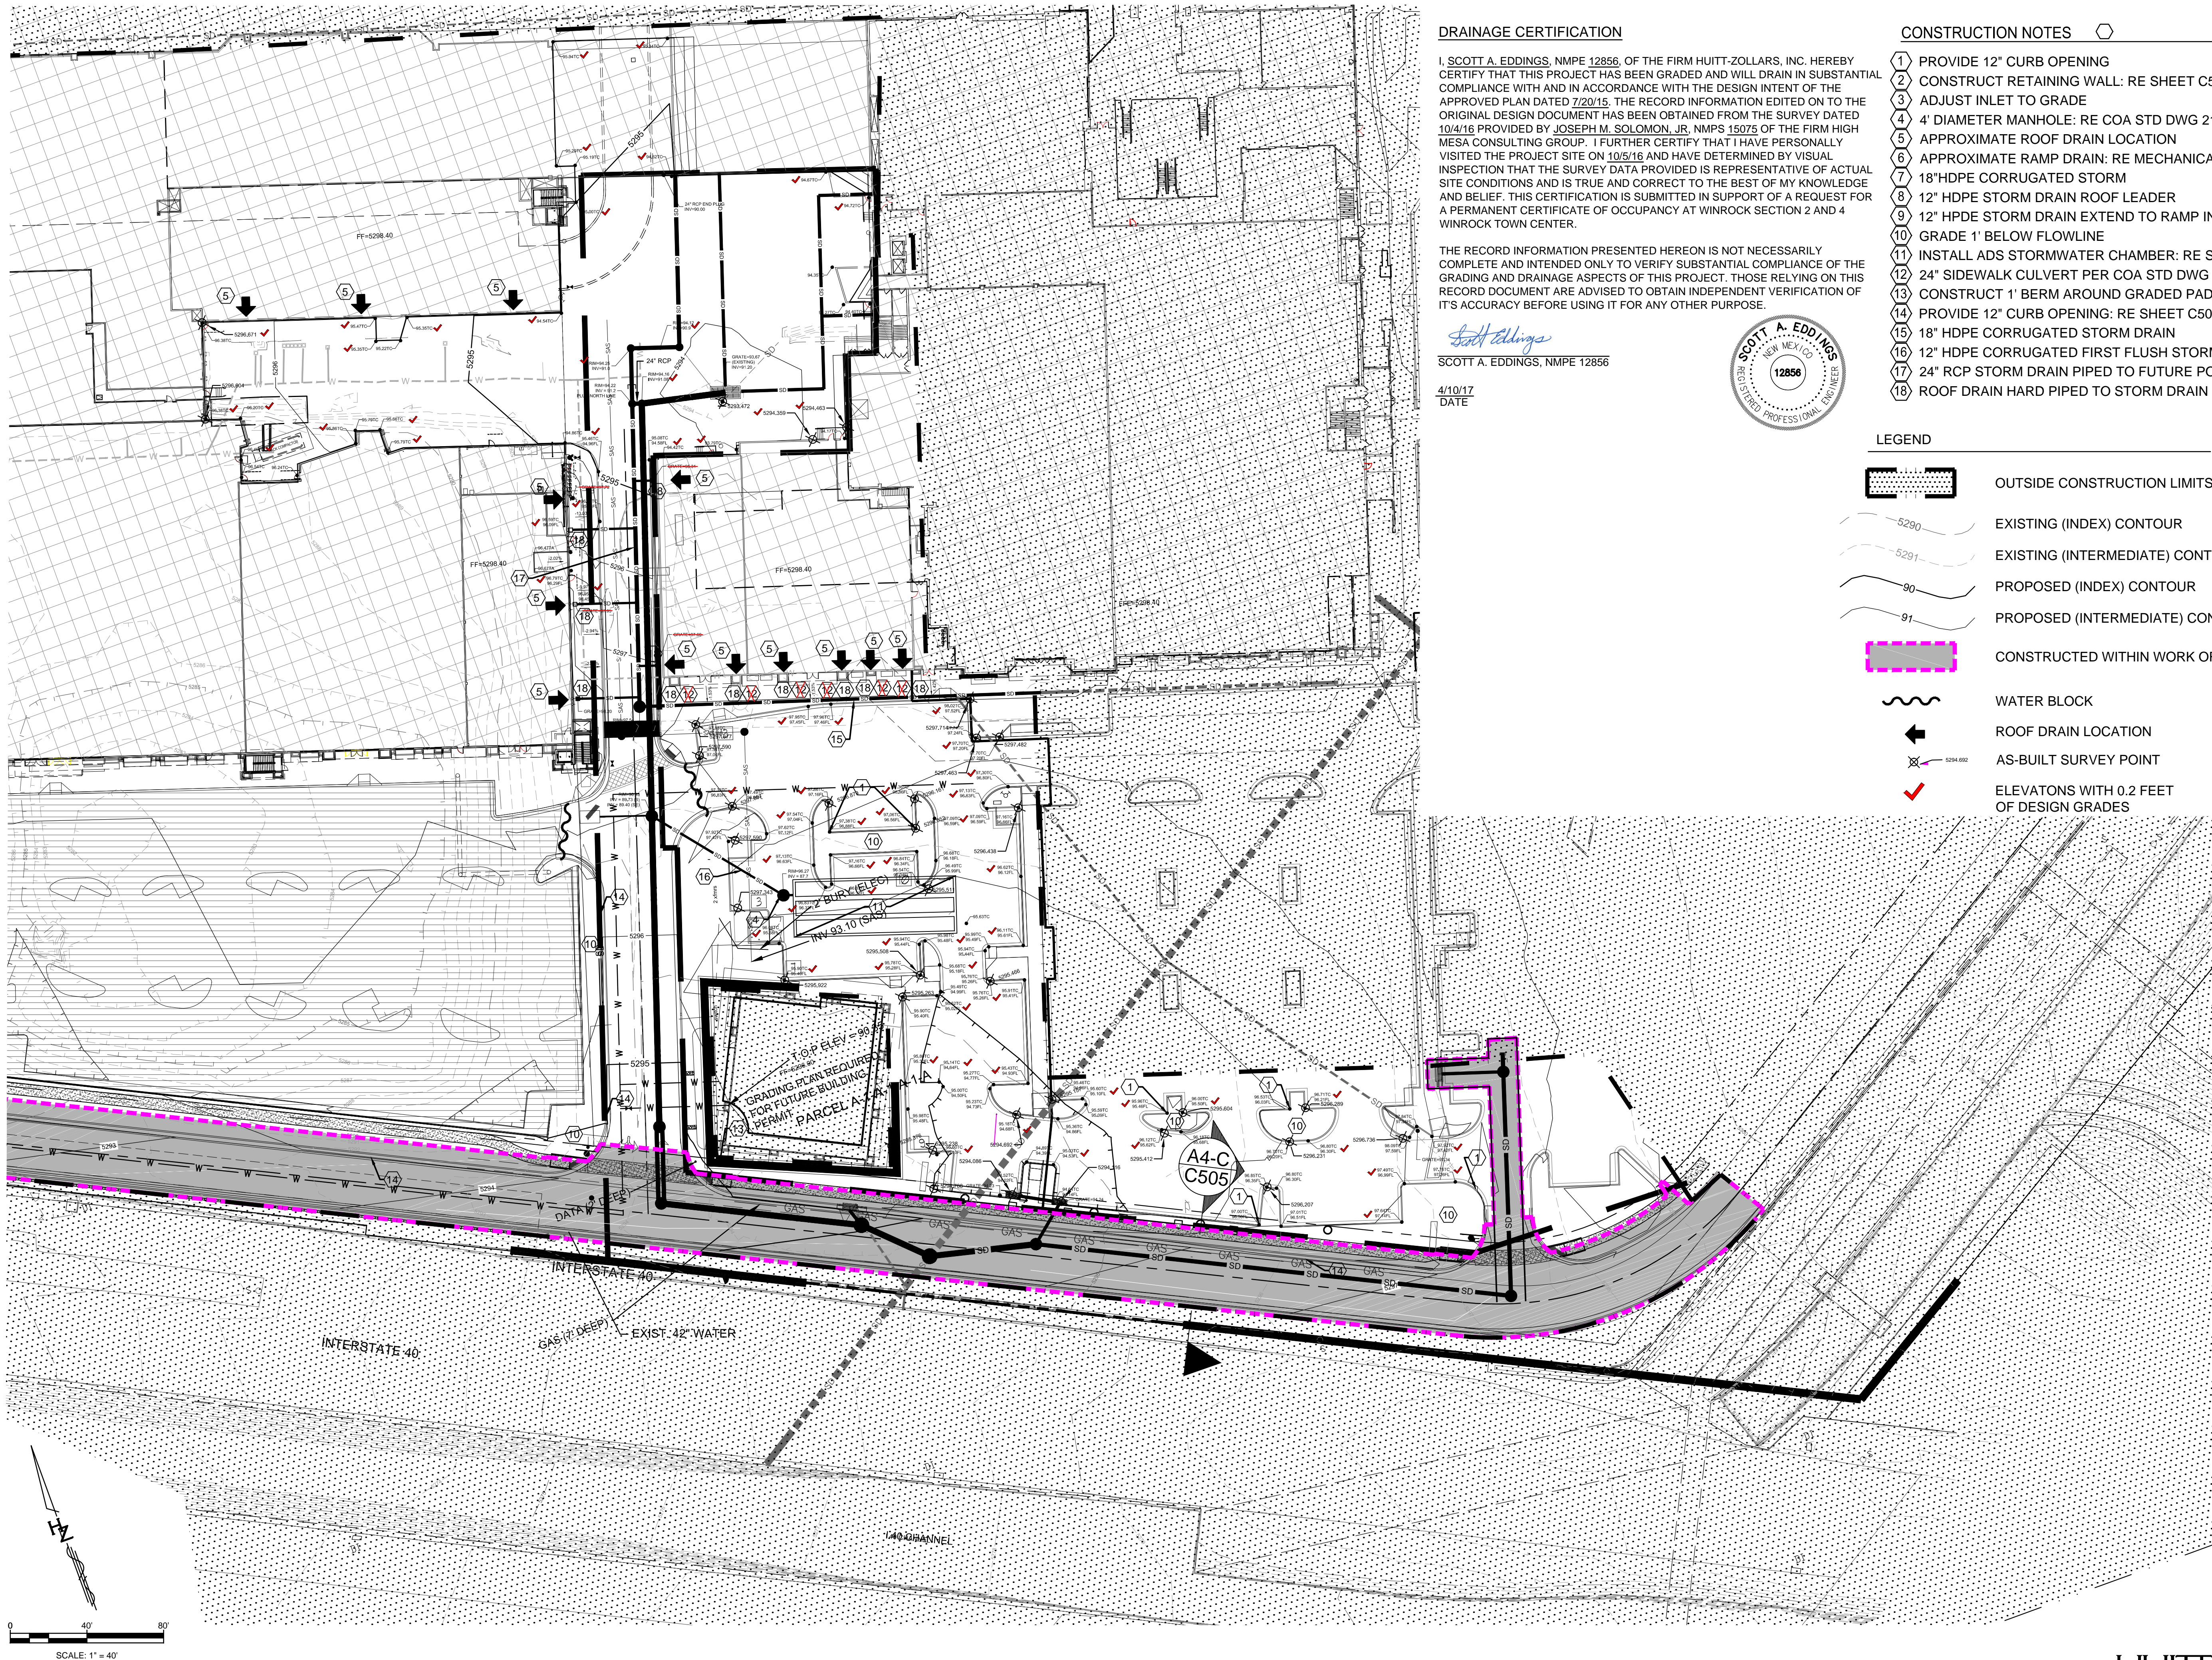

DRAINAGE CERTIFICATION

I, SCOTT A. EDDINGS, NMPE 12856, OF THE FIRM HUITT-ZOLLARS, INC. HEREBY CERTIFY THAT THIS PROJECT HAS BEEN GRADED AND WILL DRAIN IN SUBSTANTIAL COMPLIANCE WITH AND IN ACCORDANCE WITH THE DESIGN INTENT OF THE APPROVED PLAN DATED 7/20/15. THE RECORD INFORMATION EDITED ON TO THE ORIGINAL DESIGN DOCUMENT HAS BEEN OBTAINED FROM THE SURVEY DATED 10/4/16 PROVIDED BY JOSEPH M. SOLOMON, JR., NMPS 15075 OF THE FIRM HIGH MESA CONSULTING GROUP. I FURTHER CERTIFY THAT I HAVE PERSONALLY VISITED THE PROJECT SITE ON 10/5/16 AND HAVE DETERMINED BY VISUAL INSPECTION THAT THE SURVEY DATA PROVIDED IS REPRESENTATIVE OF ACTUAL SITE CONDITIONS AND IS TRUE AND CORRECT TO THE BEST OF MY KNOWLEDGE AND BELIEF. THIS CERTIFICATION IS SUBMITTED IN SUPPORT OF A REQUEST FOR A PERMANENT CERTIFICATE OF OCCUPANCY AT WINROCK SECTION 2 AND 4 WINROCK TOWN CENTER.

THE RECORD INFORMATION PRESENTED HEREON IS NOT NECESSARILY COMPLETE AND INTENDED ONLY TO VERIFY SUBSTANTIAL COMPLIANCE OF THE GRADING AND DRAINAGE ASPECTS OF THIS PROJECT. THOSE RELYING ON THIS RECORD DOCUMENT ARE ADVISED TO OBTAIN INDEPENDENT VERIFICATION OF ITS ACCURACY BEFORE USING IT FOR ANY OTHER PURPOSE.

*Scott A. Eddings*

SCOTT A. EDDINGS, NMPE 12856

4/10/17  
DATE



CONSTRUCTION NOTES

- 1 PROVIDE 12" CURB OPENING
- 2 CONSTRUCT RETAINING WALL: RE SHEET C504
- 3 ADJUST INLET TO GRADE
- 4 4' DIAMETER MANHOLE: RE COA STD DWG 2102
- 5 APPROXIMATE ROOF DRAIN LOCATION
- 6 APPROXIMATE RAMP DRAIN: RE MECHANICAL PLANS
- 7 18"HDPE CORRUGATED STORM
- 8 12" HDPE STORM DRAIN ROOF LEADER
- 9 12" HDPE STORM DRAIN EXTEND TO RAMP INLET
- 10 GRADE 1' BELOW FLOWLINE
- 11 INSTALL ADS STORMWATER CHAMBER: RE SHEETS C501-C504
- 12 24" SIDEWALK CULVERT PER COA STD DWG 2236
- 13 CONSTRUCT 1' BERM AROUND GRADED PAD
- 14 PROVIDE 12" CURB OPENING: RE SHEET C505
- 15 18" HDPE CORRUGATED STORM DRAIN
- 16 12" HDPE CORRUGATED FIRST FLUSH STORM DRAIN
- 17 24" RCP STORM DRAIN PIPED TO FUTURE POND
- 18 ROOF DRAIN HARD PIPED TO STORM DRAIN

LEGEND

- OUTSIDE CONSTRUCTION LIMITS
- EXISTING (INDEX) CONTOUR
- EXISTING (INTERMEDIATE) CONTOUR
- PROPOSED (INDEX) CONTOUR
- PROPOSED (INTERMEDIATE) CONTOUR
- CONSTRUCTED WITHIN WORK ORDER 4553.84
- WATER BLOCK
- ROOF DRAIN LOCATION
- AS-BUILT SURVEY POINT
- ELEVATIONS WITH 0.2 FEET OF DESIGN GRADES


BUILDING PERMIT

PROJECT TITLE		WINROCK SECTION 2 AND 4			
		WINROCK TOWN CENTER			
		ALBUQUERQUE, NEW MEXICO			
PROJECT MANAGER	JOB NO.	DRAWN BY:	KLS		
SCOTT EDDINGS P.E.		R303699.01			
SHEET TITLE					
GRADING PLAN					

DATE:	7/20/15	SHEET:	8
SCALE:	1"=40'	C202	
		of	13



**MODULUS ARCHITECTS**  
220 COPPER AVE. N.W. SUITE 350  
ALBUQUERQUE, NEW MEXICO 87102  
PHONE (505) 338-1499 FAX (505) 338-1498

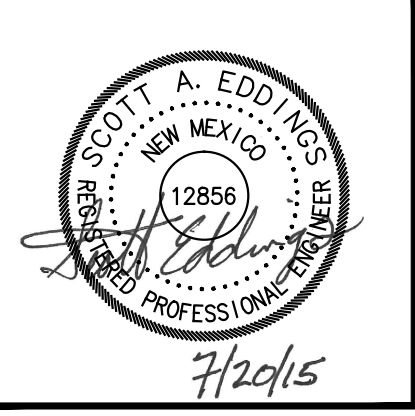


**HUITT-ZOLLARS**  
Huitt-Zollars, Inc. Rio Rancho  
333 Rio Rancho Drive NE, Suite 101  
Rio Rancho, New Mexico 87124  
Phone (505) 892-5141 Fax (505) 892-3259



MATERIAL LOCATION		DESCRIPTION	AASHTO MATERIAL CLASSIFICATIONS	COMPACTION / DENSITY REQUIREMENTS
D	INITIAL FILL: FILL MATERIAL FOR LAYER 'C' STARTS FROM THE TOP OF THE EMBEDMENT STONE ('B' LAYER) TO 24" ABOVE THE TOP OF THE CHAMBER. NOTE THAT PAVEMENT SUBBASE MAY BE A PART OF THE 'C' LAYER.	ANY SOIL/ ROCK MATERIALS, NATIVE SOILS, OR PER ENGINEER'S PLANS. CHECK PLANS FOR PAVEMENT SUBGRADE REQUIREMENTS	N/ A	PRAPARE PER SITE DESIGN ENGINEER'S PLANS. PAVED INSTALLATIONS MAY HAVE STRINGENT MATERIALS AND PREPARATION REQUIREMENTS.
C	INITIAL FILL: FILL MATERIAL FOR LAYER 'C' STARTS FROM THE TOP OF THE EMBEDMENT STONE ('B' LAYER) TO 24" ABOVE THE TOP OF THE CHAMBER. NOTE THAT PAVEMENT SUBBASE MAY BE A PART OF THE 'C' LAYER.	GRANULAR WELL-GRADED SOIL/AGGREGATE MIXTURES, <35% FINES OR PROCESSED AGGREGATE.  MOST PAVEMENT SUBBASE MATERIALS CAN BE USED IN LIEU OF THIS LAYER.	AASHTO M145 <sup>1</sup> A-1, A-2-4, A-3  OR  AASHTO M43 <sup>1</sup> 3, 357, 4, 467, 5, 56, 57, 6, 67, 68, 7, 78, 8, 89, 9, 10	BEGIN COMPACTIONS AFTER 24" OF MATERIAL OVER THE CHAMBERS IS REACHED. COMPACT ADDITIONAL LAYERS IN 12" (300 mm) MAX LIFTS TO A MIN. 95% PROCTOR DENSITY FOR WELL GRADED MATERIAL AND 95% RELATIVE DENSITY FOR PROCESSED AGGREGATE MATERIALS.
B	EMBEDMENT STONE: FILL SURROUNDING THE CHAMBERS FROM THE FOUNDATION STONE ('A' LAYER) TO THE 'C' LAYER ABOVE.	CLEAN, CRUSHED, ANGULAR STONE, NOMINAL SIZE DISTRIBUTION BETWEEN 3/4-2 INCH	AASHTO M43 <sup>1</sup> 3, 4	NO COMPACTION REQUIRED.
A	FOUNDATION STONE: FILL BELOW CHAMBERS FROM THE SUBGRADE UP TO THE FOOT (BOTTOM) OF THE CHAMBER.	CLEAN, CRUSHED, ANGULAR STONE, NOMINAL SIZE DISTRIBUTION BETWEEN 3/4-2 INCH	AASHTO M43 <sup>1</sup> 3, 4	PLATE COMPACT OR ROLL TO ACHIEVE A FLAT SURFACE. <sup>2</sup> <sup>3</sup>

PLEASE NOTE:

1. THE LISTED AASHTO DESIGNATIONS ARE FOR GRADATIONS ONLY. THE STONE MUST ALSO BE CLEAN, CRUSHED, ANGULAR. FOR EXAMPLE, A SPECIFICATION FOR #4 STONE WOULD STATE: "CLEAN, CRUSHED, ANGULAR NO. 4 (AASHTO M43) STONE".
2. COMPACTION REQUIREMENTS ARE MET FOR 'A' LOCATION MATERIALS WHEN PLACED AND COMPACTED IN 9" (MAX) LIFTS USING TWO FULL COVERAGES WITH A VIBRATORY COMPACTOR.
3. WHERE INFILTRATION SURFACES MAY BE COMPROMISED BY COMPACTION, FOR STANDARD DESIGN LOAD CONDITIONS, A FLAT SURFACE MAY BE ACHIEVED BY RAKING OR DRAGGING WITHOUT COMPACTION EQUIPMENT.

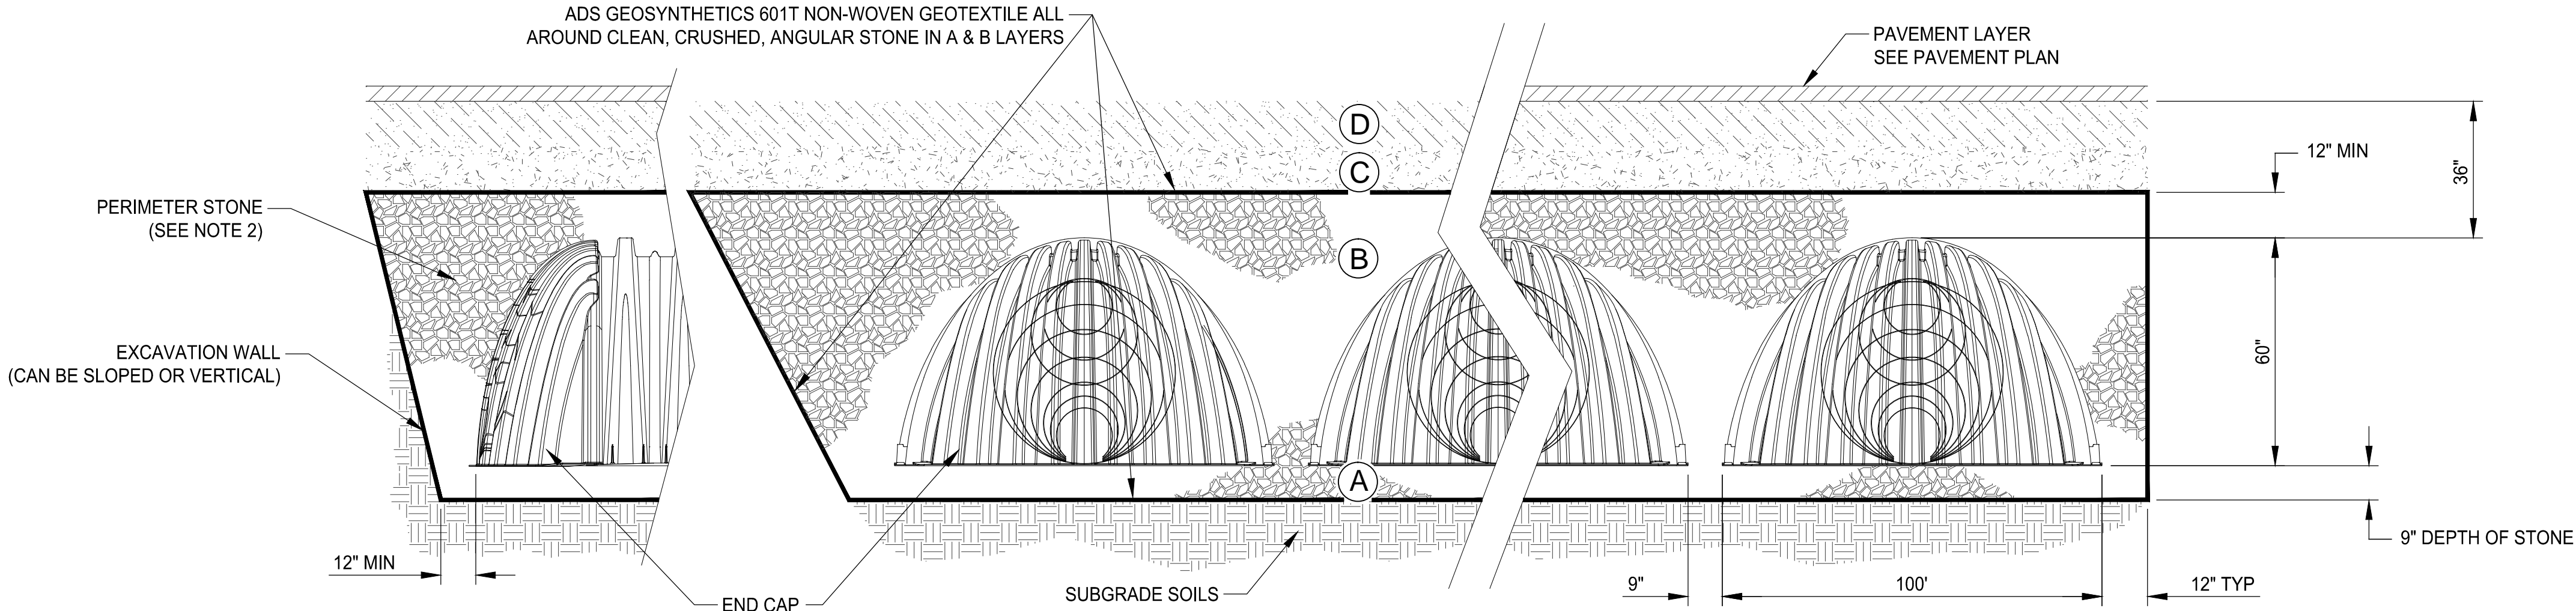

NOTES:

1. "ACCEPTABLE FILL MATERIALS" TABLE ABOVE PROVIDES MATERIAL LOCATIONS, DESCRIPTIONS, GRADATIONS, AND COMPACTION REQUIREMENTS FOR FOUNDATION, EMBEDMENT, AND FILL MATERIALS.
2. PERIMETER STONE MUST BE EXTENDED HORIZONTALLY TO THE EXCAVATION WALL FOR BOTH VERTICAL AND SLOPED EXCAVATION WALLS.
3. ONCE LAYER 'C' IS PLACED, ANY SOIL/MATERIAL CAN BE PLACED IN LAYER 'D' UP TO THE FINISHED GRADE. MOST PAVEMENT SUBBASE SOILS CAN BE USED TO REPLACE THE MATERIAL REQUIREMENTS OF LAYER 'C' OR 'D' .

A1 ACCEPTABLE FILL MATERIALS: STORMTECH MC-4500 CHAMBER SYSTEMS

NTS

DRAINAGE CERTIFICATION

I, SCOTT A. EDDINGS, NMPE 12856, OF THE FIRM HUITT-ZOLLARS, INC. HEREBY CERTIFY THAT THIS PROJECT HAS BEEN GRADED AND WILL DRAIN IN SUBSTANTIAL COMPLIANCE WITH AND IN ACCORDANCE WITH THE DESIGN INTENT OF THE APPROVED PLAN DATED 7/20/15. THE RECORD INFORMATION EDITED ON TO THE ORIGINAL DESIGN DOCUMENT HAS BEEN OBTAINED FROM THE SURVEY DATED 10/4/16 PROVIDED BY JOSEPH M. SOLOMON, JR, NMPS 15075 OF THE FIRM HIGH MESA CONSULTING GROUP. I FURTHER CERTIFY THAT I HAVE PERSONALLY VISITED THE PROJECT SITE ON 10/5/16 AND HAVE DETERMINED BY VISUAL INSPECTION THAT THE SURVEY DATA PROVIDED IS REPRESENTATIVE OF ACTUAL SITE CONDITIONS AND IS TRUE AND CORRECT TO THE BEST OF MY KNOWLEDGE AND BELIEF. THIS CERTIFICATION IS SUBMITTED IN SUPPORT OF A REQUEST FOR A PERMANENT CERTIFICATE OF OCCUPANCY AT WINROCK SECTION 2 AND 4 WINROCK TOWN CENTER.

THE RECORD INFORMATION PRESENTED HEREON IS NOT NECESSARILY COMPLETE AND INTENDED ONLY TO VERIFY SUBSTANTIAL COMPLIANCE OF THE GRADING AND DRAINAGE ASPECTS OF THIS PROJECT. THOSE RELYING ON THIS RECORD DOCUMENT ARE ADVISED TO OBTAIN INDEPENDENT VERIFICATION OF IT'S ACCURACY BEFORE USING IT FOR ANY OTHER PURPOSE.

Scott A. Eddings

SCOTT A. EDDINGS, NMPE 12856


3/21/17  
DATE



HUITT-ZOLLARS  
Huitt-Zollars, Inc. Rio Rancho  
333 Rio Rancho Drive NE, Suite 101  
Rio Rancho, New Mexico 87124  
Phone (505) 892-5141 Fax (505) 892-3259

MODULUS ARCHITECTS

220 COPPER AVE. N.W. SUITE 350  
ALBUQUERQUE, NEW MEXICO 87102  
PHONE (505) 338-1499 FAX (505) 338-1498

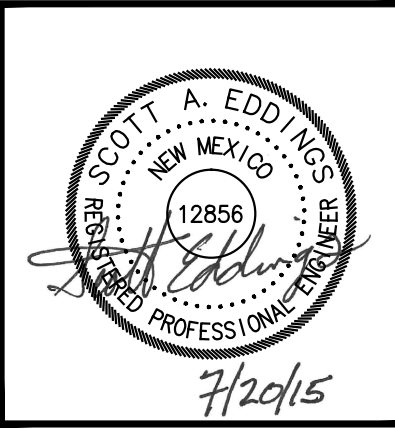

BUILDING PERMIT

PROJECT TITLE	WINROCK SECTION 2 AND 4	DRAWN BY:	VKL
PROJECT MANAGER	WINROCK TOWN CENTER ALBUQUERQUE, NEW MEXICO	JOB NO.	307669.01
SHEET TITLE	SCOTT EDDINGS P.E.	DATE	07/20/15

DATE:	07/20/15	sheet-	10
SCALE:	N.T.S.		
		of-	13


C502

- NTS

DATE: 07/20/15	sheet- 11
SCALE: N.T.S.	C503 of 13


Plotted: 3/21/2017 1:46:03 PM, By: Tafuya, Linda  
 File Path: J:\proj\303699 Winrock\ICAD\Sheet Set\Section 2\Grading Permit\GRD CERT 3-21-17\CS01-CS04 STORM DETAILS.dwg  
 Last Saved: 3/21/2017 1:45:31 PM, ltafuya

D

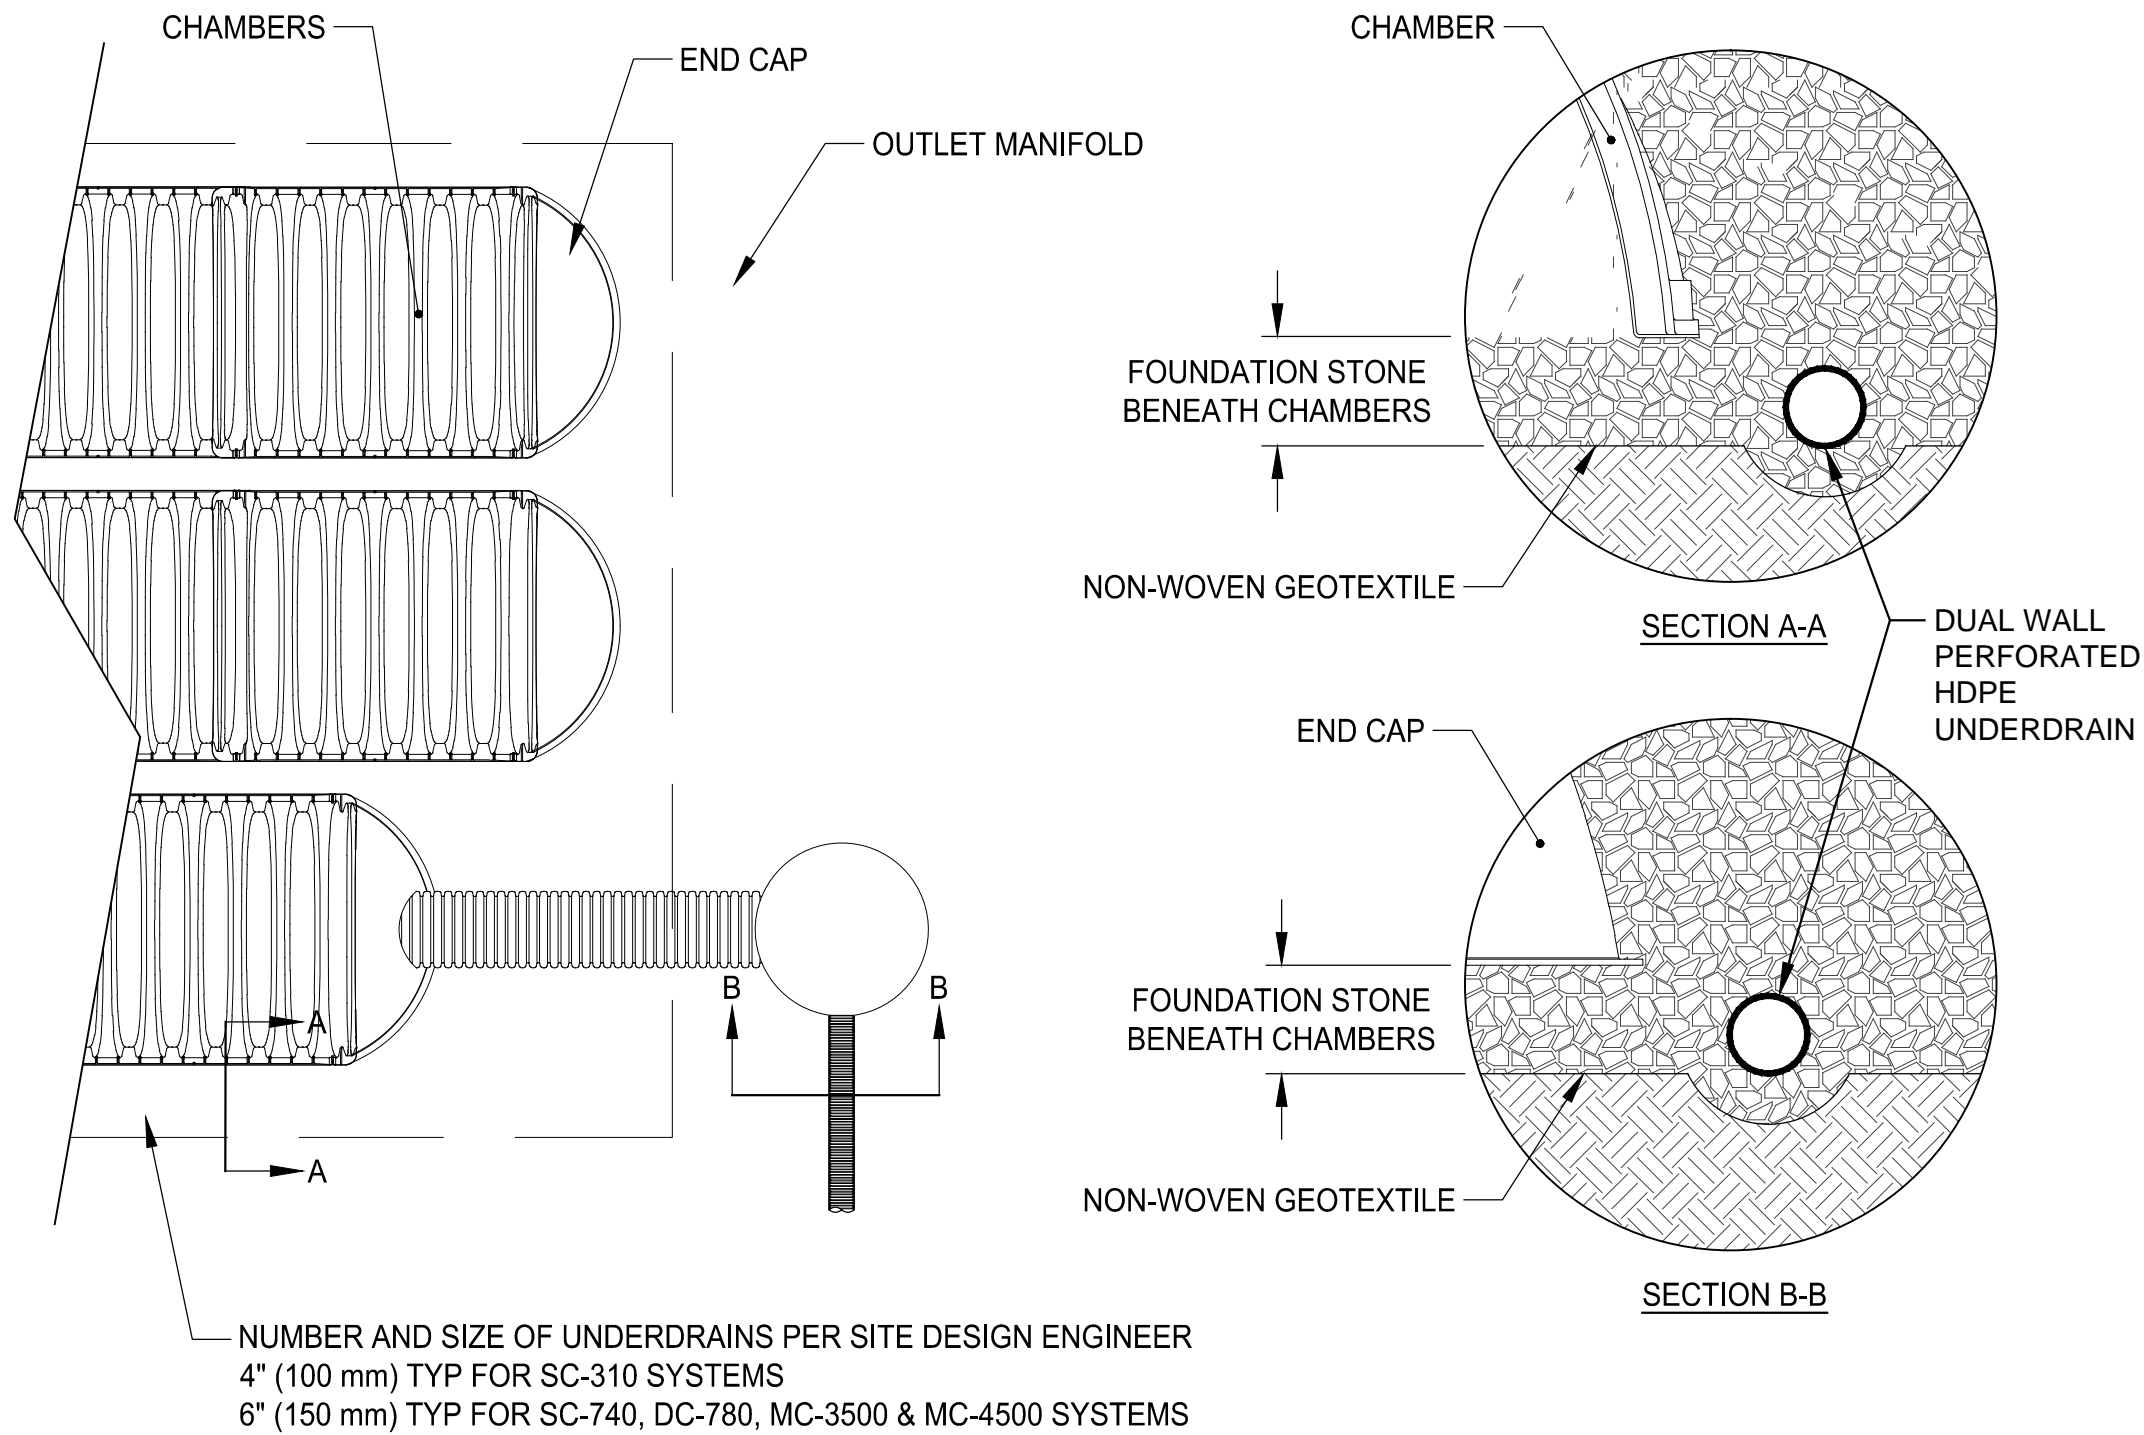


C1 UNDERDRAIN DETAIL  
NTS

B

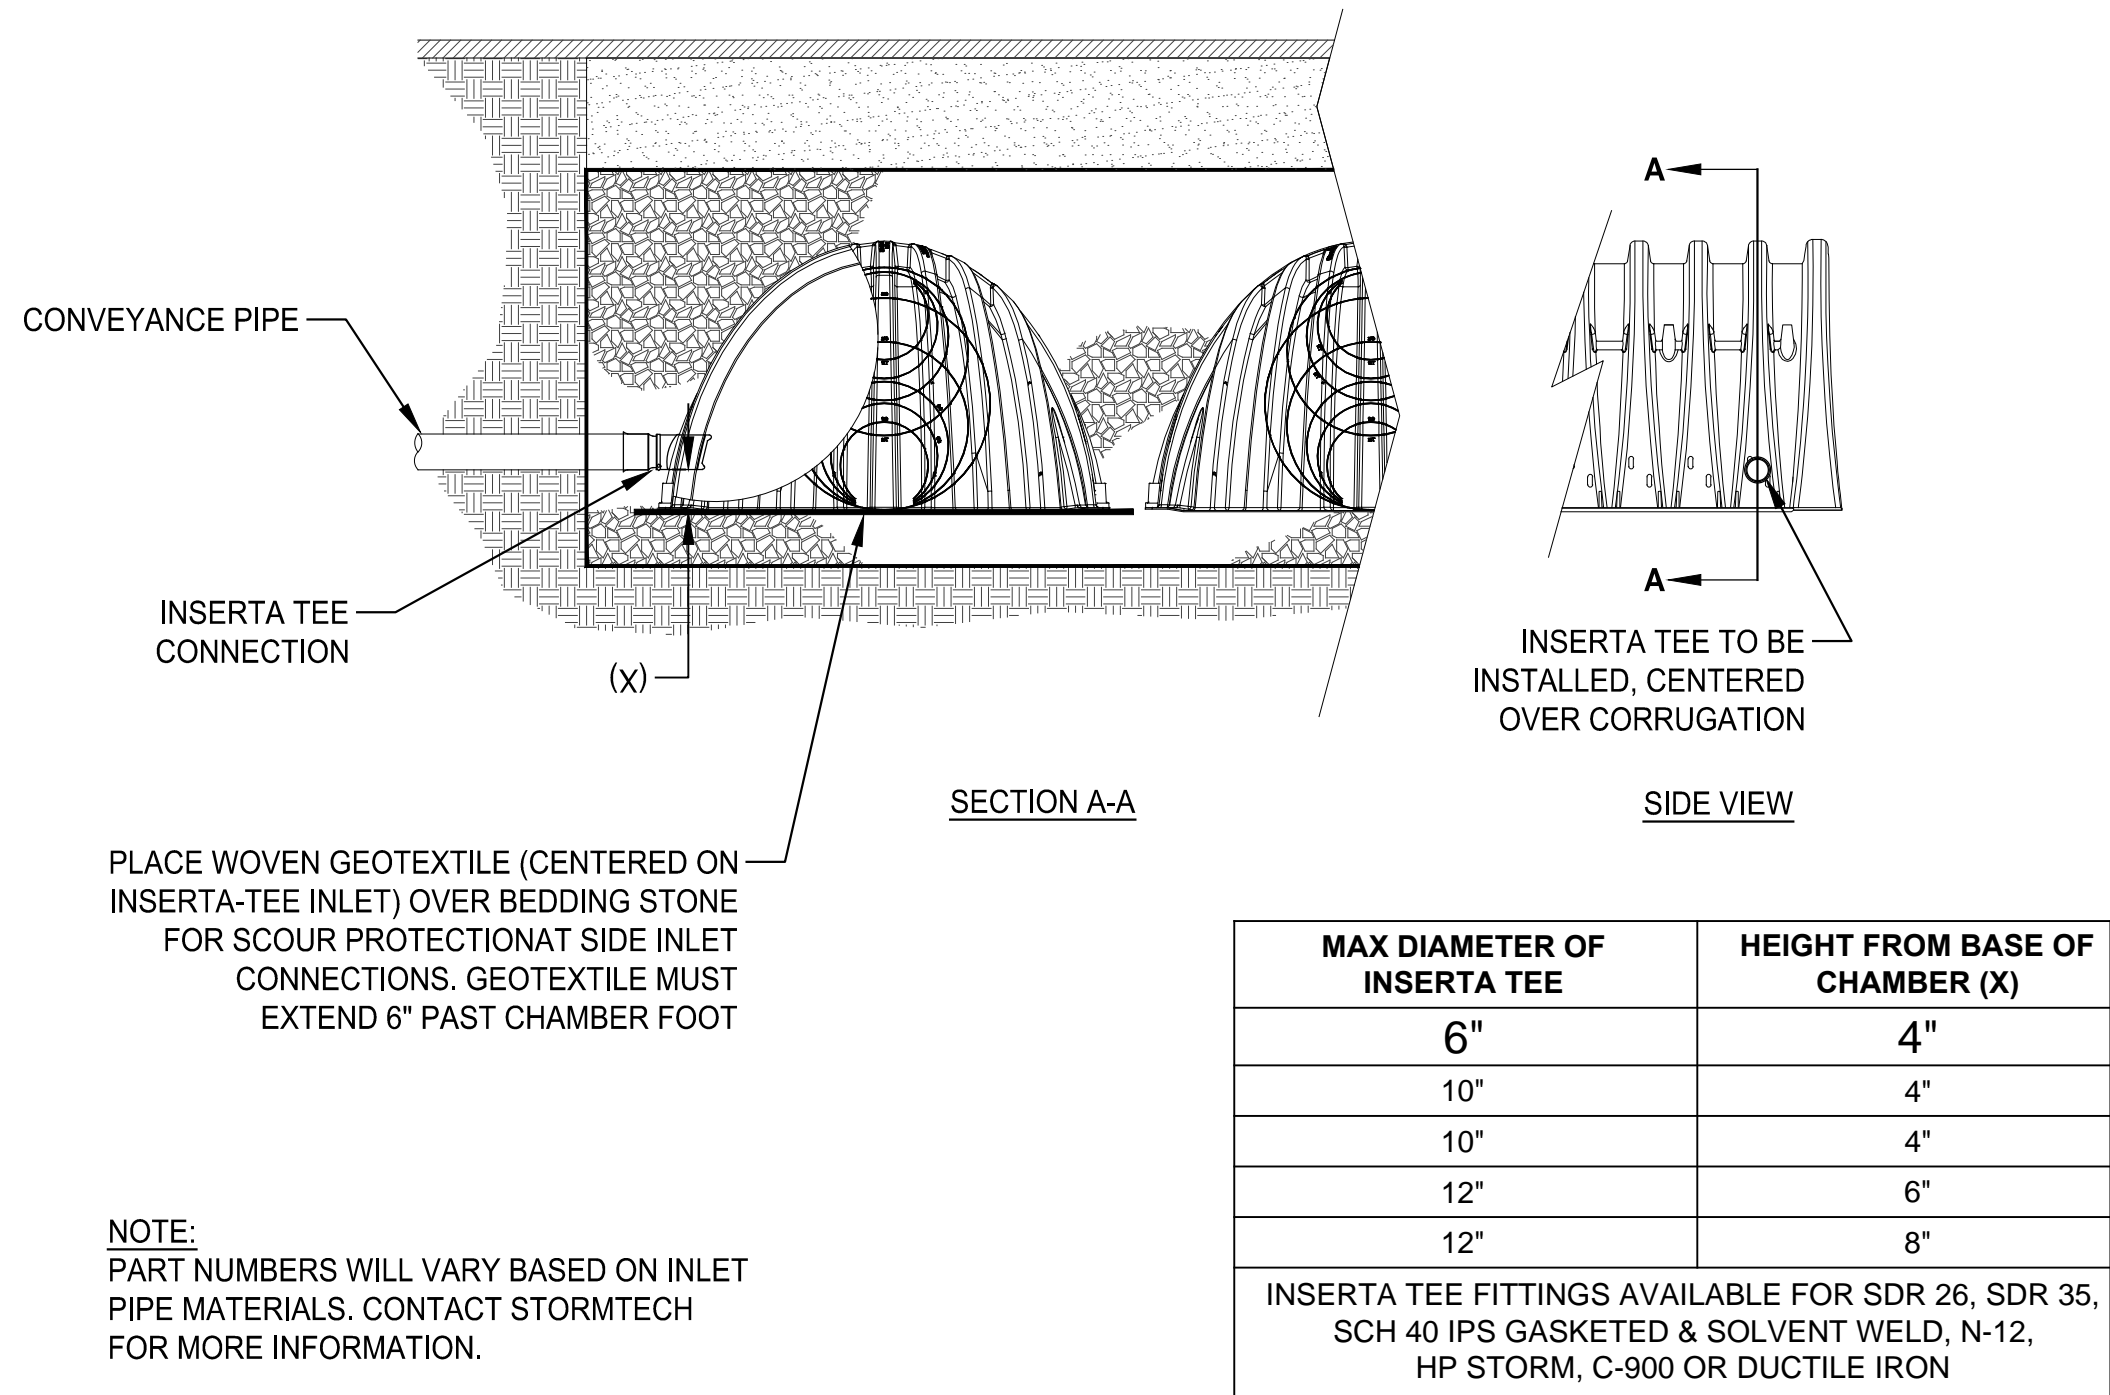

A1 INSERTA TEE DETAIL  
NTS

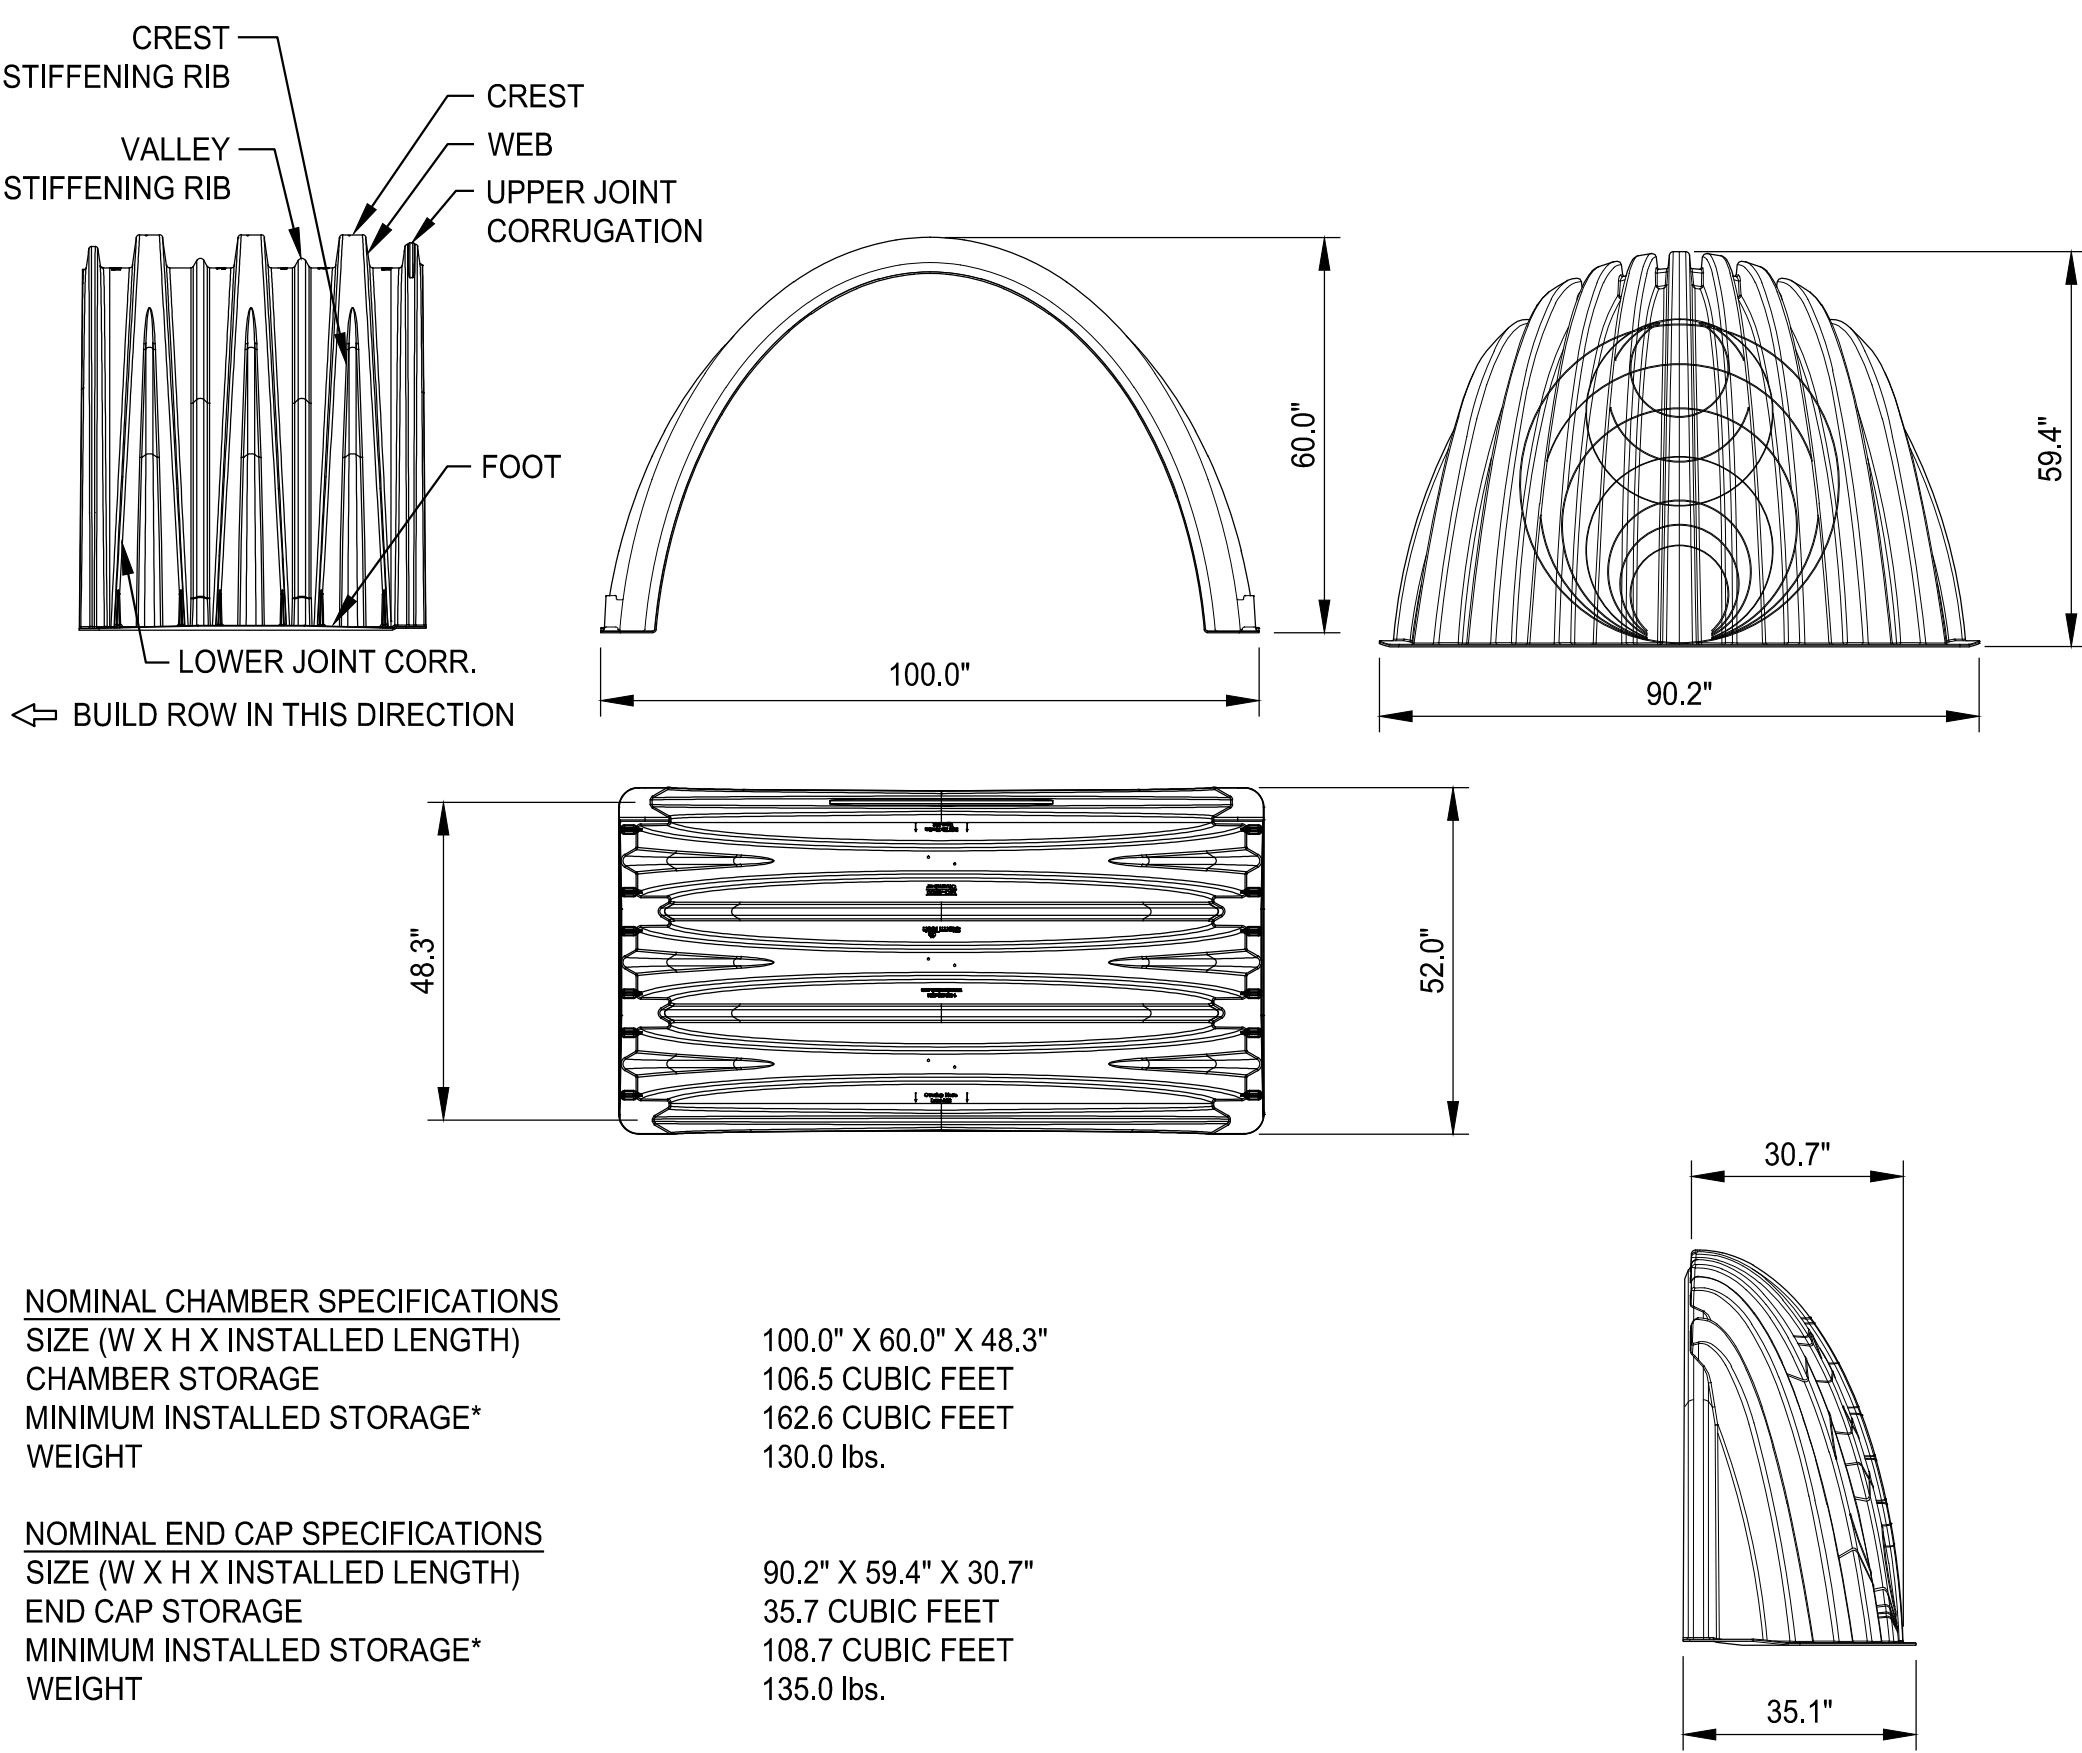


STUBS AT BOTTOM OF END CAP FOR PART NUMBERS ENDING WITH "B"  
STUBS AT TOP OF END CAP FOR PART NUMBERS ENDING WITH "T"

STUB	B	C
6" (150 mm)	42.54" (1.081 m)	---
8"	---	0.86"
8"	40.50"	---
10"	---	1.01"
10"	38.37"	---
12"	---	1.33"
12"	35.69"	---
12"	---	1.55"
15"	32.72"	---
15"	---	1.70"
18"	29.36"	---
18"	---	1.97"
24"	23.05"	---
24"	---	2.26"
30"	---	2.95"
36"	---	3.25"
42"	---	3.55"

NOTE: ALL DIMENSIONS ARE NOMINAL

A3 SPECIFICATION  
NTS

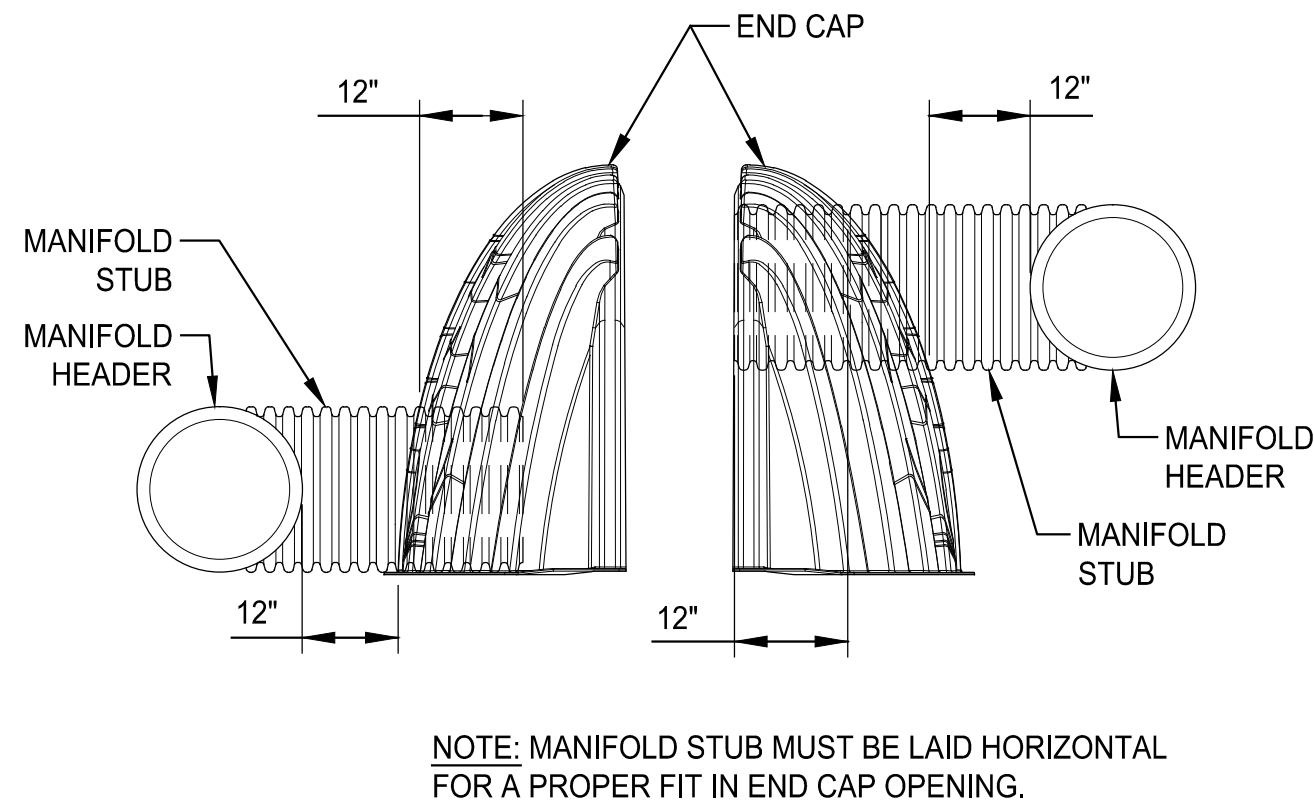

C5 END CAP INSERTION DETAIL  
NTS

#### DRAINAGE CERTIFICATION

I, SCOTT A. EDDINGS, NMPE 12856, OF THE FIRM HUITT-ZOLLARS, INC. HEREBY CERTIFY THAT THIS PROJECT HAS BEEN GRADED AND WILL DRAIN IN SUBSTANTIAL COMPLIANCE WITH AND IN ACCORDANCE WITH THE DESIGN INTENT OF THE APPROVED PLAN DATED 7/20/15. THE RECORD INFORMATION EDITED ON TO THE ORIGINAL DESIGN DOCUMENT HAS BEEN OBTAINED FROM THE SURVEY DATED 10/4/16 PROVIDED BY JOSEPH M. SOLOMON, JR, NMPS 15075 OF THE FIRM HIGH MESA CONSULTING GROUP. I FURTHER CERTIFY THAT I HAVE PERSONALLY VISITED THE PROJECT SITE ON 10/5/16 AND HAVE DETERMINED BY VISUAL INSPECTION THAT THE SURVEY DATA PROVIDED IS REPRESENTATIVE OF ACTUAL SITE CONDITIONS AND IS TRUE AND CORRECT TO THE BEST OF MY KNOWLEDGE AND BELIEF. THIS CERTIFICATION IS SUBMITTED IN SUPPORT OF A REQUEST FOR A PERMANENT CERTIFICATE OF OCCUPANCY AT WINROCK SECTION 2 AND 4 WINROCK TOWN CENTER.

THE RECORD INFORMATION PRESENTED HEREON IS NOT NECESSARILY COMPLETE AND INTENDED ONLY TO VERIFY SUBSTANTIAL COMPLIANCE OF THE GRADING AND DRAINAGE ASPECTS OF THIS PROJECT. THOSE RELYING ON THIS RECORD DOCUMENT ARE ADVISED TO OBTAIN INDEPENDENT VERIFICATION OF IT'S ACCURACY BEFORE USING IT FOR ANY OTHER PURPOSE.

SCOTT A. EDDINGS, NMPE 12856


3/21/17  
DATE



HUITT-ZOLLARS  
Huitt-Zollars, Inc. Rio Rancho  
333 Rio Rancho Drive NE, Suite 101  
Rio Rancho, New Mexico 87124  
Phone (505) 892-5141 Fax (505) 892-3259

MODULUS ARCHITECTS

220 COPPER AVE. N.W. SUITE 350  
ALBUQUERQUE, NEW MEXICO 87102  
PHONE (505) 338-1499 FAX (505) 338-1498

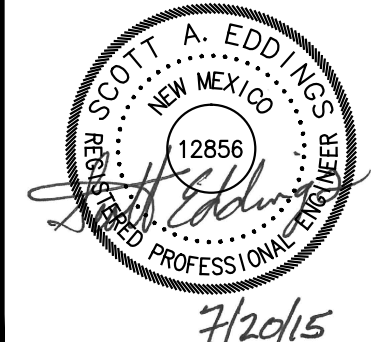

PROJECT TITLE  
WINROCK SECTION 2 AND 4  
WINROCK TOWN CENTER  
ALBUQUERQUE, NEW MEXICO


PROJECT MANAGER  
SCOTT EDDINGS P.E.  
JOB NO.  
303689.01

DRAWN BY  
VKL


SHEET TITLE  
STORM WATER RETENTION - DETAILS

DATE  
07/20/15  
SCALE  
N.T.S.  
sheet- 12  
C504  
of- 13


D

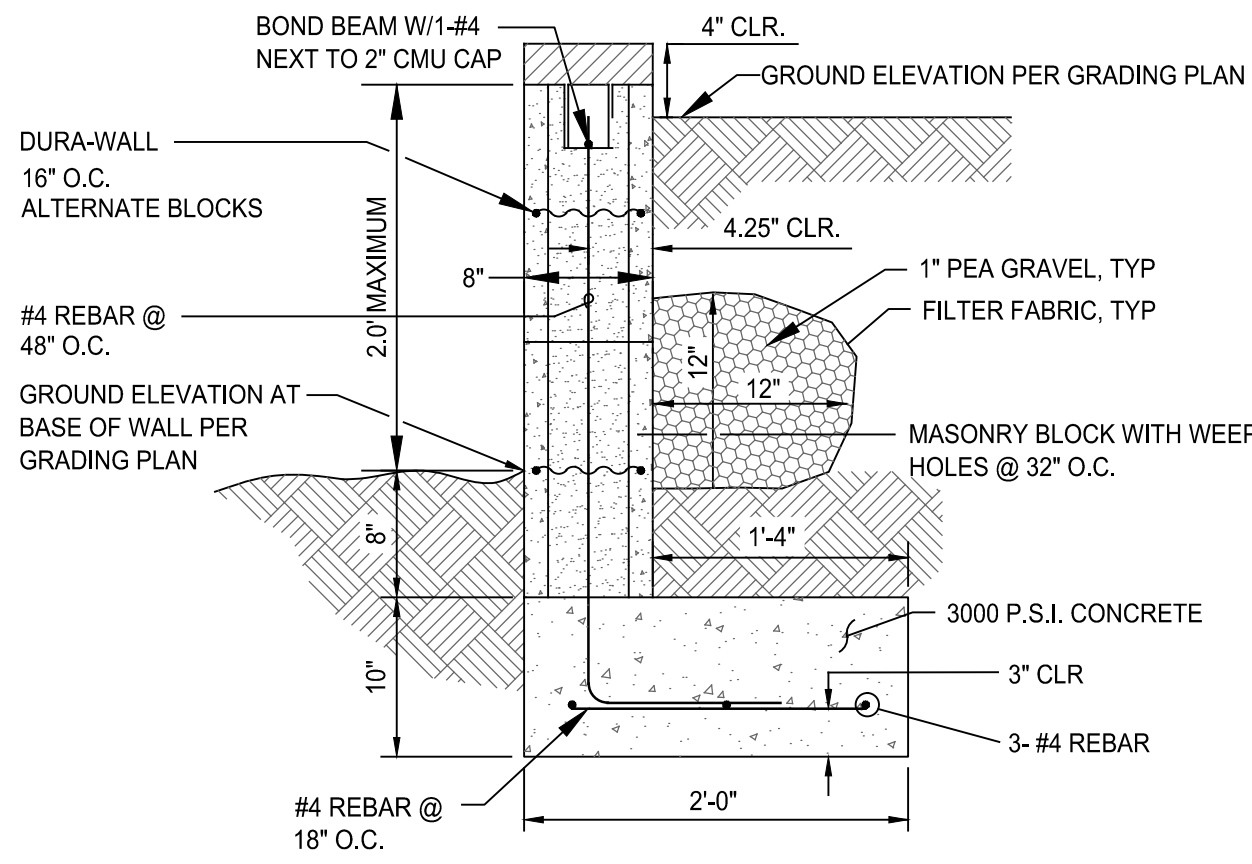


D1 TYPE A RETAINING WALL  
0 TO 2'

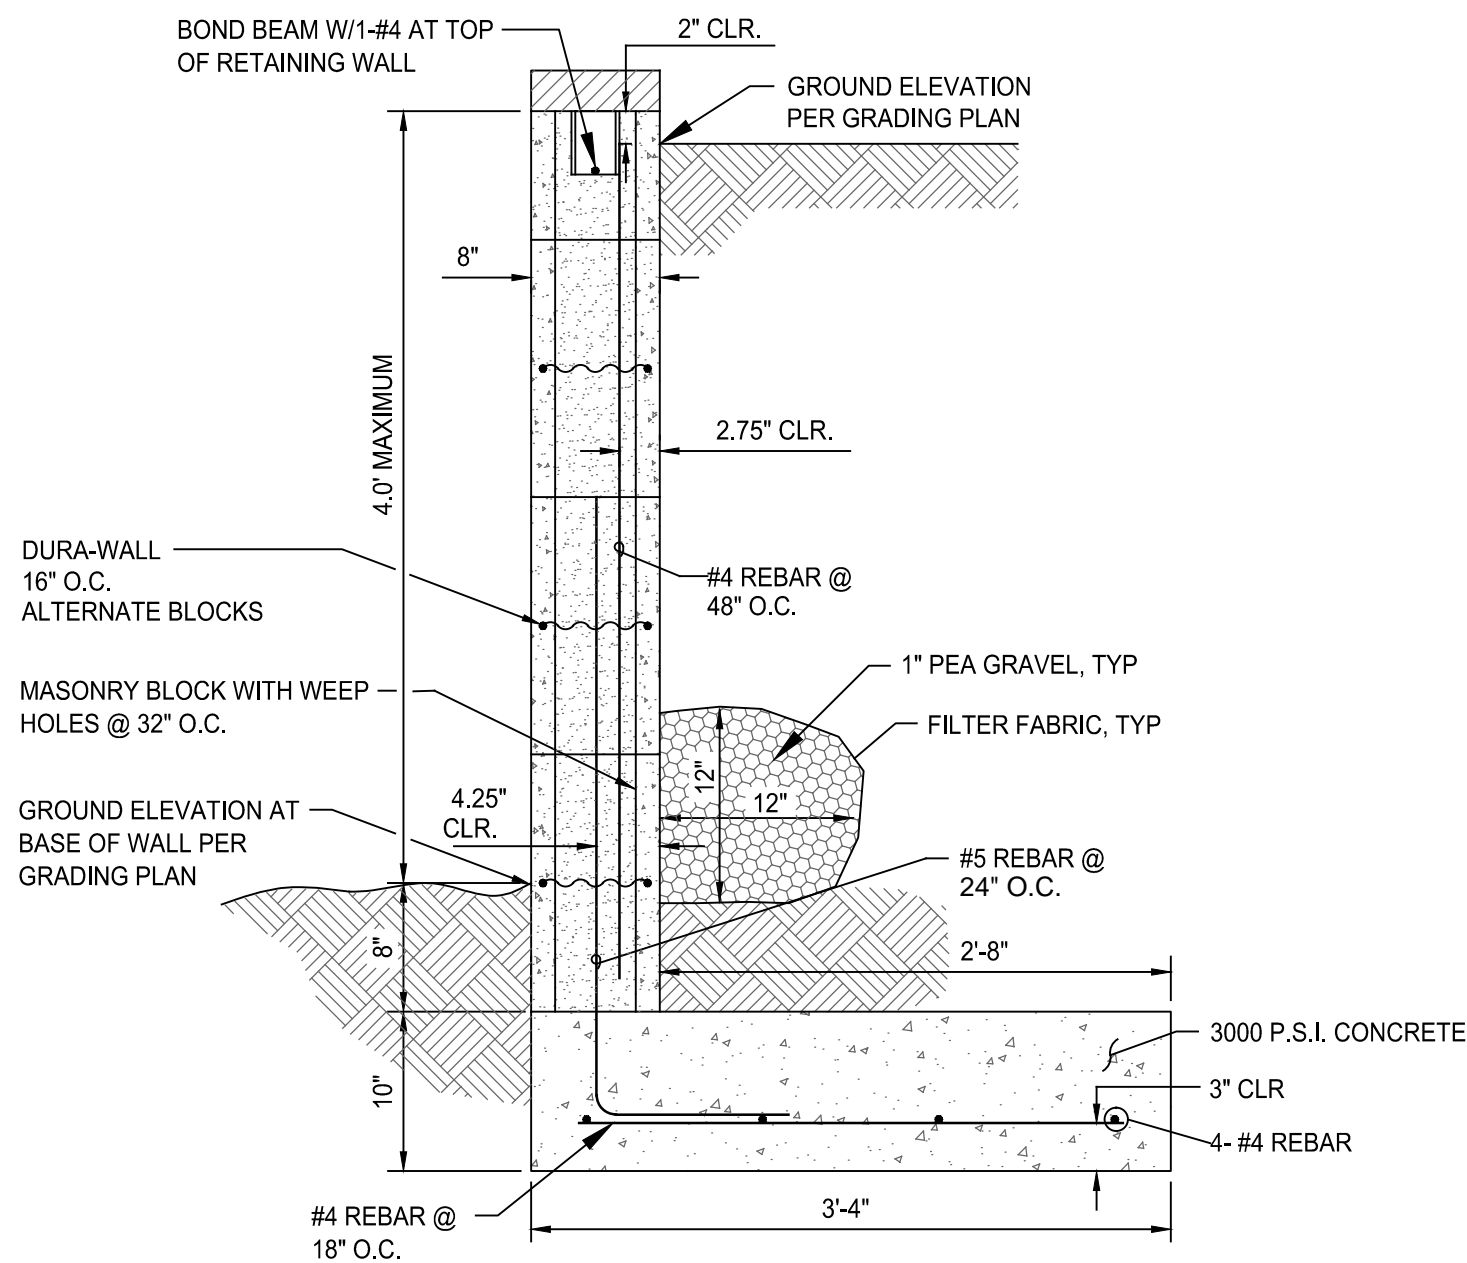


B1 TYPE B-RETAINING WALL  
2' TO 4'

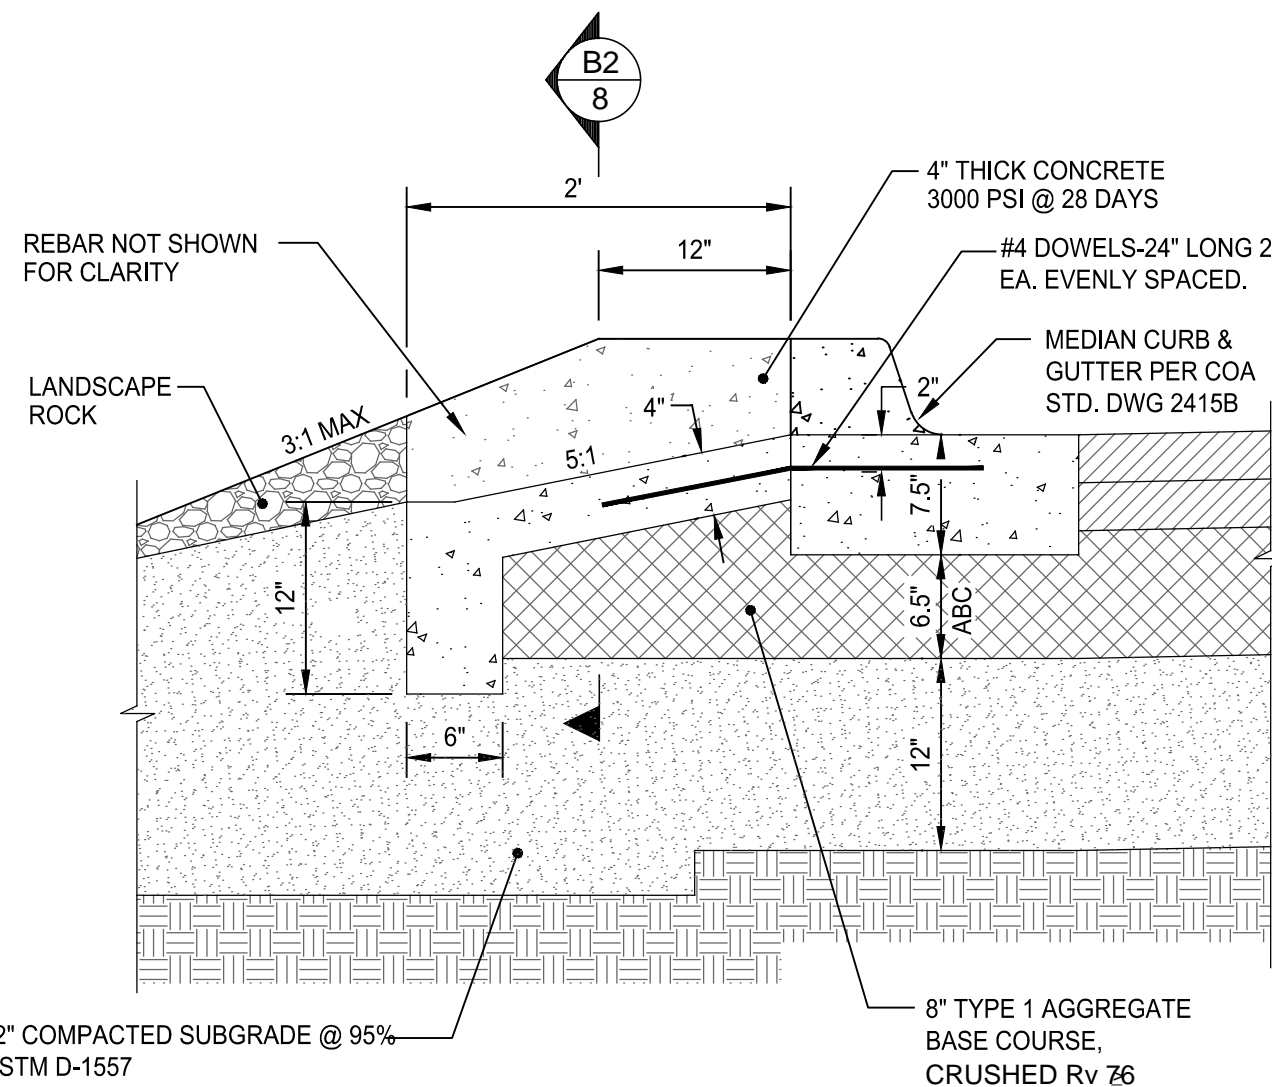


A1 CURB OPENING DETAIL  
NTS

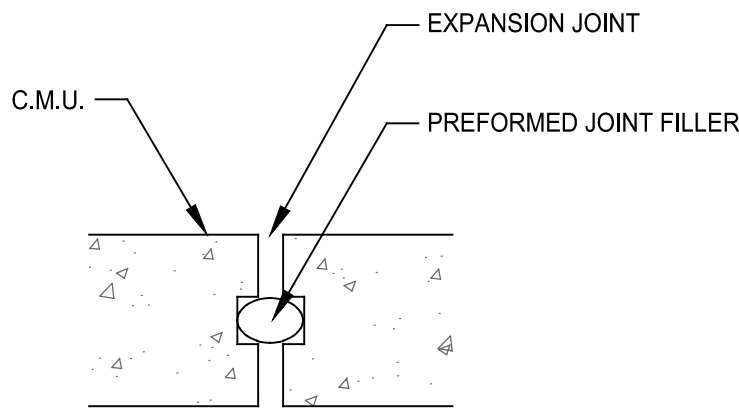

D2 EXPANSION JOINT DETAIL  
NTS

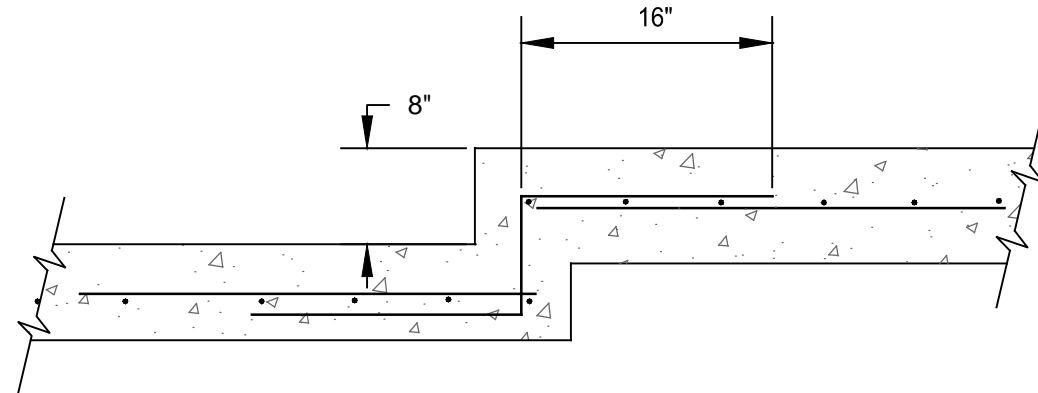

C2 FOOTING STEP DETAIL  
NTS

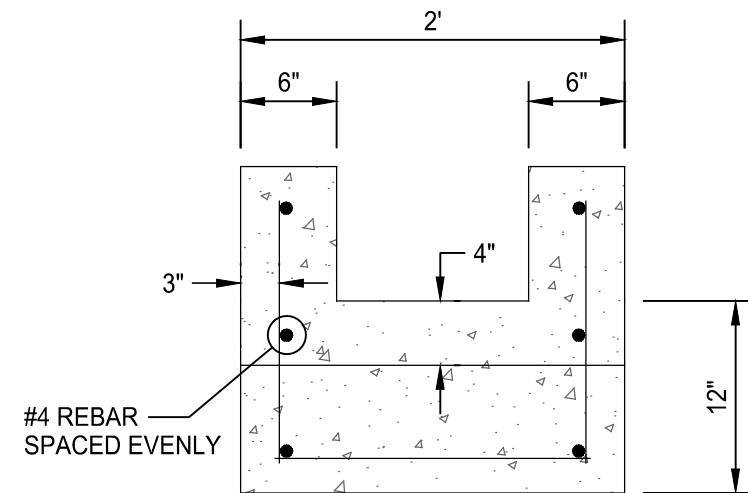

B2 SECTION DETAIL  
N.T.S.

B2 SECTION DETAIL  
NTS

#### DRAINAGE CERTIFICATION

I, **SCOTT A. EDDINGS**, NMPE 12856, OF THE FIRM HUITT-ZOLLARS, INC. HEREBY CERTIFY THAT THIS PROJECT HAS BEEN GRADED AND WILL DRAIN IN SUBSTANTIAL COMPLIANCE WITH AND IN ACCORDANCE WITH THE DESIGN INTENT OF THE APPROVED PLAN DATED **7/20/15**. THE RECORD INFORMATION EDITED ON TO THE ORIGINAL DESIGN DOCUMENT HAS BEEN OBTAINED FROM THE SURVEY DATED 10/4/16 PROVIDED BY JOSEPH M. SOLOMON, JR., NMPS 15073 OF THE FIRM HIGH MESA CONSULTING GROUP. I FURTHER CERTIFY THAT I HAVE PERSONALLY VISITED THE PROJECT SITE ON 10/5/16 AND HAVE DETERMINED BY VISUAL INSPECTION THAT THE SURVEY DATA PROVIDED IS REPRESENTATIVE OF ACTUAL SITE CONDITIONS AND IS TRUE AND CORRECT TO THE BEST OF MY KNOWLEDGE AND BELIEF. THIS CERTIFICATION IS SUBMITTED IN SUPPORT OF A REQUEST FOR A PERMANENT CERTIFICATE OF OCCUPANCY AT WINROCK SECTION 2 AND 4 WINROCK TOWN CENTER.

THE RECORD INFORMATION PRESENTED HEREON IS NOT NECESSARILY COMPLETE AND INTENDED ONLY TO VERIFY SUBSTANTIAL COMPLIANCE OF THE GRADING AND DRAINAGE ASPECTS OF THIS PROJECT. THOSE RELYING ON THIS RECORD DOCUMENT ARE ADVISED TO OBTAIN INDEPENDENT VERIFICATION OF ITS ACCURACY BEFORE USING IT FOR ANY OTHER PURPOSE.

*Scott A. Eddings*  
SCOTT A. EDDINGS, NMPE 12856

3/21/17  
DATE



#### GENERAL NOTES


1. THE WALL TYPES ON THIS PLAN INDICATE THE TYPE OF RETAINING WALL TO BE CONSTRUCTED, DETAILED ON SHEET 2-27 & 2-28, TO MATCH SURFACE ELEVATIONS ON THE RETAINING WALL SHEETS. A MINIMUM OF ONE ADDITIONAL COURSE (8" HIGH) IS REQUIRED, BURIED BELOW THE LOWER SURFACE DESIGN ELEVATION. WHEN THE LOWER SLOPE IS SEVERE AND/OR THE FOOTER IS WIDE, AN ADDITIONAL BURIED COURSE MAY BE REQUIRED.
2. PAY QUANTITIES INCLUDE THE COST OF EXCAVATION, GRADING, COMPACTION, FOOTERS, AND ALL COURSES (INCLUDING BURIED COURSES) OF CMU WALL WITH REINFORCING, GROUT, BOND BEAMS, EXPANSION JOINTS, WATERPROOFING GRAVEL DRAIN AND BACKFILL ALL PER SPECIFICATIONS.
3. FINAL TYPE AND HEIGHTS OF CMU WALL, AS INDICATED ON THIS SHEET.
4. CONTRACTOR SHALL APPLY ANTI-GRAFFITI COATINGS TO ALL PERIMETER WALLS. CONTRACTOR SHALL USE PROSOCO DEFACER ERASER OR APPROVED EQUIVALENT.

#### RETAINING WALL GENERAL NOTES


1. WHERE RETAINING WALLS ARE INSTALLED, WEEP HOLES SHALL BE PROVIDED IN THE PORTION OF THE WALL BELOW GRADE, TO RELIEVE POTENTIAL HYDROSTATIC PRESSURE, BY ELIMINATING THE MORTAR FROM ALTERNATING VERTICAL JOINTS IN EVERY OTHER COURSE OF BLOCK BELOW GRADE. NO TURNED BLOCKS WILL BE ALLOWED.

#### MASONRY WALL CONSTRUCTION NOTES:


1. RETAINING WALLS ARE REQUIRED WHENEVER THE DIFFERENCE IN SURFACE ELEVATIONS EXCEED 1.50 FEET (2 EXPOSED CMU COURSES)
2. ALL MASONRY UNITS SHALL BE TYPE 1, GRADE N WITH A COMPRESSIVE STRENGTH OF 1900 PSI (NET AREA), F'M=1500 PSI
3. MORTAR SHALL BE TYPE S.
4. GROUT - F' =2000 PSI
5. CELLS CONTAINING REBAR SHALL BE GROUTED SOLID FROM THE BOTTOM TO THE TOP OF THE WALL IN ACCORDANCE WITH THE UNIFORM BUILDING CODE.
6. PROVIDE EXPANSION JOINTS AT 20' O.C.
7. THE BACK OF WALLS BELOW GRADE SHALL BE WATERPROOFED PRIOR TO BACKFILLING.
8. ALL CELLS BELOW GRADE SHALL BE GROUTED SOLID.
9. LAP ALL REBAR 40 BAR DIAMETERS, UNLESS OTHERWISE NOTED.
10. ALL HORIZONTAL REINFORCING IN BOND BEAMS SHALL BE CONTINUOUS AROUND CORNERS OR HAVE CORNER BARS OF THE SAME SIZE AND A LAP OF 48 BAR DIAMETERS OR 24" MINIMUM. VERTICAL STEEL SHALL CONTINUE THROUGH BOND BEAMS.
11. PROVIDE STANDARD TRUSS TYPE JOINT REINFORCING AT 16" O.C. (ALTERNATE COURSES), USE PREFABRICATED CORNERS AND TEES AT ALL WALL CORNERS AND INTERSECTIONS RESPECTIVELY.
12. MIN. CONCRETE COMPRESSIVE STRENGTH SHALL BE 3000 PSI.
13. UNLESS OTHERWISE SPECIFIED ON THESE PLANS OR WITHIN THE GEOTECHNICAL INVESTIGATION REPORT FOR THIS SITE, THE SUBGRADE UNDER FOOTING SHALL BE COMPACTED TO 95% ASTM D-1557, AND ALL BACKFILL SHALL BE COMPACTED TO 90% ASTM D-1557 IN NON-PAVED AREAS, AND 95% ASTM D-1557 IN PAVED AREAS.
14. REINFORCING STEEL SHALL COMFORM TO ASTM A-615, GRADE 60.
15. ALL RETAINING WALLS REPRESENTED ON THIS SHEET HAVE BEEN DESIGNED TO ACCEPT A 5' TO 6' PRIVACY WALL.
16. THE TOP COURSE OF RETAINING WALL SHOULD BE A 2" THICK SOLID MASONRY CAP UNLESS A PRIVACY WALL IS TO BE CONSTRUCTED ON TOP.

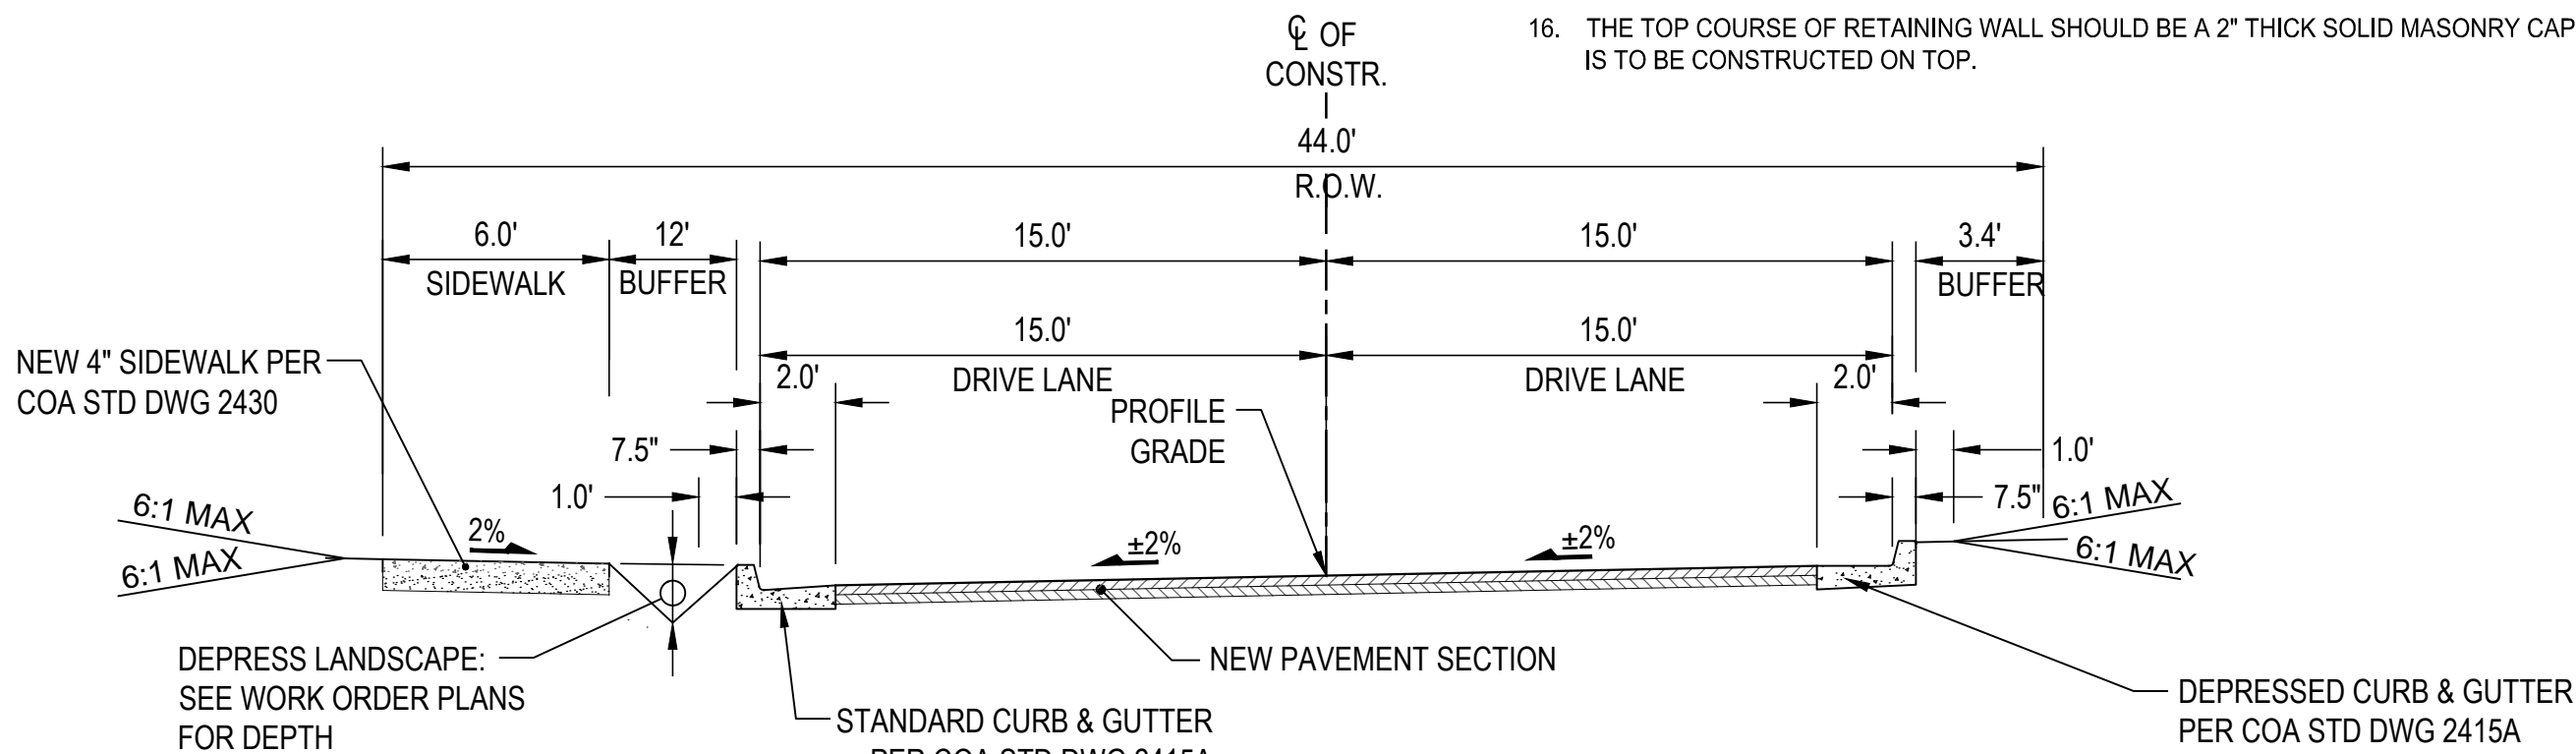

SECTION A

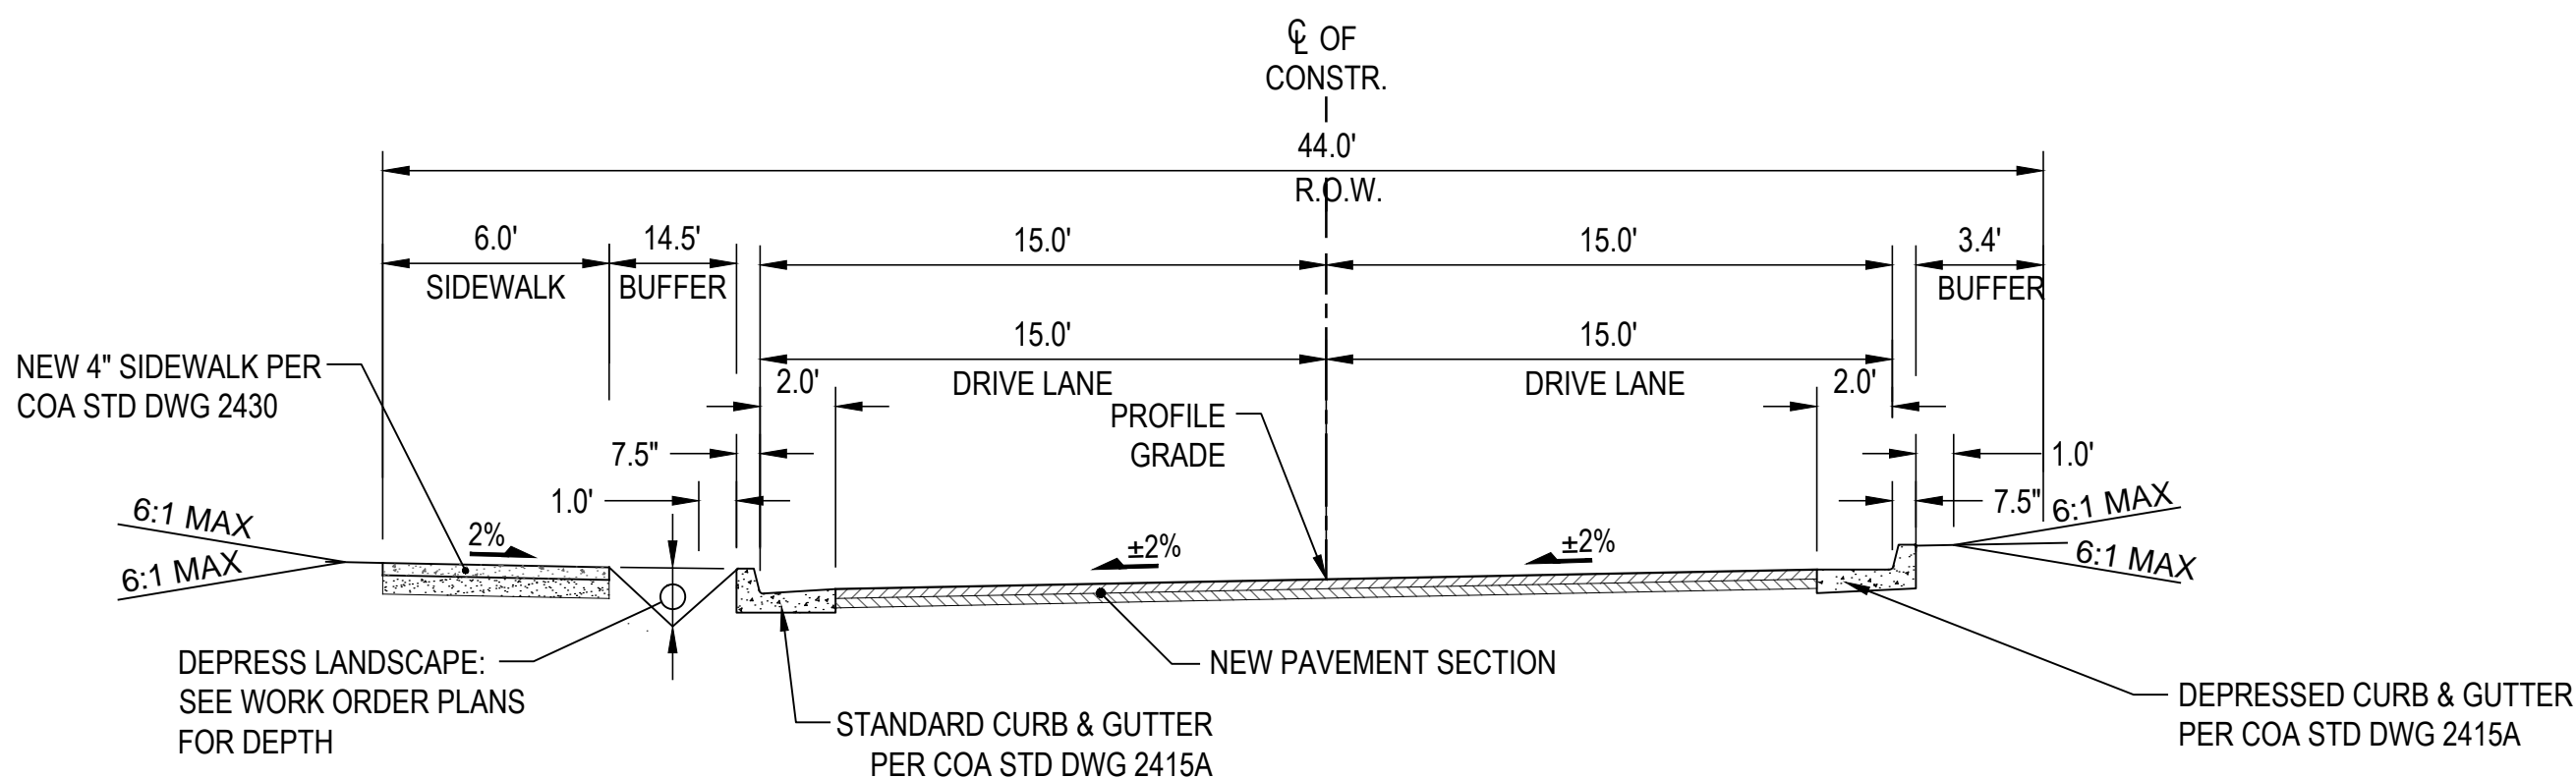

SECTION B

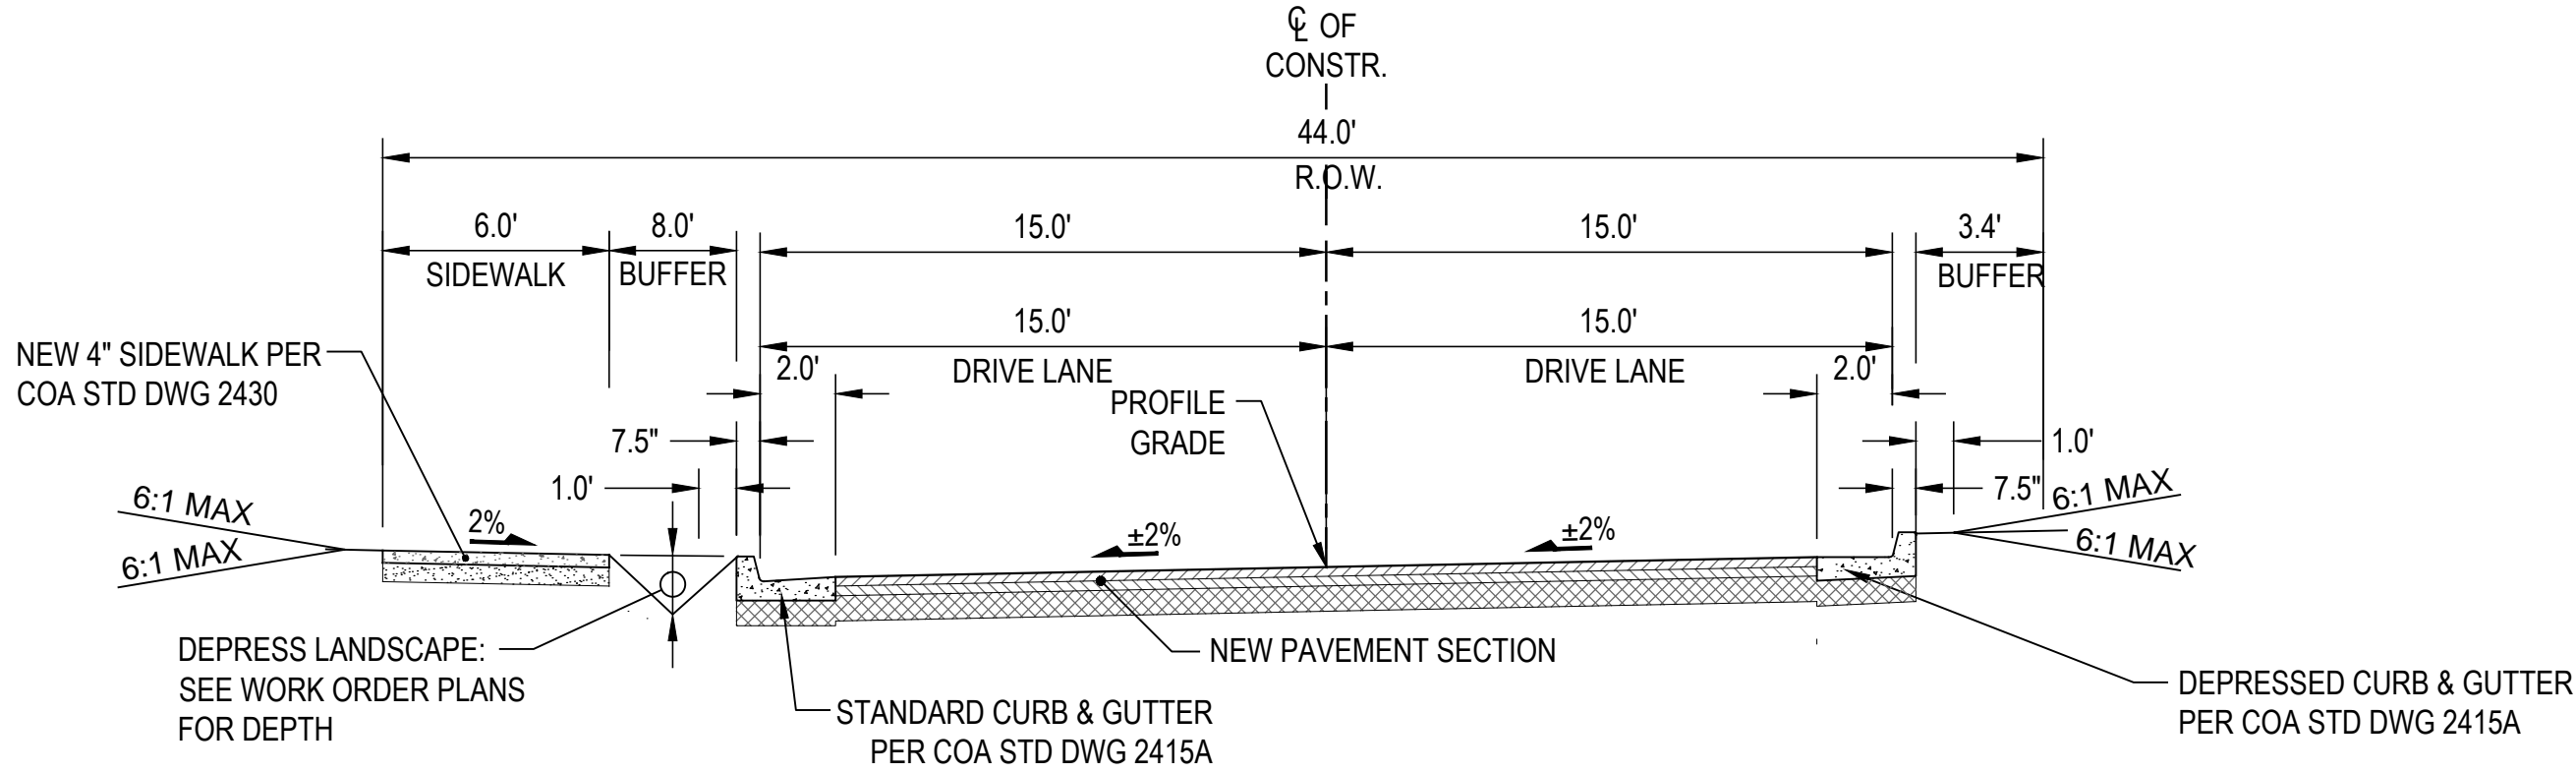


SECTION C

A4 ROAD C SECTIONS  
NTS

**HUITT-ZOLLARS**  
Huitt-Zollars, Inc. Rio Rancho  
333 Rio Rancho Drive NE, Suite 101  
Rio Rancho, New Mexico 87124  
Phone (505) 892-5141 Fax (505) 892-3259

REV	DATE	BY	REVISION
1	07/20/15	VKL	WINROCK SECTION 2 AND 4
2	07/20/15	VKL	WINROCK TOWN CENTER
3	07/20/15	VKL	ALBUQUERQUE, NEW MEXICO
4	07/20/15	VKL	SCOTT EDDINGS P.E.
5	07/20/15	VKL	303689.01
6	07/20/15	VKL	7/20/15

**MODULUS ARCHITECTS**  
220 COPPER AVE. N.W. SUITE 350  
ALBUQUERQUE, NEW MEXICO 87102  
PHONE (505) 338-1499 FAX (505) 338-1498

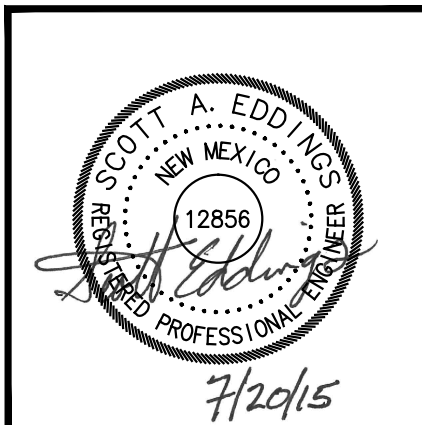

PROJECT TITLE	WINROCK SECTION 2 AND 4
PROJECT LOCATION	WINROCK TOWN CENTER ALBUQUERQUE, NEW MEXICO
PROJECT MANAGER	SCOTT EDDINGS P.E.
JOB NO.	303689.01
DRAWN BY	VKL
SHEET TITLE	DETAILS

DATE	07/20/15	SHEET	13
SCALE	1"=100'	C505	13