## **CITY OF ALBUQUERQUE**

PLANNING DEPARTMENT - Development Review Services



Richard J. Berry, Mayor

September 6, 2016

Scott Eddings, P.E. Huitt-Zollars 6501 Americas Parkway NE Albuquerque, New Mexico 87110

## Re: Winrock Redevelopment Section 4 – 2100 Louisiana Blvd. Grading and Drainage Plan, Engineer's Stamp Date 7-20-15 Drainage file number (J19D058C) Engineer's Certified Plan, Stamped 8-5-2016

Dear Mr. Eddings:

Based on the Certification received 8-8-16, the site is acceptable for a TEMPORARY 60 - day Certificate of Occupancy by Hydrology, with the following conditions/comments:

• The Engineer's Certified Plan should also include the Storm Drain sheets showing Storm Drain and inlets in the Final condition.

PO Box 1293

- There is an existing inlet and Storm Drain that was left in place that should be noted.
- It is unclear if the Storm Drain parallel to and north of the underground retention system was built or not.

Albuquerque

• Since Building Permit approval was contingent on corrections in the Work Order Construction Set, Final C.O. will only be issued after acceptance of the Work Order.

New Mexico 87103

If you have any questions, you can contact me at 924-3695.

www.cabq.gov

Sincerely,

Rita Harmon, P.E. Senior Engineer, Planning Dept. Development Review Services

Orig: Drainage file

c.pdf Addressee via Email, Cordova, Camille C.; Miranda, Rachel; Sandoval, Darlene M.; Blocker, Lois

## DRAINAGE AND TRANSPORTATION INFORMATION SHEET (REV 12/2005)


PROJECT TITLE:	JECT TITLE: Winrock Town Center – Section 4			ZONE MAP: <u>J-19-Z</u>			
DRB#:	EPC#: WOR			ORK (	X ORDER#: <u>4553.84</u>		
LEGAL DESCRIPTION:	Parcel A-1-A-1-	A-1-A Wii	nrock Center	r Additi	ion		
CITY ADDRESS:	2100 Louisiana Blvd						
ENCINEEDING EIDM.	Huitt Zollars					cott Eddings	
ADDRESS:	INEERING FIRM: Huitt-Zollars ADDRESS: 6501 Americas Parkway NE				PHONE: 802 5141		
	ABQ, NM						
OWNER:	Winrock Partners, LLC				CONTACT:	Fred Gorenz	
ADDRESS:	100 South Ave NE, Suite 100				PHONE:	881-0100	
CITY, STATE:	ABQ, NM				ZIP CODE:	87109	
ARCHITECT							
ADDRESS'					PHONE		
CITY STATE:					ZIP CODE:		
011 1, 01111 <u>2</u> .					211 CODE		
SURVEYOR:					CONTACT:		
ADDRESS:					PHONE:		
CITY, STATE:					ZIP CODE:		
CONTRACTOR:					CONTACT:		
CITY, STATE:					ZIP CODE:		
		CUECK				T.	
TYPE OF SUBMITTAL:					VAL SOUGH		
DRAINAGE RE					GUARANTEI		
	DRAINAGE PLAN 1 <sup>st</sup> SUBMITTAL PRELIMINAR'				Y PLAT APPROVAL		
					FOR SUB'D APPROVAL		
					BLDG. PERMIT APPROVAL		
GRADING PLAN SECTOR PLAN							
EROSION CONTROL PLAN FINAL PLAT A							
	ENGINEER'S CERT (HYDROLOGY) FOUNDATION						
	CLOMR/LOMR BUILDING PE				OF OCCUPANCY (PERM)		
	ENGINEER'S CERT (TCL) X CERTIFICATE						
	ENGINEER'S CERT (DRB SITE PLAN) GRADING PE   OTHER (SPECIFY) PAVING PER						
OTHER (SPEC	IFY)		PAVINGP		APPROVAL		
			OTHER (S				
			O IIILIA (D	Len	.,		
WAS A PRE-DESIGN C	ONFERENCE ATTENDE	D:					
X YES							
NO							
COPY PROVID	DED						
DATE SUBMITTED:	8-6-16		B	Y: S	cott Eddings		
				-			

Requests for approvals of Site Development Plans and/or Subdivision Plats shall be accompanied by a drainage submittal. The particular nature, location, and scope to the proposed development defines the degree of drainage detail. One or more of the following levels of submittal may be required based on the following:

1. Conceptual Grading and Drainage Plan: Required for approval of Site Development Plans greater than five (5) acres and Sector Plans.

2. Drainage Plans: Required for building permits, grading permits, paving permits and site plans less than five (5) acres.

3. **Drainage Report**: Required for subdivision containing more than ten (10) lots or constituting five (5) acres or more.

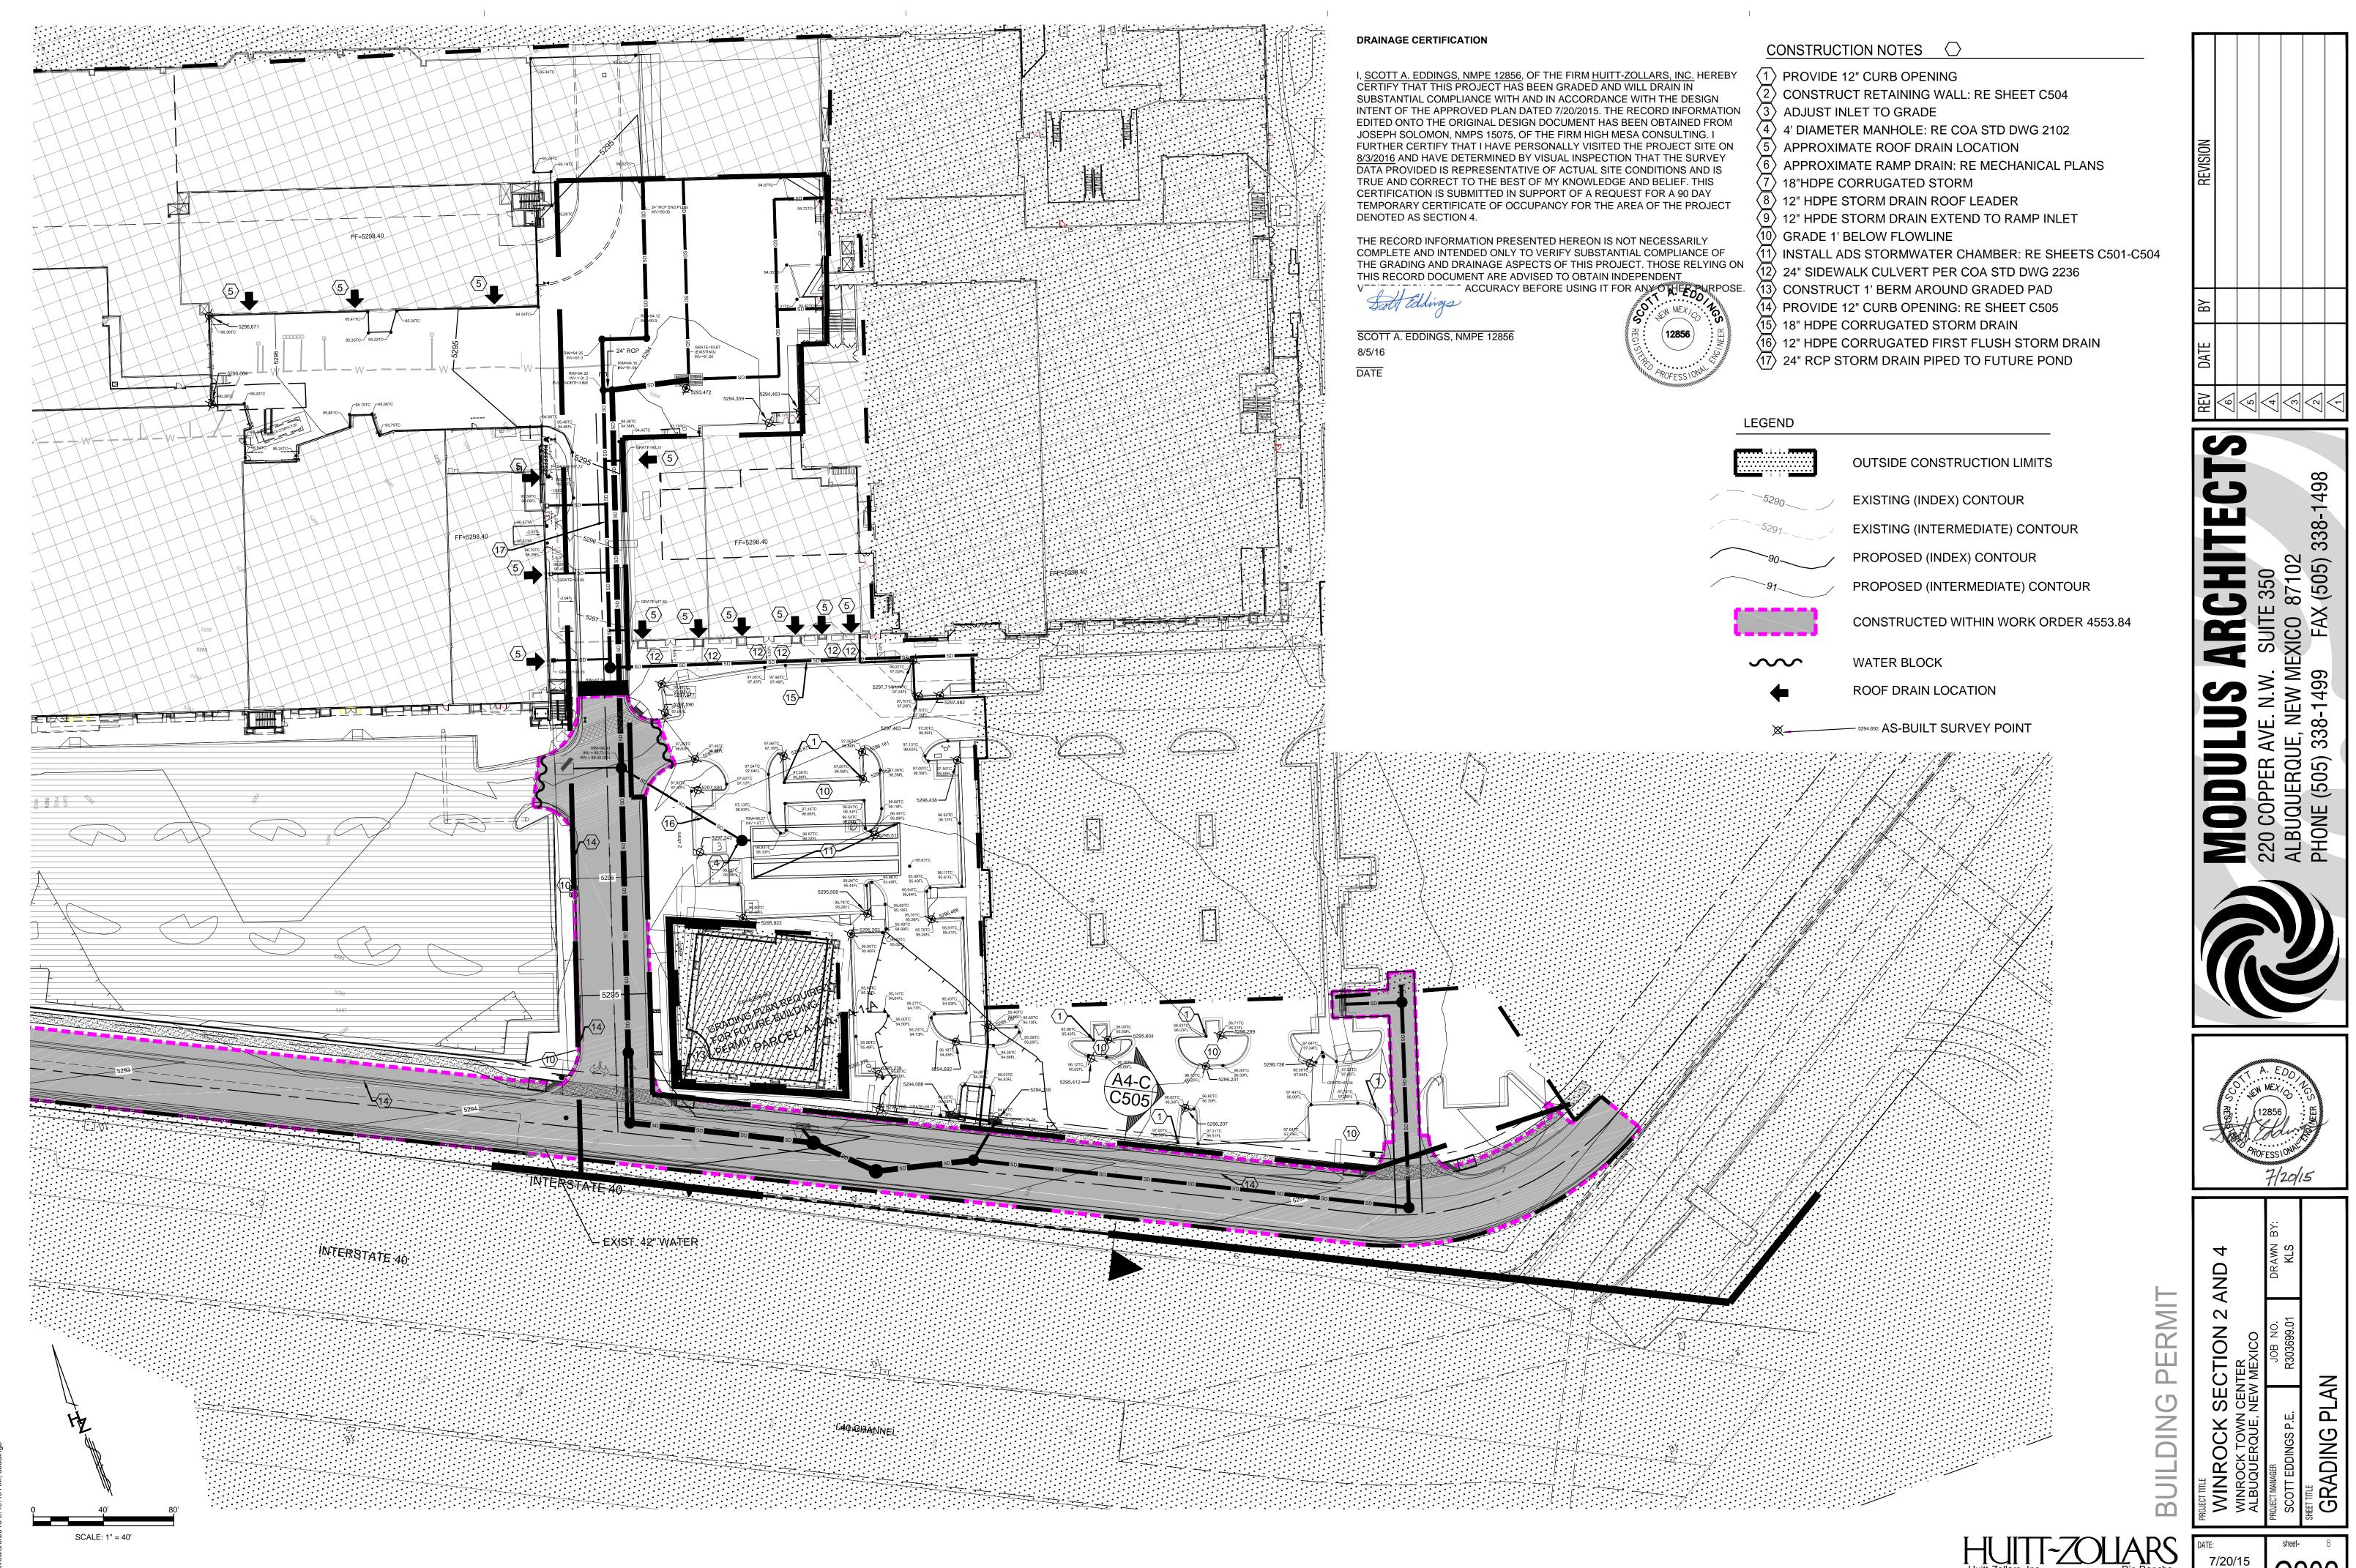

В

LARS Rio Rancho

SCALE:

1"=40'

IUF 333 Rio Rancho Drive NE, Suite 101 Rio Rancho, New Mexico 87124 Phone (505) 892-5141 Fax (505) 892-3259

