

# CITY OF ALBUQUERQUE



April 19, 2017

Jake Bordenave, P.E., P.S.  
Bordenave Designs  
PO Box 91194  
Albuquerque, NM 87199

RE: **Garcia Honda Gen 3 Service Bldg**  
**8301 Lomas NE**  
**Request for Certificate of Occupancy – Permanent**  
**Hydrology Final Inspection - Disapproved**  
**Engineer's Stamp Date 8/29/18 (J19D072)**  
**Certification Dated: 4/12/18**

Dear Mr. Bordenave,

Based on the certification received 4/12/18, this submittal cannot be approved for release of Certificate of Occupancy (Permanent) by Hydrology until the following are corrected:

1. The Drainage Certification language, per DPM Ch. 22, Section 7, is missing.
2. The sidewalk culverts need to be built to city standards, refer to Standard Drawing 2236 for correct construction:
  - a. The smooth rod, welded to the front of the steel plat and free of burrs and sharp edges was missing from all culverts.
  - b. All screws need to be tack welded or ground down to discourage removal and theft.
  - c. The sidewalk culvert described in keyed note 19 has several screws that were not countersunk and are left projecting above the plate.
  - d. The sidewalk culvert described in keyed note 20 is not flush with the sidewalk, creating a trip hazard.
  - e. The sidewalk described by keyed note 21, needs to be removed and rebuilt as two culverts as stated in the approved grading plan. Per drawing 2236, single culverts shall not exceed 24" wide.

If you have any questions, you can contact me at 924-3695 or [dpeterson@cabq.gov](mailto:dpeterson@cabq.gov).

Sincerely,

Dana Peterson, P.E.  
Senior Engineer, Planning Dept.  
Development and Review Services



# City of Albuquerque

Planning Department

Development & Building Services Division

## DRAINAGE AND TRANSPORTATION INFORMATION SHEET (REV 09/2015)

Project Title: GARCIA HONDA Building Permit #: 2013-18065 City Drainage #: J19/D072  
DRB#: \_\_\_\_\_ EPC#: \_\_\_\_\_ Work Order#: \_\_\_\_\_  
Legal Description: LOTS 19-24, BLDG 24, EAST END ADDITION  
City Address: 8301 LOMAS NE ALB, NM 87  
Engineering Firm: BORDENAVE DESIGNS Contact: \_\_\_\_\_  
Address: P.O. Box 91194, 87199  
Phone#: 823-1344 Fax#: 821-9105 E-mail: jakebordenave@comcast.net  
Owner: GARCIA Contact: \_\_\_\_\_  
Address: 8301 LOMAS NE, ALB, NM, 87110  
Phone#: \_\_\_\_\_ Fax#: \_\_\_\_\_ E-mail: \_\_\_\_\_  
Architect: V.H. GILBERT Contact: M. Lee  
Address: 2428 BAYLOR SE 87106  
Phone#: 247-9955 Fax#: \_\_\_\_\_ E-mail: \_\_\_\_\_  
Other Contact: \_\_\_\_\_  
Address: \_\_\_\_\_ Contact: \_\_\_\_\_  
Phone#: \_\_\_\_\_ Fax#: \_\_\_\_\_ E-mail: \_\_\_\_\_

Check all that Apply:

### DEPARTMENT:

- ☒ HYDROLOGY/ DRAINAGE  
☐ TRAFFIC/ TRANSPORTATION  
☐ MS4/ EROSION & SEDIMENT CONTROL

### TYPE OF SUBMITTAL:

- ☐ ENGINEER/ ARCHITECT CERTIFICATION  
☐ CONCEPTUAL G & D PLAN  
☒ GRADING PLAN RESUBMIT  
☐ DRAINAGE MASTER PLAN  
☐ DRAINAGE REPORT  
☐ CLOMR/LOMR  
☐ TRAFFIC CIRCULATION LAYOUT (TCL)  
☐ TRAFFIC IMPACT STUDY (TIS)  
☒ EROSION & SEDIMENT CONTROL PLAN (ESC)  
☐ OTHER (SPECIFY) \_\_\_\_\_

### CHECK TYPE OF APPROVAL/ACCEPTANCE SOUGHT:


- ☒ BUILDING PERMIT APPROVAL  
☒ CERTIFICATE OF OCCUPANCY  
☐ PRELIMINARY PLAT APPROVAL  
☐ SITE PLAN FOR SUB'D APPROVAL  
☐ SITE PLAN FOR BLDG. PERMIT APPROVAL  
☐ FINAL PLAT APPROVAL  
☐ SIA/ RELEASE OF FINANCIAL GUARANTEE  
☐ FOUNDATION PERMIT APPROVAL  
☐ GRADING PERMIT APPROVAL  
☐ SO-19 APPROVAL  
☐ PAVING PERMIT APPROVAL  
☐ GRADING/ PAD CERTIFICATION  
☐ WORK ORDER APPROVAL  
☐ CLOMR/LOMR  
☐ PRE-DESIGN MEETING  
☐ OTHER (SPECIFY) \_\_\_\_\_

IS THIS A RESUBMITTAL?: ☐ Yes ☒ No

DATE SUBMITTED: 04/12/18 By: [Signature]

COA STAFF: \_\_\_\_\_ ELECTRONIC SUBMITTAL RECEIVED: \_\_\_\_\_



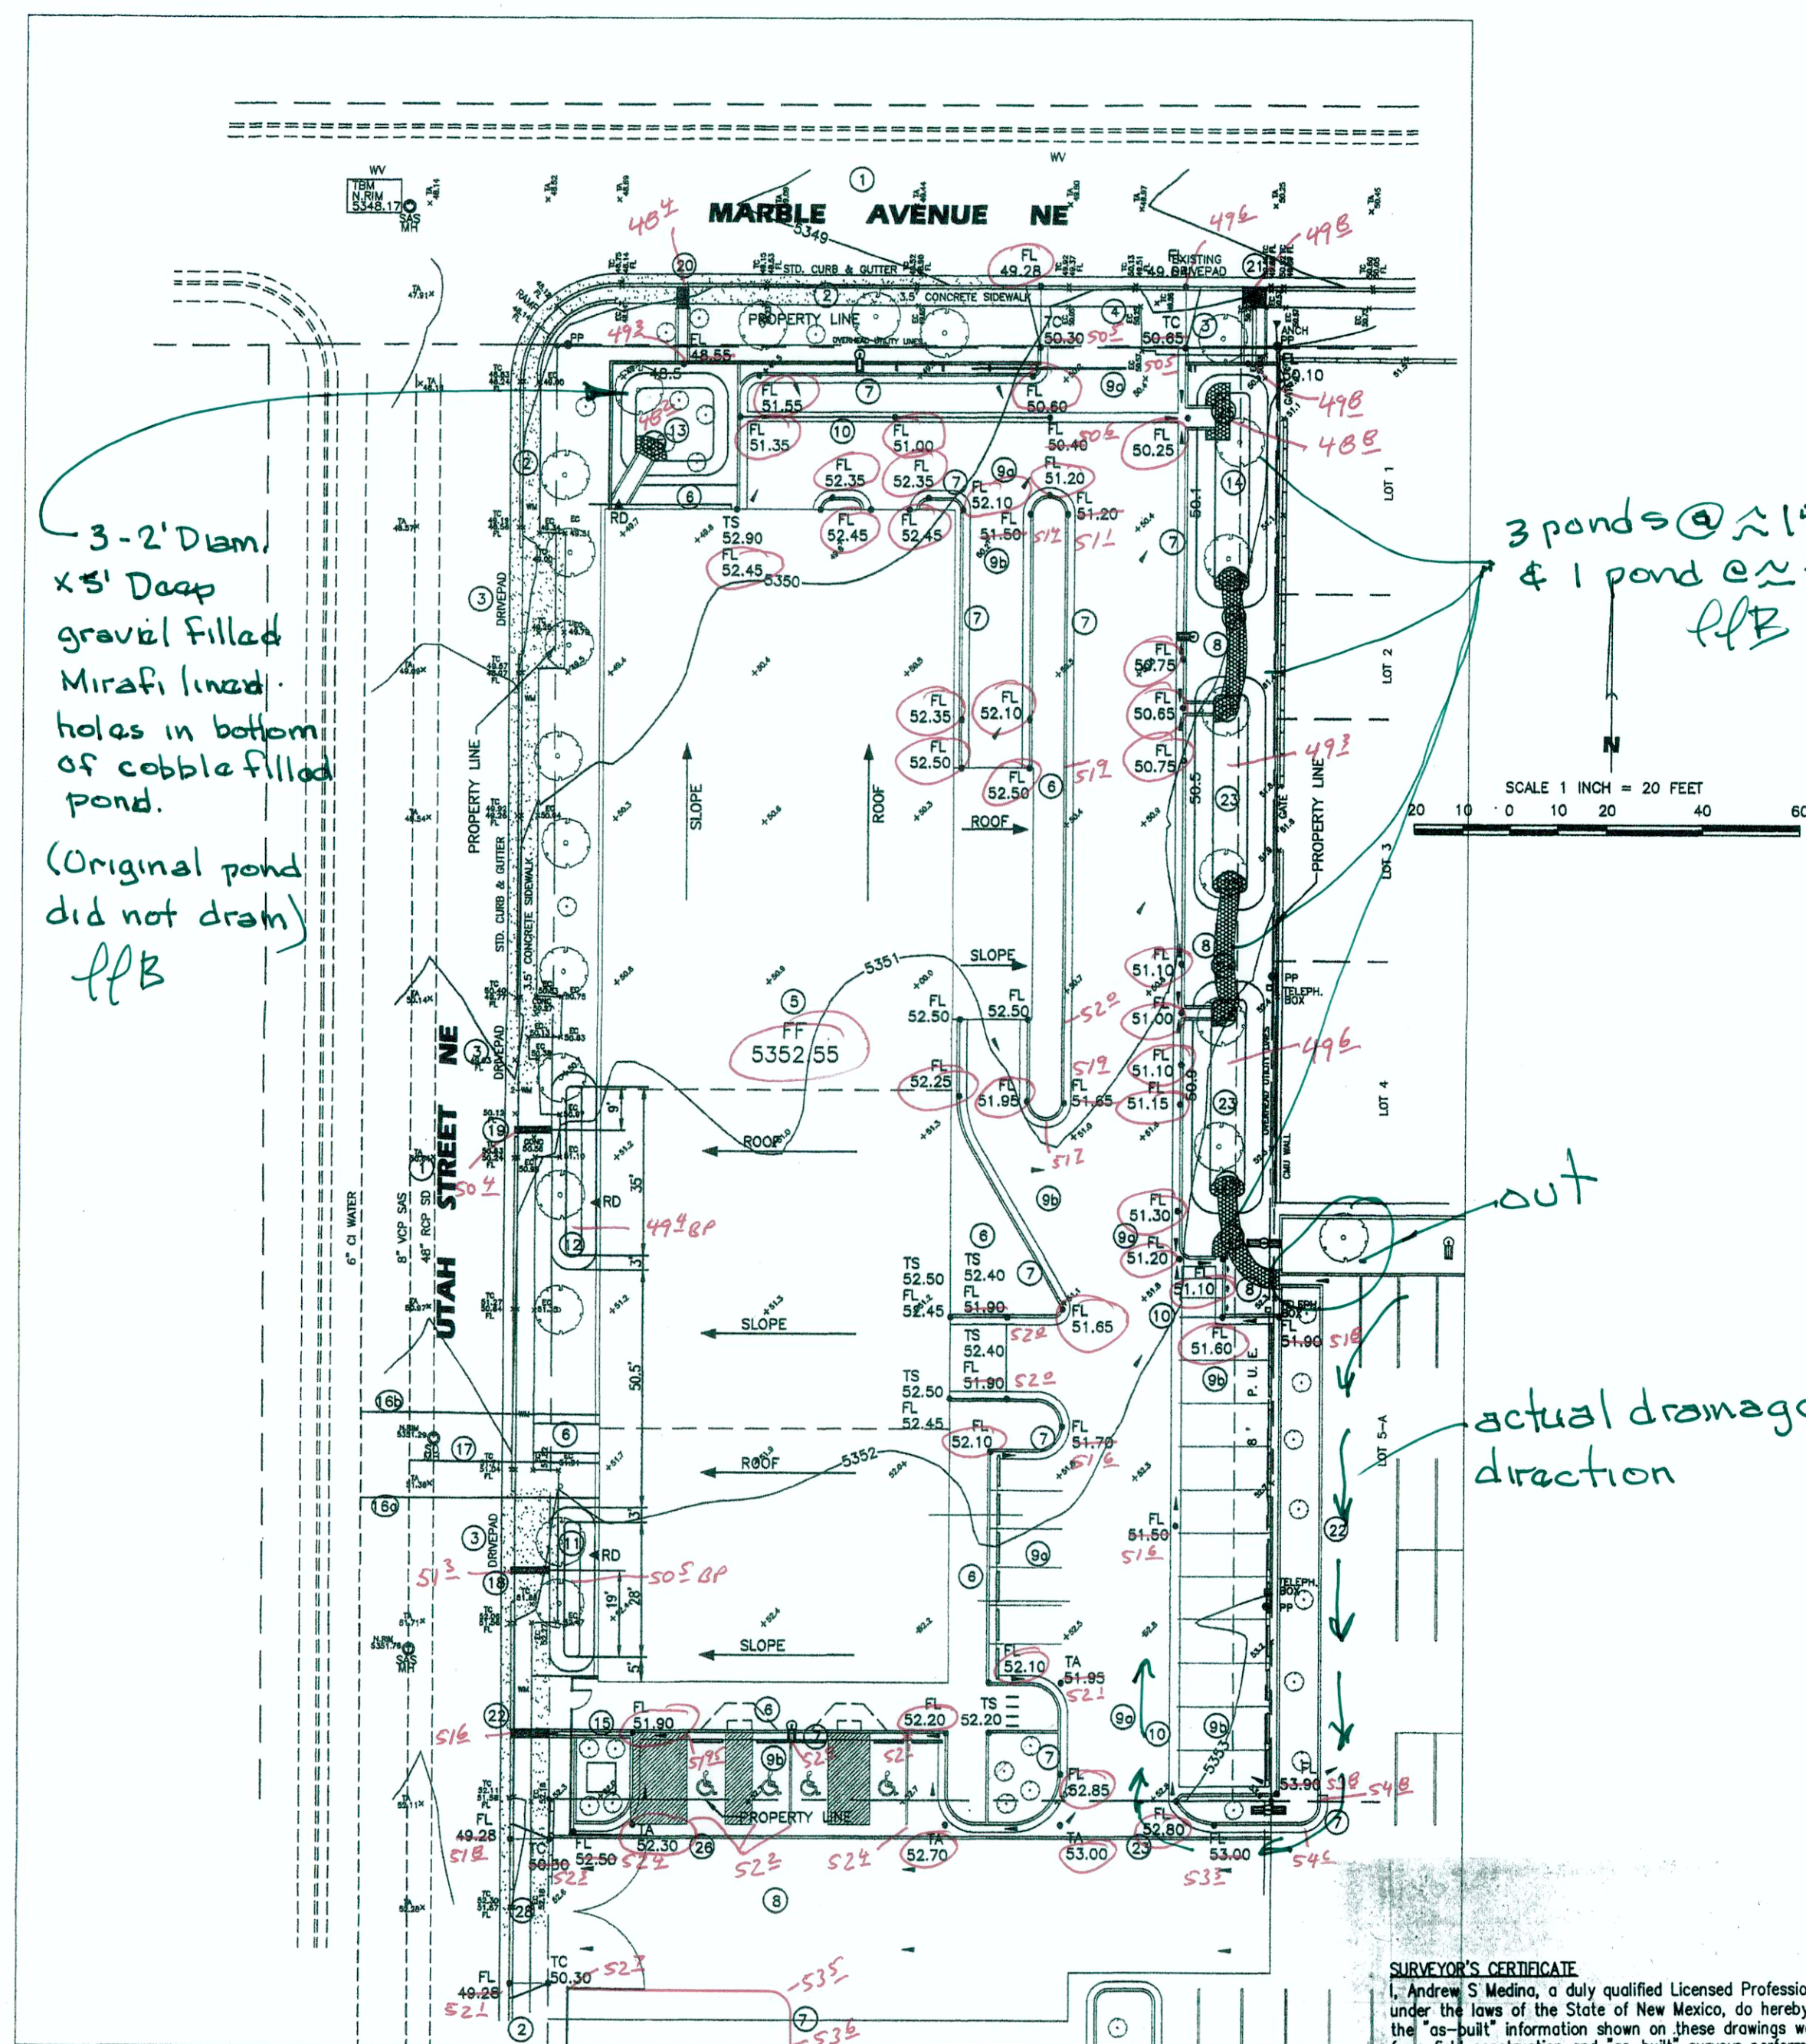


NOTE: ALL PUBLIC IMPROVEMENTS IN THE PUBLIC RIGHT-OF-WAY ARE INCLUDED ON A PUBLIC WORK ORDER. THIS INCLUDES REMOVAL OF EXISTING WATER SERVICE BOXES AND CAPPING WATER SERVICE AND SANITARY SERVICE LINES AND INSTALLATION OF NEW WATER AND SANITARY SEWER SERVICES. IT ALSO INCLUDES ITEMS 3, 4 AND 18 THRU 21 SHOWN ON THIS SHEET AND DEFINED IN THE KEYED NOTES AT RIGHT.

SURVEYOR'S CERTIFICATE  
I, Andrew S. Medina, a duly qualified Licensed Professional Surveyor under the laws of the State of New Mexico, do hereby certify that the "as-built" information shown on these drawings was obtained from field construction and "as-built" surveys performed by me or under my supervision that the "as-built" information shown on these drawings was added by me or under my supervision; and that this "as-built" information is true and correct to the best of my knowledge and belief. I am not responsible for any of the design concepts, calculations, engineering, or intent of the record drawings.

SANDIA LAND SURVEYING LLC  
15 CASA TERRENO  
ALBUQUERQUE, NM 87102  
505-257-5130


ANDREW S. MEDINA  
12649  
REGISTERED PROFESSIONAL SURVEYOR  
Date

## MOUNTABLE CURB

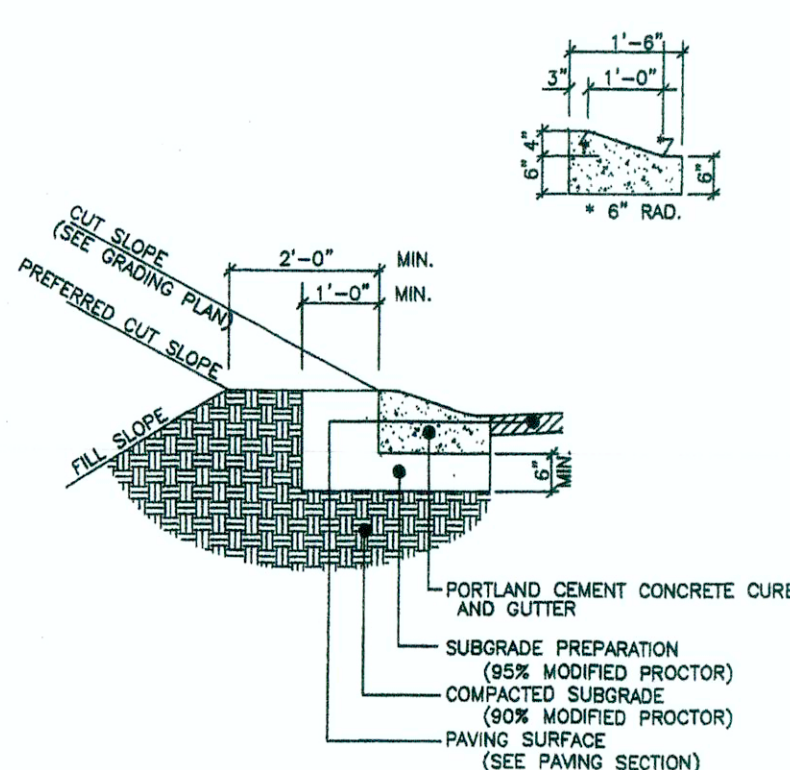


NOTE: PROVIDE CONTRACTION JOINTS AT 5 FEET ON CENTER AND EXPANSION JOINTS AT 50 FEET ON CENTER UNLESS OTHERWISE STATED ON SITE PLANS OR IF CURB ABUTS SIDEWALK; WHERE CURB JOINTS SHALL MATCH SIDEWALK JOINTS.

## 2' x 6" HIGH CONCRETE CURB

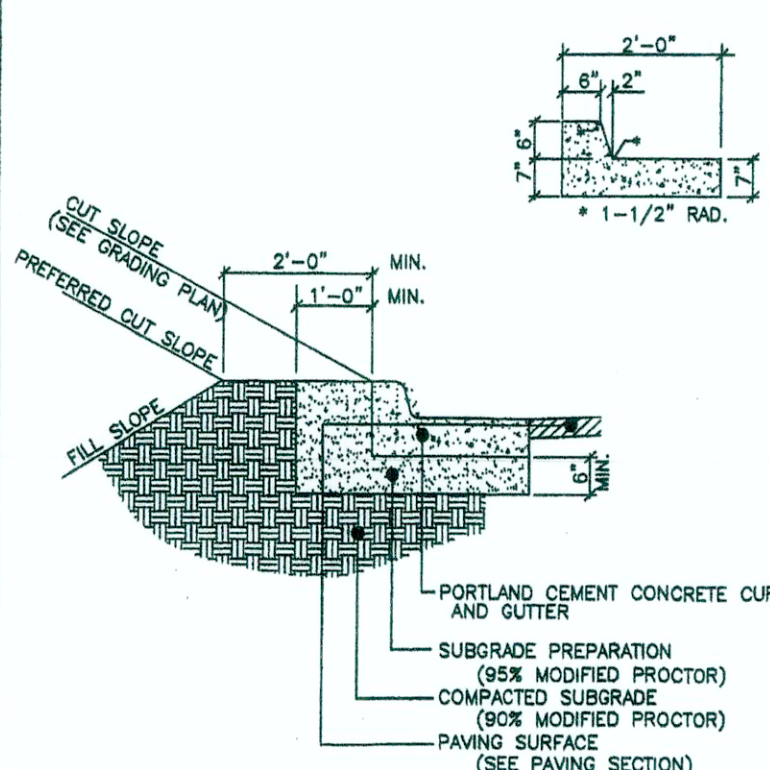


NOTE: PROVIDE CONTRACTION JOINTS AT 5 FEET ON CENTER AND EXPANSION JOINTS AT 50 FEET ON CENTER UNLESS OTHERWISE STATED ON SITE PLANS OR IF CURB ABUTS SIDEWALK; WHERE CURB JOINTS SHALL MATCH SIDEWALK JOINTS.

## SIDEWALK

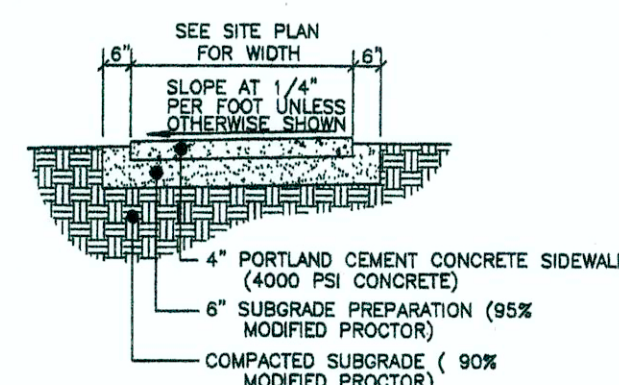


## VALLEY GUTTER

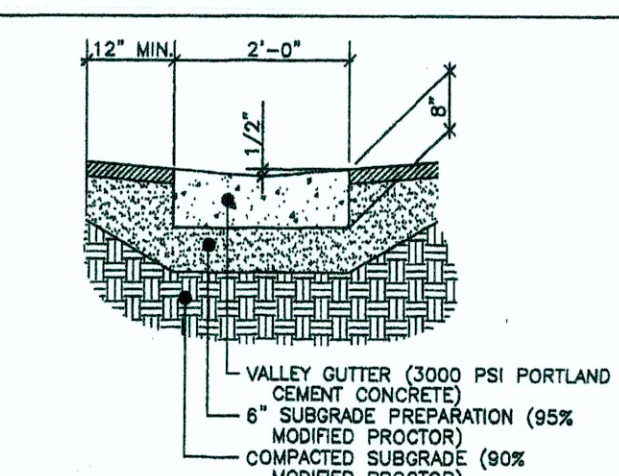


## DRAINAGE BASINS


SCALE 1" = 30'

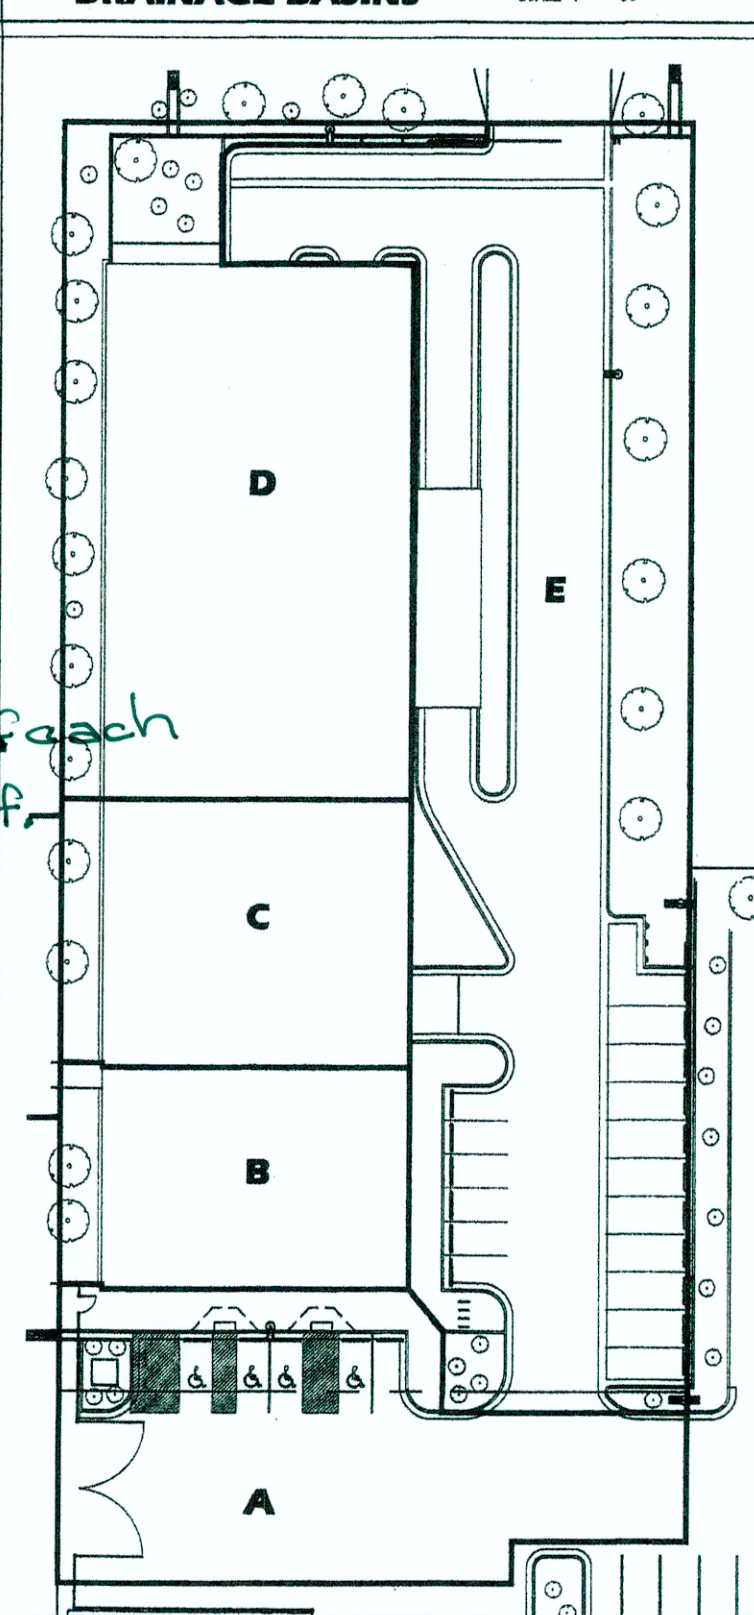


## TYPICAL GRADING - WEST SIDE OF BUILDING

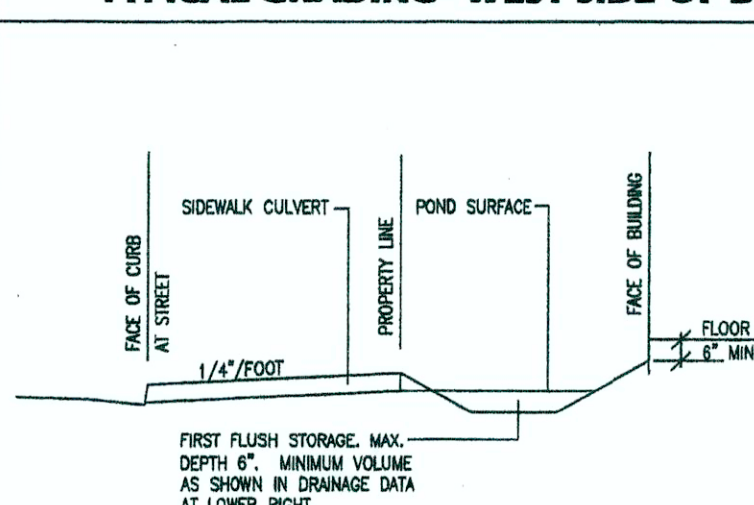

## CONCRETE CHANNEL

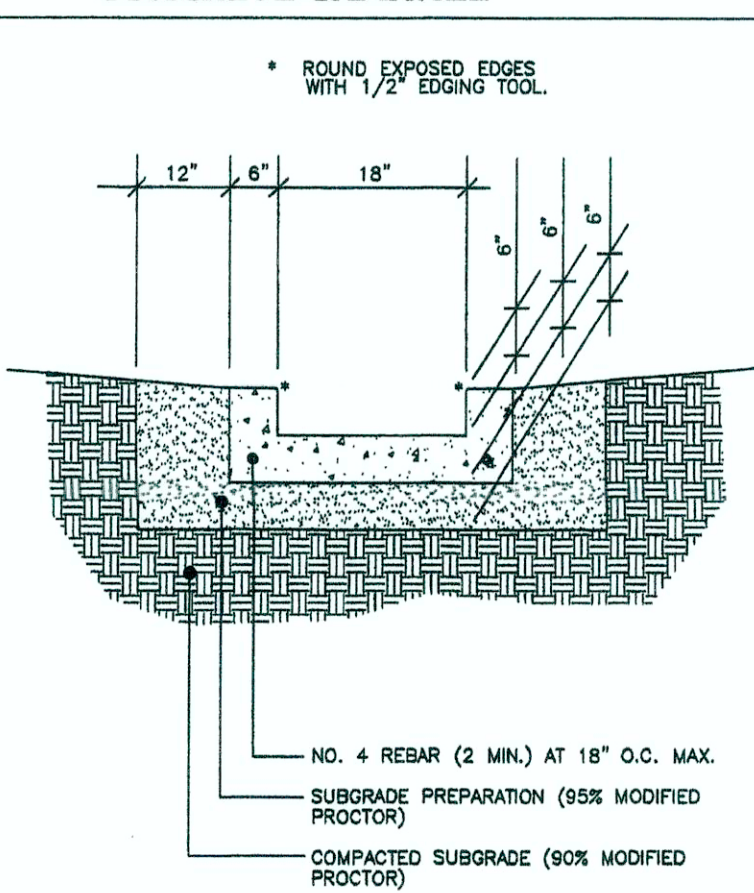

## ASPHALT PAVEMENT

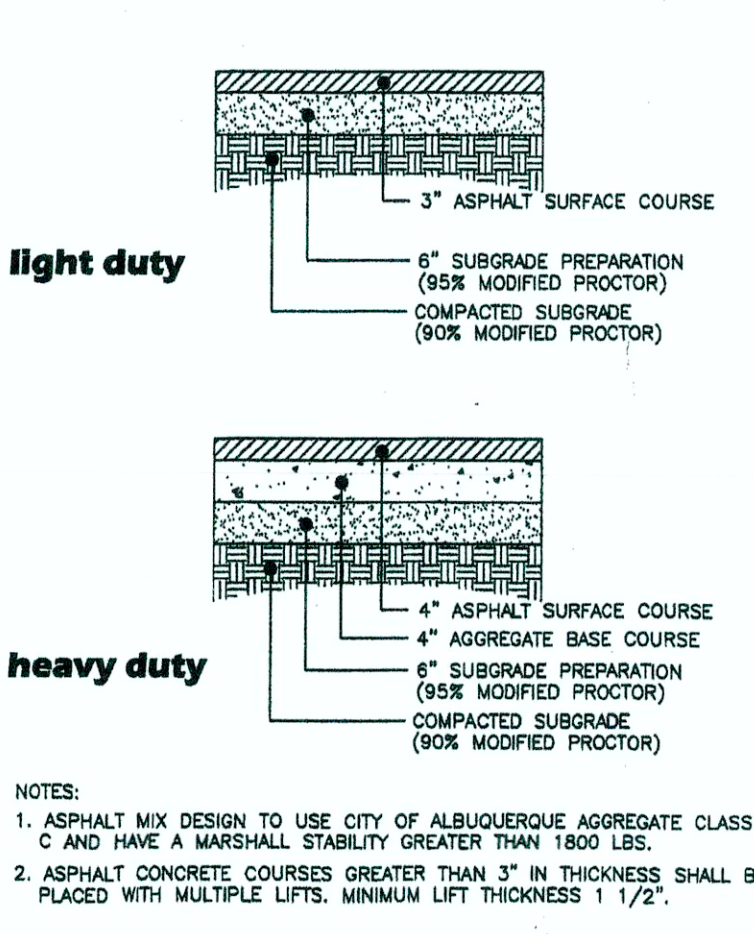

NOTES:  
1. ASPHALT MIX DESIGN TO USE CITY OF ALBUQUERQUE AGGREGATE CLASS C AND HAVE A MARSHALL STABILITY GREATER THAN 1800 LBS.  
2. ASPHALT CONCRETE COURSES GREATER THAN 3" IN THICKNESS SHALL BE PLACED WITH MULTIPLE LIFTS. MINIMUM LIFT THICKNESS 1 1/2".

## KEYED NOTES

- EXISTING PAVED PUBLIC STREET.
- EXISTING CONCRETE PUBLIC SIDEWALK.
- EXISTING CONCRETE DRIVE PAD. REMOVE DRIVE PAD AND CONSTRUCT STD. C&G 4" WIDE CONC. SIDEWALK PER COA STD. DETAILS 2415B & 2430 RESPECTIVELY.
- REMOVE CONCRETE CURB & GUTTER AND CONCRETE SIDEWALK. CONSTRUCT 30" CONCRETE DRIVE PAD PER COA STD. DET. 2405, SECTION D-D. CONSTRUCT PAD AFTER OTHER CONSTRUCTION IS COMPLETE.
- PROPOSED BUILDING. SEE ARCHITECTURAL FOR DETAILS.
- PROPOSED CONCRETE SIDEWALK. SEE DETAIL THIS SHEET.
- PROPOSED 2" WIDE, 6" HIGH CONCRETE CURB. SEE DETAIL THIS SHEET. SEE ARCHITECTURAL SITE PLAN FOR GEOMETRY.
- EXISTING ASPHALT PAVEMENT TO REMAIN.
- PROPOSED HEAVY DUTY ASPHALT. SEE DETAIL THIS SHEET.
- PROPOSED LIGHT DUTY ASPHALT. SEE DETAIL THIS SHEET.
- PROPOSED CONCRETE VALLEY GUTTER. SEE DETAIL THIS SHEET.
- PROPOSED WATER HARVESTING POND. MINIMUM STORAGE VOLUME-111 C.F. MIN. STORAGE DEPTH 7" INCHES BELOW CULVERT INLET.
- PROPOSED WATER HARVESTING POND. MINIMUM STORAGE VOLUME-135 C.F. MIN. STORAGE DEPTH 7" INCHES BELOW CULVERT INLET.
- PROPOSED WATER HARVESTING POND. MINIMUM STORAGE VOLUME-272 C.F. MIN. STORAGE DEPTH 10" INCHES BELOW CULVERT INLET.
- PROPOSED WATER HARVESTING POND. MINIMUM STORAGE VOLUME-504 C.F. MIN. STORAGE DEPTH 12" INCHES BELOW CULVERT INLET.
- PROPOSED 2" WIDE CONCRETE CHANNEL. SEE DETAIL THIS SHEET.
- 6" UNMETERED WATER FIRE SERVICE.
- 1-1/2" WATER METER w/ 2" WATER LINE.
- 4" SANITARY SEWER SERVICE.
- PROPOSED 9" SIDEWALK CULVERT. INLET INVERT 51.31 OUTLET INVERT 51.11.
- PROPOSED 11" SIDEWALK CULVERT. INLET INVERT 50.40 OUTLET INVERT 50.20.
- PROPOSED 24" WIDE CONCRETE CHANNEL. PER DETAIL THIS SHEET AND DOUBLE BARREL 21" SIDEWALK CULVERT PER COA STD. DWG 2236. INLET INVERT 51.16 OUTLET INVERT 51.50.
- PROPOSED 18" WIDE CONCRETE CULVERT PER COA STD. DWG. 2236. INLET INVERT 51.60, OUTLET INVERT 51.50.
- PROPOSED WATER HARVESTING POND. APPROX. STORAGE VOLUME 500 C.F. MIN. STORAGE DEPTH 12" INCHES CURB FLOWLINE AT INLET.
- 36" WIDE DRY STREAM. SEE DETAIL THIS SHEET.
- ENERGY DISSIPATOR. SEE DETAIL THIS SHEET.
- REMOVE EXISTING CONCRETE HEADER CURB IMMEDIATELY PRIOR TO INSTALLING NEW PAVEMENT.
- SOUTH LIMIT OF DRAINAGE STUDY.
- REMOVE CONCRETE CURB & GUTTER AND CONCRETE SIDEWALK. CONSTRUCT 30" CONCRETE DRIVE PAD PER COA STD. DET. 2425, SECTION D-D. CONSTRUCT PAD AFTER OTHER CONSTRUCTION IS COMPLETE.

## DRAINAGE DATA

CONDITION	STORM	TREATMENT	TREATMENT	EXCESS	PEAK	RUNOFF	RUNOFF
	PERIOD	TYPE	AREA	PRECIPITATION	RUNOFF VOLUME	RATE	
				(inches)	(cu. ft.)	(cfs)	
EXISTING	10	A	0.19	0.88	0.00	0.00	
		B	0.36	1.19	280	0.27	
		C	0.82	2	0.00	0.00	
		D	4184	1.5	3.39	5241	3.20
		E	5174			5535	3.63
DEVELOPED	10	A	0.19	0.88	0.00	0.00	
		B	0.36	1.19	228	0.20	
		C	0.82	2	0.00	0.00	
		D	4184	1.5	3.39	5523	3.44
		E	5174			5748	3.64
100	A	0.19	0.88	0.00	0.00	0.00	
	B	0.36	1.19	2.6	748	0.68	
	C	0.82	2	3.45	0.00	0.00	
	D	4184	2.38	5.02	8248	4.83	
	E	5174			8893	5.41	
100	A	0.19	0.88	1.87	0.00	0.00	
	B	0.36	1.19	2.6	11	0.01	
	C	0.82	2	3.45	0.00	0.00	
	D	4184	2.38	5.02	1611	0.94	
	E	5174			1621	0.96	
100	A	0.19	0.88	1.87	0.00	0.00	
	B	0.36	1.19	2.6	34	0.03	
	C	0.82	2	3.45	0.00	0.00	
	D	4184	2.38	5.02	924	0.54	
	E	5174			968	0.58	
100	A	0.19	0.88	1.87	0.00	0.00	
	B	0.36	1.19	2.6	202	0.16	
	C	0.82	2	3.45	0.00	0.00	
	D	4184	2.38	5.02	1886	1.11	
	E	5174			2088	1.26	
100	A	0.19	0.88	1.87	0.00	0.00	
	B	0.36	1.19	2.6	254	0.22	
	C	0.82	2	3.45	0.00	0.00	
	D	4184	2.38	5.02	3498	2.08	
	E	5174			3780	2.27	


WATER HARVESTING VOLUME PER BASIN  
VOLUME = IMPERVIOUS AREA X (0.44-0.10)/12  
C.F.

A	8190	0	0	0	0
B	3828	111	0	0	0
C	4700	133	0	0	0
D	9590	272	0	0	0
E	17776	504	0	0	0


NOTE: MOST OF BASIN 'A' IS AN EXISTING PAVED AREA AND ONLY SHOWN FOR TOP TO CLARITY. THE BALANCE IS A TRANSITION FROM EXISTING PAVEMENT TO THE NEW BUILDING.

BASIN	FLOW RATE	NEW LENGTH	WATER LENGTH	USE L (N)
A	0.48	0.73	9	
B	0.58	0.88	11	
C	1.28	1.91	23	
D	2.27	3.45	42 (DOUBLE BARREL 21")	

## VICINITY MAP NO. J-19

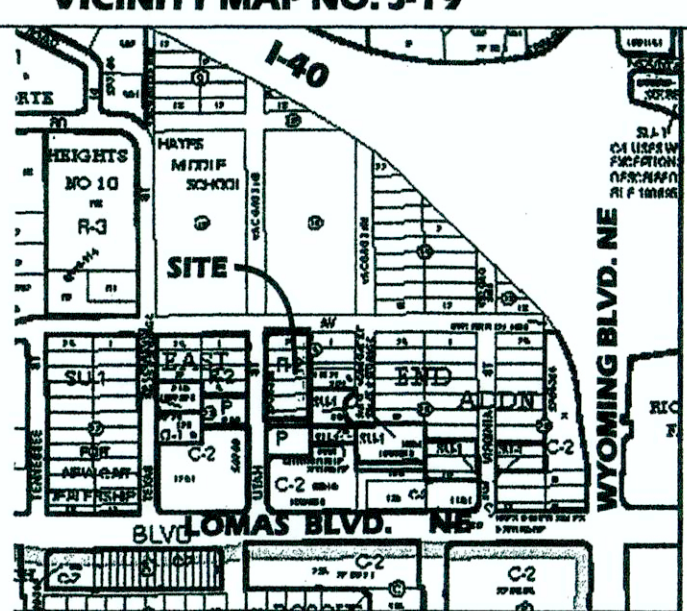

## FEMA FIRM PANEL NO. 358H

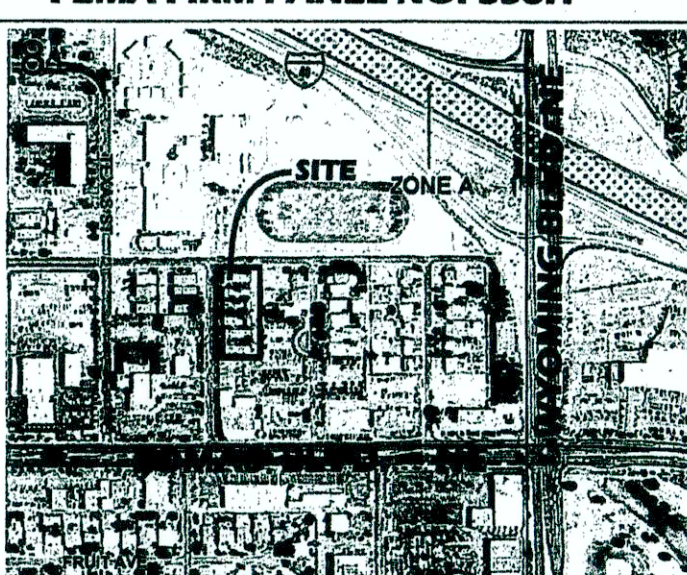


## LEGAL DESCRIPTION

LOTS 19 THRU 24, BLOCK 24, EAST END ADDITION

## PERMANENT BENCHMARK

ACS STATION 17-K19, ELEVATION 5544.389 (NAVD 1988)

## DRY STREAM/ ENERGY DISSIPATOR

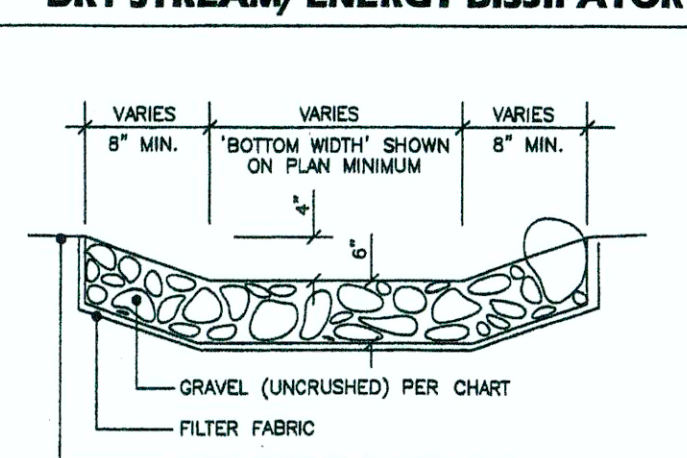

DRY STREAM	PERCENT BY VOL.	PERCENT BY VOL.	ENERGY DISSIPATOR	PERCENT BY VOL.	PERCENT BY VOL.
> 8"	0-5	0-5	> 6"	10-25	10-25
3"-8"	40-60	40-60	3"-6"	10-25	10-25
1"-3"	10-30	10-30	1"-3"	5-10	5-10
3/8"-1"	10-15	10-15	3/8"-1"	5-10	5-10
< 3/8"	0-5	0-5	< 3/8"	0	0

STREAM CONSTRUCTION NOTES:  
BOTTOM AND BANK WIDTHS SHALL VARY TO SIMULATE A NATURAL STREAM.  
STONES GREATER THAN 6" SHALL BE LIMITED TO THE BANK AREA.

DISSIPATOR CONSTRUCTION NOTES:  
DISSIPATOR SHALL BE FLAT. INCREASE STONE PORTION OF SECTION TO 10" THICKNESS.  
WIDTH OF DISSIPATOR TO BE AT LEAST 6" BEYOND THE APPROACH CHANNEL WIDTH AND 8' LONG IN THE DIRECTION OF TRAVEL.

## DRAINAGE NOTES

- THE SITE WAS PREVIOUSLY DEVELOPED AS AN APARTMENT COMPLEX. THAT CONSTRUCTION HAS BEEN RAZED AND THE SITE IS BARE. THE PROPOSED DEVELOPMENT WILL BE LANDSCAPED ON THE PERIMETER AND THE BALANCE OF THE SITE WILL BE DEVELOPED WITH IMPERVIOUS SURFACES.
- RUNOFF IS ROUTED THROUGH RETENTION PONDS. RUNOFF VOLUMES FROM RAINFALL IN EXCESS OF 0.44 INCHES ON IMPERVIOUS SURFACES IS ALLOWED TO OVERFLOW FROM THE PONDS TO ABUTTING STREETS VIA CONCRETE CHANNELS AND SIDEWALK CULVERTS.
- THE SITE IS LOCATED IN RAINFALL ZONE 3. THERE WILL BE A VERY SLIGHT INCREASE 0.13 CFS (FROM THE EXISTING DEVELOPMENT CONDITIONS) IN RUNOFF VOLUMES AND FLOW RATES. SEE TABLE (AT LEFT) FOR EXISTING AND DEVELOPED FLOW RATES AND RUNOFF VOLUMES.
- THE SITE IS LOCATED IN AN AREA DESIGNATED "ZONE X" PER FEMA FIRM MAP NO. 358H, DATED AUGUST, 2012.
- EXISTING TOPOGRAPHY FOR THE SITE WAS OBTAINED BY HARRIS SURVEYING, INC. IN APRIL, 2017.

## LEGEND

TEMPORARY BENCHMARK	LEGEND
GB	GROUND
FF	FINISH FLOOR
FG	FINISH GRADE (after landscaping)
FL	FLOWLINE
TA	TOP OF ASPHALT
TC	TOP OF CONCRETE
BC	TOP OF CURB
TP	TOP OF EARTH PAD
TS	TOP OF SIDEWALK
TW	TOP OF WALL
FM	FIRE HYDRANT
WM	WATER METER
WV	WATER VALVE
MH	MANHOLE
CB	CATCH BASIN GRATE
GM	GAS MANHOLE
GV	GAS VALVE
LP	LIGHT POLE
PP	POWER POLE
GW	GUY WIRE
PE	ELEC. TEL. OR CBL. PED.
OHU	OVERHEAD UTILITIES
RD/C	RD/C ROOF DRAINAGE POINT

## Van H. Gilbert Architect PC

ARCHITECTURE • INTERIORS • PLANNING

VHGA  
2428 Baylor Dr SE Albuquerque, NM 87108  
Tel 505-247-8985 Fax 505-247-1828  
E-mail info@vhgaarchitect.com  
Web Site www.vhgaarchitect.com

BORDENAVE DESIGNS  
P.O. BOX 91194, ALBUQUERQUE, NM 87199  
ph (505)823-1344 cell (505)480-8812  
email jakebordenave@comcast.net

GARCIA  
AUTOMOTIVE  
GROUP  
GARCIA HONDA -  
GENERATION 3 - NEW  
SERVICE BUILDING

8301 LOMAS BLVD,  
ALBUQUERQUE, NM  
87110

## PERMIT SET

Mark	Date	Description
	05/05/17	
Project Number	15918	
Drawn By	JJB	
Checked By	VAN H. GILBERT ARCHITECT	
Copyright ©	AS-BUILT	
SHEET TITLE	GRADING, DRAINAGE & UTILITY SERVICE PLAN	
	C-101	