
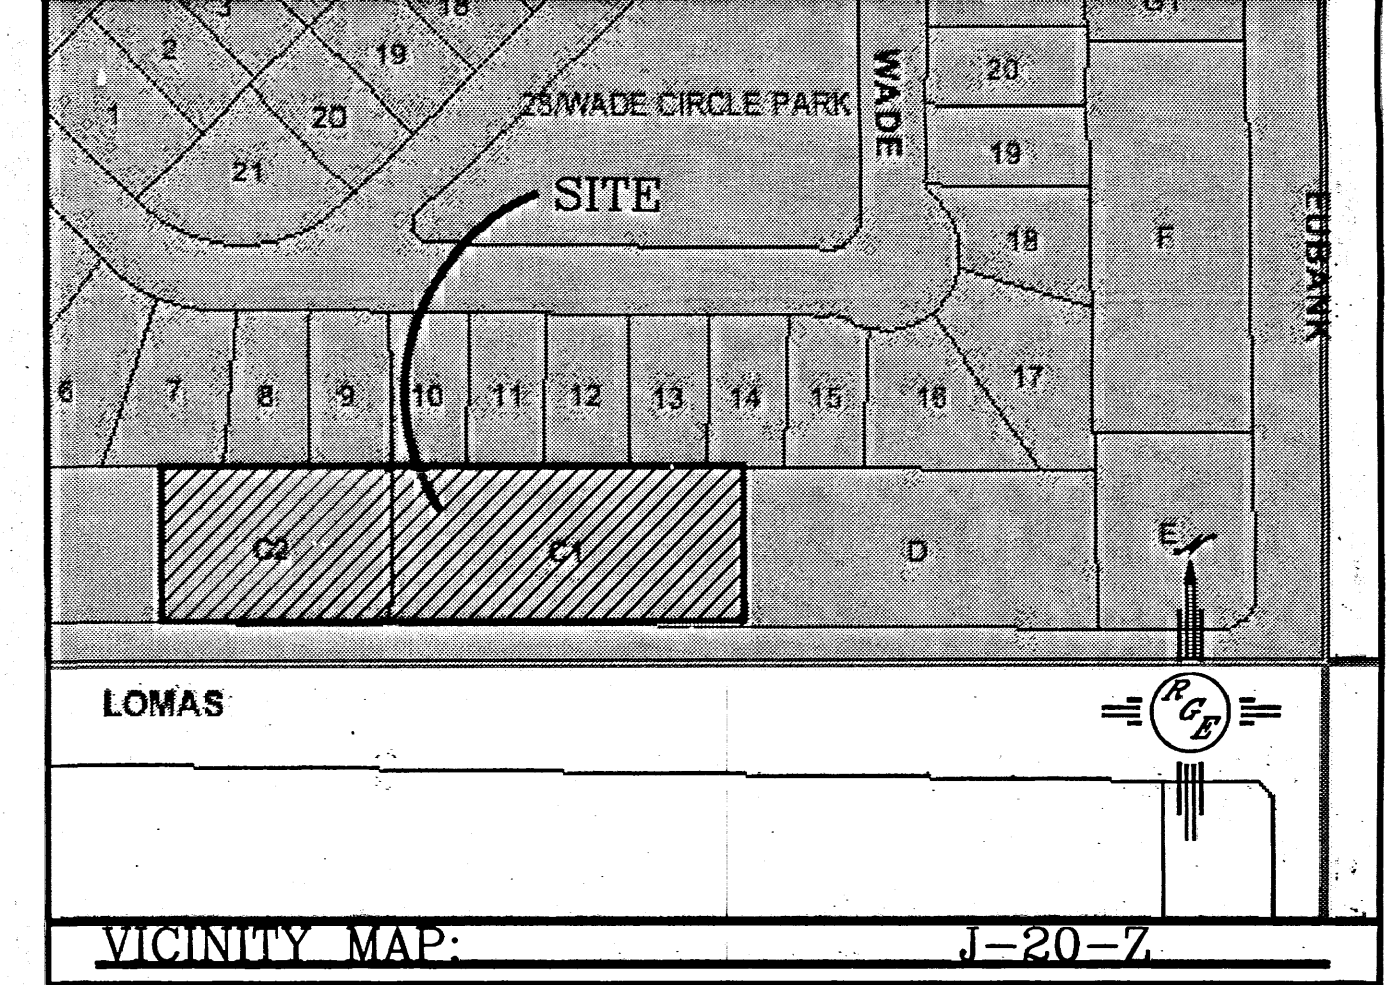


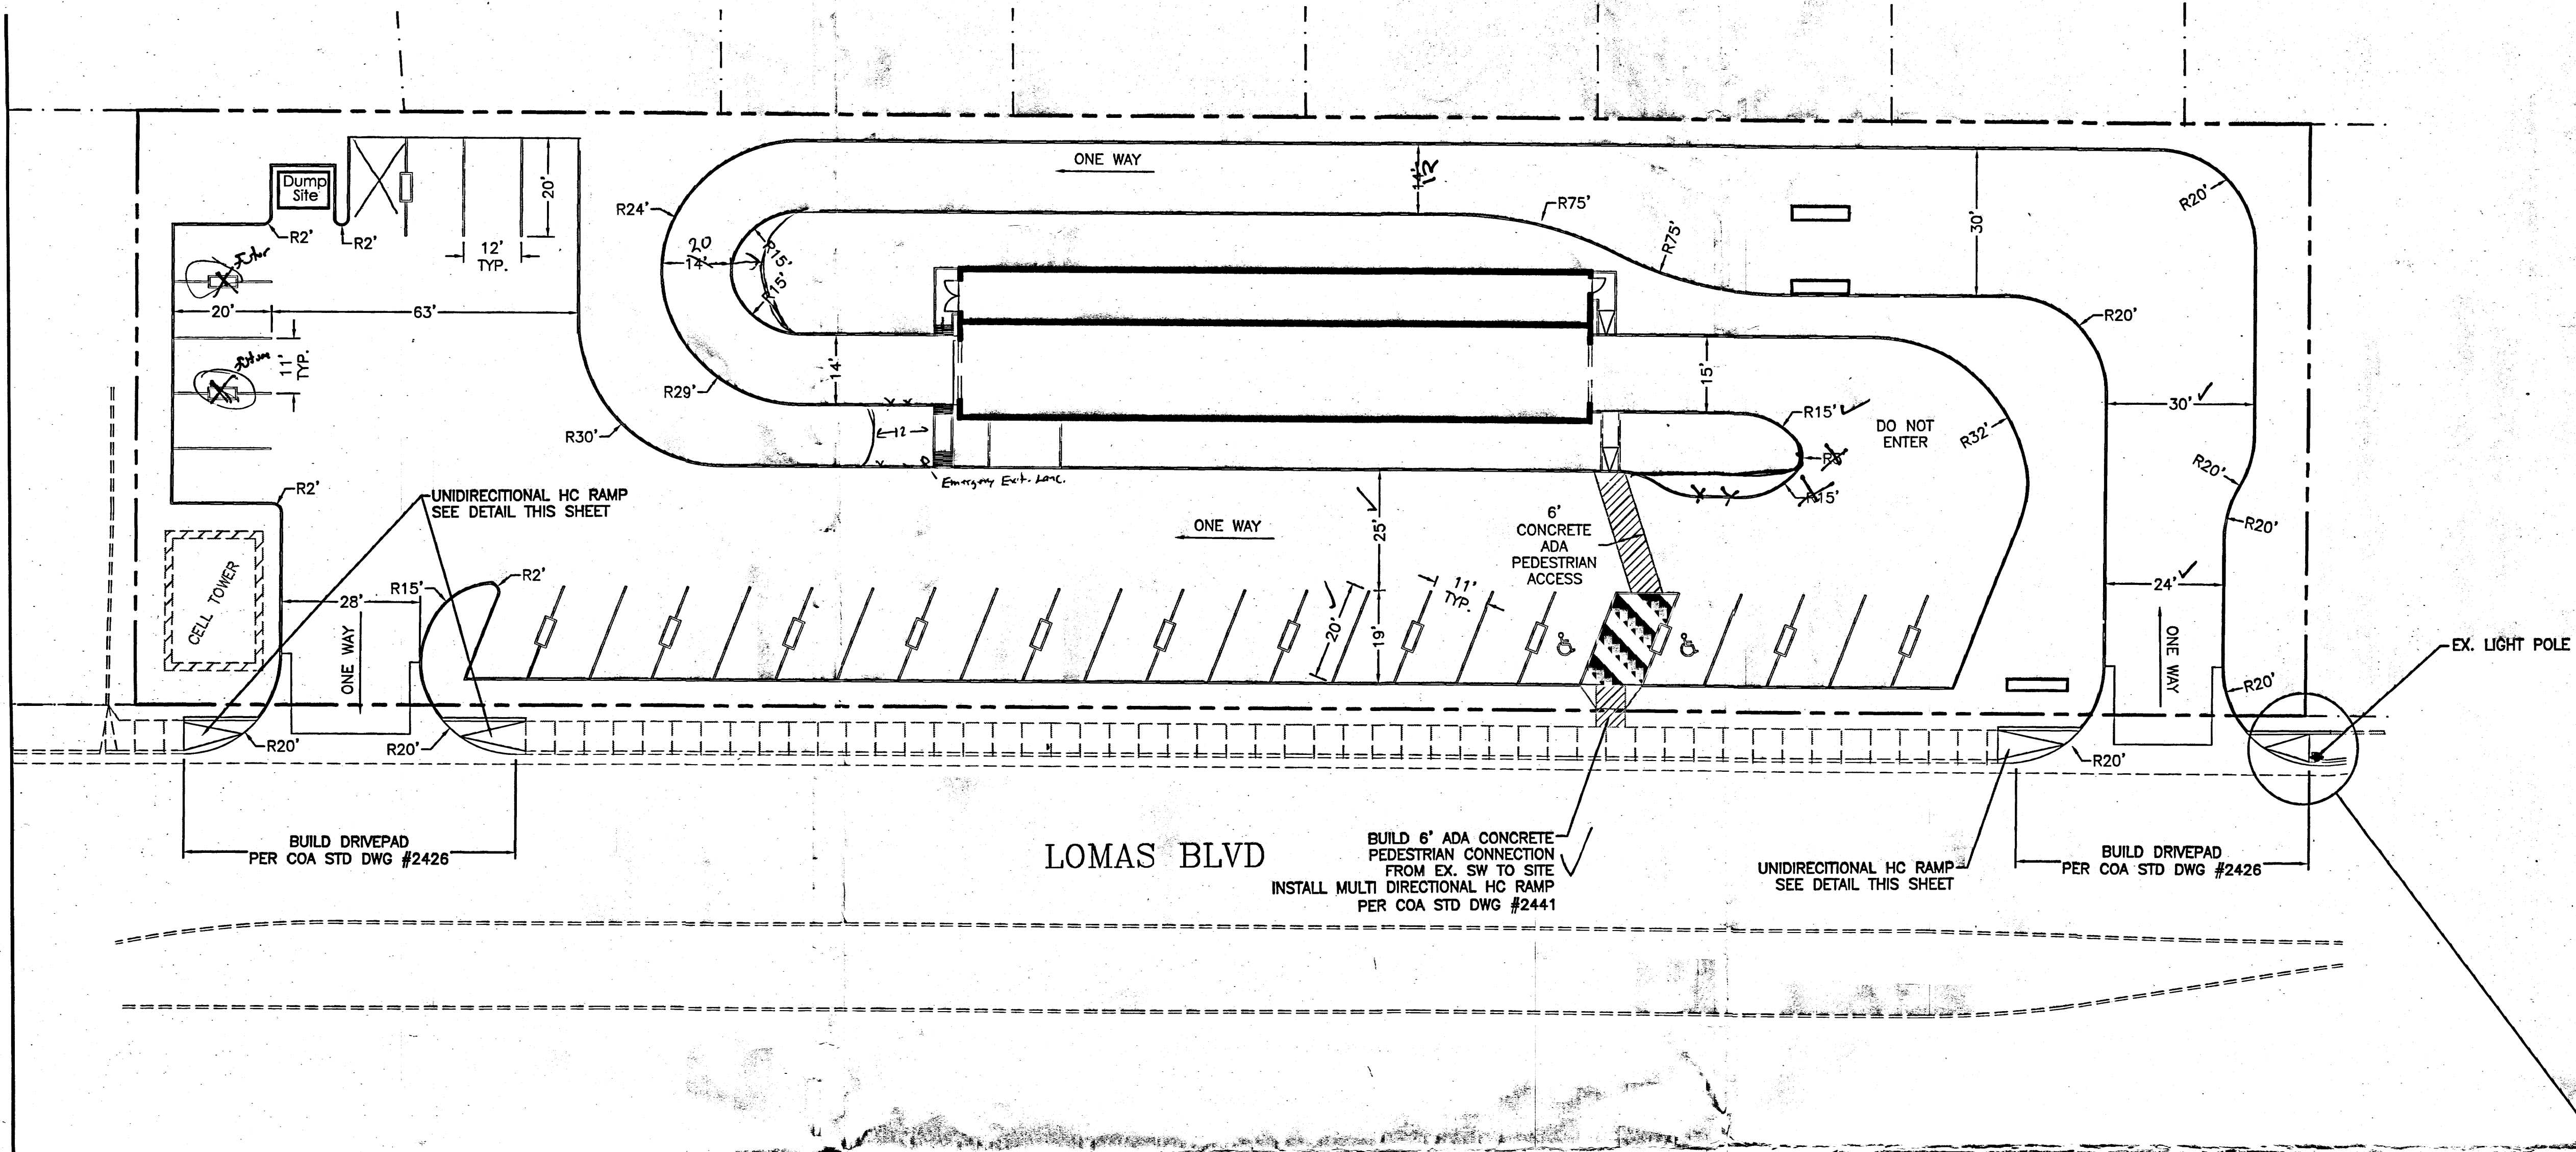

**LEGAL DESCRIPTION:**  
TRACTS C1 AND C2, LANDS OF GREVEY

**LEGEND**


- EXISTING CURB & GUTTER
- PROPOSED CURB & GUTTER
- BOUNDARY LINE
- EXISTING BOUNDARY LINE
- EXISTING SIDEWALK
- CENTERLINE
- RIGHT-OF-WAY

**PERMITS CALCULATIONS**

WAITING AREA/EQUIPMENT ROOM 15' / 200 SQFT  
1463 SQFT. / 200 = 8 SPACES

EMPLOYEE SPACES 15' / PER EMPLOYEE  
9 EMPLOYEES = 9 SPACES

TOTAL SPACES REQUIRED 17 SPACES  
TOTAL SPACES PROVIDED INCLUDING DRIVING AREAS 32 SPACES  
HC SPACES REQUIRED 28-35 = 2 SPACES  
HC SPACES PROVIDED = 2 SPACES

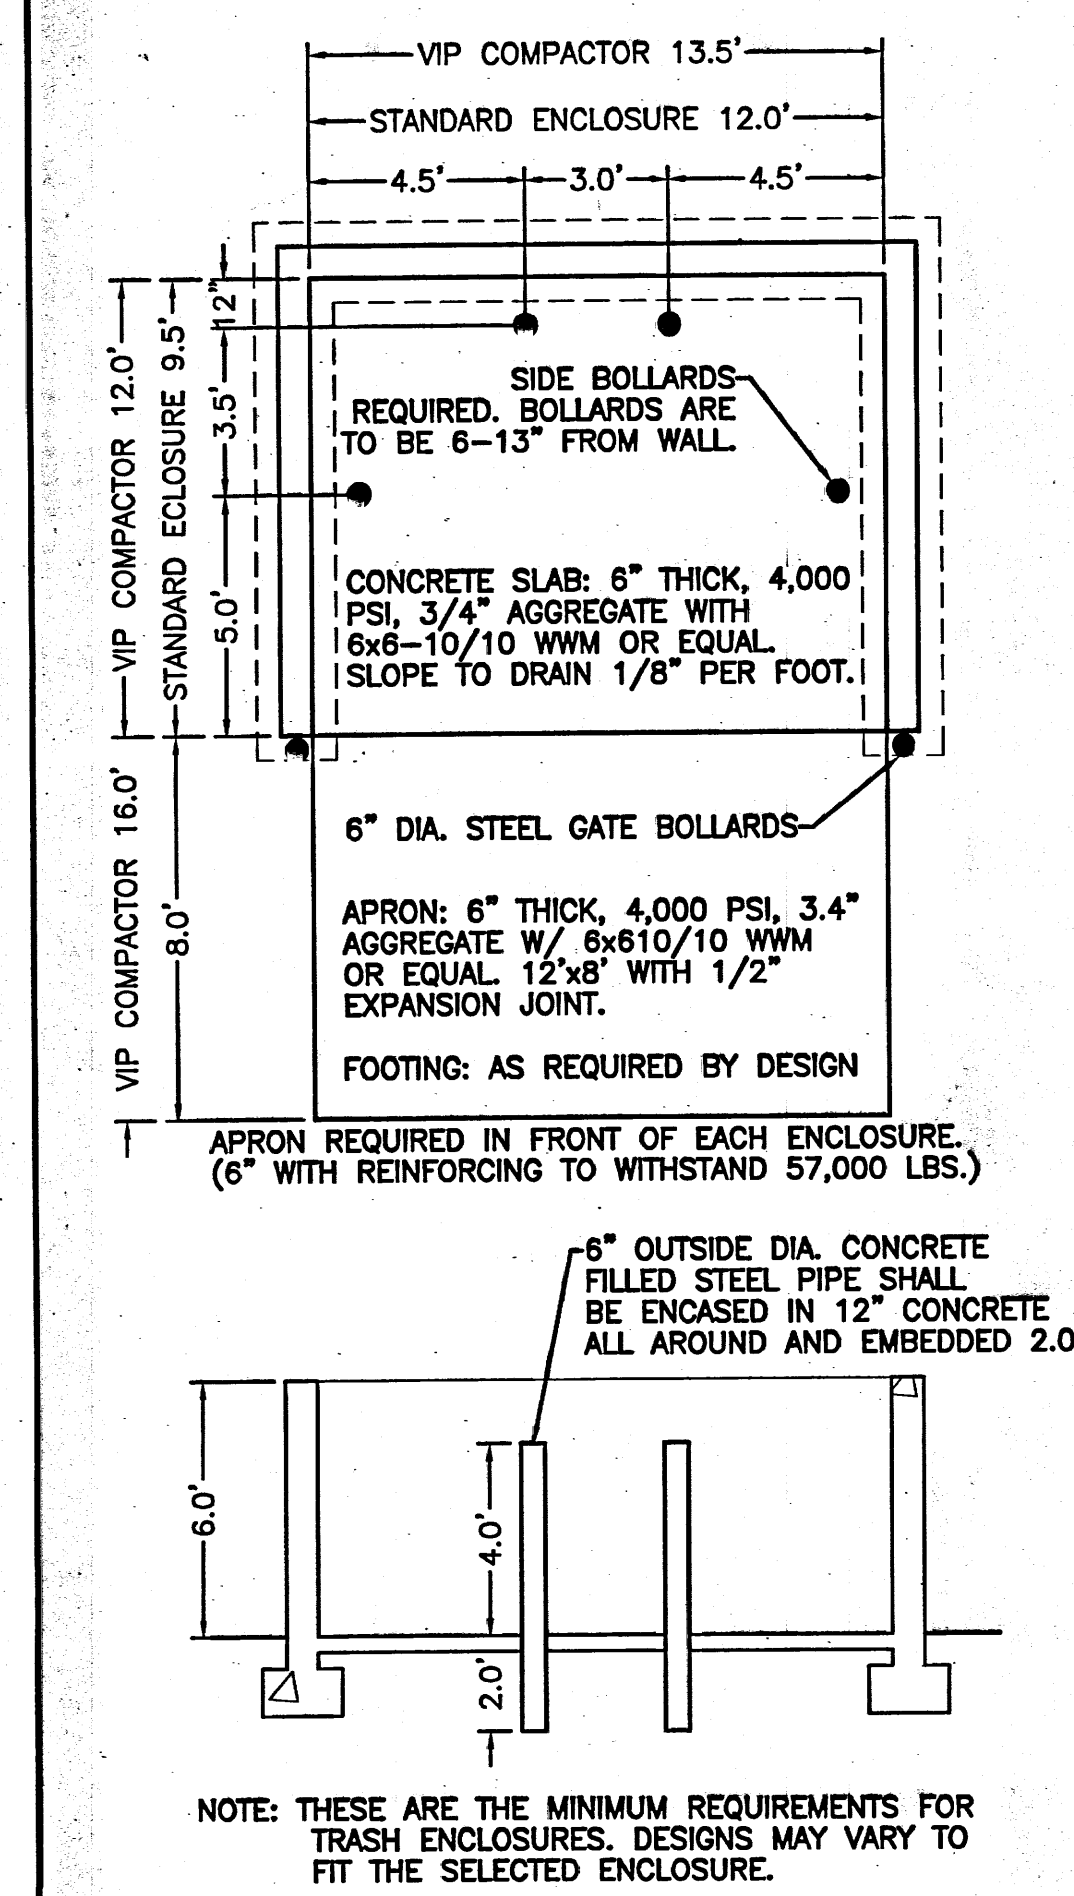


DUMPSTER ENCLOSURE DETAIL


I, David Soule, NMPE 14522, of the firm Rio Grande Engineering, hereby certify that this project has been graded and will be constructed in substantial compliance with and in accordance with the design intent of the approved TCL plan dated 5/6/10. The record information edited on the original design document has been performed by me or under my direct supervision and is true and correct to the best of my knowledge and belief. The as-built survey was provided by David Vigil, 8911. The certification is submitted in support of a request for Permanent Certificate of Occupancy. The record information presented herein is not necessarily complete and intended only to verify substantial compliance of the Traffic Circulation aspects of this project. Those relying on this record document are advised to obtain independent verification of its accuracy before using it for any other purpose.



TRUNCATED DOMES SHALL BE PER ADA GUIDELINES CONTRACTOR SHALL SUBMIT SPECS TO COA CONSTRUCTION ENGINEER FOR REVIEW AND APPROVAL PRIOR TO CONSTRUCTION


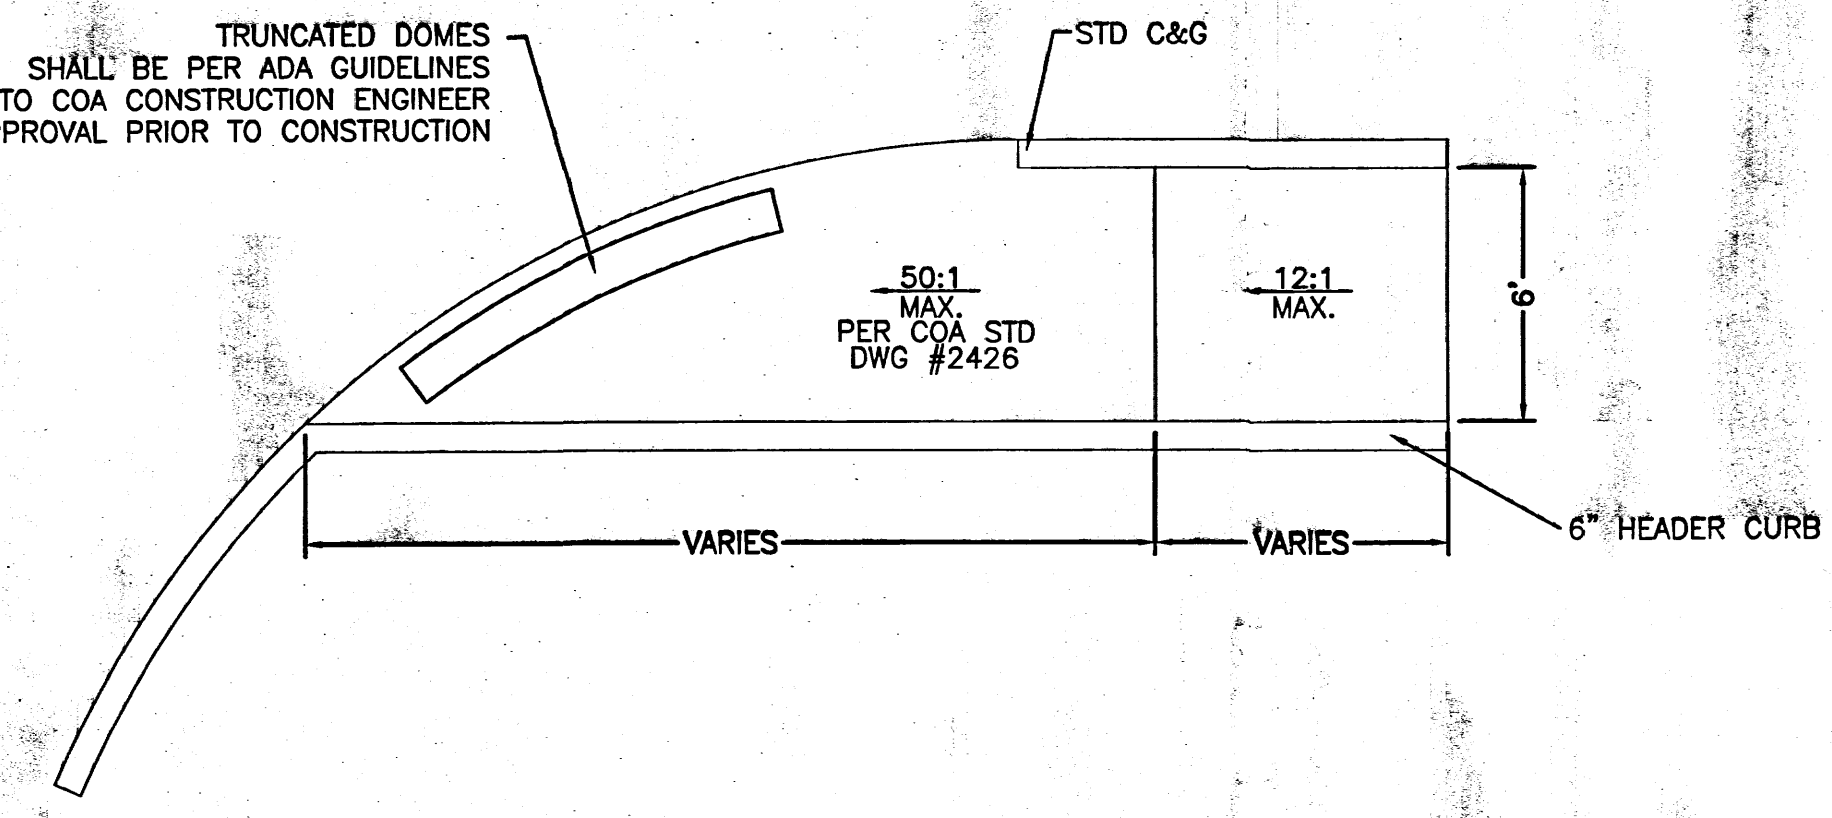


UNI-DIRECTIONAL WHEELCHAIR RAMP DETAIL (TYP.)

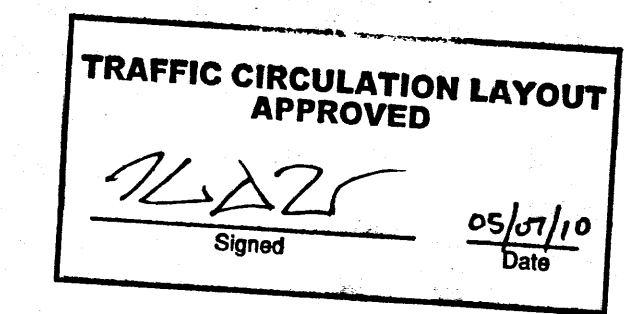


Public Infrastructure shown on these plans for information only and not part of approval. Separate DRC/Permit approval and Work Order required.

ALL WHEELCHAIR RAMPS LOCATED WITHIN THE PUBLIC RIGHT OF WAY MUST HAVE TRUNCATED DOMES.

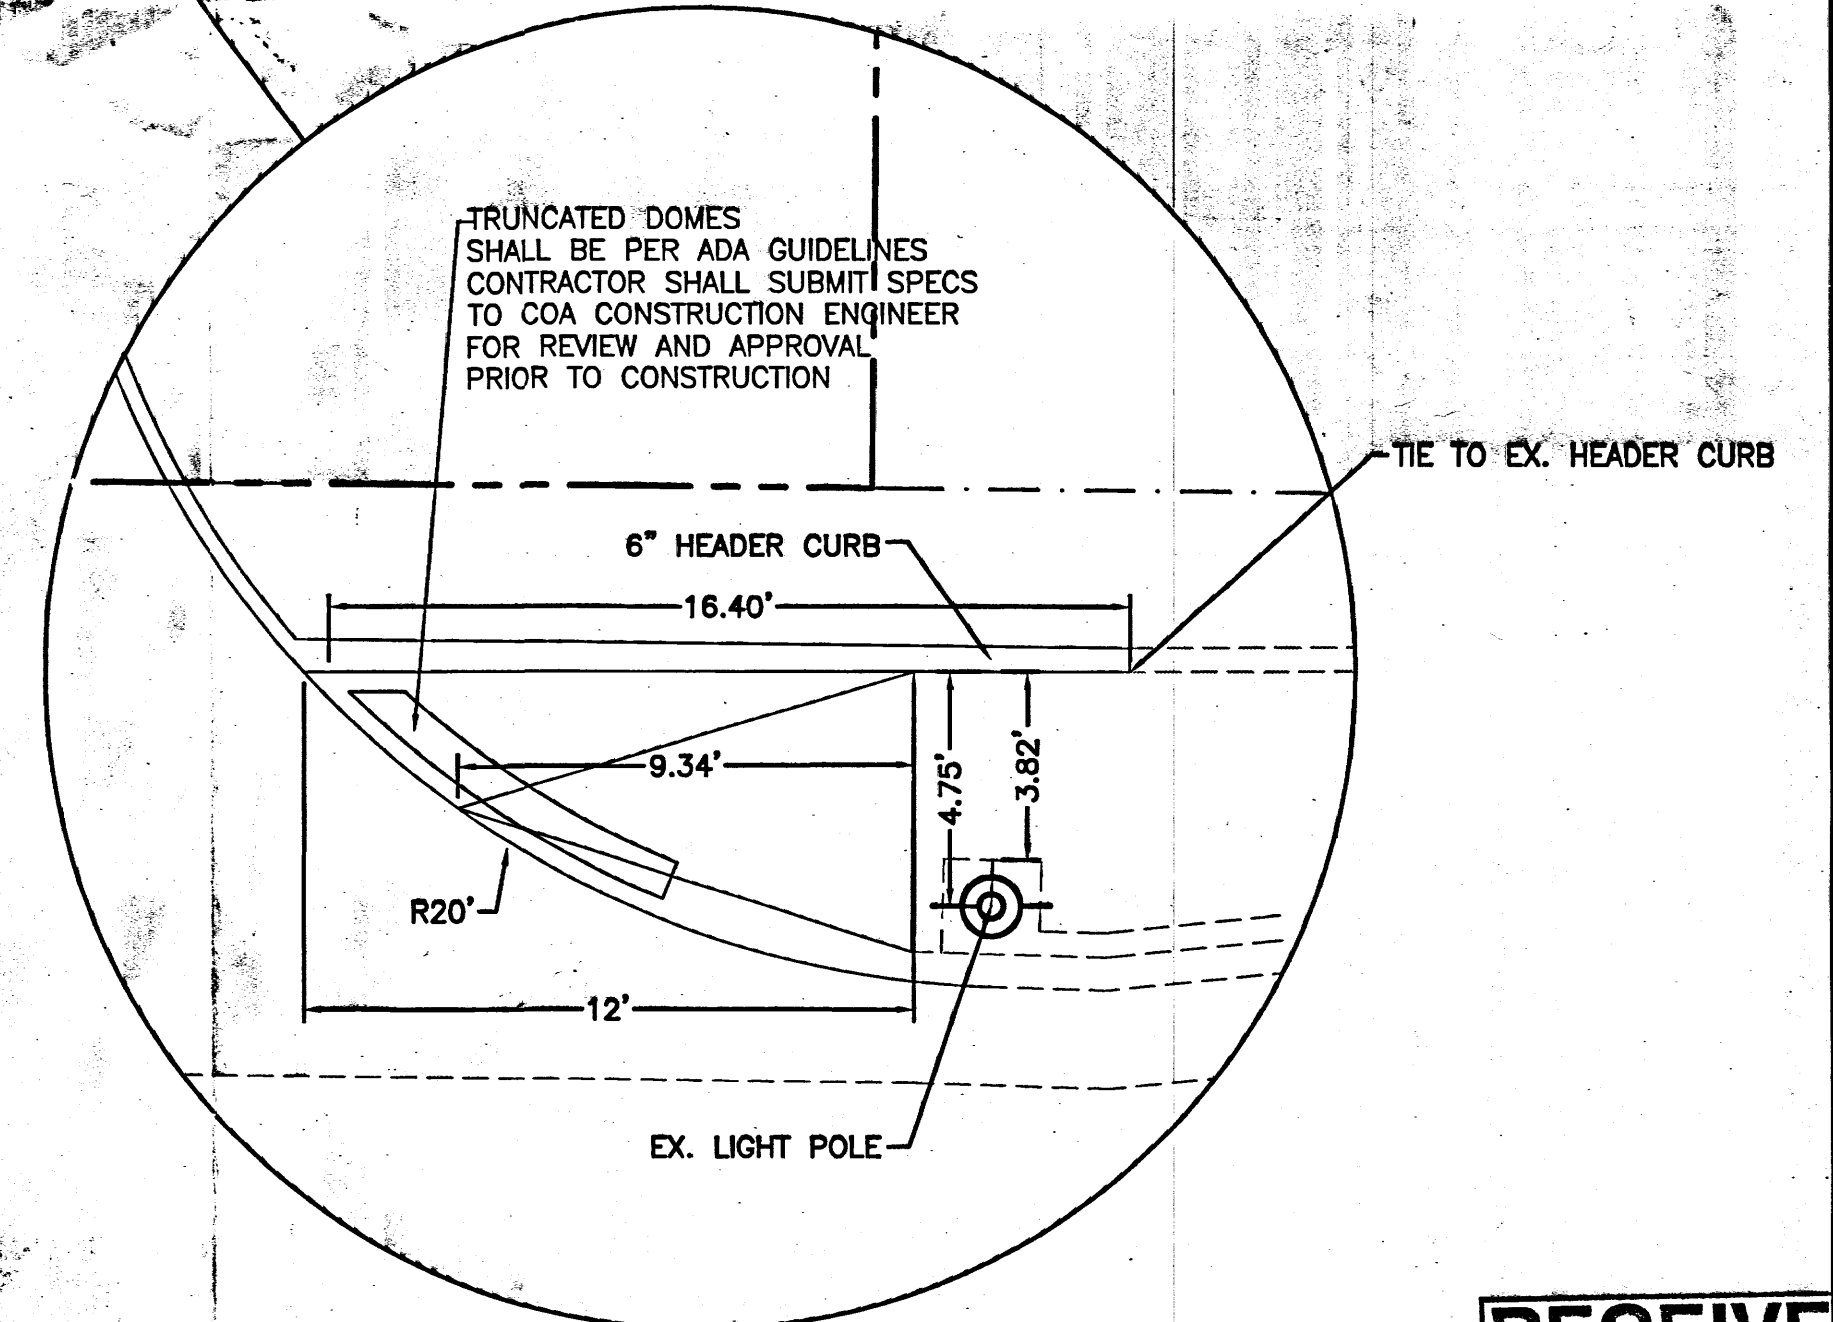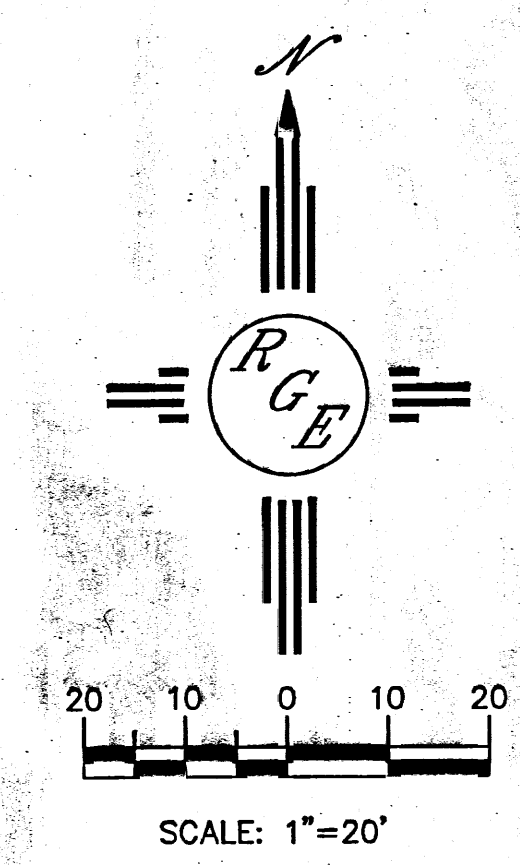

UNI-DIRECTIONAL WHEELCHAIR RAMP W/EX. POLE DETAIL

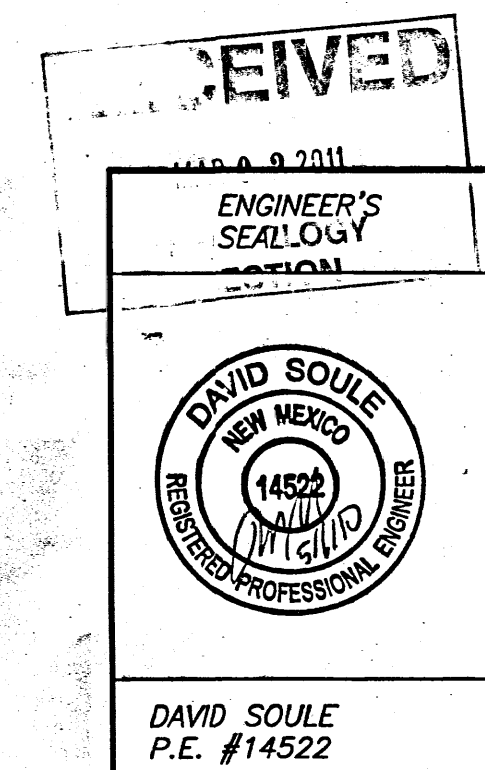

LOMAS CAR WASH  
TRAFFIC CIRCULATION LAYOUT

Rio Grande Engineering  
1806 CENTRAL AVENUE  
SUITE 201  
ALBUQUERQUE, NM 87106  
(505) 872-0999

| RECEIVED            |         |
|---------------------|---------|
| MAY 06 2010         |         |
| HYDROLOGY SECTION   |         |
| DRAWN BY            | WCWJ    |
| DATE                | 4-29-10 |
| 2014 LAYOUT-1-07-10 |         |
| SHEET #             |         |
| JOB #               | 2944    |


I, David Soule, NMPE 14522, of the firm Rio Grande Engineering, hereby certify that this project has been graded and will drain in substantial compliance with and in accordance with the design intent of the approved plan dated 3/10/10. The record information edited on the original design document has been performed by me or under my direct supervision and is true and correct to the best of my knowledge and belief. The as-built survey was provided by David Vigil, 8911. The certification is submitted in support of a request for Permanent Certificate of Occupancy. The record information presented herein is not necessarily complete and intended only to verify substantial compliance of the grading and drainage aspects of this project. Those relying on this record document are advised to obtain independent verification of its accuracy before using it for any other purpose.



BLOCK 27  
MESA VILLAGE  
VOL C3, FOLIO 92

**CAUTION:**  
EXISTING UTILITIES ARE NOT SHOWN. IT SHALL BE THE SOLE RESPONSIBILITY OF THE CONTRACTOR TO CONDUCT ALL NECESSARY FIELD INVESTIGATIONS PRIOR TO ANY EXCAVATION TO DETERMINE THE ACTUAL LOCATION OF UTILITIES & OTHER IMPROVEMENTS.


- EROSION CONTROL NOTES:**
1. CONTRACTOR IS RESPONSIBLE FOR OBTAINING A TOPSOIL DISTURBANCE PERMIT PRIOR TO BEGINNING WORK.
  2. CONTRACTOR IS RESPONSIBLE FOR MAINTAINING RUN-OFF ON SITE DURING CONSTRUCTION.
  3. CONTRACTOR IS RESPONSIBLE FOR CLEANING ALL SEDIMENT THAT GETS INTO EXISTING RIGHT-OF-WAY.
  4. REPAIR OF DAMAGED FACILITIES AND CLEANUP OF SEDIMENT ACCUMULATIONS ON ADJACENT PROPERTIES AND IN PUBLIC FACILITIES IS THE RESPONSIBILITY OF THE CONTRACTOR.
  5. ALL EXPOSED EARTH SURFACES MUST BE PROTECTED FROM WIND AND WATER EROSION PRIOR TO FINAL ACCEPTANCE OF ANY PROJECT.

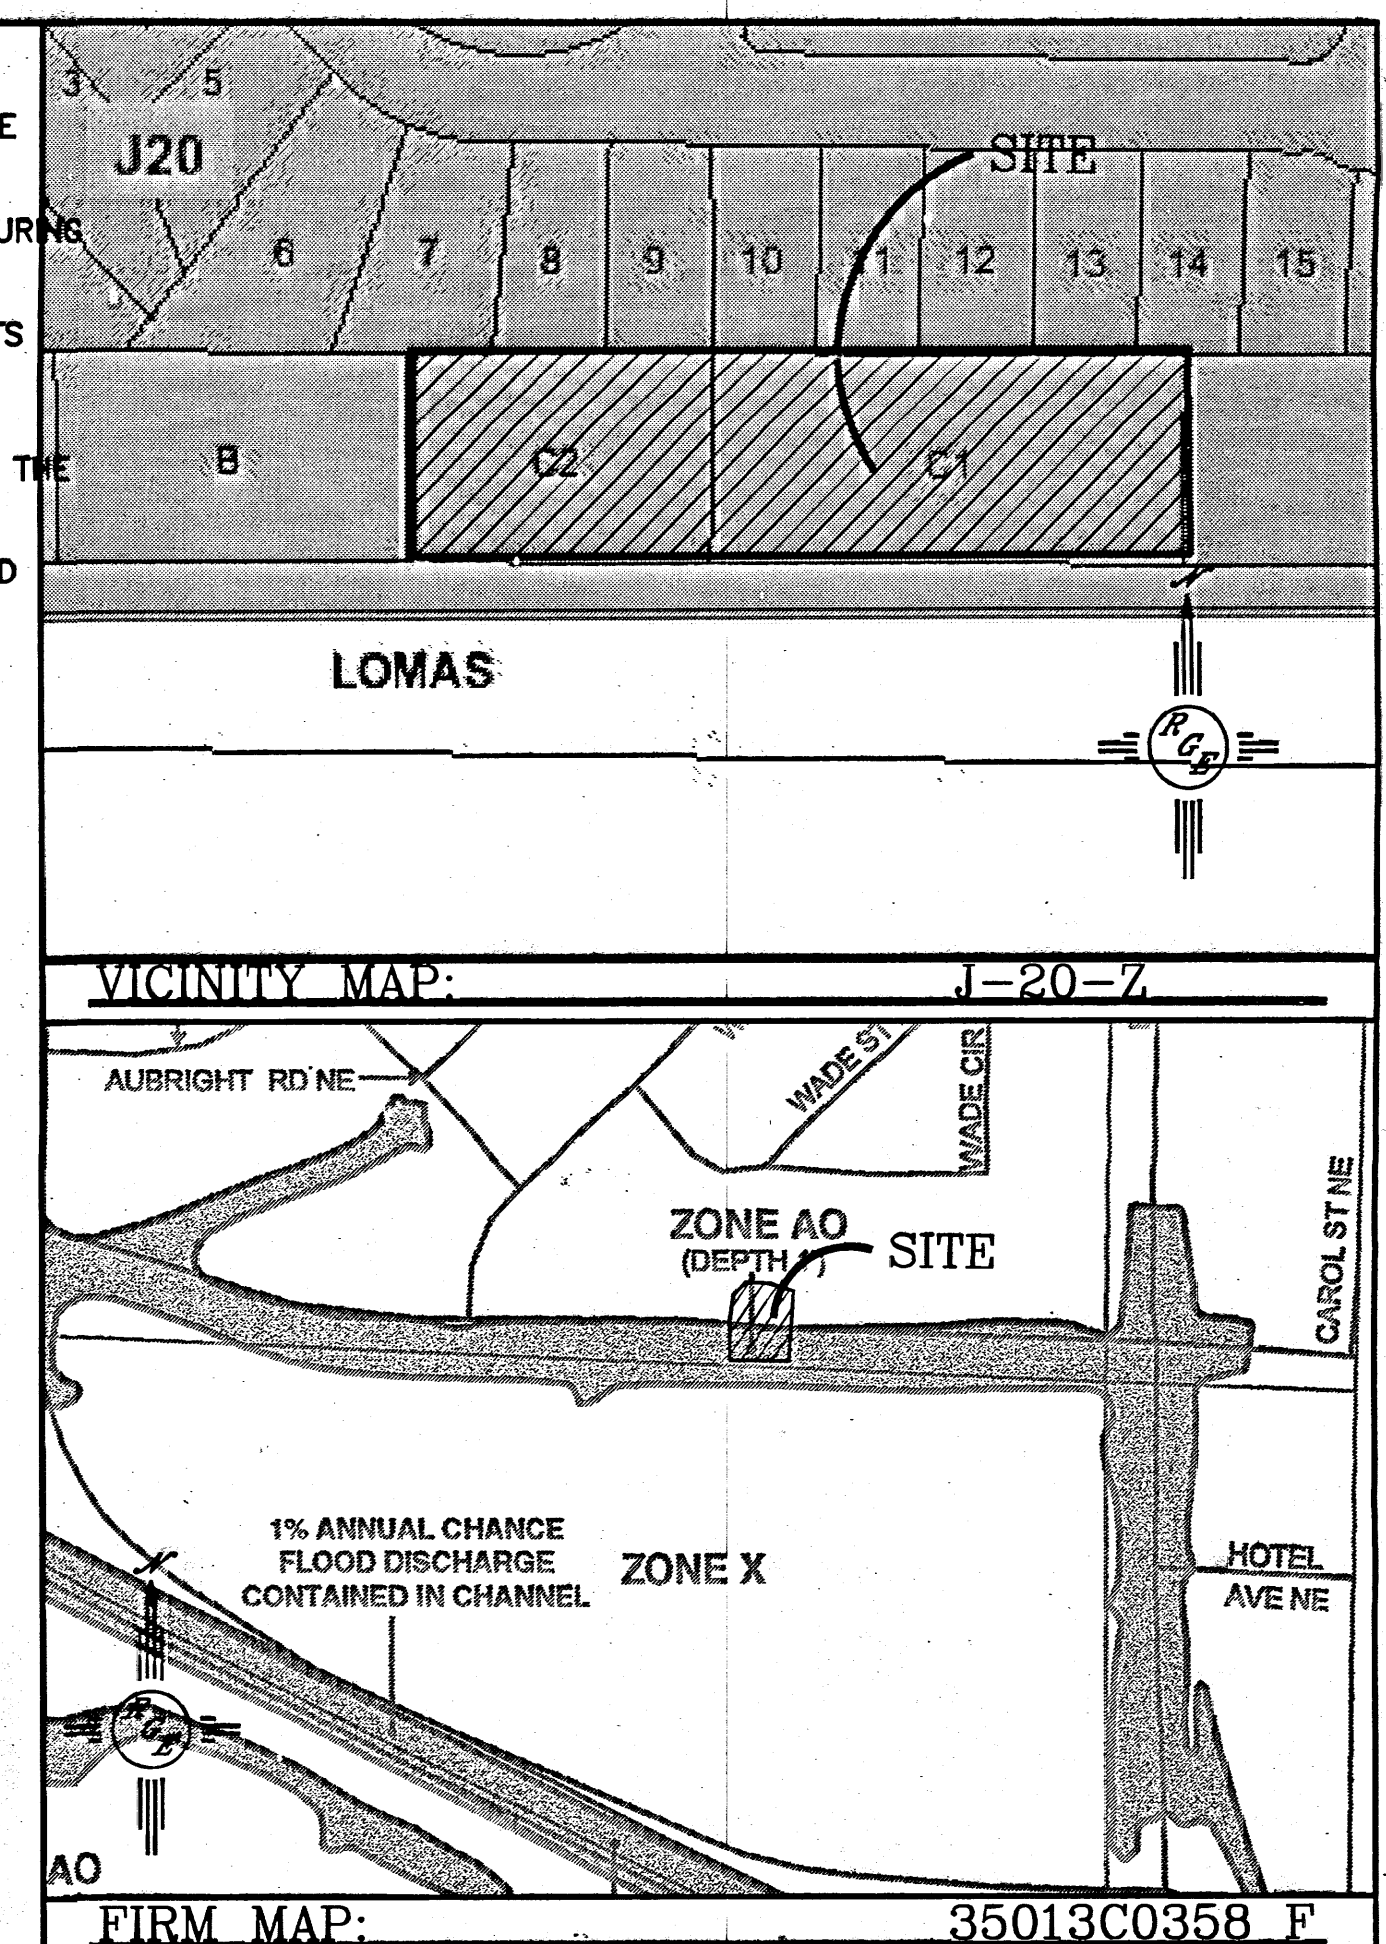



**LEGAL DESCRIPTION:**  
TRACTS C1 AND C2, LANDS OF GREVEY

**NOTES:**  
1. ALL SPOT ELEVATIONS REPRESENT FLOWLINE ELEVATION UNLESS OTHERWISE NOTED.

- LEGEND**
- 4071 EXISTING CONTOUR
  - 4070 EXISTING INDEX CONTOUR
  - 4071 PROPOSED CONTOUR
  - 4070 PROPOSED INDEX CONTOUR
  - 4070 SLOPE TIE
  - 4048.25 EXISTING SPOT ELEVATION
  - 4048.25 PROPOSED SPOT ELEVATION
  - BOUNDARY
  - CENTERLINE
  - RIGHT-OF-WAY
  - CMU BLOCK SCREEN WALL
  - CMU BLOCK RETAINING WALL
  - BREAK LINE
  - EXISTING SIDEWALK

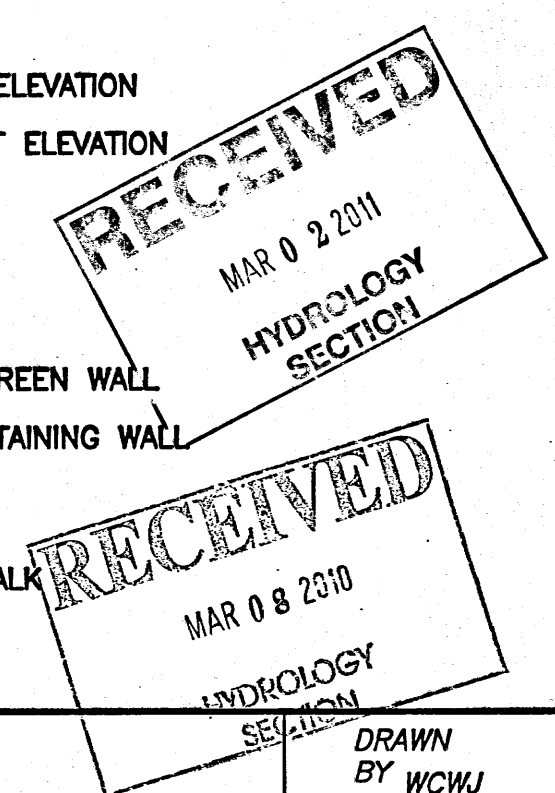


|                            |                                                                                 |                       |
|----------------------------|---------------------------------------------------------------------------------|-----------------------|
| ENGINEER'S SEAL            | <b>LOMAS CAR WASH</b><br><b>GRADING AND DRAINAGE PLAN</b>                       | DRAWN BY WCUJ         |
|                            |                                                                                 | DATE 1-07-10          |
| DAVID SOULE<br>P.E. #14522 | <br>1806 CENTRAL AVENUE<br>SUITE 201<br>ALBUQUERQUE, NM 87104<br>(505) 872-0999 | SHEET #<br>JOB # 2944 |

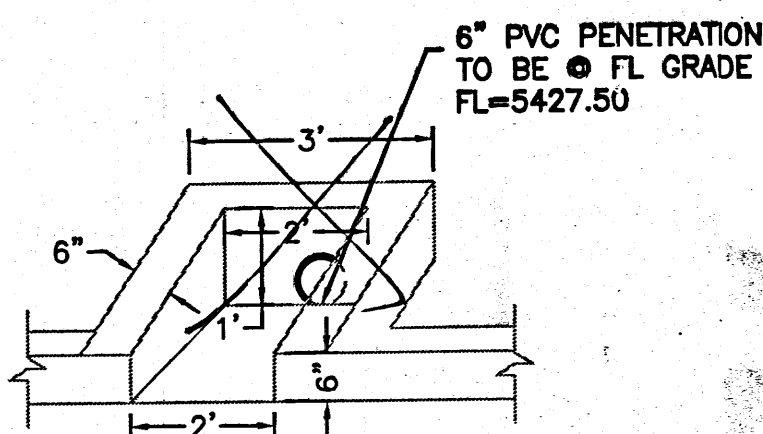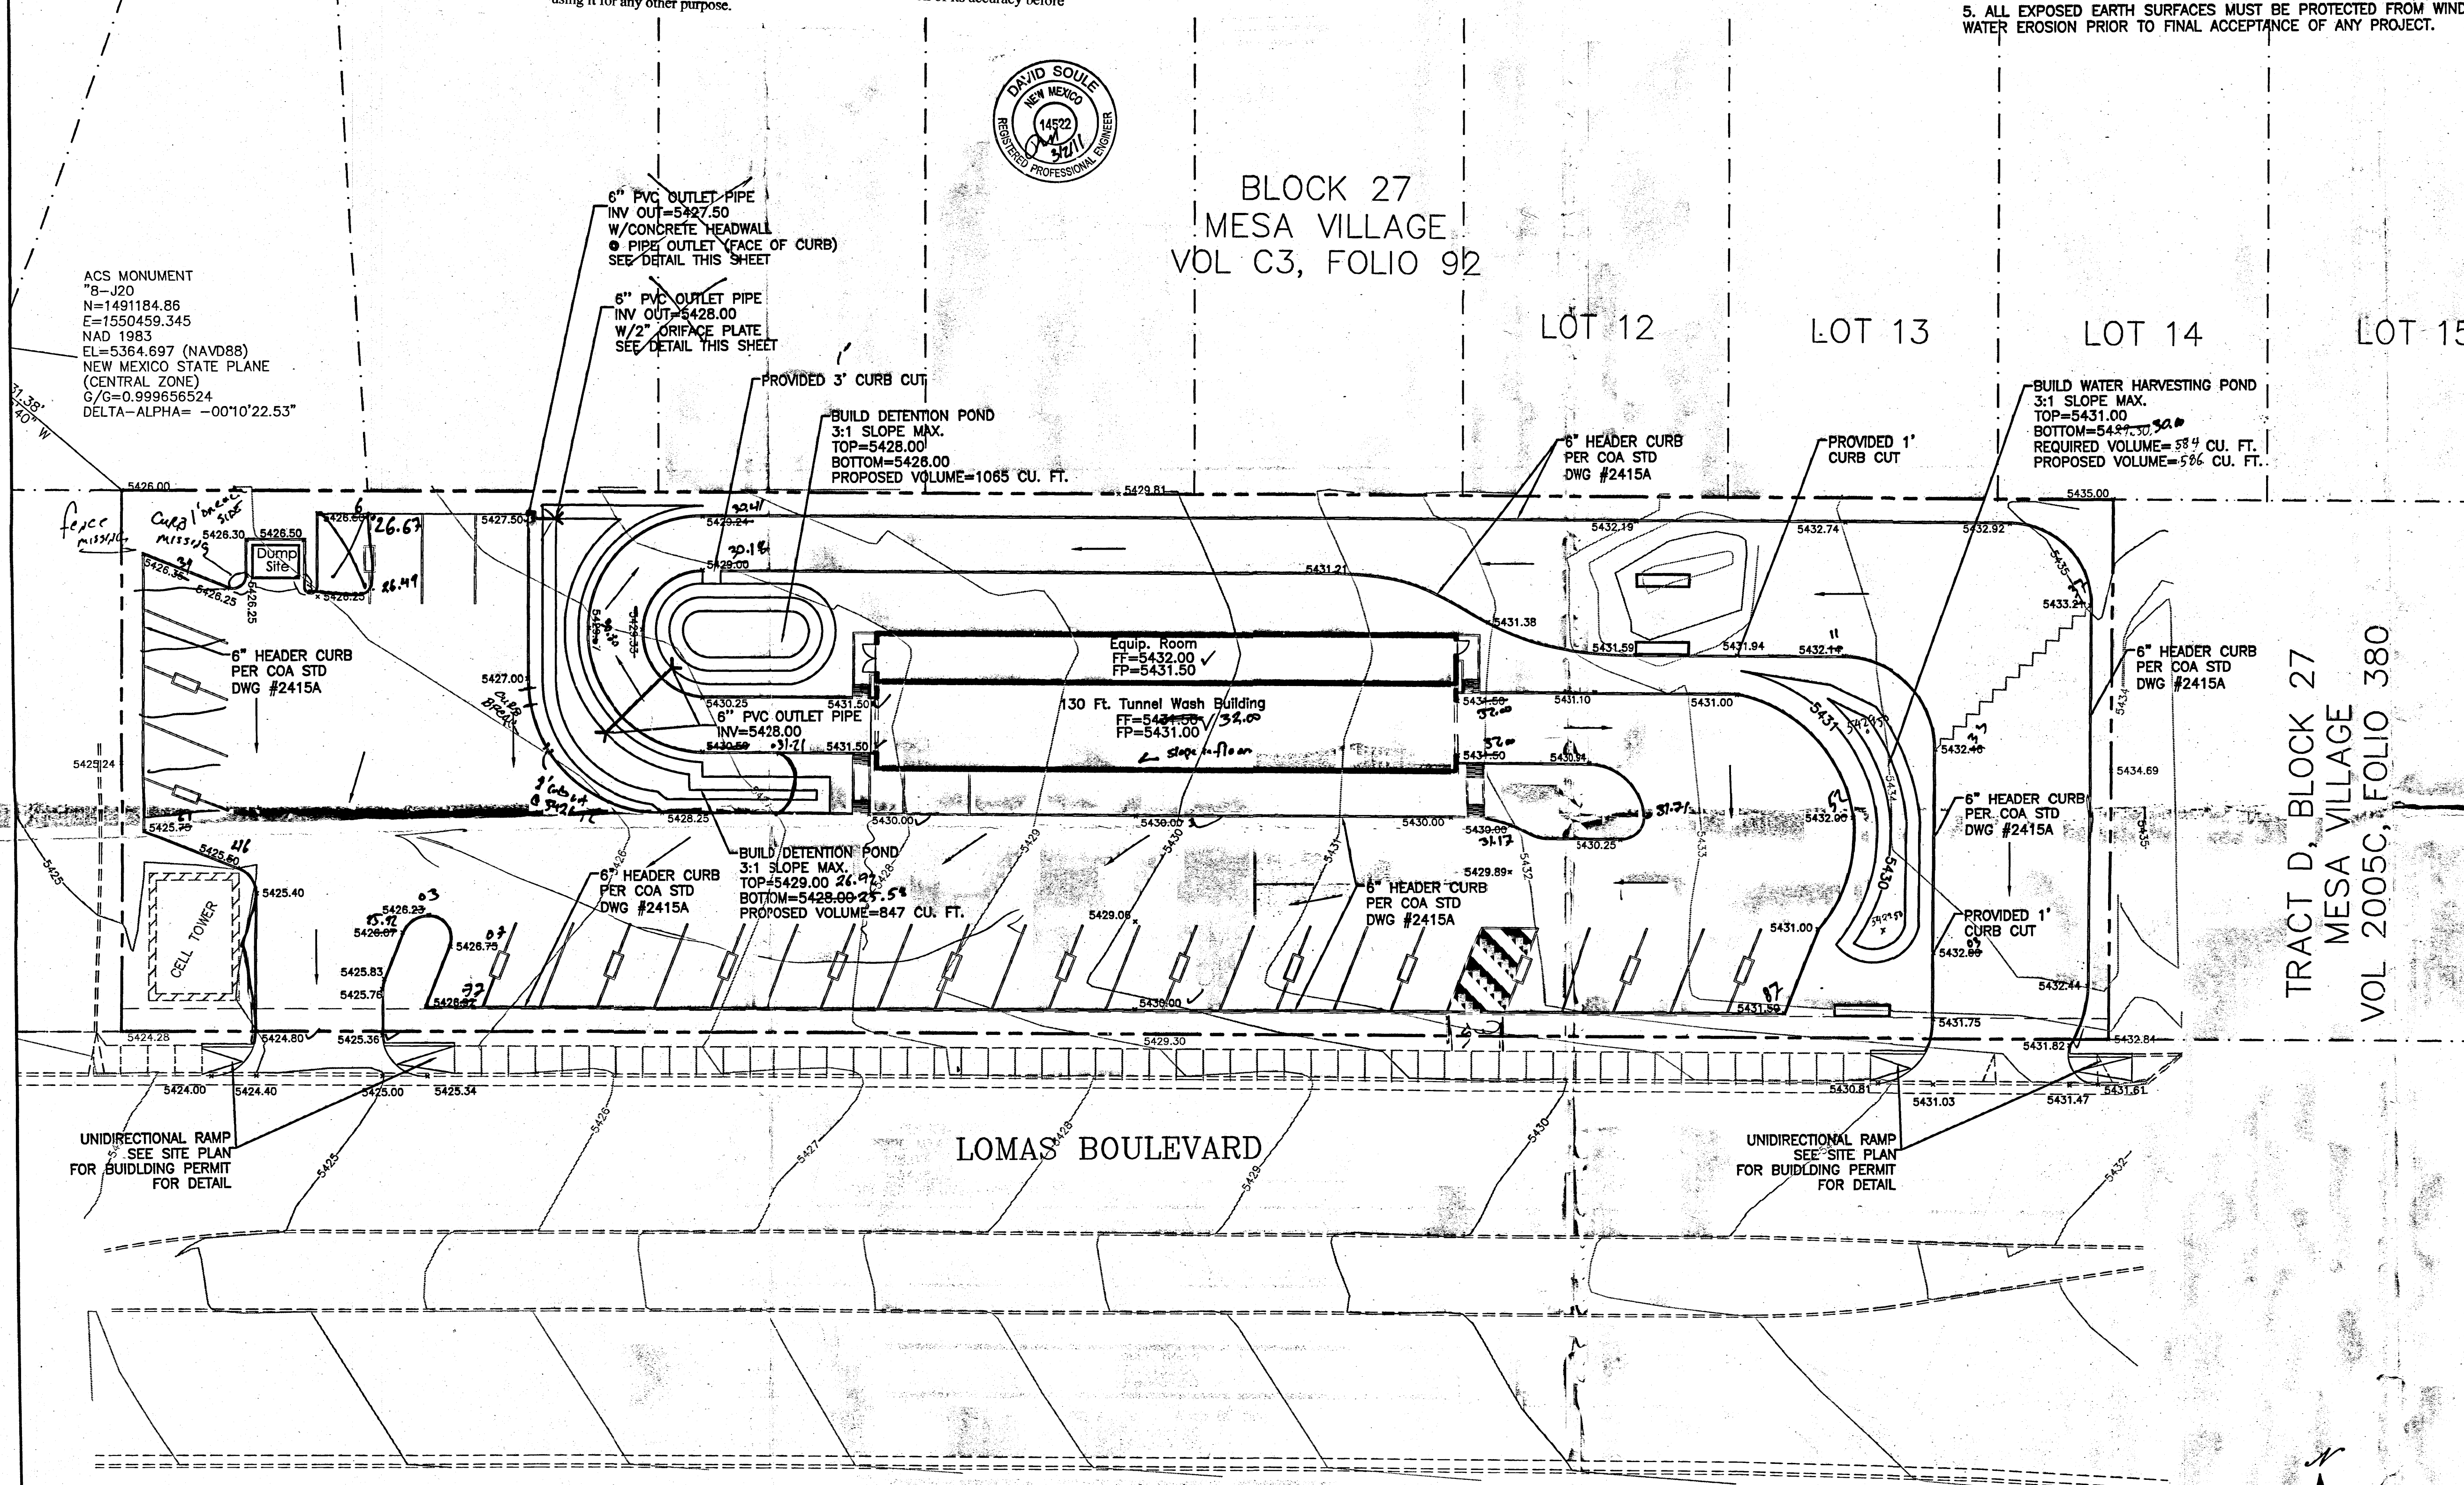


6" PIPE PENETRATION HEADWALL DETAIL

NTS

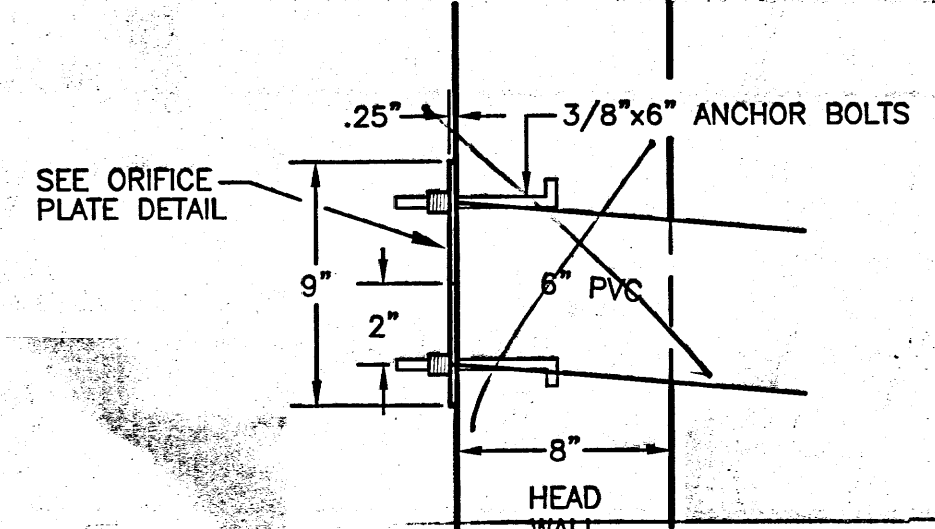

DETAIL A

N.T.S.  
TO BE INSTALLED @ THE OUTFLOW OF THE POND

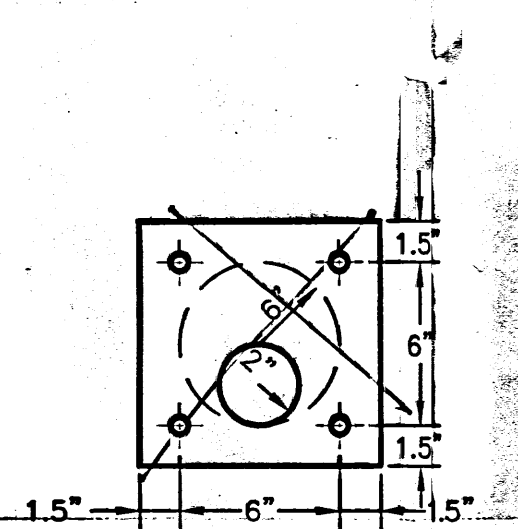

TYP. ORIFICE PLATE DETAIL

N.T.S.



**CAUTION:**  
EXISTING UTILITIES ARE NOT SHOWN.  
IT SHALL BE THE SOLE RESPONSIBILITY  
OF THE CONTRACTOR TO CONDUCT ALL  
NECESSARY FIELD INVESTIGATIONS PRIOR  
TO ANY EXCAVATION TO DETERMINE THE  
ACTUAL LOCATION OF UTILITIES & OTHER  
IMPROVEMENTS.

### EROSION CONTROL NOTES:

1. CONTRACTOR IS RESPONSIBLE FOR OBTAINING A TOPSOIL DISTURBANCE PERMIT PRIOR TO BEGINNING WORK.
2. CONTRACTOR IS RESPONSIBLE FOR MAINTAINING RUN-OFF ON SITE DURING CONSTRUCTION.
3. CONTRACTOR IS RESPONSIBLE FOR CLEANING ALL SEDIMENT THAT GETS INTO EXISTING RIGHT-OF-WAY.
4. REPAIR OF DAMAGED FACILITIES AND CLEANUP OF SEDIMENT ACCUMULATIONS ON ADJACENT PROPERTIES AND IN PUBLIC FACILITIES IS THE RESPONSIBILITY OF THE CONTRACTOR.
5. ALL EXPOSED EARTH SURFACES MUST BE PROTECTED FROM WIND AND WATER EROSION PRIOR TO FINAL ACCEPTANCE OF ANY PROJECT.

## BLOCK 27 MESA VILLAGE VOL C3, FOLIO 92

ACS MONUMENT  
8-J20  
N=1491184.86  
E=1550459.345  
NAD 1983  
EL=5364.697 (NAVD88)  
NEW MEXICO STATE PLANE  
(CENTRAL ZONE)  
G/G=0.999656524  
DELTA-ALPHA= -00°10'22.53"

6" PVC OUTLET PIPE  
INV OUT=5427.50  
W/CONCRETE HEADWALL  
● PIPE OUTLET (FACE OF CURB)  
SEE DETAIL THIS SHEET

6" PVC OUTLET PIPE  
INV OUT=5428.00  
W/2" ORIFICE PLATE  
SEE DETAIL THIS SHEET

PROVIDED 3' CURB CUT

BUILD DETENTION POND  
3:1 SLOPE MAX.  
TOP=5428.00  
BOTTOM=5426.00  
PROPOSED VOLUME=1065 CU. FT.

LOT 12

LOT 13

LOT 14

LOT 15

BUILD WATER HARVESTING POND  
3:1 SLOPE MAX.  
TOP=5431.00  
BOTTOM=5429.30  
REQUIRED VOLUME=584 CU. FT.  
PROPOSED VOLUME=506 CU. FT.

6" HEADER CURB  
PER COA STD  
DWG #2415A

PROVIDED 1'  
CURB CUT

6" HEADER CURB  
PER COA STD  
DWG #2415A

PROVIDED 1'  
CURB CUT

LOMAS BOULEVARD


TRACT D, BLOCK 27  
MESA VILLAGE  
VOL 2005C, FOLIO 380

### LEGEND


- 4071 EXISTING CONTOUR
- 4070 EXISTING INDEX CONTOUR
- 4071 PROPOSED CONTOUR
- 4070 PROPOSED INDEX CONTOUR
- SLOPE TIE
- 4048.25 EXISTING SPOT ELEVATION
- 4048.25 PROPOSED SPOT ELEVATION
- BOUNDARY
- CENTERLINE
- RIGHT-OF-WAY
- CMU BLOCK SCREEN WALL
- CMU BLOCK RETAINING WALL
- BREAK LINE
- EXISTING SIDEWALK

RECEIVED  
MAR 08 2010  
HYDROLOGY  
SECTION

|                                                                                           |                                                                                                               |                                                            |
|-------------------------------------------------------------------------------------------|---------------------------------------------------------------------------------------------------------------|------------------------------------------------------------|
| ENGINEER'S SEAL<br>DAVID SOULE<br>NEW MEXICO<br>REGISTERED PROFESSIONAL ENGINEER<br>14522 | LOMAS CAR WASH<br>GRADING AND DRAINAGE PLAN                                                                   | DRAWN BY<br>WCWJ<br>DATE<br>1-07-10<br>2944-LAYOUT-1-07-10 |
| DAVID SOULE<br>P.E. #14522                                                                | Rio Grande Engineering<br>1606 CENTRAL AVENUE<br>SUITE 201<br>ALBUQUERQUE, NM 87108<br>(505) 872-0000 SECTION | SHEET #<br>JOB #<br>2944                                   |

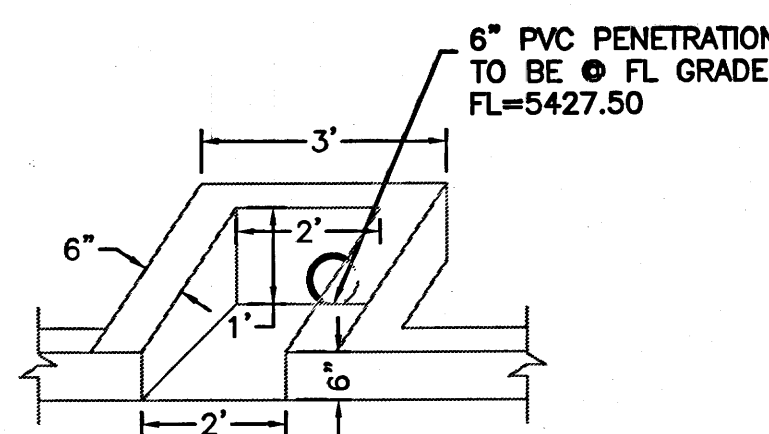


6" PIPE PENETRATION HEADWALL DETAIL

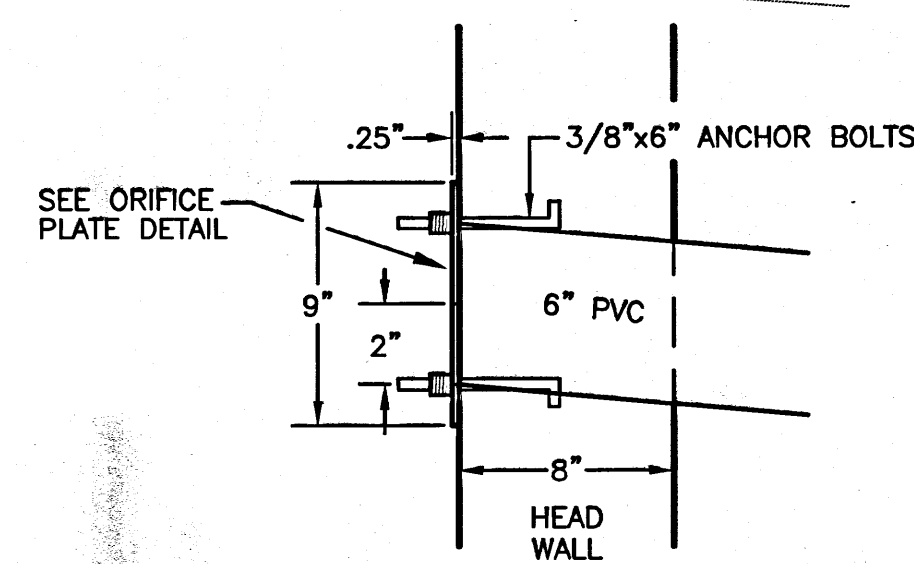


DETAIL A



N.T.S.  
TO BE INSTALLED @ THE OUTFLOW  
OF THE POND

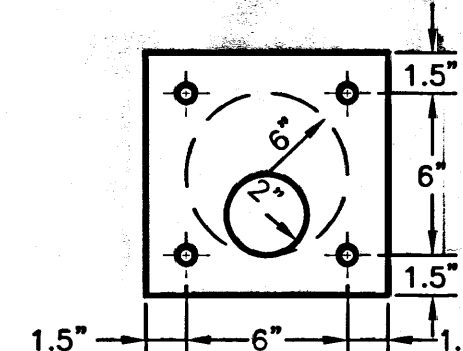

TYP. ORIFICE PLATE DETAIL

N.T.S.

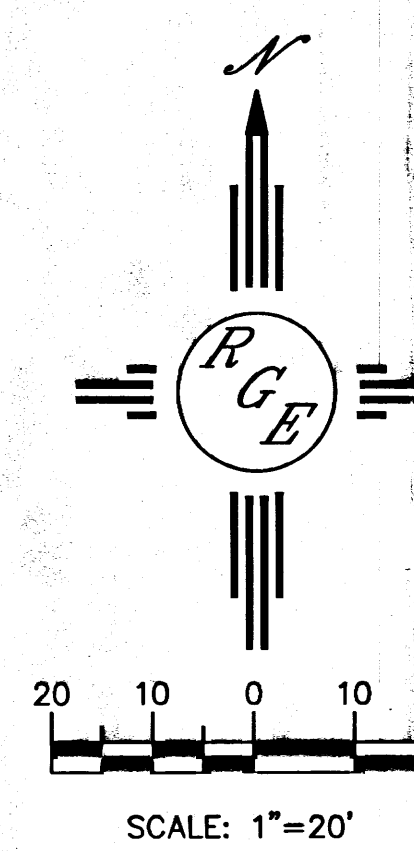

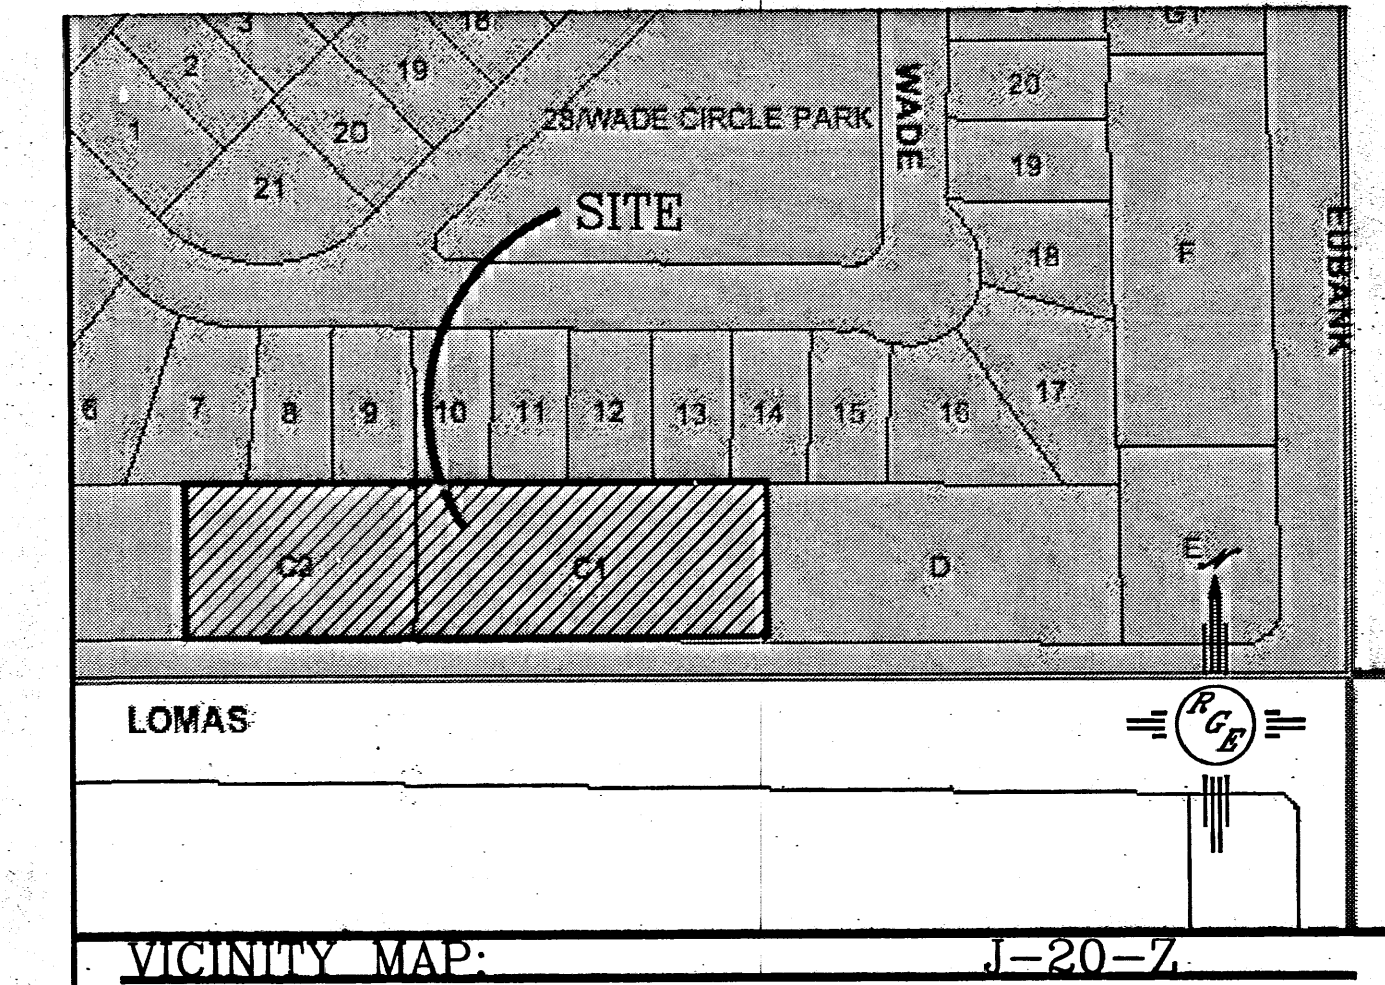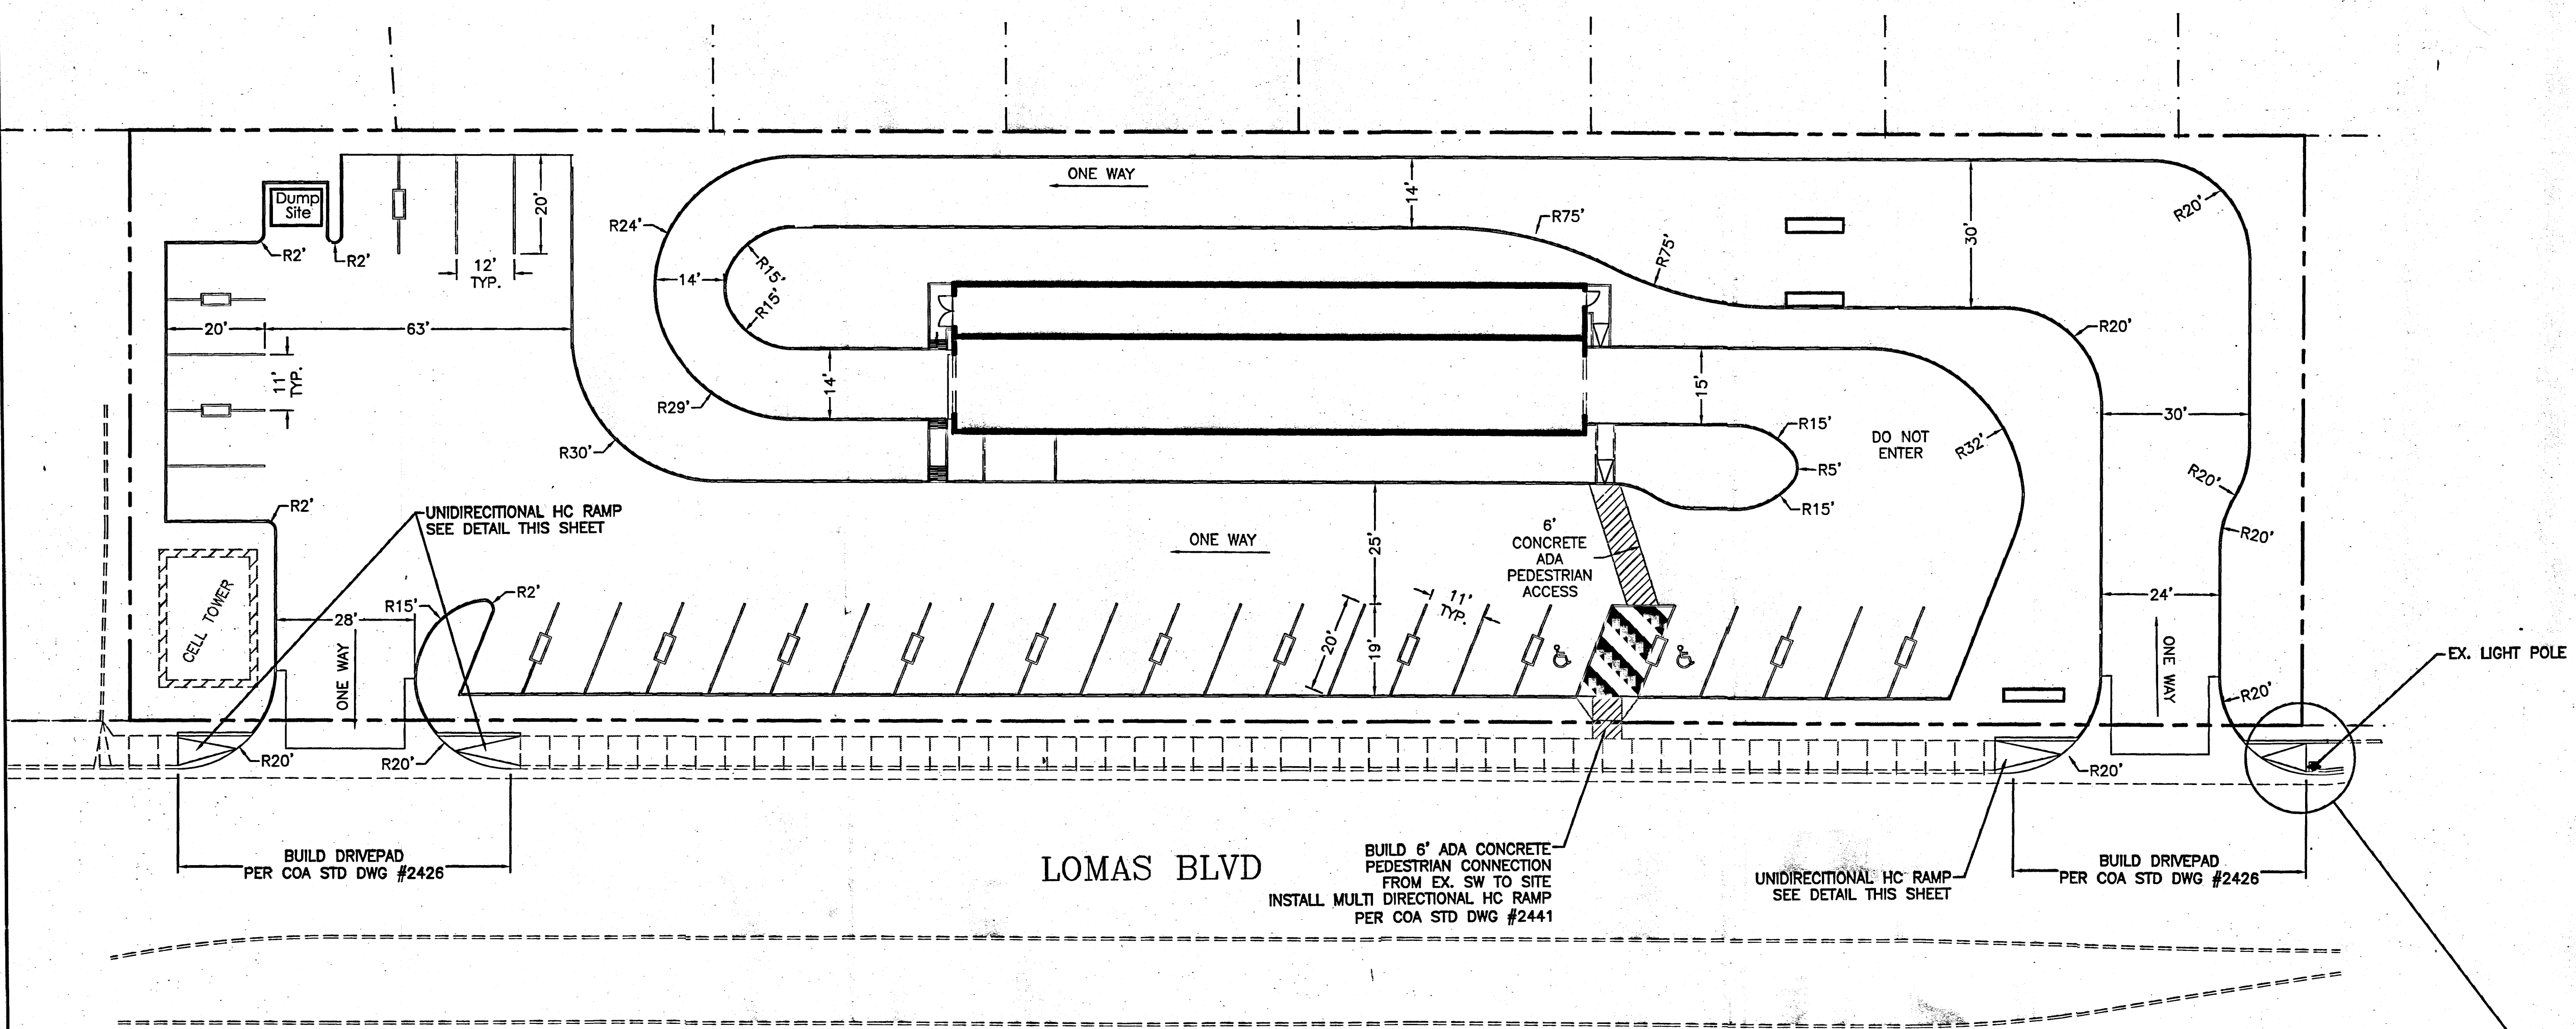

**LEGAL DESCRIPTION:**  
TRACTS C1 AND C2, LANDS OF GREVEY



- LEGEND**
- EXISTING CURB & GUTTER
  - ===== PROPOSED CURB & GUTTER
  - BOUNDARY LINE
  - EXISTING BOUNDARY LINE
  - EXISTING SIDEWALK
  - CENTERLINE
  - RIGHT-OF-WAY

**PARKING CALCULATIONS**

WAITING AREA/EQUIPMENT ROOM 150' x 200' SQFT  
1453 SQ.FT. / 200 = 8 SPACES

EMPLOYEE SPACES 150' PER EMPLOYEE  
9 EMPLOYEES = 9 SPACES

TOTAL SPACES REQUIRED 17 SPACES  
TOTAL SPACES PROVIDED INCLUDING DRIVING AREAS 32 SPACES  
HC SPACES REQUIRED 26-36 = 2 SPACES  
HC SPACES PROVIDED = 2 SPACES

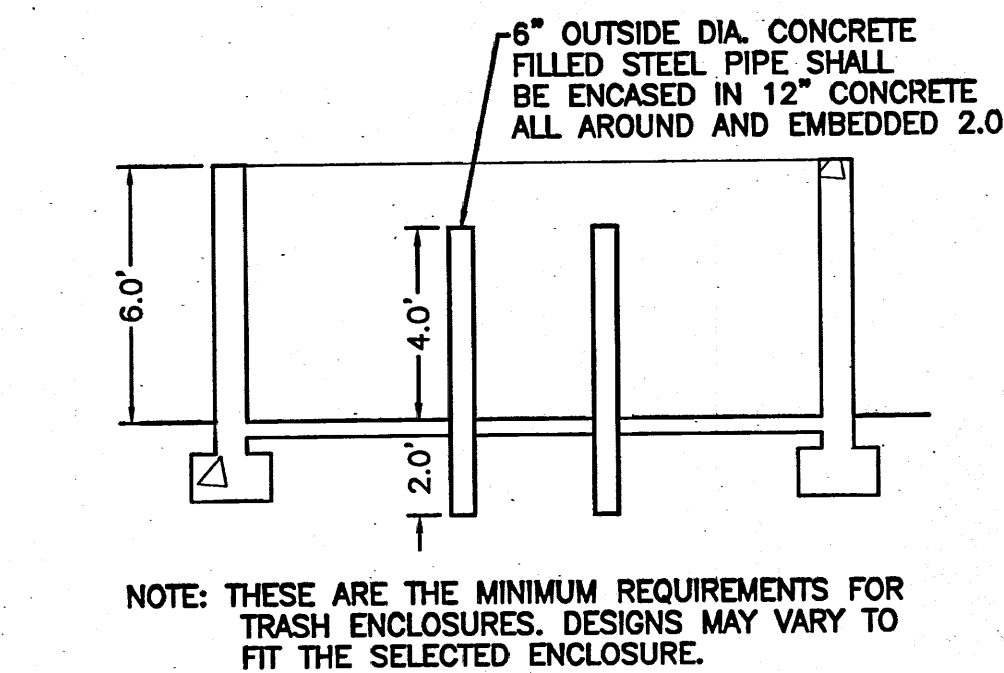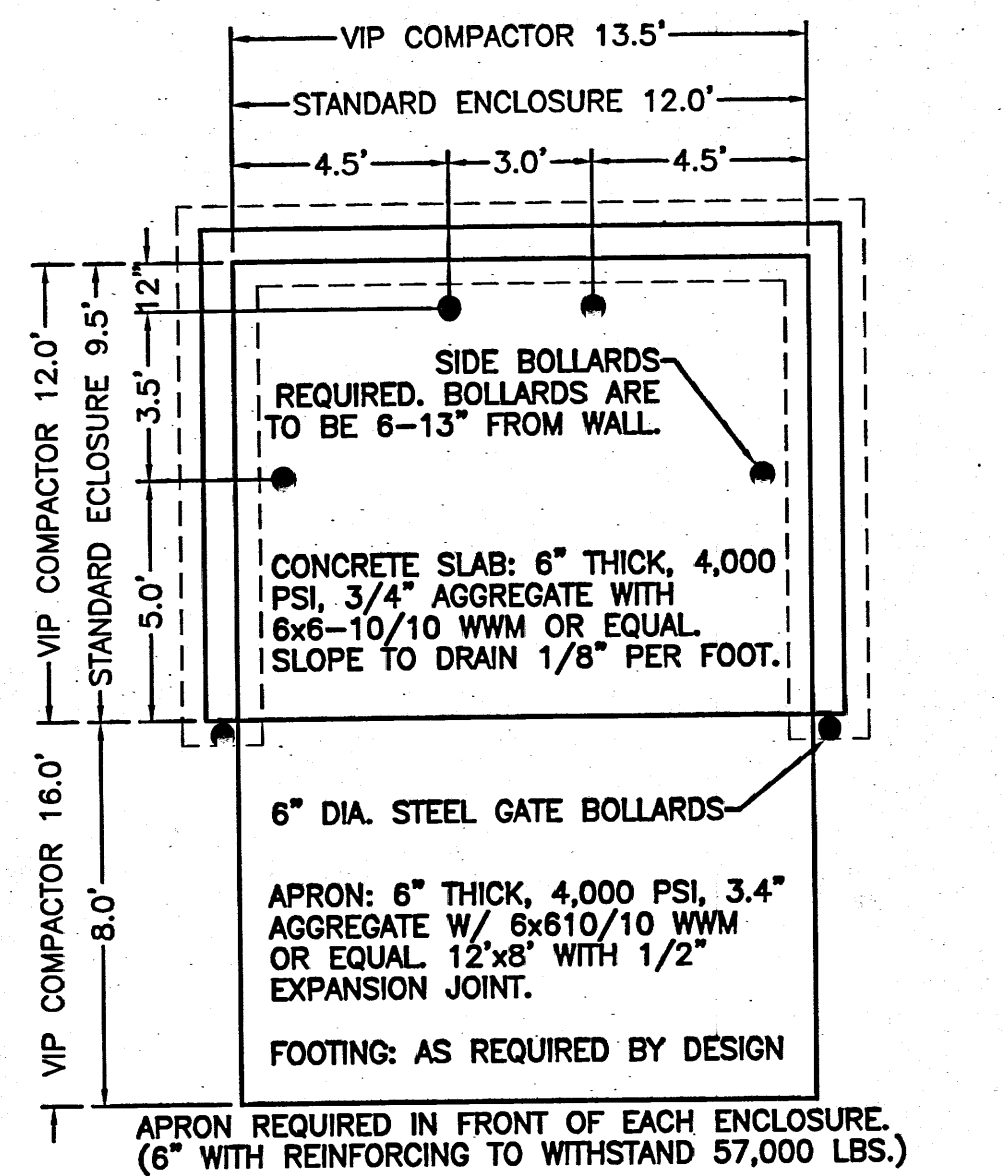


**DUMPSTER ENCLOSURE DETAIL**

**TRAFFIC CIRCULATION LAYOUT**  
APPROVED  
Signed: [Signature] Date: 05/07/10


ALL WHEELCHAIR RAMPS LOCATED WITHIN THE PUBLIC RIGHT OF WAY MUST HAVE TRUNCATED DOMES.

Public Infrastructure shown on these plans for information only and not part of approval. Separate DRC/Permit approval and Work Order required.


TRUNCATED DOMES SHALL BE PER ADA GUIDELINES. CONTRACTOR SHALL SUBMIT SPECS TO COA CONSTRUCTION ENGINEER FOR REVIEW AND APPROVAL PRIOR TO CONSTRUCTION.

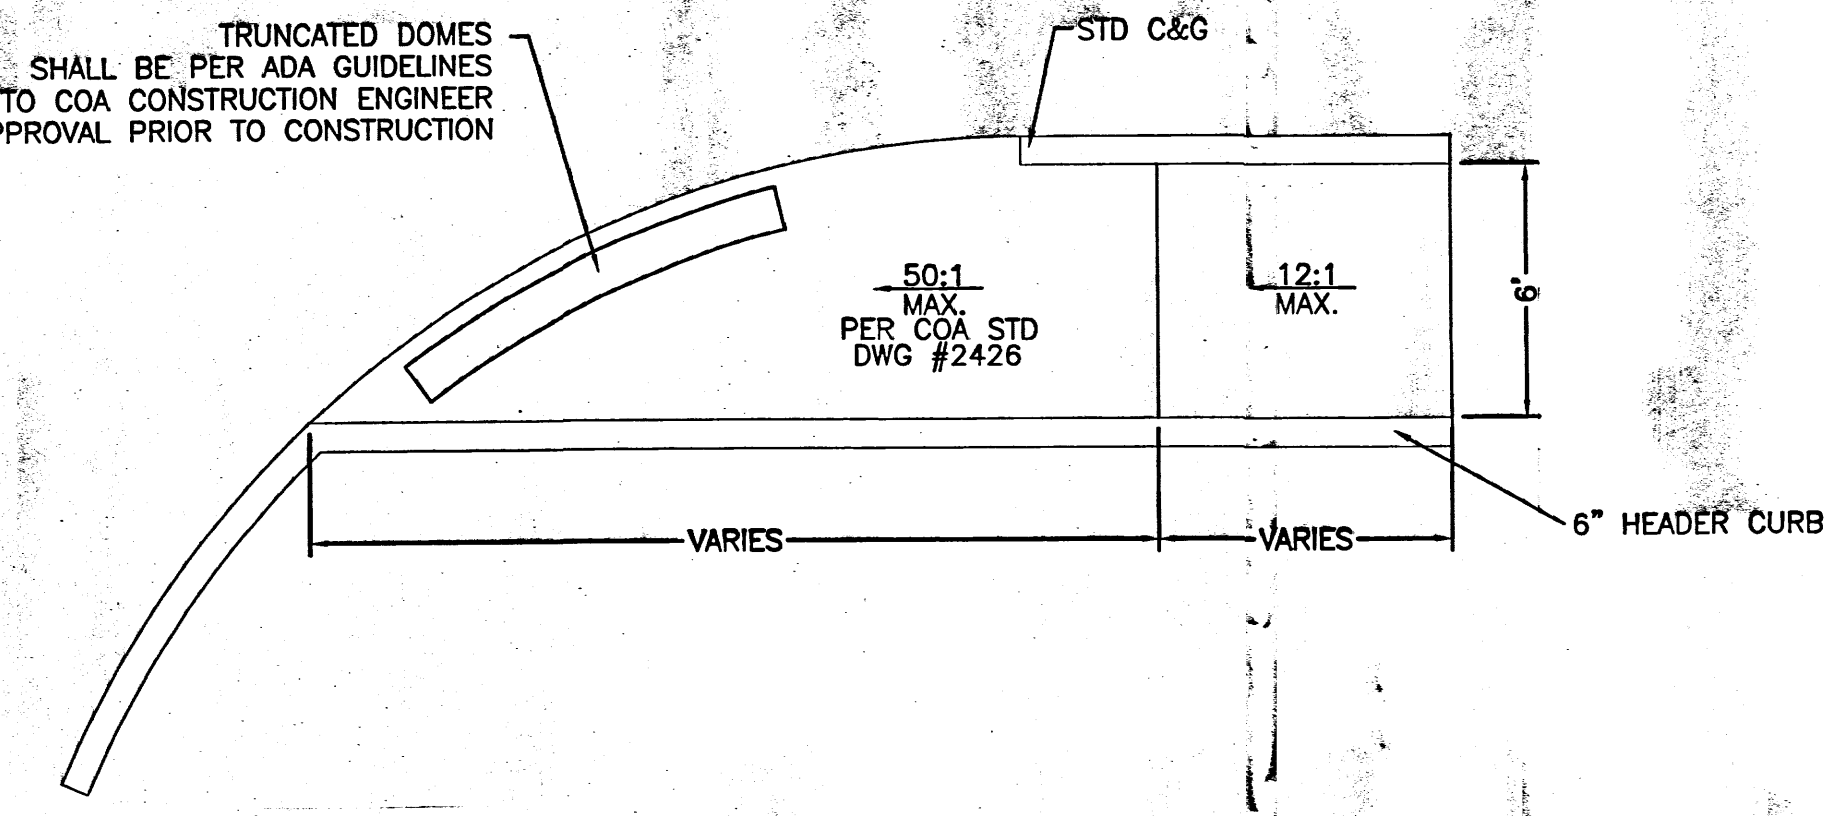


**UNI-DIRECTIONAL WHEELCHAIR RAMP DETAIL (TYP.)**





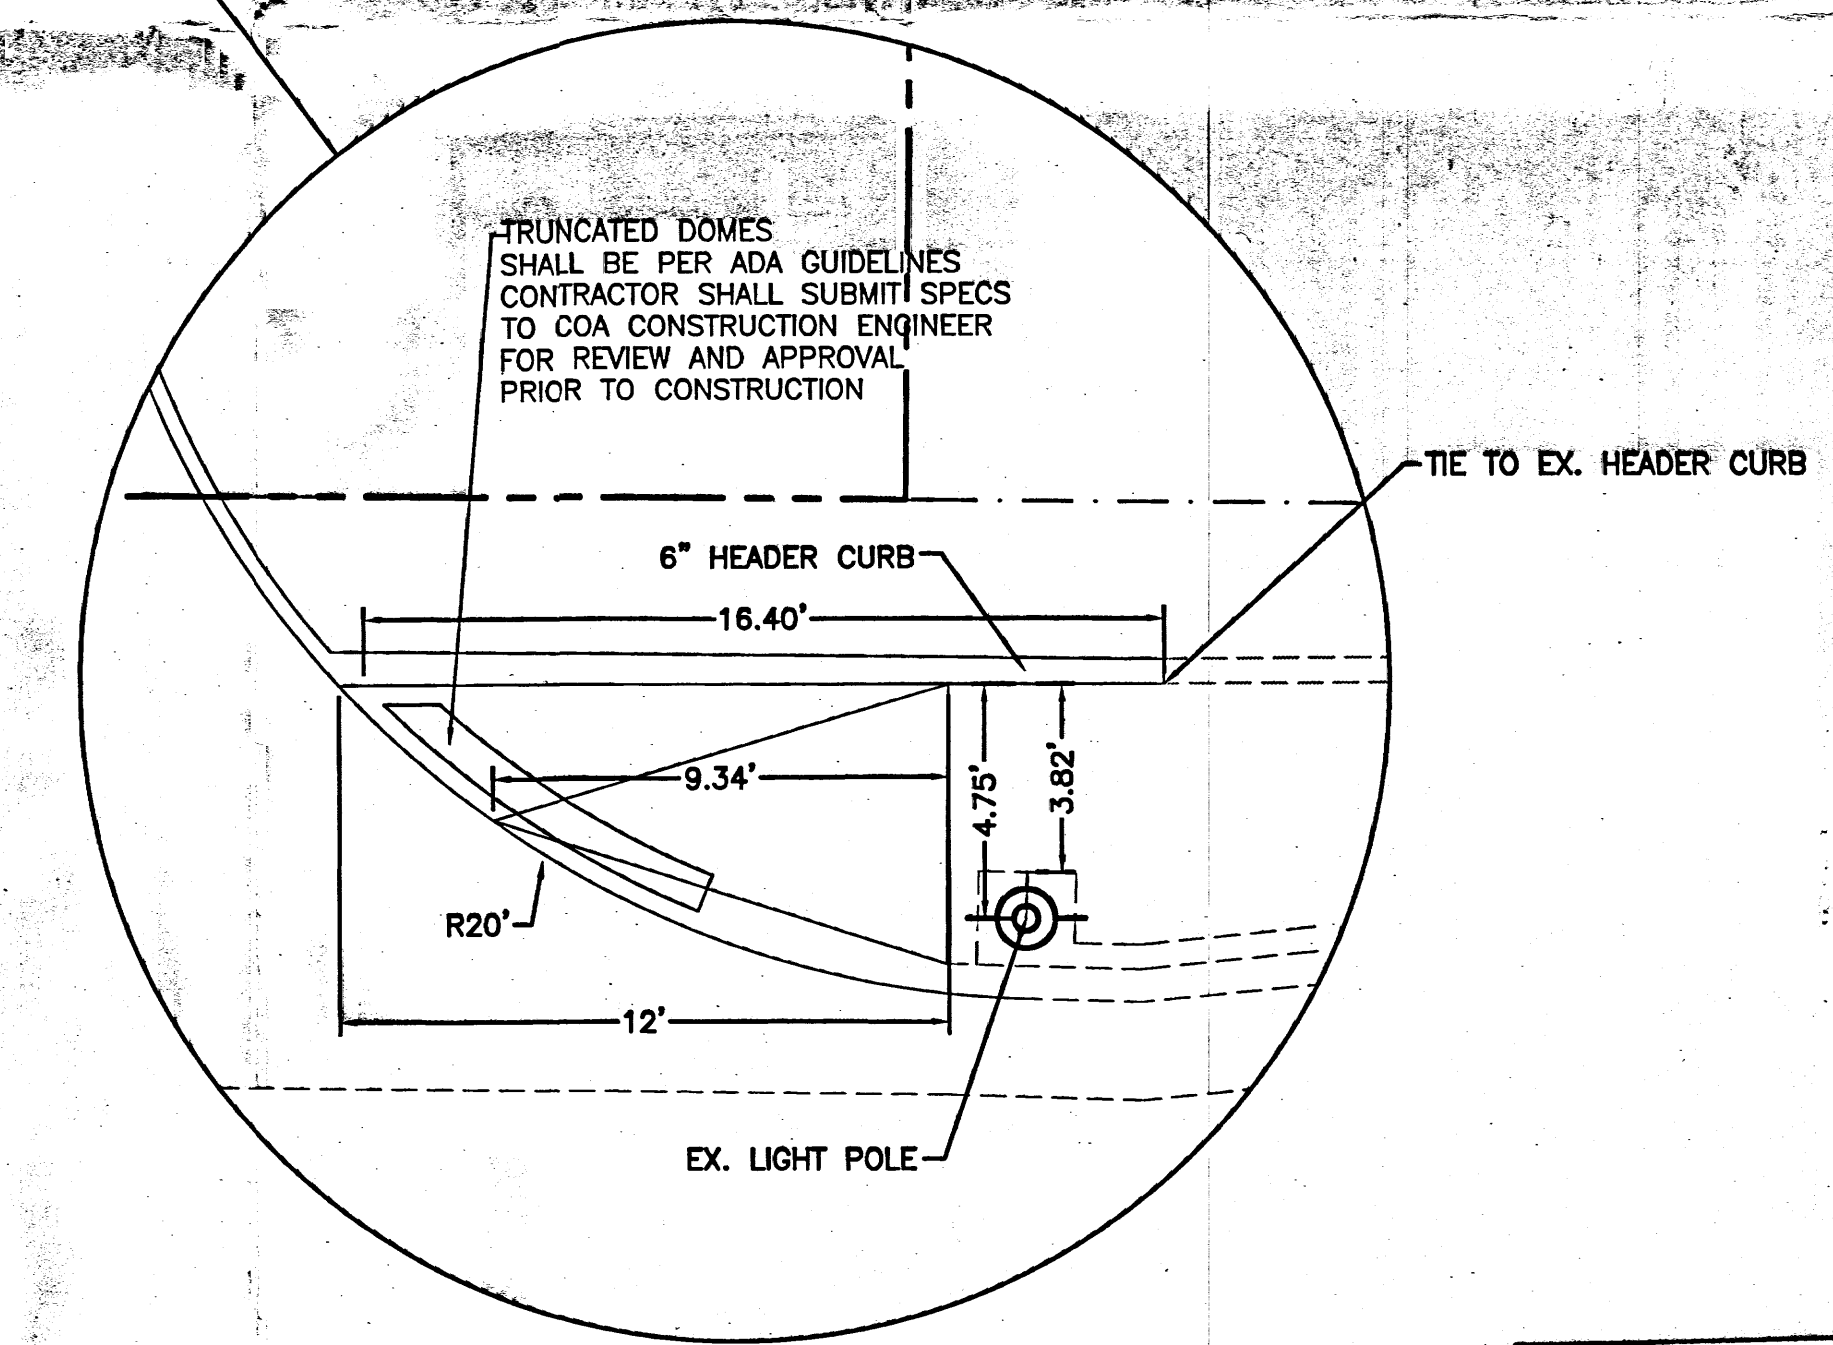


**UNI-DIRECTIONAL WHEELCHAIR RAMP W/EX. POLE DETAIL**

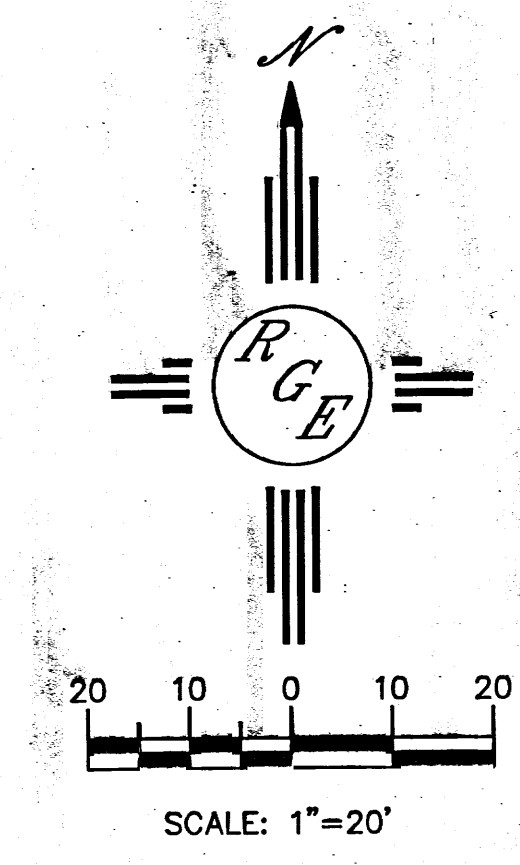

**RECEIVED**  
MAY 06 2010  
HYDROLOGY SECTION
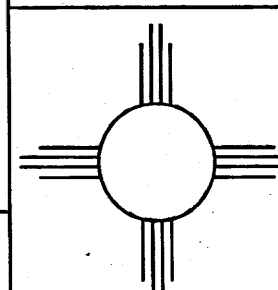
|                                                                                                                                                      |                                                                                                                                                                                                    |                      |
|------------------------------------------------------------------------------------------------------------------------------------------------------|----------------------------------------------------------------------------------------------------------------------------------------------------------------------------------------------------|----------------------|
| <b>ENGINEER'S SEAL</b><br><br><b>DAVID SOULE</b><br>P.E. #14522 | <b>LOMAS CAR WASH</b>                                                                                                                                                                              | <b>DRAWN BY</b> WCWJ |
|                                                                                                                                                      | <b>TRAFFIC CIRCULATION LAYOUT</b>                                                                                                                                                                  | <b>DATE</b> 4-29-10  |
|                                                                                                                                                      |  <b>Rio Grande Engineering</b><br>1806 CENTRAL AVENUE<br>SUITE 201<br>ALBUQUERQUE, NM 87108<br>(505) 872-0999 | <b>SHEET #</b>       |
|                                                                                                                                                      |                                                                                                                                                                                                    | <b>JOB #</b> 2944    |

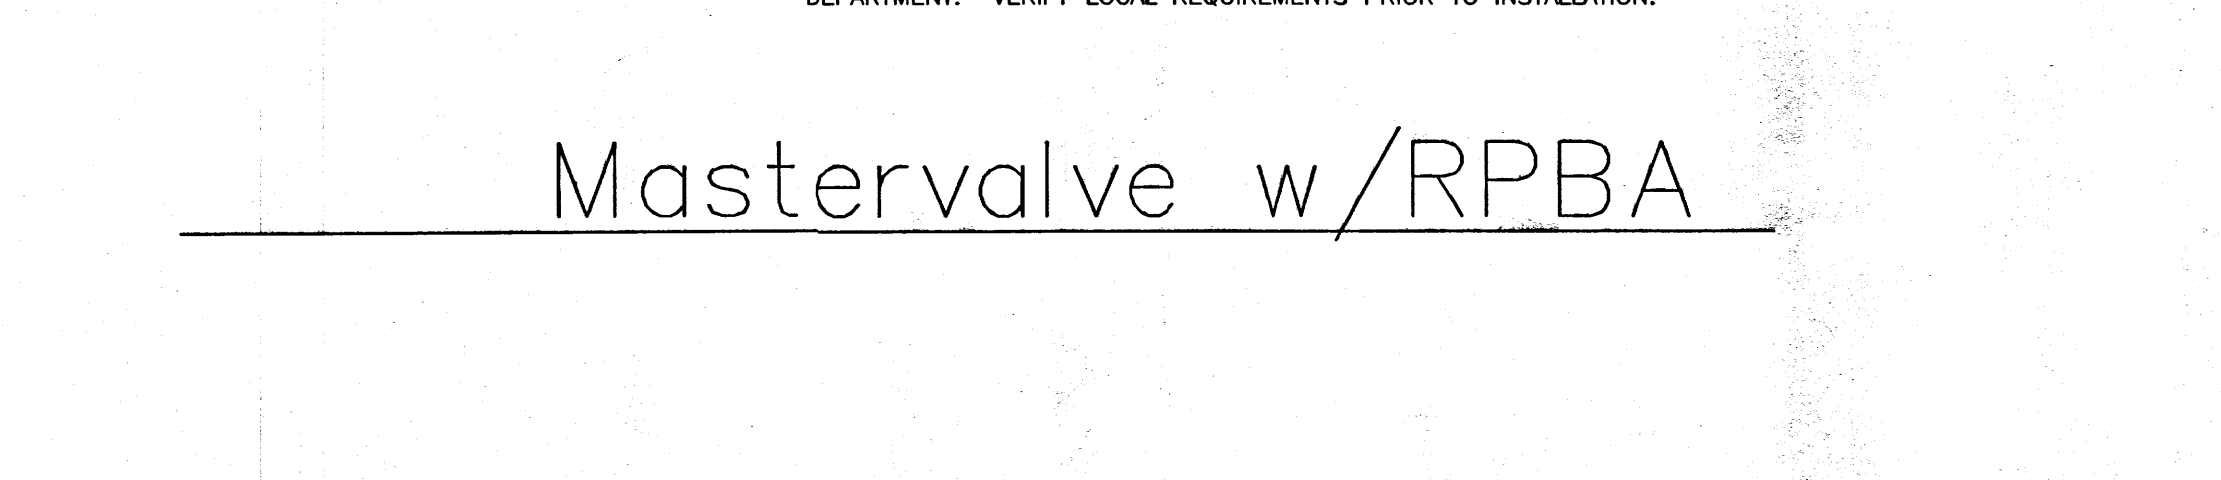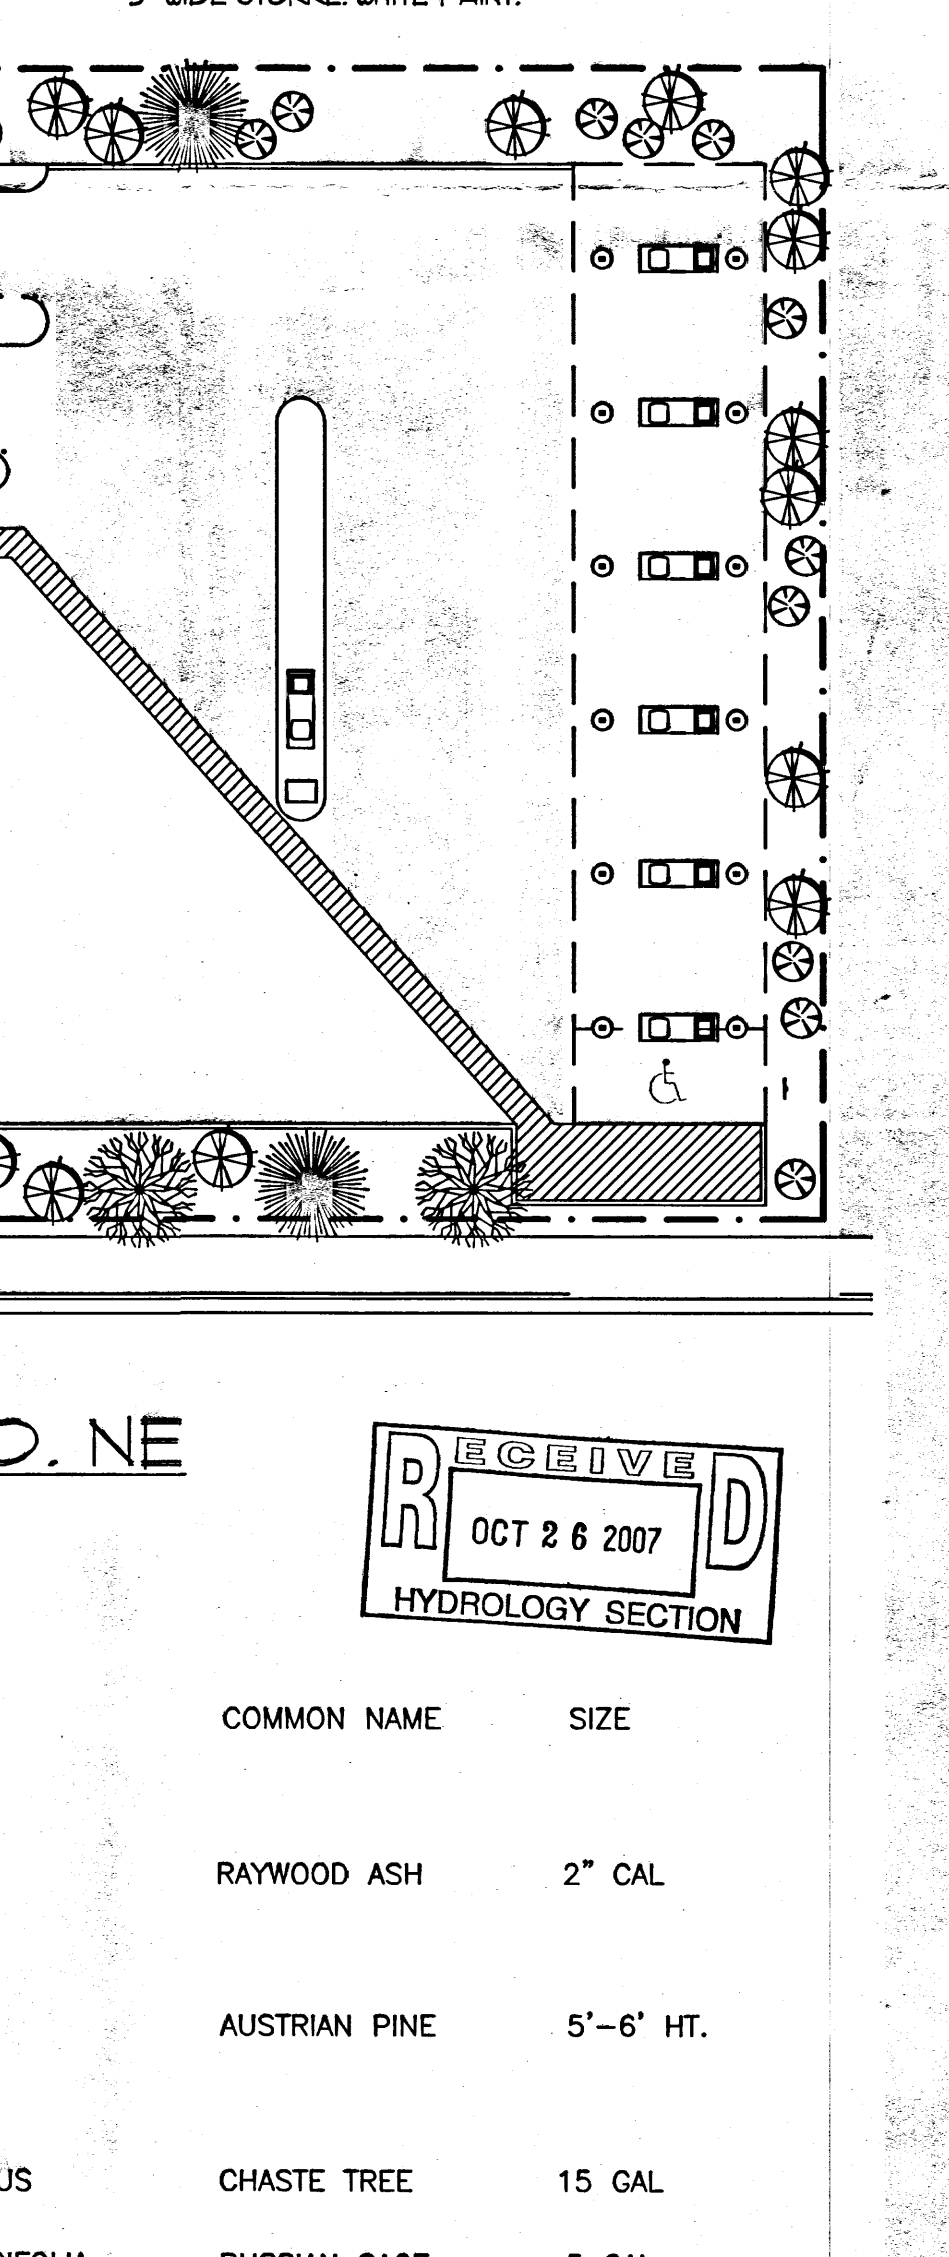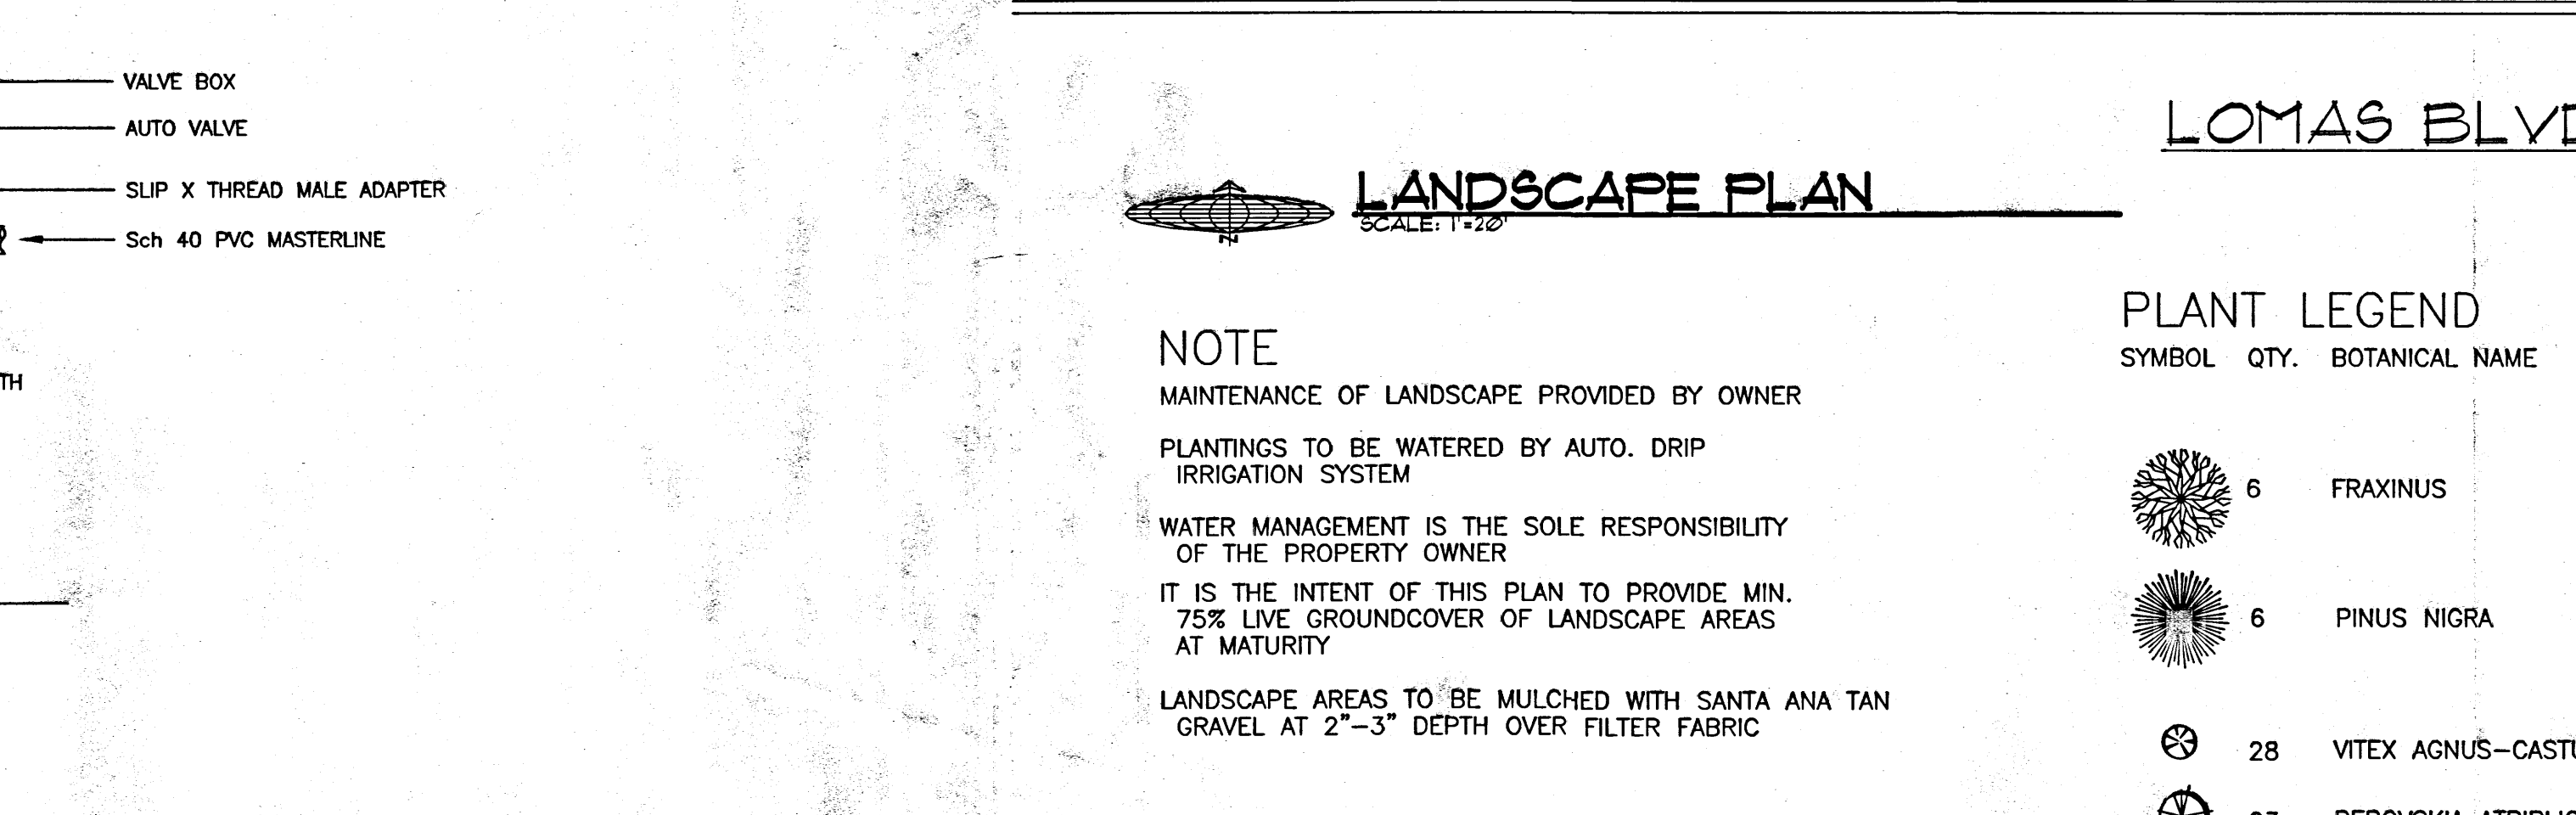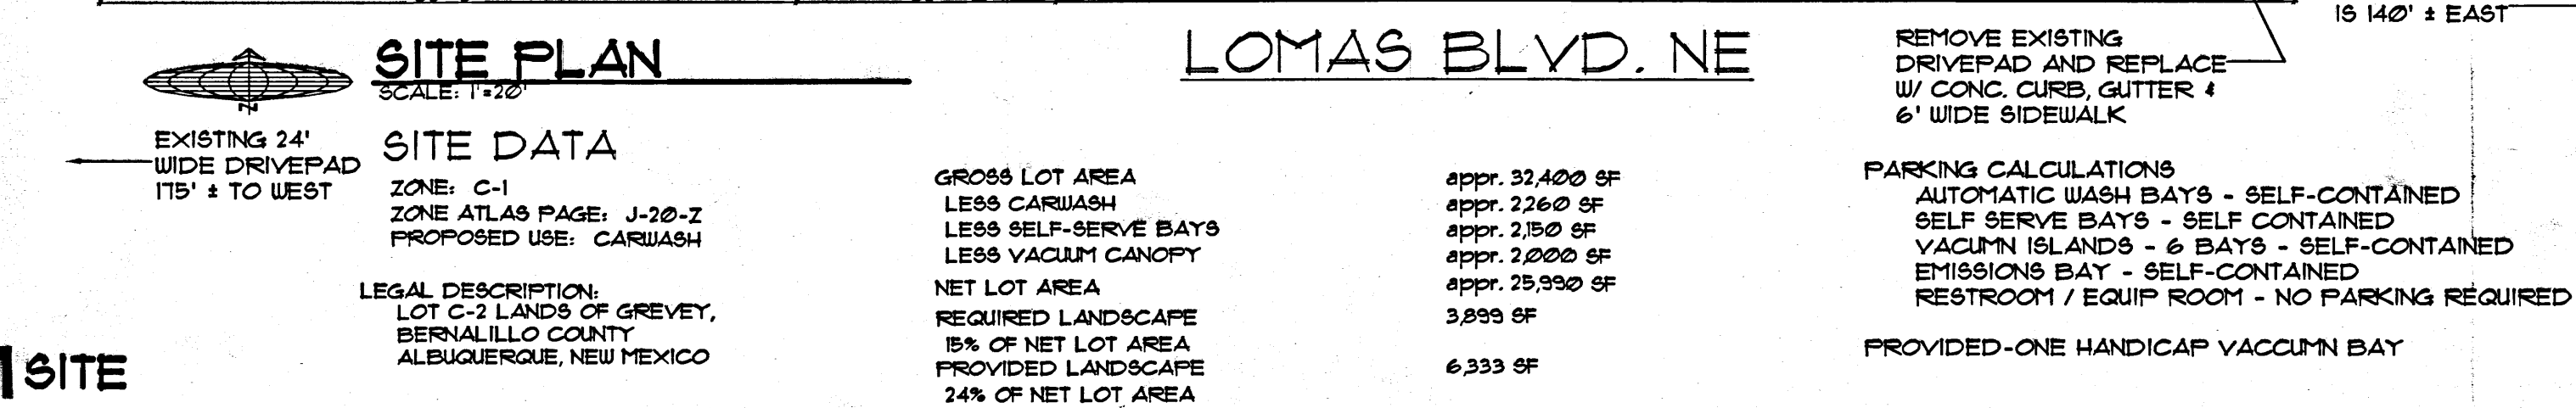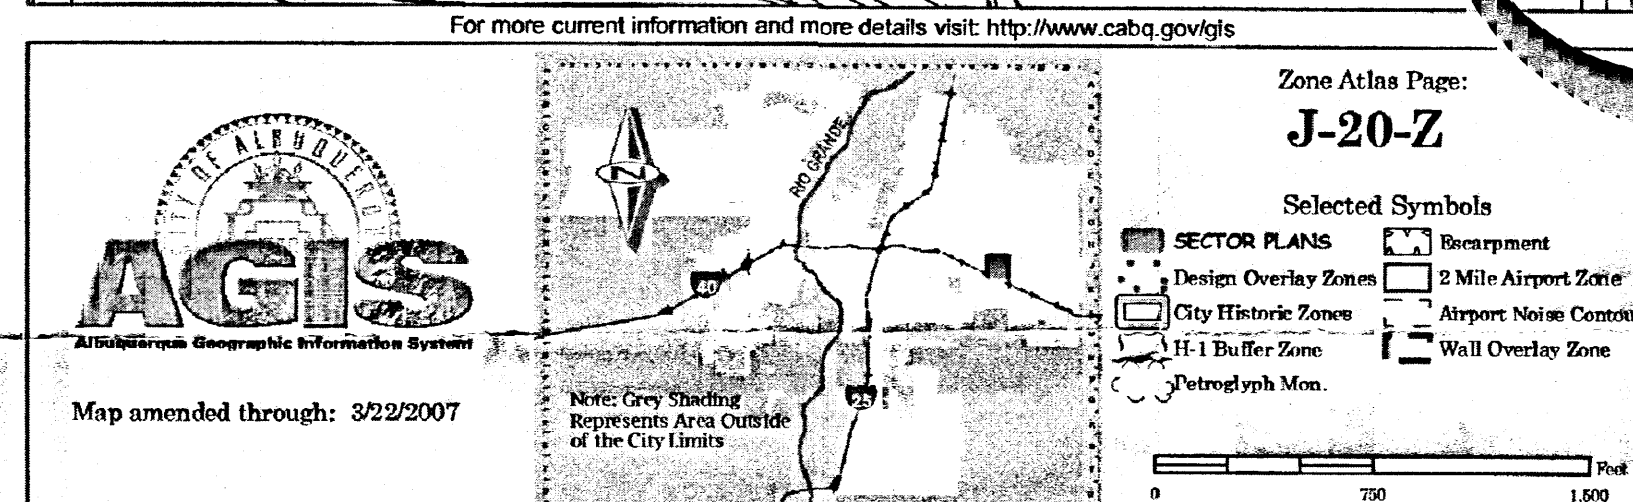

Mastervalue w/RPBA

NOTE

MAINTENANCE OF LANDSCAPE PROVIDED BY OWNER

PLANTINGS TO BE WATERED BY AUTO. DRIP  
IRRIGATION SYSTEM

WATER MANAGEMENT IS THE SOLE RESPONSIBILITY  
OF THE PROPERTY OWNER

IT IS THE INTENT OF THIS PLAN TO PROVIDE MIN.  
75% LIVE GROUNDCOVER OF LANDSCAPE AREAS  
AT MATURITY.

LANDSCAPE AREAS TO BE MULCHED WITH SANTA ANA TAN  
GRAVEL AT 2"-3" DEPTH OVER FILTER FABRIC

### PLANT LEGEND

| SYMBOL                                                                                | QTY. | BOTANICAL NAME      | COMMON NAME       | SIZE      |
|---------------------------------------------------------------------------------------|------|---------------------|-------------------|-----------|
|  | 6    | FRAXINUS            | RAYWOOD ASH       | 2" CAL    |
|  | 6    | PINUS NIGRA         | AUSTRIAN PINE     | 5'-6' HT. |
|  | 28   | VITEX AGNUS-CASTUS  | CHASTE TREE       | 15 GAL    |
|  | 28   | BERBERIS AQUIFOLIUM | EUROPEAN HAWTHORN | 2" CAL    |

**JIM MEDLEY, Architect AIA**  
NCARB Certificate No. 85,895

3100 Christine N. E. Albuquerque, NM 87111

email: jmedley@jim-medley-architect.com  
Phone (505) 292-3514 Fax (505) 294-5593

|                           |                      |                  |                   |
|---------------------------|----------------------|------------------|-------------------|
| Plan No.<br>0502/SED15001 | Date:<br>October '07 | Drawn by:<br>SED | Checked by:<br>MG |
|---------------------------|----------------------|------------------|-------------------|

Project:  
The Ultimate Car Wash  
Lomas Blvd.  
Albuquerque, New Mexico


|     |                                       |          |
|-----|---------------------------------------|----------|
| No. | Revision / Issue                      | Date:    |
| △   | REVISED PER CITY<br>OF ALBUQ. REVIEW. | 10/16/01 |
|     |                                       |          |
|     |                                       |          |

Sheet Description

**SITE PLAN &  
LANDSCAPE PLAN**

Sheet:

C1

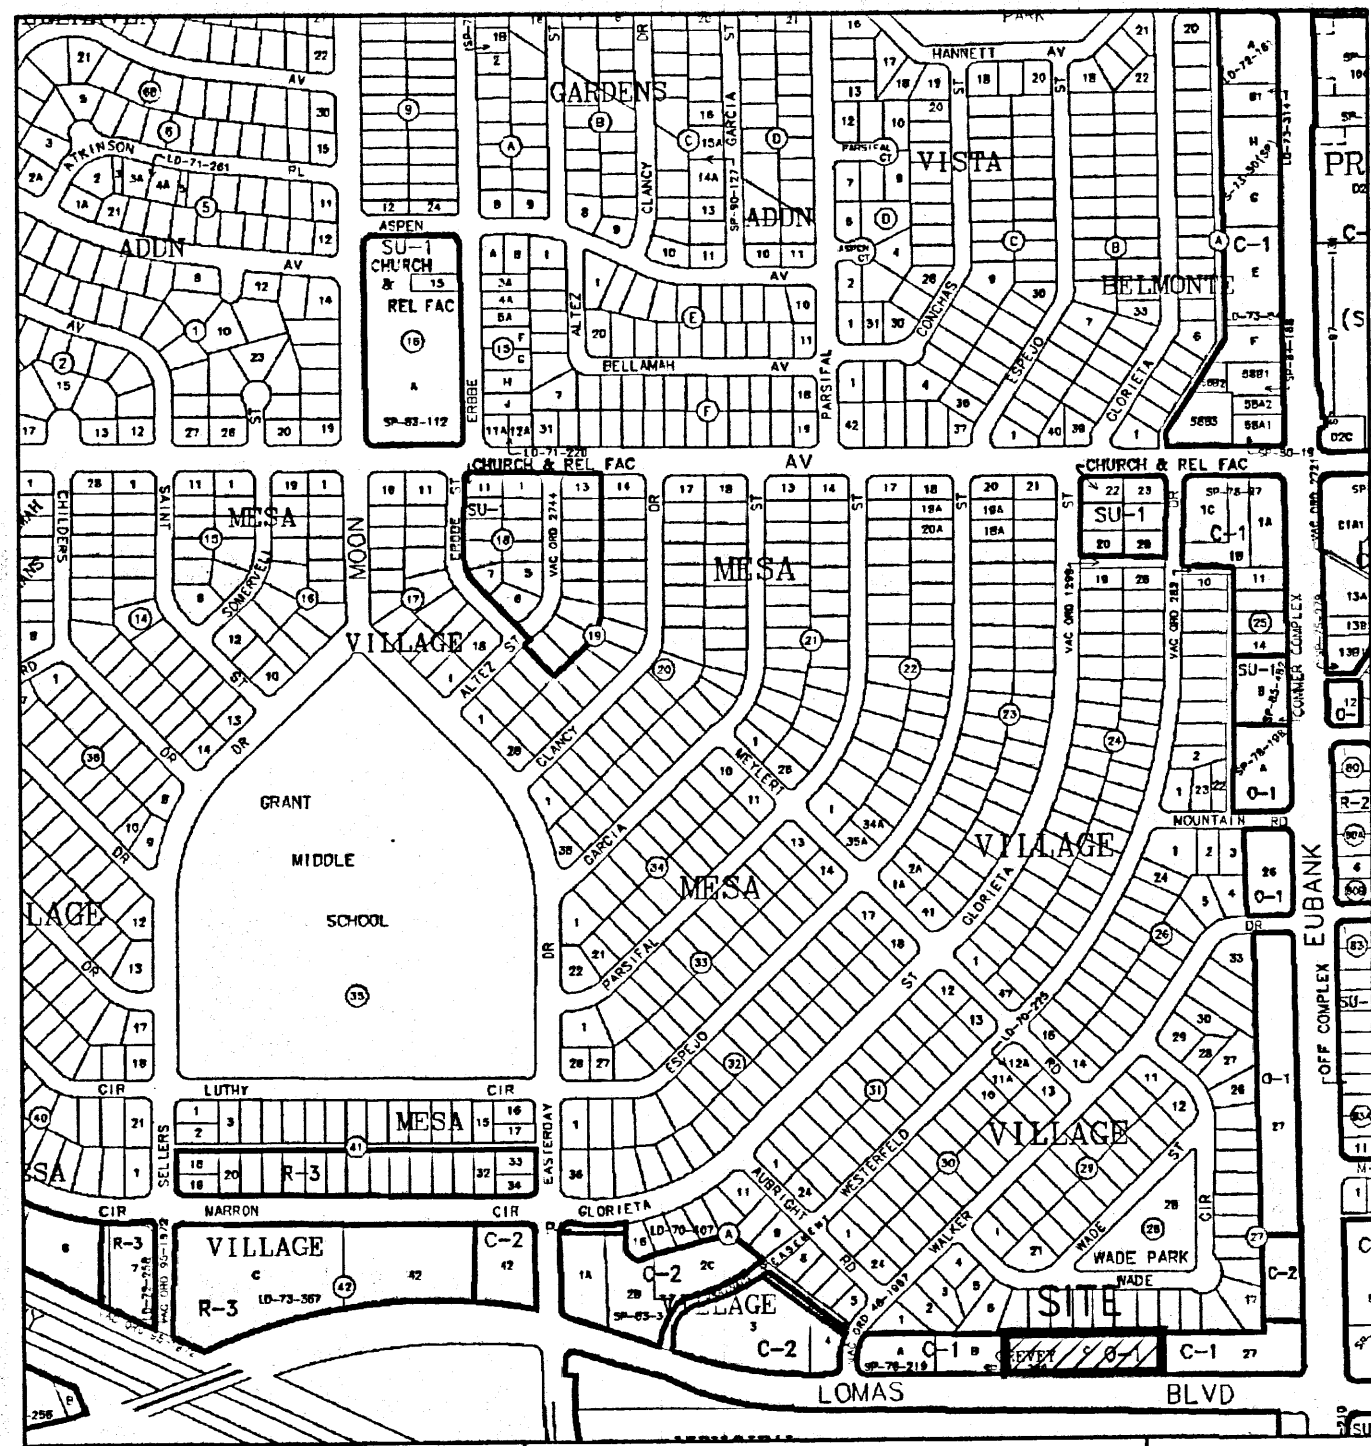

LEGAL DESCRIPTION / FLOOD NOTE

Tracts lettered "C-1" and "C-2", LANDS OF GREVEY, Albuquerque, Bernalillo County, New Mexico, as the same are shown and designated on the plot thereof, filed in the Office of the County Clerk of Bernalillo County, New Mexico, on xxxxx xx, 2007, in Plot Book 2007C, page xx.

The above described property is located within Zone "X" (No flood hazard)", Community Panel No. 350002 0358 F, dated November 19, 2003, and is not located within a Special Flood Hazard Boundary Indicated by FEMA Flood Insurance Rate Maps. Determination of Flood Hazard is by graphic plotting only.

BENCH MARK

ACS STA 19-J21  
1-3/4" Aluminum disk exposed to top of curb.  
NE quadrant of Lomas Blvd. & Eubank Blvd, NE  
ELEV. 5441.47  
TBM: #5 rebar and cap "LS 4078" at Southeast corner of property; ELEV. 5109.82  
ELEV. 5433.33

KEYED NOTES

- 1 REMOVE EXISTING ADVERTISING SIGN
- 2 REMOVE AND REPLACE EXISTING DRIVEWAY WITH 6" CONCRETE SIDEWALK AND SIDEWALK CULVERT PER COA STD. DWGS. 2430, 2415 AND 2236.
- 3 GRADE AND COMPACT 1" HIGH EARTHEN EROSION CONTROL BERM
- 4 RETAINING WALL CONSTRUCTED UNDER SEPARATE BUILDING PERMIT.
- 5 NEW DRIVEWAY TO BE CONSTRUCTED UNDER SEPARATE PERMIT.
- 6 CONSTRUCT NEW UNIDIRECTIONAL CURB RAMPS AT EACH SIDE OF NEW DRIVE CUT PER CITY OF ALB. DRAWING #2426.

SPECIFIC DRIVE AND INTERIOR CURB LAYOUT DETAILS AND DIMENSIONS APPEAR ON SITE PLAN, SHEET C2.

DRAINAGE CONCEPT:

THE DRAINAGE CONCEPT FOR THIS SITE IS TO FREE DISCHARGE THE EXCESS RUNOFF FROM IMPERVIOUS SURFACES VIA CONCRETE SIDEWALK CULVERTS TO LOMAS BLVD. HISTORICAL FLOWS WILL BE ALLOWED TO CONTINUE TO DISCHARGE TO THE WEST VIA GRADED LANDSCAPE BUFFER.

OFFSITE FLOW INFORMATION

THIS SITE ACCEPTS EXISTING NATURAL FLOWS ENTERING FROM TRACT "D" FROM THE EAST. EXISTING UPSTREAM CONTRIBUTORY AREA IS 0.33 ACRE. 100% C TREATMENT (COMPACTED SOIL). DURING THE 100-YEAR FLOW, 1.04 CFS OF RUNOFF, PEAK IS GENERATED BY THE UPSTREAM SITE. ENTRY IS VIA SHEET FLOW. THERE ARE NO DISCERNIBLE FLOWLINES FROM THE EAST.

DRAINAGE NOTES:

- ROOF DRAINAGE CONVEYED TO PARKING OR DRIVE SURFACES LOTS VIA GUTTER AND DOWNSPOUT. SEE ROOF PLAN FOR LOCATIONS.
- ALL ELEVATIONS GIVEN ARE TO TOP OF PROPOSED GRADE

NOTICE TO CONTRACTOR


PROPOSED CONTOURS AND SPOT ELEVATIONS SHOWN ARE TO FINISHED SURFACES AND ARE PROVIDED FOR THE PURPOSE OF SHOWING FLOW ROUTING.  
CONTRACTOR IS RESPONSIBLE FOR THE ABATEMENT OF SEDIMENT ONTO ADJOINING PUBLIC RIGHTS-OF-WAY DURING CONSTRUCTION AND FOR THE REMOVAL OF ANY SEDIMENT DEPOSITED IN PUBLIC RIGHT-OF-WAY.  
CONTRACTOR SHALL OBTAIN ALL REQUIRED PERMITS PRIOR TO ANY GRADING OR CONSTRUCTION.  
SITE IS NOT SUBJECT TO NPDES SWPPP REQUIREMENTS (< 1 ACRE).  
ALL IMPROVEMENTS WITHIN CITY OF ALBUQUERQUE RIGHT OF WAY MUST BE CONSTRUCTED BY CITY OF ALBUQUERQUE WORK ORDER.

ONSITE HYDROLOGY

DRAINAGE DATA


| THIS SITE LIES WITHIN PRECIPITATION ZONE 2 |                        |                |                |               |                           |                  |            |
|--------------------------------------------|------------------------|----------------|----------------|---------------|---------------------------|------------------|------------|
| Condition                                  | Return Table 4 (Years) | Treatment Type | Area (sq. ft.) | Precip. (in.) | Runoff Table A-9 (cfs/ac) | Volume (cu. Ft.) | Rate (cfs) |
| EXISTING                                   | 100                    | A              | 0              | 0.53          | 1.56                      | 0.0              | 0.00       |
|                                            |                        | B              | 32,398         | 0.78          | 2.28                      | 2,105.9          | 1.70       |
|                                            |                        | C              | 0              | 1.13          | 3.14                      | 0.0              | 0.00       |
|                                            |                        | D              | 0              | 2.12          | 4.70                      | 0.0              | 0.00       |
| EXISTING                                   | 10                     | A              | 0              | 0.13          | 0.38                      | 0.0              | 0.00       |
|                                            |                        | B              | 32,398         | 0.28          | 0.95                      | 756.0            | 0.71       |
|                                            |                        | C              | 0              | 0.52          | 1.71                      | 0.0              | 0.00       |
|                                            |                        | D              | 0              | 1.34          | 3.14                      | 0.0              | 0.00       |
| DEVELOPED                                  | 100                    | A              | 0              | 0.53          | 1.56                      | 0.0              | 0.00       |
|                                            |                        | B              | 6,333          | 0.78          | 2.28                      | 411.6            | 0.33       |
|                                            |                        | C              | 0              | 1.13          | 3.14                      | 0.0              | 0.00       |
|                                            |                        | D              | 26,065         | 2.12          | 4.70                      | 4,604.8          | 2.81       |
| DEVELOPED                                  | 10                     | A              | 0              | 0.13          | 0.38                      | 0.0              | 0.00       |
|                                            |                        | B              | 6,333          | 0.28          | 0.95                      | 147.8            | 0.14       |
|                                            |                        | C              | 0              | 0.52          | 1.71                      | 0.0              | 0.00       |
|                                            |                        | D              | 26,065         | 1.34          | 3.14                      | 2,910.6          | 1.88       |
| TOTAL (EXT)                                | 100                    |                |                |               |                           | 2,105.9          | 1.7        |
|                                            | 10                     |                |                |               |                           | 756.0            | 0.7        |
| TOTAL (DEV)                                | 100                    |                |                |               |                           | 5,016.5          | 3.1        |
|                                            | 10                     |                |                |               |                           | 3,058.4          | 2.0        |

BLOCK 27  
MESA VILLAGE

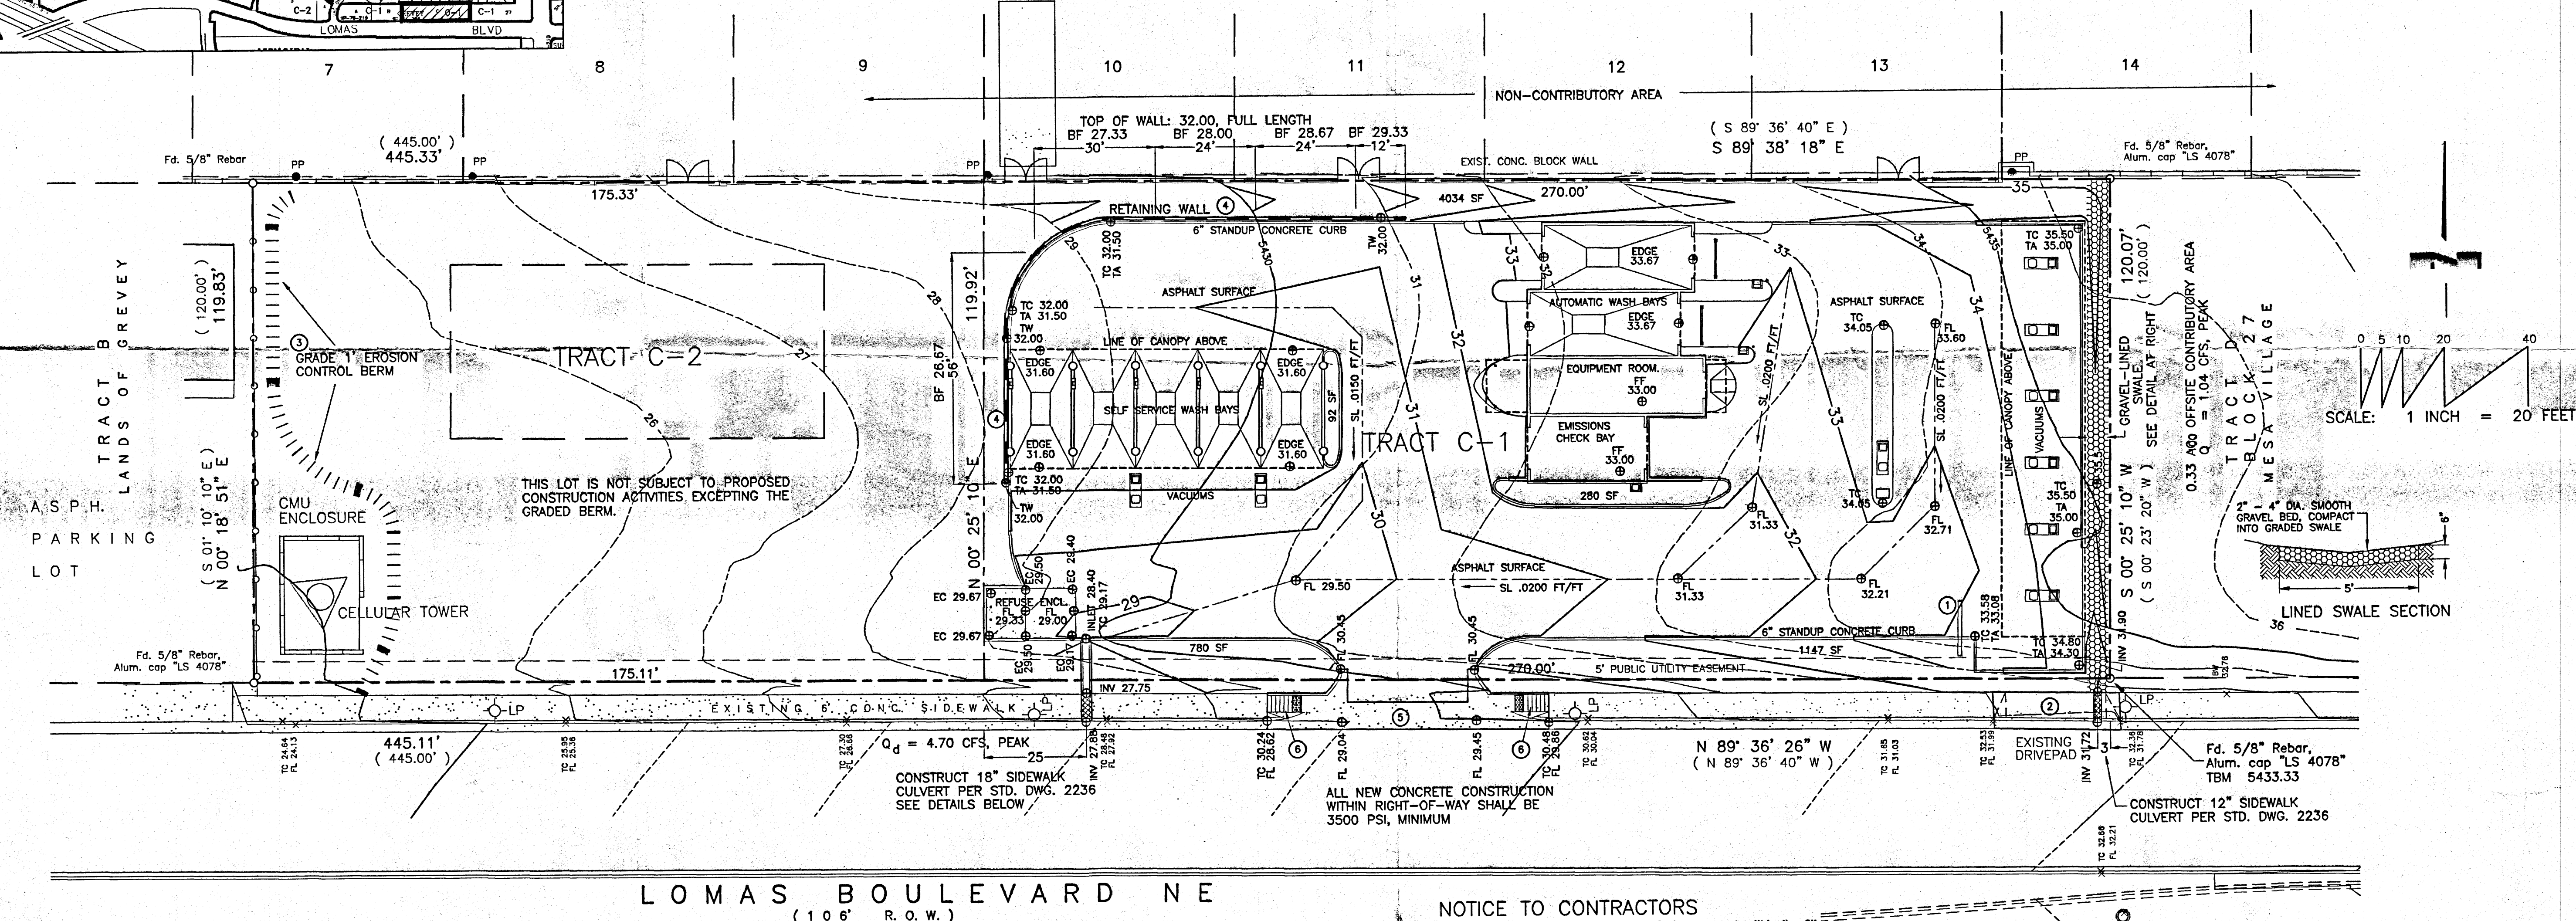

LEGEND:

- WM WATER METER
- ELEC ELECTRIC SERVICE RISER
- CO SANITARY SEWER CLEANOUTS
- TEL TELEPHONE RISER
- FH FIRE HYDRANT
- MH SANITARY SEWER MANHOLE
- WV WATER VALVE
- LP LIGHT POLE
- SPOT ELEVATION UNLESS OTHERWISE INDICATED, SPOT ELEVATIONS ARE TO NATURAL GRADE
- TC TOP OF CURB
- FL FLOWLINE
- BW BACK OF SIDEWALK
- EC EDGE OF CONCRETE
- RM RIM OF MANHOLE
- Rectangular Channel Analysis & Design
- Open Channel - Uniform flow
- Solve For Discharge
- Given Constant Data:
- Bottom Width..... 1.50
- Mannings "n"..... 0.013
- Channel Slope..... 0.0200
- Channel Depth..... 0.50
- COMPUTED COMPUTED
- Bottom Width..... 1.50
- Mannings Channel Slope..... 0.013
- Channel Depth..... 0.50
- Channel Velocity..... 5.43
- Discharge..... 7.24
- Open Channel Flow Module, Version 3.12 (c)
- Haestad Methods, Inc. • 37 Brookside Rd • Waterbury, Ct 06708

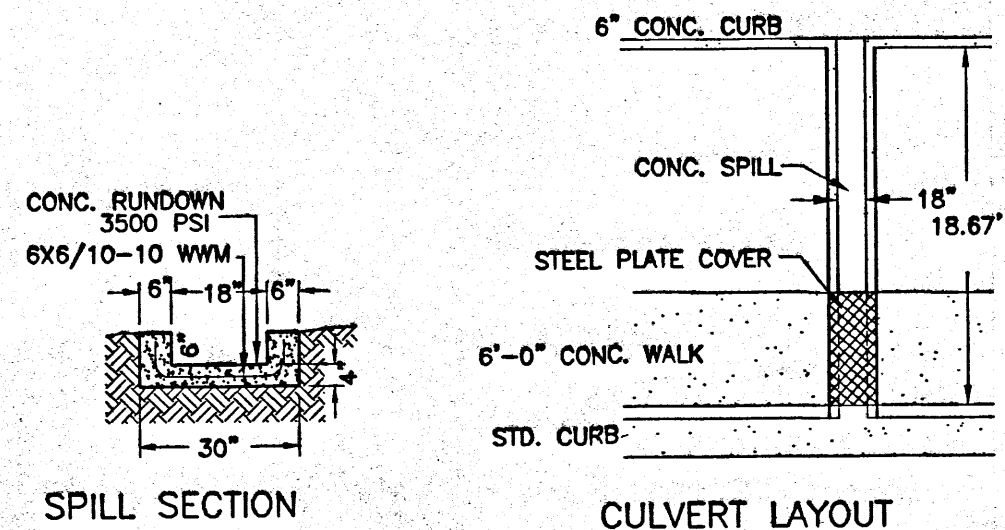


NOTICE TO CONTRACTORS

1. An excavation/barricade permit will be required before beginning any work within the City of Albuquerque Right-of-way. An approved copy of these plans must be submitted at the time of application for these permits.
2. All work detailed on these plans to be done, except as otherwise stated or provided hereon, will be constructed in accordance with "City of Albuquerque Interim Standard Specification for Public Works Construction, 1986", latest revision.
3. Two working days prior to any excavation, the contractor must contact Line Locating Service, 280-1990, for location of existing utilities.
4. Prior to construction, the contractor will excavate and verify the horizontal and vertical locations of all construction. Should a conflict exist, the contractor will notify the Construction Engineer so that the conflict can be resolved with a minimum amount of delay.
5. The contractor will be responsible for performing soil density tests as required by the City of Albuquerque.
6. Owner shall be responsible for maintenance of sidewalk culverts and shall ensure proper operation of culverts at all times.
7. Work on arterial streets shall be performed on a 24-hour basis.

I, THOMAS D. JOHNSTON, NEW MEXICO REGISTERED PROFESSIONAL ENGINEER NO. 17158, DO HEREBY CERTIFY THAT I INSPECTED THIS SITE ON APRIL 26, 2007, AND THAT, AS OF THAT DATE, THERE HAD BEEN NO RECENT ALTERATION OF GRADE OR EVIDENCE OF GRADING OPERATIONS ON THIS SITE.


THOMAS D. JOHNSTON, NMPE NO. 17158

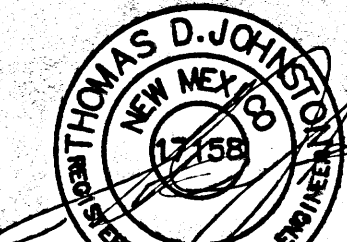

DRAINAGE AND GRADING PLAN  
ULTIMATE CAR WASH

ENGINEERING INC.  
330 LOUISIANA BLVD. NE  
ALBUQUERQUE, NM 87108

(505)266-7256  
Fax: (505) 255-2887

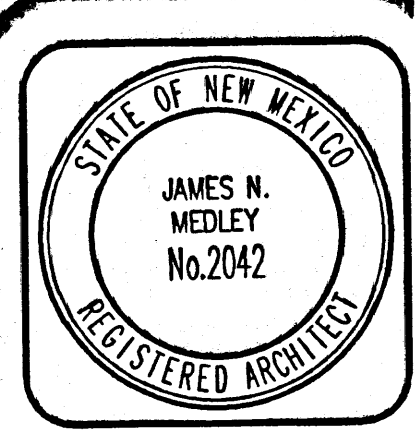

JIM MEDLEY, Architect AIA  
NCEM Certificate No. 35,895  
3100 Christine N. E. Albuquerque, NM 87111  
email: jmedley@jim-medley-architect.com  
Phone (505) 292-3514 Fax (505) 294-5593


Plan No. 0502/SED25001  
Date:  
Drawn by SED  
Checked by MG

The Ultimate Car Wash  
Lomas Blvd. NE  
Albuquerque, New Mexico

| No. | Revision / Issue | Date: |
|-----|------------------|-------|
|     |                  |       |
|     |                  |       |
|     |                  |       |

GRADING AND DRAINAGE PLAN

Sheet:  
C1

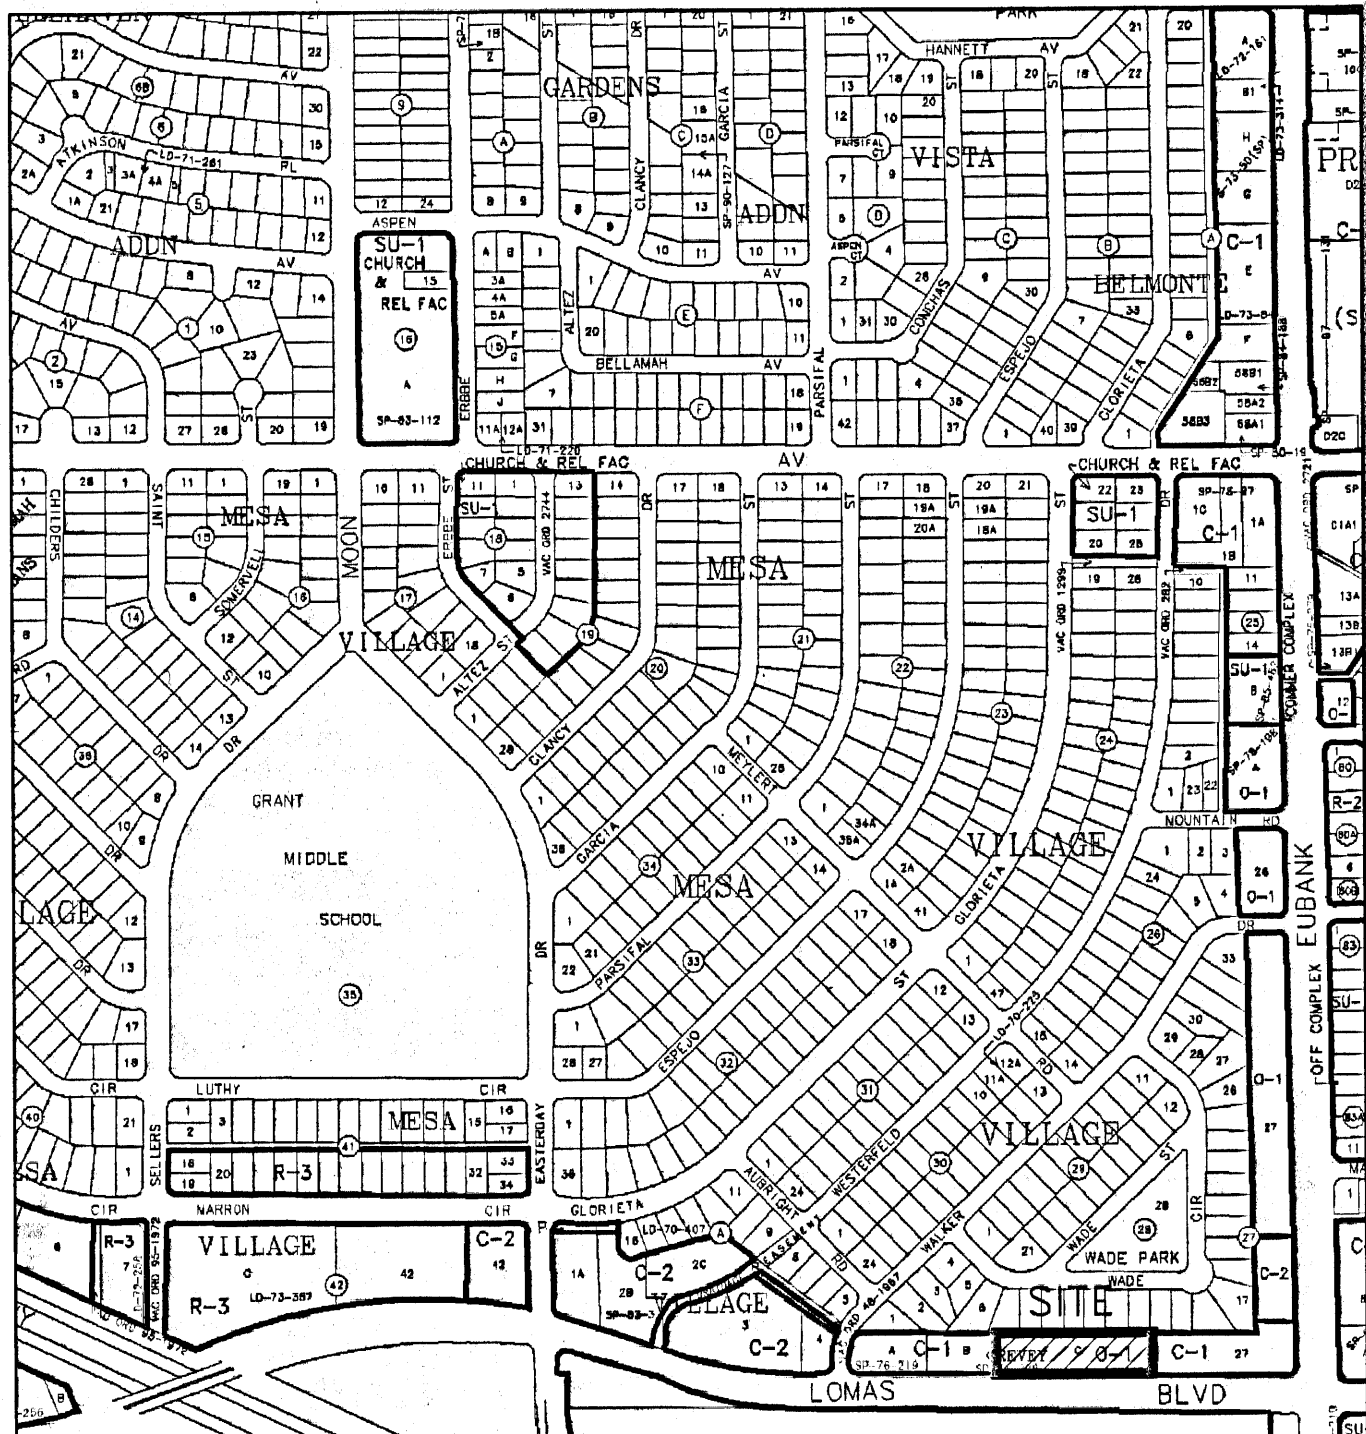

LEGAL DESCRIPTION / FLOOD NOTE

Tracts lettered "C-1" and "C-2", LANDS OF GREVEY, Albuquerque, Bernalillo County, New Mexico, as the same are shown and designated on the plat thereof, filed in the Office of the County Clerk of Bernalillo County, New Mexico, on xxxxx xx, 2007, in Plat Book 2007C, page xx.

The above described property is located within Zone "X" (No flood hazard)". Community Panel No. 350002 0358 F, dated November 19, 2003, and is not located within a Special Flood Hazard Boundary indicated by FEMA Flood Insurance Rate Maps. Determination of Flood Hazard is by graphic plotting only.

BENCH MARK

ACS STA 19-J21  
1-1/4" Aluminum disk epoxied to top of curb,  
NE quadrant of Lomas Blvd. & Eubank Blvd, NE  
ELEV. 5441.47

TBM: #5 rebar and cap "LS 4078" at Southeast corner of property; ELEV. 5109.82  
ELEV. 5433.33

KEYED NOTES

- REMOVE EXISTING ADVERTISING SIGN
- REMOVE AND REPLACE EXISTING DRIVEPAD WITH 6" CONCRETE SIDEWALK AND SIDEWALK CULVERT PER COA STD. DWGS. 2430, 2415 AND 2236.
- GRADE AND COMPACT 1" HIGH EARTHEN EROSION CONTROL BERM
- RETAINING WALL CONSTRUCTED UNDER SEPARATE BUILDING PERMIT.
- NEW DRIVEWAY TO BE CONSTRUCTED UNDER SEPARATE PERMIT.
- CONSTRUCT NEW UNIDIRECTIONAL CURB RAMPS AT EACH SIDE OF NEW DRIVE CUT PER CITY OF ALB. DRAWING #2428.

SPECIFIC DRIVE AND INTERIOR CURB LAYOUT DETAILS AND DIMENSIONS  
APPEAR ON SITE PLAN, SHEET C2.

DRAINAGE CONCEPT:

THE DRAINAGE CONCEPT FOR THIS SITE IS TO FREE DISCHARGE THE EXCESS RUNOFF FROM IMPERVIOUS SURFACES VIA CONCRETE SIDEWALK CULVERTS TO LOMAS BLVD. HISTORICAL FLOWS WILL BE ALLOWED TO CONTINUE TO DISCHARGE TO THE WEST VIA GRADED LANDSCAPE BUFFER.

OFFSITE FLOW INFORMATION

THIS SITE ACCEPTS EXISTING NATURAL FLOWS ENTERING FROM TRACT "D" FROM THE EAST. EXISTING UPSTREAM CONTRIBUTORY AREA IS 0.33 ACRE, 100% C TREATMENT (COMPACTED SOIL). DURING THE 100-YEAR FLOW, 1.04 CFS OF RUNOFF PEAK IS GENERATED BY THE UPSTREAM SITE. ENTRY IS VIA SHEET FLOW. THERE ARE NO DISCERNIBLE FLOWLINES FROM THE EAST.

DRAINAGE NOTES:

- ROOF DRAINAGE CONVEYED TO PARKING OR DRIVE SURFACES LOTS VIA GUTTER AND DOWNSPOUT. SEE ROOF PLAN FOR LOCATIONS.
- ALL ELEVATIONS GIVEN ARE TO TOP OF PROPOSED GRADE.

NOTICE TO CONTRACTOR

PROPOSED CONTOURS AND SPOT ELEVATIONS SHOWN ARE TO FINISHED SURFACES AND ARE PROVIDED FOR THE PURPOSE OF SHOWING FLOW ROUTING.

CONTRACTOR IS RESPONSIBLE FOR THE ABATEMENT OF SEDIMENT ONTO ADJOINING PUBLIC RIGHTS-OF-WAY DURING CONSTRUCTION AND FOR THE REMOVAL OF ANY SEDIMENT DEPOSITED IN PUBLIC RIGHT-OF-WAY.

CONTRACTOR SHALL OBTAIN ALL REQUIRED PERMITS PRIOR TO ANY GRADING OR CONSTRUCTION.

SITE IS NOT SUBJECT TO NPDES SWPPP REQUIREMENTS (< 1 ACRE).


ALL IMPROVEMENTS WITHIN CITY OF ALBUQUERQUE RIGHT OF WAY MUST BE CONSTRUCTED BY CITY OF ALBUQUERQUE WORK ORDER.

ONSITE HYDROLOGY

DRAINAGE DATA

THIS SITE LIES WITHIN PRECIPITATION ZONE 2

| Condition   | Return<br>Table 4<br>(Years) | Treatment<br>Type | Area<br>(sq. ft.) | Precip.<br>(in.) | Runoff<br>Table A-9<br>(cfs/ac) | Volume<br>(cu. Ft.) | Rate<br>(cfs) |
|-------------|------------------------------|-------------------|-------------------|------------------|---------------------------------|---------------------|---------------|
| EXISTING    | 100                          | A                 | 0                 | 0.53             | 1.56                            | 0.0                 | 0.00          |
|             |                              | B                 | 32,398            | 0.78             | 2.28                            | 2,105.9             | 1.70          |
|             |                              | C                 | 0                 | 1.13             | 3.14                            | 0.0                 | 0.00          |
|             |                              | D                 | 0                 | 2.12             | 4.70                            | 0.0                 | 0.00          |
| EXISTING    | 10                           | A                 | 0                 | 0.13             | 0.38                            | 0.0                 | 0.00          |
|             |                              | B                 | 32,398            | 0.28             | 0.95                            | 758.0               | 0.71          |
|             |                              | C                 | 0                 | 0.52             | 1.71                            | 0.0                 | 0.00          |
|             |                              | D                 | 0                 | 1.34             | 3.14                            | 0.0                 | 0.00          |
| DEVELOPED   | 100                          | A                 | 0                 | 0.53             | 1.56                            | 0.0                 | 0.00          |
|             |                              | B                 | 6,333             | 0.78             | 2.28                            | 411.6               | 0.33          |
|             |                              | C                 | 0                 | 1.13             | 3.14                            | 0.0                 | 0.00          |
|             |                              | D                 | 26,065            | 2.12             | 4.70                            | 4,804.8             | 2.81          |
| DEVELOPED   | 10                           | A                 | 0                 | 0.13             | 0.38                            | 0.0                 | 0.00          |
|             |                              | B                 | 6,333             | 0.28             | 0.95                            | 147.8               | 0.14          |
|             |                              | C                 | 0                 | 0.52             | 1.71                            | 0.0                 | 0.00          |
|             |                              | D                 | 26,065            | 1.34             | 3.14                            | 2,910.6             | 1.88          |
| TOTAL (EXT) | 100                          |                   |                   |                  |                                 | 2,105.9             | 1.7           |
|             | 10                           |                   |                   |                  |                                 | 758.0               | 0.7           |
| TOTAL (DEV) | 100                          |                   |                   |                  |                                 | 5,016.5             | 3.1           |
|             | 10                           |                   |                   |                  |                                 | 3,058.4             | 2.0           |

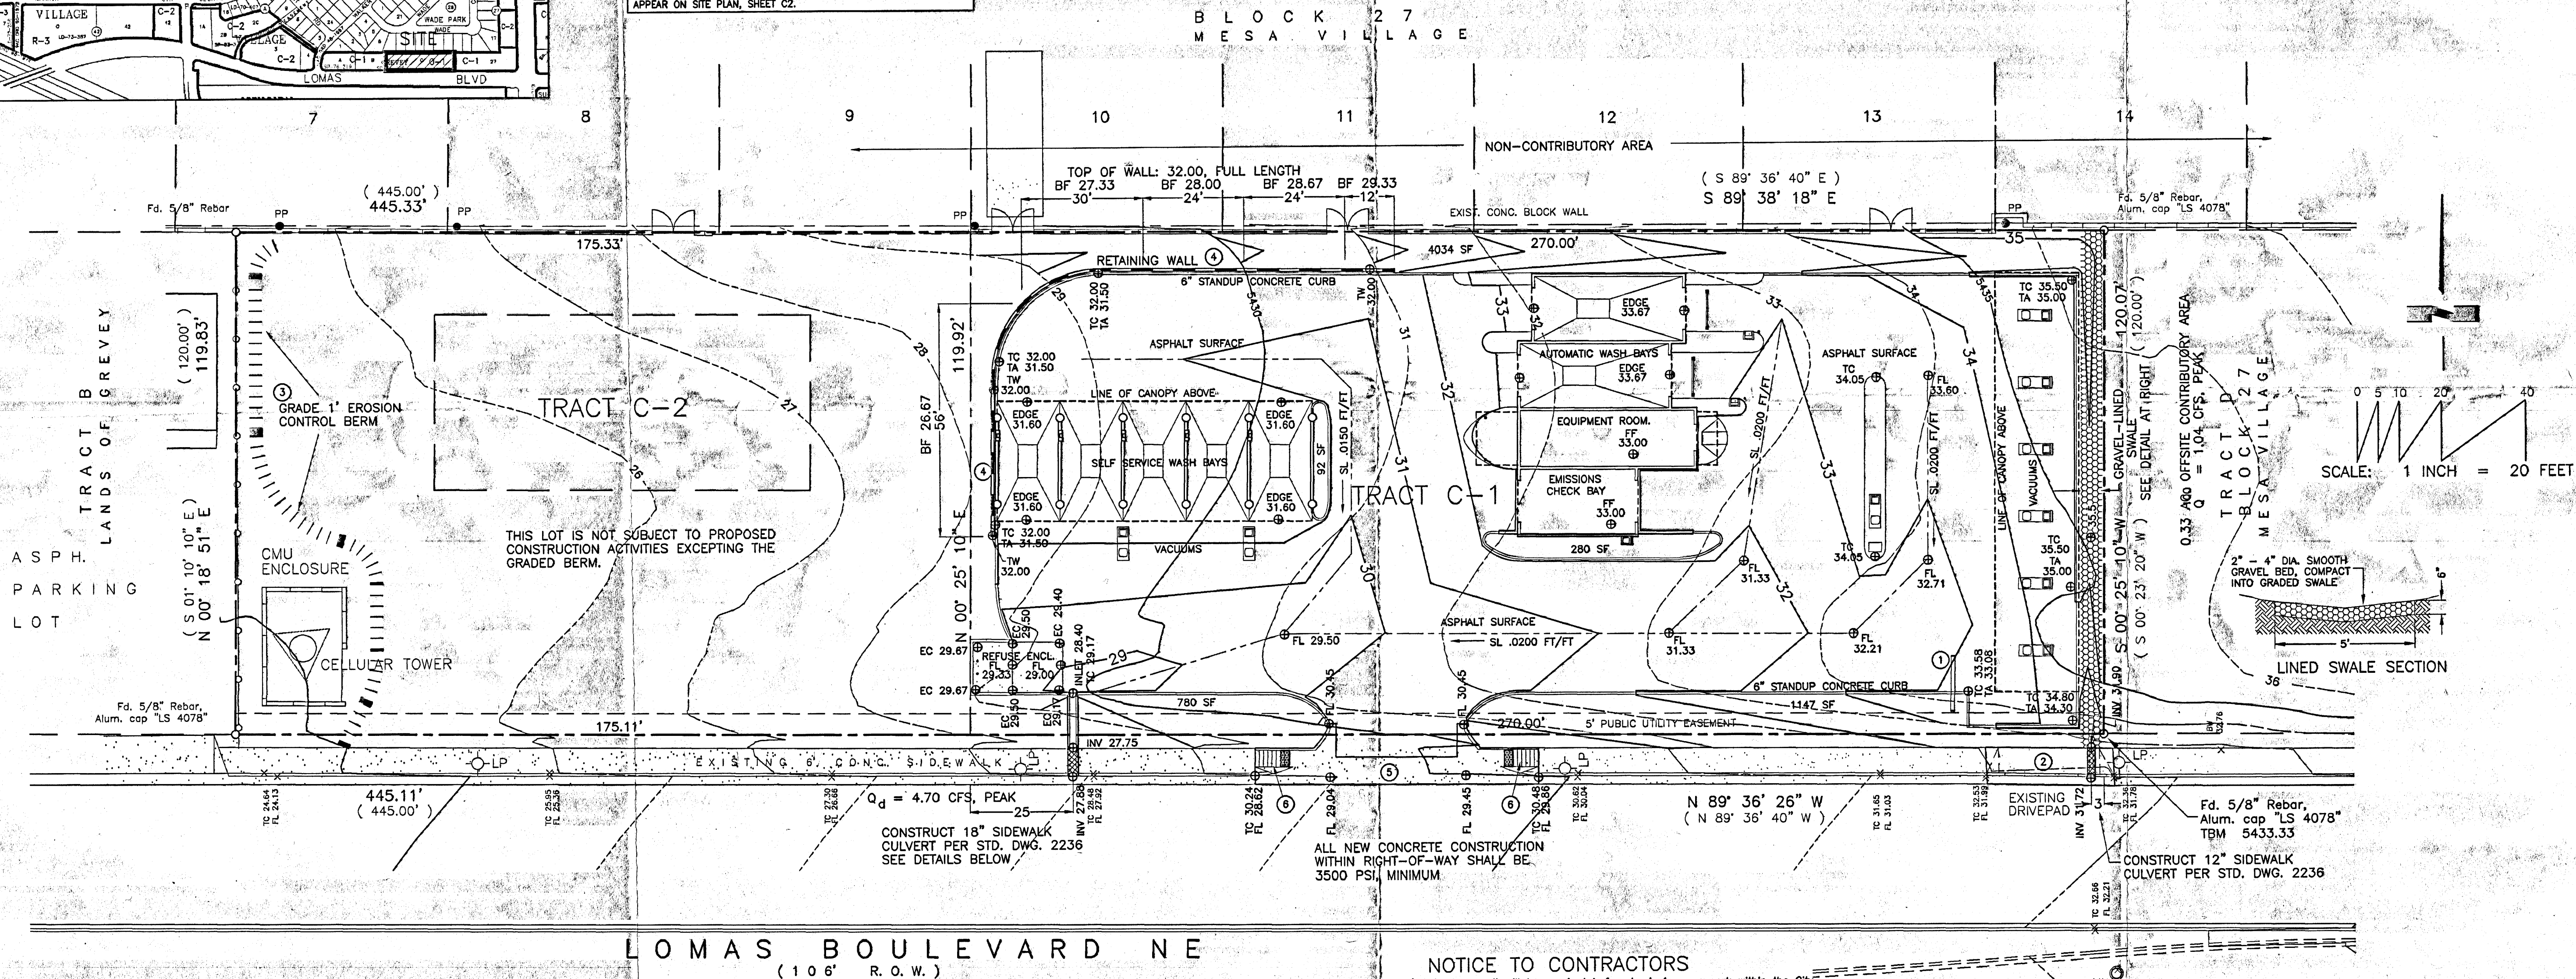

LEGEND:

- WM WATER METER
- ELEC ELECTRIC SERVICE RISER
- CD SANITARY SEWER CLEANOUTS
- TEL TELEPHONE RISER
- FH FIRE HYDRANT
- MSH SANITARY SEWER MANHOLE
- WV WATER VALVE
- LP LIGHT POLE
- SPOT ELEVATION
- UNLESS OTHERWISE INDICATED, SPOT ELEVATIONS ARE TO NATURAL GRADE
- TC TOP OF CURB
- FL FLOWLINE
- GW BACK OF SIDEWALK
- EC EDGE OF CONCRETE
- RM RIM OF MANHOLE


Rectangular Channel Analysis & Design  
Open Channel - Uniform flow

Solve For Discharge  
Given Constant Data:  
Bottom Width..... 1.50  
Manning's 'n'..... 0.013  
Channel Slope..... 0.0200  
Channel Depth..... 0.50

COMPUTED COMPUTED

| Bottom Width ft | Manning's 'n' | Channel Slope ft/ft | Channel Depth ft | Channel Velocity cfs | Discharge cfs |
|-----------------|---------------|---------------------|------------------|----------------------|---------------|
| 1.50            | 0.013         | 0.0200              | 0.50             | 5.43                 | 7.24          |

Open Channel Flow Module, Version 3.12 (c)  
Haestad Methods, Inc. • 37 Brookside Rd • Waterbury, Ct 06708

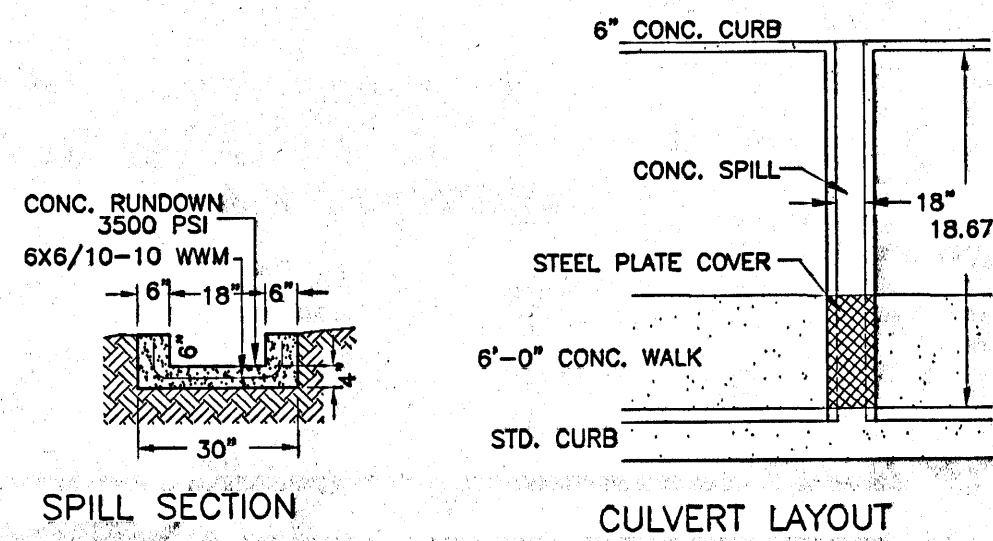

SIDEWALK CULVERTS


NOTICE TO CONTRACTORS

- An excavation/barricade permit will be required before beginning any work within the City of Albuquerque Right-of-way. An approved copy of these plans must be submitted at the time of application for these permits.
- All work detailed on these plans to be done, except as otherwise stated or provided hereon, will be constructed in accordance with "City of Albuquerque Interim Standard Specification for Public Works Construction, 1988", latest revision.
- Two working days prior to any excavation, the contractor must contact Line Locating Service, 280-1990, for location of existing utilities.
- Prior to construction, the contractor will excavate and verify the horizontal and vertical locations of all construction. Should a conflict exist, the contractor will notify the Construction Engineer so that the conflict can be resolved with a minimum amount of delay.
- The contractor will be responsible for performing soil density tests as required by the City of Albuquerque.
- Owner shall be responsible for maintenance of sidewalk culverts and shall ensure proper operation of culverts at all times.

| APPROVALS FOR                      | NAME | DATE | TITLE OF PROJECT                         |
|------------------------------------|------|------|------------------------------------------|
| DESIGN/CITY HYDROLOGY              |      |      | FOR: ULTIMATE CAR WASH LOMAS BLVD., NE   |
| CONSTRUCTION/CONSTRUCTION ENGINEER |      |      | PROJECT NO. ZONE ATLAS SHEET 1 OF 1 J-20 |
| ACCEPTANCE/CONSTRUCTION INSPECTOR  |      |      |                                          |



I, THOMAS D. JOHNSTON, NEW MEXICO REGISTERED PROFESSIONAL ENGINEER NO. 17158, DO HEREBY CERTIFY THAT I INSPECTED THIS SITE ON APRIL 26, 2007, AND THAT, AS OF THAT DATE, THERE HAD BEEN NO RECENT ALTERATION OF GRADE OR EVIDENCE OF GRADING OPERATIONS ON THIS SITE.

THOMAS D. JOHNSTON, NMPE NO. 17158

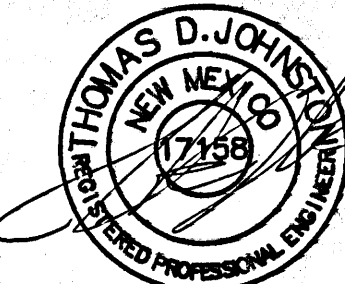

DRAINAGE AND GRADING PLAN  
ULTIMATE CAR WASH

ENGINEERING, INC.  
330 LOUISIANA BLVD. NE  
ALBUQUERQUE, NM 87108

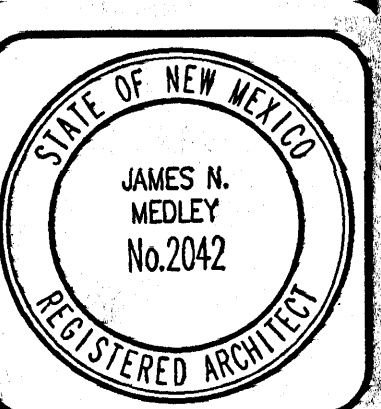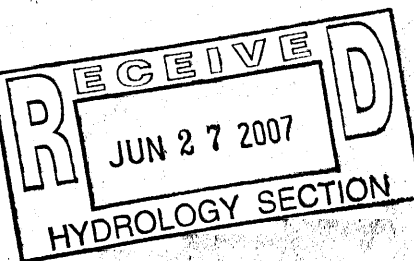

JIM MEDLEY, Architect AIA  
NCEM Certificate No. 85,896  
3100 Christine N. E. Albuquerque, NM 87111  
email: jmedley@jim-medley-architect.com  
Phone (505) 292-3514 Fax (505) 294-5593

Plan No. 0502/SED25001  
Date:  
Drawn by: SED  
Checked by: MG

The Ultimate Car Wash  
Lomas Blvd. NE  
Albuquerque, New Mexico

| No. | Revision / Issue | Date: |
|-----|------------------|-------|
|     |                  |       |

GRADING AND  
DRAINAGE PLAN

Sheet:

C1