

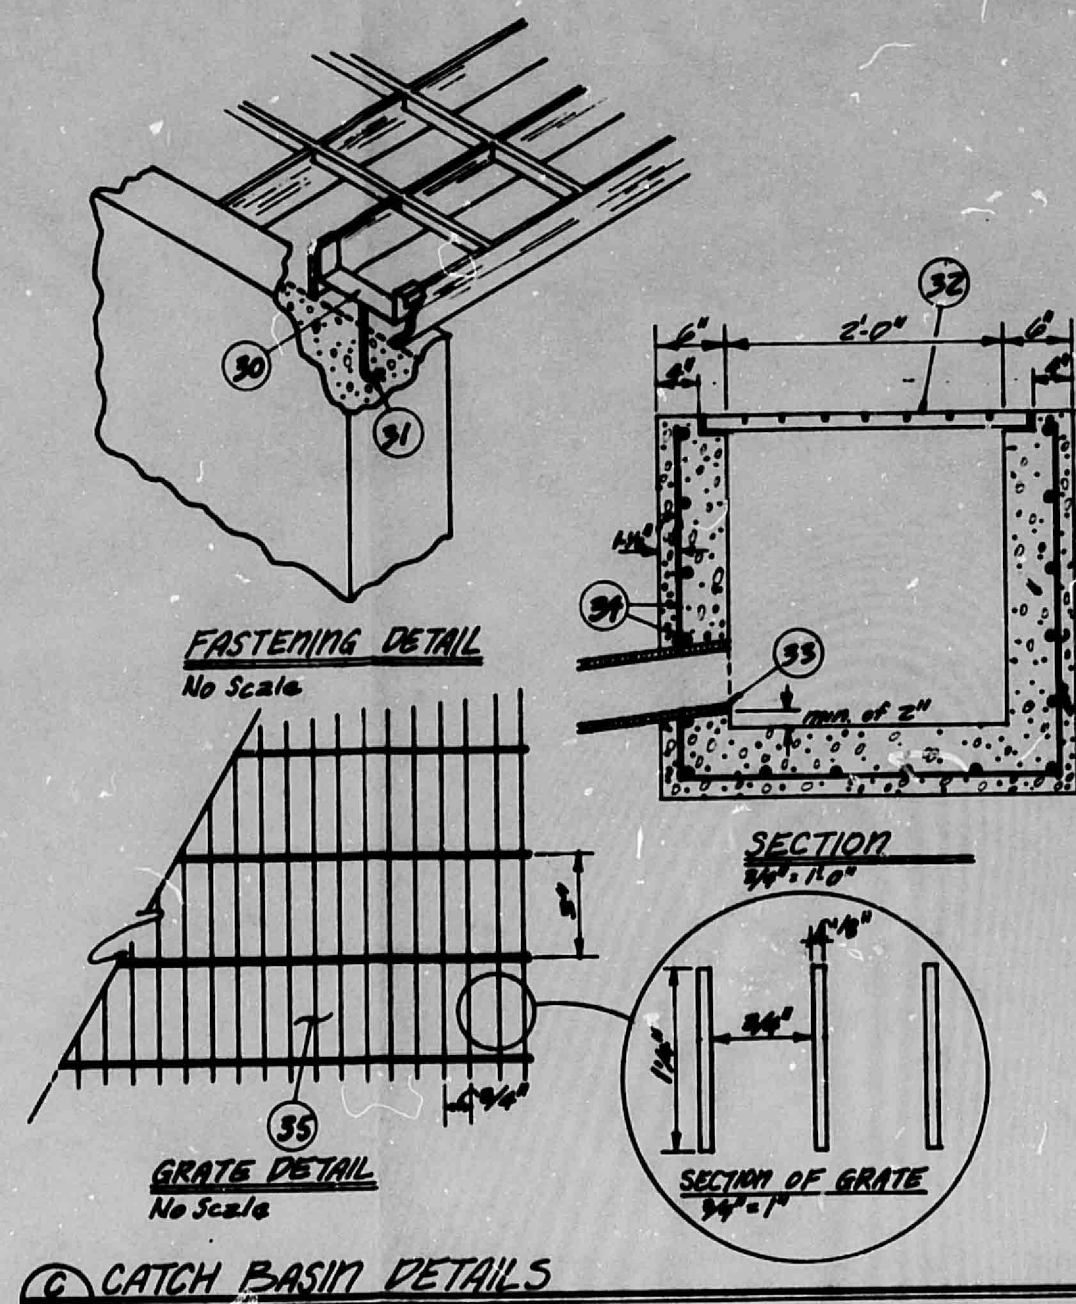


AS-BUILT DRAINAGE REPORT FOR 1416 JUAN TABO BLVD. N.E. ALBUQ., NEW MEXICO

LEGAL DESCRIPTION
TRACT 2-2-A-1, DALE J. BELLAMAH'S
UNIT 4, EASTRIDGE, ALBUQUERQUE,
NEW MEXICO

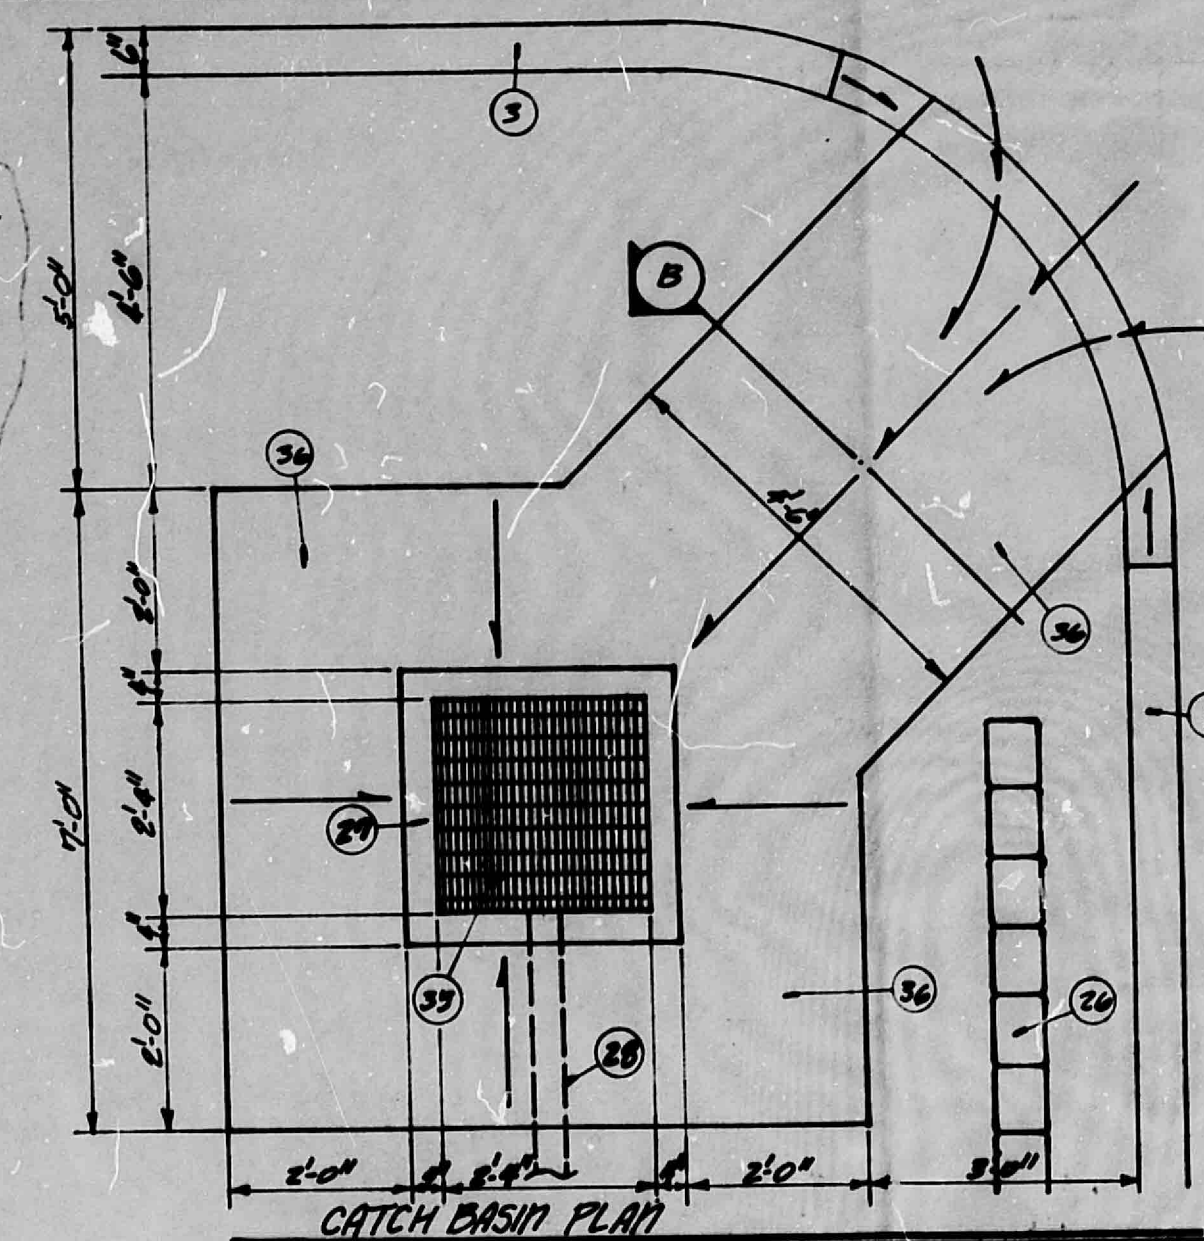

CATCH BASIN DETAILS

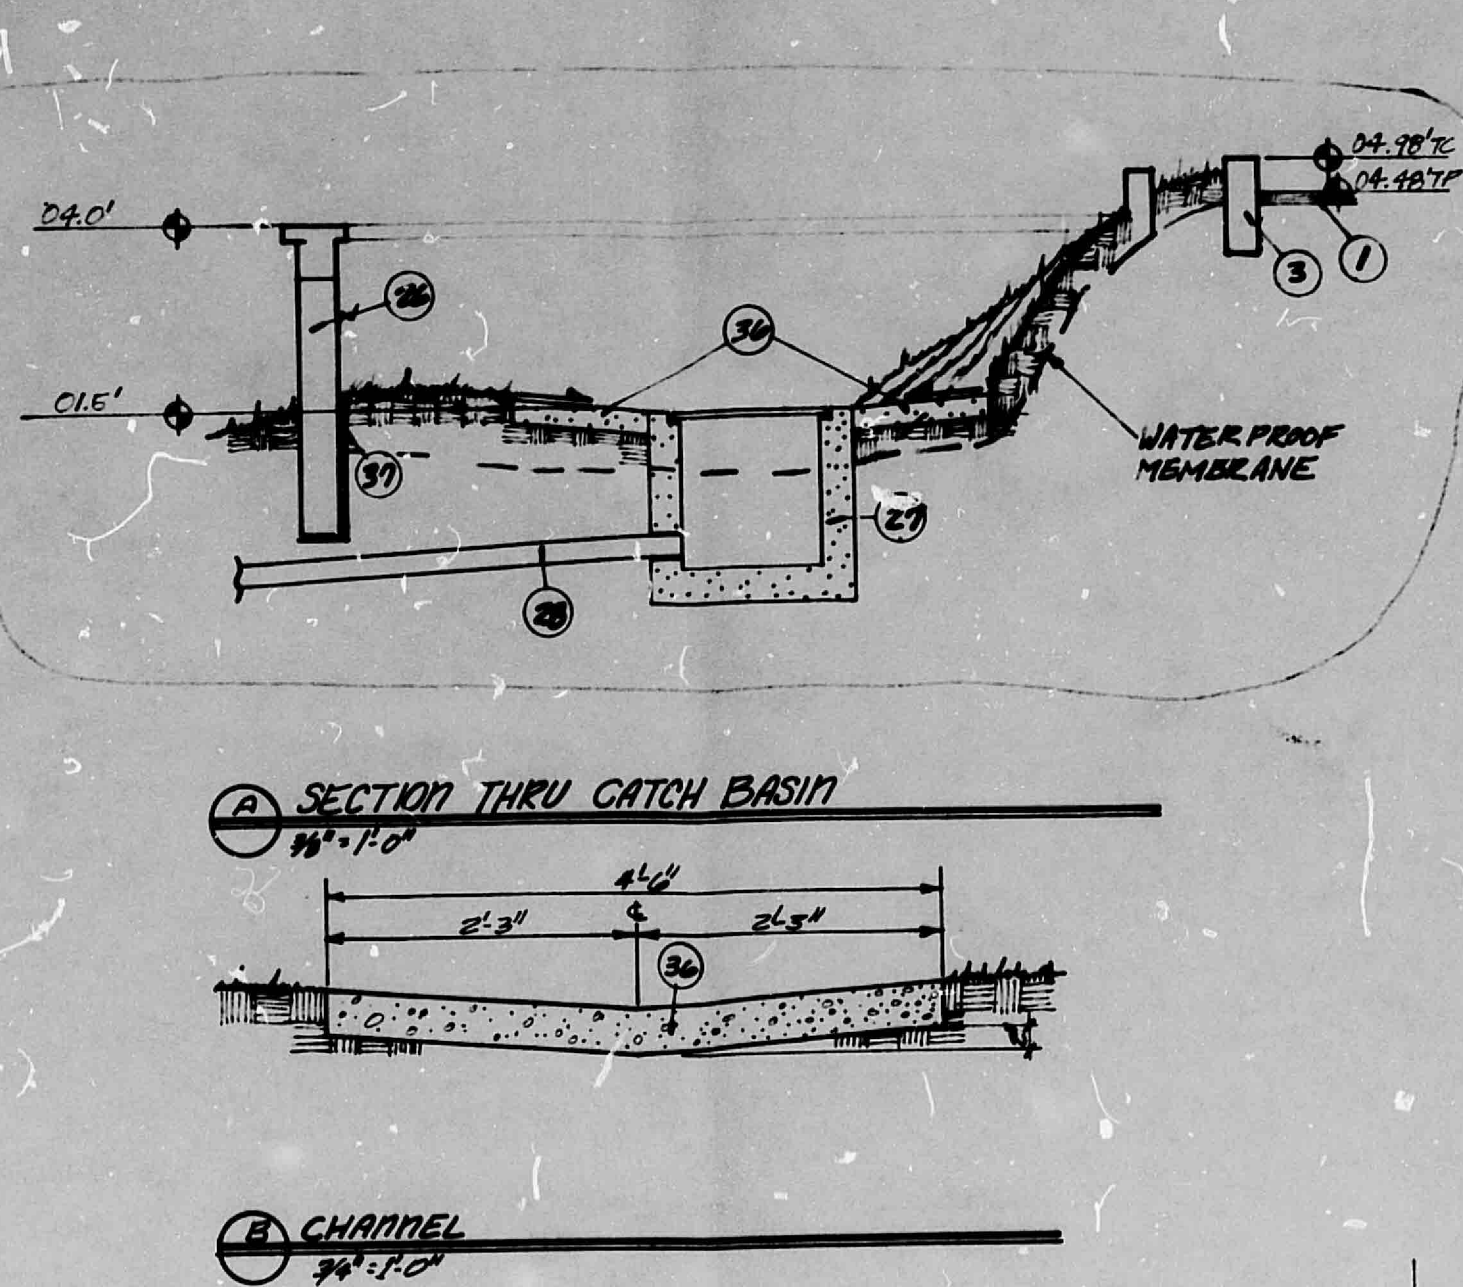

SITE DRAINAGE CRITERIA & DRAINAGE REPORT

I PURPOSE: THE PURPOSE OF THIS REPORT IS TO FORMULATE A COMPREHENSIVE STUDY OF DRAINAGE AFFECTING THE SITE DEVELOPMENT AND TO SHOW THAT THE DEVELOPMENT DOES NOT INCREASE DRAINAGE IN A MANNER TO CONTRIBUTE TO EXISTING DOWNSTREAM DRAINAGE PROBLEMS OR TO ADJACENT LAND OWNERS.

II SCOPE: THIS REPORT IS LIMITED TO RUNOFF ORIGINATING WITHIN THE SITE AND INCLUDES REVIEW OF ADJACENT LANDS WHICH EFFECT RUNOFF OF THIS SITE. GENERAL ENGINEERING PROCEDURES ARE PRESENTED FOR THE CALCULATION OF STORM RUNOFF, STORAGE AND DISPERSEMENT.

III LOCATION: THE SITE IS LOCATED ON THE EAST SIDE OF JUAN TABO BLVD. BETWEEN CONSTITUTION AVE. AND PRINCESS JEA'S AVE. THE ADDRESS IS 1416 JUAN TABO BLVD. N.E. SEE VICINITY MAP AND LEGAL DESCRIPTION THIS SHEET.

IV EXISTING DRAINAGE: THE GENERAL SLOPE OF THE SITE IS FROM EAST TO WEST AT APPROXIMATELY 3.5% WITH NO SIGNIFICANT GEOLOGICAL OR TOPOGRAPHICAL FEATURES. NO EXISTING DEVELOPMENT IS ON THE SITE. THE EXISTING RUNOFF SHEET FLOWS TO THE CURB AND GUTTER ON THE EAST SIDE OF JUAN TABO BLVD. WHICH SERVES AS A WATER CARVEING IMPROVEMENT, TO A DROP INLET APPROXIMATELY 100' SOUTH (DOWN STREET) OF THE SITE. AN EXISTING 48" CONCRETE STORM DRAINAGE CATCHMENT WITH A 24" CONDUIT CONNECTING THE DROP INLET WITH THE MAIN CONDUIT, SERVES AS THE EXISTING STORM DRAINAGE SYSTEM.

V ADJACENT LAND DRAINAGE: THE SITE IS BARRICADED ON THE EAST BY RESIDENTIAL DEVELOPMENT, ON THE NORTH BY COMMERCIAL DEVELOPMENT, ON THE WEST BY JUAN TABO BLVD. AND ON THE SOUTH BY UNDEVELOPED LAND. VIRTUALLY NO STORM RUNOFF IS DIRECTED TO OR ACROSS THIS SITE. THE RESIDENTIAL AREA TO THE EAST HAS A 6" HIGH CMU WALL ALONG THE EAST PROPERTY LINE OF THIS SITE AND ALL STORM RUNOFF OF THE RESIDENTIAL AREA IS DIRECTED TO THE EAST ALONG FROM THIS SITE. THE COMMERCIAL DEVELOPMENT TO THE NORTH IS DEVELOPED WITH PAVEMENT, AND VIRTUALLY ALL STORM RUNOFF IS DIRECTED ALONG FROM THIS SITE AND FLOWS TO THE JUAN TABO BLVD. EAST GUTTER. THE UNDEVELOPED SITE SOUTH OF THIS SITE HAS NATURAL TOPOGRAPHY WHICH DIRECTS STORM RUNOFF TO THE SOUTHWEST, AWAY FROM THIS SITE.

VI DOWNSTREAM FLOOD HAZARD: THIS SITE DOES NOT LIE WITHIN A DESIGNATED FLOOD HAZARD ZONE AS IS INDICATED ON FLOOD HAZARD MAP 55000E 0001.

APPROXIMATELY 1800' SOUTH (DOWN STREET) A FLOOD HAZARD ZONE AO, 100 YR. SHALLOW FLOODING WITH AVERAGE DEPTH OF 1' OF INUNDATION IS SHOWN. THIS ZONE EXTENDS BETWEEN MOUNTAIN ROAD AND LOMAS BLVD. AND IS GENERALLY CONTAINED WITHIN THE R.O.W. OF JUAN TABO BLVD. AS INDICATED ON THE ABOVE FLOOD HAZARD MAP.

THE PROPOSED DRAINAGE DESIGN OF THIS SITE WILL PROVIDE FACILITIES TO DETAIN AND THEREFORE ASSIST IN LESSENING THE IMPACT OF THE INDICATED ZONE.

VII PROPOSED DEVELOPMENT: THE PROPOSED DEVELOPMENT WILL CONSIST OF A DETAIL STORE OF 4000 SQ. FT. WITH REQUIRED PARKING AND ACCESS. THE SIZE AND SHAPE OF THE BUILDING WILL REQUIRE TERRACING OF APPROXIMATELY 5' AT THE REAR AND FRONT OF THE SITE TO ACCOMMODATE THE SLOPE OF THE SITE.

VIII PROPOSED DRAINAGE PLAN: THE PROPOSED DRAINAGE PLAN IS TO CONTAIN AND DELAY THE PEAK DISCHARGE AFTER DEVELOPMENT TO LESS THAN THE PEAK DISCHARGE BEFORE DEVELOPMENT, BY USE OF LANDSCAPE PONDING AND A CATCH BASIN WITH A RESTRICTED DISCHARGE, TO ROUTE RUNOFF INTO THE EXISTING STORM DRAINAGE SYSTEM.

II SITE CRITERIA & CALCULATIONS

EXISTING

LAND SIZE = 0.4178 ACRES = 18,200 S.F.
EXISTING SLOPE = 5.5%

PROPOSED DEVELOPMENT

ROOF AREA = 4000 S.F.
SIDEWALK PAVING = 11,820 S.F.
LANDSCAPING = 2,580 S.F.

PROPOSED SLOPE MAX 2.2%

DESIGN CRITERIA

EXIST = .35
CM DEW = .97
G HR = 2.45"
S = 5.51"
Tc = 10 min.

EXIST RUNOFF

$V_1 = (18,200 \times 0.35) \times 1.49 = 1,500 \text{ CU. FT.}$
 $Q_p = CTA = .35(5.51)(4178) = 0.805 \text{ CFS}$

PROPOSED DEVELOPMENT

$V_2 = (11,820 \times 0.35) \times 1.49 = 3,235 \text{ CU. FT.}$
 $Q_p = .87(5.51)(4178) = 2.00 \text{ CFS}$

PROPOSED RETENTION

AREA	AREA	AREA	AREA
AREA "A" 15' x 67' x 15' = 1507.5 CF	10' x 47' x 25' x 3' x 67' x 25' = 1726 CF	AREA "B" 30' x 30' x 5' = 450 C.F.	-0- CF
AREA "C" 5' x 135' x 1' = 675 C.F.	5' x 135' x 5' = 337 C.F.	AREA "D" 7' x 100' x 5' (50%) = 175 C.F.	175 C.F.
AREA "E" 7' x 100' x 5' (50%) = 175 C.F.	7' x 100' x 5' (50%) = 175 C.F.	TOTAL RETENTION = 2807 C.F.	

DISCHARGE

$Q_p = CTA = .35(5.51)(4178) = 0.805 \text{ CFS}$
 $C_{(max)} = .648$
 $A(4' x 4') = .087$
 $h = 5'$

II SOLUTION:



THE INCREASED RUNOFF FROM DEVELOPMENT WILL BE STORED ALONG THE LANDSCAPED TERRACED AREA "A" AND DIRECTED TO THE LANDSCAPED RETENTION AREA "A". A CATCH BASIN WILL ALLOW DISCHARGE OF RUNOFF THROUGH A 1/4" PIPE TO THE EXISTING JUAN TABO GUTTER AND DROP INLET. RUNOFF WILL BE DISCHARGED THROUGH THE EXISTING STORM DRAINAGE SYSTEM.

III CONCLUSIONS:

ON THE BASIS OF THIS REPORT, THE PROPERTY CAN BE DEVELOPED AS PROPOSED WITHOUT ANY MAJOR IMPACT TO THE OFFSITE DRAINAGE FACILITY. THE RESTRICTION OF THE DISCHARGE ALLOWS A REDUCTION OF .058 CFS. OF PEAK RUNOFF FROM THE EXISTING LAND.

KEYED NOTES:

- Asphalt pavement
- Concrete sidewalk
- Concrete curb
- Landscaped Retention Area
- CMU Retaining wall
- Roof drain - 6" P.V.C. pipe to parking
- 2142
- Roof slope
- 6" wide corr. city sidewalk
- 20' wide curb cut
- Existing city of Albuq. curb & gutter
- Existing city of Albuq. curb, gutter and 6" wide sidewalk
- Existing curb cut
- Existing CMU Retaining Wall
- Existing 6" high CMU wall
- 7' wide utility Easement
- Existing Building
- Existing pavement
- Recorded private Access Easement
- Temporary
- Gutter flow line - site drainage to existing storm inlet
- Existing storm drainage drop inlet
- Existing 24" storm culvert from drop inlet to 48" storm drainage line.
- Street median
- 60' wide median cut - centerline
- UNDEVELOPED LAND
- R.R. Tie Retaining Wall
- Drainage Catch Basin
- 4" P.V.C. drain pipe
- 4" Drain line through curb to be constructed in accordance with city of Albuq. standard spec. K-15, BLK. BLK. No. 91.
- Stainless steel saddle clip (on each corner of grate)
- Anchors bolt (on each corner of grate)
- Top of catch basin elev. = 01.5'
- Invert elev. = 99.4'
- 2" x 6" Pebar 6" o.c. each way
- Double-Lok Grate w/ clamps & anchors
- 4" Conc. pad
- Water proof Membrane

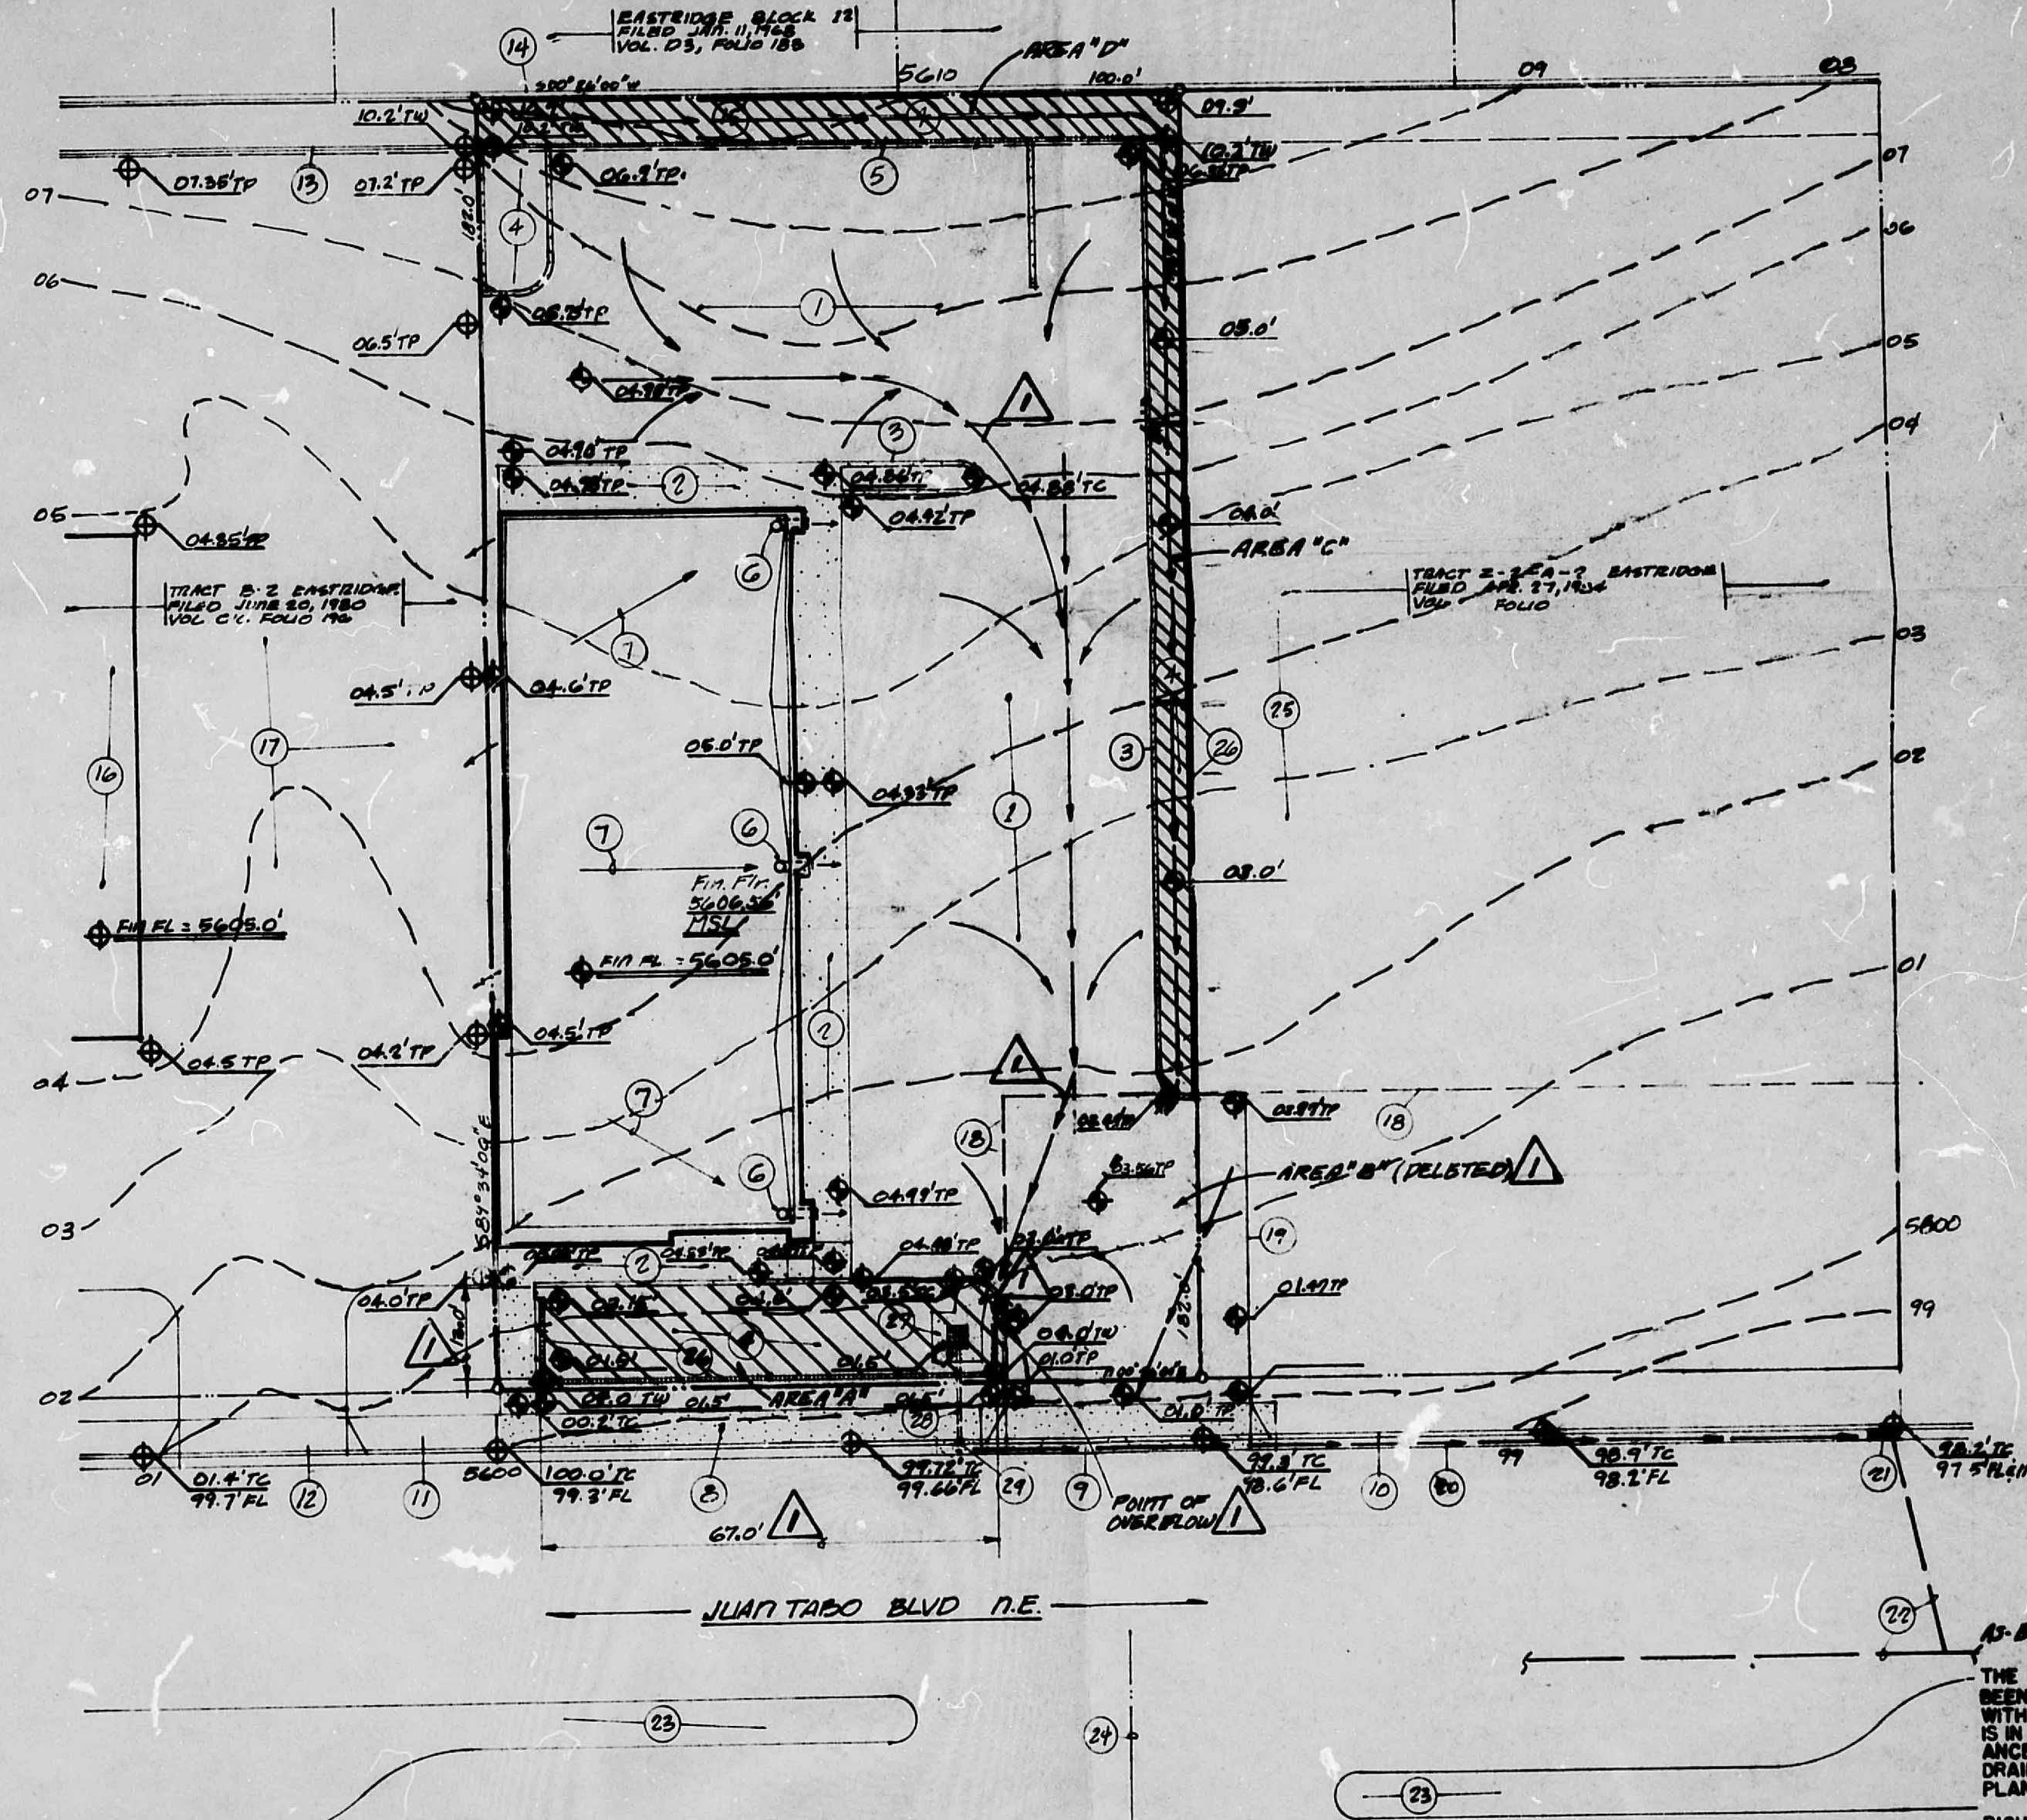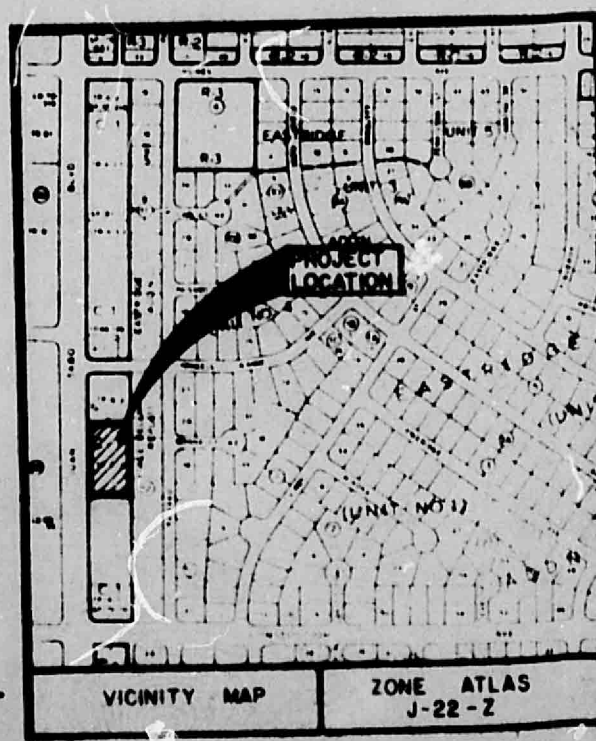

THE DRAINAGE FACILITIES HAVE BEEN PREPARED IN ACCORDANCE WITH THESE AS-BUILTS AND IS IN SUBSTANTIAL COMPLIANCE WITH THE ORIGINAL DRAINAGE REPORT AND/OR PLAN.

RICHARD BURTON
MARCH 8, 1985

RECEIVED
MAR 15 1985
HYDROLOGY SECTION



J22/D34