




SECTION A-A
NOT TO SCALE

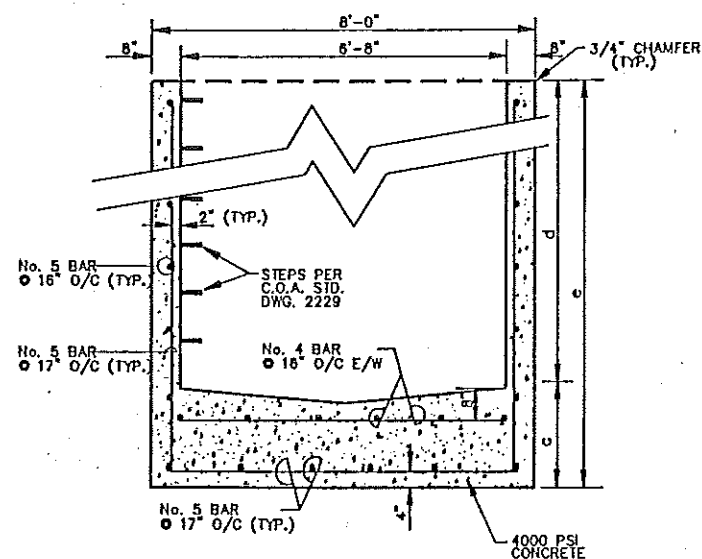

SECTION B-B
NOT TO SCALE

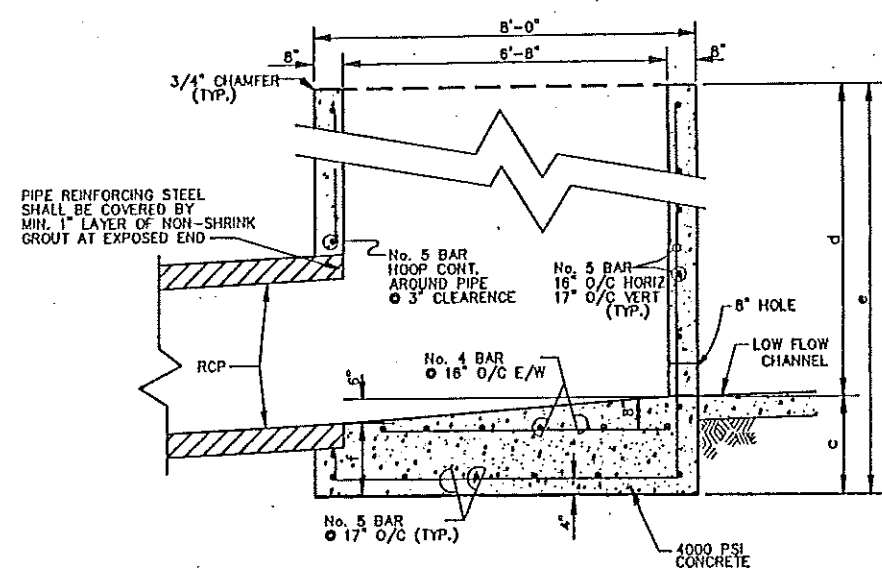

SECTION C-C
NOT TO SCALE

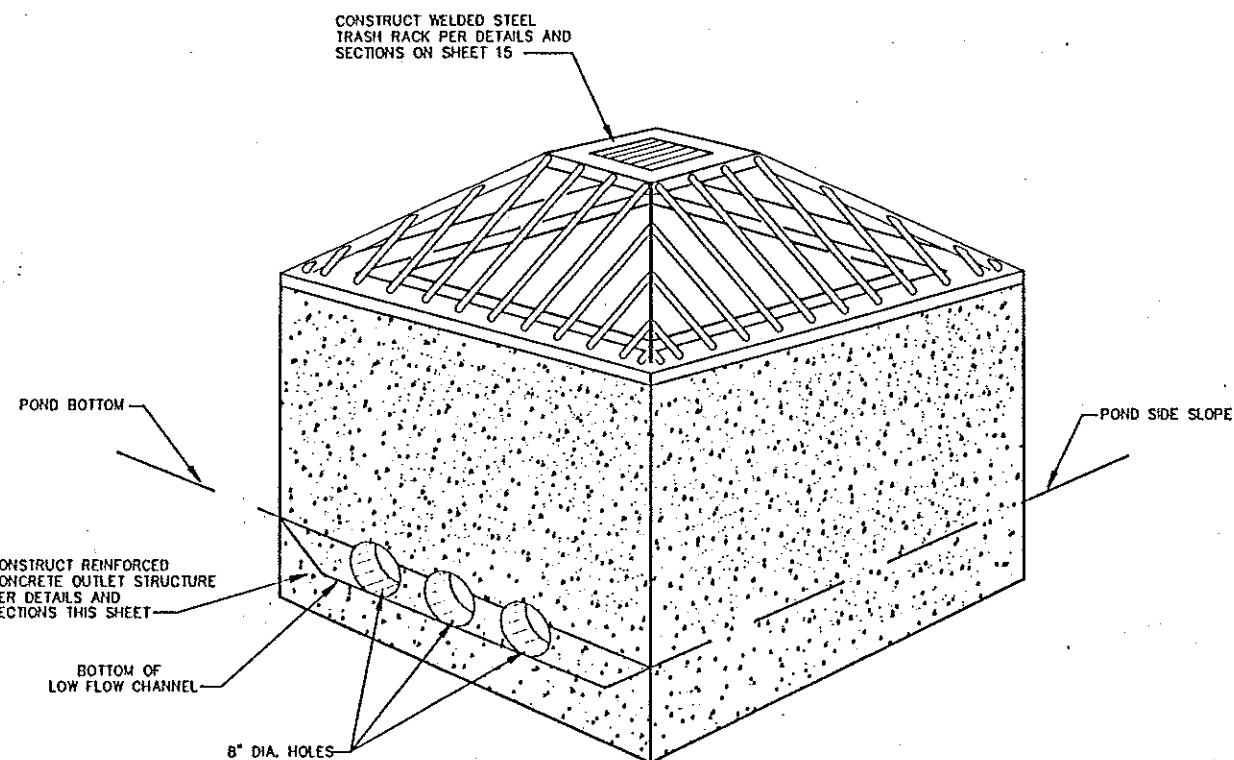

ISOMETRIC - CONCRETE OUTLET STRUCTURE
NOT TO SCALE

RECORD DRAWING
I, Charles M. Easterling, hereby certify that these drawings have been reviewed in accordance with

EASTERLING & ASSOCIATES, INC. CONSULTING ENGINEERS 10131 Coors Rd., NW, Suite H-7/8 ALBUQUERQUE, NEW MEXICO 87114 (505) 898-8021 FAX (505) 898-8501										ALBUQUERQUE METROPOLITAN ARROYO FLOOD CONTROL AUTHORITY																																																											
TITLE:										UNSER DIVERSION OUTLET STRUCTURE DETAILS AND SECTIONS																																																											
APPROVALS										ENGINEER										DATE										APPROVALS										ENGINEER										DATE																			
NO.										DATE										REVISIONS										DESIGNED BY										DATE										DRAWN BY										DATE									
BY										REMARKS										DESIGN										VSF										10/93										10/93																			
ENGINEERS SEAL																				SURVEY INFORMATION										BENCH MARKS										AS BUILT INFORMATION																													
NO.										FIELD NOTES										STATION NAME										CONTRACTOR										WORKED BY										DATE																			
TOP-O										GEO SERVICE										U.S. HWY.										INSPECTOR'S										DATE																													
DATE										OVERPASS										U.S. HWY.										ACCEPTANCE BY										DATE																													
DATE										NORTHING										U.S. HWY.										VERIFICATION BY										DATE																													
DATE										EASTING										U.S. HWY.										DRAWINGS										DATE																													
DATE										1,490,198.97										U.S. HWY.										MICRO-FILM INFORMATION										NO.																													
DATE										365,926.16										U.S. HWY.										RECORDED BY										DATE																													