## CITY OF ALBUQUERQUE

*Planning Department* David Campbell, Director



Mayor Timothy M. Keller

February 14, 2019

Vince Carrica, P.E. Tierra West, LLC 5571 Midway Park Place, NE Albuquerque, NM 87109

RE: Utility Trailer Sales 8201 Daytona Rd NW Request for Certificate of Occupancy – Permanent Engineer's Certification Date: 2/1/19 & 2/13/19 – Accepted Revised Berm Grading Plan Stamp Date: 2/7/19 Grading Plan Stamp Date: 7/12/18 Drainage Report Stamp Date: 7/11/18 Hydrology File: K09D026B

PO Box 1293 Dear Mr. Carrica,

AlbuquerqueBased on the submittal received on 2/13/19, Engineer's Certification is approved in support of<br/>Certificate of Occupancy (Permanent) by Hydrology.

NM 87103 For Information. Prior to Work Order acceptance, the Agreement and Covenant (signed by the underlying owner) and Drainage Easement for the swale and pond on Tract 2 with need to be recorded and included in the closeout package. Also the Agreement and Covenant and the Drainage Easement for the riprap and gabions in the NE corner of Tract 3 with need to be recorded and included in the closeout package.

www.cabq.gov

If you have any questions, please contact me at 924-3695 or dpeterson@cabq.gov.

Sincerely,

Dana Peterson, P.E. Senior Engineer, Planning Dept. Development Review Services

C: Email Fox, Debi; Tena, Victoria; Sandoval, Darlene; Costilla, Michelle





## City of Albuquerque


Planning Department Development & Building Services Division


DRAINAGE AND TRANSPORTATION INFORMATION SHEET (REV 6/2018)

Project Title: Utility Trailer Sales	Building Permit #:		Hydrology File #:					
DRB#: 1008585	EPC#: 8-EPC-40004							
Legal Description: Tract 3 of Plat of TRS 1 th	ru 12 Avalo	n Subdivision Unit 5						
City Address:8201 Daytona Rd NW Albuquerqu								
Applicant:         Tierra West, LLC           Address:         5571 Midway Park Place NE Albuquero			Contact: Vince Carrica					
Phone#: 505-858-3100	Fax#:		E-mail: vcarrica@tierrawestllc.com					
Other Contact:			Contact:					
Address:								
Phone#:			E-mail:					
TYPE OF DEVELOPMENT: PLAT (	# of lots)	RESIDENCE	DRB SITE X_ADMIN SITE					
IS THIS A RESUBMITTAL? X Yes	N	lo						
DEPARTMENT TRANSPORTATION	<u>х</u> н	YDROLOGY/DRAIN	AGE					
Check all that Apply:			YPE OF APPROVAL/ACCEPTANCE SOUGHT: BUILDING PERMIT APPROVAL					
TYPE OF SUBMITTAL:         X       ENGINEER/ARCHITECT CERTIFICATION         PAD CERTIFICATION         CONCEPTUAL G & D PLAN         GRADING PLAN         DRAINAGE REPORT         DRAINAGE MASTER PLAN         FLOODPLAIN DEVELOPMENT PERMIT A         ELEVATION CERTIFICATE         CLOMR/LOMR         TRAFFIC CIRCULATION LAYOUT (TCL)         TRAFFIC IMPACT STUDY (TIS)         STREET LIGHT LAYOUT         OTHER (SPECIFY)		PRELIM SITE PL SITE PL FINAL F SIA/ REI FOUND GRADIN GRADIN SO-19 A PAVING X GRADIN	ICATE OF OCCUPANCY INARY PLAT APPROVAL AN FOR SUB'D APPROVAL AN FOR BLDG. PERMIT APPROVAL PLAT APPROVAL LEASE OF FINANCIAL GUARANTEE ATION PERMIT APPROVAL IG PERMIT APPROVAL PPROVAL PERMIT APPROVAL IG/ PAD CERTIFICATION PROVAL					
PRE-DESIGN MEETING? DATE SUBMITTED:2/13/2019		OTHER Vince Carrica	/LOMR PLAIN DEVELOPMENT PERMIT (SPECIFY)					
COA STAFF:		NIC SUBMITTAL RECEIVI	ED:					

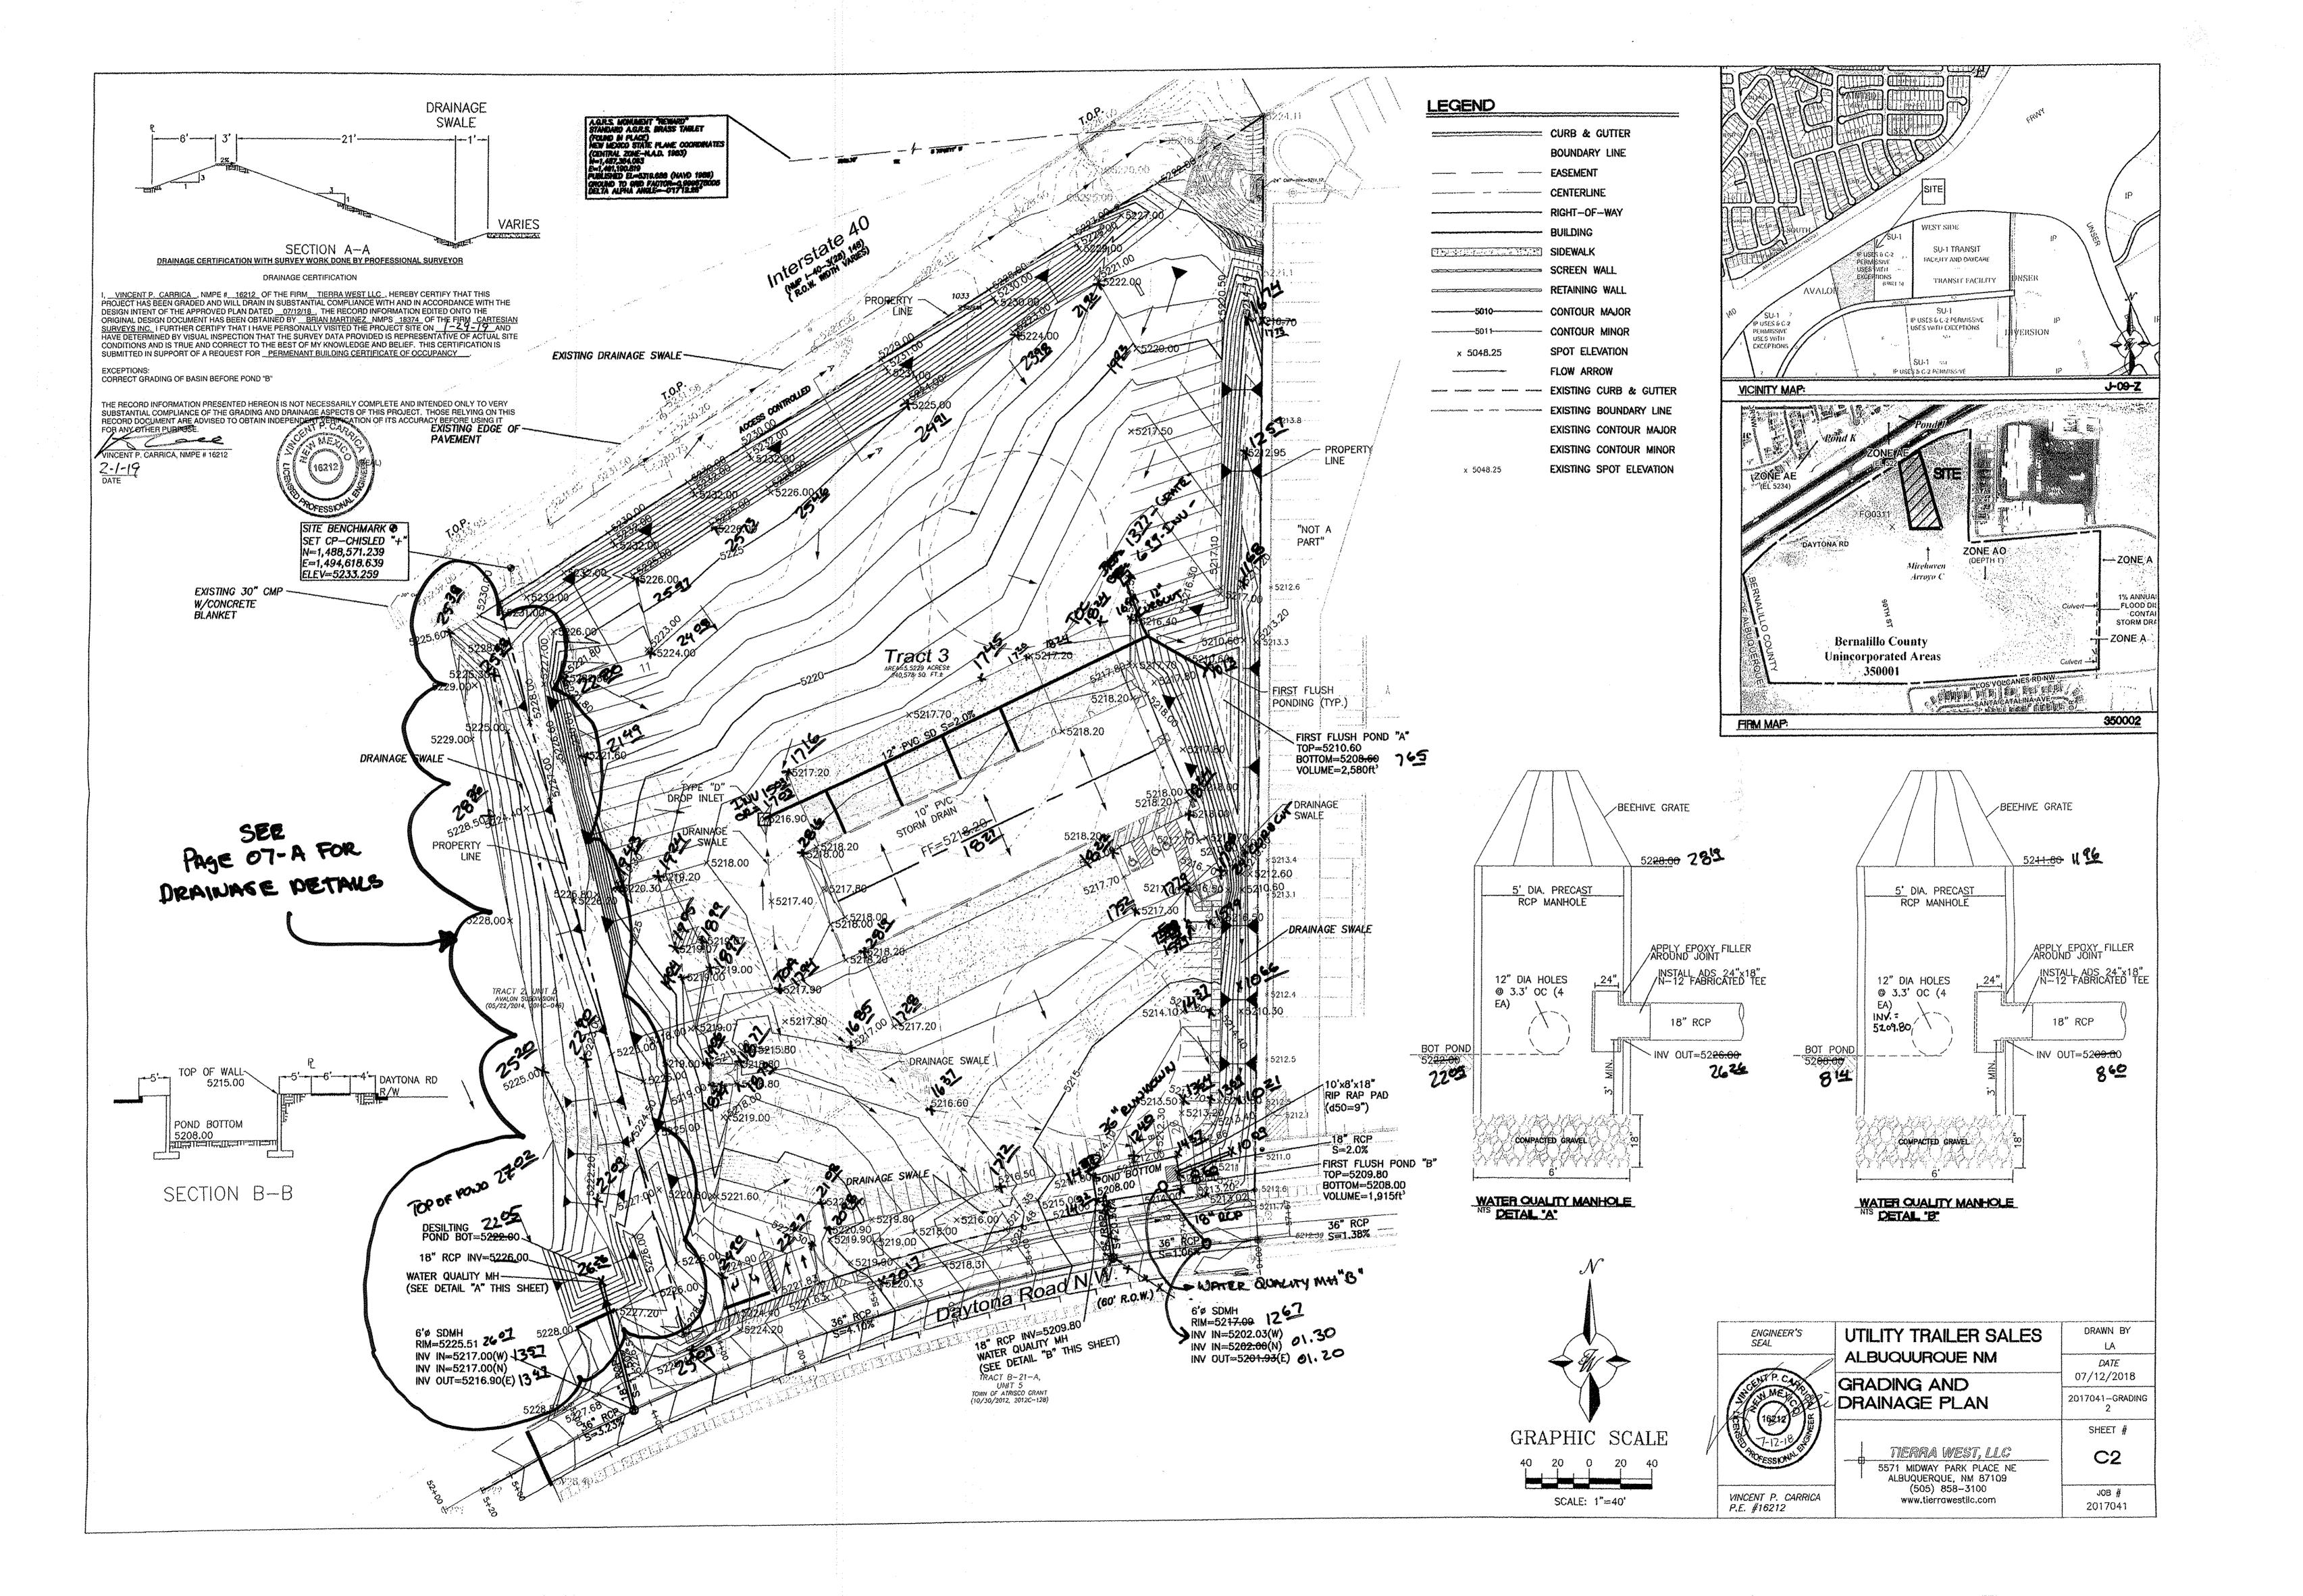


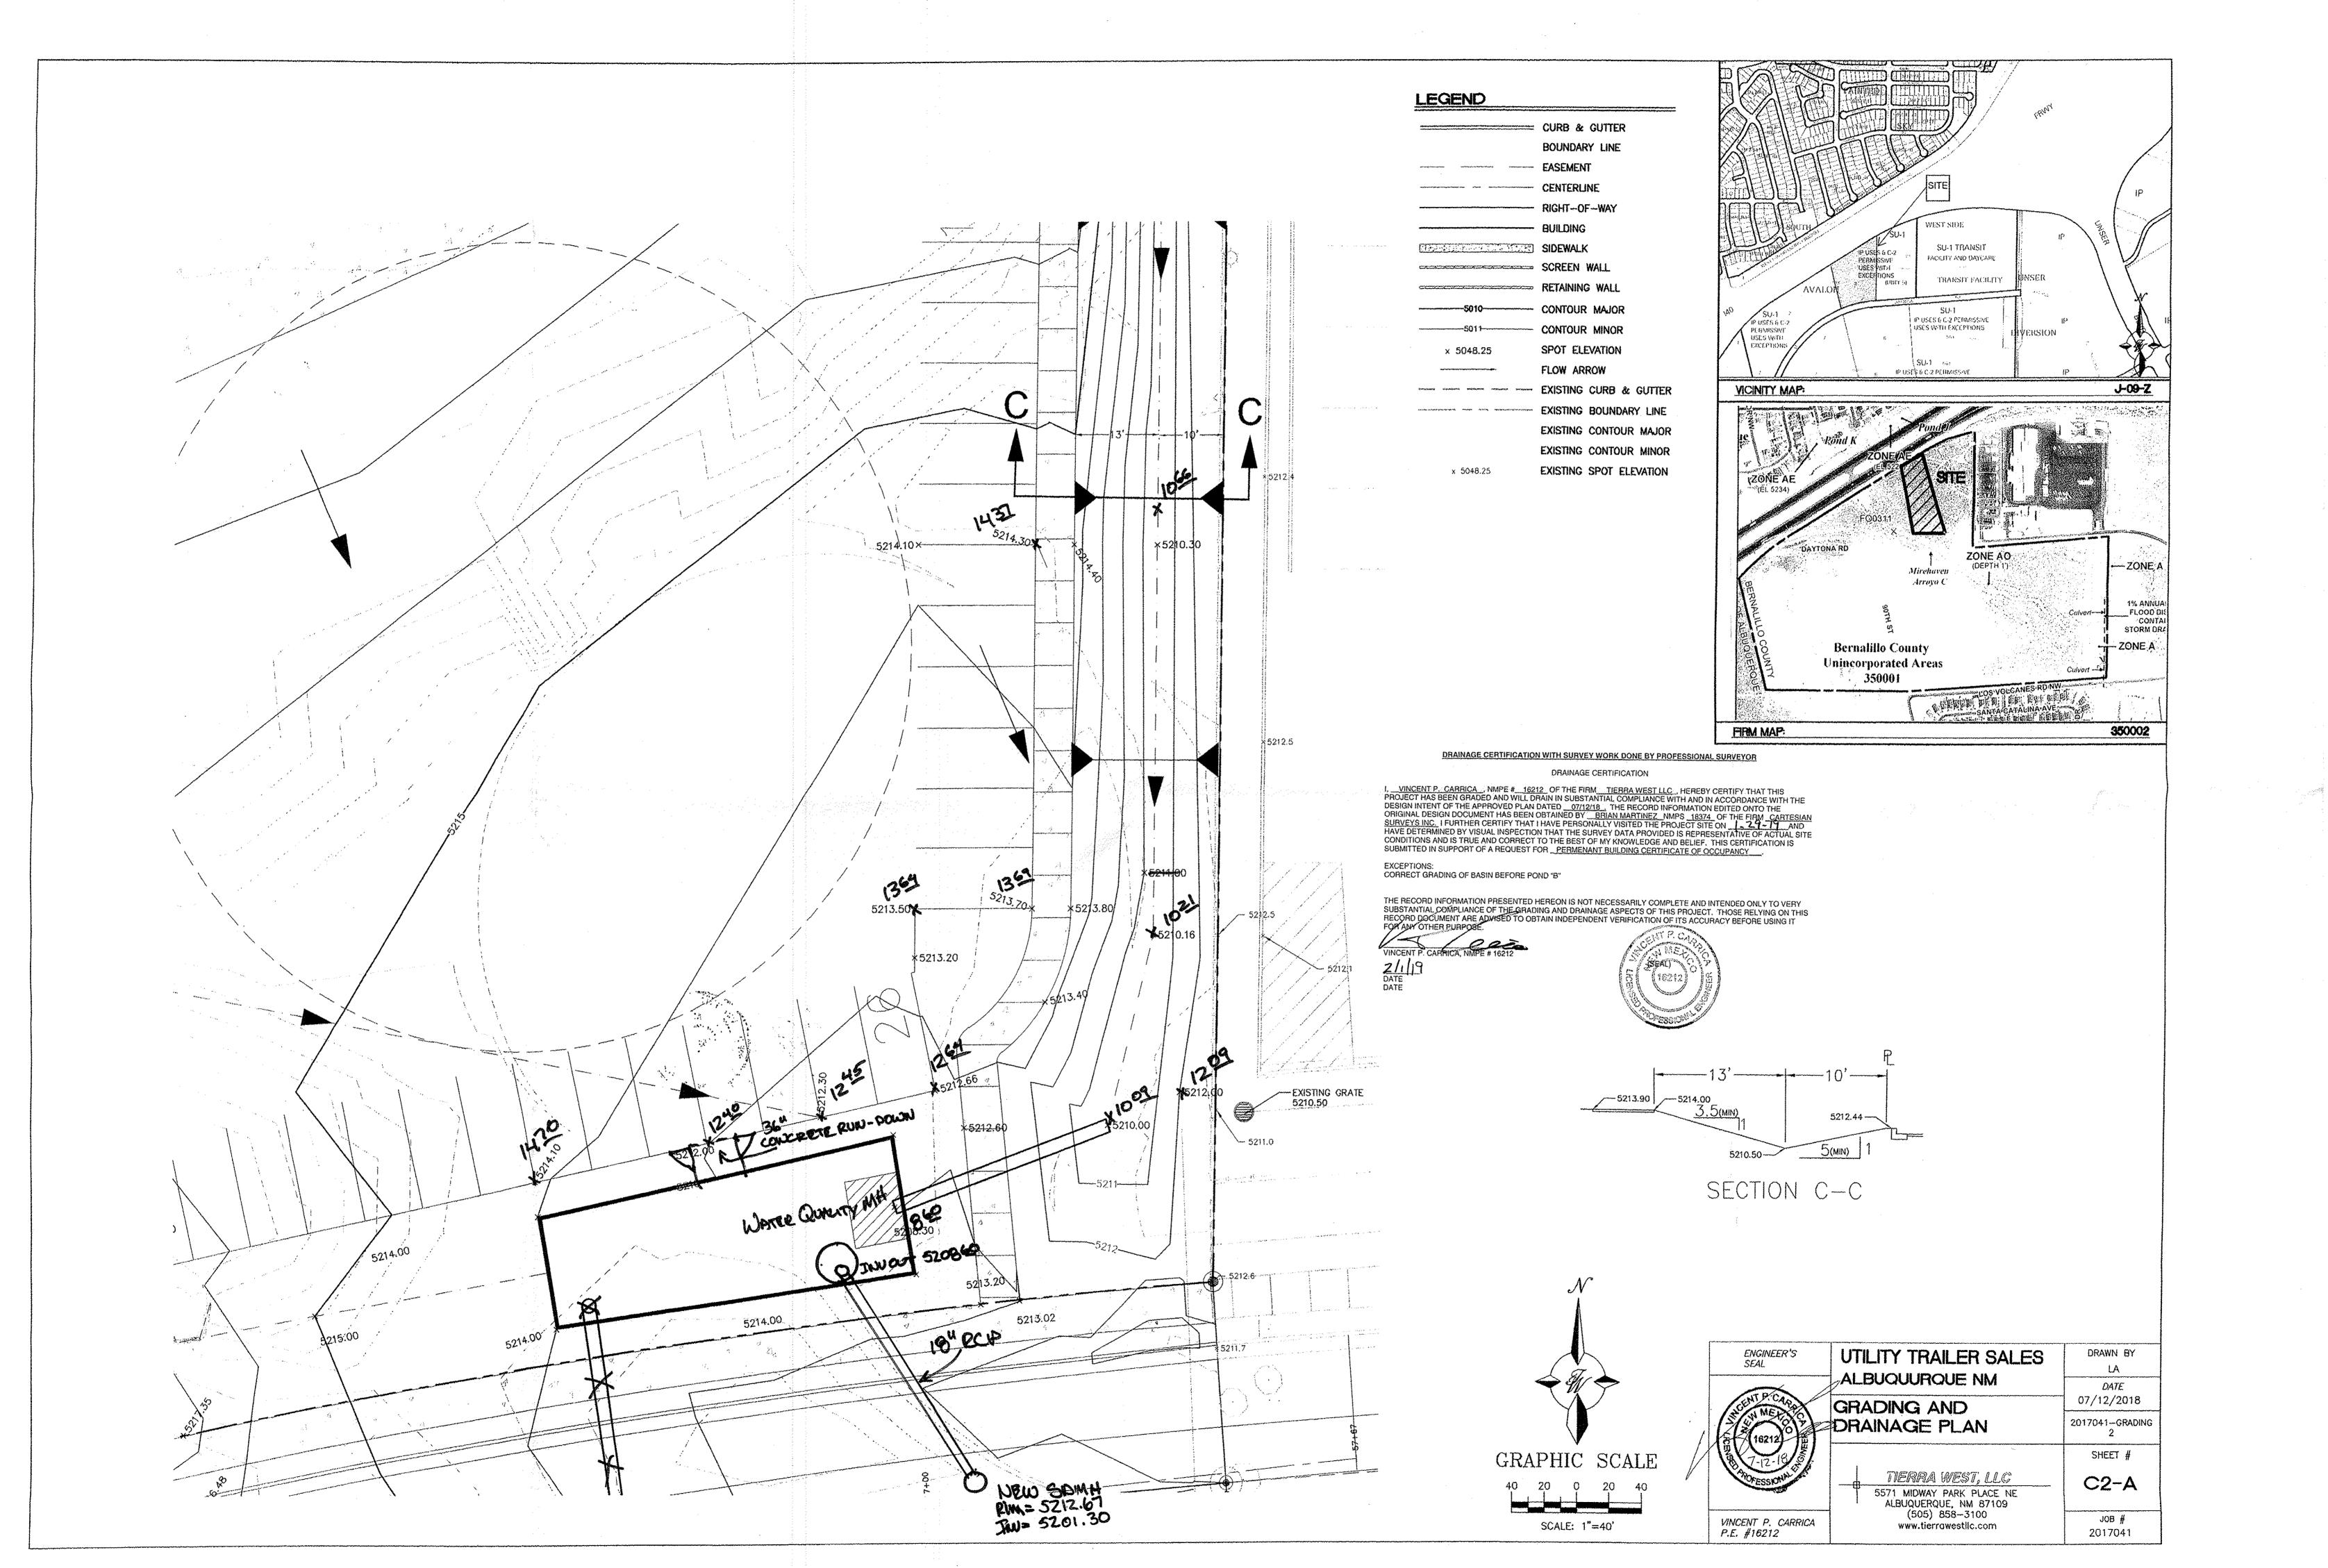

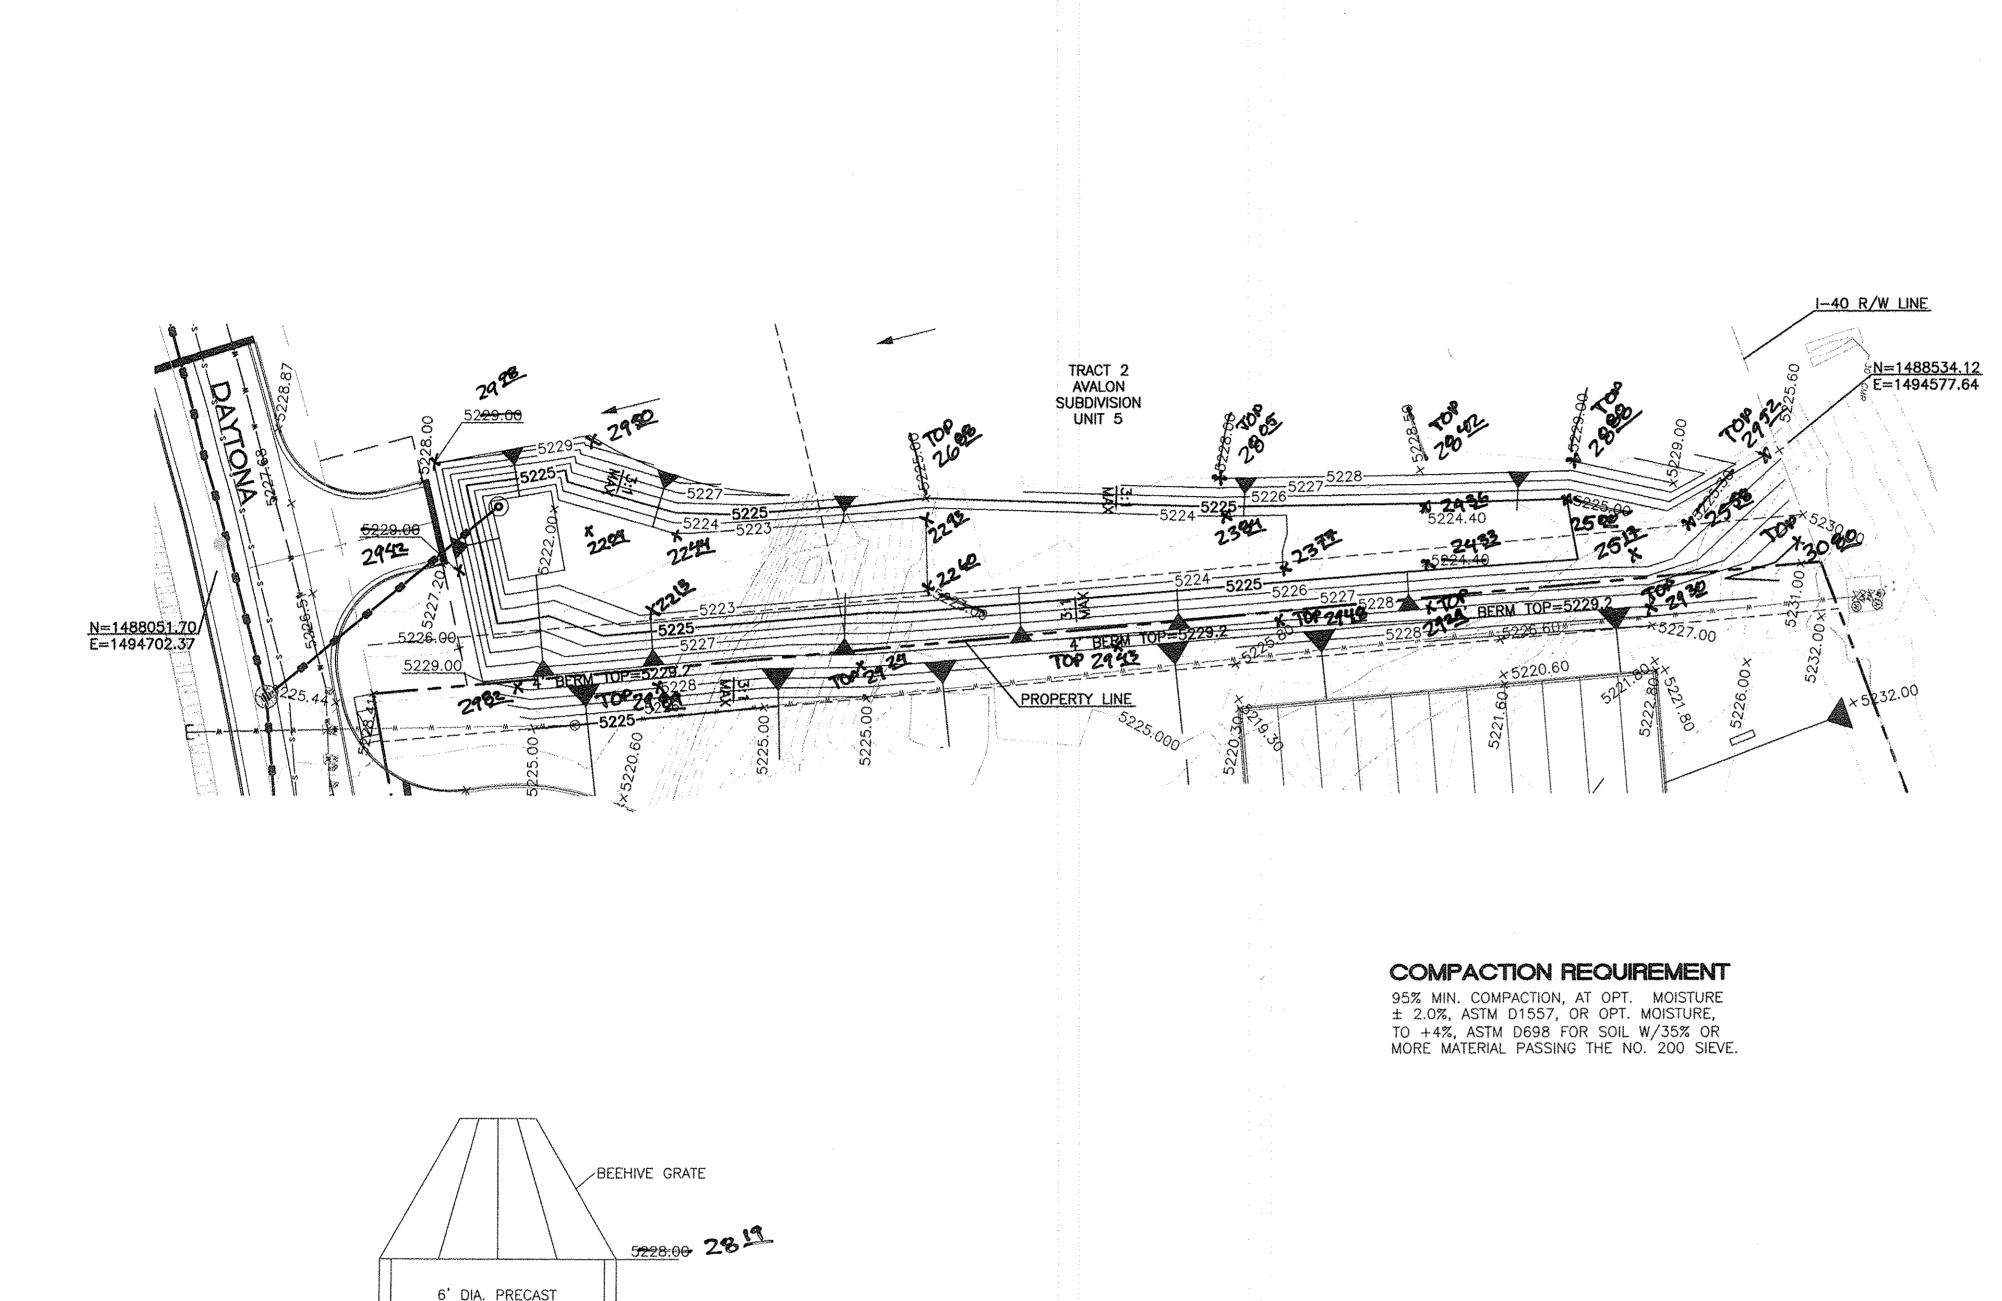


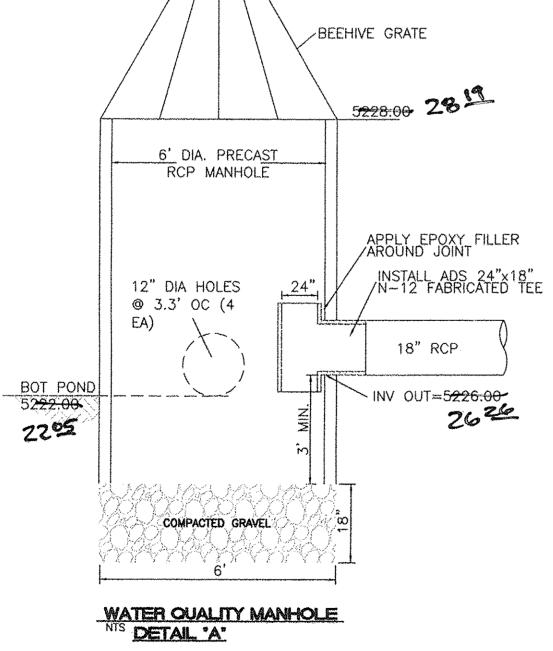


.

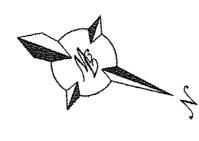

.

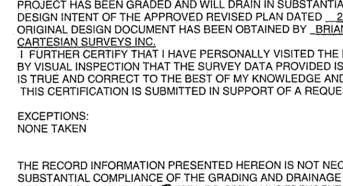

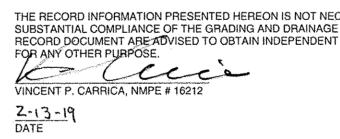

CRAPHIC SCALE $(IN FEET)$	LEGEND	CURB & GUTTER BOUNDARY LINE EASEMENT CENTERLINE RIGHTOFWAY CONTOUR MAJOR CONTOUR MAJOR SPOT ELEVATION (FLOWLINE) FLOW ARROW EXISTING CONTOUR MAJOR EXISTING CONTOUR MINOR	BENCH MARKS AS BUILT INFORMATION	"REWARD"	ANDARD USC&GS BRASS DISC	PLANE COORDINATES INSPECTOR'S ACCEPTANCE BY	ICATION BY INGS	1,491,190.819	=0.999675005 RECORDED BY	Da=-0'17'12.26" NO.	Elev=5319.688 (NAVD 1988)	
			SURVEY INFORMATION	IOTES	NO. BY DATE							
DRAINAGE CERTIFICATION WITH SURVEY WORK DONE BY PROFESSIONAL SURVEYOR         I, VINCENT P. CARRICA_, NMPE #_16212_OF THE FIRM_TIERRA WEST LLC_, HEREBY CERTIFY THAT THIS         PROJECT HAS BEEN GRADED AND WILL DRAIN IN SUBSTANTIAL COMPLIANCE WITH AND IN ACCORDANCE WITH THE         DESIGN DRADED AND WILL DRAIN IN SUBSTANTIAL COMPLIANCE WITH AND IN ACCORDANCE WITH THE         DESIGN DRADED AND WILL DRAIN IN SUBSTANTIAL COMPLIANCE WITH AND IN ACCORDANCE WITH THE         DESIGN DRADED AND WILL DRAIN IN SUBSTANTIAL COMPLIANCE WITH AND IN ACCORDANCE WITH THE         DESIGN DRADED AND WILL DRAIN IN SUBSTANTIAL COMPLIANCE WITH AND IN ACCORDANCE WITH THE         DESIGN DRADED AND WILL DRAIN IN SUBSTANTIAL COMPLIANCE WITH AND IN ACCORDANCE WITH THE         ORIGINAL DESIGN DOCUMENT HAS BEEN OBTAINED BY207/19         DESIGN DOCUMENT HAS BEEN OBTAINED BYBRIAN MARTINEZNMPS #18374 OF THE FIRM         CARTESIAN SURVEYSINC.         I FURTHER CERTIFY THAT I HAVE PERSONALLY VISITED THE PROJECT SITE ON 2         DESIGN DOCUMENT HAT THE SURVEY DATA PROVIDED IS REPRESENTATIVE OF ACTUAL SITE CONDITIONS AND         SUBJECTION THAT THE SURVEY DATA PROVIDED IS REPRESENTATIVE OF ACTUAL SITE CONDITIONS AND         SUBJECTION THAT THE SURVEY DATA PROVIDED IS REPRESENTATIVE OF ACTUAL SITE CONDITIONS AND         SUBJECTION THAT THE SURVEY DATA PROVIDED IS REPRESENTATIVE OF ACTUAL SITE CONDITIONS AND				THERE S. HANNELL CO PROFESSIONAL AB								
THE RECORD INFORMATION PRESENTED HEREON IS NOT NECESSAL SUBSTANTIAL COMPLIANCE OF THE GRADING AND DRAINAGE ASPEC RECORD DOCUMENT ABE ADVISED TO OBTAIN INDEPENDENT VERIF FOR ANY OTHER PURPOSE. VINCENT P. CARRICA, NMPE # 16212 Z-13-19 DATE	CTS OF THIS PROJECT. THOSE RELYIN	G ON THIS				REMARKS	REVISIONS	ц]	2-7-	7041-SWALE-PP-REVISED-2-6-19 JOB NO .: 2	DATE: 2-7-19	
	TITLE:	A WEST, LLC VAY PARK PLACE NE ERQUE, NM 87109 D5)858–3100 ierrawestilc.com CITY OF ALBUQUERG PUBLIC WORKS DEPAR ENGINEERING GROU ITILITY TRAILER SA REVISIONS OFFSITE SWA	rmen P <b>Alle</b>	ES		0d NO. DATE	ND	DESIGNED BY: VC		DRAWING NAME: 201	CHECKED BY:RRB	
	DESIGN REVIEW COMMITTEE	CITY ENGINEER APPROVAL	D. [	MO.,		/YR. 07		OF	./DA)	//YR.		



