

CITY OF ALBUQUERQUE

Planning Department
Alan Varela, Director



Mayor Timothy M. Keller

November 18, 2024


Tim Shoemaker, P.E.
RTM Engineering
7007 Wyoming Blvd. NE, Ste. F-2
Albuquerque, NM 87109

RE: Panda Express - 98th Street SW
Permanent Certificate of Occupancy - Accepted
Engineer's Certification Date: 11/15/2024
Engineer's Stamp Date: 04/29/2022
Hydrology File: K09D038

Dear Mr. Shoemaker:

PO Box 1293 Based on the Engineer's Grading and Drainage Certification received 11/15/2024 and the site visit on 11/15/2024, this letter serves as a "green tag" from Hydrology Section for a Permanent Certificate of Occupancy to be issued by the Building and Safety Division.

Albuquerque If you have any questions, please contact me at 505-924-3314 or amontoya@cabq.gov.

NM 87103 Sincerely,

Anthony Montoya, Jr., P.E.
www.cabq.gov Senior Engineer, Hydrology
Planning Department, Development Review Services



City of Albuquerque

Planning Department
Development & Building Services Division

DRAINAGE AND TRANSPORTATION INFORMATION SHEET (DTIS)

Project Title: _____ Hydrology File # _____

Legal Description: _____

City Address, UPC, OR Parcel: _____

Applicant/Agent: _____ Contact: _____

Address: _____ Phone: _____

Email: _____

Applicant/Owner: _____ Contact: _____

Address: _____ Phone: _____

Email: _____

TYPE OF DEVELOPMENT: Plat (# of lots) _____ Single Family Home
All other Developments

RE-SUBMITTAL: YES NO

DEPARTMENT: TRANSPORTATION HYDROLOGY/DRAINAGE

Check all that apply under Both the Type of Submittal and the Type of Approval Sought:


TYPE OF SUBMITTAL:

Engineering / Architect Certification
Conceptual Grading & Drainage Plan
Grading & Drainage Plan, and/or Drainage Report
Drainage Report (Work Order)
Drainage Master Plan
Conditional Letter of Map Revision (CLOMR)
Letter of Map Revision (LOMR)
Floodplain Development Permit
Traffic Circulation Layout (TCL) – Administrative
Traffic Circulation Layout (TCL) – DFT Approval
Traffic Impact Study (TIS)
Street Light Layout
OTHER (SPECIFY) _____

TYPE OF APPROVAL SOUGHT:

Pad Certification
Building Permit
Grading Permit
Paving Permit
SO-19 Permit
Foundation Permit
Certificate of Occupancy - Temp Perm
Preliminary / Final Plat
Site Plan for Building Permit - DFT
Work Order (DRC)
Release of Financial Guarantee (ROFG)
CLOMR / LOMR
Conceptual TCL - DFT
OTHER (SPECIFY) _____

DATE SUBMITTED: _____

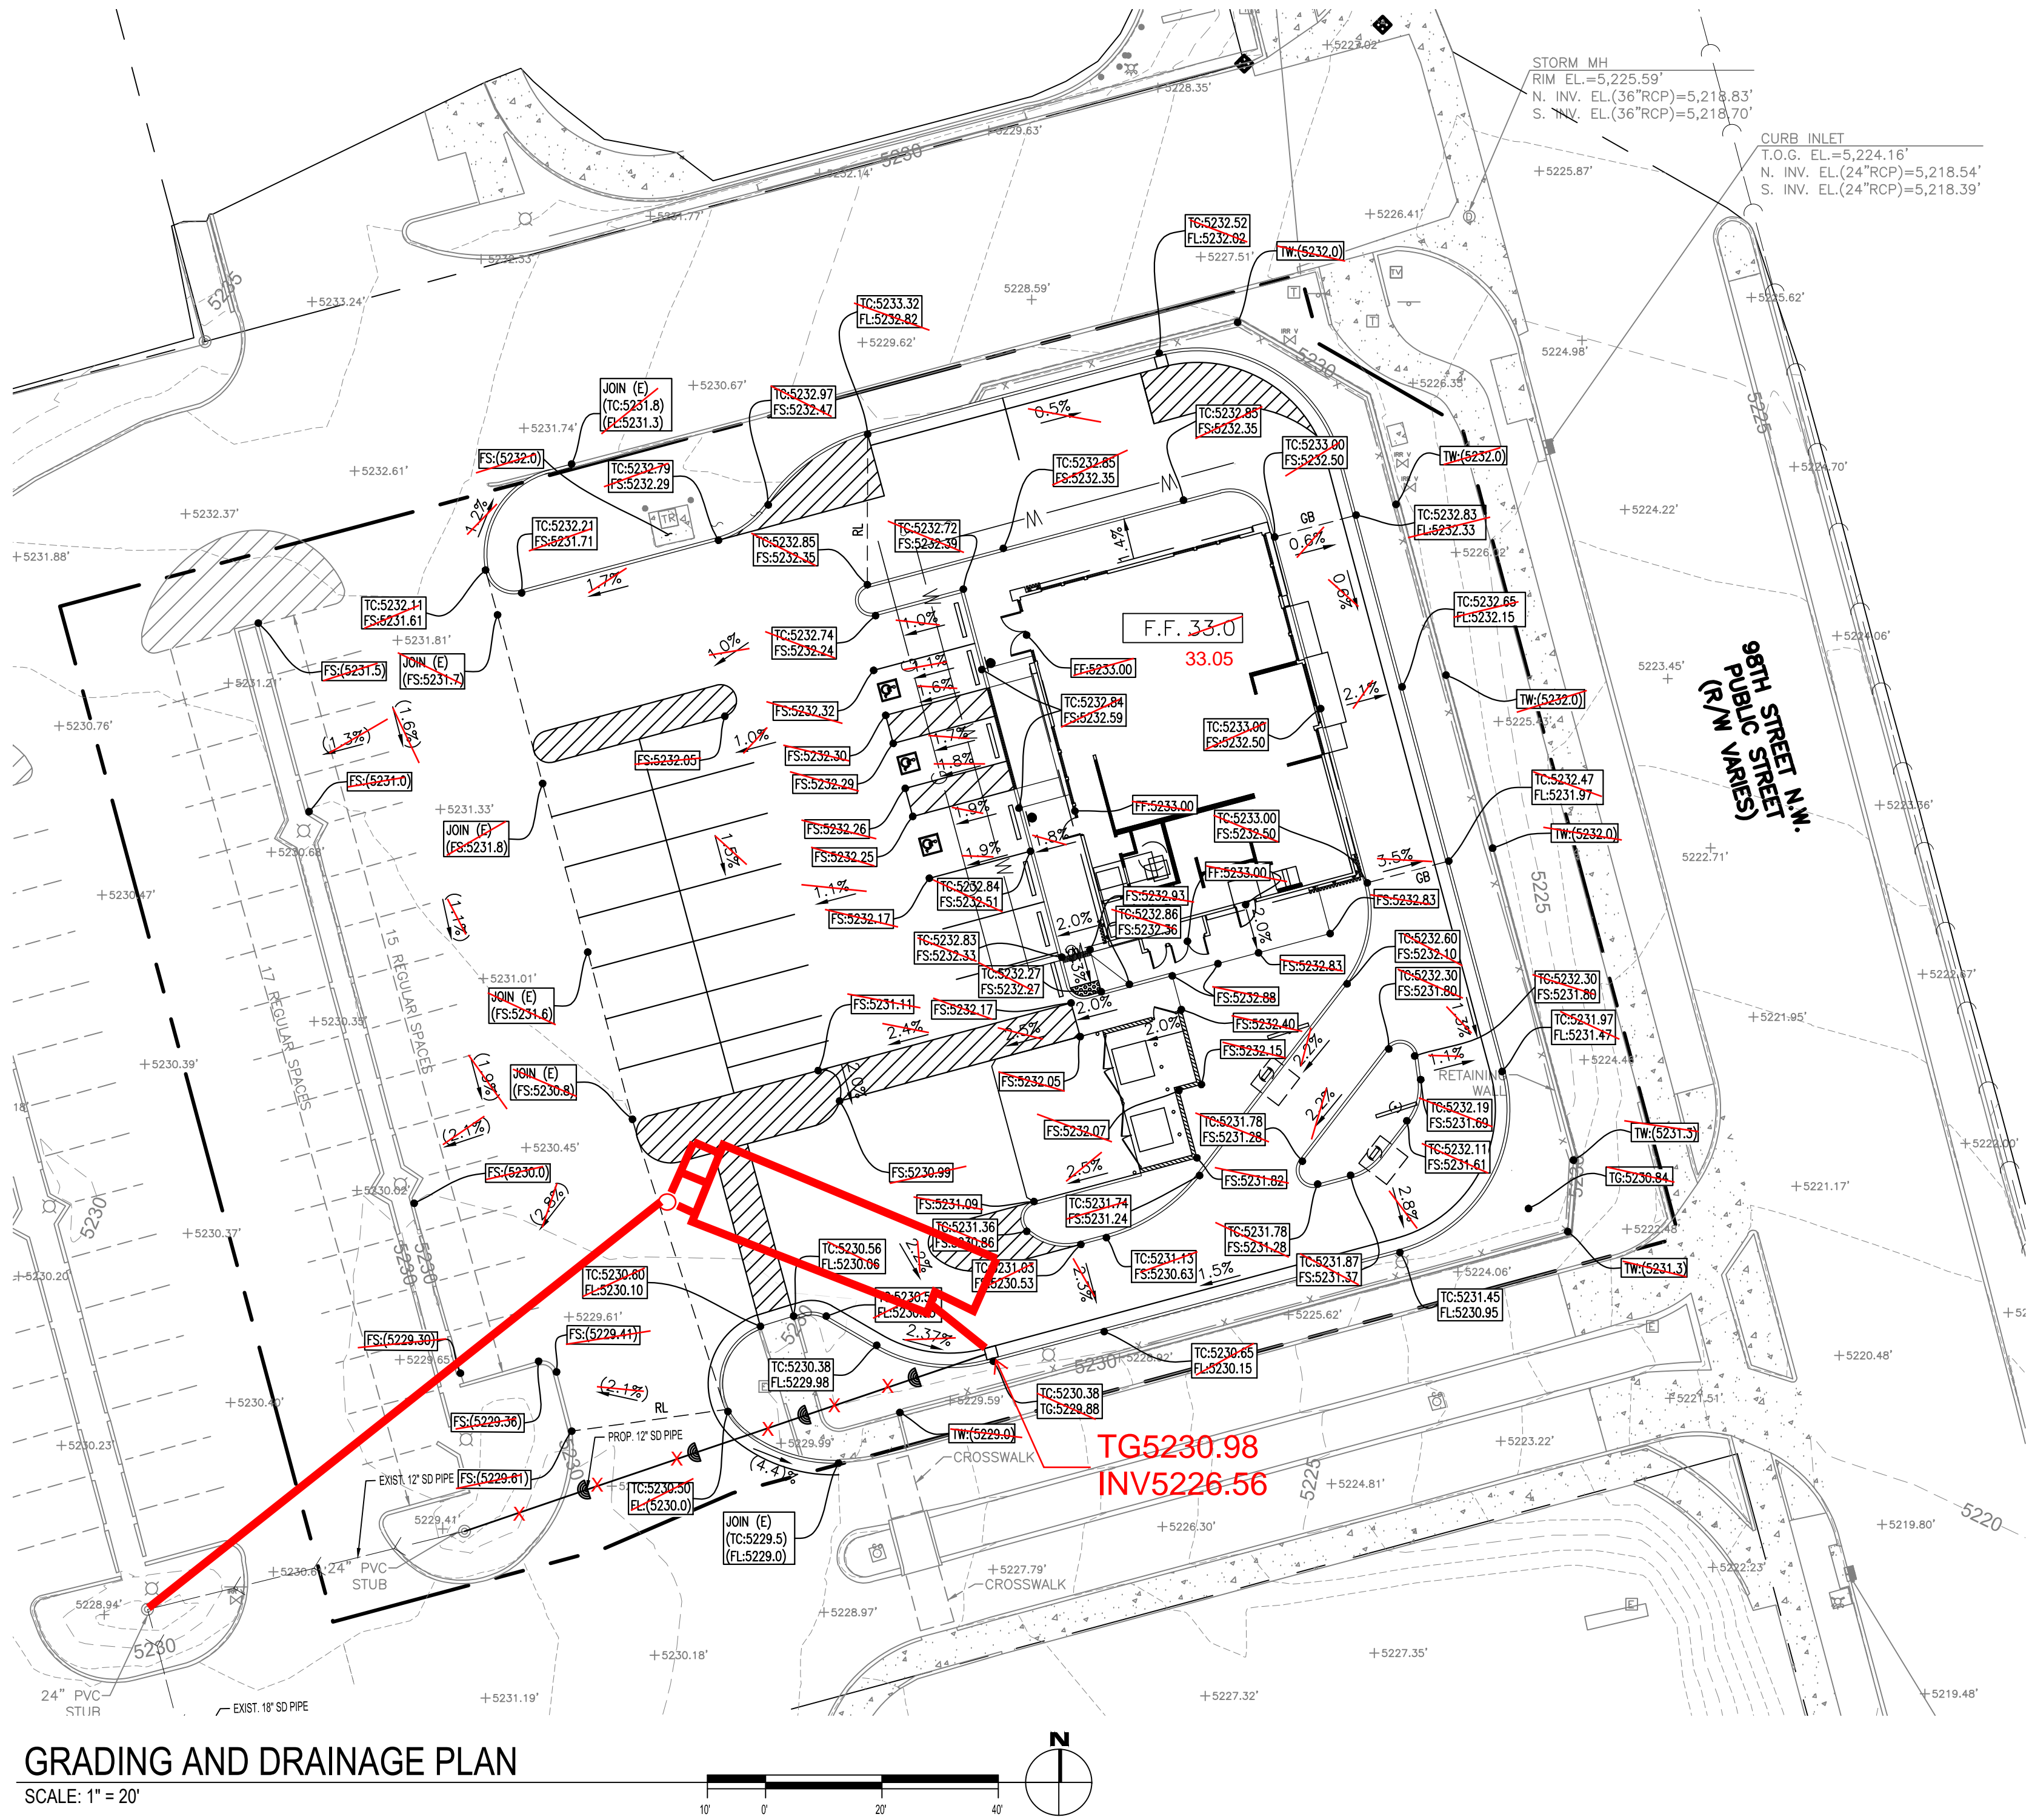

GRADING AND DRAINAGE PLAN

SCALE: 1" = 20'

PROPOSED SITE 100 YR, 6-HR										100-YEAR, 6HR		
Basin	Area	Treatment A		Treatment B		Treatment C		Treatment D		WEIGHTED E	VOLUME	FLOW
	SF	%	AC	%	AC	%	AC	%	AC	IN	AC-FT	CFS
Basin 1	5399.2	0%	0	0%	0	100%	0.124	0%	0	0.95	0.0098	0.4
Basin 2	33363.2	0%	0	0%	0	0%	0	100%	0.77	2.24	0.1430	3.2
Basin 3	3605.87	0%	0	0%	0	100%	0.083	0%	0	0.95	0.0066	0.2

EXISTING SITE 100-YR, 6-HR										100-YEAR, 6HR		
Basin	Area	Treatment A		Treatment B		Treatment C		Treatment D		WEIGHTED E	VOLUME	FLOW
	SF	%	AC	%	AC	%	AC	%	AC	IN	AC-FT	CFS
Basin 1	4573.85	0%	0	0%	0	100%	0.105	0%	0	0.95	0.0083	0.3
Basin 2	35165.58	0%	0	0%	0	0%	0	100%	0.81	2.24	0.1507	3.3
Basin 3	2628.84	0%	0	0%	0	100%	0.060	0%	0	0.95	0.0048	0.2

NOTES

THE AREAS THAT WERE USED FOR THE STORM WATER CALCULATIONS ARE BASED ON THE SITE LAYOUT SHOWN ON THE PREVIOUS GRADING PLANS APPROVED ON APRIL 7, 2015

LEGAL DESCRIPTION

TRACT NUMBER TWO (2) OF 98TH STREET PLAZA, AS THE SAME ARE SHOWN AND DESIGNATED IN THE CORRECTED PLAT THEREOF FILED IN THE OFFICE OF THE COUNTY CLERK OF BERNILLO COUNTY, NEW MEXICO ON AUGUST 18, 2015 IN PLAT BOOK 2015C, FOLIO 97

TRACT OF LAND HERIN DESCRIBED HAVING 0.9726 ACRES (42,368.27 SQUARE FEET)

IDO ZONE DISTRICT: MX-M (MIXED USES-MODERATE INTENSITY ZONE DISTRICT)

BASIS OF BEARING AND BENCHMARK

NAD 83 NEW MEXICO CENTRAL ZONE STATE PLANE COORDINATE VALUES ESTABLISHED FOR:

- NMISHC SURVEY CONTROL STATION "4-20-23" DATA:
STANDARD BRASS DISC SET FLUSH TO THE GROUND
NAD 83 NEW MEXICO CENTRAL ZONE STATE PLANE COORDINATES
NORTHING: 1,485,519.844 US FEET EASTING: 1,489,913.599 US FEET
ELEV. = 5,341.357 US FEET
COMBINED GROUND TO GRID FACTOR = 0.999974412
DELTA ALPHA = (+) 0'17'02.90"
- NMISHC SURVEY CONTROL STATION "9-10-1987" DATA:
STANDARD 1-3/4" ALUMINUM DISC RIVETED TO A PIPE
NAD 83 NEW MEXICO CENTRAL ZONE STATE PLANE COORDINATES
NORTHING: 1,484,994.639 US FEET EASTING: 1,492,463.769 US FEET
ELEV. = 5,280.166 US FEET
COMBINED GROUND TO GRID FACTOR = 0.999977891
DELTA ALPHA = (+) 0'17'03.21"

THE BASIS OF BEARINGS FOR THE PREMISES SURVEYED ARE NAD 83 NEW MEXICO CENTRAL ZONE GRID BEARINGS BEING BASED ON A LINE BETWEEN THE FOUND PROPERTY CORNERS LISTED ABOVE BEARING = N78°21'46"E

PROJECT BENCHMARK 13-19 IS A CITY OF ALBUQUERQUE SURVEY CONTROL STATION "ACS BM 13-19" ELEVATION = 5,234.53 FEET

BASIS OF ELEVATIONS

NAVD 88

FLOODPLAIN STATEMENT


AREA LIES WITHIN FLOOD ZONE X (OTHER AREAS). AREAS DETERMINED TO BE OUTSIDE THE 0.2% ANNUAL CHANCE OF FLOOD PLAN ACCORDING TO THE FLOOD INSURANCE RATE MAP PER FIRM MAP PANEL 328 OF 750, MAP NO. 35001C0328J, MAP REVISED DATE 11/04/2016, BERNILLO COUNTY, NEW MEXICO AND INCORPORATED AREAS.

DRAINAGE CONDITIONS

- EXISTING
THE EXISTING SITE IS A PARTIALLY DEVELOPED 0.97 AC LOT. THE CURRENT GRADING WAS DONE PER GRADING PLANS COMPLETED BY WOOTEN ENGINEERING THAT WERE APPROVED ON APRIL 7, 2015 BY THE CITY OF ALBUQUERQUE. THE APPROVED PLANS SHOWED ABOUT 7,500 SQUARE FEET OF RETAIL RESTAURANT BUILDING SPACE WHERE THE CURRENT PROPOSED BUILDING WILL BE LOCATED. THE SITE WAS DESIGNED AND GRADED TO DRAIN IN A WESTERLY DIRECTION (AWAY FROM 98TH ST) TOWARDS LANDSCAPE MEDIANS THROUGH SURFACE FLOWS. THESE MEDIANS THEN OUTLET TO THE EXISTING 98TH STREET STORM DRAIN THROUGH AN UNDERGROUND STORM DRAIN DRAIN SYSTEM CONTAINING VARYING PIPE SIZES. RUNOFF THAT DOES NOT MAKE IT TO THE LANDSCAPE MEDIANS WILL SHEET FLOW AND BE COLLECTED IN ONE OF THREE CATCH BASINS LOCATED ON 98TH STREET. THESE CATCH BASINS WERE SIZED AND BUILT BY CPM 676284.
- PROPOSED
THE PROPOSED SITE DESIGN MATCHES THE PREVIOUSLY APPROVED DRAINAGE MANAGEMENT PLAN AND THEREFORE MEETS ALL PRIOR REQUIREMENTS REGARDING DOWNSTREAM RUNOFF. THE DEVIATIONS FROM SAID DRAINAGE MANAGEMENT PLAN IS AN INCREASE OF PERVIOUS AREAS FROM 21% TO 27% AS WELL AS A NEW SITE LAYOUT

CONCLUSION

DUE TO THE COMPLIANCE WITH THE PREVIOUSLY APPROVED DRAINAGE MANAGEMENT PLAN, WE ARE REQUESTING THAT THIS DRAINAGE AND GRADING PLAN BE APPROVED

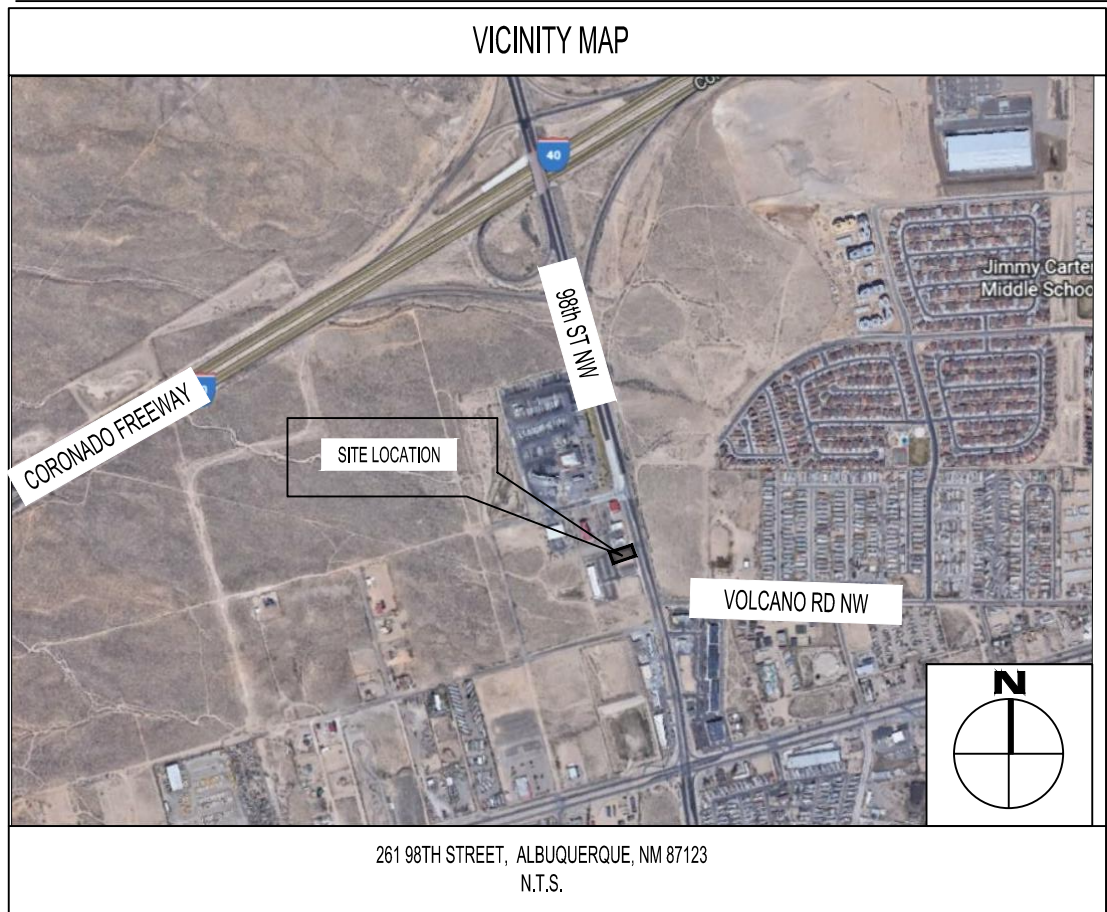

DRAINAGE CERTIFICATION
I, TIM SHOEMAKER, NMPE 26935, OF THE FIRM RTM ENGINEERING, HEREBY CERTIFY THAT THIS PROJECT HAS BEEN GRADED AND WILL DRAIN IN SUBSTANTIAL COMPLIANCE WITH AND IN ACCORDANCE WITH THE DESIGN INTENT OF THE APPROVED PLAN DATED 5/22/22. THE RECORD INFORMATION EDITED ONTO THE ORIGINAL DESIGN DOCUMENT HAS BEEN OBTAINED BY CHRISTOPHER MEDINA, NMPS 15702, OF THE FIRM TERRA LAND SURVEYS. I FURTHER CERTIFY THAT I HAVE PERSONALLY VISITED THE PROJECT SITE ON 11/15/24 AND HAVE DETERMINED BY VISUAL INSPECTION THAT THE SURVEY DATA PROVIDED IS REPRESENTATIVE OF ACTUAL SITE CONDITIONS AND IS TRUE AND CORRECT TO THE BEST OF MY KNOWLEDGE AND BELIEF. THIS CERTIFICATION IS SUBMITTED IN SUPPORT OF A REQUEST FOR FINAL CERTIFICATE OF OCCUPANCY.

THE RECORD INFORMATION PRESENTED HEREON IS NOT NECESSARILY COMPLETE AND INTENDED ONLY TO VERIFY SUBSTANTIAL COMPLIANCE OF THE GRADING AND DRAINAGE ASPECTS OF THIS PROJECT. THOSE RELYING ON THIS RECORD DOCUMENT ARE ADVISED TO OBTAIN INDEPENDENT VERIFICATION OF ITS ACCURACY BEFORE USING IT FOR ANY OTHER PURPOSE.



TIM SHOEMAKER, NMPE 26935, EXPIRES 12-31-2025

DATE: 11/15/24

RECORD DRAWING



GRADING LEGEND			
DESCRIPTION	EXISTING	PROPOSED	BY OTHERS
SPOT ELEVATION			
CONTOUR LINE			
FLOW ARROW			



04-29-2022



PANDA EXPRESS, INC.
1683 Walnut Grove Ave.
Rosemead, California
91770

Telephone: 626.799.9898
Facsimile: 626.372.8288

All ideas, designs, arrangement and plans indicated or represented by this drawing are the property of Panda Express Inc. and were created for use on this specific project. None of these ideas, designs, arrangements or plans may be used by or disclosed to any person, firm, or corporation without the written permission of Panda Express Inc.

REVISIONS:

NO.	DESCRIPTION	DATE

ISSUE DATE:

DRAWN BY:

rtm

PANDA PROJECT #: S8-23-D220241

PANDA STORE #: D220241

ARCH PROJECT #: 21229



650 E. Algonquin Road
Suite 250
Schaumburg, IL 60193
Telephone: (847) 756-4380
www.rtmec.com
OH Certificate of Authority: 05046

Heights Venture ARCHITECTURE + DESIGN

HOUSTON 1111 North Loop West, Suite 800 713 869 1103 V
DALLAS 5717 Legacy Drive, Suite 240 Plano, Texas 75094 972 490 7292 V

PANDA EXPRESS

261 98TH STREET
ALBUQUERQUE, NM 87123

GRADING AND DRAINAGE PLAN

C01.0

261 98TH STREET

PLANNING PERMIT SET



PANDA EXPRESS, INC.
1683 Walnut Grove Ave.
Rosemead, California
91770
Telephone: 626.799.9898
Facsimile: 626.372.8288

All ideas, designs, arrangement and plans indicated or represented by this drawing are the property of Panda Express Inc. and were created for use on this specific project. None of these ideas, designs, arrangements or plans may be used by or disclosed to any person, firm, or corporation without the written permission of Panda Express Inc.

REVISIONS:

	CITY COMMENTS	02-14-23
	PANDA COMMENTS	02-14-23
	CITY COMMENTS 2	04-28-23
	CITY COMMENTS 3	06-28-23
	CONSTRUCTION SET REV.	08-01-23
	CONSTRUCTION SET REV.	09-08-23

ISSUE DATE:

1	DRB SUBMITTAL	06-17-2022
2	PERMIT SET	09-09-2022
3	BID SET	10-03-2022
4	CONSTRUCTION SET	02-14-2023
5	CONSTRUCTION SET	08-01-2023
6	DELTA 6 REV.	09-11-2023

DRAWN BY: rtm

PANDA PROJECT #: S8-23-D220241

PANDA STORE #: D220241

ARCH PROJECT #: 21229

rtm
engineering consultants
9225 Indian Creek Pkwy
Suite 1075
Overland Park, KS 66210
Telephone: (913) 332-1400
www.rtmec.com
KS Certificate of Authority: E-2641

Heights Venture
ARCHITECTURE DESIGN

HOUSTON 1111 North Loop West, Suite 800 713 869 1103 V
DALLAS 5717 Legacy Drive, Suite 240 Plano, Texas 75024 972 490 7292 V

PANDA EXPRESS

PANDA HOME - CUSTOM
261 98TH STREET
ALBUQUERQUE, NM 87123

UTILITY PLAN

C04.0

PANDA HOME - SQUARE CUSTOM

NOTES:

- EX. ITEMS SHALL BE FIELD VERIFIED. RELOCATION OR ADJUSTMENT MAY BE NEEDED. CONTRACTOR TO VERIFY.
- CONTRACTOR SHALL VERIFY ALL WORK, INCLUDING BUT LIMITED TO, SIZES, MATERIALS AND LOCATION, WITH UTILITY COMPANIES PRIOR TO INSTALLATION.
- VERIFY SERVICE LOCATIONS WITH BUILDING PLANS PRIOR TO CONSTRUCTION AND NOTIFY ENGINEER OF ANY DISCREPANCIES.
- RIM GRADES ALONG CURBS ARE FLOW LINE ELEVATIONS.
- SEE SPECIFICATIONS SHEETS FOR ALL STORM, SANITARY, AND WATER PIPE AND STRUCTURE SPECIFICATIONS.
- ALL UTILITY TIE DIMENSIONS ARE FROM CENTER OF UTILITY AND TO BACK OF CURB WHEN TIED TO CURB LINES, UNLESS OTHERWISE NOTED.
- CONTRACTOR TO INSPECT EXISTING SEWER AT POINT OF CONNECTION. CONTRACTOR TO VERIFY THAT EXISTING PIPE IS IN GOOD WORKING CONDITION. CONTRACTOR TO REPAIR AS REQUIRED.
- CONTRACTOR TO NOTIFY OWNER/ENGINEER IF CONFLICTS OCCUR.
- NEW OPENING/CONNECTIONS TO EXISTING MANHOLE/STRUCTURES SHALL BE CORE-DRILLED.
- TEST PITS MUST BE EXCAVATED IN ADVANCE OF CONSTRUCTION IN ORDER TO CONFIRM DEPTH AND LOCATION OF EXISTING UTILITIES. NO ADDITIONAL PAYMENT WILL BE MADE FOR TEST PIT EXCAVATION.
- ALL NEW STORM STRUCTURES SHALL HAVE ADA COMPATIBLE OPEN LIDS, PER JURISDICTION STANDARDS.
- ALL UTILITY CONSTRUCTION SHALL BE IN ACCORDANCE WITH PERKINS TOWNSHIP/ERIE COUNTY PUBLIC UTILITIES AND CROSS CONNECTION CONTROL REGULATIONS AND STANDARDS.
- THE CONTRACTOR SHALL OBTAIN AND PAY FOR ALL INSPECTIONS, CERTIFICATIONS, EQUIPMENT ETC., THAT MAY BE REQUIRED.
- CONTRACTOR SHALL COORDINATE GAS, ELECTRIC, AND TELEPHONE CONDUIT, PIPING, AND CONDUCTOR REQUIREMENTS WITH MEP PLANS AND UTILITY PROVIDER PRIOR TO INSTALLATION.
- STREET ASPHALT PAVEMENT SHALL BE RESTORED IN ACCORDANCE WITH CITY OF ALBUQUERQUE REQUIREMENTS AND STANDARDS.

UTILITY LEGEND

DESCRIPTION	EXISTING	PROPOSED
WATERMAIN PIPE	— W —	— W —
STORM SEWER PIPE	— S —	— S —
SANITARY SEWER PIPE	— SS —	— SS —
ELECTRICAL DUCT BANK	— E —	— E —
NATURAL GAS LINE	— G —	— G —
COMMUNICATIONS LINE	— COM —	— COM —
OVERHEAD LINE	— OHW —	— OHW —
TELEVISION CABLE	— TV —	— TV —
UNDERGROUND WIRE	— UGW —	— UGW —
TELEPHONE CABLE	— T —	— T —
FIBER OPTIC CABLE	— FO —	— FO —
AERIAL WIRES	— A —	— A —
EASEMENT LINE	— — —	— — —
VENT LINE	— — —	— — —
VALVE VAULT	⊗	⊗
WATER B-BOX	⊗	⊗
WATER VALVE BOX	⊗	⊗
FIRE HYDRANT	⊗	⊗
WELL HEAD	⊗	⊗
FIRE DEPARTMENT CONNECTION	⊗	⊗
STORM INLET	⊗	⊗
STORM MANHOLE	⊗	⊗
CATCH BASIN	⊗	⊗
STORM CLEANOUT	⊗	⊗
DOWNSPOUT	⊗	⊗
FLARED END SECTION	⊗	⊗
SANITARY MANHOLE	⊗	⊗
SANITARY CLEANOUT	⊗	⊗
LIGHT POLE	⊗	⊗
TELEPHONE MANHOLE	⊗	⊗
POWER POLE	⊗	⊗
GAS VALVE	⊗	⊗
GAS METER	⊗	⊗
HAND HOLE	⊗	⊗
MAIL BOX	⊗	⊗
ELECTRICAL MANHOLE	⊗	⊗
CABLE TV PEDESTAL	⊗	⊗
TELEPHONE PEDESTAL	⊗	⊗



RECORD DRAWING

UTILITY PLAN



SCALE: 1" = 20'

CONTECH CROSS SECTION

N.T.S.

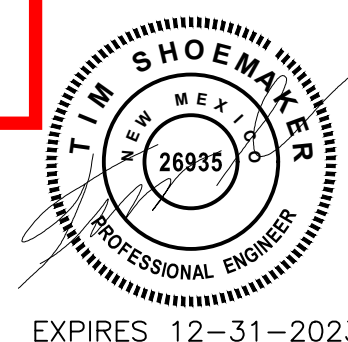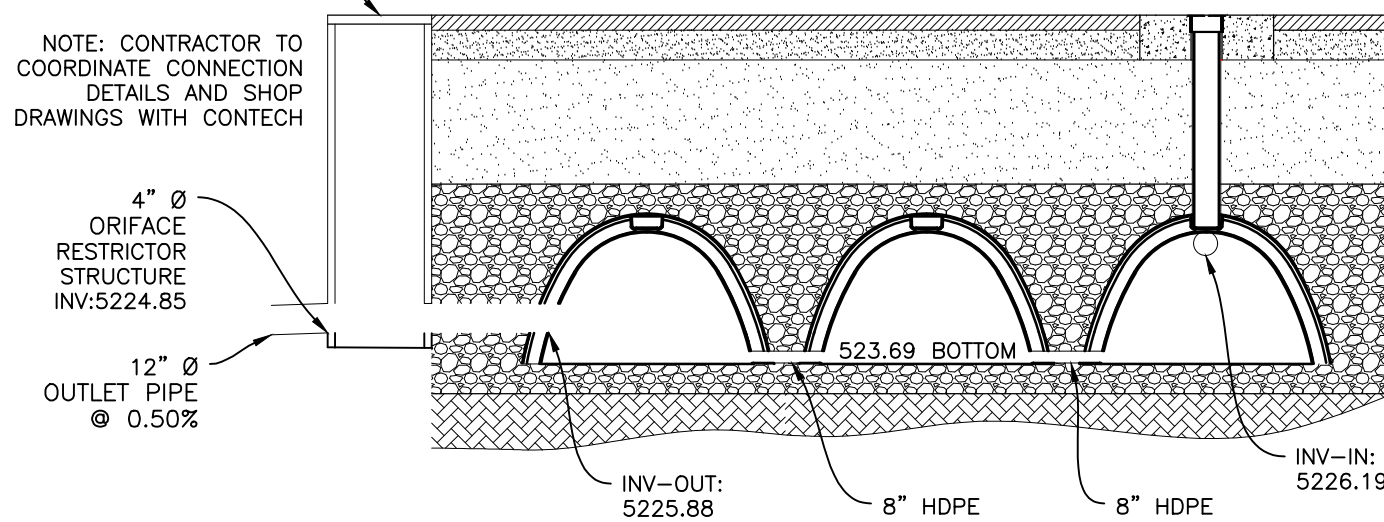

CONSTRUCTION ISSUE

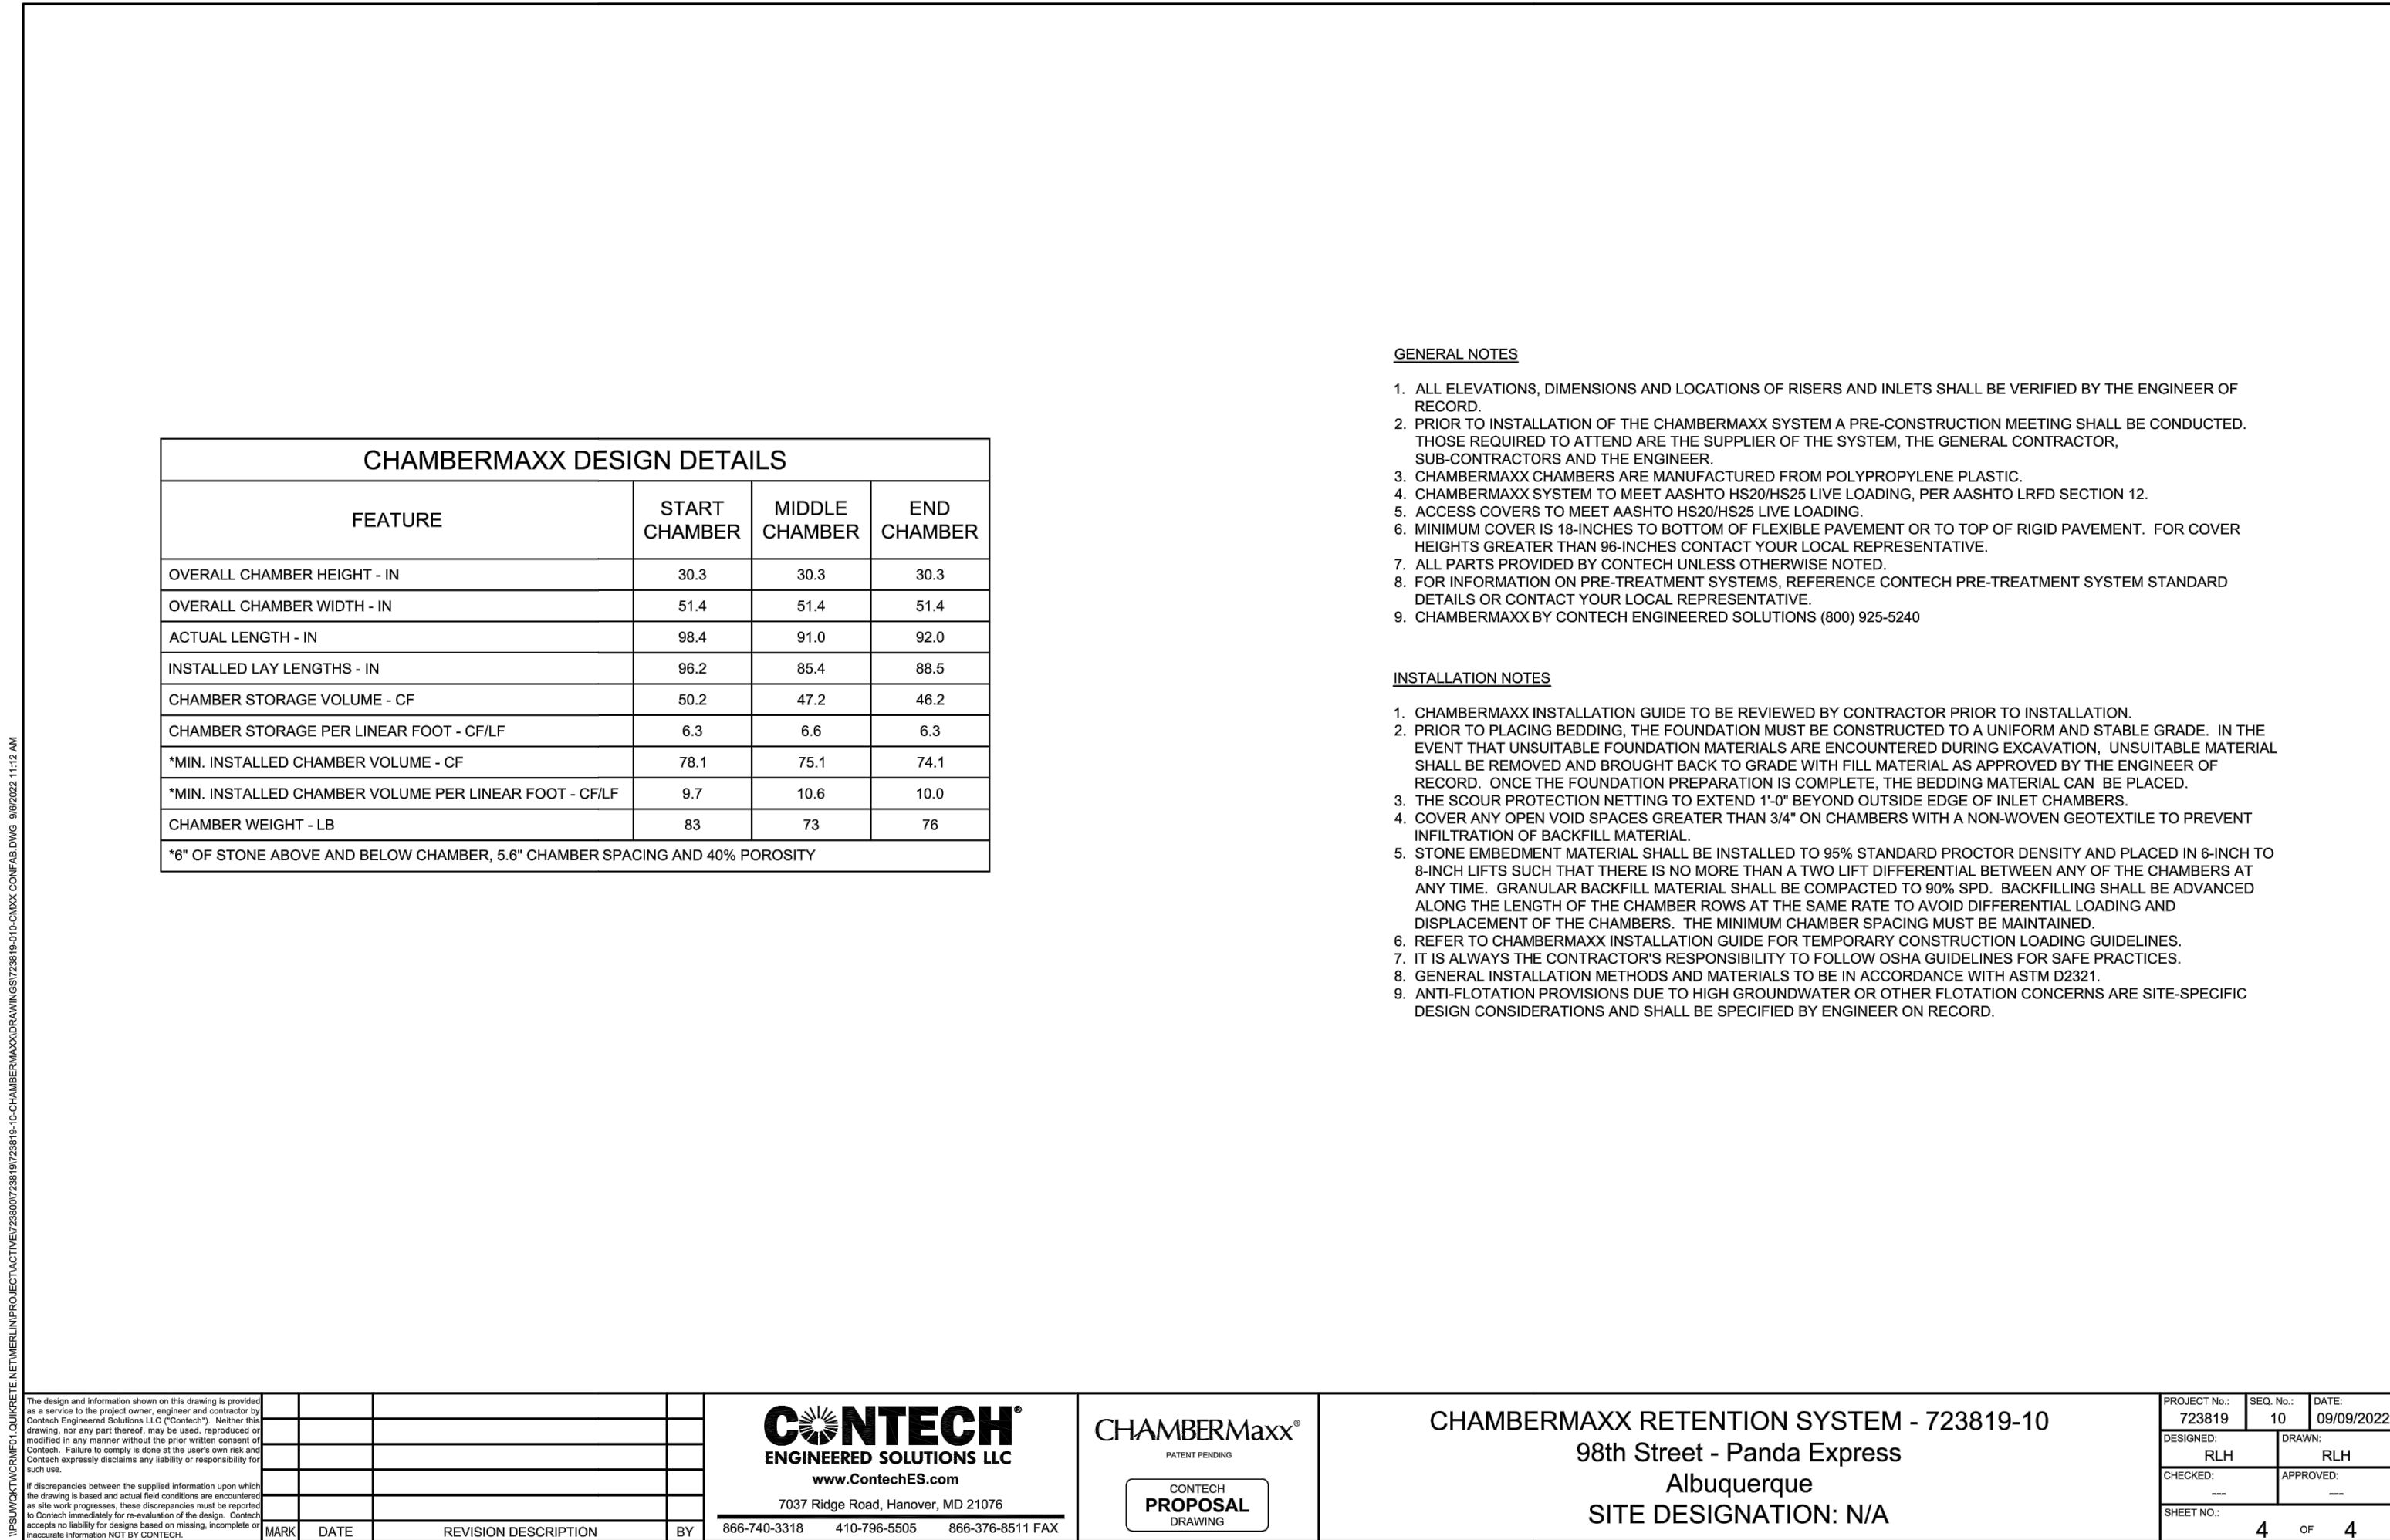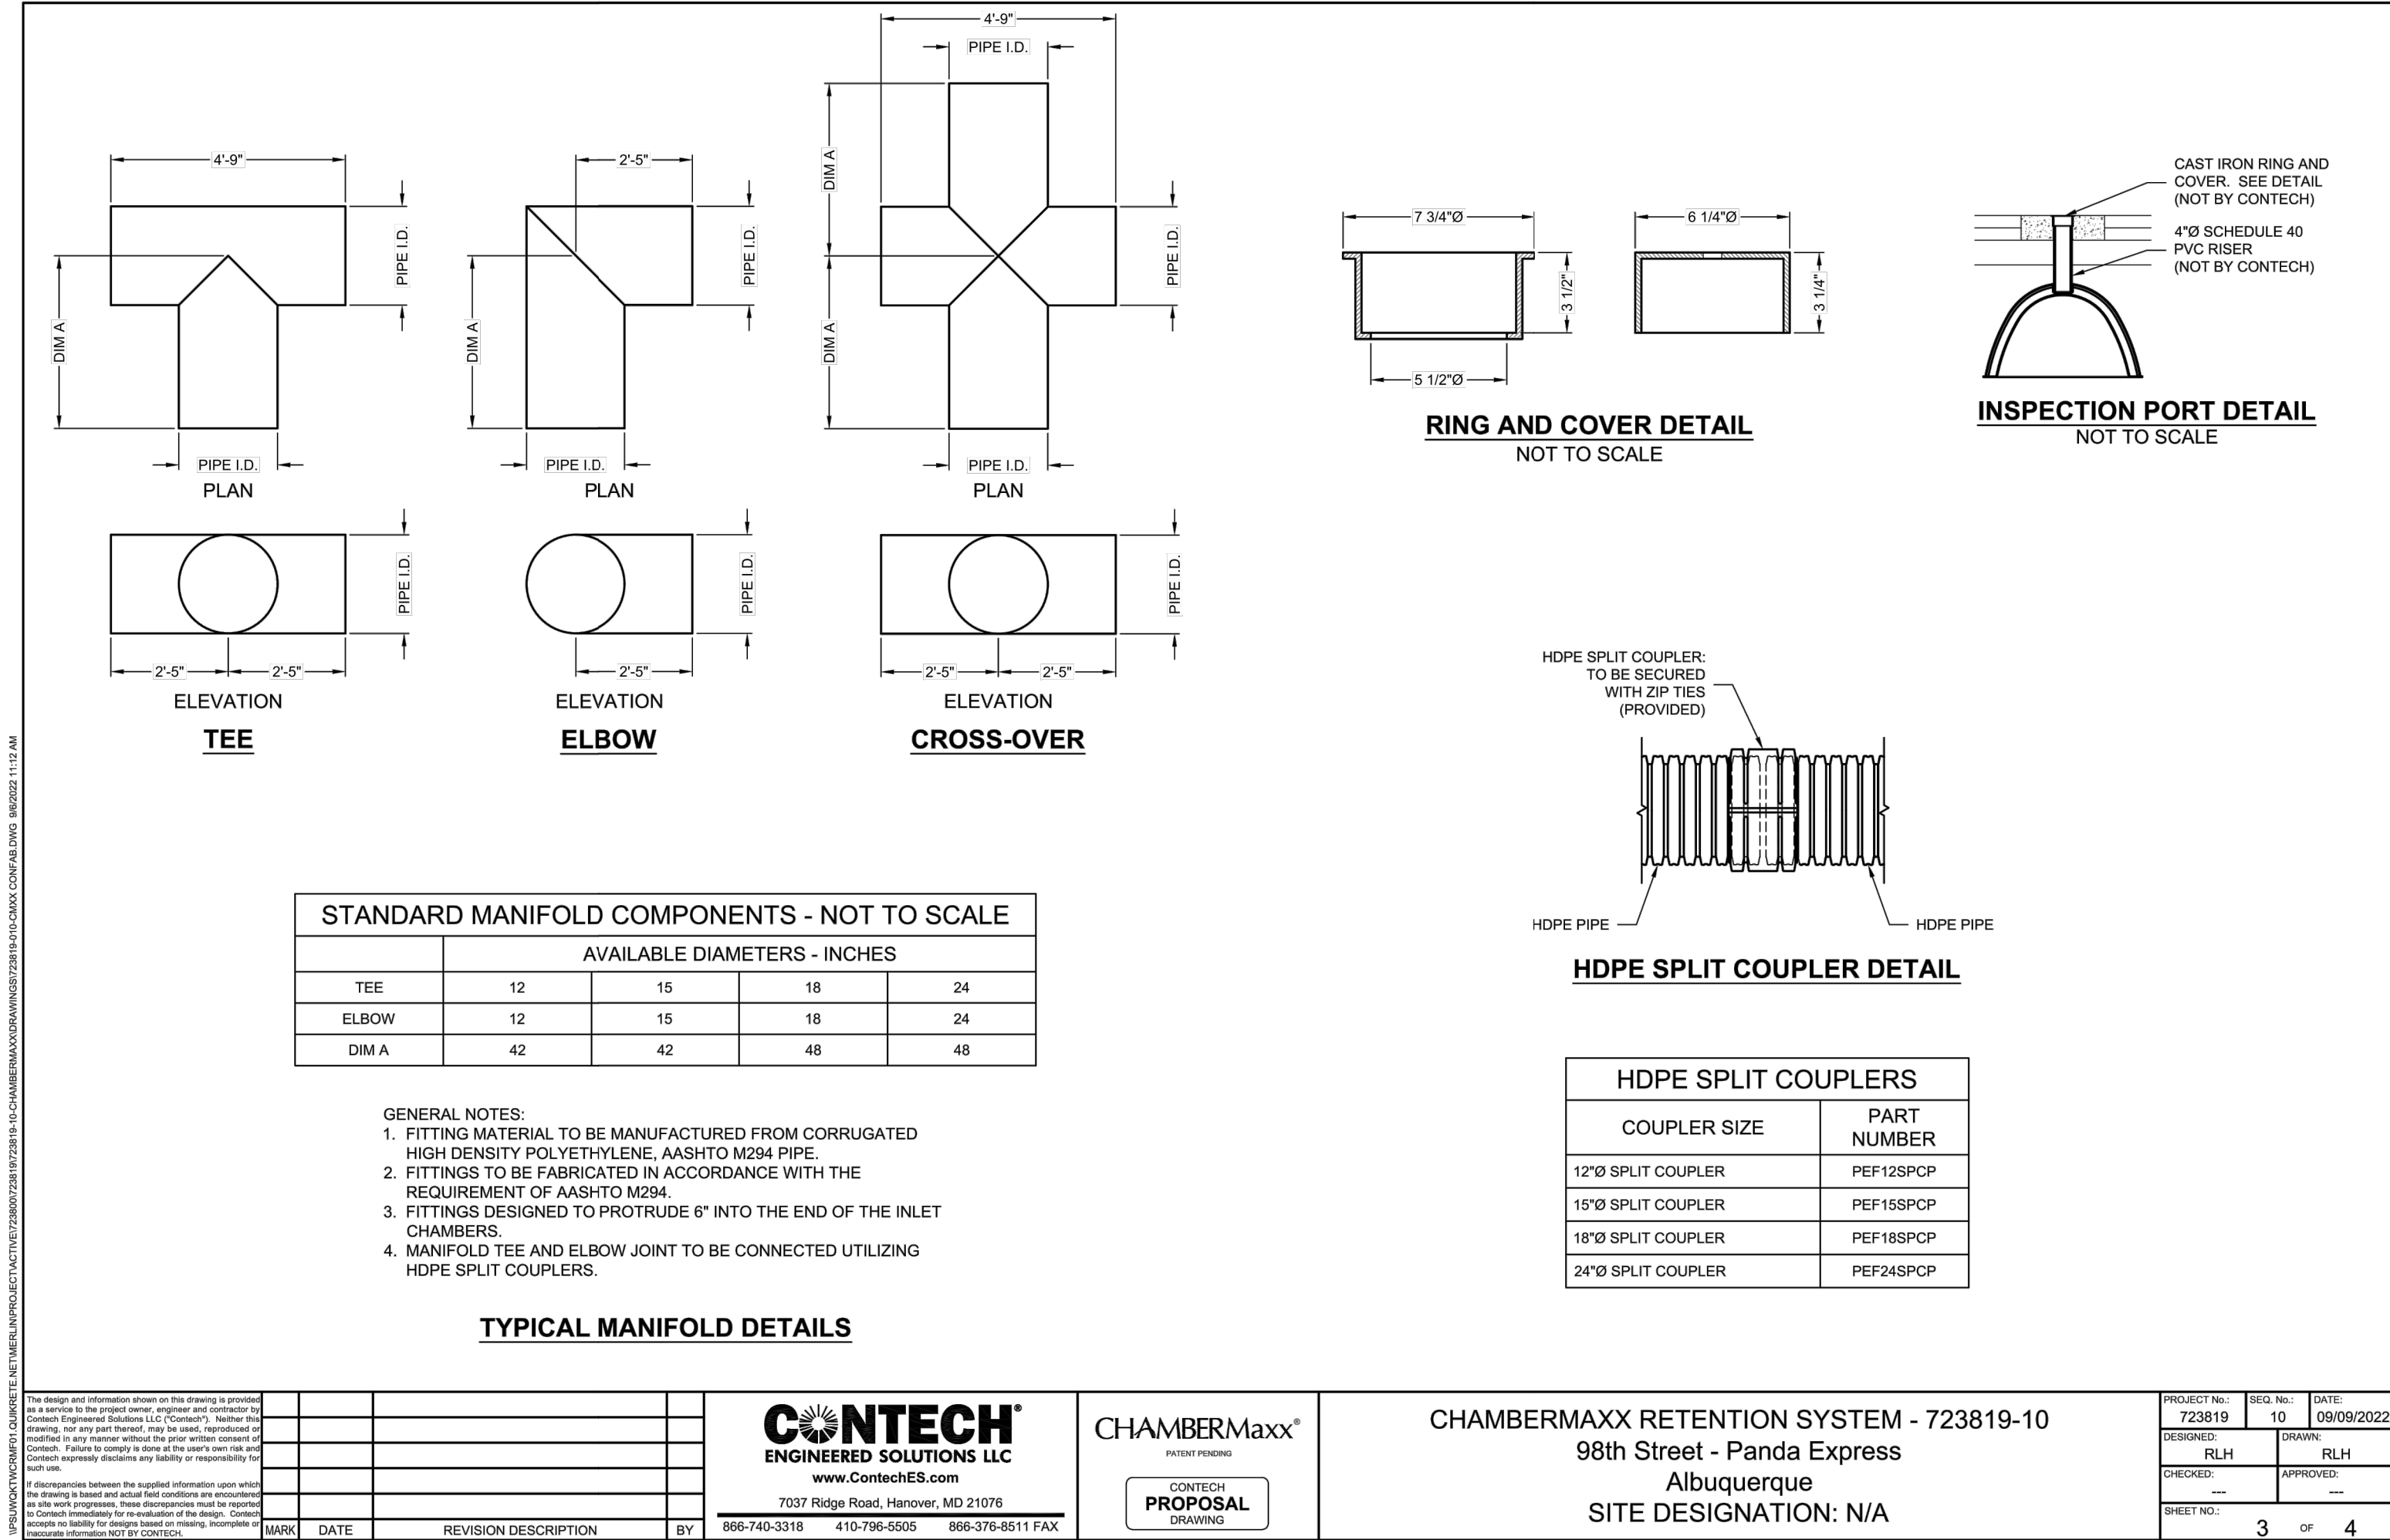

PANDA EXPRESS, INC.
1683 Walnut Grove Ave.
Rosemead, California
91770
Telephone: 626.799.9898
Facsimile: 626.372.8288

All ideas, designs, arrangement and plans indicated or represented by this drawing are the property of Panda Express Inc. and were created for use on this specific project. None of these ideas, designs, arrangements or plans may be used by or disclosed to any person, firm, or corporation without the written permission of Panda Express Inc.

REVISIONS:

CITY COMMENTS	02-14-23
PANDA COMMENTS	02-14-23
CITY COMMENTS 2	04-28-23
CITY COMMENTS 3	06-28-23
CONSTRUCTION SET REV.	08-01-23

ISSUE DATE:

1	DRB SUBMITTAL	06-17-2022
2	PERMIT SET	09-09-2022
3	BID SET	10-03-2022
4	CONSTRUCTION SET	02-14-2023
5	CONSTRUCTION SET	08-01-2023
6	DELTA 6 REV.	09-11-2023

DRAWN BY: rtm

PANDA PROJECT #: S8-23-D220241
PANDA STORE #: D220241
ARCH PROJECT #: 21229

rtm
engineering consultants
9225 Indian Creek Pkwy
Suite 1075
Overland Park, KS 66210
Telephone: (913) 332-1490
www.rtmec.com
KS Certificate of Authority: E-2641

Heights Venture
ARCHITECTURE DESIGN

HOUSTON 1111 North Loop West, Suite 800 Houston, Texas 77008 713 869 1103 V
DALLAS 5717 Legacy Drive, Suite 240 Plano, Texas 75024 972 490 7292 V

PANDA EXPRESS
PANDA HOME - CUSTOM
261 98TH STREET
ALBUQUERQUE, NM 87123

UTILITY DETAILS IV

C04.5

PANDA HOME - SQUARE CUSTOM

CONSTRUCTION ISSUE



- NOTES:
- CONTRACTOR TO COORDINATE CONNECTION DETAILS AND SHOP DRAWINGS WITH CONTECH

SURVEYOR'S CERTIFICATE

I, CHRISTOPHER A. MEDINA, N.M.P.L.S. NO. 15702, DO HEREBY CERTIFY THAT THE AS-BUILT INFORMATION SHOWN ON SHEETS 9 AND SHEET 12, AND THE ACTUAL SURVEY WHICH IT WAS DERIVED FROM WAS PERFORMED BY ME OR UNDER MY DIRECT SUPERVISION; THAT THIS AS-BUILT SURVEY WAS PERFORMED IN THE MONTH OF OCTOBER 2023; AND THAT THE INFORMATION SHOWN IS TRUE AND CORRECT TO THE BEST OF MY KNOWLEDGE AND BELIEF AND THAT IT MEETS ALL REQUIREMENTS LISTED UNDER THE STANDARD DRAWINGS AND STANDARD SPECIFICATIONS FOR SURVEYING.

Christopher A. Medina
CHRISTOPHER A. MEDINA, NMPLS NO. 15702

NOV. 14, 2024
DATE




GRADING LEGEND			
DESCRIPTION	EXISTING	PROPOSED	BY OTHERS
SPOT ELEVATION		TC:XX.XX FL:XX.XX	P:XX.XX
CONTOUR LINE	600	600	600
FLOW ARROW	(X.X%)	X.X%	

NOTES:

1. PERVIOUS/ IMPERVIOUS AREA:

EXISTING
PERVIOUS--0.19 AC (19.5%)
IMPERVIOUS--0.78 AC (80.5%)
PROPOSED
PERVIOUS--0.20 AC (21%)
IMPERVIOUS--0.77 AC (79%)

SEE SHEETS EH.01 AND EH.02 FOR FULL EXHIBIT

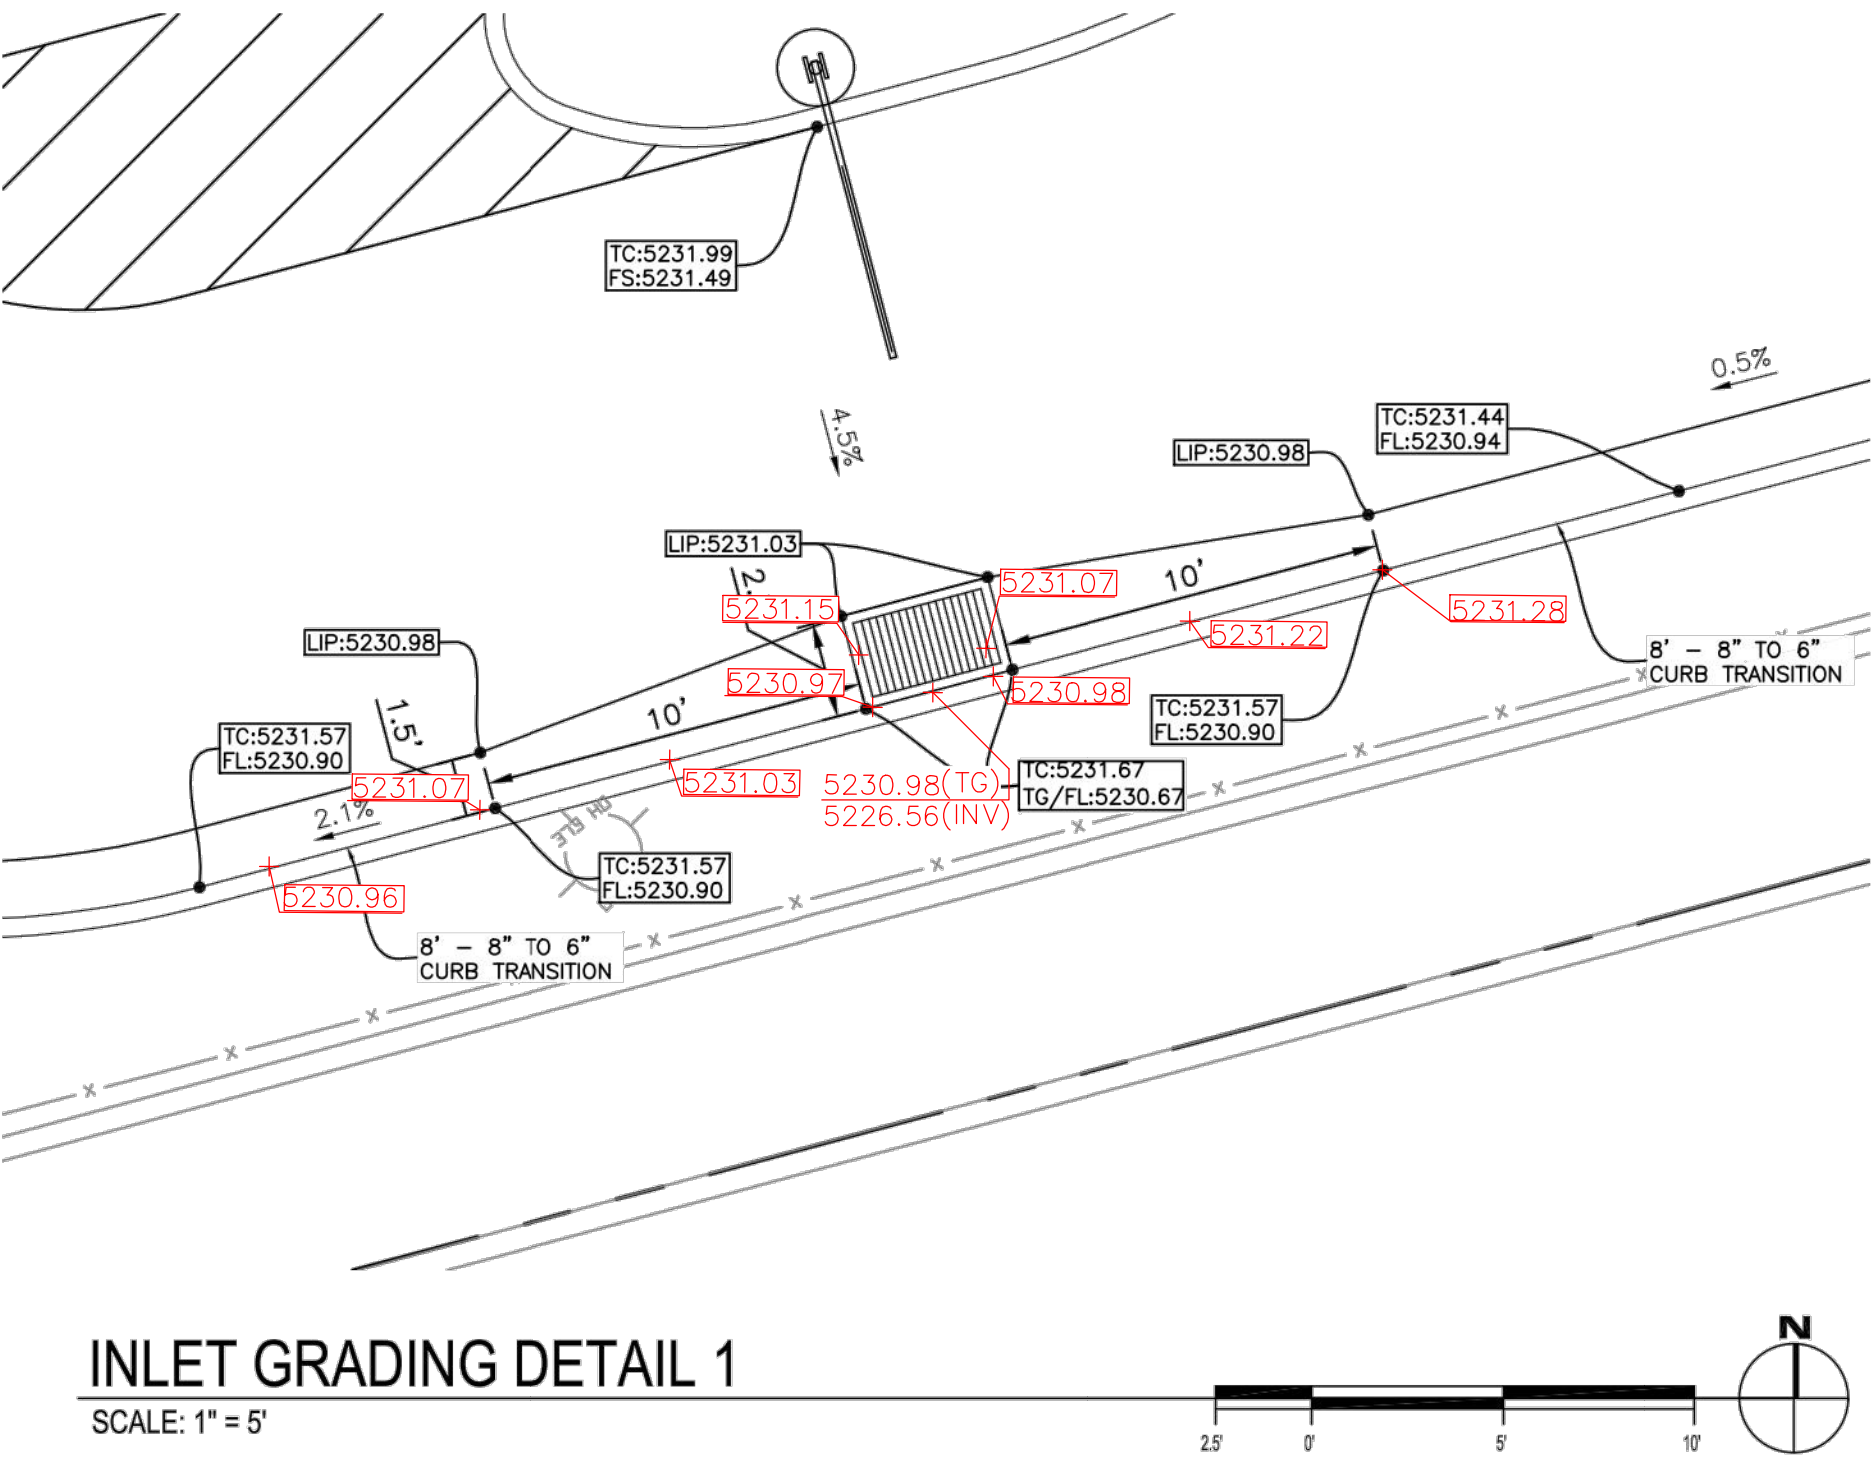


GRADING NARRATIVE:

THE PROPOSED LOT IS TO MATCH THE PREVIOUSLY APPROVED GRADING PLANS FOR THIS SITE. THE SITE DRAINS FROM EAST TO WEST AND IS COLLECTED VIA A GRATED INLET AND MEDIAN. THE SITE IS BOUNDED BY 98TH STREET TO THE EAST AND AN EXISTING PARKING LOT TO THE WEST.



GRADING PLAN

SCALE: 1" = 20'

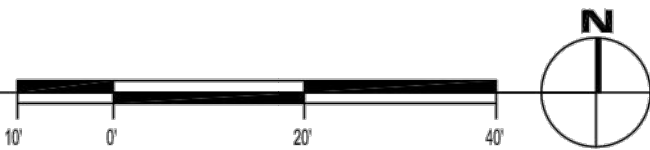

PANDA EXPRESS, INC.
1683 Walnut Grove Ave.
Rosemead, California
91770

Telephone: 626.799.9898
Facsimile: 626.372.8288

All ideas, designs, arrangement and plans indicated or represented by this drawing are the property of Panda Express Inc. and were created for use on this specific project. None of these ideas, designs, arrangements or plans may be used by or disclosed to any person, firm, or corporation without the written permission of Panda Express Inc.

REVISIONS:

	CITY COMMENTS	02-14-23
1	PANDA COMMENTS	02-14-23
2	CITY COMMENTS 2	04-28-23
3	CITY COMMENTS 3	06-28-23
4	CONSTRUCTION SET REV.	08-01-23
5	CONSTRUCTION SET REV.	09-08-23

ISSUE DATE:

1	DRB SUBMITTAL	06-17-2022
2	PERMIT SET	09-09-2022
3	BID SET	10-03-2022
4	CONSTRUCTION SET	02-14-2023
5	CONSTRUCTION SET	08-01-2023
6	DELTA 6 REV.	09-11-2023

DRAWN BY: rtm

PANDA PROJECT #: S8-23-D220241

PANDA STORE #: D220241

ARCH PROJECT #: 21229



Heights Venture
ARCHITECTURE + DESIGN

HOUSTON 1111 North Loop West, Suite 800 713 869 1103 V
DALLAS 5717 Legacy Drive, Suite 240 Plano, Texas 75024 972 450 7292 V

PANDA EXPRESS

PANDA HOME - CUSTOM
261 98TH STREET
ALBUQUERQUE, NM 87123

GRADING PLAN

C05.0

PANDA HOME - SQUARE CUSTOM