
CITY OF ALBUQUERQUE

Planning Department Alan Varela, Director

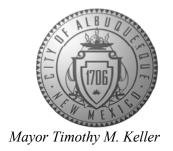

September 25, 2023

Ronald Bohannan, P.E. Tierra West, LLC 5571 Midway Park Place NE Albuquerque, NM 87109

RE: Southern Tire Mart

Permanent C.O. - Accepted

Engineer's Certification Date: 09/14/23

Engineer's Stamp Date: 03/29/21

Hydrology File: K09D047

Dear Mr. Bohannan:

PO Box 1293 Based on the Certification received 09/15/2023 and site visit on 09/22/2023, this letter serves as

a "green tag" from Hydrology Section for a Permanent Certificate of Occupancy to be issued by

the Building and Safety Division.

Renée C. Brissette

Albuquerque If you have any questions, please contact me at 924-3995 or rbrissette@cabq.gov.

Sincerely,

NM 87103

Renée C. Brissette, P.E. CFM

Senior Engineer, Hydrology

Planning Department

CITY OF ALBUQUERQUE



May 3, 2022

CERTIFICATE OF COMPLETION AND ACCEPTANCE

Ben Spencer, as Manager of Titan Property 98th and I-40 Land, LLC 6300 Riverside Plaza Lane NE Ste 200 Albuquerque, NM 87120

RE: **Daytona Southern Tire Mart** City Project Number: **655788**

Dear Ben Spencer:

This is to certify that the City of Albuquerque accepts the construction of the infrastructure provided in the Work Order Construction Plans, City Project No.655788. The work was completed pursuant to the required infrastructure listed in the Infrastructure Improvements Agreement (IIA) Procedure B, between 98th and I-40 Land, LLC, and the City of Albuquerque executed on July 8, 2021.

Please note that the title "Subdivision Improvements Agreement" and the word "Subdivider" which may have been used in the original agreements are respectively replaced with the title "Infrastructure Improvements Agreement" and the word "Developer". These changes have no substantive effect on this Certificate of Completion and Acceptance.

Having satisfied the requirements referenced above, the IIA and any associated Financial Guaranty, held by the City, can now be released. Any performance/ warranty bond and the indemnity and hold harmless provisions of the IIA in favor of the City shall remain in effect. The contractor's warranty period will begin **May 3, 2022** and is effective for a period of one (1) year.

Should you have any questions or issues regarding this project, please contact me at (505) 924-3997.

Sincerely,

Shahab Biazar C7E1CB5481E9486...

Shahab Biazar, P.E., City Engineer Development Review Services Planning Department City of Albuquerque





TIERRA WEST, LLC

September 15, 2023

Ms. Marwa Al-najjar Development Review Services City of Albuquerque P.O. Box 1293 Albuquerque, NM 87103

RE: AA APPROVED SITE PLAN CERTIFICATION
REQUEST FOR TEMPORARY CERTIFICATE OF OCCUPANCY
8301 DAYTONA RD NW, ALBUQUERQUE NM 87121

I, Ronald R. Bohannan, NMPE #7868, of the firm Tierra West LLC, hereby request approval of the as-built AA Approved Site Plan for issuance of a Temporary Certificate of Occupancy for the project referenced above. This project is in substantial compliance as inspected on September 14, 2023, and is in general accordance with the design intent of the AA Approved Site Plan dated 6/08/21.

The record information presented hereon is not necessarily complete and intended only to verify substantial compliance of the traffic aspects of this project. Those relying on the record document are advised to obtain independent verification of its accuracy before using it for any other purpose.

Enclosed, please find the information sheet and the as-built Approved Site Plan for Building Permit. Therefore, we request approval of the as-built AA Approved Site Plan and issuance of the Temporary Certificate of Occupancy to allow stocking and training to proceed while the contractor completes the noted punchlist items.

If you have any questions or need additional information regarding this matter, please do not hesitate to contact me.



JN: 202031 RRB/VC/bf




City of Albuquerque

Planning Department
Development & Building Services Division

DRAINAGE AND TRANSPORTATION INFORMATION SHEET (DTIS)

Project Title:		Hydrology File #		
Legal Description:				
City Address, UPC, OR Parcel	:			
Applicant/Agent:		Contact:		
		Phone:		
Email:				
Applicant/Owner:		Contact:		
Address:		Phone:		
Email:				
(Please note that a DFT SITE is or	ne that needs Site Plan A	pproval & ADMIN SITE is one that does not need it.)		
TYPE OF DEVELOPMENT:	PLAT (#of lots)	RESIDENCE		
	DFT SITE	ADMIN SITE		
RE-SUBMITTAL: YES	NO			
DEPARTMENT: TRANS	SPORTATION	HYDROLOGY/DRAINAGE		
Cheek all that apply under Dath	the Type of Submittel	and the Type of Approval Sought:		
TYPE OF SUBMITTAL:	the Type of Submittal	TYPE OF APPROVAL SOUGHT:		
ENGINEER/ARCHITECT CF	RTIFICATION	BUILDING PERMIT APPROVAL		
PAD CERTIFICATION		CERTIFICATE OF OCCUPANCY		
CONCEPTUAL G&D PLAN		CONCEPTUAL TCL DFT APPROVAL		
GRADING & DRAINAGE PLAN DRAINAGE REPORT DRAINAGE MASTER PLAN CLOMR/LOMR		PRELIMINARY PLAT APPROVAL FINAL PLAT APPROVAL		
		APPROVAL		
		TRAFFIC CIRCULATION LAYOUT (TCL) ADMINISTRATIVE TRAFFIC CIRCULATION LAYOUT FOR DFT APPROVAL TRAFFIC IMPACT STUDY (TIS) STREET LIGHT LAYOUT OTHER (SPECIFY)		SIA/RELEASE OF FINANCIAL GUARANTEE
FOUNDATION PERMIT APPROVAL				
GRADING PERMIT APPROVAL				
SO-19 APPROVAL				
PAVING PERMIT APPROVAL				
GRADING PAD CERTIFICATION				
· - /		WORK ORDER APPROVAL		
		CLOMR/LOMR		
		OTHER (SPECIFY)		
DATE SUBMITTED:				

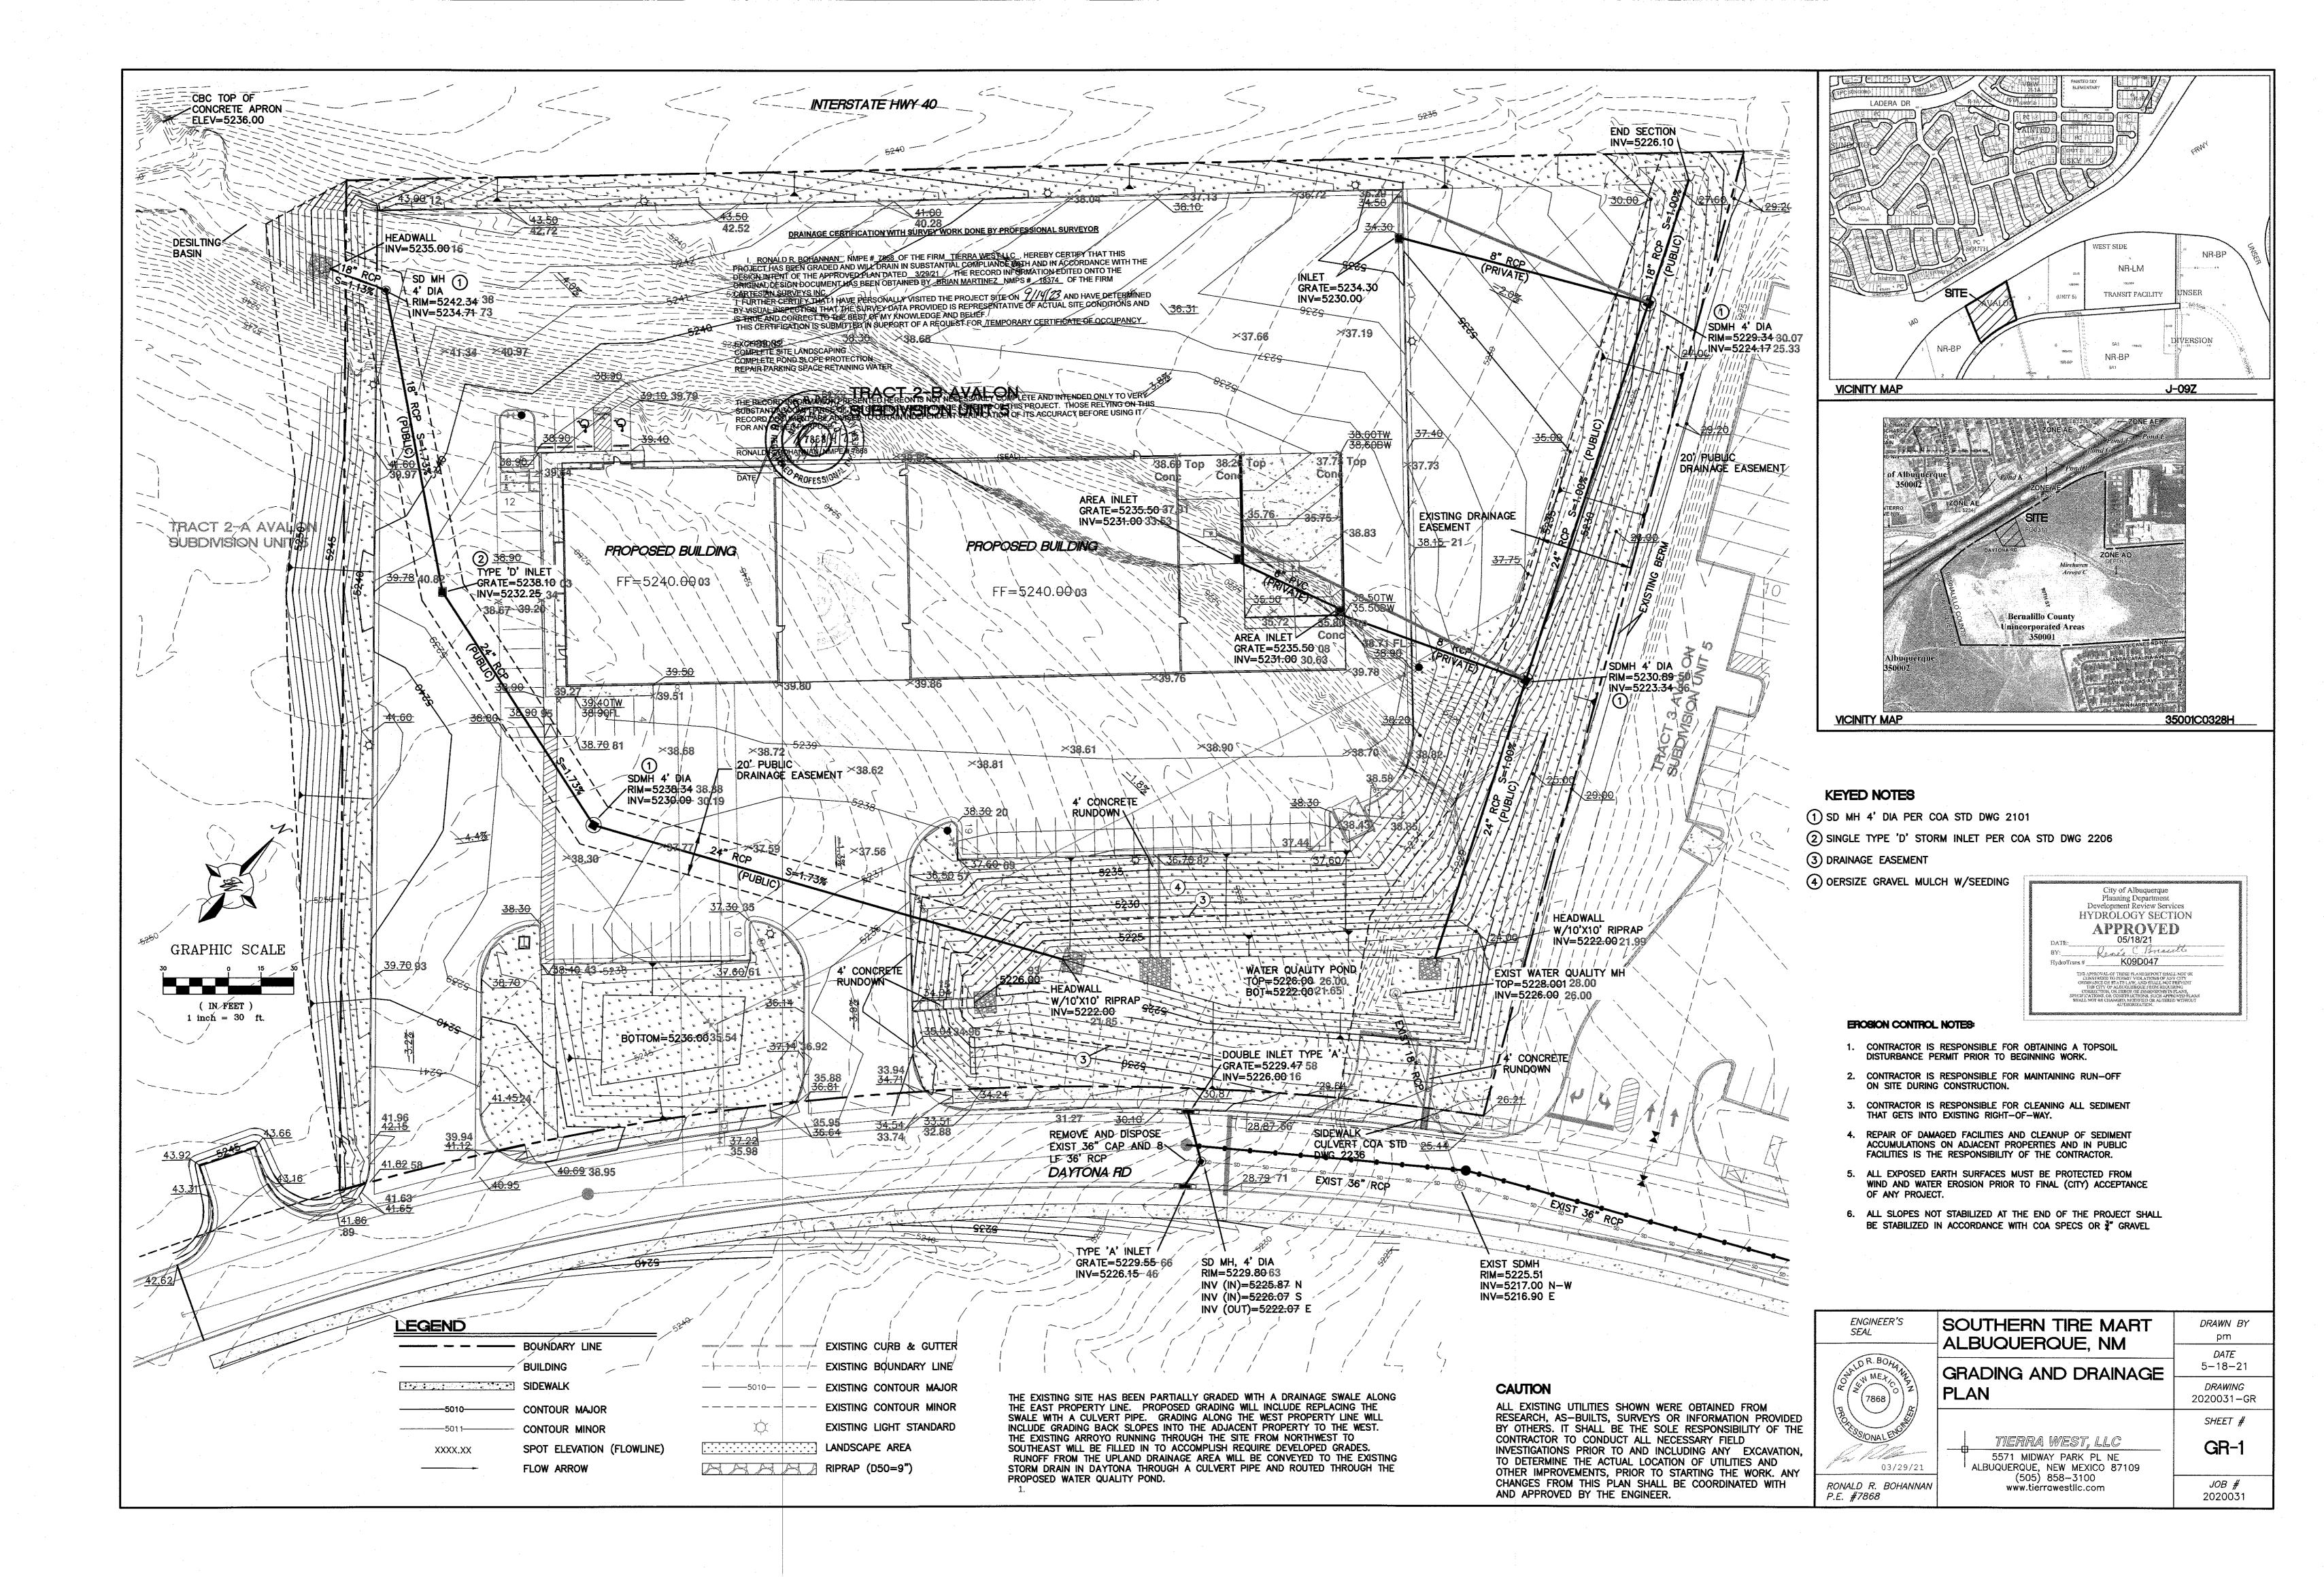





City of Albuquerque

Planning Department
Development & Building Services Division

DRAINAGE AND TRANSPORTATION INFORMATION SHEET (DTIS)

Project Title:		Hydrology File #		
Legal Description:				
City Address, UPC, OR Parcel	:			
Applicant/Agent:		Contact:		
		Phone:		
Email:				
Applicant/Owner:		Contact:		
Address:		Phone:		
Email:				
(Please note that a DFT SITE is or	ne that needs Site Plan A	pproval & ADMIN SITE is one that does not need it.)		
TYPE OF DEVELOPMENT:	PLAT (#of lots)	RESIDENCE		
	DFT SITE	ADMIN SITE		
RE-SUBMITTAL: YES	NO			
DEPARTMENT: TRANS	SPORTATION	HYDROLOGY/DRAINAGE		
Cheek all that apply under Dath	the Type of Submittel	and the Type of Approval Sought:		
TYPE OF SUBMITTAL:	the Type of Submittal	TYPE OF APPROVAL SOUGHT:		
ENGINEER/ARCHITECT CF	RTIFICATION	BUILDING PERMIT APPROVAL		
PAD CERTIFICATION		CERTIFICATE OF OCCUPANCY		
CONCEPTUAL G&D PLAN		CONCEPTUAL TCL DFT APPROVAL		
GRADING & DRAINAGE PLAN DRAINAGE REPORT DRAINAGE MASTER PLAN CLOMR/LOMR		PRELIMINARY PLAT APPROVAL FINAL PLAT APPROVAL		
		APPROVAL		
		TRAFFIC CIRCULATION LAYOUT (TCL) ADMINISTRATIVE TRAFFIC CIRCULATION LAYOUT FOR DFT APPROVAL TRAFFIC IMPACT STUDY (TIS) STREET LIGHT LAYOUT OTHER (SPECIFY)		SIA/RELEASE OF FINANCIAL GUARANTEE
FOUNDATION PERMIT APPROVAL				
GRADING PERMIT APPROVAL				
SO-19 APPROVAL				
PAVING PERMIT APPROVAL				
GRADING PAD CERTIFICATION				
· - /		WORK ORDER APPROVAL		
		CLOMR/LOMR		
		OTHER (SPECIFY)		
DATE SUBMITTED:				

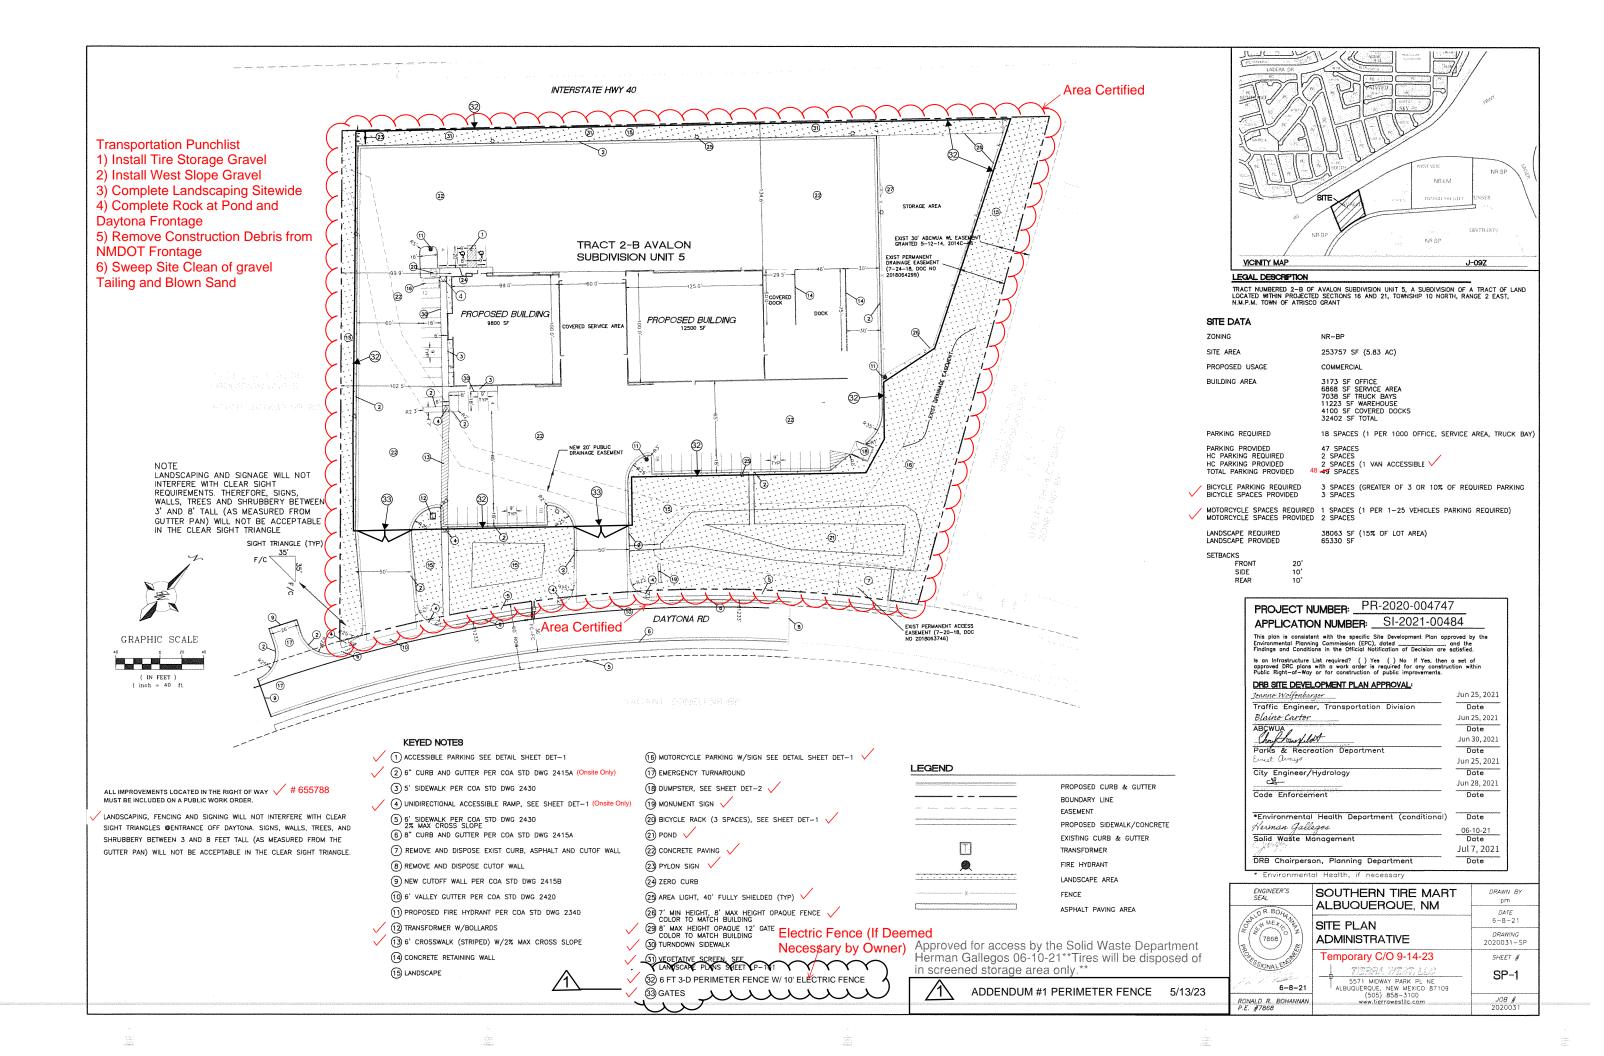

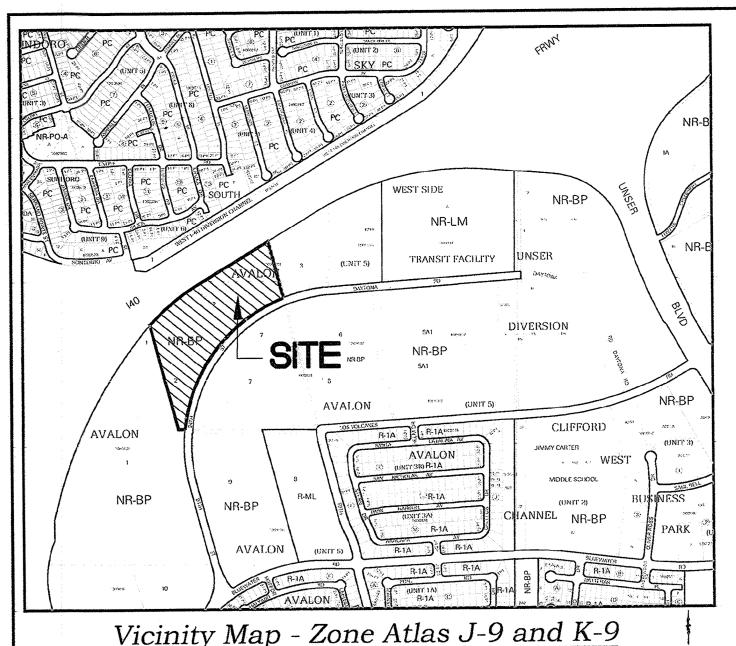

Documents

- TITLE COMMITMENT PROVIDED BY OLD REPUBLIC NATIONAL TITLE, HAVING FILE NO. 2009604 AND AN EFFECTIVE DATE OF OCTOBER 29, 2020
- 2. PLAT OF RECORD FOR AVALON SUBDIVISION UNIT 5 FILED IN THE BERNALILLO COUNTY CLERK'S OFFICE ON MAY 22, 2014 IN BOOK 2014C, PAGE 46.
- SPECIAL WARRANTY DEED FOR SUBJECT PROPERTY TO 98TH AND I-40 LAND LLC FILED DECEMBER 14, 2016 AS DOCUMENT 2016116751.

Notes

- 1. FIELD SURVEY PERFORMED IN NOVEMBER 2020. 2. ALL DISTANCES ARE GROUND DISTANCES: US SURVEY FOOT.
- 3. THE BASIS OF BEARINGS REFERENCES NEW MEXICO STATE PLANE COORDINATES (NAD 83-CENTRAL ZONE).

Solar Collection Note

NO PROPERTY WITHIN THE AREA OF REQUESTED FINAL ACTION SHALL AT ANY TIME BE SUBJECT TO A DEED RESTRICTION, COVENANT, OR BUILDING AGREEMENT PROHIBITING SOLAR COLLECTORS FROM BEING INSTALLED ON BUILDINGS OR ERECTED ON THE LOTS OR PARCELS WITHIN THE AREA OF PROPOSED PLAT, THE FOREGOING REQUIREMENT SHALL BE A CONDITION TO APPROVAL OF THIS PLAT.

Indexing Information

Projected Sections 16 and 21, Township 10 North, Range 2 East, N.M.P.M. Town of Atrisco Grant Subdivision: Avalon Subdivision, Unit 5 Owner: 98th and I-40 Land LLC. UPC #: 100905806702530101

Purpose of Plat

- SUBDIVIDE AS SHOWN HEREON GRANT EASEMENTS AS SHOWN HEREON.
- VACATE EASEMENTS AS SHOWN HEREON

Treasurer's Certificate

THIS IS TO CERTIFY THAT THE TAXES ARE CURRENT AND 100905806702530101

98 th + I-40 Land LLC

Man lole 1/20/21

DOC# 2021086661

07/22/2021 03:43 PM Page: 1 of 3 PLAT R:\$25.00 B: 2021C P: 0082 Linda Stover, Bernalillo County

Subdivision Data

GROSS ACREAGE	ES
ZONE ATLAS PAGE NO	-9
NUMBER OF EXISTING TRACTS	. ′
NUMBER OF TRACTS CREATED	. 2
MILES OF FULL-WIDTH STREETS	ES
MILES OF HALF-WIDTH STREETS D MILE	ΞS
RIGHT-OF-WAY DEDICATION TO THE CITY OF ALBUQUERQUE O ACRE	ES
DATE OF SURVEY NOVEMBER 20	20
DATE OF SORVEY.	

Legal Description

N.T.S.

TRACT NUMBERED TWO (2) OF AVALON SUBDIVISION UNIT 5, A SUBDIVISION OF A TRACT OF LAND LOCATED WITHIN PROJECTED SECTIONS 16 AND 21, TOWNSHIP 10 NORTH, RANGE 2 EAST, N.M.P.M. TOWN OF ATRISCO GRANT, AS THE SAME IS SHOWN AND DESIGNATED IN THE MAP OF SAID SUBDIVISION, FILED IN THE OFFICE OF THE COUNTY CLERK OF BERNALILLO COUNTY, NEW MEXICO, ON MAY 22, 2014, IN PLAT BOOK 2014C, PAGE 46.

Free Consent

THE SUBDIVISION SHOWN AND DESCRIBED HEREON IS WITH THE FREE CONSENT AND IN ACCORDANCE WITH THE DESIRES OF THE UNDERSIGNED OWNER(S) THEREOF. EXISTING AND/OR GRANTED PUBLIC UTILITY EASEMENTS (P.U.E) AS SHOWN HEREON, UNLESS NOTED OTHÉRWISE, ARE FOR THE COMMON AND JOINT USE OF GAS, ELECTRICAL POWER AND COMMUNICATION SERVICES FOR BURIED AND/OR OVERHEAD DISTRIBUTION LINES, CONDUIT AND PIPES FOR UNDERGROUND UTILITIES. SAID UTILITY COMPANIES HAVE THE RIGHT OF INGRESS/EGRESS FOR CONSTRUCTION OF, MAINTENANCE OF AND REPLACEMENT OF SAID UTILITIES INCLUDING THE RIGHT TO TRIM INTERFERING TREES AND SHRUBS WITHIN SAID P.U.E., SAID OWNERS CEPTIFY THAT THIS SUBDIVISION IS THEIR FREE ACT AND DEED.

BEN SPENCER, MANAGER 98TH & 1-40 LAND LLC


STATE OF NEW MEXICO)

COUNTY OF

THIS INSTRUMENT WAS ACKNOWLEDGED BEFORE ME ON BEN SPENCER, MANAGER, 98TH & 1-40 LAND LLC

JUNE 140 2021

Chenoa Crites

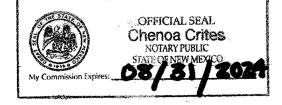

Plat for Tract 2-A and 2-B Avalon Subdivision Unit 5 Being Comprised of Tract 2

Avalon Subdivision Unit 5 City of Albuquerque Bernalillo County, New Mexico June 2021

PR-2020-004747 Project Number: SD-2021-00117 Application Number: Plat Approvals: Jun 9, 2021 Rodney Fuentes PNM Electric Services Jun 10, 2021 Abdul Bhuiyan Qwest Corp. d/b/a CenturyLink QC Jun 7, 2021 Jeff Estvanko New Mexico Gas Company Miko Mortus Jun 7, 2021

City Approvals:

Comcast

Loren N. Risenhoover P.S. 6/7/2021 City Surveyor Jeanne Wolfenbarger Jul 14, 2021 Traffic Engineer Blaine Carter Jul 14, 2021 Jul 14, 2021 Parks and Recreation Department Jul 22, 2021 Worktomic ode Enforcemen 6 14/2021 Ernest armija Jul 14, 2021 Jul 22, 2021

Surveyor's Certificate

DRB Chairperson, Planning Department

WILL PLOTNER JR., A REGISTERED PROFESSIONAL LAND SURVEYOR UNDER THE LAWS OF THE STATE OF NEW MEXICO, DO HEREBY CERTIFY THAT THIS PLAT AND DESCRIPTION WERE PREPARED BY ME OR UNDER MY SUPERVISION, SHOWS ALL EASEMENTS AS SHOWN ON THE PLAT OF RECORD OR MADE KNOWN TO ME BY THE OWNERS AND/OR PROPRIETORS OF THE SUBDIVISION SHOWN HEREON, THE UTILITY COMPANIES OR OTHER INTERESTED PARTIES AND MEETS THE MINIMUM REQUIREMENTS FOR MONUMENTATION AND SURVEYS FOR THE CITY OF ALBUQUERQUE AND FURTHER MEETS THE MINIMUM STANDARDS FOR LAND SURVEYING IN THE STATE OF NEW MEXICO AND IS TRUE AND CORRECT TO THE BEST OF MY KNOWLEDGE AND BELIEF.


Will Plotner Jr. N.M.R.P.S. No. 1427


6/10/2021

† CSI-CARTESIAN SURVEYS INC

P.O. BOX 44414 RIO RANCHO, N.M. 87174 Phone (505) 896 - 3050 Fax (505) 891 - 0244 wplotnerjr@gmail.com

Sheet 1 of 3

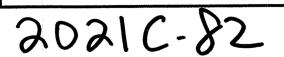

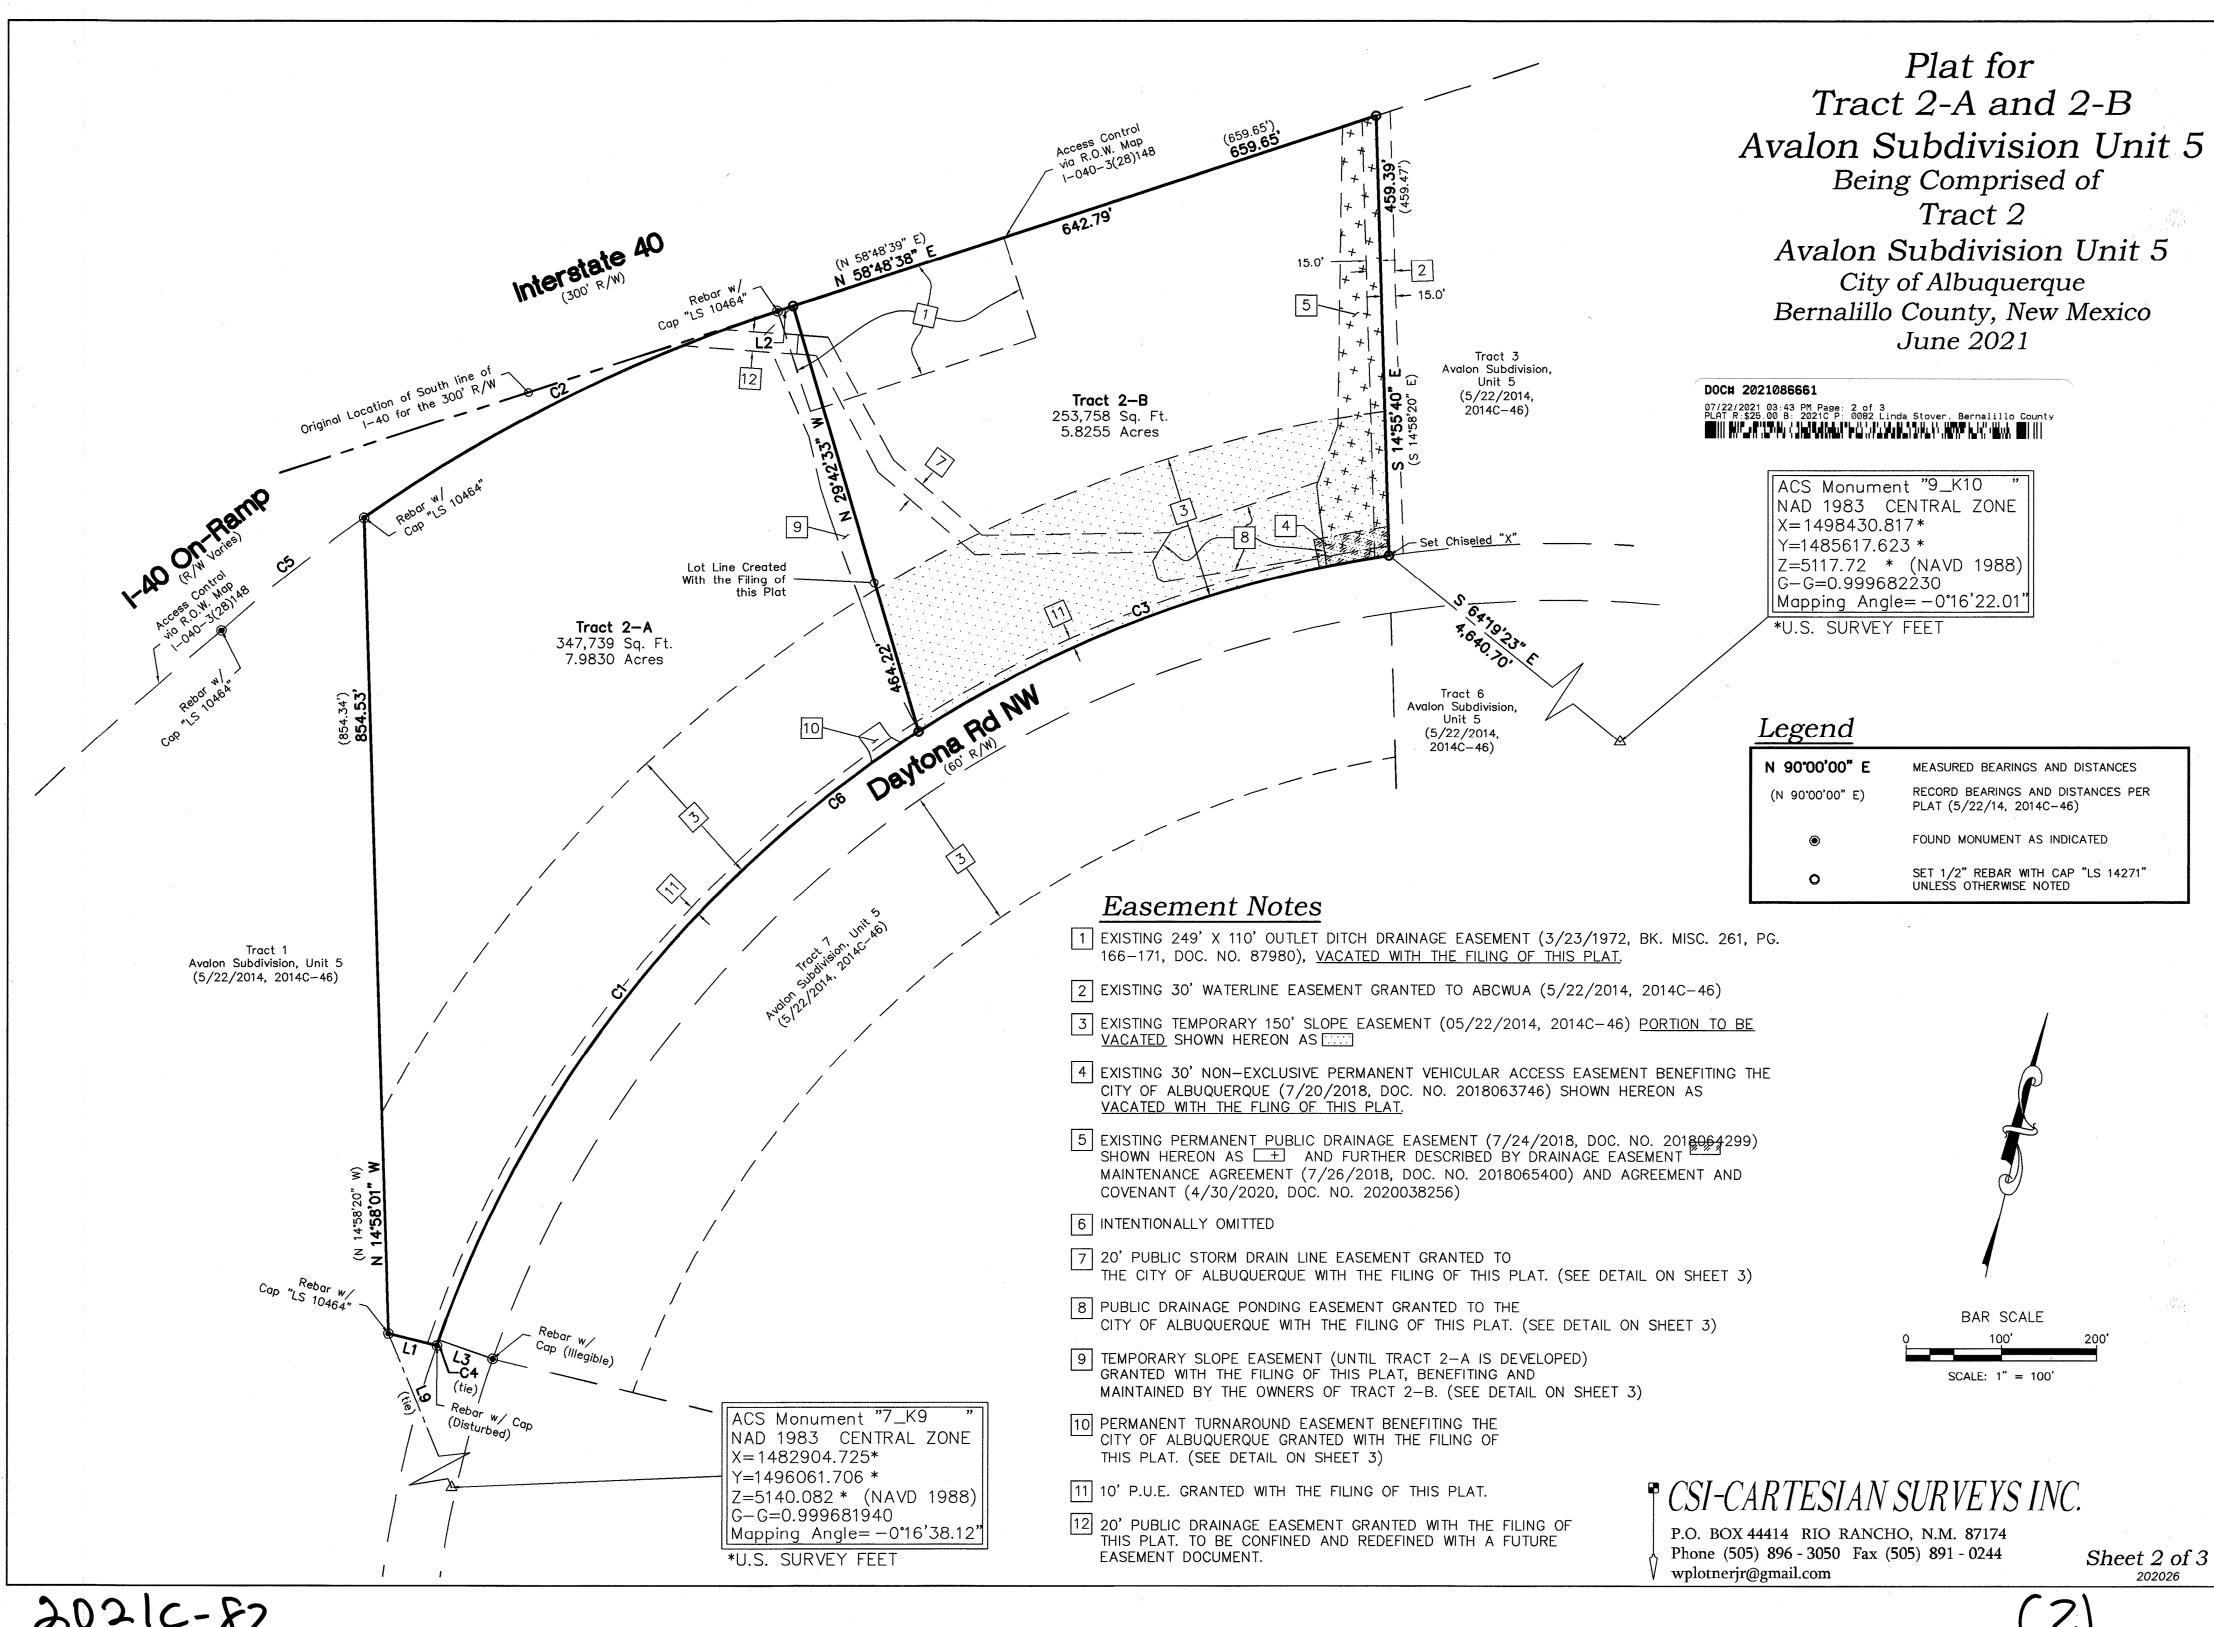

Public Utility Easements

PUBLIC UTILITY EASEMENTS shown on this plat are granted for the common and joint

- A. Public Service Company of New Mexico ("PNM"), a New Mexico corporation, (PNM Electric) for installation, maintenance, and service of overhead and underground electrical lines, transformers, and other equipment and related facilities reasonably necessary to provide electrical services.
- B. New Mexico Gas Company for installation, maintenance, and service of natural gas lines, valves and other equipment and facilities reasonably necessary to provide natural gas services.
- C. Qwest Corporation d/b/a CenturyLink QC for the installation, maintenance, and service of such lines, cable, and other related equipment and facilities reasonably necessary to provide communication services.
- D. Cable TV for the installation, maintenance, and service of such lines, cable, and other related equipment and facilities reasonably necessary to provide Cable services.

Included, is the right to build, rebuild, construct, reconstruct, locate, relocate, change, remove, replace, modify, renew, operate and maintain facilities for purposes described above, together with free access to, from, and over said easements, with the right and privilege of going upon, over and across adjoining lands of Grantor for the purposes set forth herein and with the right to utilize the right of way and easement to extend services to customers of Grantee, including sufficient working area space for electric transformers, with the right and privilege to trim and remove trees, shrubs or bushes which interfere with the purposes set forth herein. No building, sign, pool (aboveground or subsurface), hot tub, concrete or wood pool decking, or other structure shall be erected or constructed on said easements, nor shall any well be drilled or operated thereon. Property owners shall be solely responsible for correcting any violations of National Electrical Safety Code by construction of pools, decking, or any structures adjacent to or near easements shown on this plat.


Easements for electric transformer/switchgears, as installed, shall extend ten (10) feet in front of transformer/switchgear doors and five (5) feet on each side.

In approving this plat, Public Service Company of New Mexico (PNM) and New Mexico Gas Company (NMGC) did not conduct a Title Search of the properties shown hereon. Consequently, PNM and NMGC do not waive or release any easement or easement rights which may have been granted by prior plat, replat or other document and which are not shown on this plat.


Line Table			Line Table			
Line #	Direction	Length (ft)	Line #	Direction	Length (ft)	
L1	N 89°25'18" W (N 89°40'20" W)	52.22' (52.27')	L17	S 40°20'29" E	74.74'	
L2	N 58'48'38" E (N 58'48'39" E)	16.86'	L18	N 29*42'33" W	2.81'	
L3	S 83°58'27" E	60.00' (60.00')	L19	S 48'35'17" E	15.69'	
L5	N 81°05'04" E	7.51'	L20	S 41°59'27" W	27.13'	
L6	N 81°05'04" E	18.15'	L21	N 47*25'55" W	12.81'	
L7	N 29°42'33" W	42.44'	L22	S 67°36'55" W	132.07'	
L8	N 77*29'38" E	67.22'	L23	S 75*09'57" E	7.24'	
L9	S 35*38'02" E	4543.04'	L24	S 2913'00" E	19.14'	
L10	S 31°43'35" W	42.23'	L25	N 19'03'19" E	23.35'	
L11	S 36°40'03" E	117.20'	L26	N 19°03'19" E	13.60'	
L12	S 25'48'51" E	54.45'	L27	S 5814'07" W	161.92'	
L13	S 33'11'27" E	108.36'	L28	N 2011'43" W	72.46'	
L14	S 31°02'36" E	28.05'	L29	S 65°50'03" W	39.24	
L15	S 3212'31" E	31.44'	L30	N 06°26'05" E	4.40'	
L16	S 37'48'10" E	29.78'	*	L4 INTENTIONALLY OMITTED		

* L4 INTENTIONALLY OMITTED

Detail for Easements 789 10 AND 12

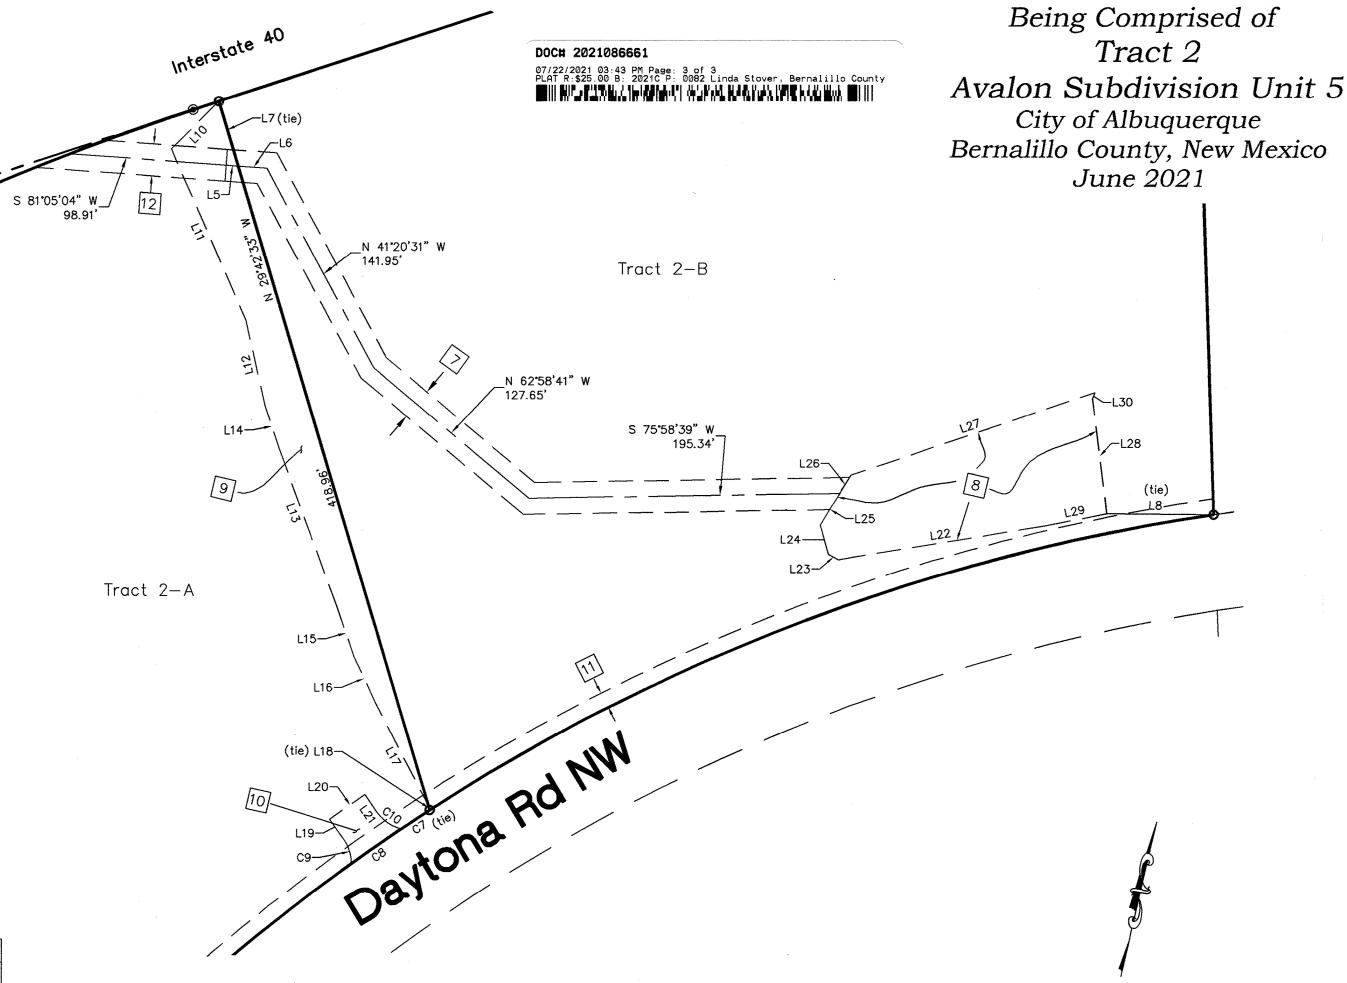

Curve Table					
Curve #	Length	Radius	Delta	Chord Length	Chord Direction
C1	831.89'	1243.34' (1243.34')	38*20'07"	816.46'	S 24°54'27" W
C2	485.53' (485.62')	1637.02' (1637.02')	16 ' 59'37"	483.76'	S 50°18'49" W
C3	530.67	1243.34' (1243.34')	24°27′15″	526.65'	S 5618'08" W
C4	6.21'	1243.34' (1243.34')	0*17'10"	6.21'	N 05*52'58" E
C5	191.00' (190.91')	1637.02' (1637.02')	6*41'05"	190.89'	S 38*26'07" W
C6	1362.56' (1362.55')	1243.34' (1243.34')	62*47'22"	1295.39'	S 37°08'04" W
C7	21.62	22168.29'	0*03'21"	21.62'	S 43*48'58" W
C8	38.04'	1815.01	1*12'03"	38.04	S 42'03'59" W
C9	15.98'	24.10	37*59'12"	15.69'	N 29*56'01" W
C10	19.32'	27.50'	40°15'22"	18.93'	S 67°32'12" E

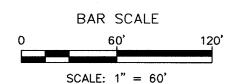

Plat for

Tract 2-A and 2-B

Avalon Subdivision Unit 5

† CSI-CARTESIAN SURVEYS INC.

P.O. BOX 44414 RIO RANCHO, N.M. 87174 Phone (505) 896 - 3050 Fax (505) 891 - 0244 wplotnerjr@gmail.com

Sheet 3 of 3 202026