
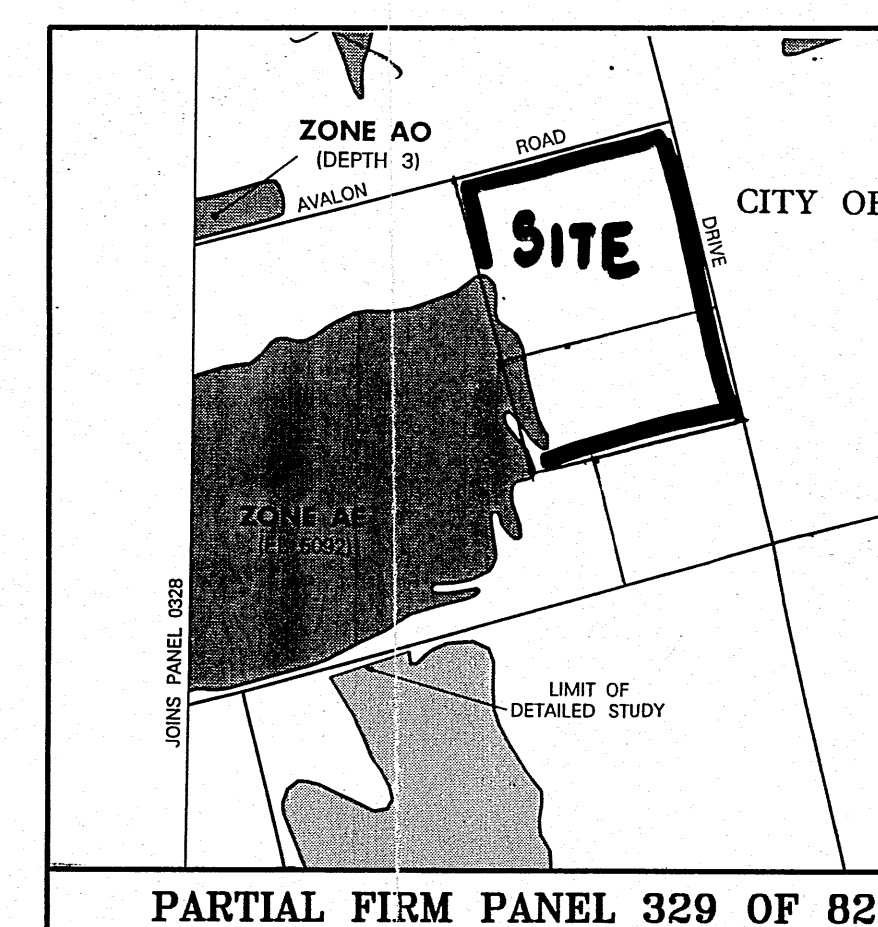
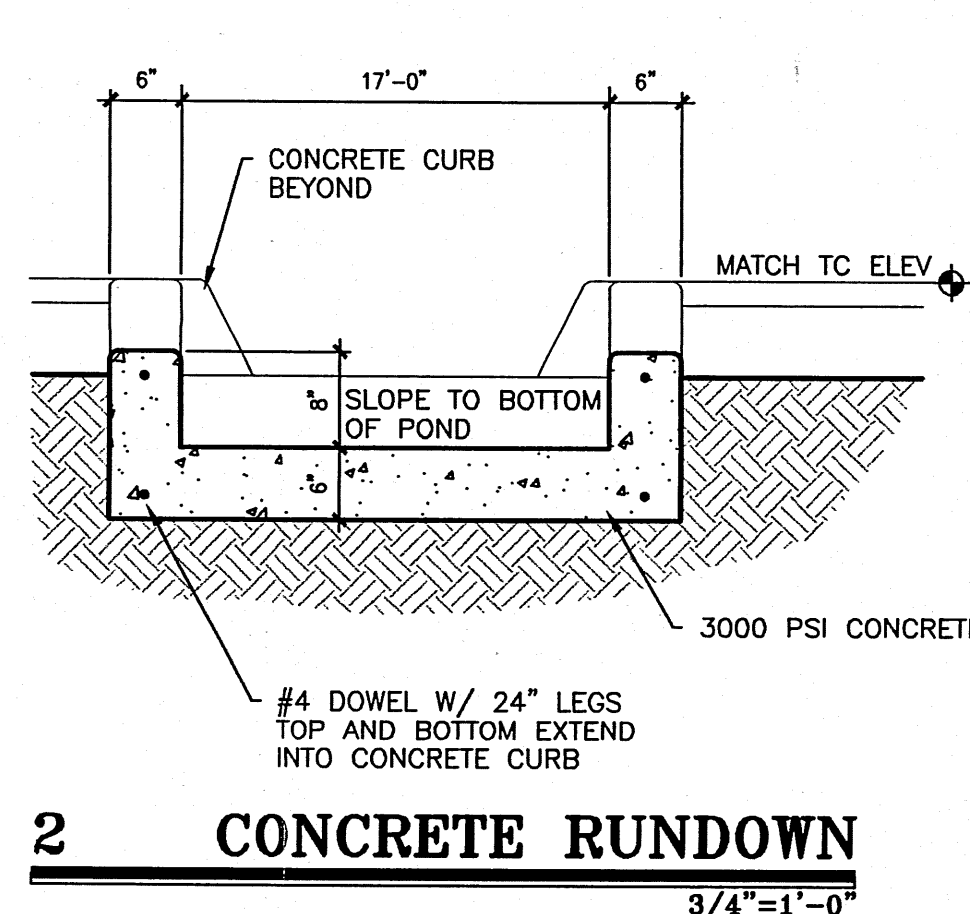


ADDRESS:
221 AIRPORT ROAD NW
LEGAL DESCRIPTION:
LOTS A-1-A-1 & B-1-A-1 WEST 66 ADDITION

LEGEND:

- 51.0 EXISTING SPOT ELEVATION
- 51.00 NEW SPOT ELEVATION
- 51- EXISTING CONTOUR
- 51- NEW CONTOUR
- SWALE
- 51.0 ✓ VERIFIED ELEVATION
- 51.0 AS BUILT ELEVATION
- BASIN BOUNDARY
- PROPERTY LINE
- FL FLOW LINE
- GND GROUND
- INV INVERT
- TA TOP OF ASPHALT
- TC TOP OF CURB
- TG TOP OF GRATE
- TS TOP OF CONCRETE SLAB
- TW TOP OF WALL
- TBM TEMPORARY BENCH MARK

BENCH MARK:
ACS CONTROL STATION 5-K-10 LOCATED AT
THE INTERSECTION OF COORS ROAD & CENTRAL AVENUE
ELEVATION = 5093.733 FT.

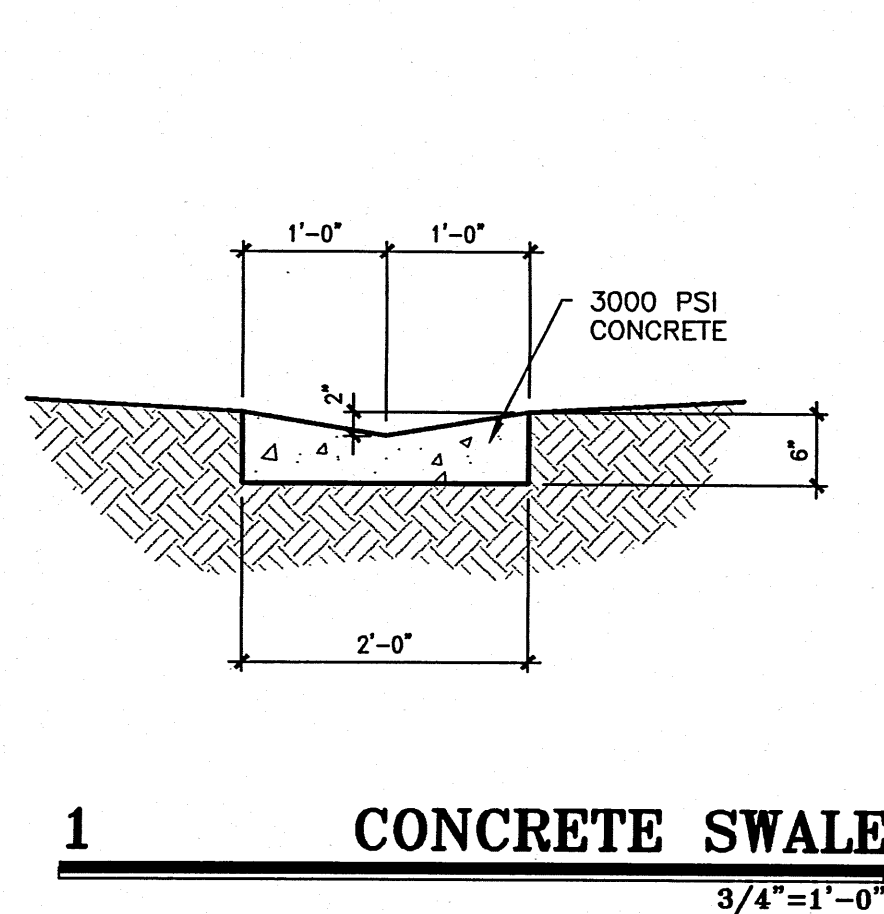

FIRM FLOOD HAZARD ZONE

THE EAST EDGE OF THE SITE FALL WITHIN THE FIRM FLOOD HAZARD ZONE AE (FIRM PANEL 329 OF 825). THE BUILDING ADDITION DOES NOT FALL WITHIN THE FLOOD HAZARD ZONE.

CONSTRUCTION NOTES

1. TWO WORKING DAY PRIOR TO ANY EXCAVATION, THE CONTRACTOR SHALL CALL FOR LOCATION OF EXISTING UTILITIES.
2. ALL WORK WITHIN THE CITY RIGHT OF WAY SHALL BE PERFORMED IN ACCORDANCE WITH THE APPLICABLE CITY OF ALBUQUERQUE STANDARD AND PROCEDURE.
3. ALL WORK SHALL BE PERFORMED IN ACCORDANCE WITH THE APPLICABLE FEDERAL, STATE, AND LOCAL REGULATIONS, LAWS, AND RULES CONCERNING SAFETY AND HEALTH.
4. PRIOR TO CONSTRUCTION THE CONTRACTOR SHALL VERIFY THE EXISTING SITE CONDITIONS AND INFORM THE ARCHITECT / ENGINEER OF ANY DISCREPANCY BETWEEN THE INFORMATION SHOWN THE PLANS AND THOSE OF THE EXISTING SITE.
5. THE OWNER SHALL VERIFY LOCATIONS OF PONDS WITH GEOTECHNICAL ENGINEER PRIOR TO PROCEEDING WITH ANY CONSTRUCTION WORK ON THIS PROJECT, AND INFORM THE ARCHITECT / ENGINEER OF ANY ADDITIONAL REQUIREMENTS.

THE PROPOSED IMPROVEMENTS CONSIST OF A WAREHOUSE / OFFICE ADDITION WITH ASSOCIATED PARKING AND LANDSCAPING. THE EXISTING POND WAS SIZED TO ACCEPT THE RUNOFF FROM THE DEVELOPED LOT A-1-A-1 AND THE UNDEVELOPED CONDITIONS FOR LOTS B-1-A-1 AND B-1-B-1. THE RUNOFF FROM LOT B-1-B-1 NOW DRAINS TO A POND ON THAT SITE. THE PROPOSED RUNOFF FROM THE SUBJECT SITE WILL DRAIN TO THE EXISTING POND. THE POND SIZE WILL BE MODIFIED TO ACCOUNT FOR THE CHANGE IN REQUIRED PONDING VOLUME. THE EXISTING CONTROLLED DISCHARGE WAS SIZED FOR LOT A-1-A-1 ONLY. THE EXISTING CONTROLLED DISCHARGE WILL BE INCREASED TO ACCOUNT FOR THE AREA OF LOT A-1-B-1.

THE EXISTING DISCHARGE IS 0.67 CFS. THE ALLOWABLE DISCHARGE RATE FOR THE COMBINED SITE IF 0.1 CFS/ACRE x 10.576 ACRES = 1.06 CFS. THE PROPOSED RUNOFF RATE IN 1.02 CFS.

THE CALCULATIONS BELOW ANALYZE THE EXISTING AND PROPOSED CONDITIONS FOR THE 6-HOUR, 100 YEAR RAINFALL EVENT. THE ANALYSIS IS IN ACCORDANCE WITH THE CITY OF ALBUQUERQUE DEVELOPMENT PROCESS MANUAL VOLUME II, AS SHOWN BY THESE CALCULATIONS. THE RATE AND VOLUME OF RUNOFF WILL INCREASE, BUT THE POND(S) WITH CONTROLLED OUTLETS WILL MITIGATE THE INCREASES. THIS PLAN IS IN CONFORMANCE WITH THE MASTER DRAINAGE PLAN.

CALCULATIONS

PRECIPITATION ZONE = 1

TOTAL SITE AREA = 10.576 ACRES

EXISTING CONDITIONS

LAND TREATMENT A=68% B=2% C=0% D=31%

$E = 0.44(0.68) + 0.67(0.02) + 1.97(0.31) = 0.91$ INCHES

$V = 0.91(10.576) / 12 = 0.803$ ACRE FEET

$Q = [1.29(0.68) + 2.03(0.02) + 4.37(0.31)] 10.576 = 23.73$ CFS

DEVELOPED CONDITIONS

LAND TREATMENT A=45% B=4% C=0% D=52%

$E = 0.44(0.45) + 0.67(0.03) + 1.97(0.52) = 1.24$ INCHES

$V = 1.24(10.576) / 12 = 1.091$ ACRE FEET

$Q = [1.29(0.45) + 2.03(0.03) + 4.37(0.52)] 10.576 = 30.73$ CFS

INCREASE IN VOLUME OF RUNOFF = 1.091 - 0.803 = 0.287 ACRE FT

INCREASE IN RATE OF RUNOFF = 30.73 - 23.73 = 7.00 CFS

POND VOLUME

$T = 0.2$ HR

$0.25 Ad/At = 0.25(0.52)/60 = 0.217$ HR

$T_p = 2.107 E At/Qp - 0.25 Ad/At = 0.768$ HR

$T_p = (0.7 T_c) + ((1.6 - Ad/At)/12) = 0.230$ HR

$V_{required} = 46,850$ CF

VOLUME @ ELEV 5090.5

$V = [0.5(39460 + 24540) * 1.5] = 48,000$ CF

0 20' 40' 80'

1" = 40'-0"

NORTH

GRADING AND DRAINAGE PLAN

SEPTEMBER 25, 2000 SCALE: 1" = 40'-0"

ORIFICES CALCULATIONS

WATER SURFACE ELEVATION 90.5

BOTTOM OF DI FLOOR 89.2

EXISTING 1/4" HOLE IN Y 89.5 (BOTTOM)

EXISTING DISCHARGE RATE 0.67 CFS

PROPOSED DISCHARGE RATE 1.02 CFS

$Q = K A \sqrt{2gh}$

$K = (90.5 - 89.5) / 0.25 = 0.875$ FT

$\Delta Q = 1.02 - 0.67 = 0.35$ CFS

$0.35 = K A \sqrt{2gh}$ $\Delta A = 0.078$ ft²

$\Delta A = 2[A - A_{EXIST}]$ $A_{EXIST} = 1.23$ in² / HOLE

$A_1 = \frac{1}{2} \Delta A + A_{EXIST} = \frac{1}{2}(0.078) + 1.23 = 0.84$ in²

DIA₁ = 2.95 in USE (2) 3" HOLES

Revised 12/17/00

CLAUDIO VIGIL ARCHITECTS

ZANIOS FOODS

WAREHOUSE ADDITION PHASE III

221 AIRPORT ROAD, N.W.
ALBUQUERQUE, NEW MEXICO

SHEET

C-1

PROJECT NUMBER 00000

1305 Tijeras NW Albuquerque, NM 87102-2882
Phone: 505/842-1113 Fax: 505/842-1330

JOHN ARTHUR BLESSON
NEW MEXICO
REGISTERED PROFESSIONAL ENGINEER
13481
9-26-00

Rev 12/17/00