



I, Jean J. Bordenave, hereby certify the as-built elevations and dimensions shown hereon were obtained December 3, 1992 and that the grading and drainage of the pond is in substantial compliance with the City approved grading and drainage plan K10/D21A.

Jean J. Bordenave 12/04/92

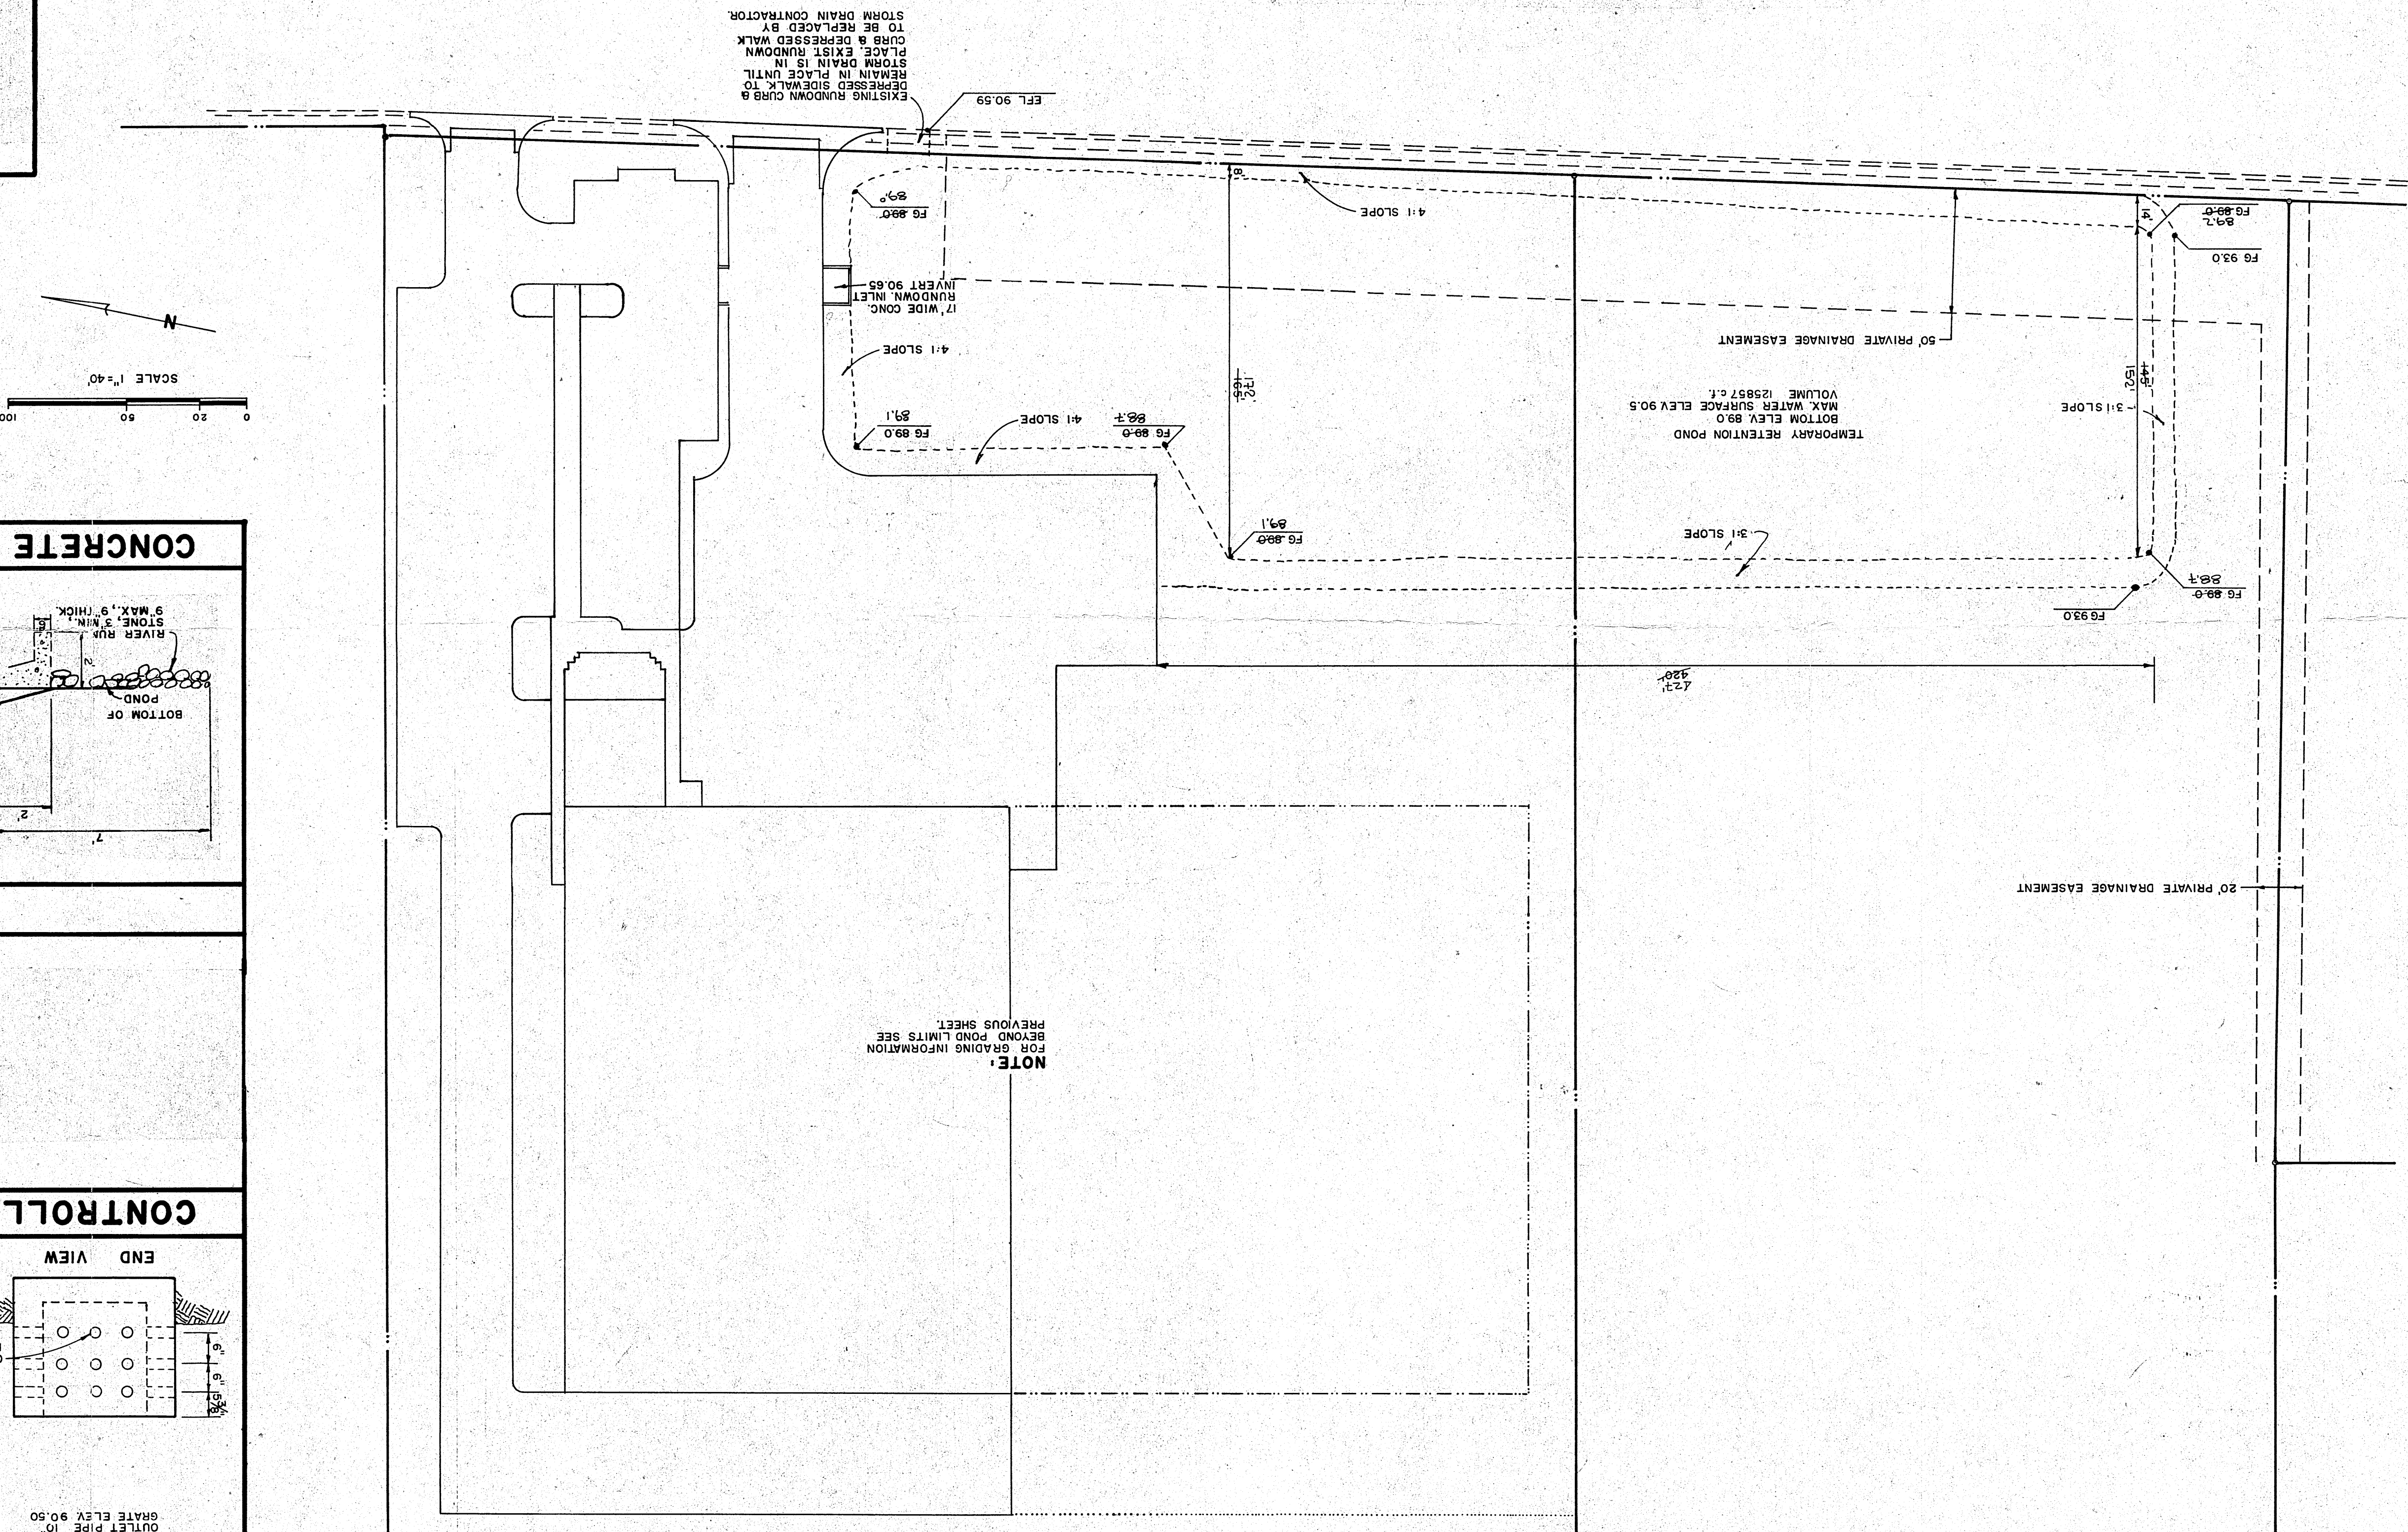


OCT 26


- DRAINAGE NOTES - PHASE I**
- The drainage facilities shown on these plans are based on phased construction of the West 66 addition. All flows from the subdivision are to be routed to the pond shown in the initial building phase. See the "Conceptual Grading and Drainage Plan, Central Airport Business Park" for phasing/drainage requirements.
 - Phase I ponding is shown on this sheet, Phase II ponding is shown on the previous sheet. Phase I ponding is a retention condition and assumes that the Airport Drive Storm Drain is available as an outfall.
 - Phase I ponding shall be constructed as part of the initial earthwork (except item c. below) and shall include:
 - a pond at the dimension and elevation shown on this plan,
 - allowing existing runoff curb and depressed sidewalk to remain in place providing a flow path for stormwater to exit the street and enter the retention pond and
 - constructing the concrete runoff from the parking area to the pond after final earthwork but prior to installing asphalt paving.

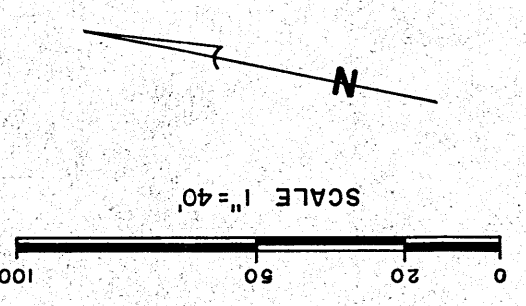

CONCRETE RUNDOWN

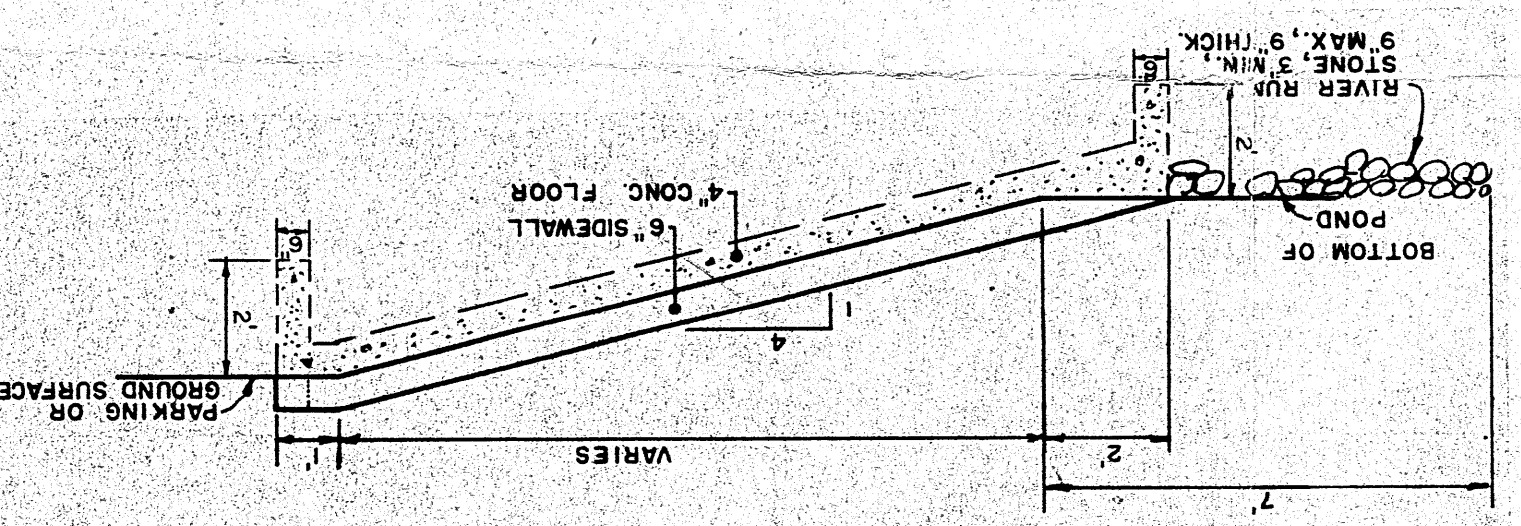

CONTROLLED OUTLET

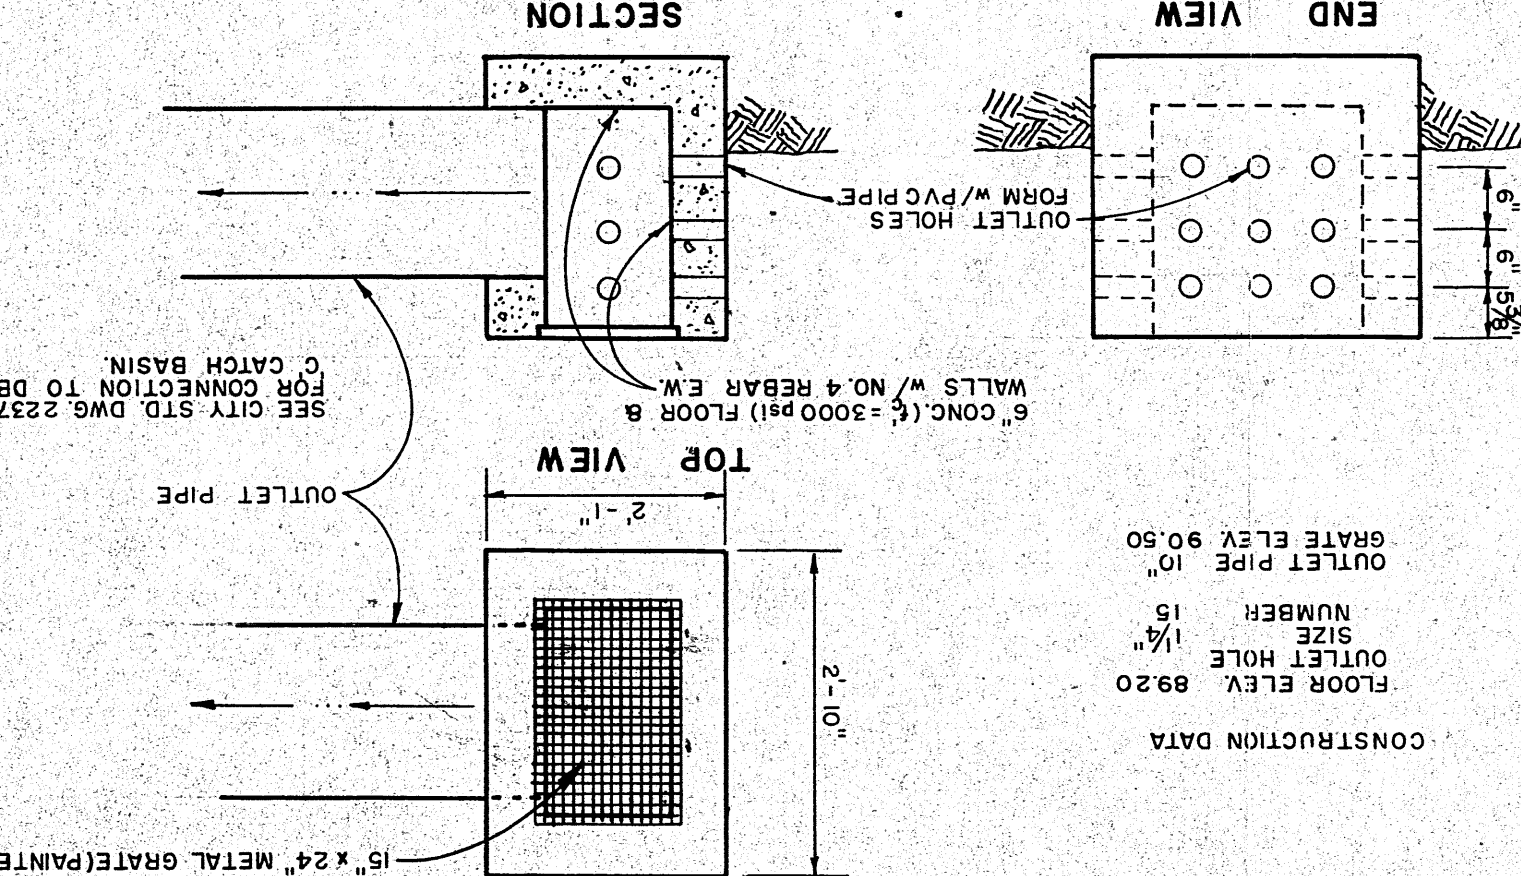

GRADING AND DRAINAGE PLAN - RETENTION POND
ZANIOS FOODS

REVISIONS

NO.	DATE	REMARKS	BY
1	1/91	ADDED SHEET	JJB
2	02/92	REDUCE OFFICE & WAREHOUSE	JJB
3	09/04/92	COMBINE POND	JJB

JOB 9214 **FILE** 9026

DESIGNED JJB **DATE** 11/91
DRAWN NET **DATE** 11/91
REVIEWED JJB **DATE** 11/91

BORDENAVE DESIGNS
P.O. BOX 91194
ALBUQUERQUE, NM 87199-1194
(505) 823-1344