

LEGEND:

EXISTING SPOT ELEVATION = 5095.2
 EXISTING CONTOUR = 5094.0
 PROPOSED SPOT ELEVATION = 5094.20
 PROPOSED CONTOUR = 5094.0

LEGAL DESCRIPTION:

TRACT "B-1-B-1", WEST 66 ADDITION, TO THE CITY OF ALBUQUERQUE, BERNALILLO COUNTY, NEW MEXICO, (CITY ZONE ATLAS "K-10-Z").

BENCH MARK REFERENCE:

ACS STATION "6K-10", M.S.L.D. ELEVATION = 5094.343; PROJECT BENCH MARK AS SHOWN ON THE PLAN HEREON.





CONSTRUCTION NOTES:

- TWO (2) WORKING DAYS PRIOR TO ANY EXCAVATION, CONTRACTOR MUST CONTACT LINE LOCATING SERVICE AT 260-1950 FOR LOCATION OF EXISTING UTILITIES.
- PRIOR TO CONSTRUCTION, THE CONTRACTOR SHALL EXCAVATE AND VERIFY THE HORIZONTAL AND VERTICAL LOCATION OF ALL POTENTIAL OBSTRUCTIONS: SHOULD A CONFLICT EXIST, THE CONTRACTOR SHALL NOTIFY THE ENGINEER SO THAT THE CONFLICT CAN BE RESOLVED WITH A MINIMUM OF DELAY.
- ALL WORK ON THIS PROJECT SHALL BE PERFORMED IN ACCORDANCE WITH APPLICABLE FEDERAL, STATE, AND LOCAL LAWS, RULES AND REGULATIONS CONCERNING CONSTRUCTION SAFETY AND HEALTH.
- ALL CONSTRUCTION WITHIN CITY RIGHT-OF-WAY SHALL BE PERFORMED IN ACCORDANCE WITH APPLICABLE CITY OF ALBUQUERQUE STANDARDS AND PROCEDURES.

EROSION CONTROL MEASURES:

THE CONTRACTOR SHALL BE HELD RESPONSIBLE FOR MANAGEMENT FOR STORM RUN-OFF DURING CONSTRUCTION; HE SHALL INSURE THAT THE FOLLOWING MEASURES ARE TAKEN:

- ADJACENT PROPERTY SHALL BE PROTECTED AT ALL TIMES BY CONSTRUCTION OF BERMS, DIKES, SWALES, PONDS, AND OTHER TEMPORARY GRADING AS REQUIRED TO PREVENT STORM RUNOFF FROM LEAVING THE SITE AND ENTERING ADJACENT PROPERTIES.
- ADJACENT PUBLIC RIGHT-OF-WAYS SHALL BE PROTECTED AT ALL TIMES FROM STORM WATER RUNOFF FROM THE SITE. NO SEDIMENT BEARING WATER SHALL BE PERMITTED TO ENTER PUBLIC STREETS.
- THE CONTRACTOR SHALL IMMEDIATELY AND THOROUGHLY REMOVE ANY AND ALL SEDIMENT WITHIN PUBLIC STREETS THAT HAS BEEN ERODED FROM THE SITE AND DEPOSITED THERE.

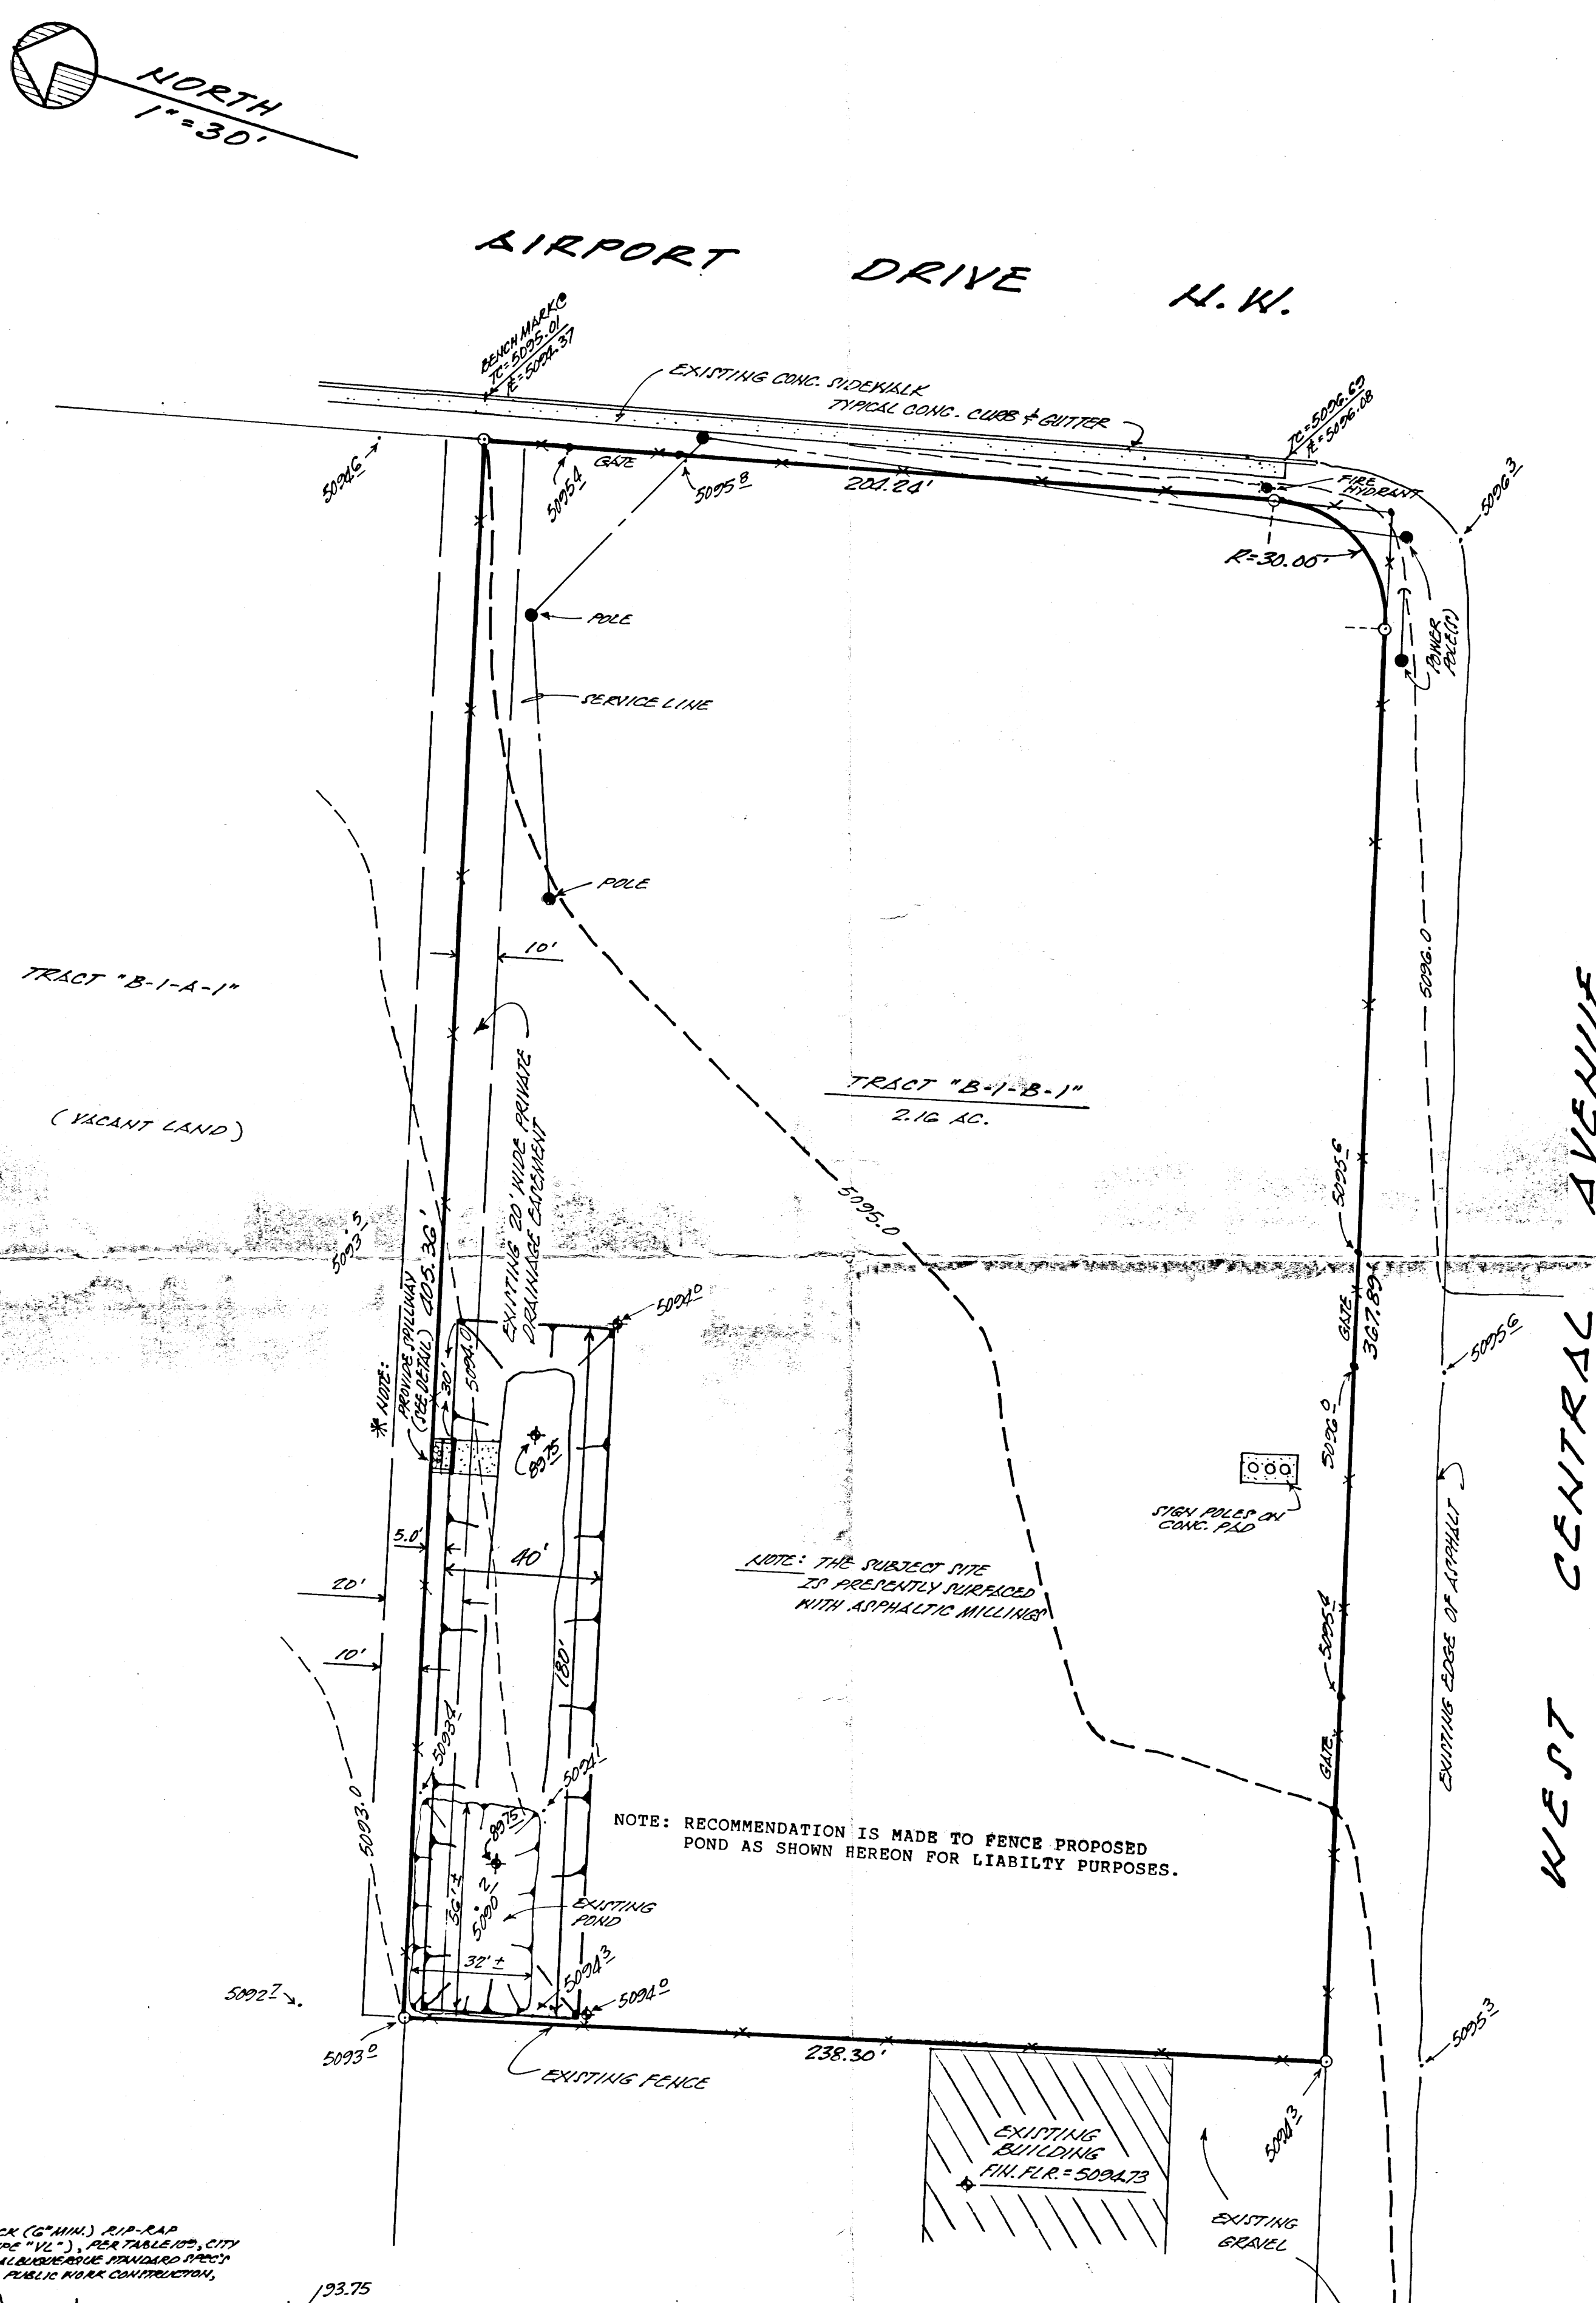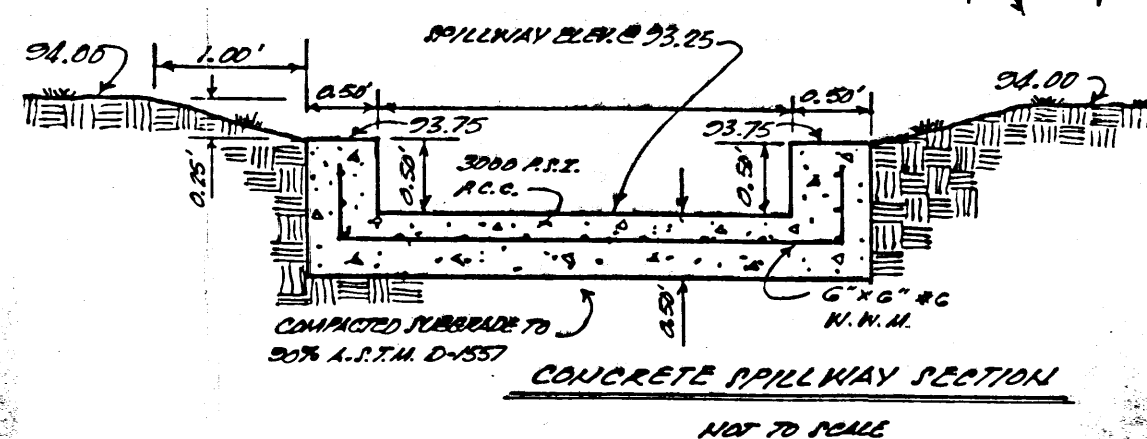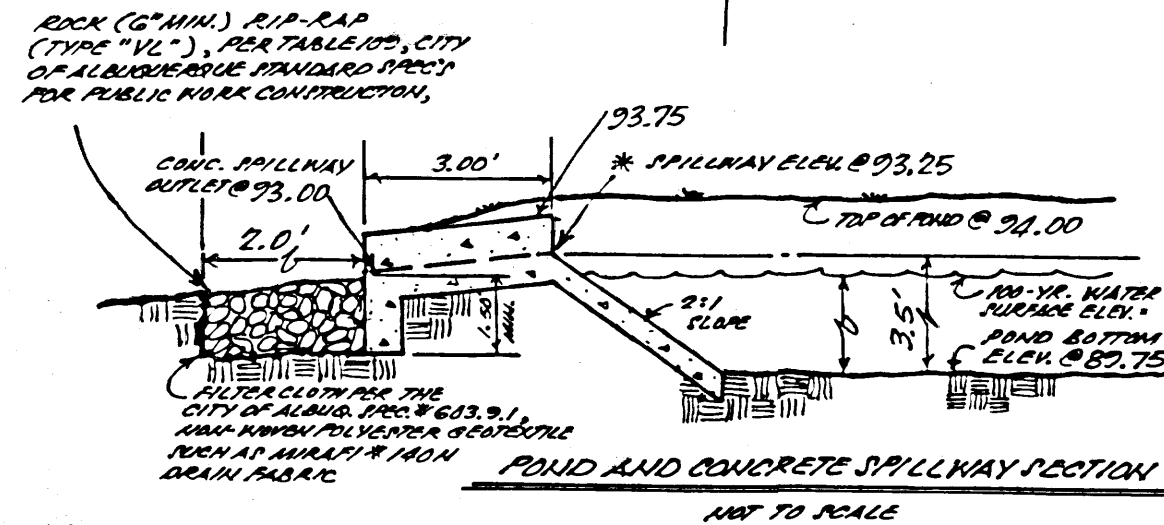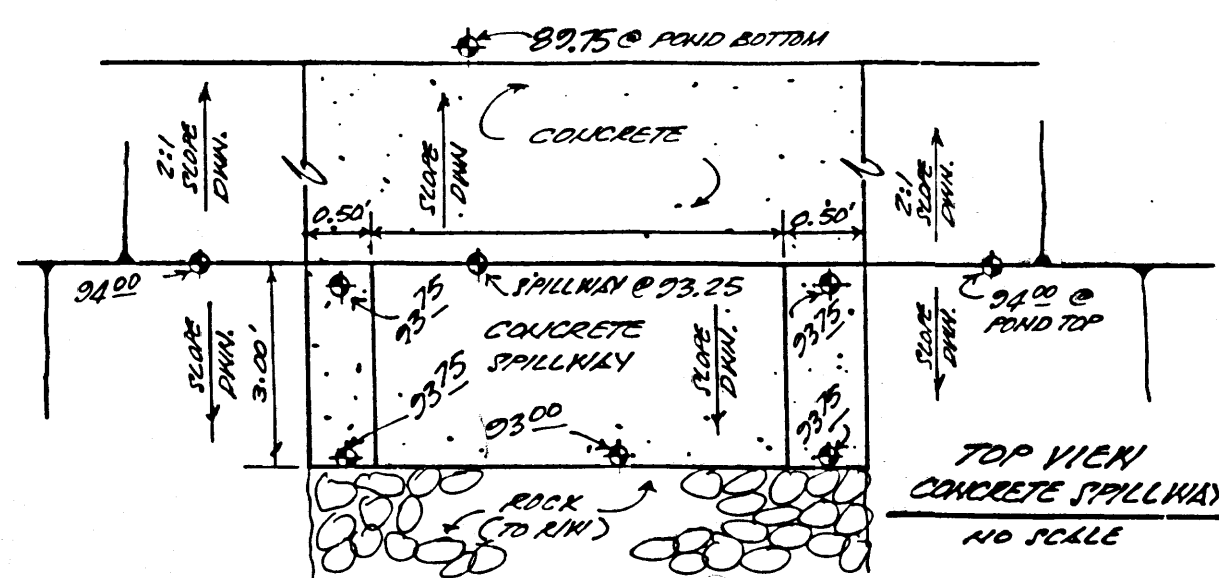


A1 PRECIPITATION ZONES

Bernalillo County's four precipitation zones are indicated in TABLE A-1 and on FIGURE A-1.

TABLE A-1. PRECIPITATION ZONES	
Zone	Location
1	West of the Rio Grande
2	Between the Rio Grande and San Mateo
3	Between San Mateo and Eubank. North of Interstate 40, and between San Mateo and the East boundary of Range 4 East, South of Interstate 40
4	East of Eubank. North of Interstate 40, and East of the East boundary of Range 4 East, South of Interstate 40

FIGURE A-1

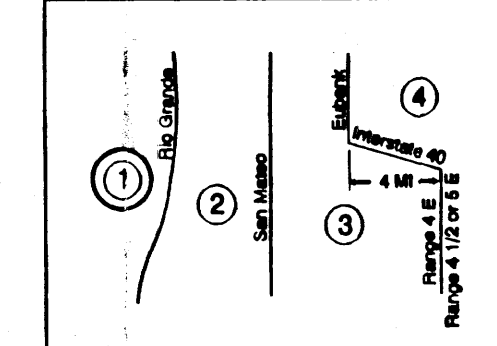

DPM SECTION 22.2 - HYDROLOGY
 January, 1993 Page A-4

TABLE A-4. LAND TREATMENTS	
Treatment	Land Condition
A	Soil unimpacted by human activity with 0 to 10 percent slopes. Native grasses, weeds and shrubs in typical densities with minimal disturbance to grading, groundwater and infiltration capacity.
B	Irrigated lawns, parks and golf courses with 0 to 10 percent slopes. Native grasses, weeds and shrubs, and soil unimpacted by human activity with slopes greater than 10 percent and less than 20 percent.
C	Soil compacted by human activity. Minimal vegetation. Unimproved parking, roads, trails. Most recent law, gravel or rock on plastic (desert landscaping). Irrigated lawns and parks with slopes greater than 10 percent. Native grasses, weeds and shrubs, and soil unimpacted by human activity with slopes of 20 percent or greater. Native grass, weed and shrub areas with clay or clay loam soils and other soils of very low permeability as classified by SCS Hydrologic Soil Group D.
D	Impervious areas, pavement and roofs.

Most watersheds contain a mix of land treatments. To determine proportional treatments, measure respective surfaces. In lieu of specific measurement for treatment D, the areal percentages in TABLE A-4 may be employed.

DRAINAGE COMMENTS AND CALCULATIONS:

AS SHOWN ON THE VICINITY MAP HEREON, THE SUBJECT SITE IS LOCATED AT THE NORTHWEST INTERSECTION OF WEST CENTRAL AVENUE AND AIRPORT DRIVE N.W., IN THE CITY OF ALBUQUERQUE, BERNALILLO COUNTY, NEW MEXICO, (CITY ZONE MAP "K-10-Z").

THE SUBJECT, 1.) IS NOT LOCATED WITHIN A DESIGNATED FLOODPLAIN (RE: F.P.M.A. FLOODWAY MAP 27 OF 50), 2.) IS PRESENTLY AN UNDEVELOPED LOT SURFACED WITH ASPHALT MILLINGS AND BEING USED AS A MOBILE HOME SALES LOT, 3.) DOES NOT LIE ADJACENT TO A NATURAL OR ARTIFICIAL WATER COURSE, 4.) PRESENTLY CONTRIBUTES TO THE OFFSITE FLOWS OF THE PROPERTY LYING NORTH OF AND ADJACENT TO THE SUBJECT SITE, 5.) HAS AN UNDERSIZED POND ON SITE THAT WILL BE ENLARGED TO ACCOMMODATE THE REQUIRED VOLUME AND WILL PROVIDE A SPILLWAY AS SHOWN ON THE PLAN HEREON.

CALCULATIONS:

PER SECTION 22.2, HYDROLOGY OF THE DEVELOPMENT PROCESS MANUAL, VOLUME 2, DESIGN CRITERIA FOR THE CITY OF ALBUQUERQUE, NEW MEXICO, DATED: JANUARY, 1993.

SITE AREA: 2.16 ACRES

PRECIPITATION ZONE: ONE (1)

PEAK INTENSITY: "I" = 4.70

LAND TREATMENT METHOD FOR CALCULATION OF "Q"

NOTE: THE SUBJECT SITE CALCULATIONS AS SHOWN HEREON ARE CONSIDERED AS A DEVELOPED LOT PER C.O.A. REQUIREMENTS.

CONDITIONS:

TREATMENT	AREA/ACRES	FACTOR	CFS
C	0.32	X 2.87	= 0.92
D	1.84	X 4.37	= 8.04

"Q" = 8.96 CFS

POND VOLUME CALCULATIONS: V_{360} (100-YR. 6 HR.)

TREATMENT	AREA/ACRES	FACTOR	
C	0.32	X 0.99	= 0.31
D	1.84	X 1.97	= 3.62

"E" = $\frac{0.31 + 3.62}{2.16} = 1.82$ INCHES

$V_{360} = \frac{1.82}{12} \times 2.16 = 0.33$ AC. FT.

FOR TEN (10) DAY STORMS:

$V_{10 \text{ DAYS}} = V_{360} + A_D \times (P_{10} - P_{360}) / 12$ IN. FT.

$V_{10 \text{ DAYS}} = 0.33 + 1.84 \times (3.67 - 2.20) / 12 = 0.56$ AC. FT.

0.56 AC. FT. X 43,560.0 = 24,393.6 CU. FT. REQUIRED

REQUIRED POND SIZE: 40.0' X 180.0' X 3.5' = 25,200.0 CU. FT. REQUIRED

** FREEBOARD = 806.4 CU. FT.

POND SPILLWAY - WEIR SIZE CALCULATION:

Q = 8.96 CFS BREADTH = 3.0' "C" = 2.63 "H" = 0.50'



NOTE: VALUE OF "C" = 2.63 INTERPOLATED FROM TABLE 5.3, BOOK OF HYDRAULICS, SECTION 5. BRATER & KING, 6th EDITION, 1976.


$$L = \frac{Q}{(2.63)(H^{1.5})} = \frac{8.96}{(2.63)(0.50^{1.5})} = 9.63' \text{ (USE 9.50')}$$

GENERAL NOTES:

- NO PROPERTY CORNERS HAVE BEEN SET PER THIS SURVEY OF THE SUBJECT PROPERTY.
- NO SEARCH HAS BEEN MADE FOR EASEMENTS OF RECORD WITHIN THE SUBJECT PROPERTY OTHER THAN THOSE SHOWN ON THE PLAN HEREON.
- TOPOGRAPHY SURVEY OBTAINED BY THE "TRANSIT-STADIA" METHOD.

A DRAINAGE PLAN FOR
 TRACT "B-1-B-1"
 WEST 66 ADDITION
 ALBUQUERQUE, NEW MEXICO
 FEBRUARY, 1995

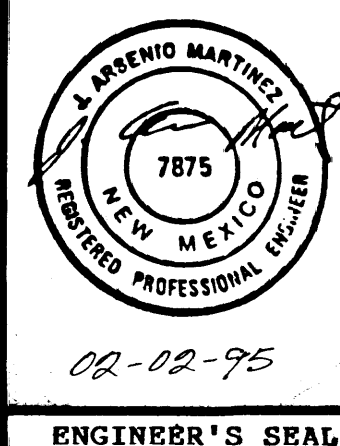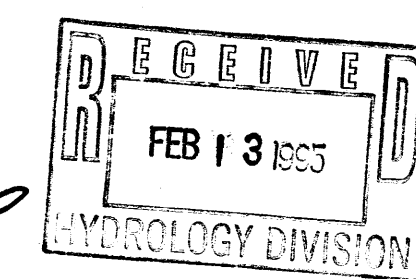

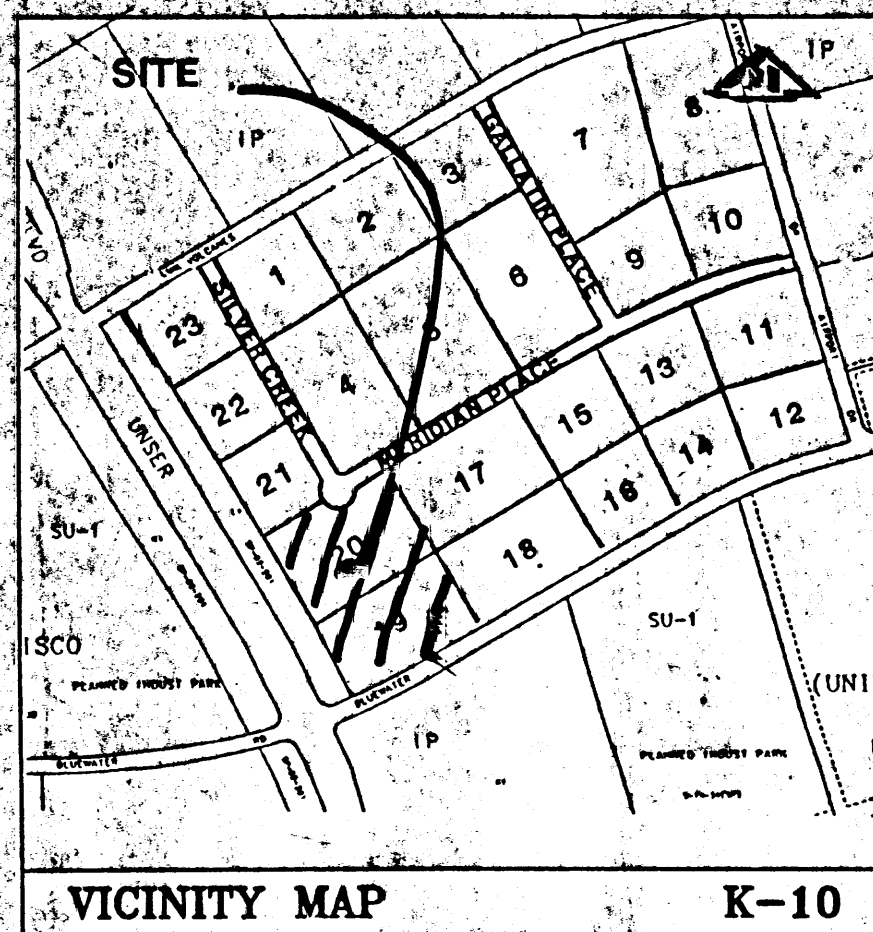

VICINITY MAP
SCALE 1" = 700'

ADDRESS

7601 BLUEWATER ROAD NW

LEGAL DESCRIPTION

LOT 19-A, MERIDIAN BUSINESS PARK


BENCHMARK

ACS MONUMENT 10-K10 LOCATED AT THE SOUTHEAST CORNER OF UNSER BLVD AND LOS VOLCANES ROAD. ELEVATION = 5142.79.

LEGEND

- 35.8 EXISTING SPOT ELEVATION
- 36.20 NEW SPOT ELEVATION
- 36 — EXISTING CONTOUR
- 35 — NEW CONTOUR
- SWALE
- ✓ VERIFIED ELEVATION
- 36.2 — AS-BUILT ELEVATION
- BASIN BOUNDARY

UNSER BOULEVARD NW

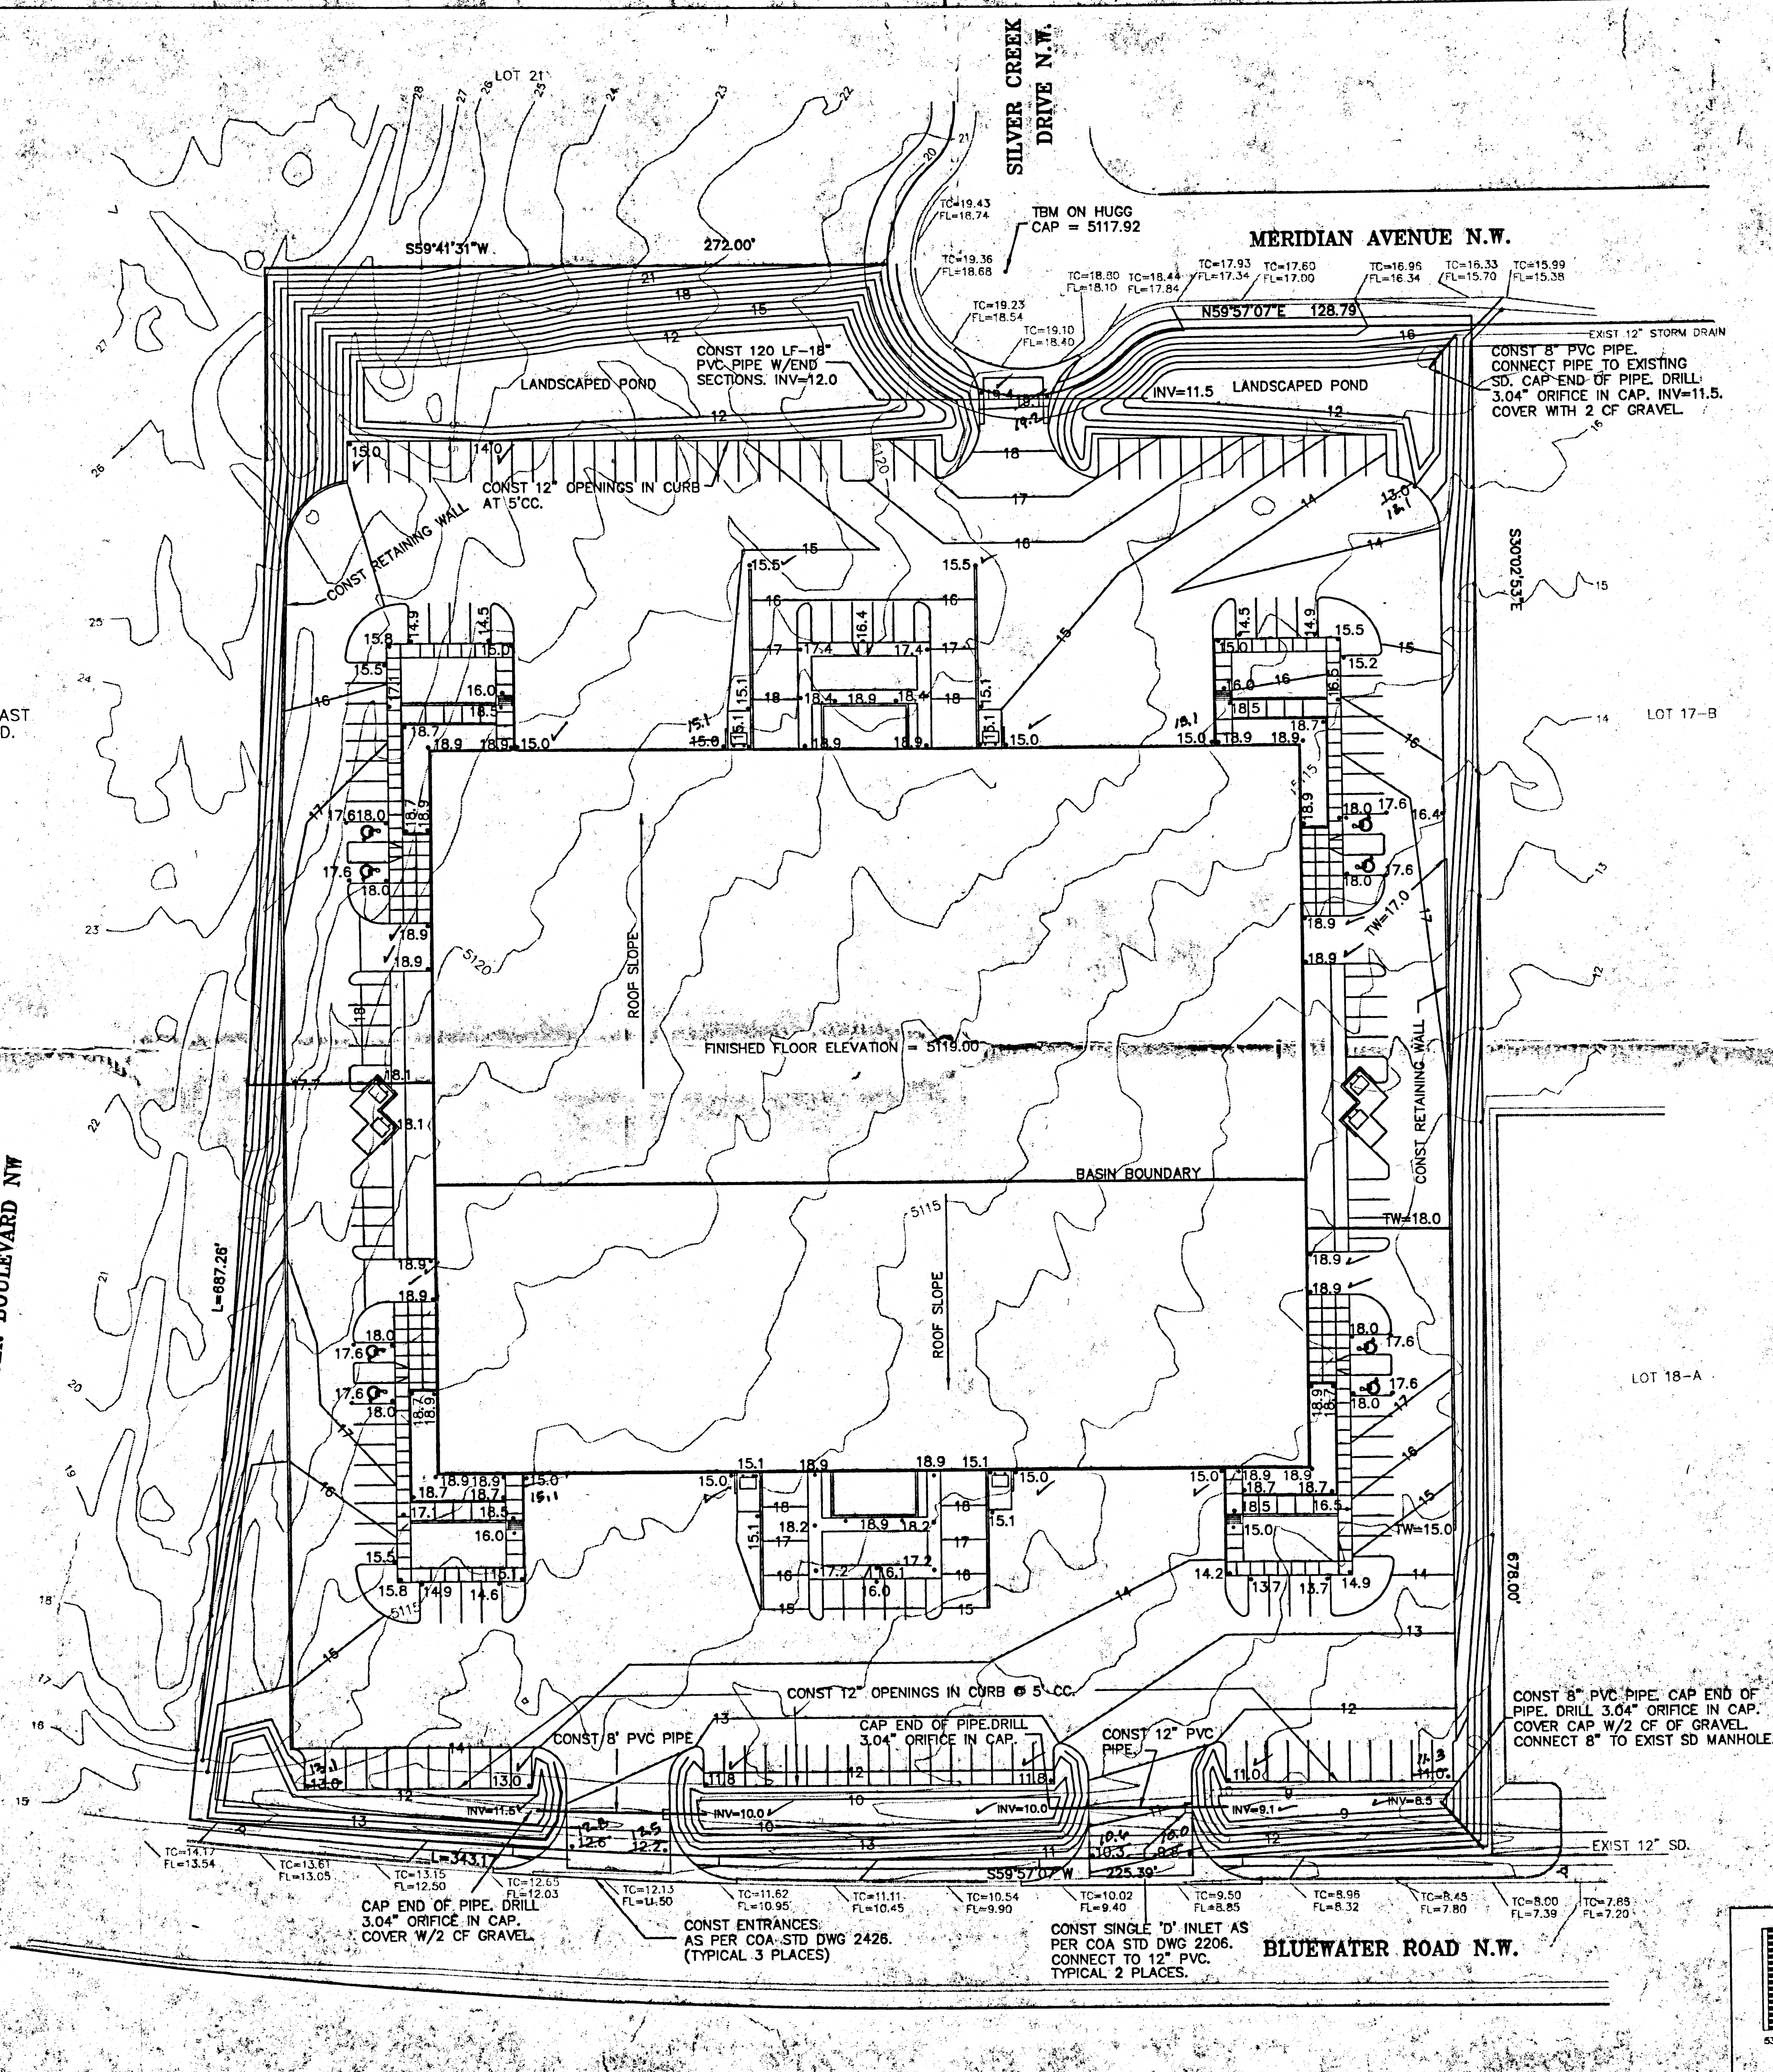

DRAINAGE PLAN

THE FOLLOWING ITEMS CONCERNING THE LOT 19-A, MERIDIAN BUSINESS PARK, GRADING AND DRAINAGE PLAN ARE CONTAINED HEREON:

1. VICINITY MAP
2. GRADING PLAN
3. CALCULATIONS

THE PROPOSED IMPROVEMENTS, AS SHOWN BY THE VICINITY MAP, ARE LOCATED ON THE NORTH SIDE OF BLUEWATER ROAD NW JUST EAST OF UNSER BLVD. THE SITE IS UNDEVELOPED. THE EXISTING LAND SLOPES FROM NORTHWEST TO SOUTHEAST AT APPROXIMATELY 2%. THE MASTER DRAINAGE PLAN FOR THE MERIDIAN BUSINESS PARK WAS PREPARED BY EASTERING AND ASSOC. THAT PLAN ESTABLISHED A DISCHARGE RATE OF 0.10 CFS PER ACRE FOR THE SUBDIVISION. THE PLAN ALSO REQUIRED THAT TEMPORARY DRAINAGE FACILITIES BE CONSTRUCTED ON EACH LOT TO CONTAIN THE RUNOFF UNTIL THE LOT IS DEVELOPED.

THE SITE IS LOWER THAN THE LOT TO THE NORTH, BUT EXIST SWALES AND A POND RETAIN THE RUNOFF ON THAT SITE. THE PROJECT SITE IS HIGHER THAN BLUEWATER TO THE SOUTH AND LOT 18-B TO THE EAST. IT IS PARALLEL WITH THE UNSER RIGHT-OF-WAY TO THE WEST. THEREFORE, OFFSITE FLOWS ENTERING THE PROJECT SITE WILL BE NEGLIGIBLE.

THE GRADING PLAN SHOWS 1) THE EXISTING AND PROPOSED GRADES, INDICATED BY SPOT ELEVATIONS AND CONTOURS AT 1'-0" INTERVALS, 2) CONTINUITY BETWEEN EXISTING AND PROPOSED ELEVATIONS, 3) THE LIMIT AND CHARACTER OF EXISTING IMPROVEMENTS AND, 4) THE LIMIT AND CHARACTER OF THE PROPOSED IMPROVEMENTS. THE PROPOSED IMPROVEMENTS CONSIST OF A WAREHOUSE AND OFFICE WITH ASSOCIATED PARKING AND LANDSCAPING. THE SITE IS BROKEN INTO TWO DRAINAGE BASINS, APPROXIMATELY 55% OF THE RUNOFF WILL BE IN THE NORTHERN BASIN AND APPROXIMATELY 45% IN THE SOUTHERN BASIN. ALL RUNOFF WILL BE ROUTED TO PONDS AND THEN RELEASED AT A RATE OF 0.10 CFS PER ACRE INTO THE EXISTING PRIVATE STORM DRAIN SYSTEM.

THE CALCULATIONS, WHICH APPEAR BELOW, ANALYZE THE EXISTING AND PROPOSED CONDITIONS FOR THE 6-HOUR 100-YEAR RAINFALL EVENT. THE ANALYSIS IS IN ACCORDANCE WITH THE CITY OF ALBUQUERQUE DEVELOPMENT PROCESS MANUAL, VOLUME II. AS SHOWN BY THESE CALCULATIONS, THE RATE AND VOLUME OF RUNOFF WILL INCREASE, BUT THE PONDS WITH CONTROLLED OUTLETS WILL MITIGATE THE INCREASES. THIS PLAN IS IN CONFORMANCE WITH THE MASTER DRAINAGE PLAN.

CALCULATIONS

PRECIPITATION ZONE = 1
SOUTH BASIN
EXISTING CONDITIONS
AREA = 3.80
LAND TREATMENT A=100%
E = 0.44*1.00 = 0.44 INCHES
V = 0.44*3.80/12 = 0.14 ACRE FEET
Q = 1.29*1.00*3.80 = 4.90 CFS
DEVELOPED CONDITIONS
LAND TREATMENT B=17% D=83%
E = 0.67*0.17+1.97*0.83 = 1.75 INCHES
V = 1.75*3.80/12 = 0.55 ACRE FEET
Q = (2.03*0.17+4.37*0.83)*3.80 = 15.09 CFS
INCREASE IN RATE OF RUNOFF = 15.09-4.90 = 10.19 CFS
INCREASE IN VOLUME OF RUNOFF = 0.55-0.14 = 0.41 ACRE FEET
NORTH BASIN
AREA = 4.72 ACRES
EXISTING CONDITIONS
LAND TREATMENT A=100%
E = 0.44*1.00 = 0.44 INCHES
V = 0.44*4.72/12 = 0.17 ACRE FEET
Q = 1.29*1.00*4.72 = 5.42 CFS
DEVELOPED CONDITIONS
LAND TREATMENT B=22% D=78%
E = 0.67*0.22+1.97*0.78 = 1.70 INCHES
V = 1.70*4.72/12 = 0.67 ACRE FEET
Q = (2.03*0.22+4.37*0.78)*4.72 = 18.20 CFS
INCREASE IN RATE OF RUNOFF = 18.20-5.42 = 12.78 CFS
INCREASE IN VOLUME OF RUNOFF = 0.67-0.17 = 0.50 ACRE FEET
ORIFICE SIZES
NORTH = SOUTH
0.42 = 0.60A(2*32.2*3)^0.5 DIA=3.04 INCHES
POND VOLUMES
SOUTH
V = 6587+13365+7583 = 27535 CF > 0.55*43560=23958 CF @ WS ELEV=14.0,13.0 & 12.0
NORTH
V = 18749+11224 = 29973 CF > 0.67*43560=29185 CF @ WS ELEV = 14.1

NORTH
GRADING & DRAINAGE PLAN
NOVEMBER 16, 1998 SCALE: 1" = 40'-0" (U.N.O.)

CLAUDIO VIGIL ARCHITECTS

MERIDIAN BUSINESS PARK
BRUNACINI TILT-UP
OFFICE WAREHOUSE
7601 BLUEWATER ROAD, N.W.
ALBUQUERQUE, NEW MEXICO

THIS PROJECT WAS CONSTRUCTED
IN SUBSTANTIAL COMPLIANCE
WITH THE APPROVED GRADING PLAN

8/16/99

THOMAS T. MANN, JR.

3792

1.4.99

HYDROLOGY SECTION

SHEET

C-2


1305 Tijeras NW Albuquerque, NM 87102-2882

Phone: 505/842-1113 Fax: 505/842-1330

Engineering &
Surveying
Associates, Inc.

5312 Huron Blvd NE Albuquerque, NM 87111

(505) 298-4851

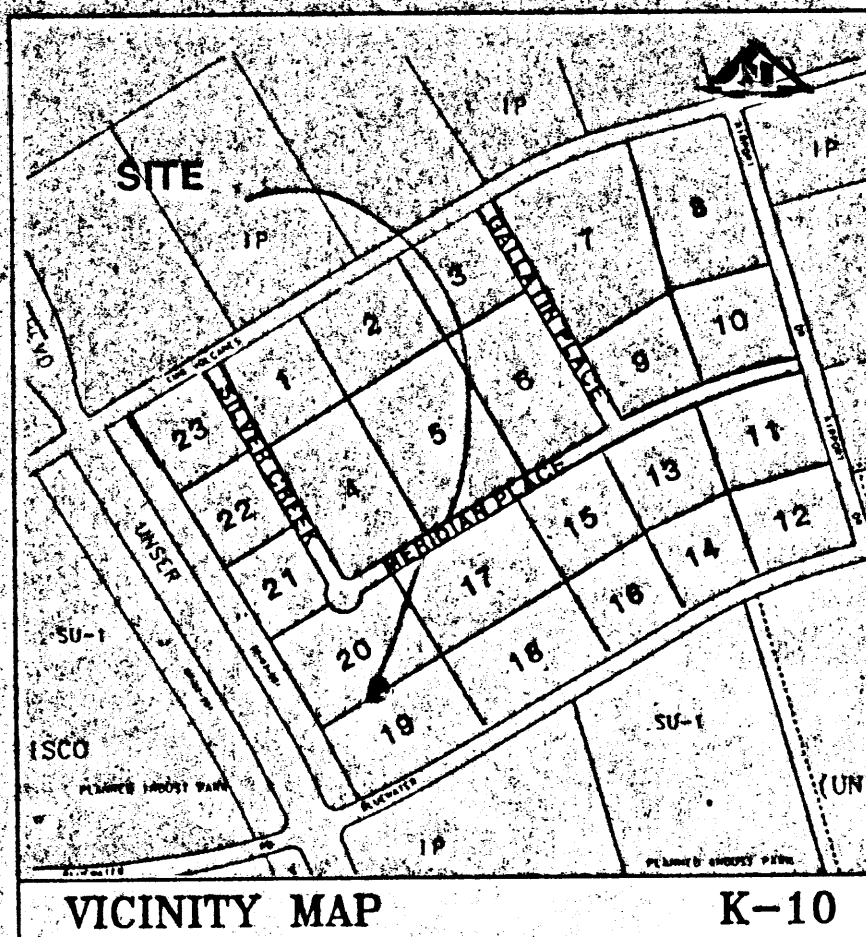

ADDRESS

7601 BLUEWATER ROAD NW

LEGAL DESCRIPTION


LOT 19-A, MERIDIAN BUSINESS PARK

BENCHMARK

ACS MONUMENT 10-K10 LOCATED AT THE SOUTHEAST CORNER OF UNSER BLVD AND LOS VOLCANES ROAD. ELEVATION = 5142.79.

LEGEND

- 35.8 EXISTING SPOT ELEVATION
- 36.20 NEW SPOT ELEVATION
- 36 — EXISTING CONTOUR
- 35 — NEW CONTOUR
- SWALE
- ✓ VERIFIED ELEVATION
- 36.2 — AS-BUILT ELEVATION
- BASIN BOUNDARY

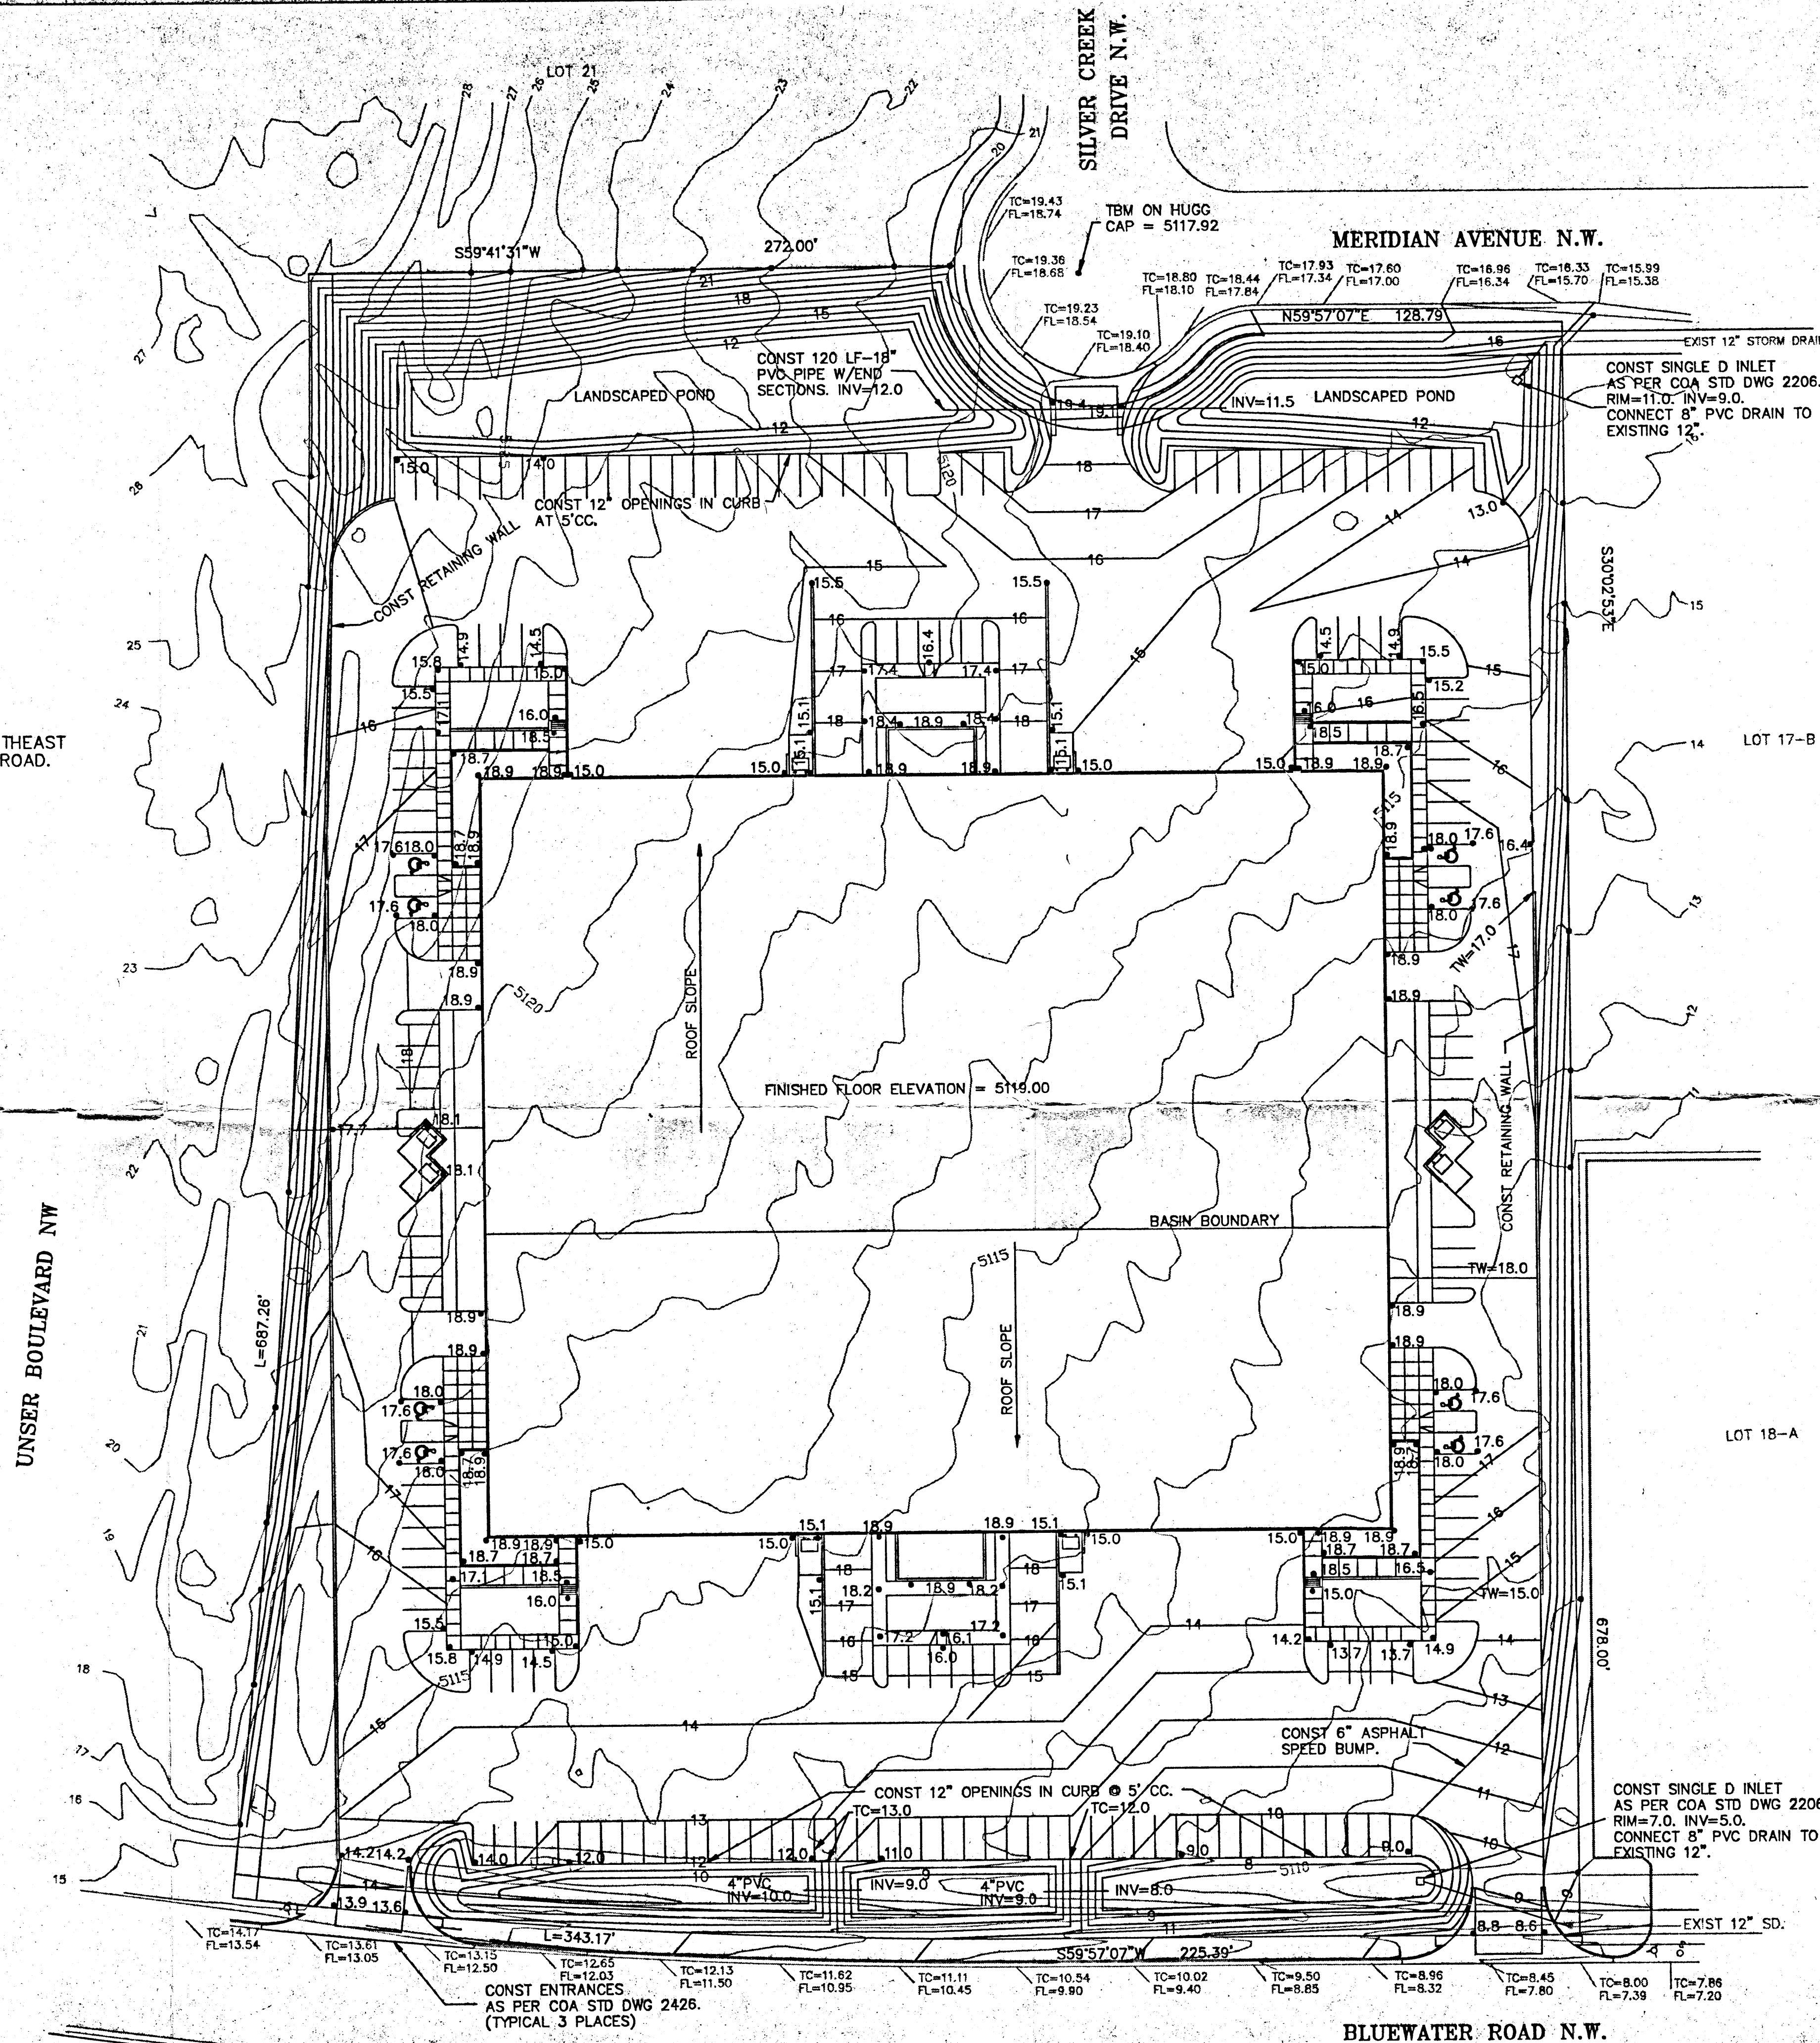

DRAINAGE PLAN

THE FOLLOWING ITEMS CONCERNING THE LOT 19-A, MERIDIAN BUSINESS PARK GRADING AND DRAINAGE PLAN ARE CONTAINED HEREON:

1. VICINITY MAP
2. GRADING PLAN
3. CALCULATIONS

THE PROPOSED IMPROVEMENTS, AS SHOWN BY THE VICINITY MAP, ARE LOCATED ON THE NORTH SIDE OF BLUEWATER ROAD NW JUST EAST OF UNSER BLVD. THE SITE IS UNDEVELOPED. THE EXISTING LAND SLOPES FROM NORTHWEST TO SOUTHEAST AT APPROXIMATELY 2%. THE MASTER DRAINAGE PLAN FOR THE MERIDIAN BUSINESS PARK WAS PREPARED BY EASTERLING AND ASSOC. THAT PLAN ESTABLISHED A DISCHARGE RATE OF 0.10 CFS PER ACRE FOR THE SUBDIVISION. THE PLAN ALSO REQUIRED THAT TEMPORARY DRAINAGE FACILITIES BE CONSTRUCTED ON EACH LOT TO CONTAIN THE RUNOFF UNTIL THE LOT IS DEVELOPED.


THE SITE IS LOWER THAN THE LOT TO THE NORTH, BUT EXISTING SWALES AND A POND RETAIN THE RUNOFF ON THAT SITE. THE PROJECT SITE IS HIGHER THAN BLUEWATER TO THE SOUTH AND LOT 18-B TO THE EAST. IT IS PARALLEL WITH THE UNSER RIGHT-OF-WAY TO THE WEST. THEREFORE, OFFSITE FLOWS ENTERING THE PROJECT SITE WILL BE NEGIGIBLE.

THE GRADING PLAN SHOWS 1) THE EXISTING AND PROPOSED GRADES, INDICATED BY SPOT ELEVATIONS AND CONTOURS AT 1'-0" INTERVALS, 2) CONTINUITY BETWEEN EXISTING AND PROPOSED ELEVATIONS, 3) THE LIMIT AND CHARACTER OF EXISTING IMPROVEMENTS AND 4) THE LIMIT AND CHARACTER OF THE PROPOSED IMPROVEMENTS. THE PROPOSED IMPROVEMENTS CONSIST OF A WAREHOUSE AND OFFICE WITH ASSOCIATED PARKING AND LANDSCAPING. THE SITE IS BROKEN INTO TWO DRAINAGE BASINS. APPROXIMATELY 55% OF THE RUNOFF WILL BE IN THE NORTHERN BASIN AND APPROXIMATELY 45% IN THE SOUTHERN BASIN. ALL RUNOFF WILL BE ROUTED TO PONDS AND THEN RELEASED AT A RATE OF 0.10 CFS PER ACRE INTO THE EXISTING PRIVATE STORM DRAIN SYSTEM.

THE CALCULATIONS, WHICH APPEAR BELOW, ANALYZE THE EXISTING AND PROPOSED CONDITIONS FOR THE 6-HOUR, 100-YEAR RAINFALL EVENT. THE ANALYSIS IS IN ACCORDANCE WITH THE CITY OF ALBUQUERQUE DEVELOPMENT PROCESS MANUAL, VOLUME II. AS SHOWN BY THESE CALCULATIONS, THE RATE AND VOLUME OF RUNOFF WILL INCREASE, BUT THE PONDS WITH CONTROLLED OUTLETS WILL MITIGATE THE INCREASES. THIS PLAN IS IN CONFORMANCE WITH THE MASTER DRAINAGE PLAN.

CALCULATIONS

PRECIPITATION ZONE = 1
SOUTH BASIN
EXISTING CONDITIONS
AREA = 3.80
LAND TREATMENT A=100%
E = 0.44*1.00 = 0.44 INCHES
V = 0.44*3.80/12 = 0.14 ACRE FEET
Q = 1.29*1.00*3.80 = 4.90 CFS
DEVELOPED CONDITIONS
LAND TREATMENT B=17% D=83%
E = 0.67*0.17+1.97*0.83 = 1.75 INCHES
V = 1.75*3.80/12 = 0.55 ACRE FEET
Q = (2.03*0.17+4.37*0.83)/3.80 = 15.09 CFS
INCREASE IN RATE OF RUNOFF = 15.09-4.90 = 10.19 CFS
INCREASE IN VOLUME OF RUNOFF = 0.55-0.14 = 0.41 ACRE FEET
NORTH BASIN
AREA = 4.72 ACRES
EXISTING CONDITIONS
LAND TREATMENT A=100%
E = 0.44*1.00 = 0.44 INCHES
V = 0.44*4.72/12 = 0.17 ACRE FEET
Q = 1.29*1.00*4.72 = 5.42 CFS
DEVELOPED CONDITIONS
LAND TREATMENT B=22% D=78%
E = 0.67*0.22+1.97*0.78 = 1.70 INCHES
V = 1.70*4.72/12 = 0.67 ACRE FEET
Q = (2.03*0.22+4.37*0.78)/4.72 = 18.20 CFS
INCREASE IN RATE OF RUNOFF = 18.20-5.42 = 12.78 CFS
INCREASE IN VOLUME OF RUNOFF = 0.67-0.17 = 0.50 ACRE FEET
ORIFICE SIZES
NORTH = SOUTH
0.42 = 0.60A(2*32.2*5)^0.5 DIA=2.74 INCHES
POND VOLUMES
SOUTH
V = 12708+6135+7927 = 26770 CF > 0.55*43560=23958 CF @ DEPTH = 2.75'
NORTH
V = 18749+11224 = 29973 CF > 0.67*43560=29185 CF @ WS ELEV = 14.1

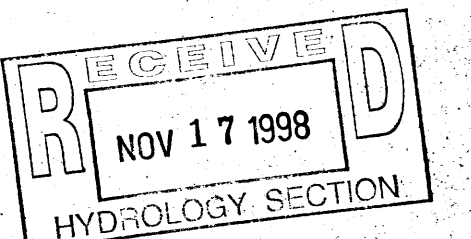



GRADING & DRAINAGE PLAN

NOVEMBER 16, 1998 SCALE: 1" = 40'-0" (U.N.O.)



CLAUDIO VIGIL ARCHITECTS


MERIDIAN BUSINESS PARK
BRUNACINI TILT-UP
OFFICE WAREHOUSE
7601 BLUEWATER ROAD, N.W.
ALBUQUERQUE, NEW MEXICO

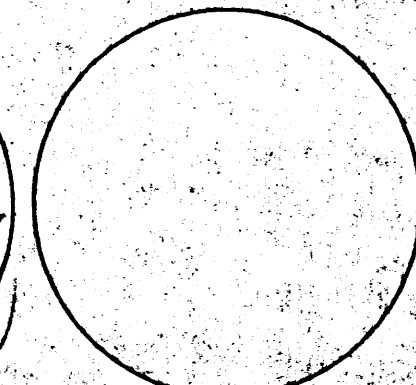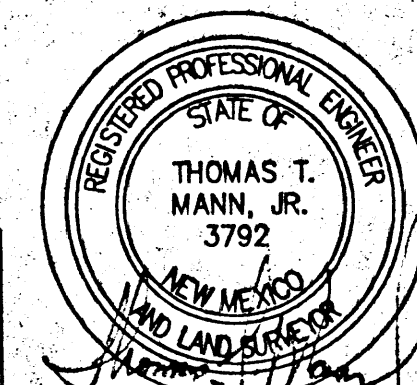

SHEET

C-1

Engineering & Surveying Associates, Inc.
1305 Tijeras NW Albuquerque, NM 87102-2882
Phone: 505/842-1113 Fax: 505/842-1330

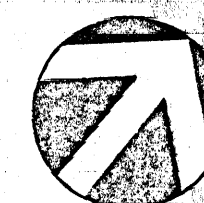

SCALE : 1" = 40

VICINITY MAP K-10

Highway 101

Highway 10

Highway 9

PROJECT LOCATION

0 1 MILE

N

THICKENED SLAB IN
THIS AREA

THIS SUITE NOT PART OF
THIS USPS LEASE SPACE

PROPERTY LINE.
EASEMENT BOUNDARIES.

BENCHMARK FOR THIS PROJECT IS THE ACS 3 1/4" ALUMINUM CAP STAMPED "9-K10, 1989" LOCATED FLUSH WITH THE TOP OF CURB AT THE SE QUADRANT OF THE INTERSECTION OF UNSER BLVD AND BLUEWATER RD IN THE TRAFFIC ISLAND.

LOTS 19 AND 20 OF MERIDIAN BUSINESS PARK, SITUATE WITHIN ATRISCO GRANT, PROJECTED SECTION 22, TOWNSHIP 10 NORTH, RANGE 2 EAST, N.M.P.M., CITY OF ALBUQUERQUE, BERNALILLO COUNTY, NEW MEXICO

EXISTING CONDITIONS:

THE GRADING AND DRAINAGE PLAN FOR THIS SITE WAS PREPARED IN NOVEMBER 1998 BY THOMAS MANN, JR. OF ENGINEERING AND SURVEYING ASSOCIATES. PLEASE SEE EXCERPT ON THIS SHEET.

THE DASHED AREAS INDICATE CHANGES TO THE SITE. THE EASTERN DASHED AREA INCLUDES CHANGES TO THE EXISTING INTERNAL PART OF THE BUILDING WHICH WILL NOT CHANGE THE SITE HYDROLOGY.

THE NORTHERN AND SOUTHERN DASHED AREAS ARE ADDING WROUGHT IRON FENCING AND REPLACING ASPHALT WITH CONCRETE AND MEDIANS TO ALREADY IMPERVIOUS AREAS. AS A RESULT, THIS WILL NOT CHANGE THE SITE HYDROLOGY.


THE WESTERN DASHED AREA IS ADDING A SECTION TO THE BUILDING AND TURNING PARKING AREA INTO LANDSCAPING. THE TOTAL AREA BEING AFFECTED IS 0.0173 AC. AND THE LANDSCAPING IS INCREASING BY 0.0051 AC. THE NET RESULT IS THAT THE VOLUME OF RUN-OFF AND FLOW ARE DECREASING BY 28 CF. AND 0.0119 CFS, RESPECTIVELY. THEREFORE, NO INCREASE IN THE VOLUME OF THE PONDS IS NECESSARY.

CALCULATIONS

PRECIPITATION ZONE = 1
SOUTH BASIN
EXISTING CONDITIONS
E = 3.80
LAND TREATMENT A=100%
Q = 0.4*1.01 = 0.44 INCHES
V = 0.44*3.6/12 = 0.14 ACRES FEET
Q = 1.291.0003.80 = 4.90
DEVELOPED CONDITIONS
LAND TREATMENT B=17% D=83%
E = 0.67*0.1741*97*0.83 = 1.75 INCHES
V = 1.75*3.6/12 = 0.52 ACRES FEET
Q = (2.0340.174.37*0.83).80 = 15.09 CFS
INCREASE IN RATE OF RUNOFF = 15.09-4.90 = 10.19 CFS
INCREASE IN VOLUME OF RUNOFF = 0.55-0.14 = 0.41 ACRES FEET
LAND BASIN
E = 8.72 ACRES
EXISTING CONDITIONS
LAND TREATMENT A=100%
Q = 0.44*1.00 = 0.44 INCHES
V = 0.44*4.72/12 = 0.17 ACRES FEET
Q = 1.291.004.72 = 5.42 CFS
DEVELOPED CONDITIONS
LAND TREATMENT B=22% D=78%
E = 0.87*0.221.97*0.78 = 1.70 INCHES
V = 1.70*4.72/12 = 0.67 ACRES FEET
Q = (2.0340.221.37*0.78).78 = 18.20 CFS
INCREASE IN RATE OF RUNOFF = 18.20-5.42 = 12.78 CFS
INCREASE IN VOLUME OF RUNOFF = 0.67-0.17 = 0.50 ACRES FEET
GRIDGE SIZES
SOUTH BASIN
FOND VOLUMES
Q = 0.42 + 0.60*(4332.2*3) = 0.95 ACRES FEET
SOUTH BASIN
Q = 0.581+1.3368+5.95 = 2735.0 CFS
Q @ WS ELEV 14,013.0 & 12.0
NORTH BASIN
Q = 0.7743350+1224 = 29973.0 CFS @ 0.67*43560+29185 CFS @ WS ELEV = 14.1

MARK GOODWIN & ASSOCIATES, P.A.
CONSULTING ENGINEERS

P.O. BOX 90606
ALBUQUERQUE, NEW MEXICO 87199
(505) 828-2200, FAX (505) 797-9539

 8000 PENNSYLVANIA CIRCLE N.E.
SUITE "B"
ALBUQUERQUE, NEW MEXICO 87110
DENNIS M. SCARCELL, P.E.
ENGINEERING (505)262-1766

SAW

Design Collaborative
Southwest Inc.
370 Central Ave. SW
Albuquerque, NM 87102

USPS Albuquerque
Temporary Mail Processing Annex
ASF Renovations
7601 Bluewater Rd NW Suite B
Albuquerque, NM 87120

**UNITED STATES
POSTAL SERVICE**

PRE-FINAL SUBMITTAL
98% REVIEW
PRELIMINARY



Scale: 1" = 40' Date: 11.17.00
Project: Albuquerque Temporary
Mail Processing Annex ASF Renovations
DCSW PROJECT NO: 9810.020
USPS File Number: F54781

E: ADYAY@VIRCA10005@tel.M0423JCB5 M0423-CD30 duo
 Fri Nov 17 13:48:43 2000 BY DER



GRADING AND DRAINAGE PLAN
SCALE: 1" = 40'

UNSER BOULEVARD

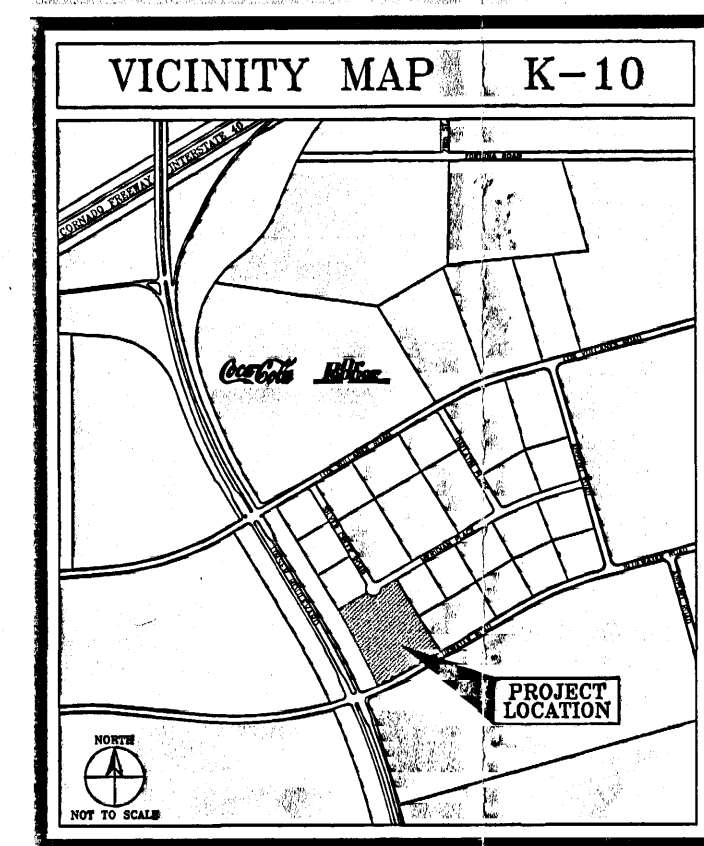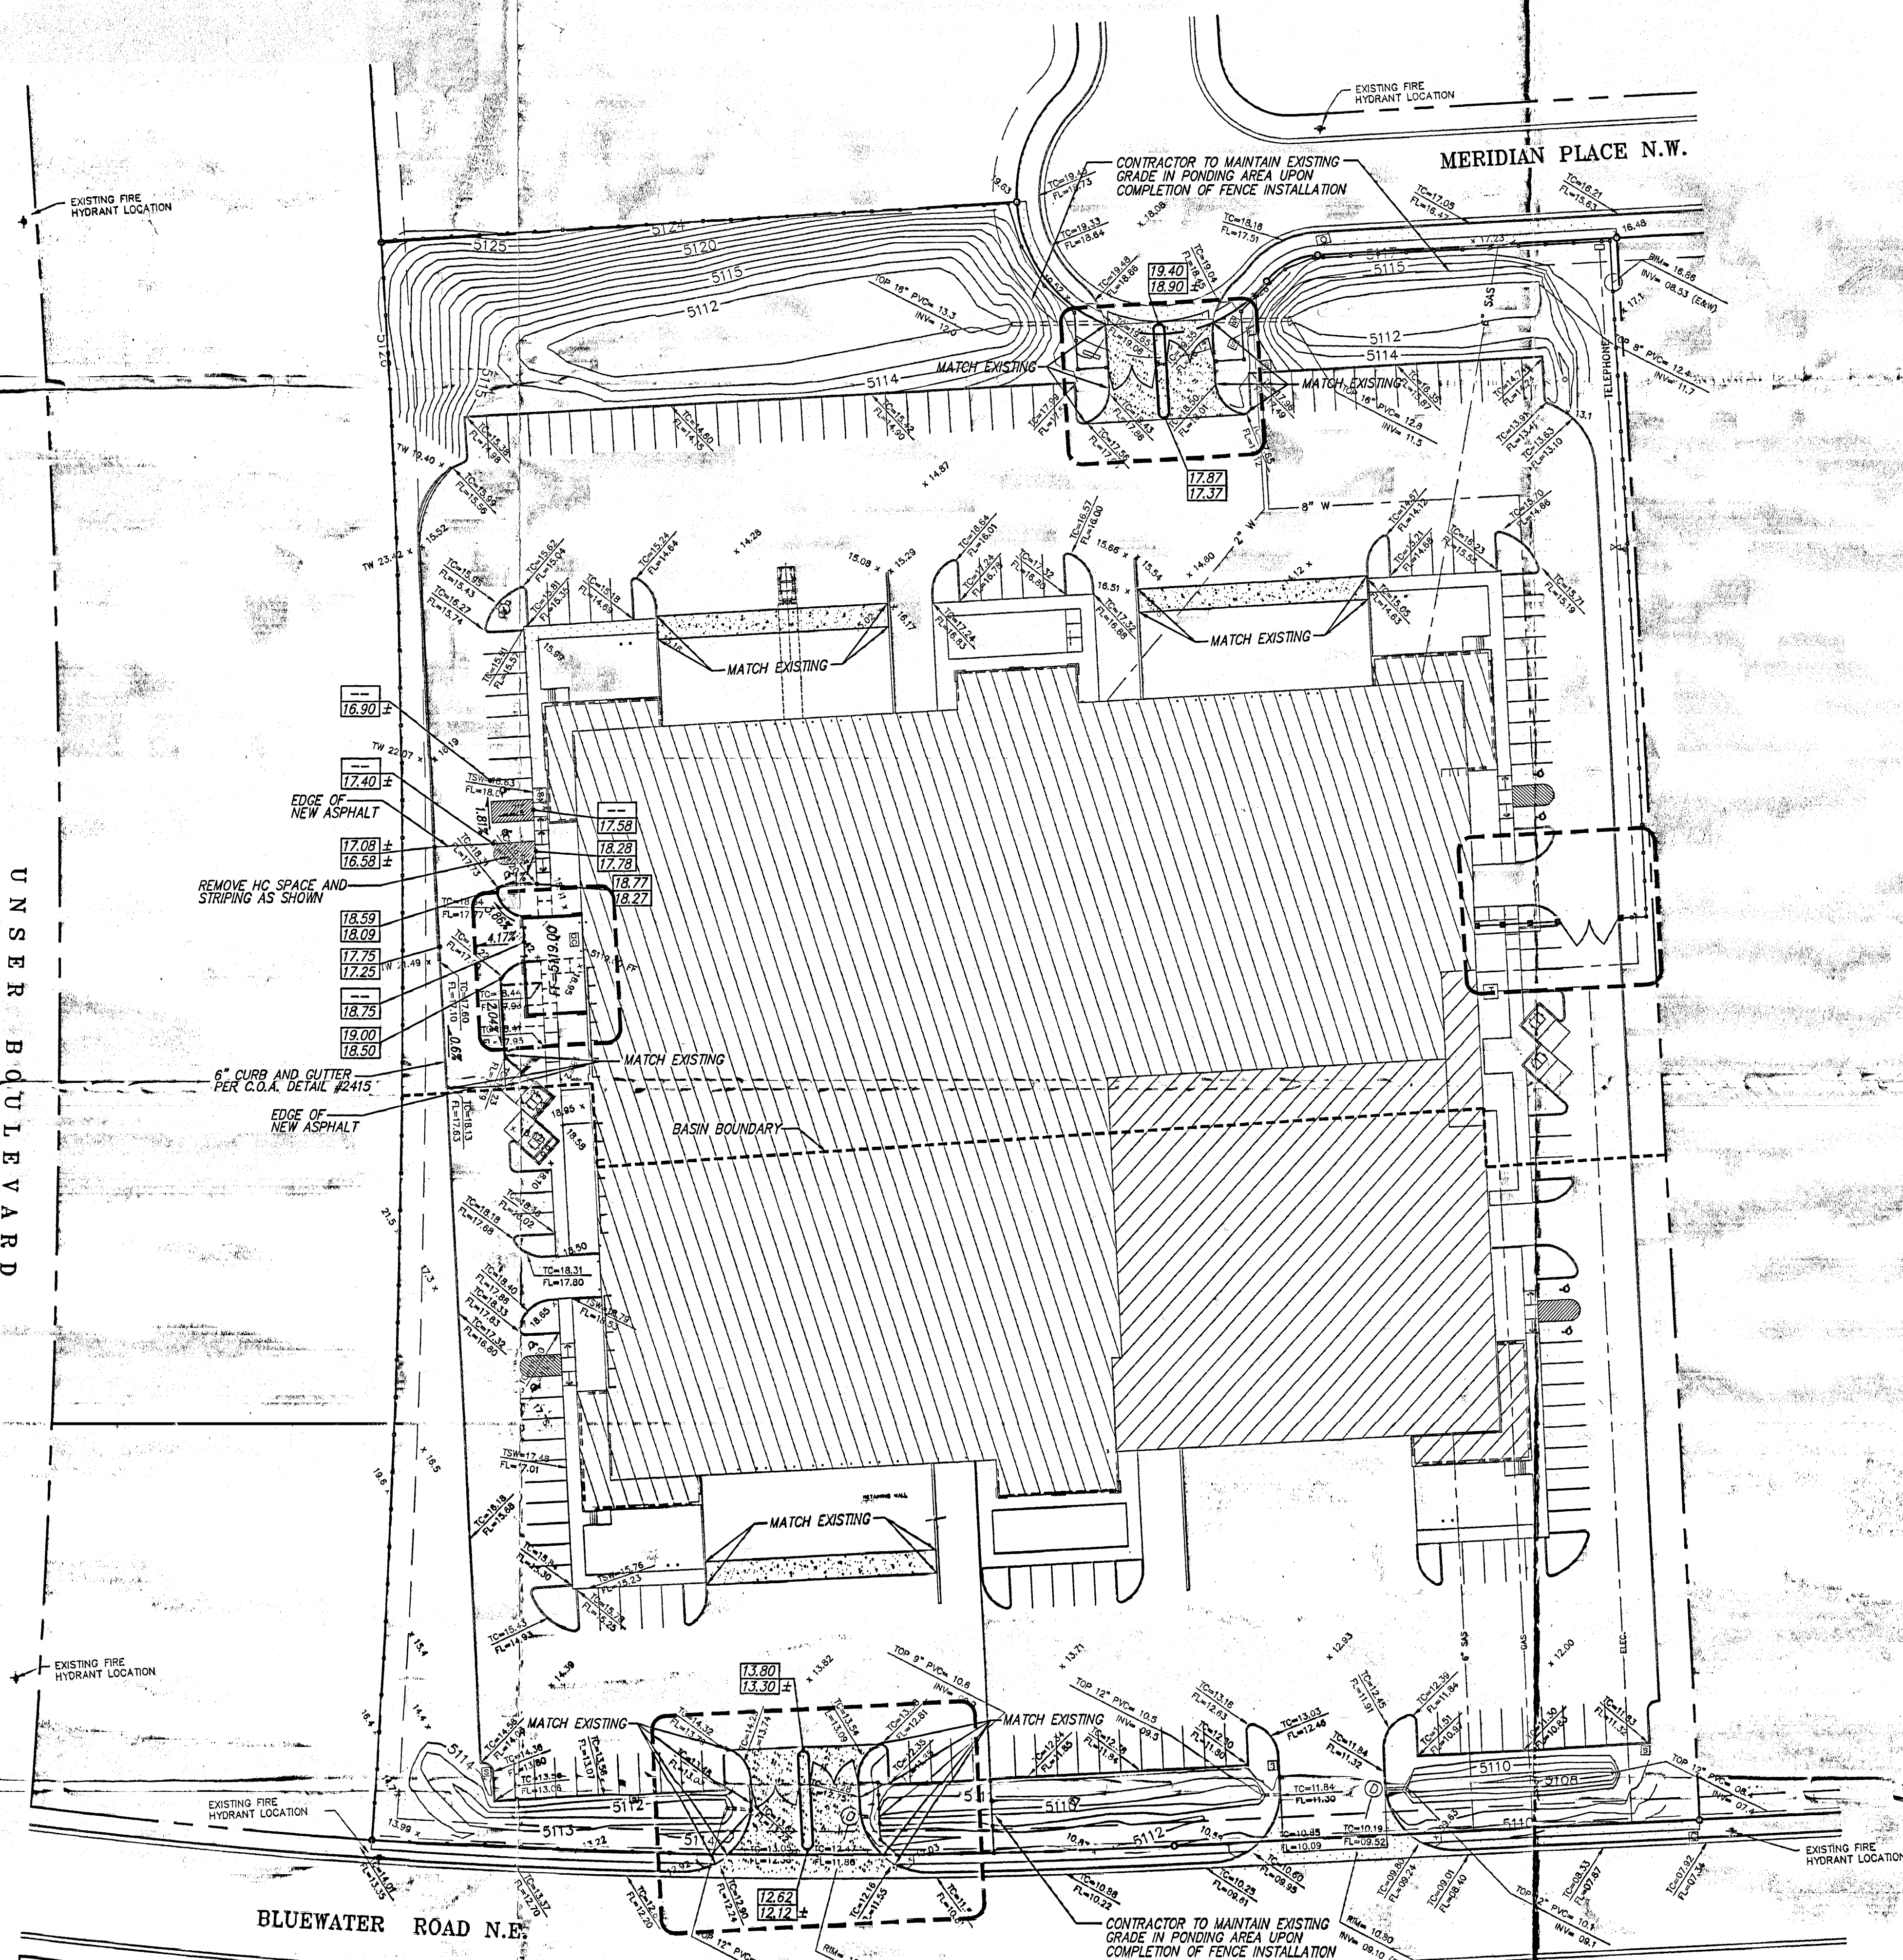

LEGEND

- EXISTING TOP OF CURB & FLOWLINE ELEVATION
- PROPOSED TOP OF CURB ELEVATION
- PROPOSED FLOWLINE ELEVATION
- PROPOSED CONCRETE

ACS BENCHMARK

BENCHMARK FOR THIS PROJECT IS THE ACS 3 1/4" ALUMINUM CAP STAMPED 9-K10, 1989 LOCATED FLUSH WITH THE TOP OF CURB AT THE SE QUADRANT OF THE INTERSECTION OF UNSER BLVD AND BLUEWATER RD IN THE TRAFFIC ISLAND.

LEGAL DESCRIPTION

LOTS 19 AND 20 OF MERIDIAN BUSINESS PARK, SITUATE WITHIN ATRISCO GRANT, PROJECTED SECTION 22, TOWNSHIP 10 NORTH, RANGE 2 EAST, N.M.P.M., CITY OF ALBUQUERQUE, BERNALILLO COUNTY, NEW MEXICO

HYDROLOGY NOTES

EXISTING CONDITIONS:

THE GRADING AND DRAINAGE PLAN FOR THIS SITE WAS PREPARED IN NOVEMBER 1998 BY THOMAS MANN, JR. OF ENGINEERING AND SURVEYING ASSOCIATES. PLEASE SEE EXCERPT ON THIS SHEET.

PROPOSED CONDITIONS:


THE DASHED AREAS INDICATE CHANGES TO THE SITE. THE EASTERN DASHED AREA INCLUDES CHANGES TO THE EXISTING INTERNAL PART OF THE BUILDING WHICH WILL NOT CHANGE THE SITE HYDROLOGY.

THE NORTHERN AND SOUTHERN DASHED AREAS ARE ADDING WROUGHT IRON FENCING AND REPLACING ASPHALT WITH CONCRETE AND MEDIANS TO ALREADY IMPERVIOUS AREAS. AS A RESULT, THIS WILL NOT CHANGE THE SITE HYDROLOGY.

THE WESTERN DASHED AREA IS ADDING A SECTION TO THE BUILDING AND TURNING PARKING AREA INTO LANDSCAPING. THE TOTAL AREA BEING AFFECTED IS 0.0173 AC. AND THE LANDSCAPING IS INCREASING BY 0.0051 AC. THE NET RESULT IS THAT THE VOLUME OF RUN-OFF AND FLOW ARE DECREASING BY 26 CF. AND 0.0119 CFS, RESPECTIVELY. THEREFORE, NO INCREASE IN THE VOLUME OF THE PONDS IS NECESSARY.

CALCULATIONS BY THOMAS MANN

PRECIPITATION ZONE = 1
SOUTH BASIN
EXISTING CONDITIONS
AREA = 3.87
LAND TREATMENT A=100%
C = 0.44100 = 0.44 INCHES
Q = 0.44100/12 = 0.14 ACRE FEET
Q = 1.28100/12 = 4.90 CFS
DEVELOPED CONDITIONS
C = 0.570171 = 0.57 INCHES
V = 0.570171/12 = 0.55 ACRE FEET
Q = (2.03122+4.37)0.55/12 = 15.09 CFS
INCREASE IN RATE OF RUNOFF = 15.09-4.90 = 10.19 CFS
INCREASE IN VOLUME OF RUNOFF = 0.55-0.14 = 0.41 ACRE FEET
NORTH BASIN
AREA = 4.12 ACRES
EXISTING CONDITIONS
LAND TREATMENT A=100%
C = 0.44100 = 0.44 INCHES
V = 0.44100/12 = 0.17 ACRE FEET
Q = 1.28100/12 = 4.90 CFS
DEVELOPED CONDITIONS
LAND TREATMENT A=22% C=78%
C = 0.67022+1.97078 = 1.70 INCHES
V = 1.70422/12 = 0.87 ACRE FEET
Q = (2.03122+4.37)0.87/12 = 18.20 CFS
INCREASE IN RATE OF RUNOFF = 18.20-4.90 = 13.30 CFS
INCREASE IN VOLUME OF RUNOFF = 0.87-0.17 = 0.70 ACRE FEET
TOTAL
Q = 13.30+10.19 = 23.49 CFS
V = 0.70+0.41 = 1.11 ACRE FEET
SOUTH
V = 0.87+0.33 = 1.20 ACRE FEET
Q = 18.20+13.30 = 31.50 CFS
NORTH
V = 0.70+0.41 = 1.11 ACRE FEET
Q = 13.30+10.19 = 23.49 CFS
TOTAL
V = 1.20+1.11 = 2.31 ACRE FEET
Q = 31.50+23.49 = 54.99 CFS

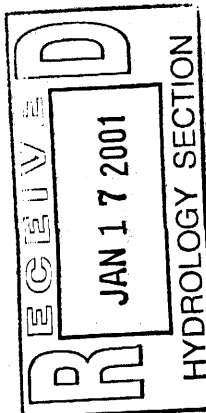

GRADING AND DRAINAGE PLAN

Scale: 1" = 40'
Date: 12/29/00
Project: Albuquerque Temporary Mail Processing Annex ASF Renovations
USPS File Number: E724781

UNITED STATES
POSTAL SERVICE
7601 Bluewater Rd NW Suite B
Albuquerque, NM 87120
USPS Albuquerque Temporary Mail Processing Annex ASF Renovations

DCSW
ARCHITECTS
300 Central Ave. SW
Albuquerque, NM 87102

DMG
ENGINEERING
300 Central Ave. SW
Albuquerque, NM 87102

MARK CODWIN & ASSOCIATES, P.A.
P.O. BOX 9600
ALBUQUERQUE, NEW MEXICO 87109
(505) 828-2200, FAX (505) 707-9539