

DRAINAGE PLAN

THIS PROJECT IS PART OF THE APPROVED CLIFFORD WEST BUSINESS PARK MASTER DRAINAGE PLAN (K10-D23) DATED 9-17-97. THE BACKBONE STORM SEWER SYSTEM HAS BEEN BUILT AND ACCEPTED BY THE CITY OF ALBUQUERQUE. AN 18" RCP STORM LATERAL STUB IS PROVIDED FOR LOT 10 AT THE WEST PROPERTY LINE APPROXIMATELY 40 FEET FROM THE SOUTHWEST PROPERTY CORNER. DRAINAGE FROM LOT 11 AND 12 IS PROVIDED THROUGH A 10" WIDE PRIVATE DRAINAGE EASEMENT LOCATED ALONG THE SOUTH PROPERTY LINE OF LOT 12 AND EXTENDING SOUTH BETWEEN LOTS 5 AND 6 TO AN EXISTING 18" RCP STORM SEWER LATERAL STUBBED AT THE RIGHT-OF-WAY LINE WITH AN INVERT = ±17.0'.

THE ALLOWABLE DISCHARGE Q(LOT 10) = 0.63 cfs AND Q(LOT 11 & 12) = 2.05 cfs.

SUBBASIN 1: THE DEVELOPED CONDITIONS RUNOFF WILL BE RESTRICTED TO THE MAXIMUM ALLOWABLE DISCHARGE THROUGH AN ORIFICE PLATE ATTACHED TO THE END OF THE 18" RCP IN THE JUNCTION BOX. THE ONSITE DRIVEWAY WILL BE USED TO TEMPORARILY DETAIN THE RUNOFF.

SUBBASIN 2: THE DEVELOPED CONDITIONS RUNOFF WILL BE RESTRICTED TO THE MAXIMUM ALLOWABLE DISCHARGE THROUGH A RESTRICTED OPENING IN THE FLOODWALL ALONG THE SOUTH PROPERTY LINE BEFORE DISCHARGING INTO A CONCRETE CHANNEL AND THEN INTO THE EXISTING 18" RCP AS SHOWN ON THIS GRADING AND DRAINAGE PLAN.

HYDROLOGY SUMMARY (100 YEAR 6 HOUR)

P(1 HR) = 1.90"
P(6 HR) = 2.20"

	DEVELOPED Q	ALLOWABLE Q	DESIGN AREA(A)	ORIFICE OPENING SQUARE DIMENSIONS
SUBBASIN 1	3.47 cfs	0.63 cfs	0.052517 SQFT.	2.75" x 2.75"
SUBBASIN 2	9.88 cfs	2.05 cfs	0.3987 SQFT.	

(*) ORIFICE EQN. : $Q = 0.6 \times (\text{AREA}) \times (2 \times 32.2 \times H)^{1/2}$

FOR SINGLE "C" INLET
 $Q = C \times L \times H^{1/2}$

SIDE Q CAP = $(3.0)(2+2+4)(0.5) \times 1.5 = 8.48 \text{ cfs}$



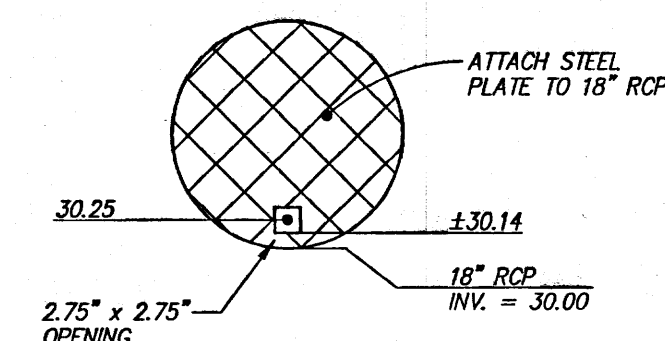



PLATE DETAIL FOR JUNCTION BOX

NTS

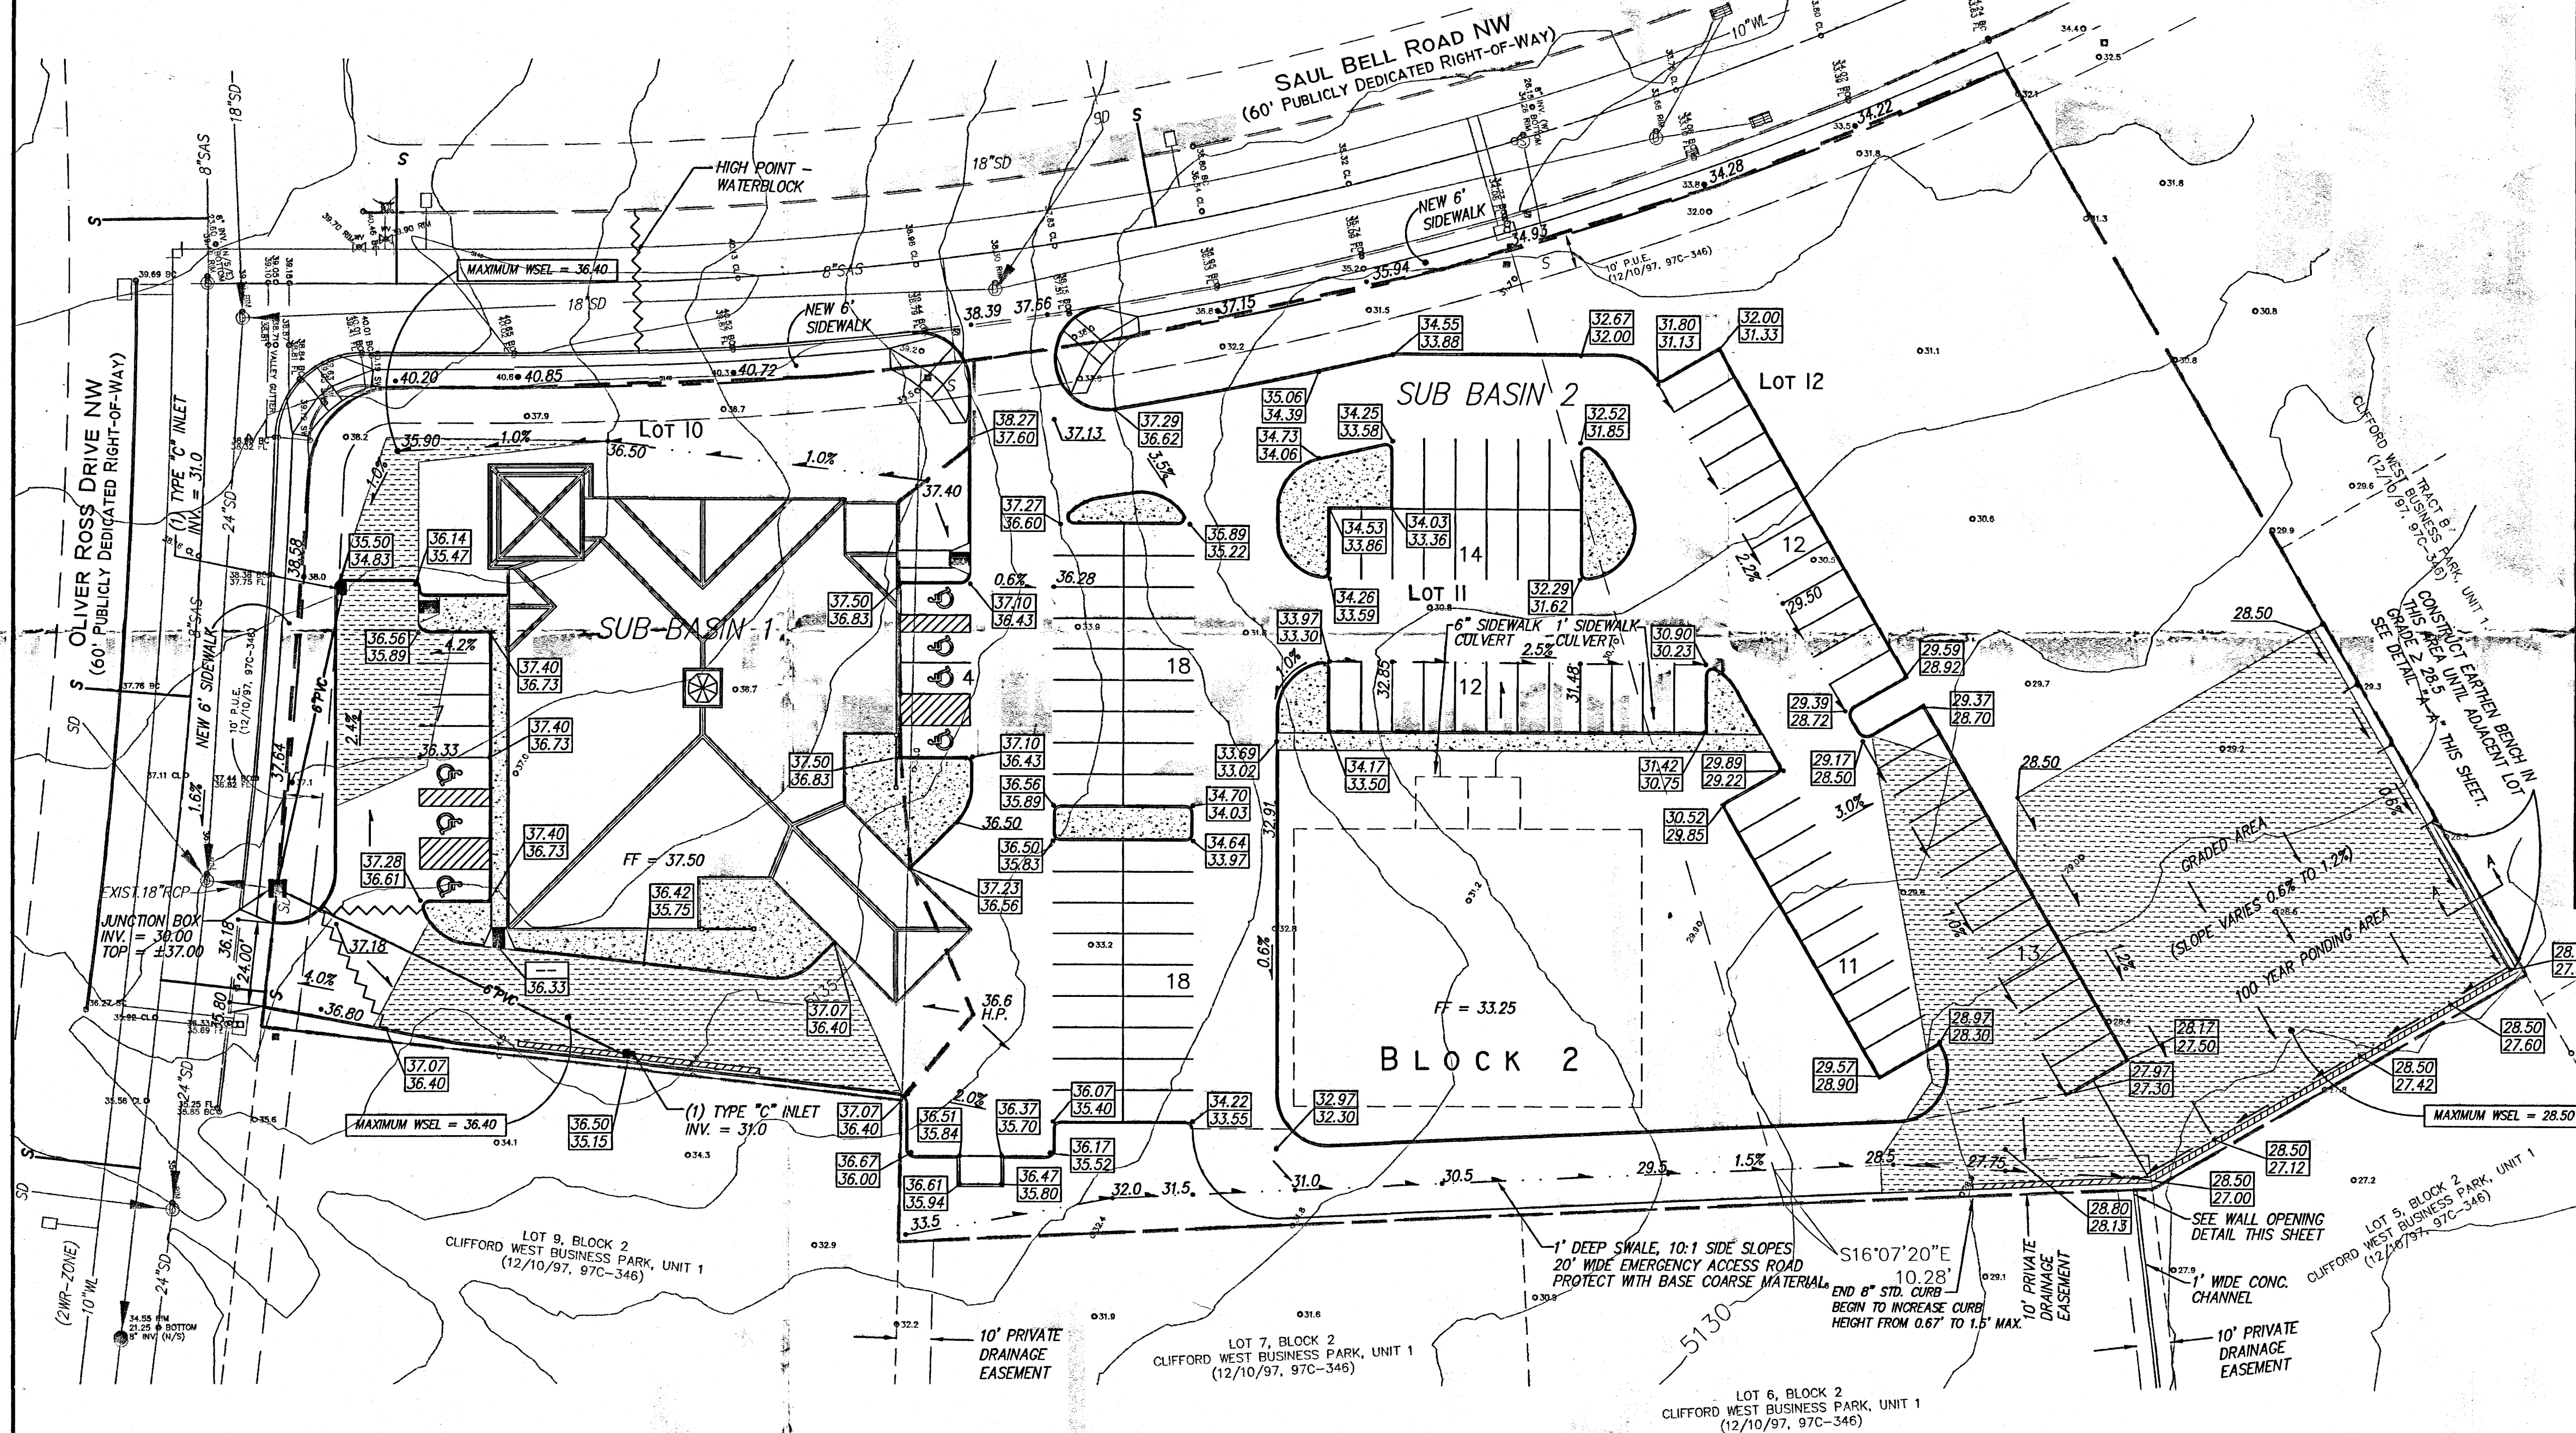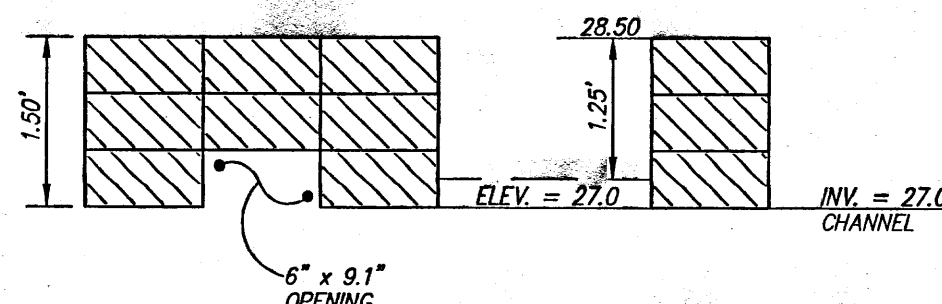


WALL OPENING DETAIL

NTS

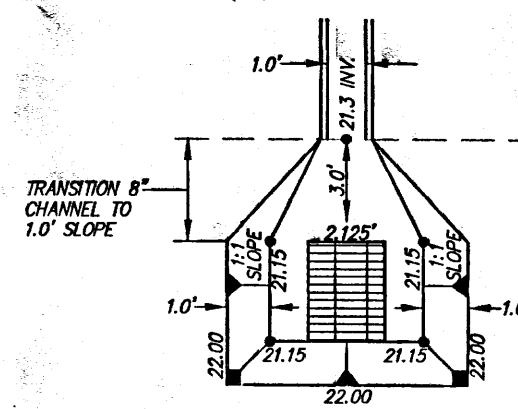


CHANNEL DETAIL

NTS

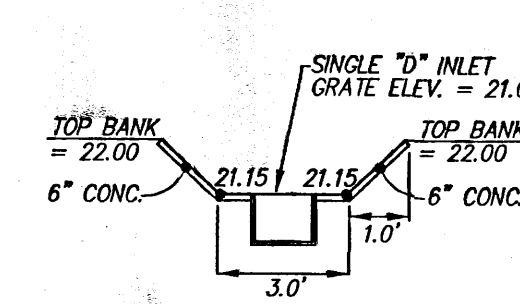


CHANNEL DETAIL

NTS

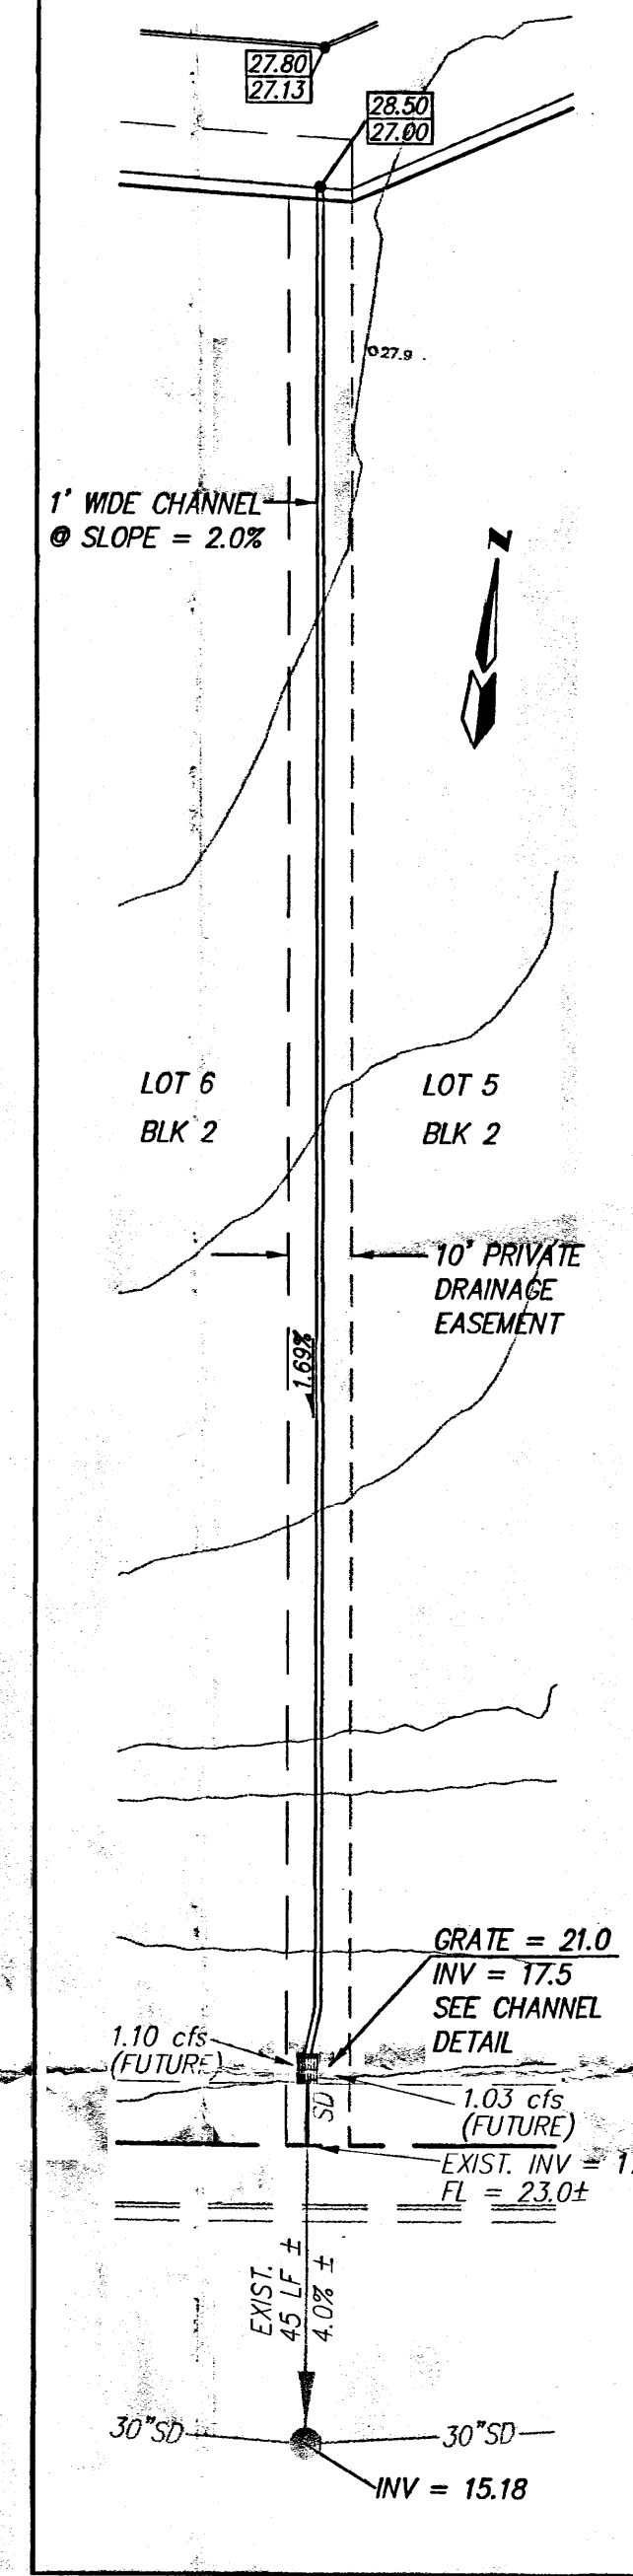

DETAIL A-A
SCALE: 1" = 5'

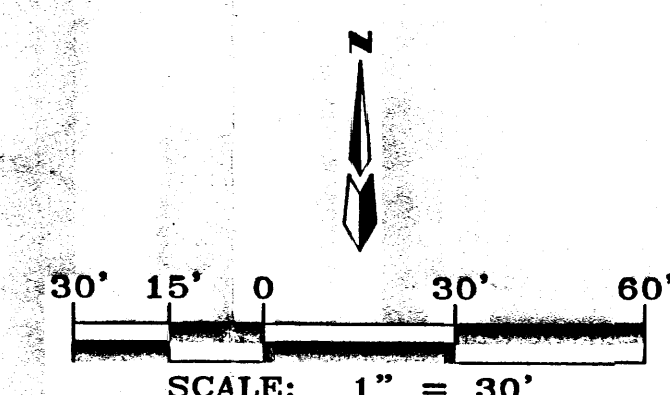

SCALE: 1" = 30'



VICINITY MAP ZONE MAP: K-9, K-10

NOTES


ADD 5100 FOR MEAN SEA LEVEL ELEVATIONS

LEGAL DESCRIPTION

LOTS 10, 11, & 12, BLOCK 2
CLIFFORD WEST BUSINESS PARK, UNIT 1

LEGEND

- EXISTING ELEVATION AT GROUND
- EXISTING SEWER MANHOLE
- EXISTING DRAINAGE MANHOLE
- EXISTING WATER METER
- EXISTING WATER VALVE
- EXISTING SEWER SERVICE
- EXISTING TELEPHONE RISER
- EXISTING CABLE TV RISER
- EXISTING FIRE HYDRANT
- EXISTING DROP INLET
- EXISTING LOTS
- EXISTING CURB & GUTTER
- EXISTING WATERLINE
- EXISTING SAS
- EXISTING STORMDRAIN
- EXISTING EASEMENT
- NEW CURB & GUTTER
- NEW BUILDING
- NEW SWALE
- NEW STORM DRAIN
- NEW SPOT ELEVATION
- NEW FLOW
- NEW CONCRETE
- EXTENT OF 100 YR FLOOD PONDING AREA
- NEW SUBBASIN BOUNDARY
- CURB HEIGHT VARIES FROM 8" TO 1.5'

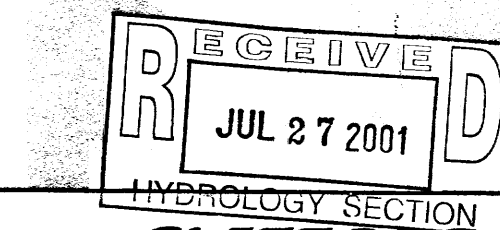


CLIFF WEST CHURCH GRADING & DRAINAGE PLAN



MARK GOODWIN & ASSOCIATES, P.A.
CONSULTING ENGINEERS
P.O. BOX 90606
ALBUQUERQUE, NEW MEXICO 87199
(505)828-2200, FAX (505)797-9539

Designed: DLH Drawn: ACH Checked: DMG
Scale: 1" = 30' Date: 02-08-01 Job: A01021 Sheet 1 of 1

A01021CLC/1021GD30_R2/07-24-01/ACH NHM SPS DLH

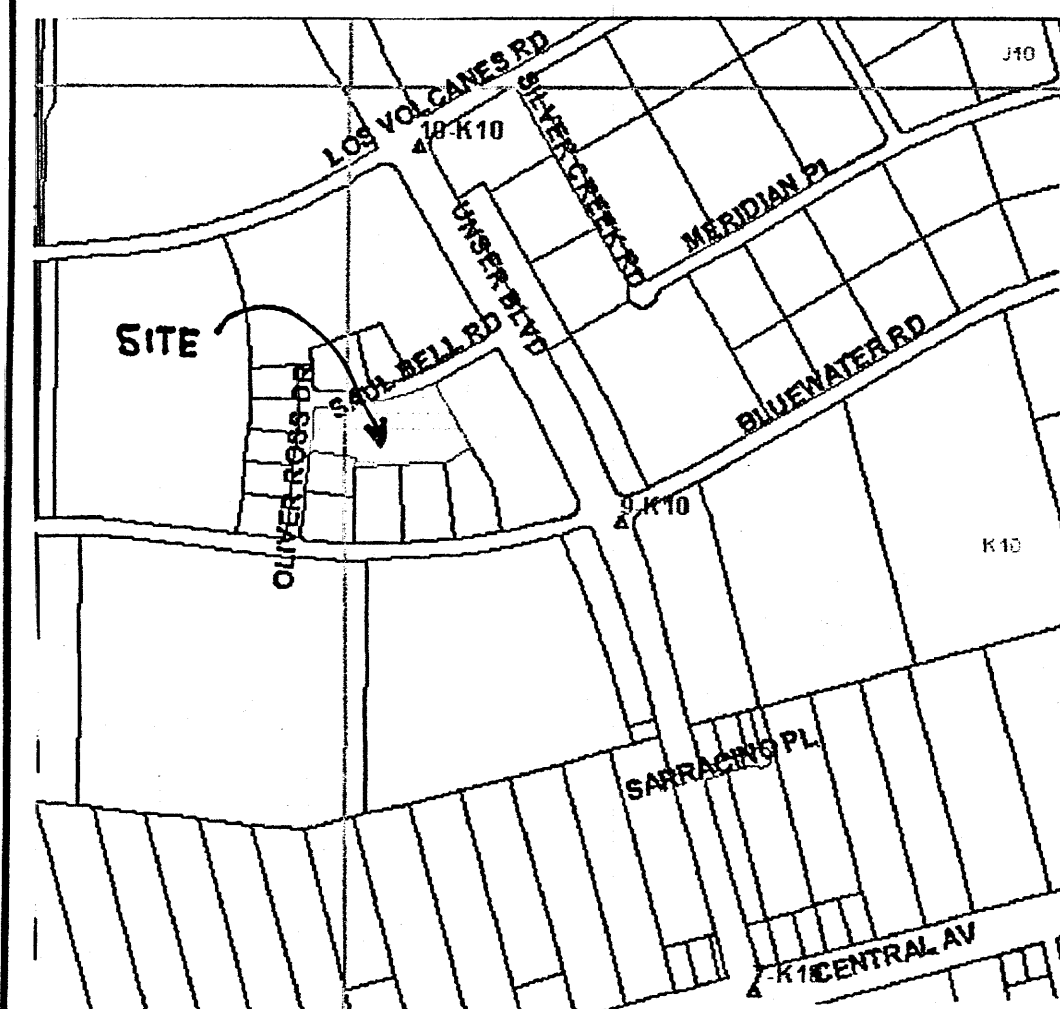

VICINITY MAP K-10 FIRM PANEL 0328D

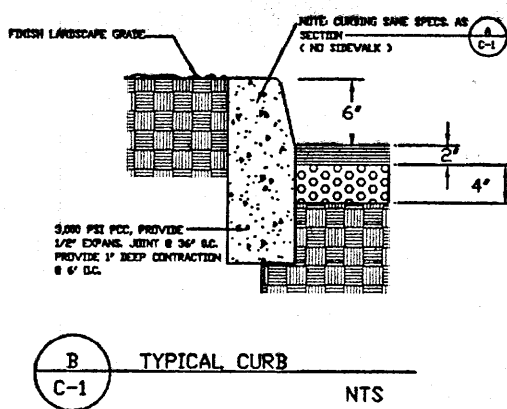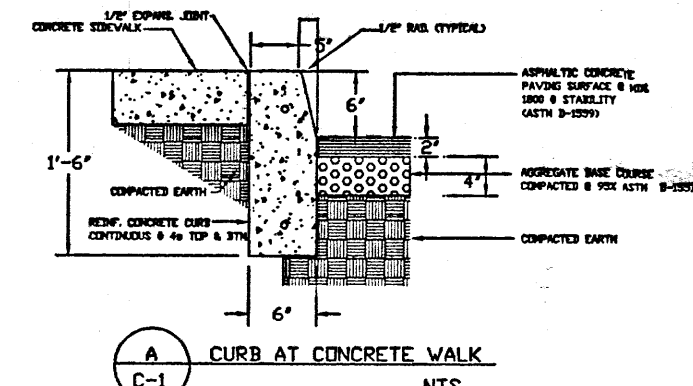

NOTE TO CONTRACTOR:

1. An excavation/construction permit will be required before beginning any work within the City right-of-way. Approved copy of this plan must be submitted at the time of application for permit.
2. All work detailed in this plan to be performed, except as otherwise stated or provided hereon, shall be constructed in accordance with City of Albuquerque Standard Specification for Public Works Construction.
3. Two working days prior to any excavation, contractor must contact line locating Services (760-1990) for locating existing sub-surface utilities.
4. Prior to construction, the contractor shall excavate and verify the horizontal and vertical location of all potential constructions; Should a conflict exist, the contractor shall notify the engineer so that the conflict can be resolved with a minimum amount of delay to the subject project.
5. Backfill compaction shall be according to commercial use or soils report(s) recommendations.
6. All work on this project shall be performed in accordance with applicable Federal, State and local laws, rules and regulations concerning construction safety and health.
7. Maintenance of this facilities shall be the responsibility of the owner of the property it serves

GRADING/PAVING PLAN

THE FOLLOWING ITEMS CONCERNING LOT 10A BLOCK 2 CLIFFORD WEST BUSINESS PARK UNIT 1 (8570 SAUL BELL RD. N.W.) ARE CONTAINED HEREON:

EXISTING CONDITIONS

AS SHOWN BY THE VICINITY MAP, THE SITE CONTAINS 3.393 ACRES MORE OR LESS, AND IS LOCATED AT THE SOUTHEAST CORNER OF THE INTERSECTION OF SAUL BELL RD. AND OLIVER ROSS DR. N.W. CURRENTLY THE SITE IS OCCUPIED BY A 14,375 SQ. FT. CHURCH FACILITY ALONG WITH ASSOCIATED PAVED PARKING AND LANDSCAPED AREAS. AS SHOWN BY THE FLOOD INSURANCE RATE MAP, PANEL 0328, DATED SEPTEMBER 20, 1996, THIS SITE IS LOCATED WITHIN A DESIGNATED AO FLOOD ZONE. THE MASTER DRAINAGE PLAN FOR CLIFFORD WEST BUSINESS PARK HAS ALREADY ADDRESSED THE FLOOD PLAIN ISSUE.

PROPOSED CONDITIONS

AS SHOWN BY THE GRADING/PAVING PLAN, THE PROPOSED PROJECT WILL CONSIST OF ADDITIONAL NEW ASPHALT PAVING ON THE EAST SIDE OF THE EXISTING PARKING AREA. AN ADDITIONAL 0.763 ACRES OF NEW ASPHALT PAVING IS PROPOSED. AN INCREASE OF 2,714 CF (5,456 CF - 2,742 CF = 2,714 CF) OF ADDITIONAL RUN-OFF WILL BE DEVELOPED BY CONSTRUCTING THE ADDITIONAL PAVED PARKING AREA. THE SMALL WALL DESIGNED IN THE ORIGINAL DRAINAGE PLAN TO CONTAIN THE 100-YEAR, 6-HOUR VOLUME WILL BE RAISED SO AS TO ACCOMMODATE THE ADDITIONAL VOLUME. THE OUTLET FLOW RATE PER FILE NUMBER K10-D37 DRAINAGE PLAN WILL STILL REMAIN THE SAME. THE 100-YEAR WATER SURFACE WILL INCREASE SLIGHTLY. THE CALCULATIONS WHICH APPEAR HEREON, ANALYZE BOTH EXISTING AND DEVELOPED CONDITIONS FOR THE 100-YEAR, 6-HOUR RAINFALL EVENT. THE PROCEDURE FOR 40-ACRES AND SMALLER BASINS, AS SET FORTH IN THE REVISION OF SECTION 22.2 WAS USED TO QUANTIFY THE PEAK RATE OF DISCHARGE AND VOLUME OF RUN-OFF GENERATED.

PROJECT AREA = 0.763 ac.
FELLOWSHIP MISSIONARY BAPTIST CHURCH (ADDITIONAL PARKING)
ZONE 1
PRECIPITATION: 360 = 2.20 in.
1440 = 2.66 in.
10day = 3.67 in.

TREATMENT	EXCESS PRECIPITATION:	PEAK DISCHARGE:
TREATMENT A	0.44 in.	1.29 cfs/ac.
TREATMENT B	0.67 in.	2.03 cfs/ac.
TREATMENT C	0.99 in.	2.87 cfs/ac.
TREATMENT D	1.97 in.	4.37 cfs/ac.

TREATMENT	EXISTING CONDITIONS:	PROPOSED CONDITIONS:
TREATMENT A	0 ac.	0 ac.
TREATMENT B	0 ac.	10 ac.
TREATMENT C	0.763 ac.	0 ac.
TREATMENT D	0 ac.	0.763 ac.

EXISTING EXCESS PRECIPITATION:
Weighted E = (0.44) x (0.00) + (0.67) x (0.00) + (0.99) x (0.76) + (1.97) x (0.00) / 0.76 ac.
= 0.99 in.
V100-360 = (0.99) x (0.76) / 12 = 0.062948 ac-ft = 2742 CF


EXISTING PEAK DISCHARGE:
Q100 = (1.29) x (0.00) + (2.03) x (0.00) + (2.87) x (0.76) + (4.37) x (0.00) = 2.19 CFS

PROPOSED EXCESS PRECIPITATION:
Weighted E = (0.44) x (0.00) + (0.67) x (0.00) + (0.99) x (0.00) + (1.97) x (0.76) / 0.76 ac.
= 1.97 in.
V100-360 = (1.97) x (0.76) / 12.0 = 0.125259 ac-ft = 5456 CF
V100-1440 = (0.13) + (0.76) x (2.66 - 2.20) / 12 = 0.154508 ac-ft = 6730 CF
V100-10day = (0.13) + (0.76) x (3.67 - 2.20) / 12 = 0.218727 ac-ft = 9528 CF

PROPOSED PEAK DISCHARGE:
Q100 = (1.29) x (0.00) + (2.03) x (0.00) + (2.87) x (0.00) + (4.37) x (0.76) = 3.33 CFS
INCREASE 3.33 CFS - 2.19 CFS = 1.13 CFS

EROSION CONTROL MEASURES:

1. THE CONTRACTOR SHALL BE HELD RESPONSIBLE FOR MANAGEMENT OF STORM RUN-OFF DURING CONSTRUCTION, HE SHALL ASSURE THAT THE FOLLOWING MEASURES ARE TAKEN:
 - A. ADJACENT PROPERTY SHALL BE PROTECTED AT ALL TIMES BY TEMPORARY BERMS, DIKES, SWALES, AND OTHER TEMPORARY GRADING AS REQUIRED TO PREVENT STORM RUN-OFF FROM LEAVING THE SITE AND ENTERING ADJACENT PROPERTIES.
 - B. ADJACENT PUBLIC RIGHT-OF-WAY SHALL BE PROTECTED AT ALL TIMES FROM STORM WATER RUN-OFF FROM THE SITE. NO SEDIMENT BEARING WATER SHALL BE PERMITTED TO ENTER THE PUBLIC STREETS.
2. THE CONTRACTOR SHALL IMMEDIATELY AND THOROUGHLY REMOVE ANY OR ALL SEDIMENT WITHIN THE PUBLIC STREETS THAT HAVE BEEN ERODED FROM THE SITE AND DEPOSITED THEREON.

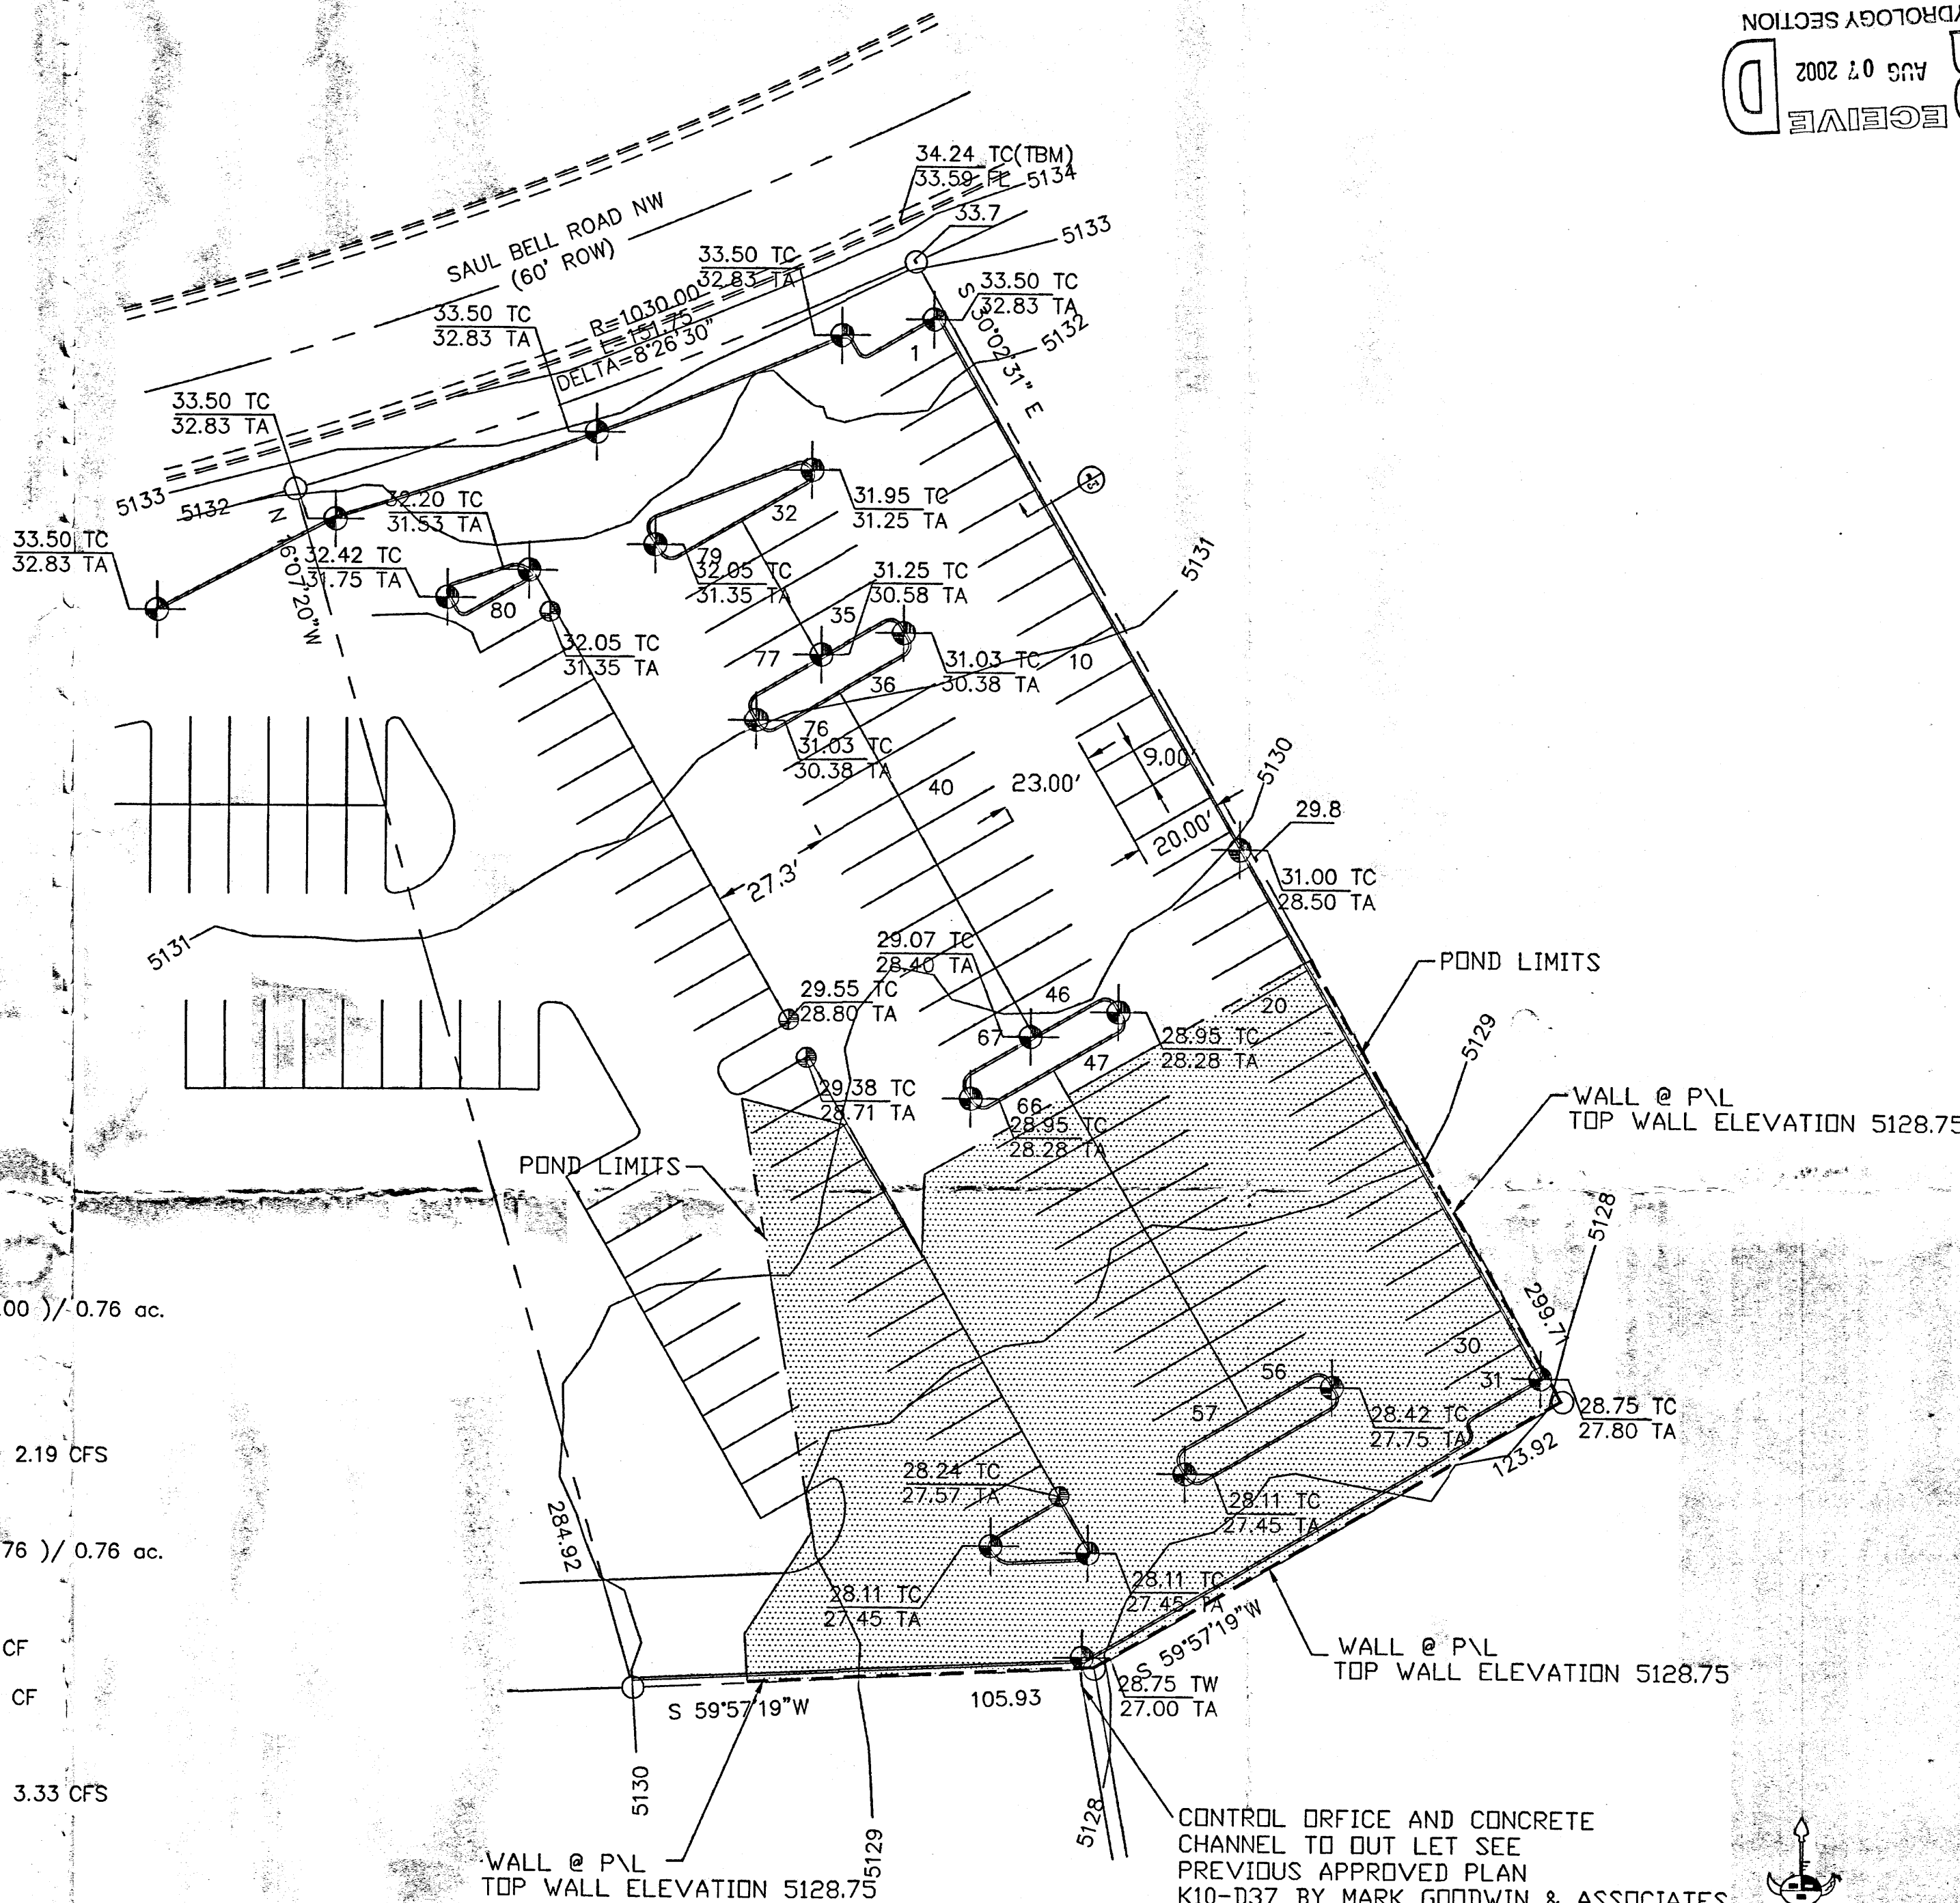

SYMBOL LEGEND

EXISTING CONTOUR — 5129
PROPOSED CONTOUR — 27.00
PROPOSED SPOT ELEVATION — 27.50
EXISTING SPOT ELEVATION —

ABBREVIATION LEGEND

TOP OF CURB — TC = 27.25
FLOWLINE — FL = 26.57
TOP OF WALL — TW = 29.00
EXISTING OR PROPOSED CONCRETE SURFACE


LEGAL DESCRIPTION

A PORTION OF LOT 10A, BLCK 2, CLIFFORD WEST BUSINESS PARK, UNIT 1 BERNALILLO COUNTY, ALBUQUERQUE NEW MEXICO.

BENCHMARK:

TOP OF EXISTING CURB AT THE NORTHEAST CORNER OF SITE
ELEVATION: 5134.24 (M.S.L.).

RECEIVED
AUG 07 2002
HYDROLOGY SECTION

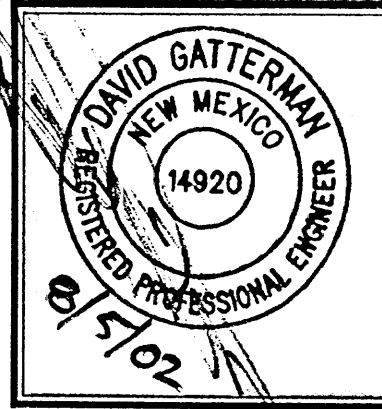

JOB NO:	
DATE:	JULY 2002
REVISIONS	

Sheet Title
GRADING/PAVING PLAN
Drawn By: BUM & HH
Checked By: BUM & HH

ADDITIONAL PARKING

Project Name
FELLOWSHIP MISSIONARY BAPTIST CHURCH
8570 SAUL BELL RD. NW
ALBUQUERQUE, NEW MEXICO

SHEET NO.
GP

DRAINAGE PLAN

THIS PROJECT IS PART OF THE APPROVED CLIFFORD WEST BUSINESS PARK MASTER DRAINAGE PLAN (K10-D23) DATED 9-17-97. THE BACKBONE STORM SEWER SYSTEM HAS BEEN BUILT AND ACCEPTED BY THE CITY OF ALBUQUERQUE. AN 18" RCP STORM LATERAL STUB IS PROVIDED FOR LOT 10 AT THE WEST PROPERTY LINE APPROXIMATELY 40 FEET FROM THE SOUTHWEST PROPERTY CORNER. DRAINAGE FROM LOT 11 AND 12 IS PROVIDED THROUGH A 10" WIDE PRIVATE DRAINAGE EASEMENT LOCATED ALONG THE SOUTH PROPERTY LINE OF LOT 12 AND EXTENDING SOUTH BETWEEN LOTS 5 AND 6 TO AN EXISTING 18" RCP STORM SEWER LATERAL STUBBED AT THE RIGHT-OF-WAY LINE WITH AN INVERT AT ±17.0'.

THE ALLOWABLE DISCHARGE Q(LOT 10) = 0.63 cfs AND Q(LOT 11 & 12) = 2.05 cfs.

SUBBASIN 1: THE DEVELOPED CONDITIONS RUNOFF WILL BE RESTRICTED TO THE MAXIMUM ALLOWABLE DISCHARGE THROUGH AN ORIFICE PLATE ATTACHED TO THE END OF THE 18" RCP IN THE JUNCTION BOX. THE ONSITE DRIVEWAY WILL BE USED TO TEMPORARILY DETAIN THE RUNOFF.

SUBBASIN 2: THE DEVELOPED CONDITIONS RUNOFF WILL BE RESTRICTED TO THE MAXIMUM ALLOWABLE DISCHARGE THROUGH A RESTRICTED OPENING IN THE FLOODWALL ALONG THE SOUTH PROPERTY LINE BEFORE DISCHARGING INTO A CONCRETE CHANNEL AND THEN INTO THE EXISTING 18" RCP AS SHOWN ON THIS GRADING AND DRAINAGE PLAN.

HYDROLOGY SUMMARY (100 YEAR 6 HOUR)

P(1 HR) = 1.90"
P(6 HR) = 2.20"

	DEVELOPED Q	ALLOWABLE Q	DESIGN AREA(*)	ORIFICE OPENING SQUARE DIMENSIONS
SUBBASIN 1	3.47 cfs	0.63 cfs	0.052517 SQFT.	2.75" x 2.75"
SUBBASIN 2	9.86 cfs	2.05 cfs	0.3987 SQFT.	



FOR SINGLE "C" INLET
 $Q = C \times L \times H^{1/2}$

SIDE Q CAP = $(3.0)/(2+2+4)(0.5) \times 1.5 = 8.48$ cfs

RECORD DRAWING

I hereby certify that the information contained on this drawing has been revised in accordance with information furnished by the contractors, Custom Grading Inc. and Cambro Construction Inc., and by the surveyor, Survey Southwest Ltd., and reflects the construction as actually accomplished. This plan as constructed is in substantial compliance with the Approved Plan.

DATE: 8-28-02
DIANE HOELZER, P.E.
N.M.P.E. 11967

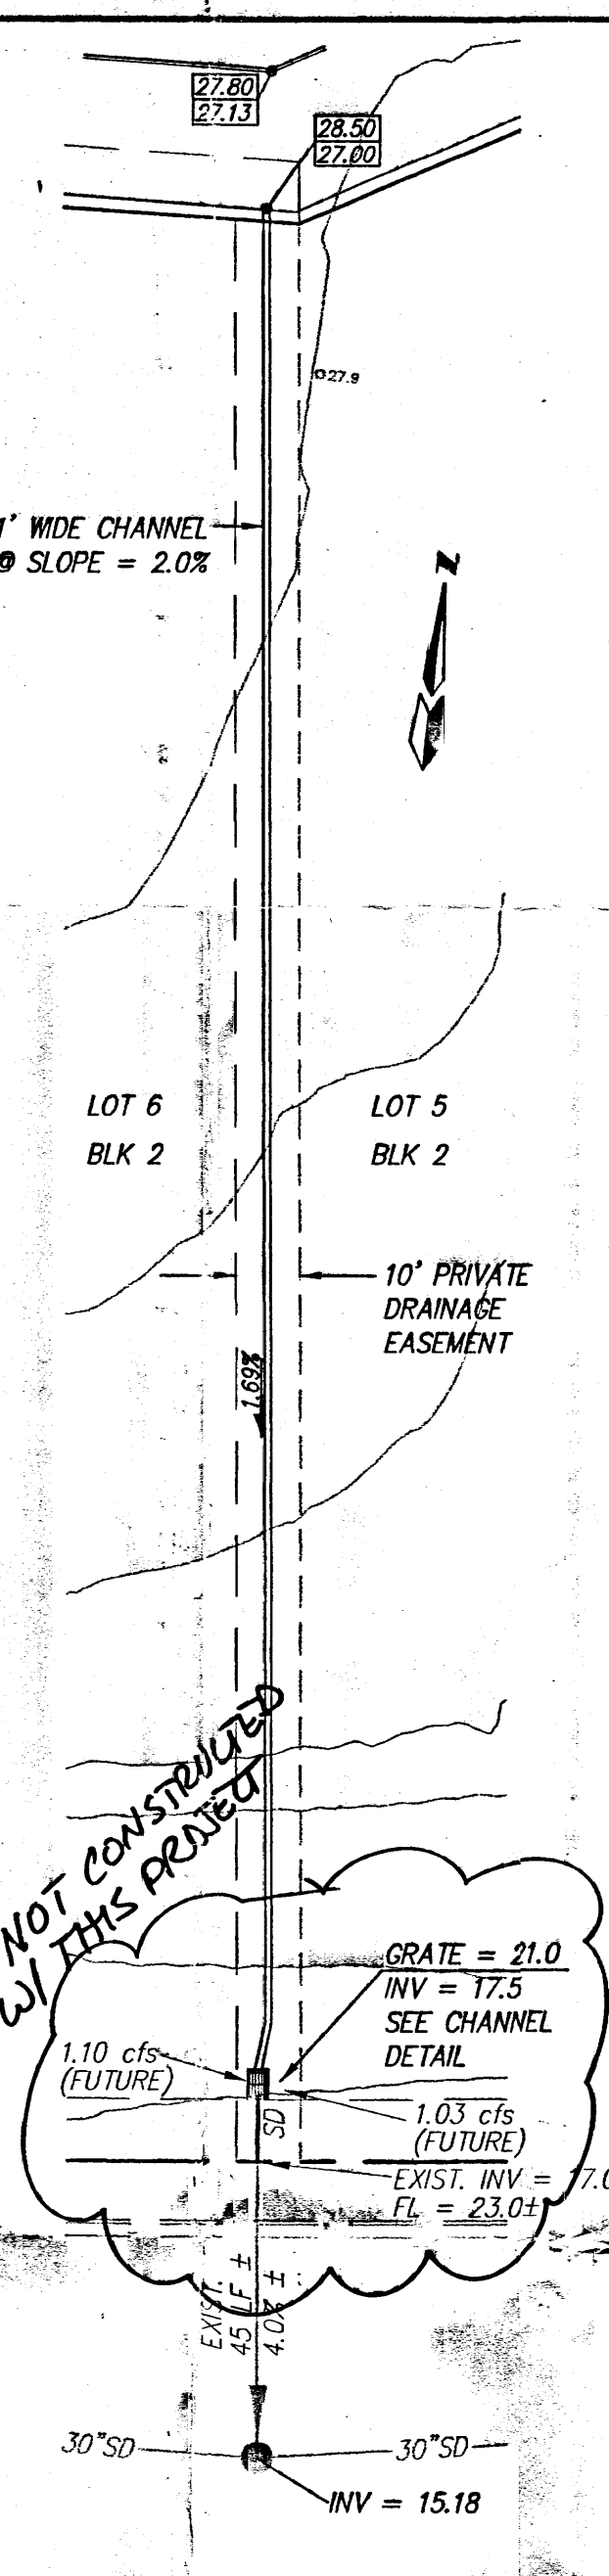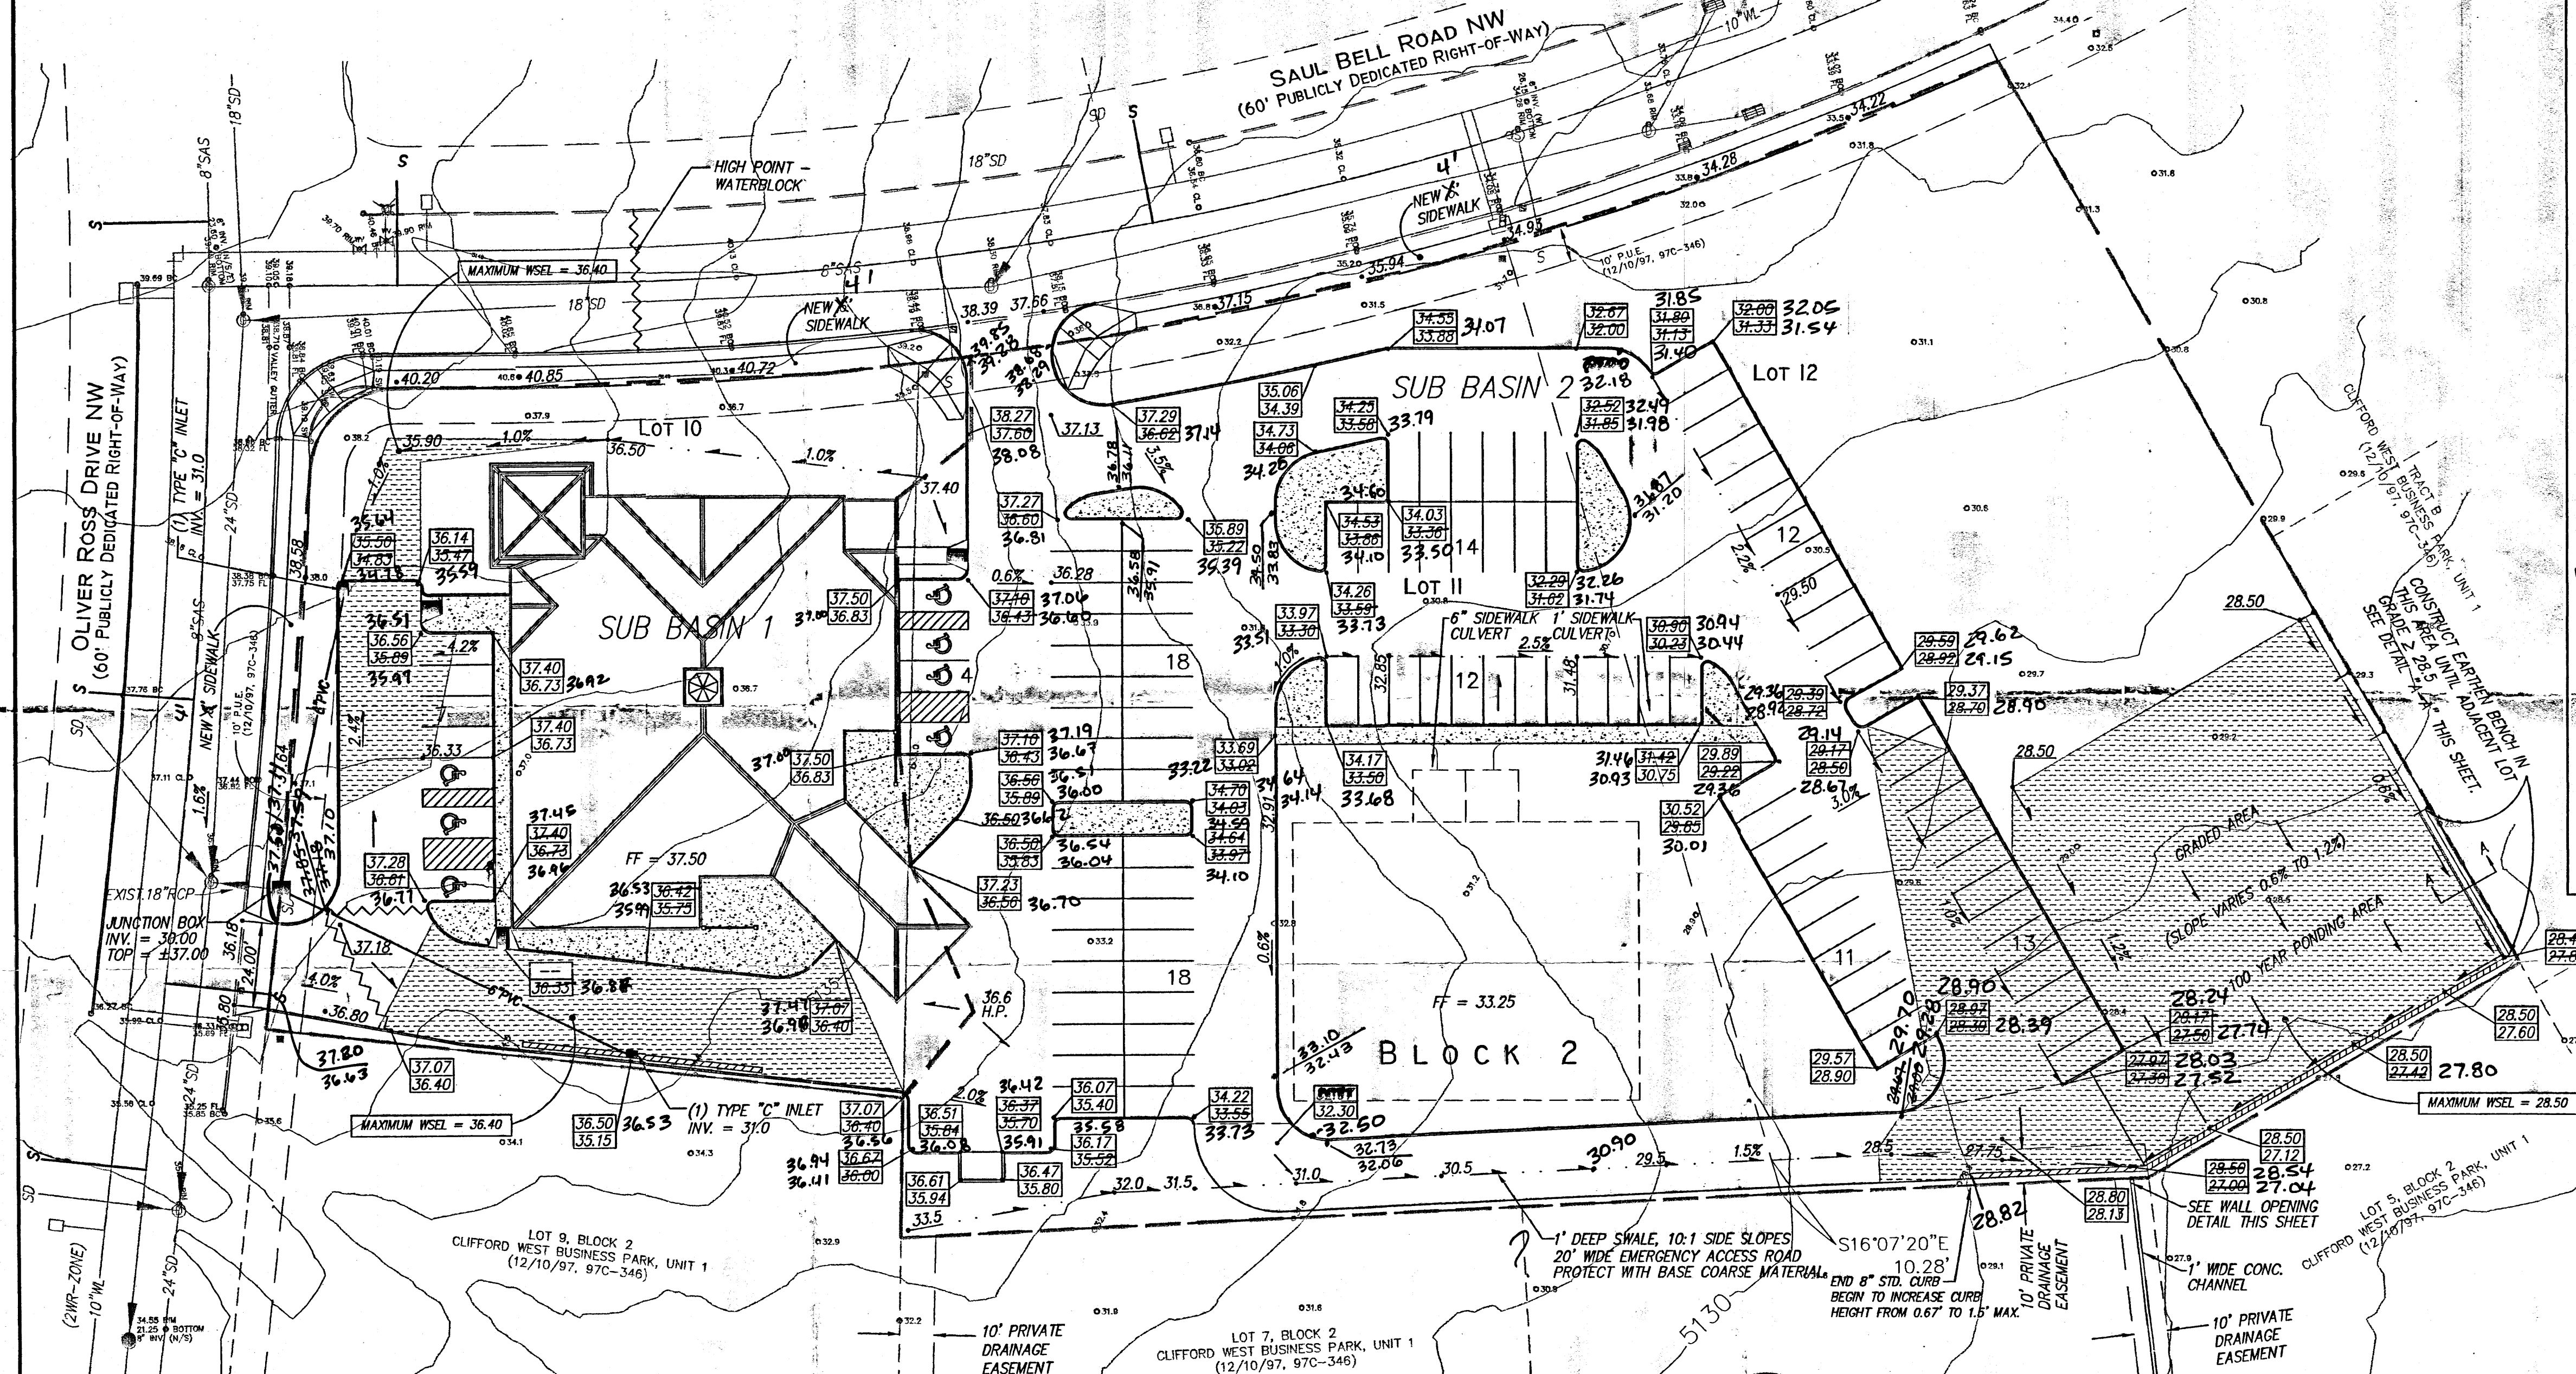

VICINITY MAP ZONE MAP: K-9, K-10

NOTES

ADD 5100 FOR MEAN SEA LEVEL ELEVATIONS

LEGAL DESCRIPTION

LOTS 10, 11, & 12, BLOCK 2
CLIFFORD WEST BUSINESS PARK, UNIT 1

LEGEND

- EXISTING ELEVATION AT GROUND
- EXISTING SEWER MANHOLE
- EXISTING DRAINAGE MANHOLE
- EXISTING WATER METER
- EXISTING WATER VALVE
- EXISTING SEWER SERVICE
- EXISTING TELEPHONE RISER
- EXISTING CABLE TV RISER
- EXISTING FIRE HYDRANT
- EXISTING DROP INLET
- EXISTING LOTS
- EXISTING CURB & GUTTER
- EXISTING WATERLINE
- EXISTING SAS
- EXISTING STORMDRAIN
- EXISTING EASEMENT
- NEW CURB & GUTTER
- NEW BUILDING
- NEW SWALE
- NEW STORM DRAIN
- NEW SPOT ELEVATION
- NEW FLOW
- NEW CONCRETE
- EXTENT OF 100 YR FLOOD PONDING AREA
- NEW SUBBASIN BOUNDARY
- CURB HEIGHT VARIES FROM 8" TO 1.5'


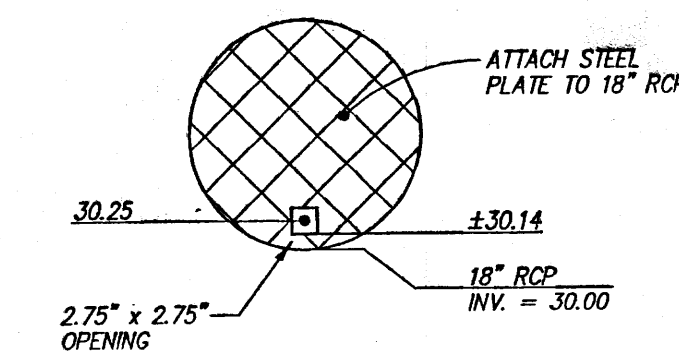



PLATE DETAIL FOR JUNCTION BOX

NTS

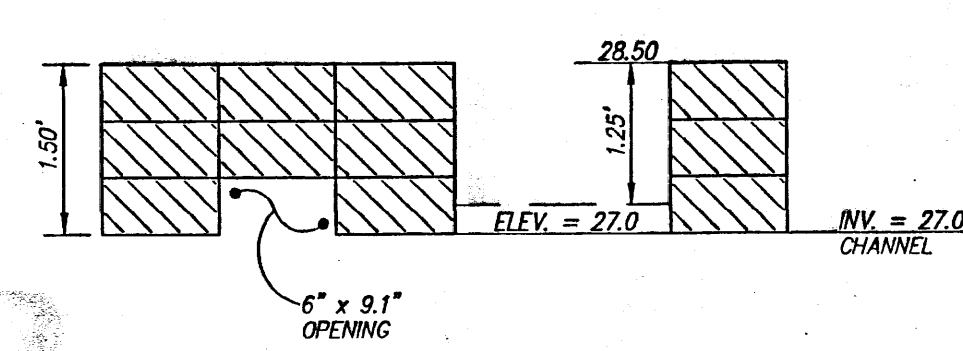

WALL OPENING DETAIL

NTS

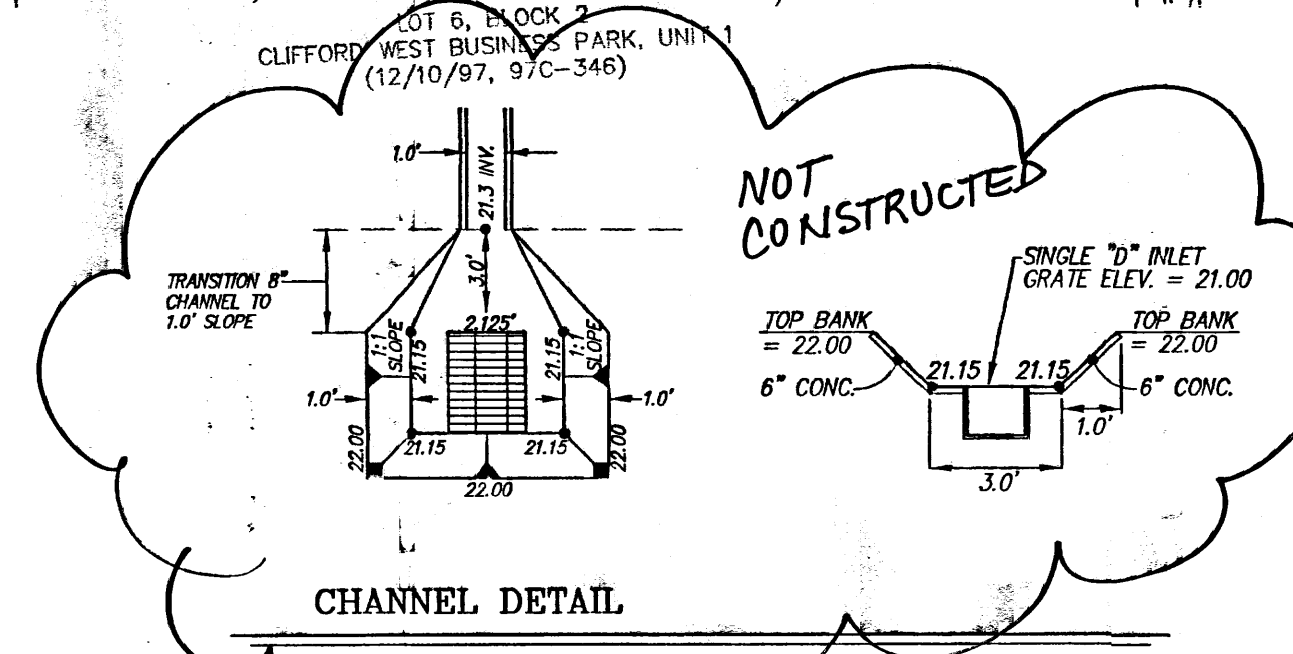


CHANNEL DETAIL

NTS

CHANNEL DETAIL

NTS

DETAIL A-A
SCALE: 1" = 5'

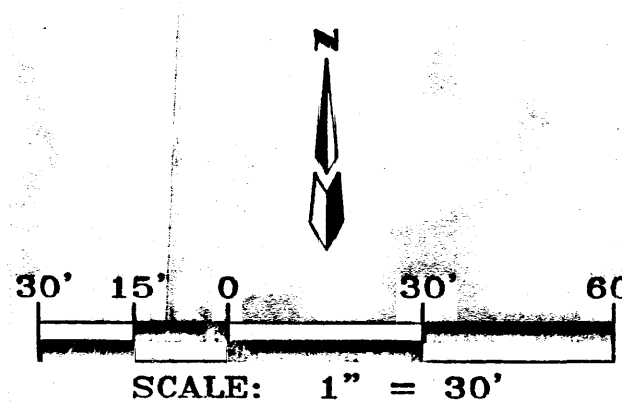

CLIFFORD WEST CHURCH GRADING & DRAINAGE PLAN

MARK GOODWIN & ASSOCIATES, P.A.
CONSULTING ENGINEERS
P.O. BOX 90606
ALBUQUERQUE, NEW MEXICO 87199
(505)828-2200, FAX (505)797-9539

Designed: DLH Drawn: ACH Checked: DMG Sheet 1 of 1
Scale: 1" = 30' Date: 02-08-01 Job: A01021

NO 40. UNIL OUTLET CONSTRUCTION
CHANNEL COMPUTED & SWALE
EMERGENCY ROAD CONSTRUCTION

DRAINAGE PLAN

THIS PROJECT IS PART OF THE APPROVED CLIFFORD WEST BUSINESS PARK MASTER DRAINAGE PLAN (KTO-023) DATED 9-17-97. THE BACKBONE STORM SEWER SYSTEM HAS BEEN BUILT AND ACCEPTED BY THE CITY OF ALBUQUERQUE. AN 18" RCP STORM LATERAL IS PROVIDED FOR LOT 10 AT THE WEST PROPERTY LINE APPROXIMATELY 40 FEET FROM THE SOUTHWEST PROPERTY CORNER. DRAINAGE FROM LOT 11 AND 12 IS PROVIDED THROUGH A 10" WIDE PRIVATE DRAINAGE EASEMENT LOCATED ALONG THE SOUTH PROPERTY LINE OF LOT 12 AND EXTENDING SOUTH BETWEEN LOTS 5 AND 6 TO AN EXISTING 18" RCP STORM SEWER LATERAL STUBBED AT THE RIGHT-OF-WAY LINE WITH AN INVERT = ±17.0'.

THE ALLOWABLE DISCHARGE Q(LOT 10) = 0.63 cfs AND Q(LOT 11 & 12) = 2.05 cfs.

SUBBASIN 1: THE DEVELOPED CONDITIONS RUNOFF WILL BE RESTRICTED TO THE MAXIMUM ALLOWABLE DISCHARGE THROUGH AN ORIFICE PLATE ATTACHED TO THE END OF THE 18" RCP IN THE JUNCTION BOX. THE ONSITE DRIVEWAY WILL BE USED TO TEMPORARILY DETAIN THE RUNOFF.

SUBBASIN 2: THE DEVELOPED CONDITIONS RUNOFF WILL BE RESTRICTED TO THE MAXIMUM ALLOWABLE DISCHARGE THROUGH A RESTRICTED OPENING IN THE FLOODWALL ALONG THE SOUTH PROPERTY LINE BEFORE DISCHARGING INTO A CONCRETE CHANNEL AND THEN INTO THE EXISTING 18" RCP AS SHOWN ON THIS GRADING AND DRAINAGE PLAN.

HYDROLOGY SUMMARY (100 YEAR 6 HOUR)

P(1 HR) = 1.90"
P(6 HR) = 2.20"

	DEVELOPED Q	ALLOWABLE Q	DESIGN AREA(*)	ORIFICE OPENING SQUARE DIMENSIONS
SUBBASIN 1	3.47 cfs	0.63 cfs	0.052517 SQFT.	2.75" x 2.75"
SUBBASIN 2	9.86 cfs	2.05 cfs	0.3987 SQFT.	

(*) ORIFICE EQN: $Q = 0.6x(AREA)(2x32.2xH)^{1/2}$


FOR SINGLE "C" INLET
 $Q = C \times L \times H^{3/2}$

SIDE Q CAP = $(3.0)(2+2+4)(0.5)^{1/2} = 5.48$ cfs



RECORD DRAWING

I hereby certify that the information contained on this drawing has been revised in accordance with information furnished by the contractors, Custom Grading Inc. and Cambro Construction Inc., and by the surveyor, Survey Southwest Ltd., and reflects the construction as actually accomplished. This plan as constructed is in substantial compliance with the approved plan.

DAVE HOELZER 8-28-02
Diane Hoelzer, R.E.
NMPE 11967

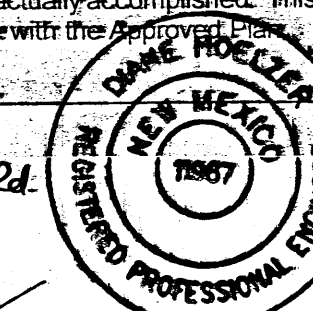

Swale in emergency access Rd.
9-25-02

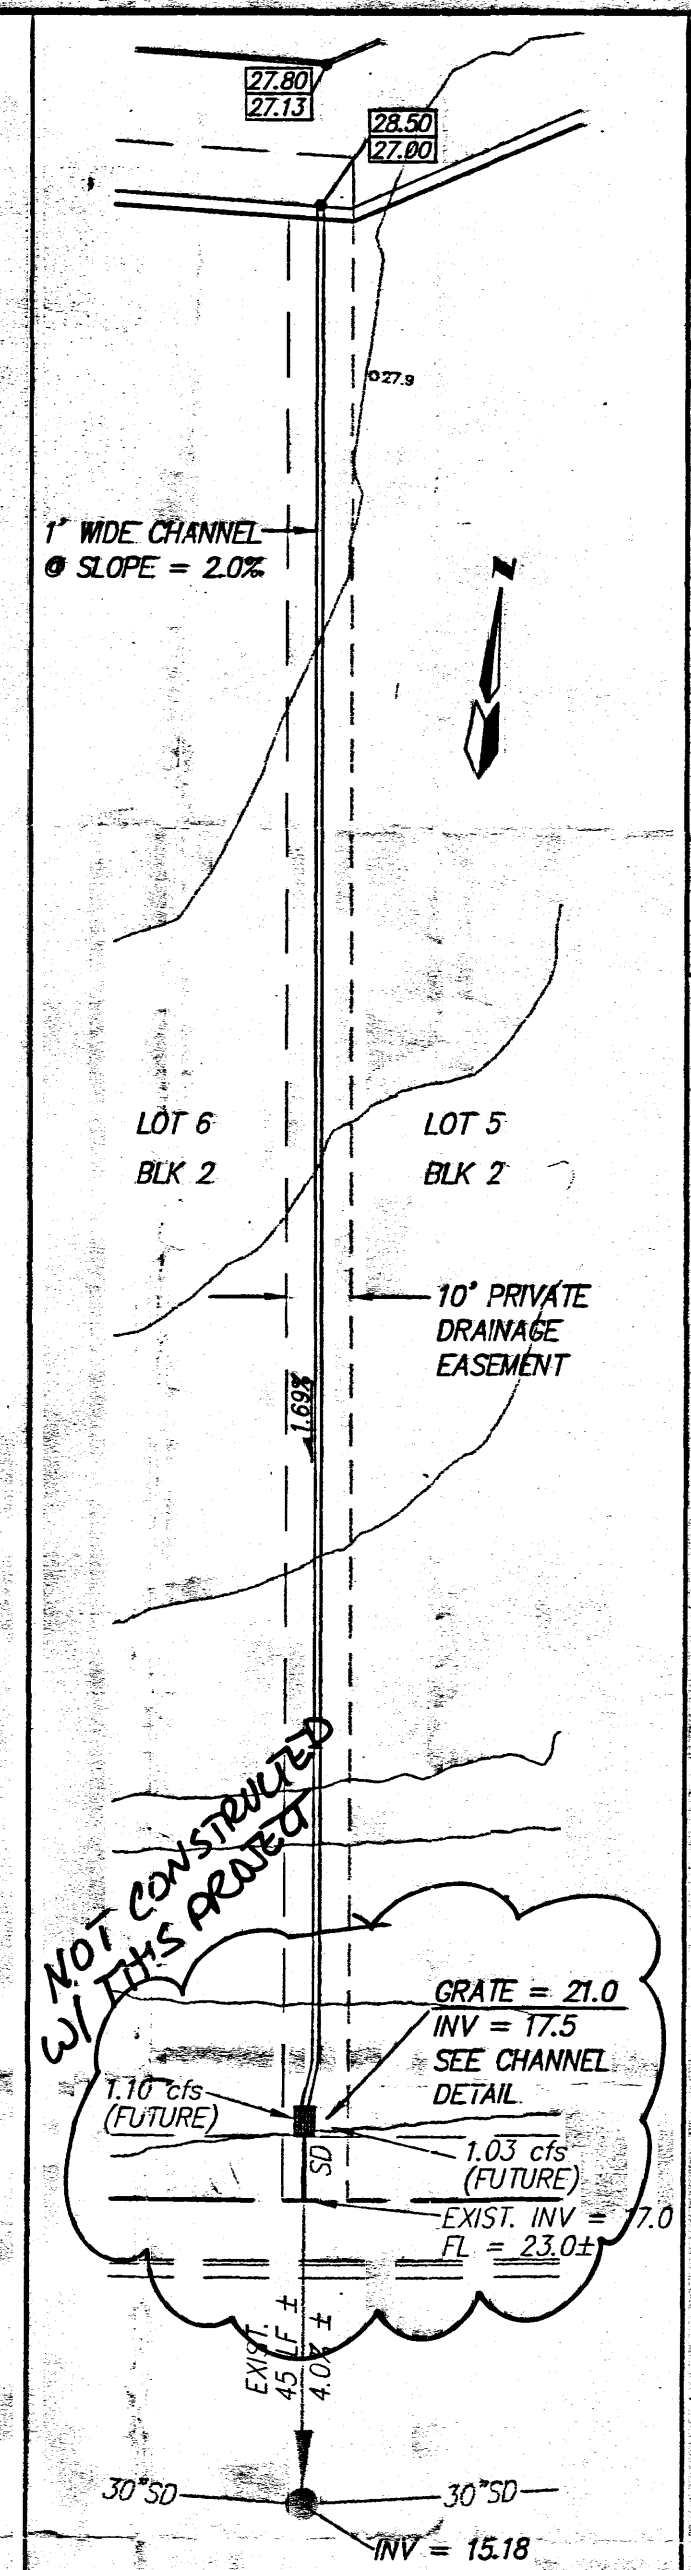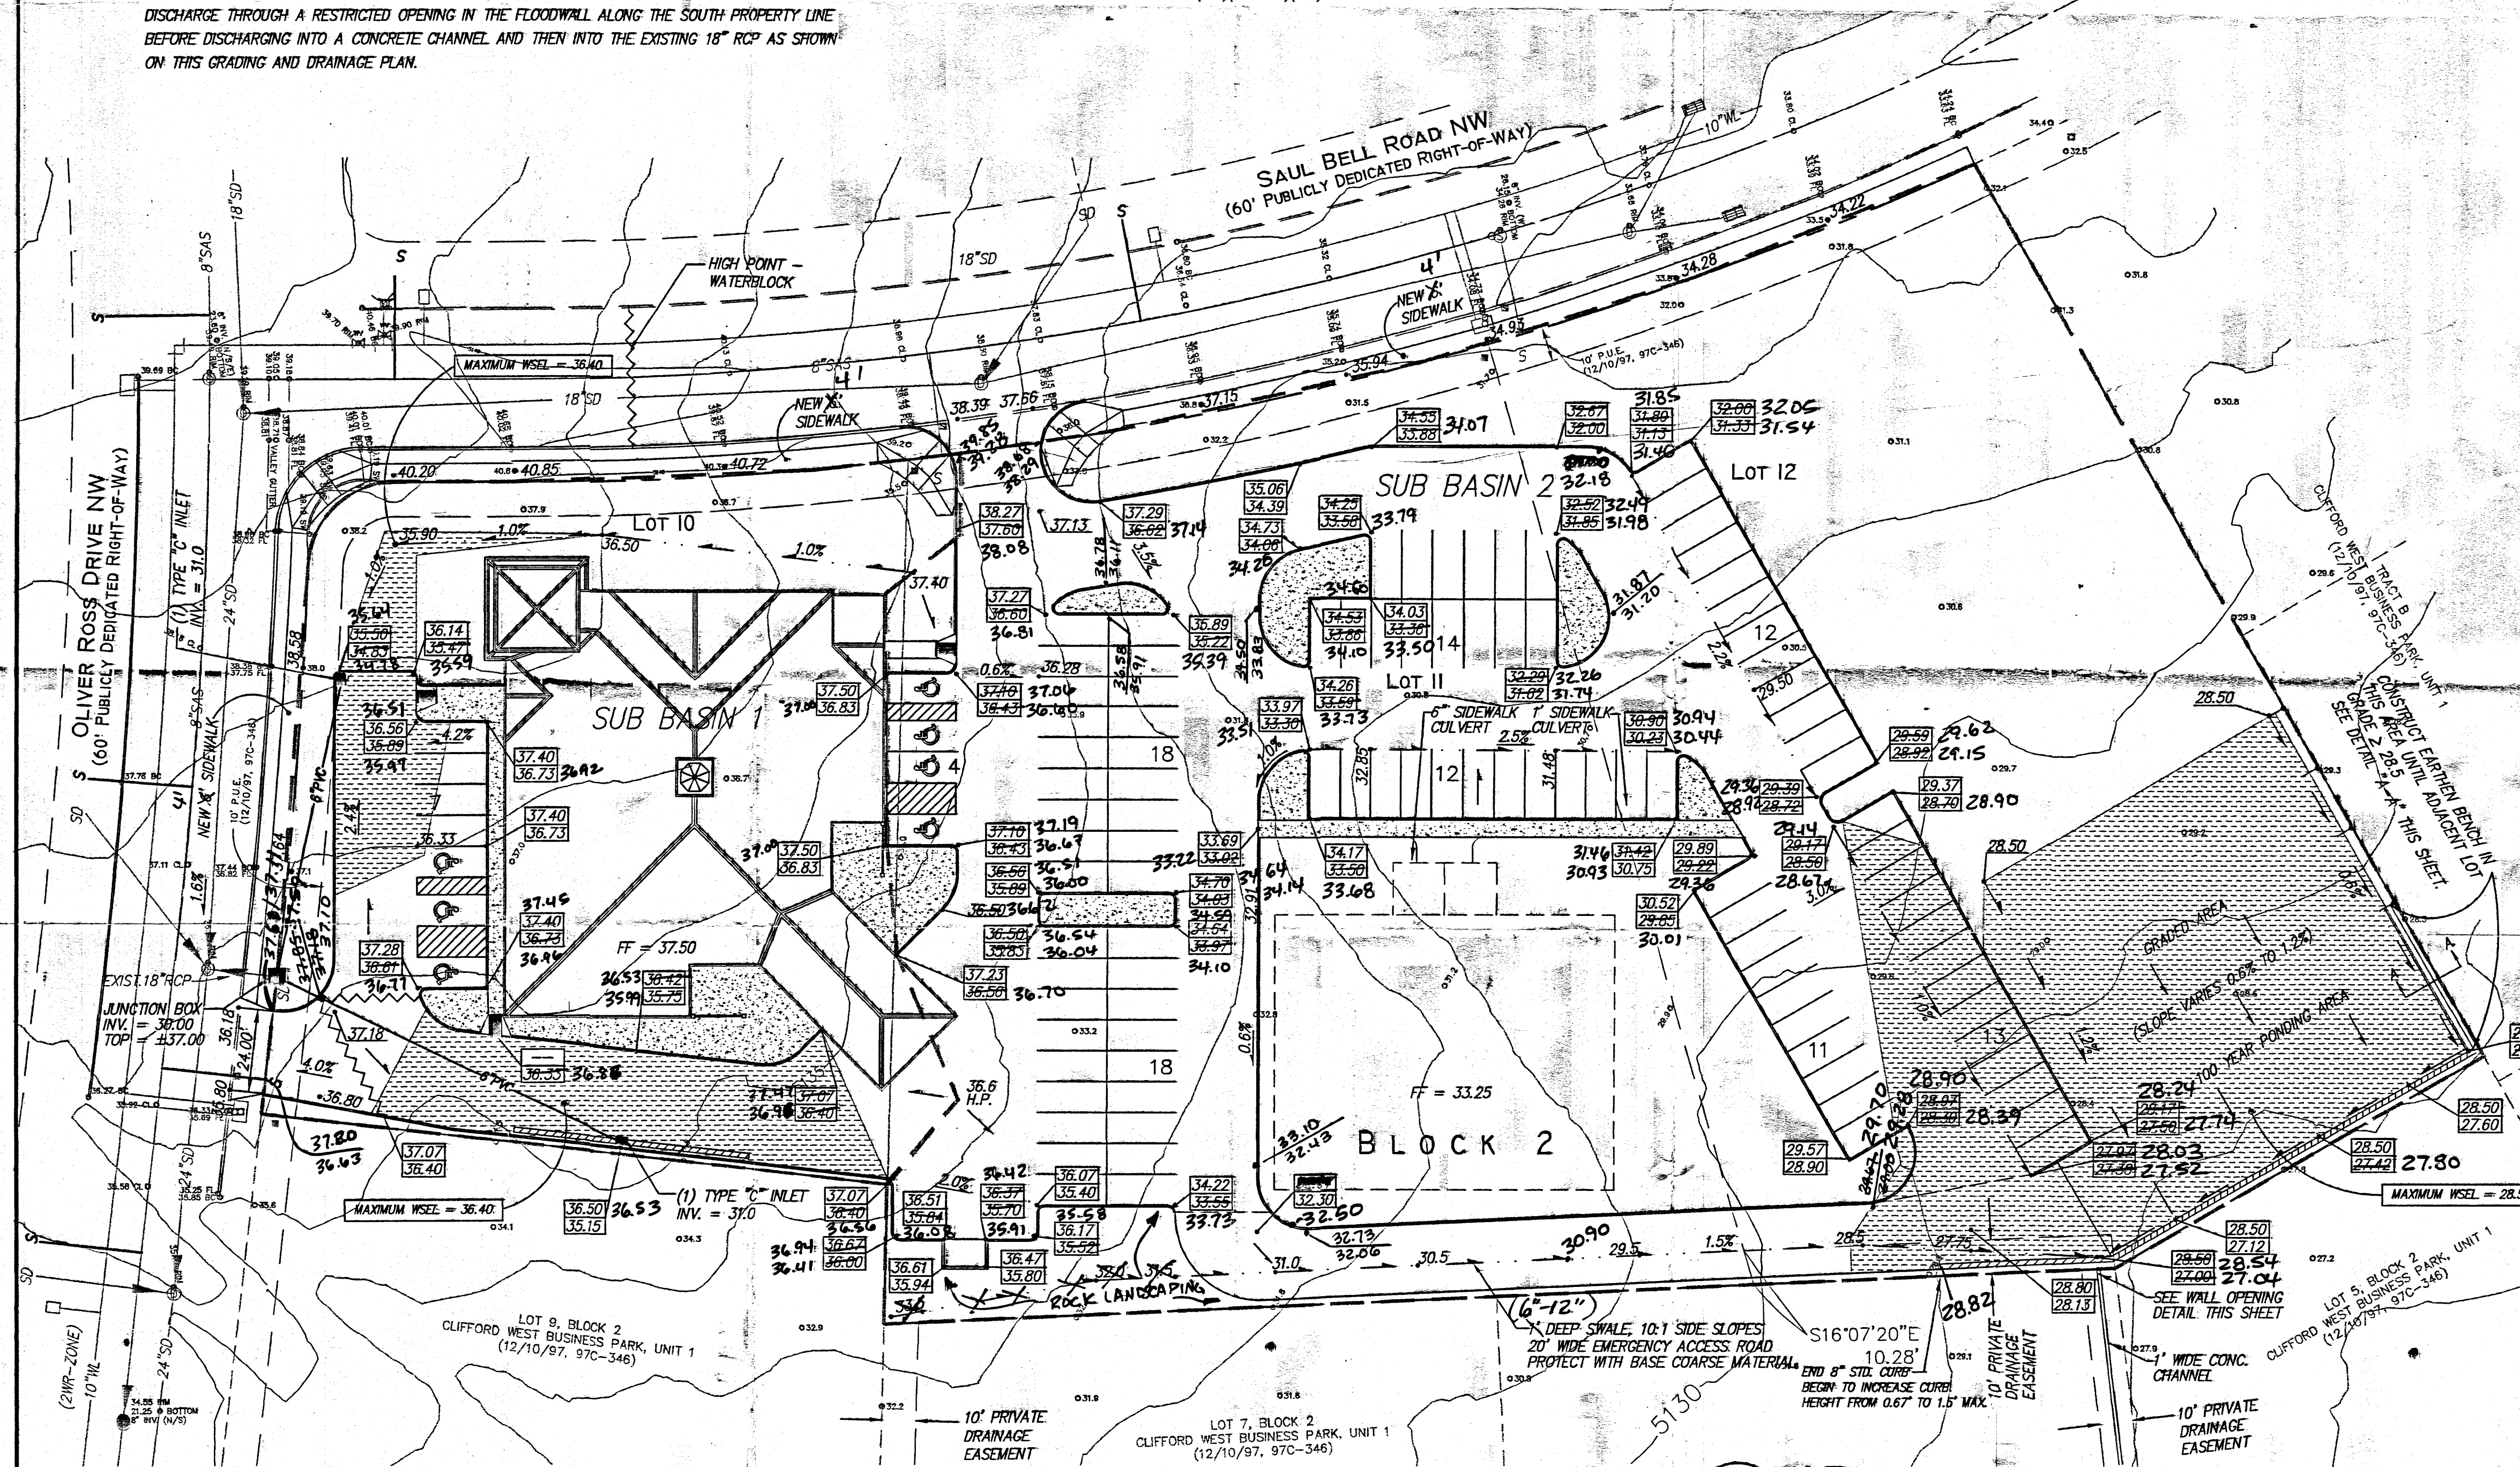

VICINITY MAP ZONE MAP: K-9, K-10

NOTES

ADD 5100 FOR MEAN SEA LEVEL ELEVATIONS


LEGAL DESCRIPTION

LOTS 10, 11, & 12, BLOCK 2
CLIFFORD WEST BUSINESS PARK, UNIT 1

LEGEND

- EXISTING ELEVATION AT GROUND
- EXISTING SEWER MANHOLE
- EXISTING DRAINAGE MANHOLE
- EXISTING WATER METER
- EXISTING WATER VALVE
- EXISTING SEWER SERVICE
- EXISTING TELEPHONE RISER
- EXISTING CABLE TV RISER
- EXISTING FIRE HYDRANT
- EXISTING DROP INLET
- EXISTING LOTS
- EXISTING CURB & GUTTER
- EXISTING WATERLINE
- EXISTING SAS
- EXISTING STORMDRAIN
- EXISTING EASEMENT
- NEW CURB & GUTTER
- NEW BUILDING
- NEW SWALE
- NEW STORM DRAIN
- NEW SPOT ELEVATION
- NEW FLOW
- NEW CONCRETE
- EXTENT OF 100 YR FLOOD PONDING AREA
- NEW SUBBASIN BOUNDARY
- CURB HEIGHT VARIES FROM 8" TO 15"

DETAIL A-A
SCALE: 1" = 5'

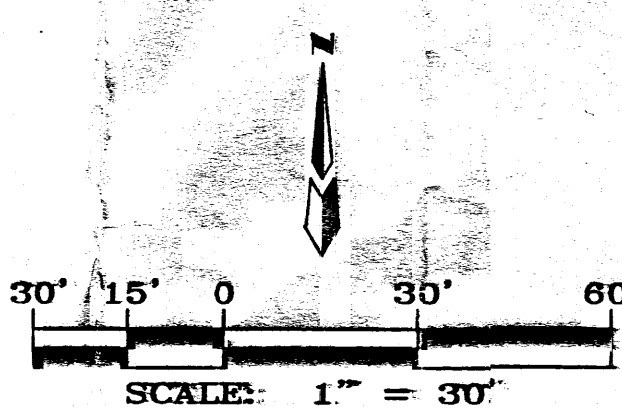


CLIFFORD WEST CHURCH GRADING & DRAINAGE PLAN

MARK GOODWIN & ASSOCIATES, P.A.
CONSULTING ENGINEERS
P.O. BOX 90606
ALBUQUERQUE, NEW MEXICO 87199
(505) 828-2200, FAX: (505) 797-9539

Designed: DLH Drawn: ACB Checked: DMG
Scale: 1" = 30' Date: 02-08-07 Job: A02021 Sheet 1 of 1


RECEIVED
SEP 25 2002
HYDROLOGY SECTION

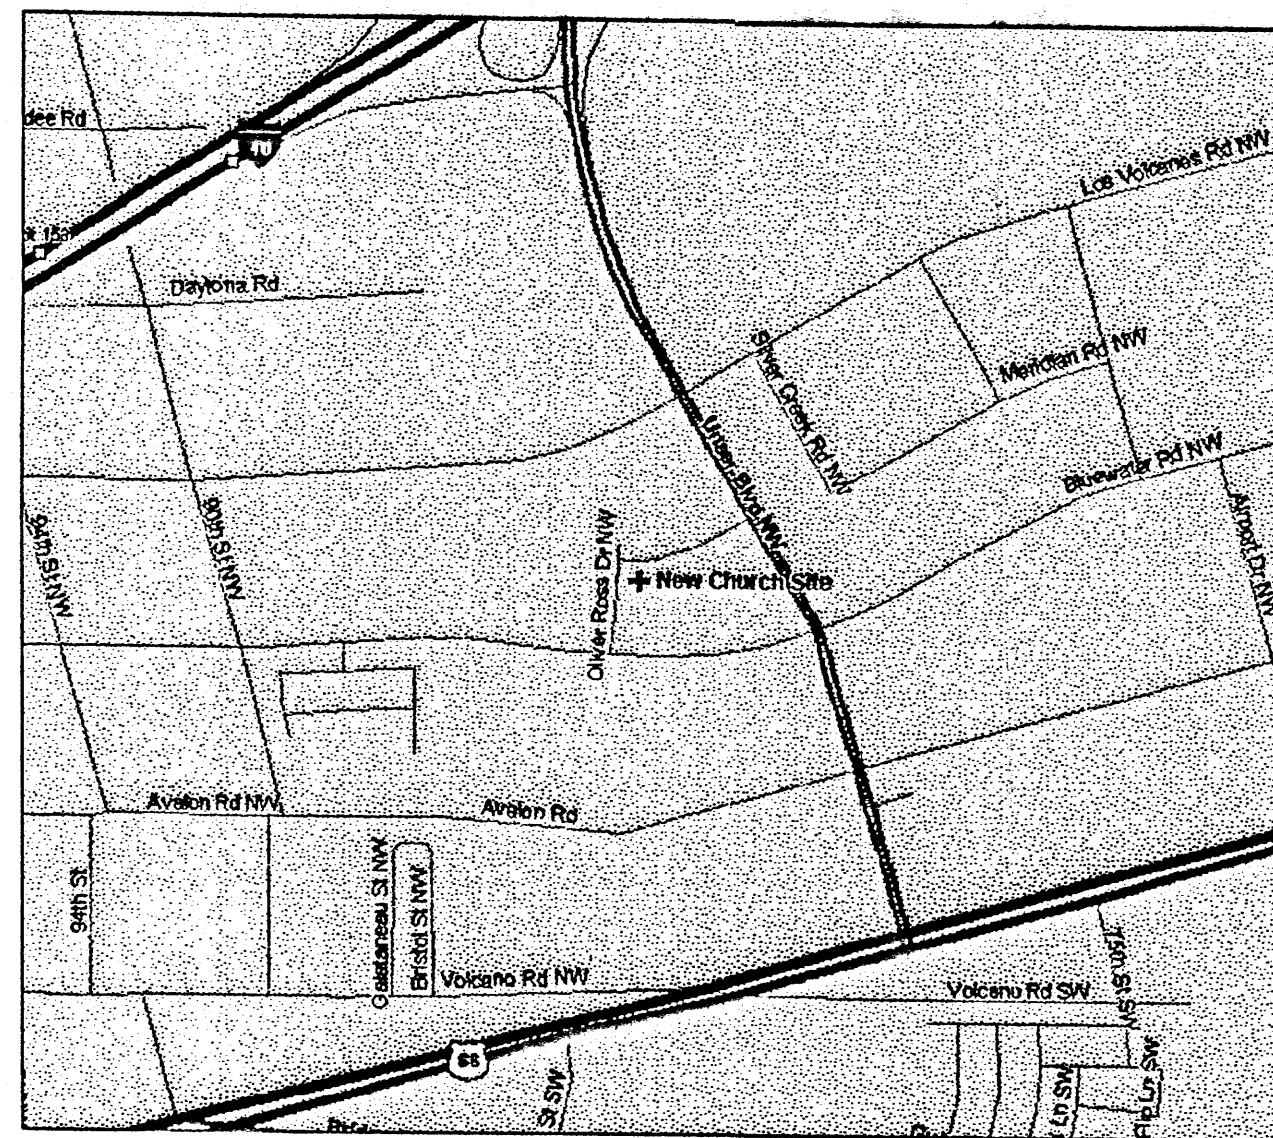

NO SITE SIGNAGE

OLIVER ROSS DRIVE NW

SAUL BELL ROAD NW

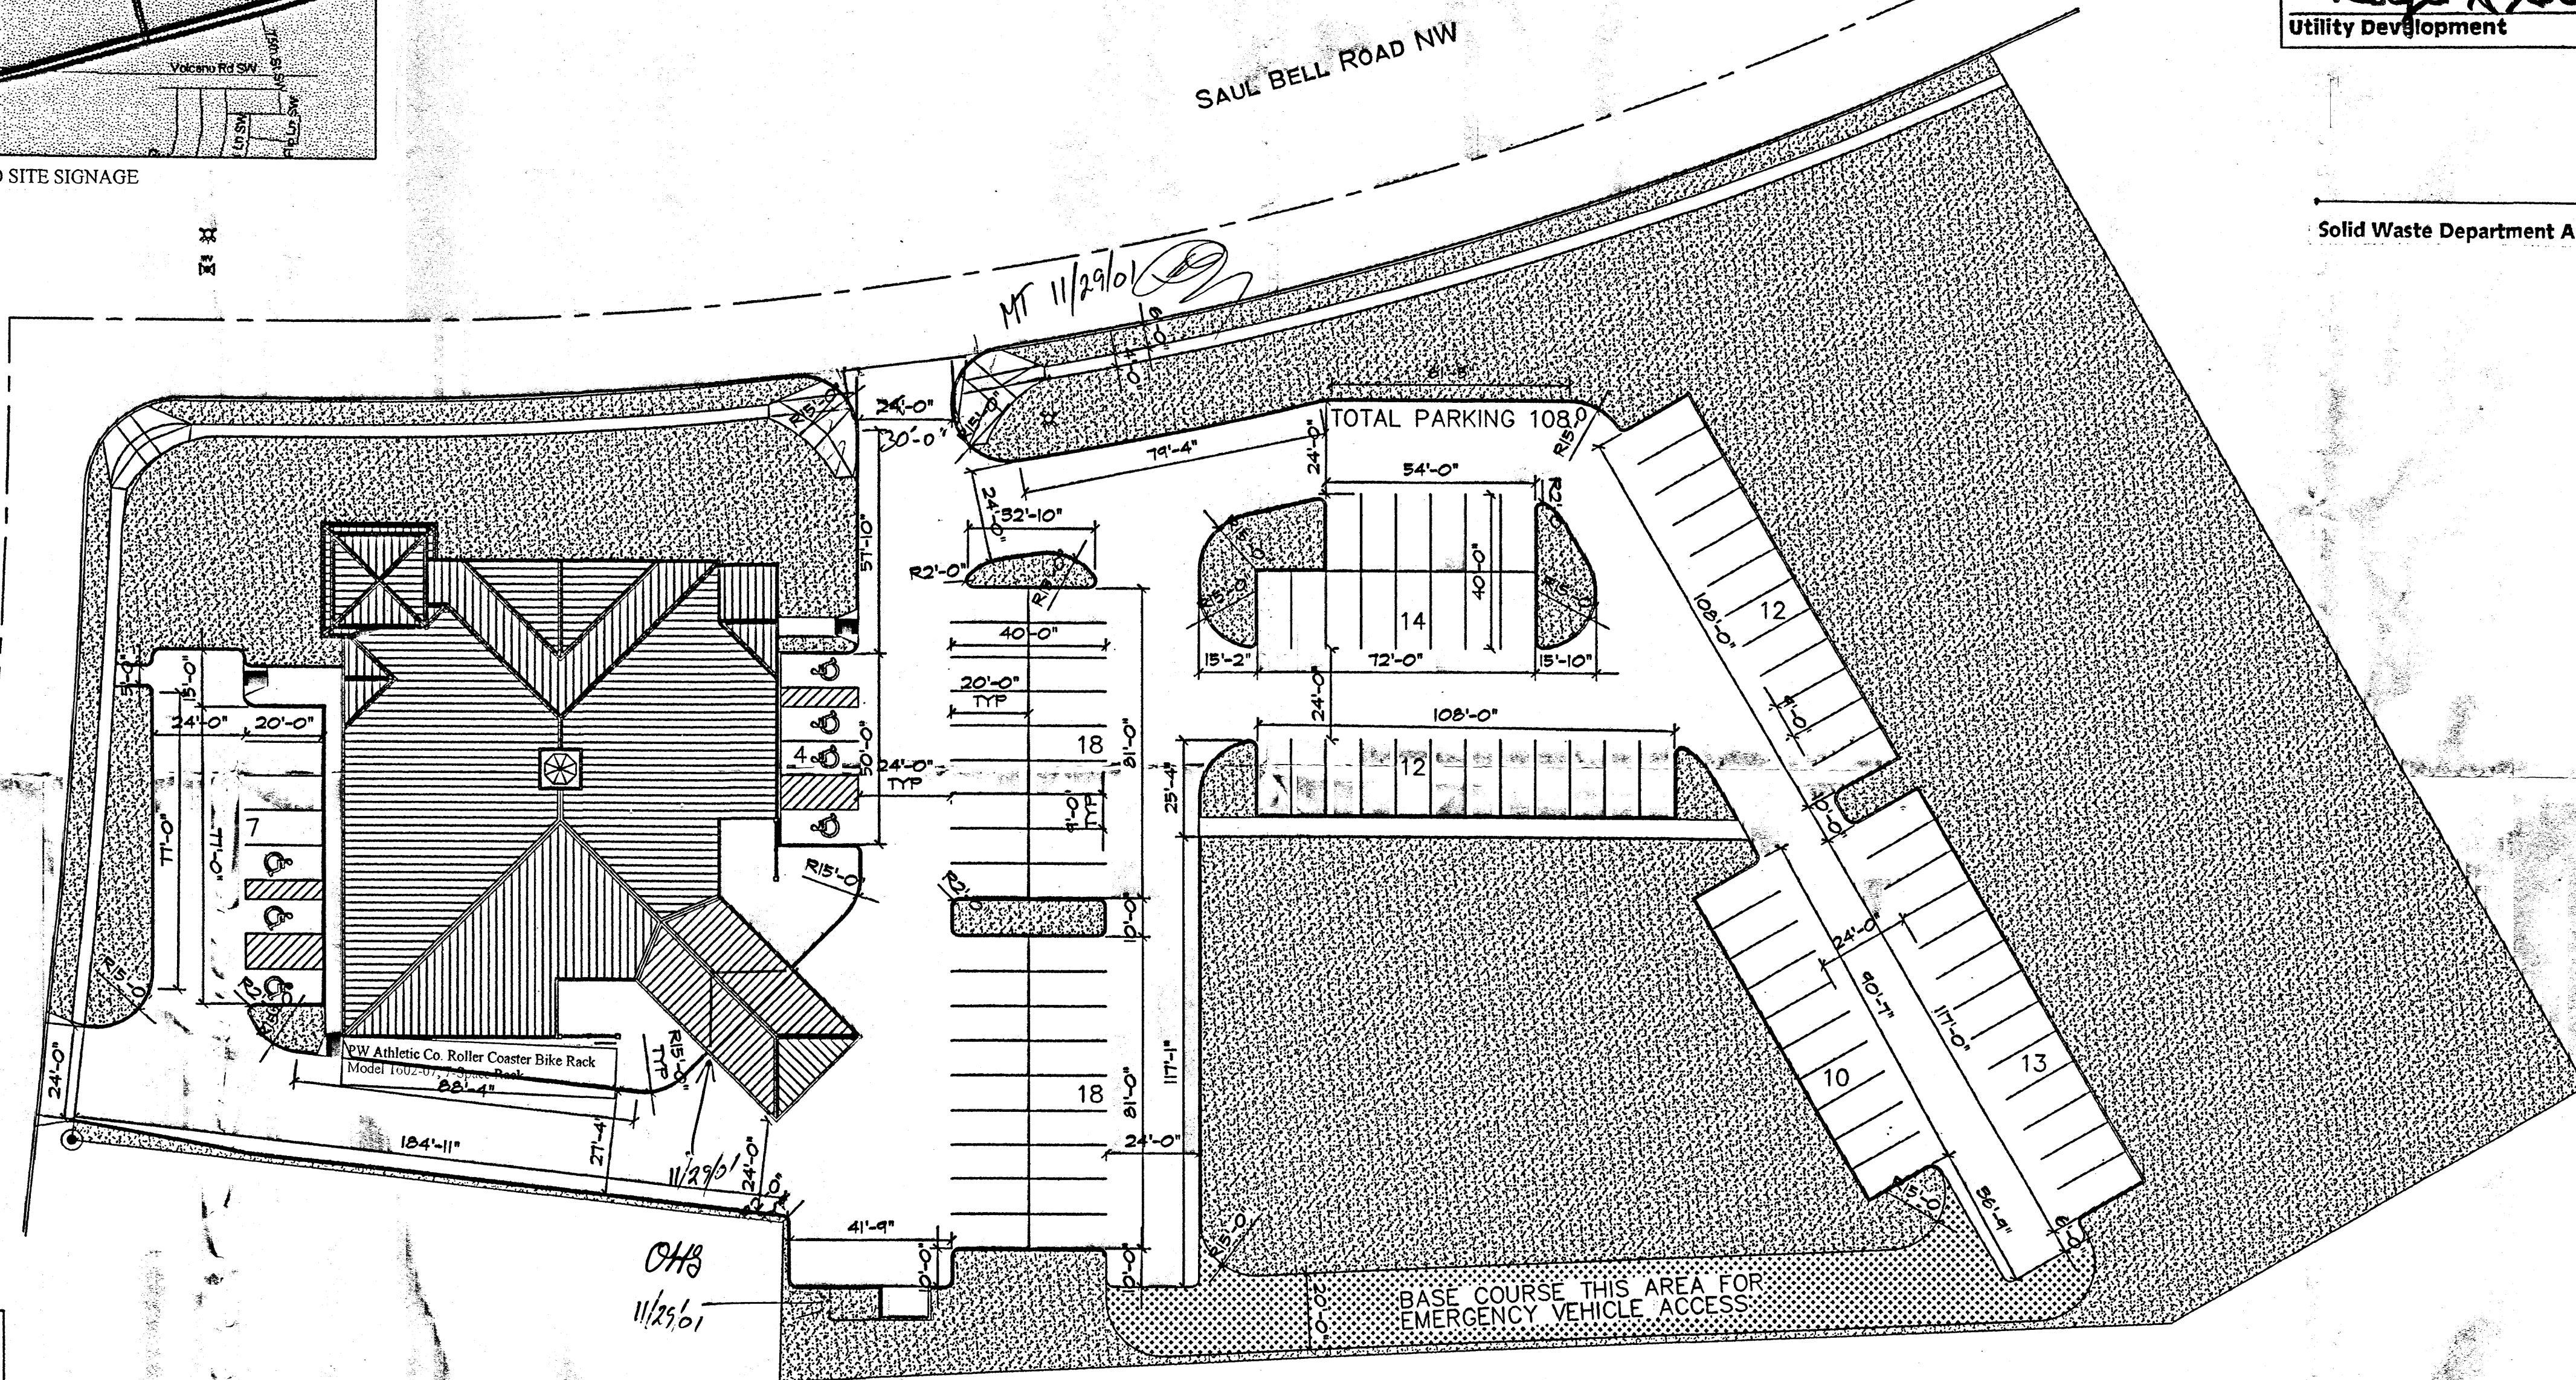



PROJECT # 1000918
Application # 01450-00000-00648
Site Development Plan for Building Permit
The site development plan is consistent with the Clifford West Business Park Master Development Plan approved 12-9-97 through DRB No. Z-97-11 and (plat) 97-138.
Planning Director, City of Albuquerque 8/30/01
Date
City Engineer, BNAFCA 5/30/01
Date
Transportation Development 8-20-01
Date
Parks and Recreation 5-30-01
Date
Utility Development 5-30-01
Date

Solid Waste Department Approval Date


SHEET FILE NAME
ALB-SITE
DRAWN BY
RDW, CRY
CHECKED BY
APPROVED BY
DATE
03/19/01
REVISIONS
JUNE 28, 2001

PAUL & ASSOCIATES, INC.
CHURCH BUILDING CONSTRUCTION MANAGEMENT
5600 OLD BALDWIN RD. SUITE 108 TUCUMCARI, NM 87303
SIEBENLIST ★ ARCHITECTS
TYLER, TEXAS

A NEW FACILITY
FOR THE
FELLOWSHIP MISSIONARY
BAPTIST CHURCH
ALBUQUERQUE, NEW MEXICO

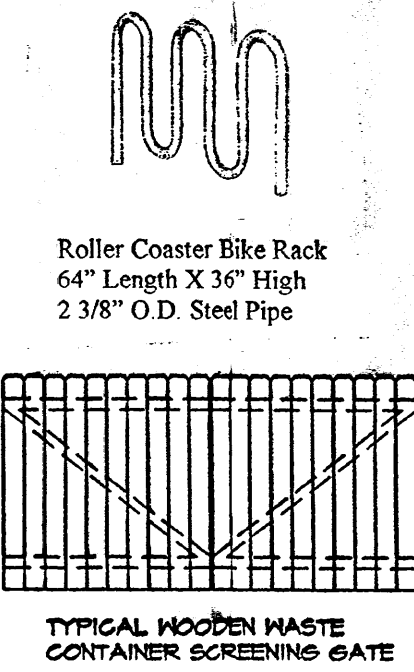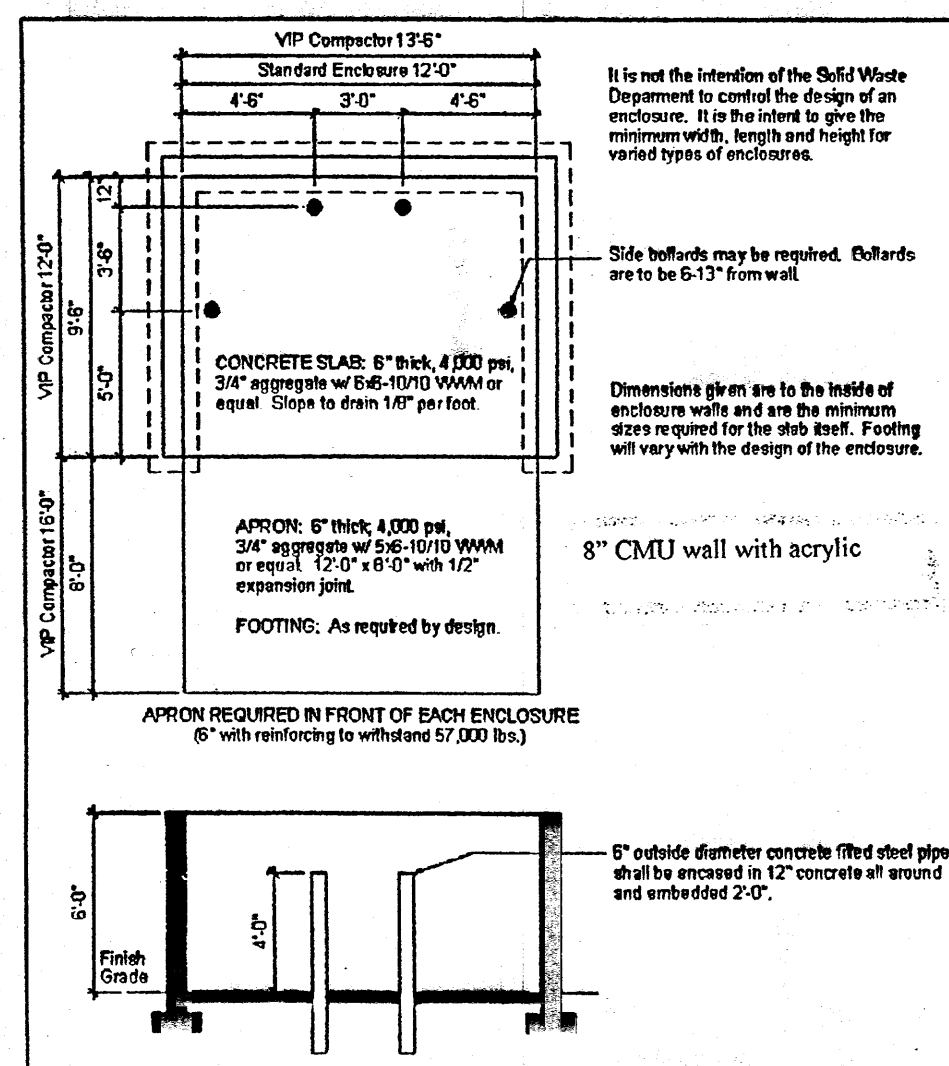

THIS IS TO CERTIFY
AS TO THE IMPROVEMENTS
SHOWN ON THIS DRAWING
ONLY. AS NOTATED -
E. RAYMOND WARDEN
DIRECTOR OF DESIGN
FOR PAUL & ASSOCIATES, INC.

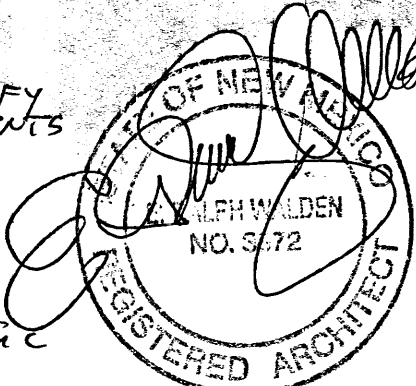

SITE PLAN
SCALE: 1" = 30'-0"

8-31-01

RECEIVED
SEP 25 2002
HYDROLOGY SECTION
SCALE: 1" = 30'

THIS DRAWING IS PROPERTY OF
SIEBENLIST ARCHITECTS AND
PAUL & ASSOCIATES, INC.,
CONSTRUCTION MANAGERS, AND
IS NOT TO BE REPRODUCED OR
COPIED IN WHOLE OR IN PART
WITHOUT WRITTEN CONSENT OF
BOTH THE ARCHITECT AND
CONSTRUCTION MANAGER. IT
IS ONLY TO BE USED FOR THE
PROJECT AND SITE SPECIFIED
HEREIN AND IS NOT TO BE
USED ON ANY OTHER PROJECT.
IT IS ALSO TO BE RETURNED
UPON REQUEST.

SHEET
C1.01

DRAINAGE PLAN

THIS PROJECT IS PART OF THE APPROVED CLIFFORD WEST BUSINESS PARK MASTER DRAINAGE PLAN (K10-023) DATED 9-17-97. THE BACKBONE STORM SEWER SYSTEM HAS BEEN BUILT AND ACCEPTED BY THE CITY OF ALBUQUERQUE. AN 18" RCP STORM LATERAL STUB IS PROVIDED FOR LOT 10 AT THE WEST PROPERTY LINE APPROXIMATELY 40 FEET FROM THE SOUTHWEST PROPERTY CORNER. DRAINAGE FROM LOT 11 AND 12 IS PROVIDED THROUGH A 10" WIDE PRIVATE DRAINAGE EASEMENT LOCATED ALONG THE SOUTH PROPERTY LINE OF LOT 12 AND EXTENDING SOUTH BETWEEN LOTS 5 AND 6 TO AN EXISTING 18" RCP STORM SEWER LATERAL STUBBED AT THE RIGHT-OF-WAY LINE WITH AN INVERT = ±17.0'.

THE ALLOWABLE DISCHARGE Q(LOT 10) = 0.63 cfs AND Q(LOT 11 & 12) = 2.05 cfs.

SUBBASIN 1: THE DEVELOPED CONDITIONS RUNOFF WILL BE RESTRICTED TO THE MAXIMUM ALLOWABLE DISCHARGE THROUGH AN ORIFICE PLATE ATTACHED TO THE END OF THE 18" RCP IN THE JUNCTION BOX. THE ONSITE DRIVEWAY WILL BE USED TO TEMPORARILY DETAIN THE RUNOFF.

SUBBASIN 2: THE DEVELOPED CONDITIONS RUNOFF WILL BE RESTRICTED TO THE MAXIMUM ALLOWABLE DISCHARGE THROUGH A RESTRICTED OPENING IN THE FLOODWALL ALONG THE SOUTH PROPERTY LINE BEFORE DISCHARGING INTO A CONCRETE CHANNEL AND THEN INTO THE EXISTING 18" RCP AS SHOWN ON THIS GRADING AND DRAINAGE PLAN.

HYDROLOGY SUMMARY (100 YEAR 6 HOUR)




P(1 HR) = 1.90"
P(6 HR) = 2.20"

	DEVELOPED Q	ALLOWABLE Q	DESIGN AREA(*)	ORIFICE OPENING SQUARE DIMENSIONS
SUBBASIN 1	3.47 cfs	0.63 cfs	0.052517 SQFT.	2.75" x 2.75"
SUBBASIN 2	9.86 cfs	2.05 cfs	0.3997 SQFT.	

(*) ORIFICE EQN.: $Q = 0.6 \times \text{AREA} \times (2 \times 32.2 \times H)^{1/2}$

FOR SINGLE "C" INLET
 $Q = C \times L \times H^{3/2} / 2$

SIDE Q CAP = $(3.0 \times 2 + 4 \times 0.5) \times 1.5 = 8.48 \text{ cfs}$

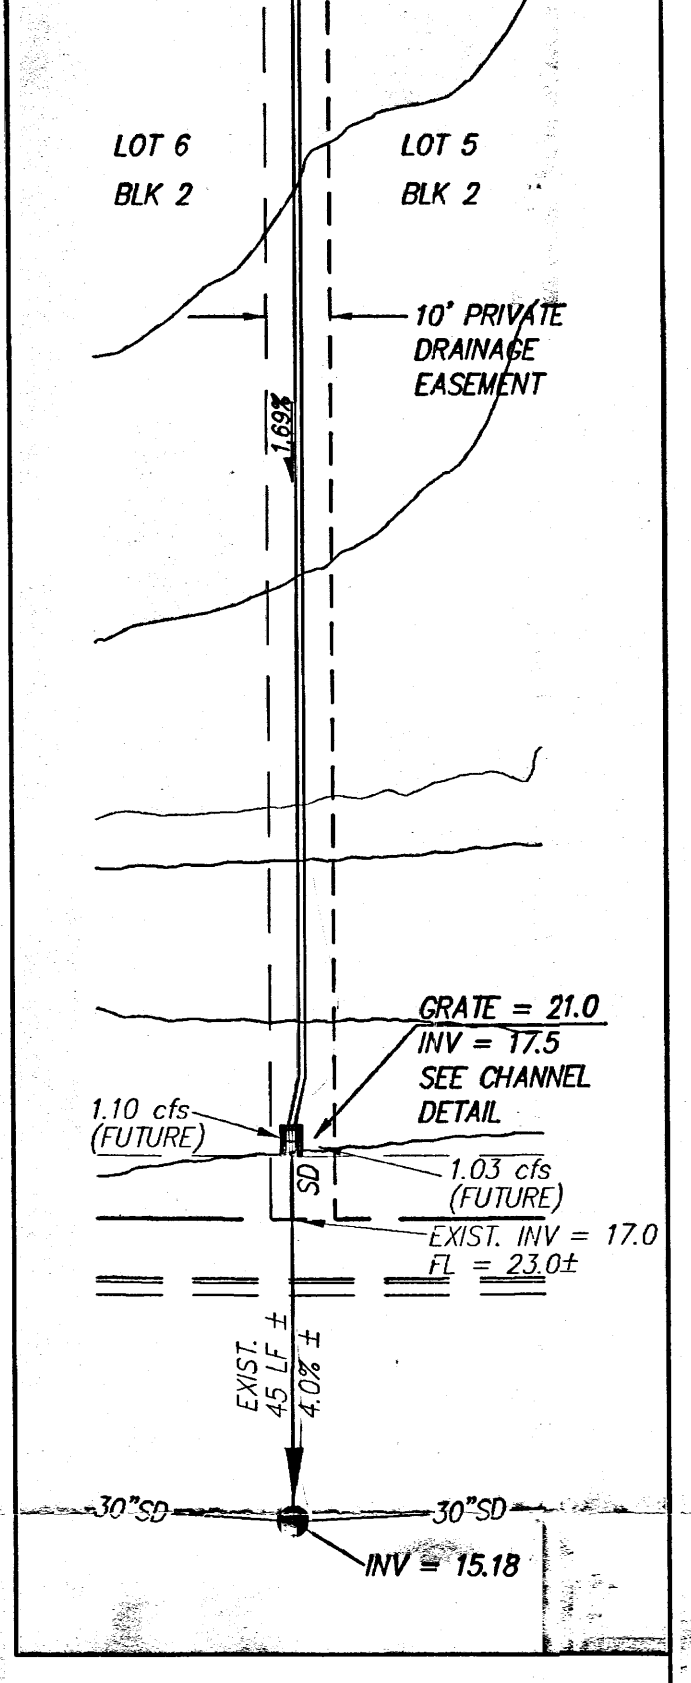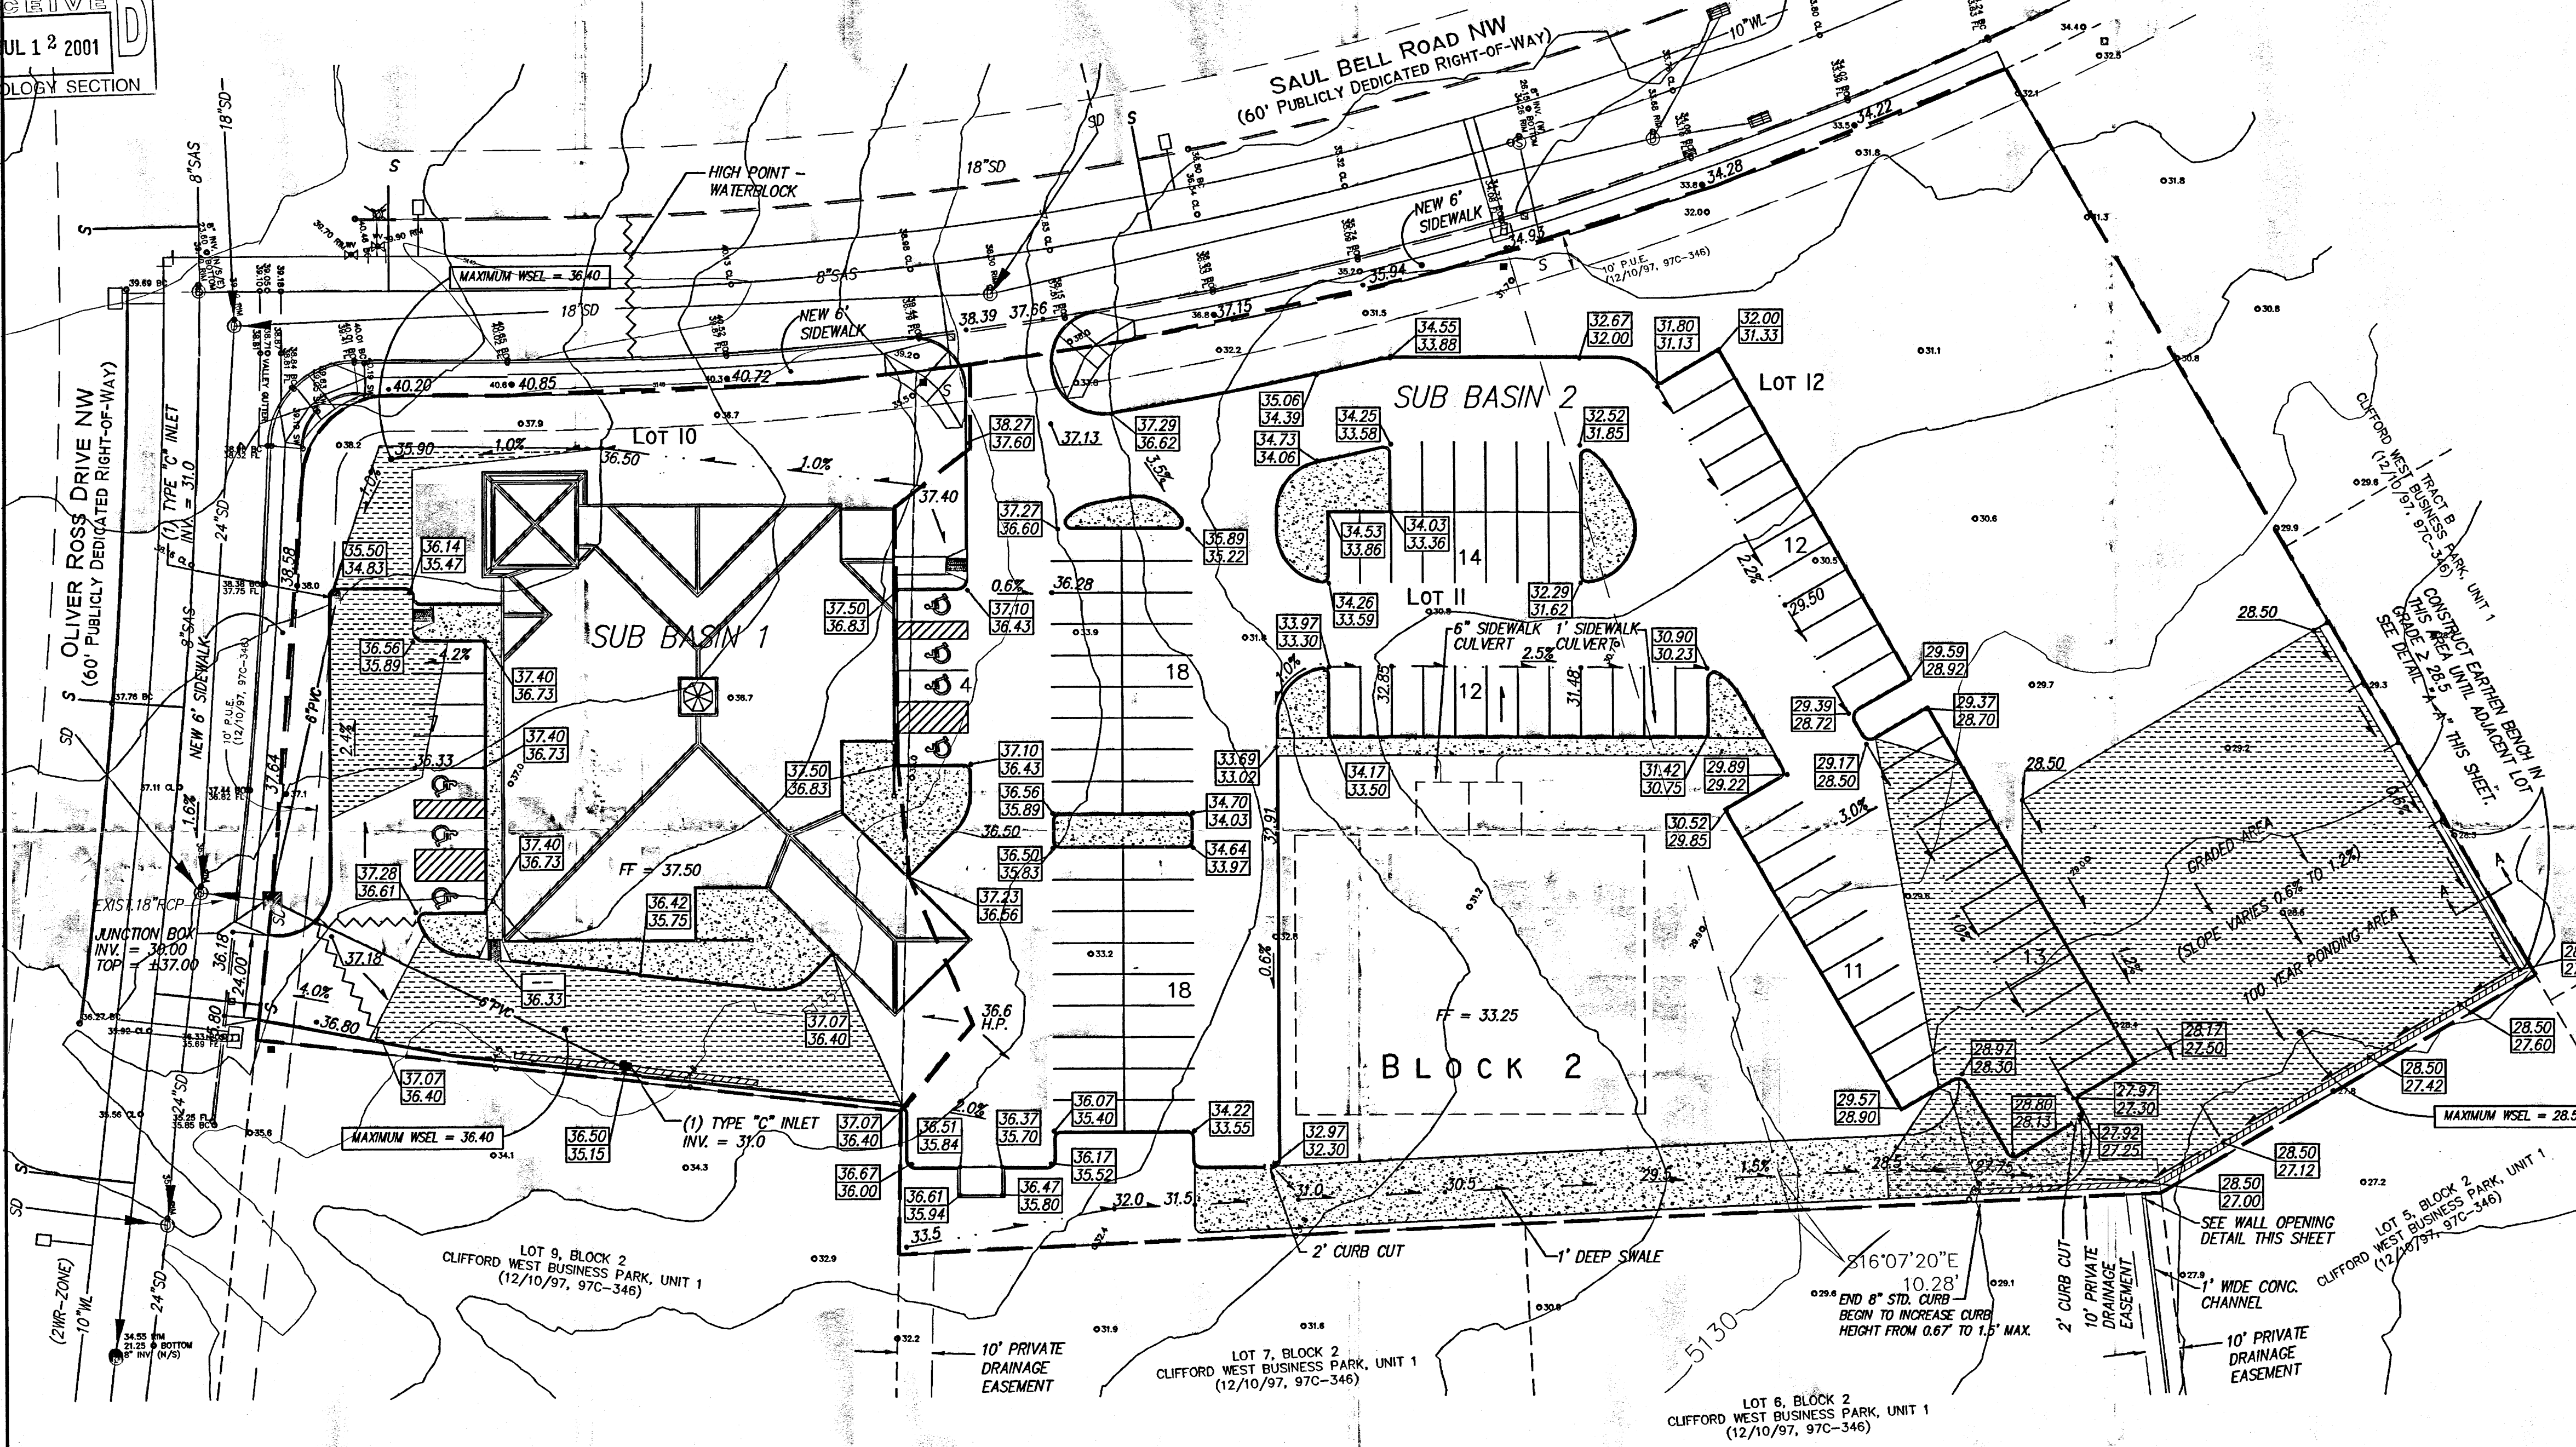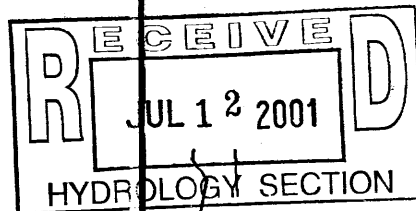

VICINITY MAP ZONE MAP: K-9, K-10

NOTES

ADD 5100 FOR MEAN SEA LEVEL ELEVATIONS

LEGAL DESCRIPTION

LOTS 10, 11, & 12, BLOCK 2
CLIFFORD WEST BUSINESS PARK, UNIT 1

LEGEND

- EXISTING ELEVATION AT GROUND
- EXISTING SEWER MANHOLE
- EXISTING DRAINAGE MANHOLE
- EXISTING WATER METER
- EXISTING WATER VALVE
- EXISTING SEWER SERVICE
- EXISTING TELEPHONE RISER
- EXISTING CABLE TV RISER
- EXISTING FIRE HYDRANT
- EXISTING DROP INLET
- EXISTING LOTS
- EXISTING CURB & GUTTER
- EXISTING WATERLINE
- EXISTING SAS
- EXISTING STORMDRAIN
- EXISTING EASEMENT
- NEW CURB & GUTTER
- NEW BUILDING
- NEW SWALE
- NEW STORM DRAIN
- NEW SPOT ELEVATION
- NEW FLOW
- NEW CONCRETE
- EXTENT OF 100 YR FLOOD PONDING AREA
- NEW SUBBASIN BOUNDARY
- CURB HEIGHT VARIES FROM 8" TO 1.5'



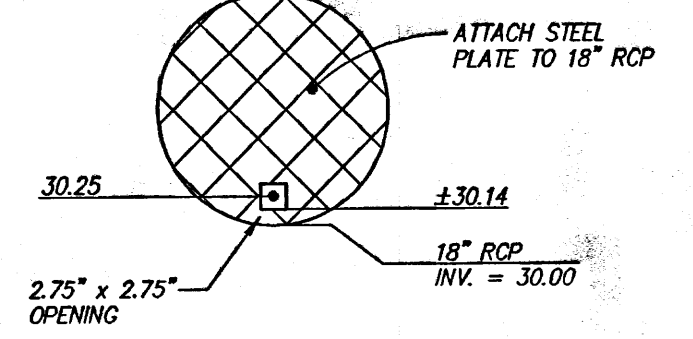



PLATE DETAIL FOR JUNCTION BOX
NTS

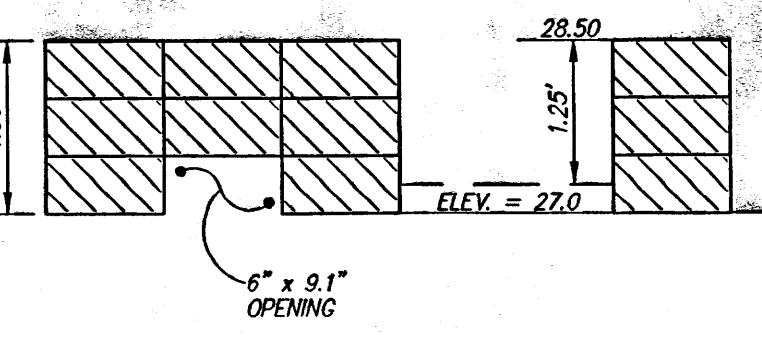


WALL OPENING DETAIL
NTS

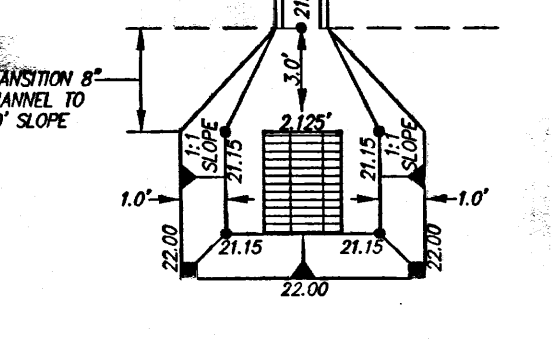


CHANNEL DETAIL
NTS

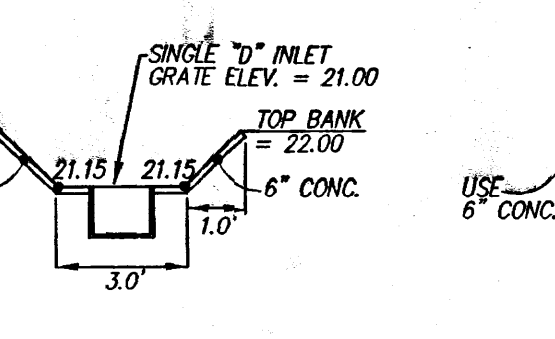

CHANNEL DETAIL
NTS

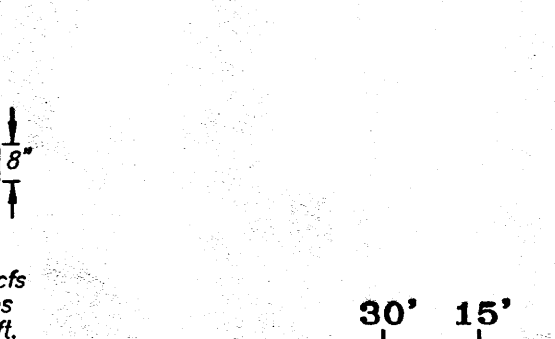

CHANNEL DETAIL
NTS

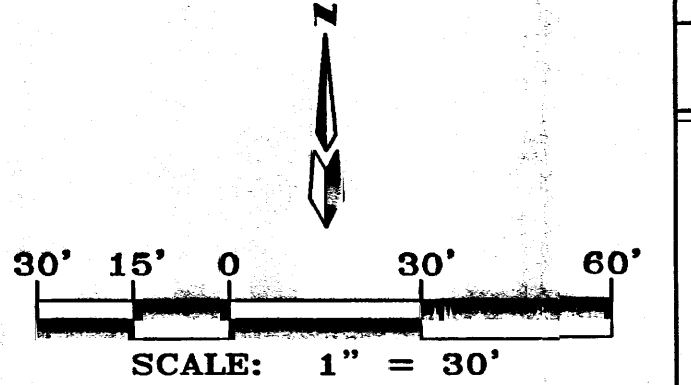

CLIFFORD WEST CHURCH GRADING & DRAINAGE PLAN

MARK GOODWIN & ASSOCIATES, P.A.
CONSULTING ENGINEERS
P.O. BOX 90606
ALBUQUERQUE, NEW MEXICO 87199
(505)828-2200, FAX (505)797-9539

Designed: DLH Drawn: ACH Checked: DMG
Scale: 1" = 30' Date: 02-08-01 Job: A01021 Sheet 1 of 1