CITY OF ALBUQUERQUE

Planning Department Brennon Williams, Director



February 7, 2020

David Soule, P.E. Rio Grande Engineering PO Box 93924 Albuquerque, NM 87199

RE: 6429 Dennison SW

Request for Pad Certification – Disapproved Grading Plan Stamp Date: 9/18/19

Certification Dated: 2/5/20 Drainage File: K11D068A

Dear Mr. Soule:

5 1 1 1 1 1

Based on the submittal received on 2/4/20, this certification cannot be accepted until the following are corrected:

Prior to Building Permit:

Albuquerque

PO Box 1293

1. Remove the fill placed against the rear yard wall, grade according to plan, and provide supporting as-built survey.

NM 87103

- 2. Provide supporting as-built survey of the compacted building pad.
- 3. Grade the ponds according to plan and provide supporting as-built survey.

www.cabq.gov

4. Use the Drainage Certification Language, per the DPM Chapter 22.7: *DRAINAGE CERTIFICATION WITH SURVEY WORK BY PROFESSIONAL SURVEYOR* or *DRAINAGE CERTIFICATION WITH VERIFICATION BY ENGINEER OF RECORD*; be sure to include surveyor information.

If you have any questions, please contact me at 924-3695 or dpeterson@cabq.gov.

Sincerely,

Dana Peterson, P.E.

Senior Engineer, Planning Dept. Development Review Services




City of Albuquerque

Planning Department

Development & Building Services Division

DRAINAGE AND TRANSPORTATION INFORMATION SHEET (REV 6/2018)

Project Title: 6429 DENNISON DRB#: Legal Description. LOT 8 BLOCK B A	Building Permit #:		Hydrology File #:	
DRB#:	EPC#:		Work Order#:	
Legal Description. LOT 8 BLOCK B A	LAMOSA ADDITION	1		
City Address: 6429 DENNISON		- 1994		
Applicant: PERFECTO GARCIA		Contact:		
Address:				
Phone#:				
Other Contact: RIO GRANDE ENGINEERING				
Address: PO BOX 93924 ALB NM				
Phone#: 505.321.9099	Fax#: 505.872.0999	E-mail: d	avid@riograndeengineering.com	
TYPE OF DEVELOPMENT:PLAT				
Check all that Apply:				
DEPARTMENT: X HYDROLOGY/ DRAINAGE TRAFFIC/ TRANSPORTATION	X_B	OF APPROVAL/ACCE	OVAL	
TYPE OF SUBMITTAL:	C	ERTIFICATE OF OCCUI	PANCY	
ENGINEER/ARCHITECT CERTIFICATION	r Þi	RELIMINARY PLAT AP	PROVAL	
X PAD CERTIFICATION		TE PLAN FOR SUB'D		
CONCEPTUAL G & D PLAN		SITE PLAN FOR BLDG. PERMIT APPROVAL		
GRADING PLAN		FINAL PLAT APPROVAL		
DRAINAGE REPORT				
DRAINAGE MASTER PLAN	SI	A/ RELEASE OF FINAN	ICIAL GUARANTEE	
FLOODPLAIN DEVELOPMENT PERMIT APPLIC		FOUNDATION PERMIT APPROVAL		
ELEVATION CERTIFICATE		GRADING PERMIT APPROVAL		
CLOMR/LOMR	Se	O-19 APPROVAL		
TRAFFIC CIRCULATION LAYOUT (TCL)		PAVING PERMIT APPROVAL		
TRAFFIC IMPACT STUDY (TIS)		X GRADING/ PAD CERTIFICATION		
STREET LIGHT LAYOUT		WORK ORDER APPROVAL		
OTHER (SPECIFY)		CLOMR/LOMR		
PRE-DESIGN MEETING?		LOODPLAIN DEVELOP		
IS THIS A RESUBMITTAL?: X Yes No	0	THER (SPECIFY)		
DATE SUBMITTED:				
COA STAFF:	ELECTRONIC SUBMITTAL	RECEIVED:		
	FEE PAID:			

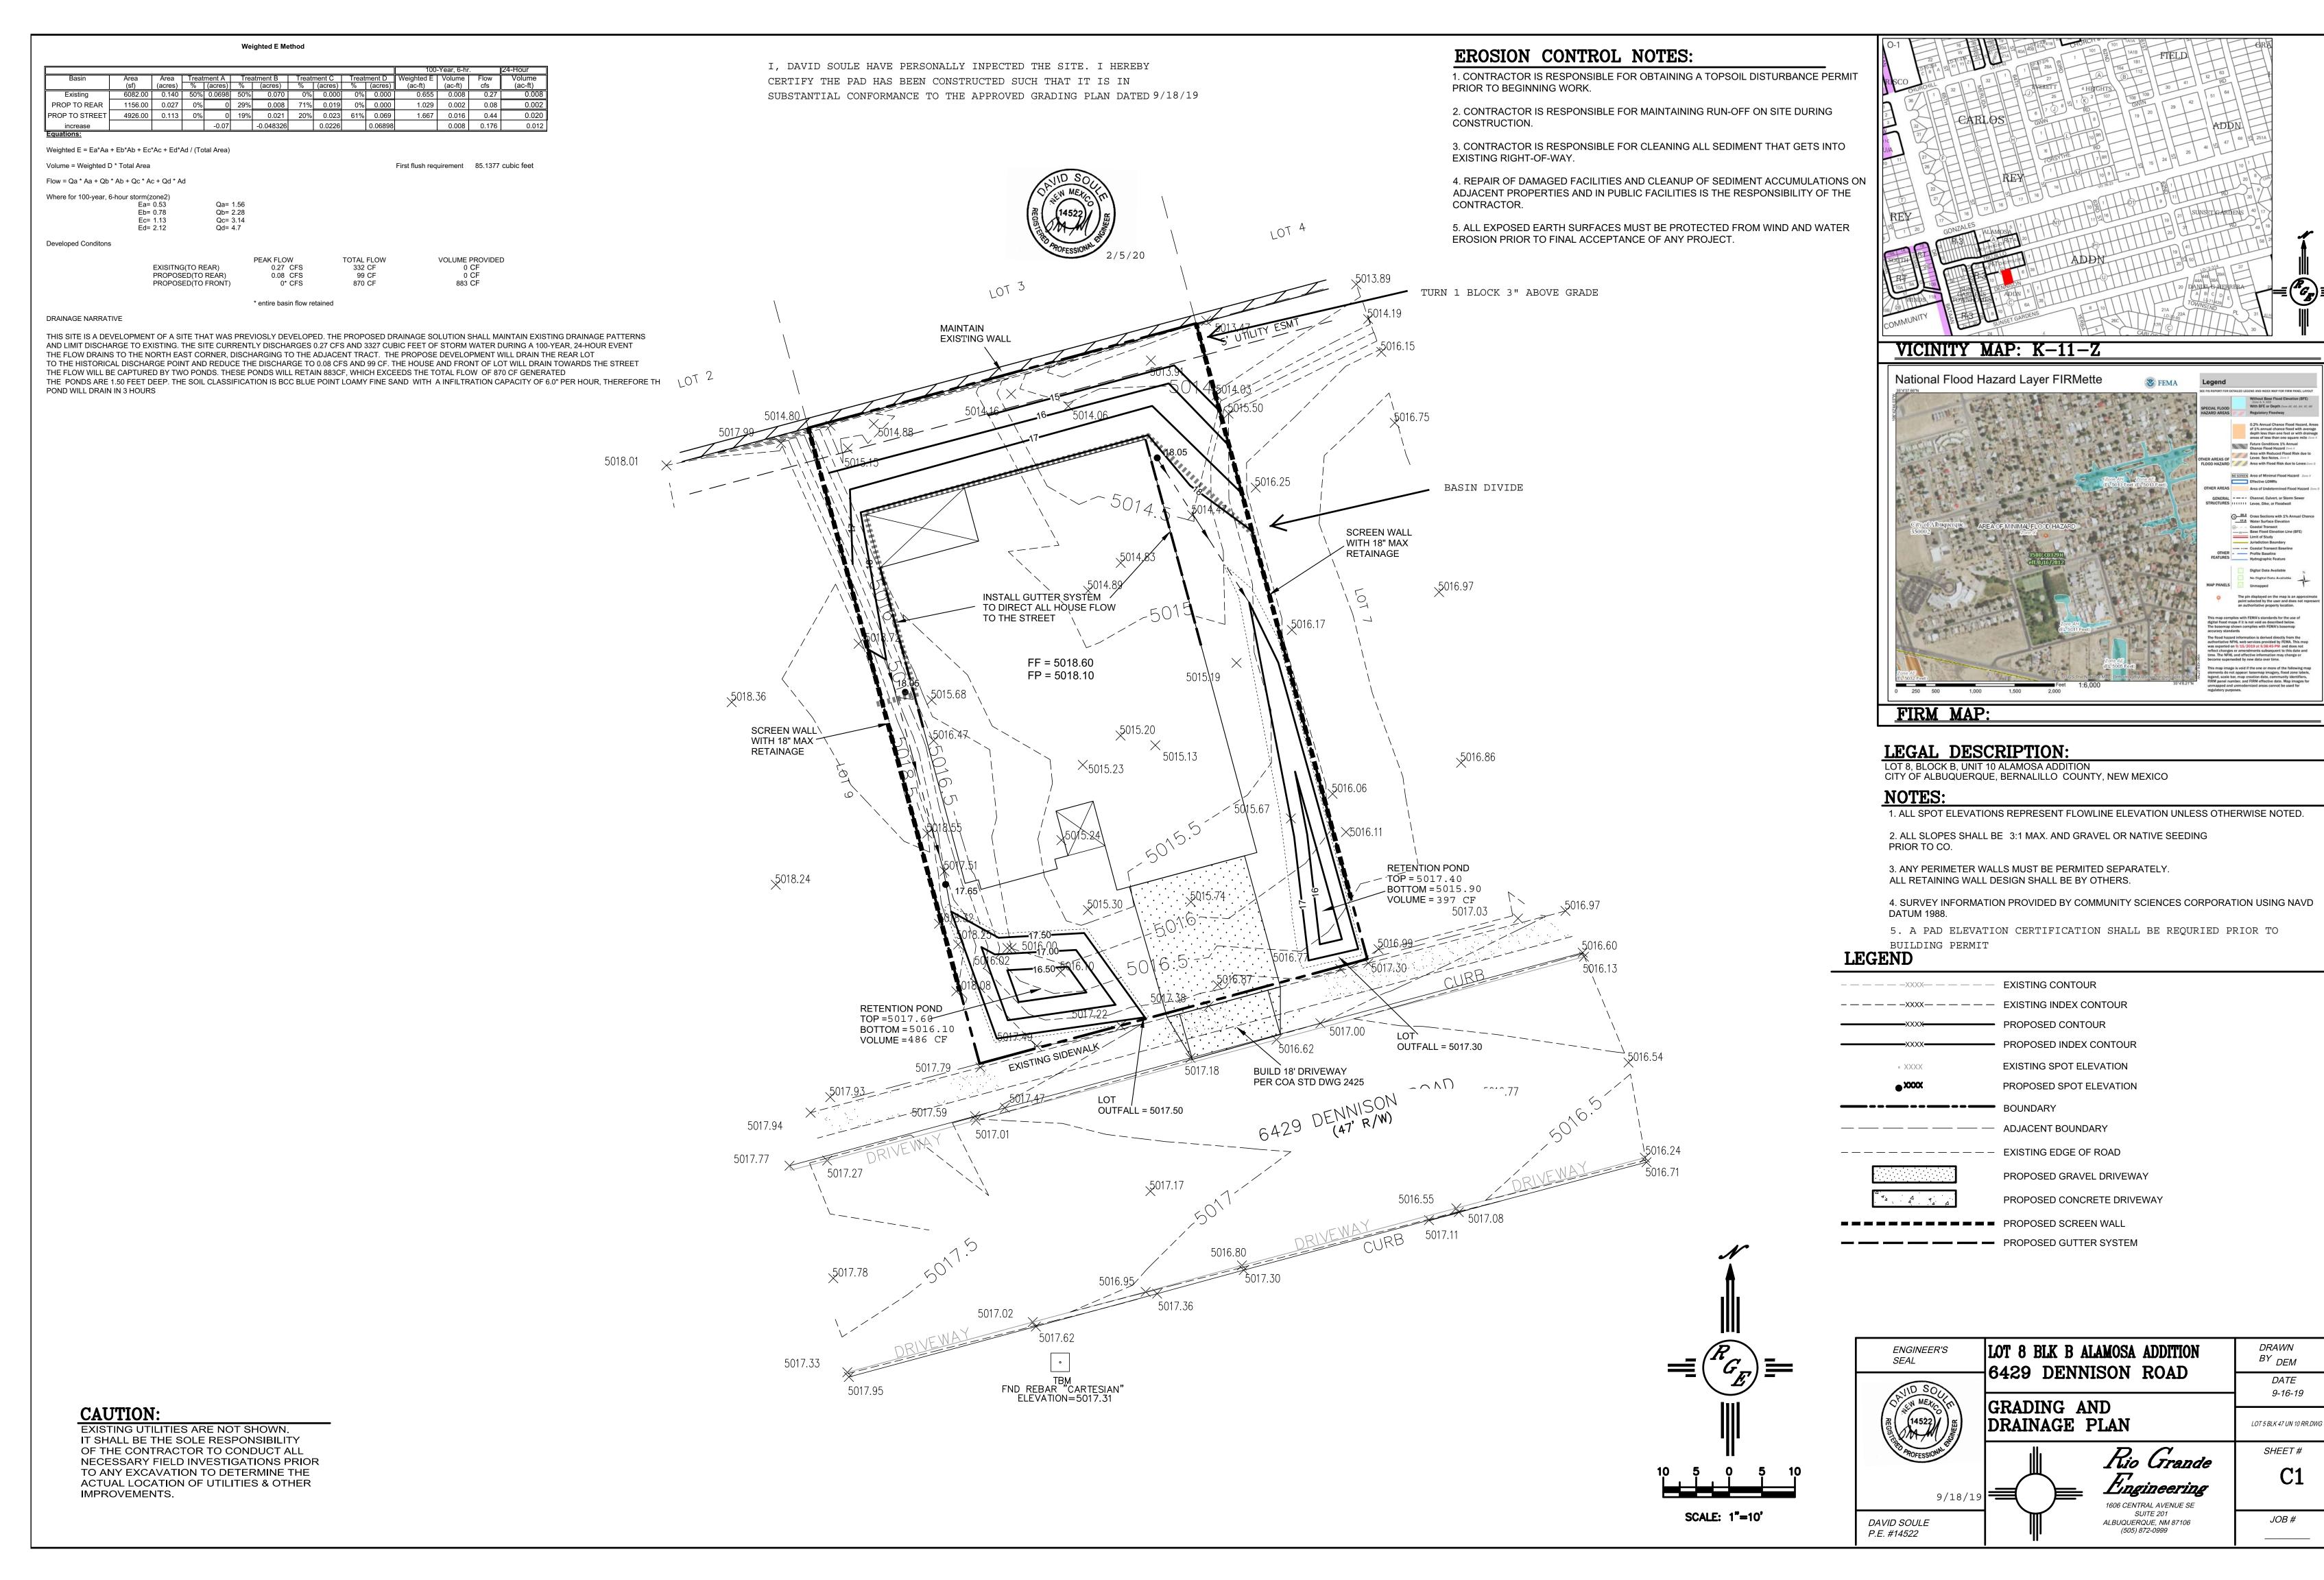

DATE

9-16-19

C1

JOB#