

## City of Albuquerque

September 8, 2000

Celia Tomlinson, P.E. Rhombus, P.A.,Inc. 2620 San Mateo NE, Suite B12324 Albuquerque, NM 87111

RE: NICOLE'S AUTOMOTIVE SHOP (K11-D61). ENGINEER"S CERTIFICATION FOR CERTIFICATE OF OCCUPANCY APPROVAL. ENGINEER'S STAMP DATED AUGUST 29, 2000.

Dear Ms. Tomlinson:

Based upon the information provided on your August 30, 2000 submittal, the above referenced project is approved for Certificate of Occupancy.

If I can be of further assistance, please feel free to contact me at 924-3984.

John P. Murray, P.E.

Hydrology

c: Whitney Reierson File

PROJECT TITLE: NICOLES ANTOMOTIVE SUPEZONE ATLAS/DRNG. FILE #: K-11/DOL/DRB #: 99-226 BPC #: WA WORK ORDER #:	
PROJECT TITLE: A COLES AVIOLES	ZONE ATLAS/DRNG. FILE #:
DRB #: 77-000 BPC #: PA	XL 1 YUCCA ADON NO. 2
LEGAL DESCRIPTION: LOT 16-A BLOCKS CITY ADDRESS: 232 OLD COORS	DRIVE SW
ENGINEERING FIRM: RHOMBUS P.A.	CONTACT: CELIA TOMILIASON
ADDRESS: 2620 SAN MATEO SUI	FEB 87111 881-6690
OWNER: NICOLE PADILLA	CONTACT: NICOLE PADILLA
	<b>A</b> • • • • • • • • • • • • • • • • • • •
ADDRESS: 1/32 JENARO SW	
ARCHITECT: GUADALUPE ALCHITEC	- ·
ADDRESS: 5961 GUADALUTE TR	PHONE: 343-9305
SURVEYOR: RHOMBUS P.A. (MIERS)	CONTACT: CELIA TOMYNSON
ADDRESS: 2620 SAN MATER NE	SUTE B PHONE: 881-6690
CONTRACTOR: NA	1/1
	CONTACT:
ADDRESS: NA,	PHONE:
TYPE OF SUBMITTAL: DRAINAGE REPORT	CHECK TYPE OF APPROVAL SOUGHT: SKETCH PLAT APPROVAL
DRAINAGE PLAN	PRELIMINARY PLAT APPROVAL
CONCEPTUAL GRADING & DRAINAGE PLAN	S. DEV. PLAN FOR SUB'D. APPROVAL
GRADING PLAN	S. DEV. PLAN FOR BLDG. PERMIT APPROVAL
EROSION CONTROL PLAN	SECTOR PLAN APPROVAL
ENGINEER'S CERTIFICATION	FINAL PLAT APPROVAL
OTHER	FOUNDATION PERMIT APPROVAL BUILDING PERMIT APPROVAL
PRE-DESIGN MEETING:	CERTIFICATE OF OCCUPANCY APPROVAL
YES	GRADING PERMIT APPROVAL
NO	PAVING PERMIT APPROVAL
COPY PROVIDED	S.A.D. DRAINAGE REPORT
	DRAINAGE REQUIREMENTS
	SUBDIVISION CERTIFICATION
•	OTHER(SPECIFY)
DATE SUBMITTED: 8/29/C BY: CELIA S. TOMLINSON	AUG 3 0 2000 D

HYDROLOGY SECTION



## City of Albuquerque

August 12, 1999

Celia Tomlinson, P.E. Rhombus, P.A., Inc. 2620 San Mateo NE, Suite B Albuquerque, NM 87111

RE: NICOLE'S AUTOMOTIVE SHOP (K11-D61). GRADING AND DRAINAGE PLAN FOR BUILDING PERMIT APPROVAL. ENGINEER'S STAMP DATED JULY 23,

1999.

Dear Ms. Tomlinson:

Based on the information provided on your August 3, 1999 submittal, the above referenced project is approved for Building Permit. (It is understood that a prefab building is expected to be on site late next week.)

Transportation still has to review the T.C.L.

Please attach a copy of this approved plan to the construction sets prior to sign-off by Hydrology.

Prior to Certificate of Occupancy approval, an Engineer's Certification per the DPM will be required.

If I can be of further assistance, please feel free to contact me at 924-3984.

Sincerely,

John P. Murray, P.E

Hydrology

c: File



## City of Albuquerque

Mr. David Weatherman Guadalupe Architects 5961 Guadalupe Trail, NW Albuquerque, NM 87121 August 12, 1999

RE:

TRAFFIC CIRCULATION LAYOUT REVIEW FOR BUILDING PERMIT

**APPROVAL** 

NICOLE'S AUTOMOTIVE SHOP, K11-D061, Architect's Stamp dated 7-23-99

Dear Mr. Weatherman:

The above referenced Traffic Circulation Layout (TCL) requires modifications to the site plan prior to review for Building Permit.

The comments are indicated in red ink on the attached marked-up site plan.

- Clearly indicate what the gravel area on the north side of the site is for; need curbing at the edge of the asphalt area.
- Need building and pedestrian protection along the building, (i.e. bollards).
- The main entrance to the building is not shown.
- Are all three driveways built with the City Public Works project?
- Need dimensions for parking stalls.
- The exact location of the gates should be indicated.

The engineer's certification required by the Hydrology section needs to include certification that this site was constructed in accordance with the TCL before Certificate of Occupancy (C.O.) is released.

Please return the attached marked-up site plan with your next submittal. Review for Building Permit will be done upon receipt of the revised site plan, with the attached marked-up site plan.

Please call me at 924-3993 to set up a meeting to discuss this project.


Sincerely.


Afsaneh Yavari Associate Engineer


Attachments


### DRAINAGE INFORMATION SHEET

PROJECT TITLE: NICOLES AUTOMOTIV	ESHOP ZONE ATLAS/DRNG. FILE #: K-11 / DOG(
DRB #: 99-226 EPC #: NA	WORK ORDER #:
LEGAL DESCRIPTION: LOT 16-A BLOC	LI YUCCA ADON NO.2
CITY ADDRESS: 232 OLD COORS	drive sw
ENGINEERING FIRM: RHOHBUS P.A.	CONTACT: CELIA TOMILIASON
ADDRESS: 2620 SAN MATEO SUIT	EB 87111 881-6690
OWNER: NICOLE PADILLA	CONTACT: NICOLE PADILLA
Address: 1132 Jenaro S 14	PHONE: 836-6967
ARCHITECT: GUADALUPE ARCHITECT	
ADDRESS: 5961 GUADALUTE TRA	
SURVEYOR: RHOMPUS P.A. (MIERS)	CONTACT: CELIA TOMUNSON
ADDRESS: 2620 SAN MATER NES	WINE B PHONE: 881-6690
CONTRACTOR: NA,	CONTACT:
ADDRESS: NA,	PHONE: N.A.
DRAINAGE REPORT  DRAINAGE PLAN  CONCEPTUAL GRADING & DRAINAGE PLAN  GRADING PLAN  EROSION CONTROL PLAN  ENGINEER'S CERTIFICATION  OTHER  PRE-DESIGN MEETING:  YES  NO  COPY PROVIDED  AUG 0 3 1999  HYDROLOGY SECTION	CHECK TYPE OF APPROVAL SOUGHT:  SKETCH PLAT APPROVAL  PRELIMINARY PLAT APPROVAL  S. DEV. PLAN FOR SUB'D. APPROVAL  S. DEV. PLAN FOR BLDG. PERMIT APPROVAL  SECTOR PLAN APPROVAL  FINAL PLAT APPROVAL  FOUNDATION PERMIT APPROVAL  CERTIFICATE OF OCCUPANCY APPROVAL  GRADING PERMIT APPROVAL  PAVING PERMIT APPROVAL  S.A.D. DRAINAGE REPORT  DRAINAGE REQUIREMENTS  SUBDIVISION CERTIFICATION  OTHER  JUL 26 1999
DATE SUBMITTED: 7/26/99  RY: C.E. L. C. T. T.M. L. A. S.O.W.	HYDROLOGY SECTION

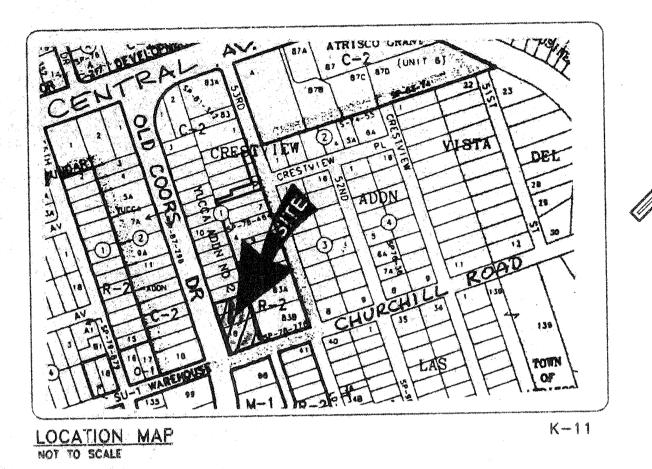

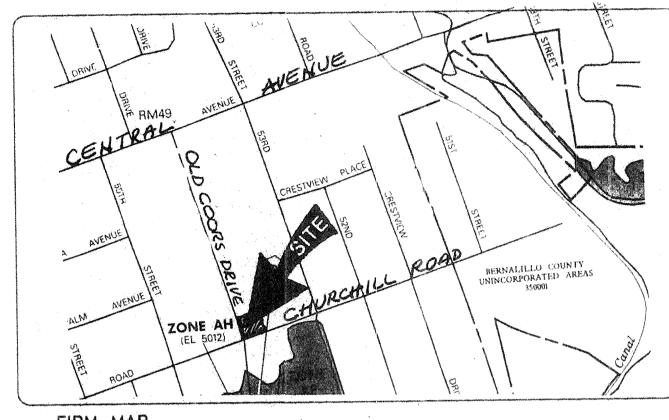

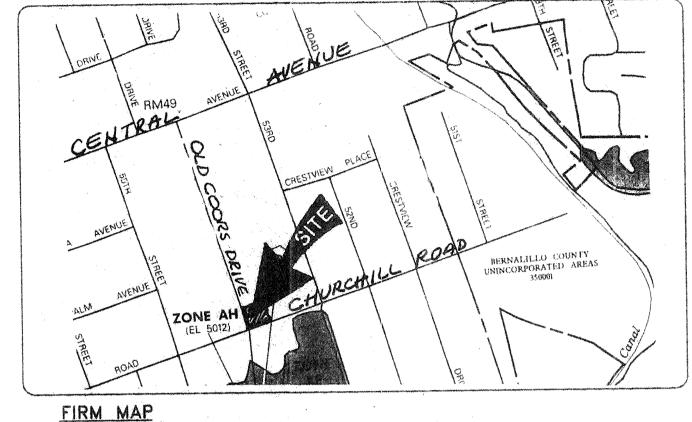

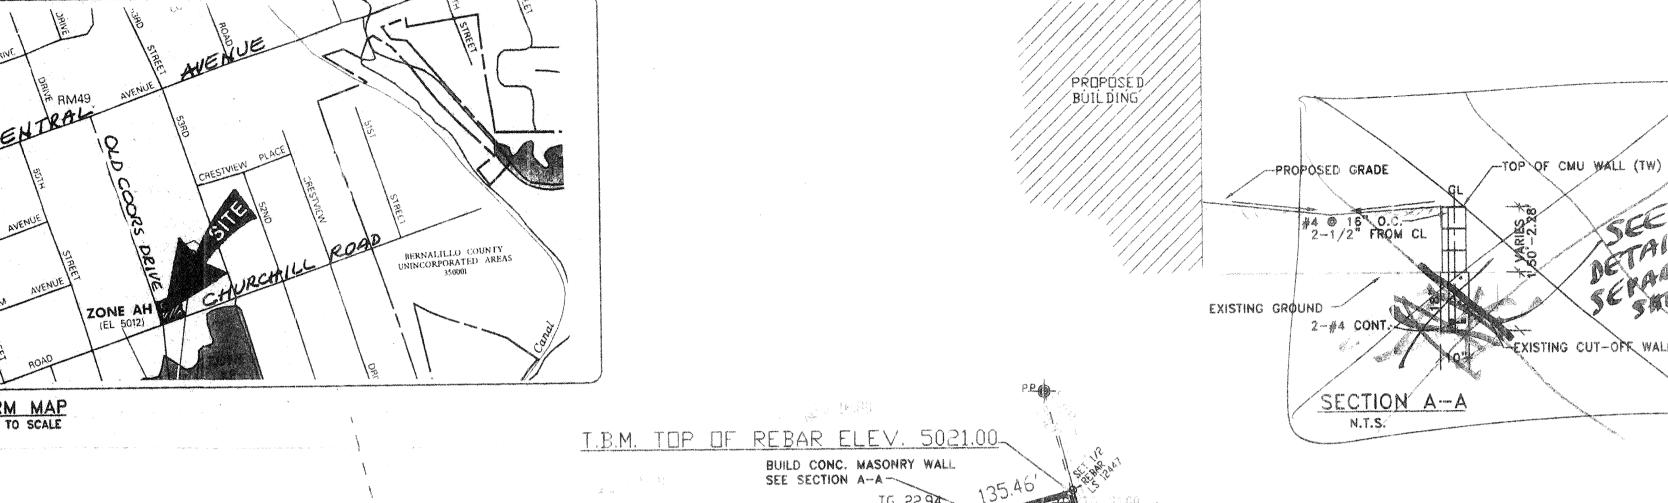

## LEGEND DIRECTION OF FLOW PROPOSED DOWNSPOUT management I ( ) Litely and a management with EXISTING CONTOUR LINE ----5022----PROPOSED CONTOUR LINE EXISTING GAS METER EXISTING WATER METER EXISTING POWER POLE POWER POLE ANCHOR TC 76,03 FL 75.38 EXISTING SPOT ELEVATION TA, 76.97 PROPOSED SPOT ELEVATION FINISHED FLOOR ELEVATION TOP OF ASPHALT

CURB FLOWLINE TOP OF CURB TOP OF GROUND OR GRAVEL TOP OF CONCRETE SLAB TOP OF CMU WALL EXISTING WATERLINE management of any and a second of the second of the second EXISTING SANITARY SEWER TAS COMMENT OF THE PROPERTY OF

> BENCHMARK: ACS NM448-C1 ELEVATION 5074.028 ADD 5000 TO EACH SPOT ELEVATION TO EQUAL SEA LEVEL DATUM ELEVATION.

AS-BUILT ELEVATION


## NOTE:

21.50 PL

1. THIS IS NOT A BOUNDARY SURVEY. PROPERTY CORNERS, BEARINGS AND DISTANCES SHOWN HEREON ARE FOR ORIENTATION PURPOSES

EXISTING STORM DRAIN

- 2. UNDERGROUND UTILITIES SHOWN HEREON ARE BASED ON MAPS AND/OR EVIDENCES ON THE GROUND. THE CONTRACTOR SHALL BE RESPONSIBLE FOR VERIFYING LOCATIONS OF ALL UTILITIES, SHOWN OR NOT SHOWN ON THIS DRAWING, PRIOR TO ANY EXCAVATIONS.
- 3. CONTRACTOR IS RESPONSIBLE FOR OBTAINING A TOPSOIL DISTURBANCE PERMIT PRIOR TO BEGINNING WORK.
- 4. CONTRACTOR IS RESPONSIBLE FOR KEEPING RUN-OFF ON SITE DURING CONSTRUCTION AND CLEANING UP SEDIMENT THAT GETS INTO EXISTING RIGHT-OF-WAY AND ADJOINING PROPERTIES AFTER CONSTRUCTION.

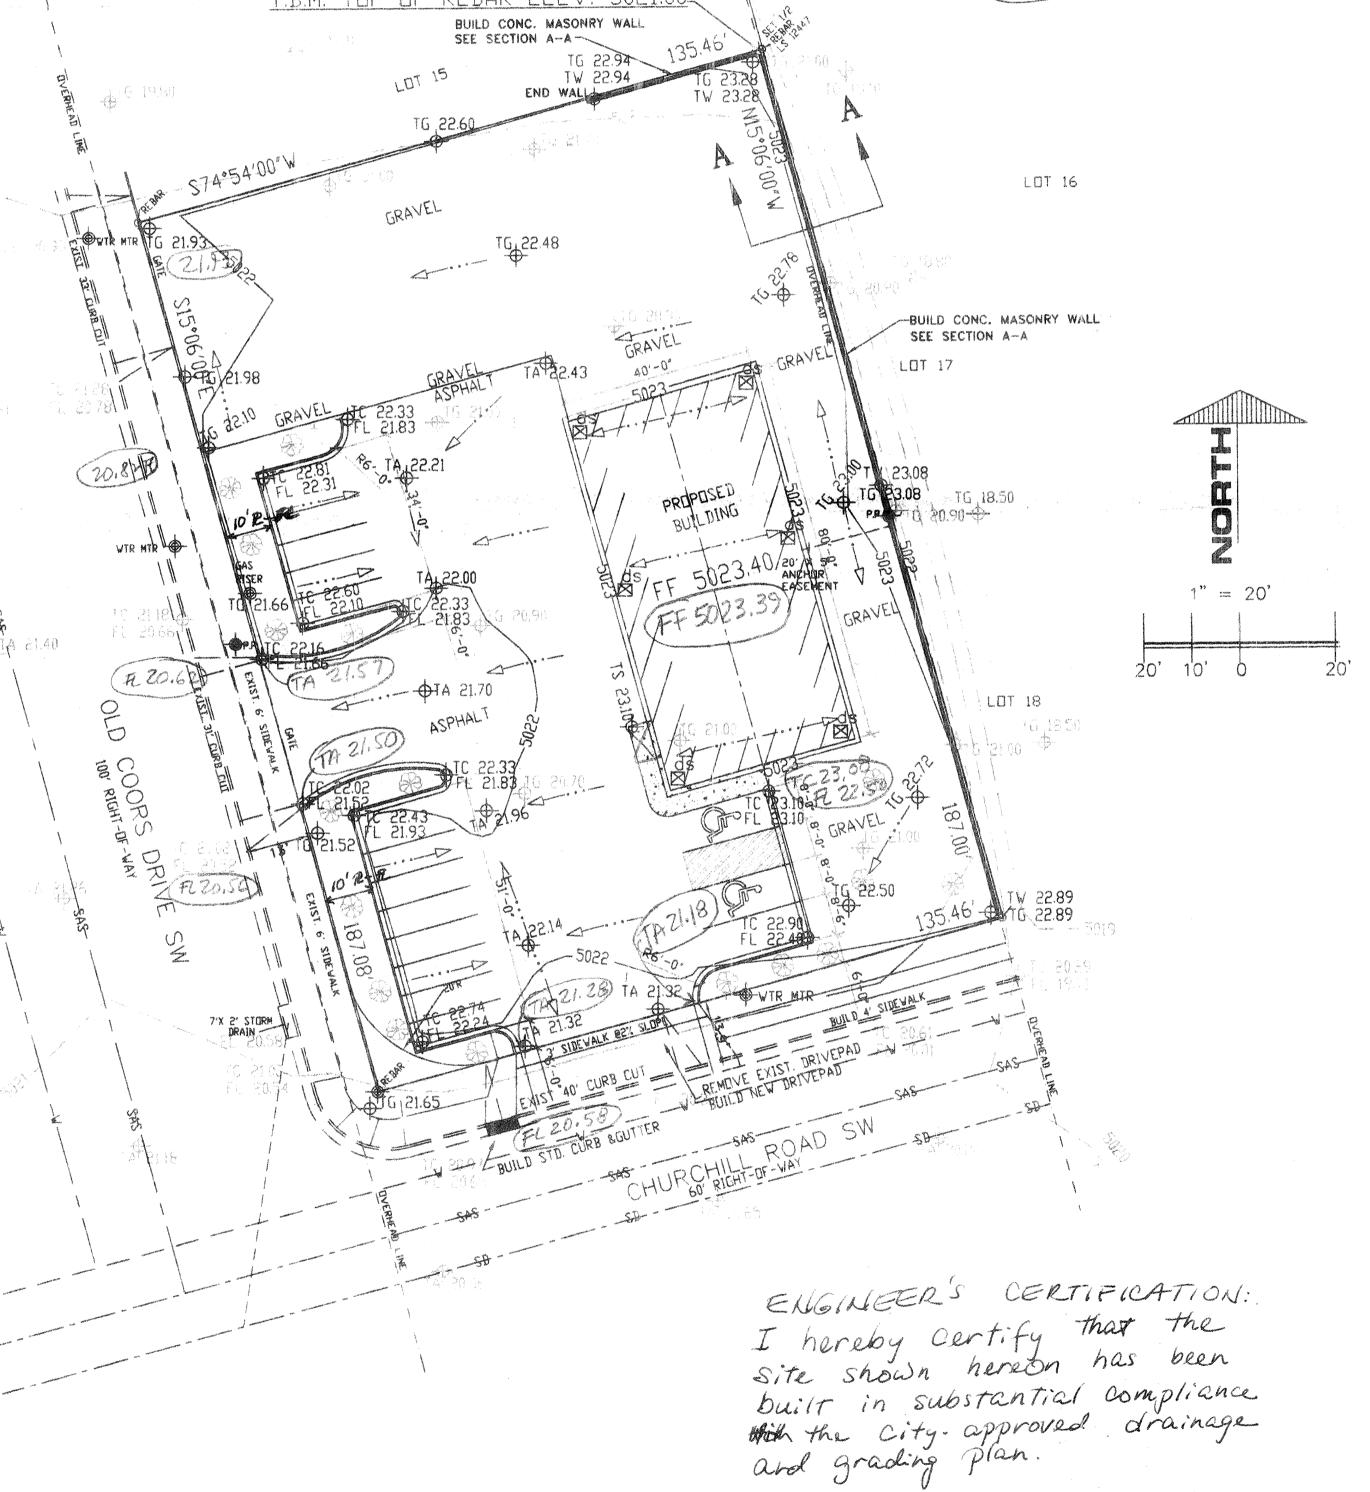

## DRAINAGE AND GRADING PLAN FOR NICOLE'S AUTOMOTIVE SHOP

LEGAL DESCRIPTION: Lot 16-A, BLOCK 1, YUCÇA ADDITION NO. 2 (Replatted by Davelopment Review Board Action)

ADDRESS: 232 OLD SOUTH COORS ROAD SW

### ZONE ATLAS K-11

FLOODPLAIN INFORMATION: The property is located in Zone X. areas of minimum flooding, according to the Floodway Boundary and Floodway Map of the City of Albuquerque, New Mexico, Community Panel 35001C0329 D, effective September 20, 1996.

EXISTING CONDITIONS: The subject property is an infill vacant land that contains an area of approximately one-half acre. The land is practically flat. The property is bounded on the west by Old Coors Drive SW. on the south by Churchill Road SW, on the east and north by improved lots. But Old Coors Drive and Churchill Raod are paved and have standard curbs and and gutters, sidewalks, and drivepads. There is catch basin on Old Coors Drive near the southwest corner of the property.

PROPOSED IMPROVEMENTS: A building with a total roof area of approximate 3200 square feet will be built. Asphalted parking lots, concrete walks, and landscaping will be provided.

OFFSITE RUN-OFF: The property receives no offsite flows.

allowed to free-discharge to Old Coors Drive.

ON-SITE RUN-OFF: The on-site runoff before development is computed. The on-site runoff after development is also calculated.

DRAINAGE PLAN CONCEPT: The on-site runoff after development will be

## CALCULATIONS:

```
Zone 1 (From DPM 22.2, page A-1)
Existing Conditions:
     Land Treatment C = 0.58 Ac.
     TOTAL
                     = 0.58 Ac.
Proposed Improvement:
     Land Treatment B = 0.03 Ac.
     Land Treatment C = 0.20
```

Existing Condition, Peak Discharge, 100-year: C = 2.87

 $Q_{000} = 0.58 \times 2.87 = 1.66 \text{ cfs}$ 

Land Treatment D = 0.25 Ac.

Volume of Runoff,

Excess Precipitation

#### 100-year: C = 0.99 $V_{100} = 0.58 \times 0.99 \times 43560/12 = 2084 \text{ cf}$

Proposed improvement: Peak Discharge, 100-year Land Treatment B, 100-year: 2.03 cfs Land Treatment C, 100-year: 2.87 cfs Land Treatment D, 100-year: 4.37 cfs

= 0.58 Acre

 $0.03 \times 2.03 = 0.06$  cfs  $0.20 \times 2.87 = 0.57 \text{ cfs}$  $0.25 \times 4.37 = 1.09 \text{ cfs}$  $Q_{100} = 1.72 \text{ cfs}$ 

Volume of Runoff, 100-year: Excess Precipitation, Land Treatment B 0.67 inch Excess Precipitation, Land Treatment C 0.99 inch

Excess Precipitation, Land Treatment D 1.97 inches  $0.03 \times 0.99 \times 43560/12 = 108 \text{ cf}$ 

 $0.20 \times 0.99 \times 43560/12 = 718 \text{ cf}$  $0.25 \times 1.97 \times 43560/12 = 1787 \text{ cf}$ 

 $V_{100} = 2613 \text{ cf}$ 

Discharge,  $Q_{100} = 1.72 - 1.66 = 0.06cfs$  (increase) Runoff Volume,  $V_{100} = 2613 - 2084 = 529$  cf (increase)

The increase in runoff will be free-discharged to Old Coors Drive. This was not adversely impact the existing basin because:

- 1. The quantity of runoff is negligible.
- 2. Old Coors Drive has no existing drainage problem. According to Carlos Montoya, PE, Drainage Engineer, the City has constructed an 84-inch diameter storm drain from the Gonzales Detention Pond to Churchill then west on Churchill past Old Coors Drive. The design used was 100—year developed conditions for free discharge from the basin. This property is within this said basin.
- 3. In 1996, the Drainage and Grading Plan of the lot on the west side of Old Coors Drive, northwest from this property, prepared by C. L. Weiss Engineering, Inc. (file K11/D55), C. L. Weiss, PE was instructed by Susan Calongne, PE, Drainage Engineer, to free—discharge to Old Coors Drive SW.

Copies of the subject drainage basin detention pond and Ms. Calongne's fax memorandum are attached and made part of this submittal.

EROSION CONTROL: Water, If any, from activities during construction and/or from rain will be temporarily ponded on site to prevent the spread of silt.

CONCLUSION: The proposed grading and drainage plan for the subject property will not have any adverse impact on or will be adversely affected by the existing drainage from the surrounding

# DRAINAGE AND GRADING PLAN FOR NICOLE'S AUTOMOTIVE SHOP

232 OLD COORS DRIVE SW

9902-113 RHOMBUS P.A., INC 2620 San Matec NE SUITE B Albuquerque, NM 87110



TEL. (505)-881-6690 FAX (505) 881-6896