



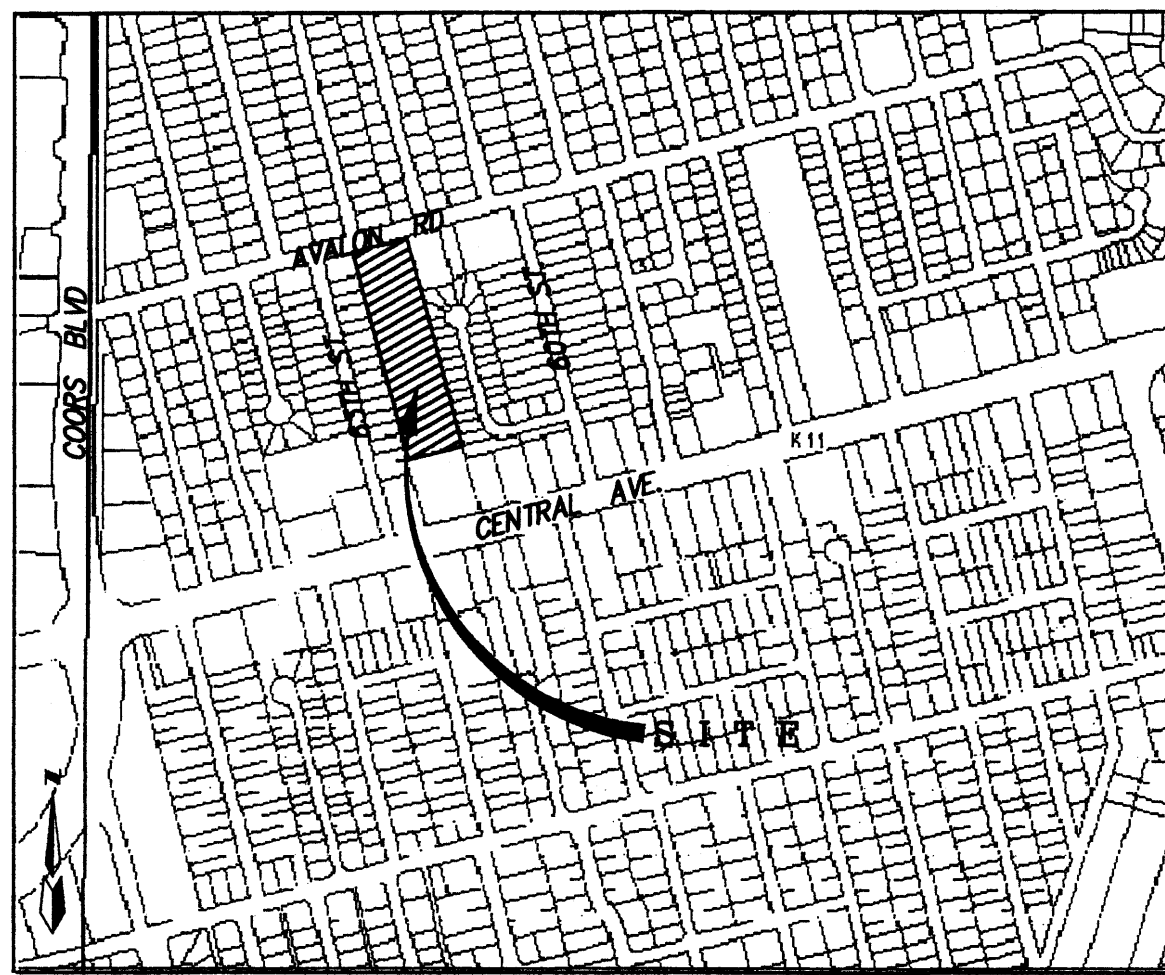

VICINITY MAP ZONE MAP: K-11-Z

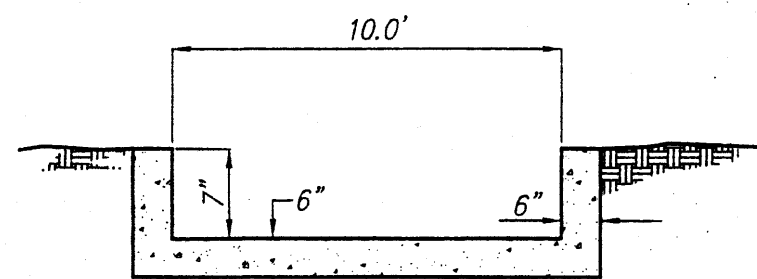

NOTE: PROVIDE 6x6 WMF AND EXPANSION JOINTS @ MIN. OF 10' O.C.

CONCRETE RUNDOWN SECTION

N.T.S.

DRAINAGE CERTIFICATION w/ VERIFICATION BY ENGINEER OF RECORD 8/05/04

DRAINAGE CERTIFICATION

I, John M. MacKenzie, NMPE 11619, of the firm Mark Goodwin & Associates, hereby certify that this project has been graded and will drain in substantial compliance with and in accordance with the design intent of the approved plan dated 12/03/01. The record information edited onto the original design document has been obtained by me or under my direct supervision and is true and correct to the best of my knowledge and belief. This certification is submitted in support of a request for Release of Financial Guaranty.

The record information presented hereon is not necessarily complete and intended only to verify substantial compliance of the grading and drainage aspects of this project. Those relying on this record document are advised to obtain independent verification of its accuracy before using it for any other purpose.

John M. MacKenzie
John M. MacKenzie NMPE 11619

(SEAL)




Date 2-7-05

PATILLY SUBDIVISION
(FILED 05-01-81, VOL. C18, FOL. 64)

PROPOSED 36" PUBLIC SANITARY SEWER,
WATER & DRAINAGE EASEMENT GRANTED TO
CITY OF ALBUQUERQUE.

EROSION CONTROL SWALE DETAIL

N.T.S.

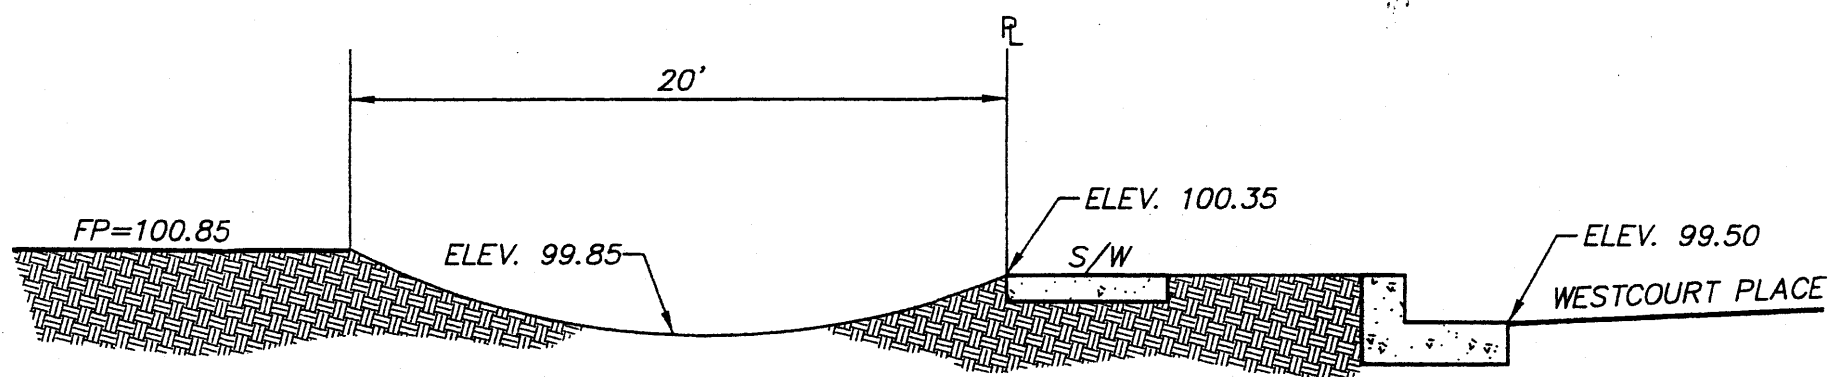


NOTES

1. CONTRACTOR MUST OBTAIN A TOPSOIL DISTURBANCE PERMIT FROM THE ENVIRONMENTAL HEALTH DIVISION PRIOR TO CONSTRUCTION.
2. CITY OF ALBUQUERQUE STANDARD SPECIFICATIONS FOR PUBLIC WORKS CONSTRUCTION, LATEST EDITION SHALL GOVERN ALL WORK.
3. THE CONTRACTOR SHALL CONFORM TO ALL CITY, COUNTY, STATE AND FEDERAL DUST CONTROL MEASURES AND REQUIREMENTS AND WILL BE RESPONSIBLE FOR PREPARING AND OBTAINING ALL NECESSARY APPLICATIONS AND APPROVALS.
4. THE CONTRACTOR SHALL ENSURE THAT NO SOIL ERODES FROM THE LOTS INTO PUBLIC RIGHT-OF-WAY. THIS CAN BE ACHIEVED BY CONSTRUCTING TEMPORARY BERMS AND WETTING THE SOIL TO KEEP IT FROM BLOWING.
5. THE EARTHWORK CONTRACTOR SHALL STOCKPILE ENOUGH MATERIAL ADJACENT TO RETAINING WALL LOCATIONS TO BE UTILIZED FOR WALL BACKFILL.

KEYED NOTES

1. TOTAL OF 2 TYPE "A" INLETS PER C.O.A. STANDARD DETAIL #2201.
TOP GRATE= 76.95
INV. EL= 73.95
2. TOTAL OF 2 TYPE "C" DOUBLE INLETS PER C.O.A. STANDARD DETAIL #2205.
TOP GRATE= 75.83
INV. EL= 72.83
3. TOTAL OF 1 TYPE "C" DOUBLE INLET PER C.O.A. STANDARD DETAIL #2205.
TOP GRATE= 74.33
INV. EL= 71.33
4. NEW 18" RCP STORM DRAIN PIPE.
5. 8" DIAMETER TYPE "C" MANHOLE PER C.O.A. STANDARD DETAIL #2101.
RM EL= 74.65
INV. IN= 71.25
INV. OUT= 71.10
6. NEW 10" WIDE CURB OUT, INV. EL=74.75
7. NEW 10" WIDE CONCRETE RUNDOWN @ 0.48% SLOPE PER DETAIL THIS SHEET.
8. 5' 2" WIDE SIDEWALK CULVERTS PER C.O.A. STANDARD DETAIL #2336.
9. 6" DIAMETER TYPE "C" MANHOLE PER C.O.A. STANDARD DETAIL #2101.
RM EL= 74.54
INV. IN= 70.40
INV. OUT= 70.30
10. NEW 24" RCP STORM DRAIN PIPE

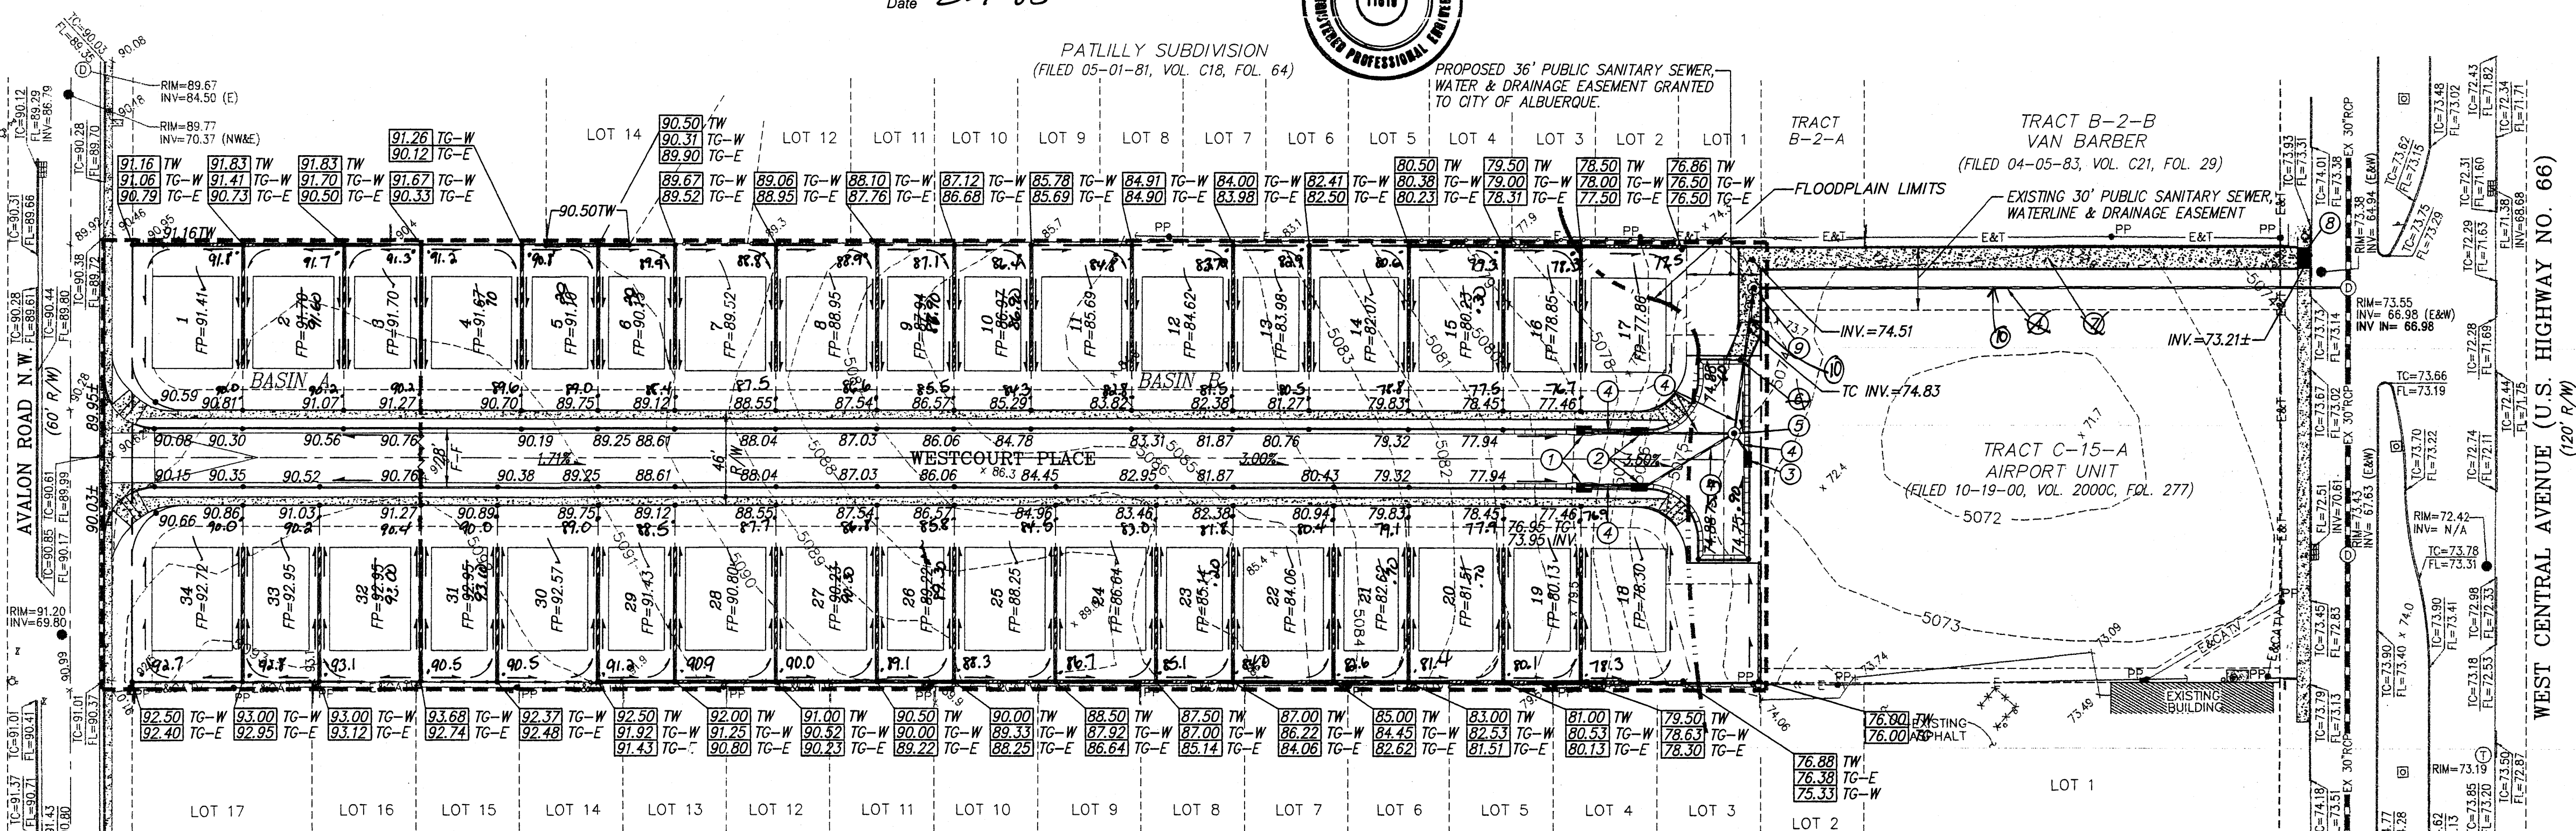


CASA BLANCA ADDITION
(FILED 12-29-45, VOL. D, FOL. 84)


RECORD DRAWING

I hereby certify that the information contained on this drawing has been revised in accordance with information furnished by the contractor, City of Albuquerque, and by the surveyor, Walker Surveying Company, and reflects the construction as actually accomplished. This drawing is constructed in substantial compliance with the Approved Plan.

Amy L. Driscoll, PE
NMPE 15334

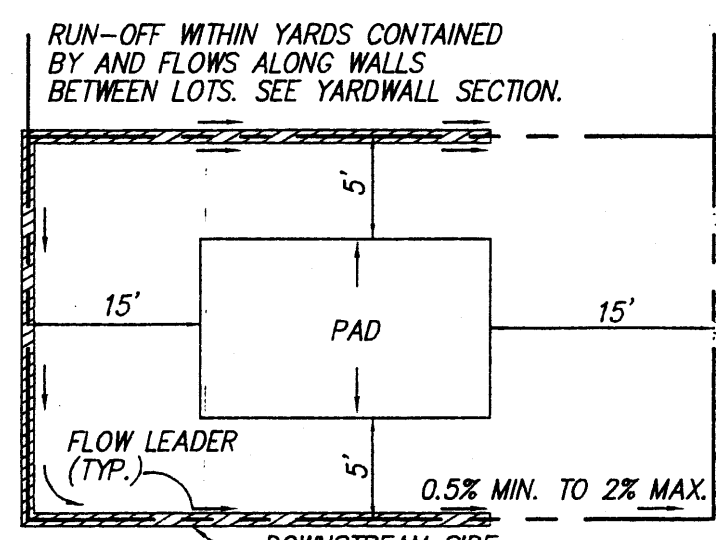


TYPICAL LOT LAYOUT PLAN
N.T.S.

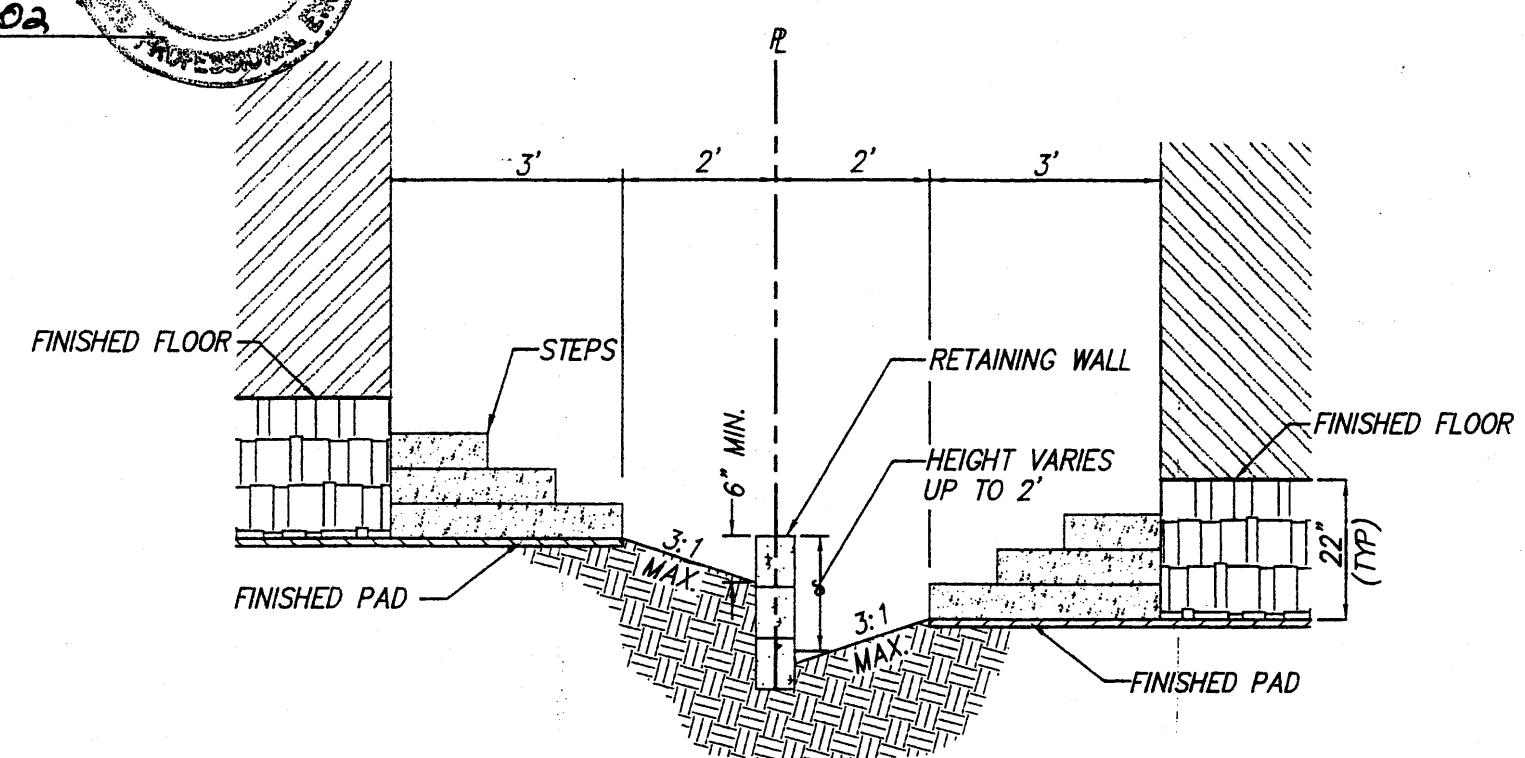



TYPICAL LOT LAYOUT SECTION
N.T.S.

LEGEND

- MOUNTABLE CURB & GUTTER
- STANDARD 8" CURB & GUTTER
- FINISHED PAD ELEVATION
- PROPOSED SPOT ELEVATION
- PROPOSED TOP OF WALL ELEVATION
- PROPOSED TOP GROUND ELEVATION-WEST
- PROPOSED TOP GROUND ELEVATION-EAST
- PROPOSED SLOPE
- FLOODPLAIN LINE
- PROPOSED WATER BLOCK
- PROPOSED 4' SIDEWALK
- TRACT/LOT BOUNDARY LINE
- RIGHT OF WAY LINE
- EASEMENT LINE
- FLOW DIRECTION
- PROPOSED SWALE
- PROPOSED RETAINING WALL
- PROPOSED STORM DRAIN PIPE
- PROPOSED STORM DRAIN MANHOLE
- PROPOSED STORM DRAIN INLET
- EXISTING CONTOUR MAJOR
- EXISTING CONTOUR MINOR
- EXISTING FIRE HYDRANT
- EXISTING WATER VALVE
- EXISTING SANITARY SEWER MANHOLE
- EXISTING STORM DRAIN MANHOLE
- EXISTING STORM DRAIN INLET
- EXISTING TOP OF CURB ELEVATION
- EXISTING FLOW LINE ELEVATION
- EXISTING SPOT ELEVATION
- EXISTING OVERHEAD ELECTRIC & CABLE TV LINE
- EXISTING POWER POLE
- EXISTING TELEPHONE MANHOLE
- EXISTING STREET LIGHT
- EXISTING CHAIN LINK FENCE
- EXISTING WOOD FENCE
- DRAINAGE BASIN LINE

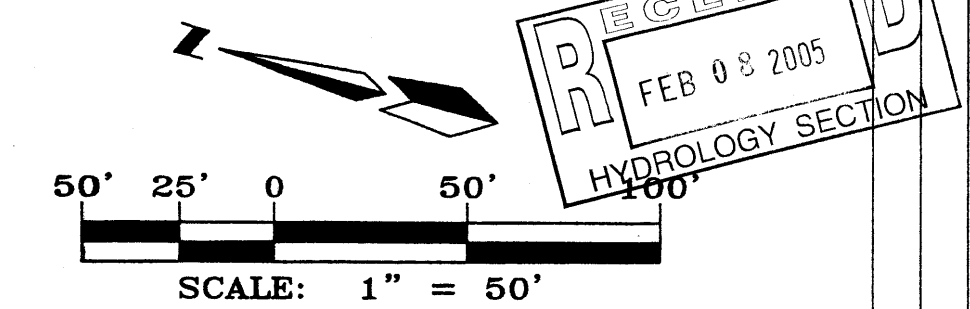

dmg MARK GOODWIN & ASSOCIATES, P.A. CONSULTING ENGINEERS P.O. BOX 90606 ALBUQUERQUE, NEW MEXICO 87199 (505) 828-2200, FAX (505) 797-9539	
CITY OF ALBUQUERQUE PUBLIC WORKS DEPARTMENT	
TITLE: St. JOSEPH'S PLACE GRADING AND DRAINAGE PLAN	
DESIGN REVIEW COMMITTEE	CITY ENGINEER APPROVAL
FOR INFORMATION ONLY	
CITY PROJECT NO. 6760.81	ZONE MAP NO. K-11-Z
SHEET 4 OF 8	

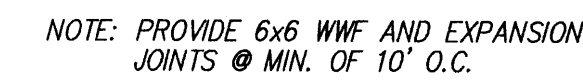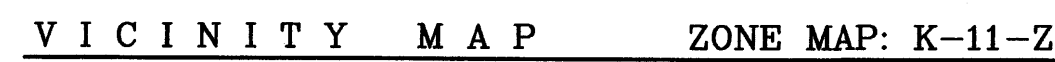


CONCRETE RUNDOWN SECTION
N.T.S.



I hereby certify that the information contained on this drawing has been revised in accordance with information furnished by the contractor, Construction Company, and by the surveyor, Walker Surveying Company, and reflects the construction as actually accomplished. This construction is in substantial compliance with the Approved Plan.





Amy L. Driscoll, PE NMPE 15334

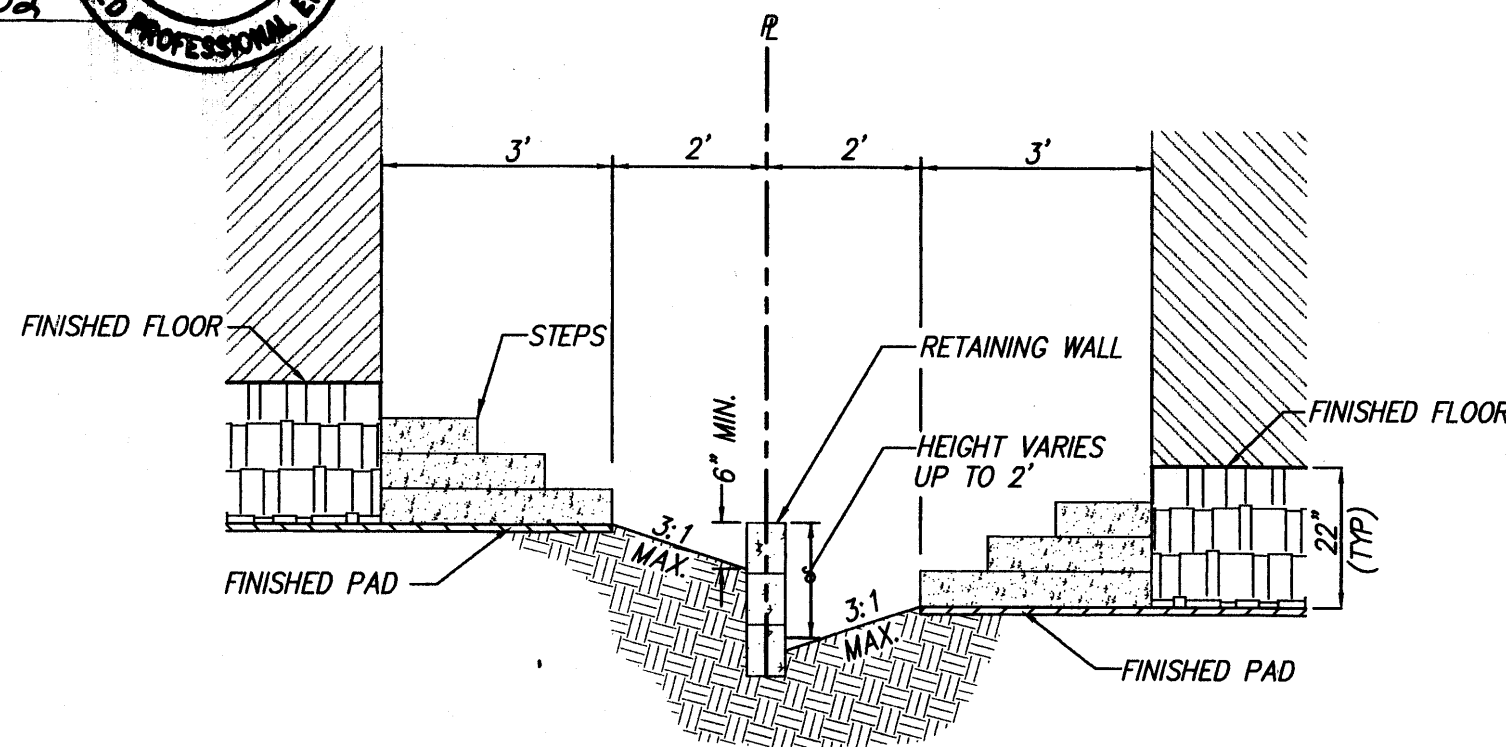


TYPICAL LOT LAYOUT SECTION
N.T.S.



    LEGEND

	MOUNTABLE CURB & GUTTER		---5135--- EXISTING SCOUR MAJOR
	STANDARD 8" CURB & GUTTER		---5135--- EXISTING CONTOUR MINOR
FP= 30.38	FINISHED PAD ELEVATION		EXISTING FIRE HYDRANT
00.00	PROPOSED SPOT ELEVATION		EXISTING WATER VALVE
85.00 TW	PROPOSED TOP OF WALL ELEVATION		EXISTING SANITARY SEWER MANHOLE
84.45 TG-W	PROPOSED TOP GROUND ELEVATION--WEST		EXISTING STORM DRAIN MANHOLE
83.37 TG-E	PROPOSED TOP GROUND ELEVATION--EAST		EXISTING STORM DRAIN INLET
	PROPOSED SLOPE		EXISTING TOP OF CURB ELEVATION
	FLOODPLAIN LINE		EXISTING FLOW LINE ELEVATION
	PROPOSED WATER BLOCK	TC=73.90 FL=73.41	
	PROPOSED 4' SIDEWALK	x 00.00	EXISTING SPOT ELEVATION
	TRACT/LOT BOUNDARY LINE		EXISTING OVERHEAD ELECTRIC & CABLE TV LINE
	RIGHT OF WAY LINE		EXISTING POWER POLE
	EASEMENT LINE		EXISTING TELEPHONE MANHOLE
	FLOW DIRECTION		EXISTING STREET LIGHT
	PROPOSED SWALE		EXISTING CHAIN LINK FENCE
	PROPOSED RETAINING WALL		EXISTING WOOD FENCE
	PROPOSED STORM DRAIN PIPE		DRAINAGE BASIN LINE
	PROPOSED STORM DRAIN MANHOLE		
	PROPOSED STORM DRAIN INLET		

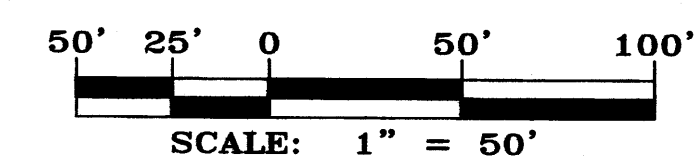

dmg MARK GOODWIN & ASSOCIATES, P.A.
CONSULTING ENGINEERS
P.O. BOX 90606
ALBUQUERQUE, NEW MEXICO 87199
(505) 828-2200, FAX (505) 797-9539

 CITY OF ALBUQUERQUE
PUBLIC WORKS DEPARTMENT

TITLE: *St. JOSEPH'S PLACE
GRADING AND DRAINAGE PLAN*


DESIGN REVIEW COMMITTEE	CITY ENGINEER APPROVAL	LAST DESIGN UPDATE	MO./DAY/YR.	MO./DAY/YR.
FOR INFORMATION ONLY				
CITY PROJECT NO.	ZONE MAP NO.	SHEET	OF	
6760.81	K-11-Z	4	8	

- ## NOTES

1. CONTRACTOR MUST OBTAIN A TOPSOIL DISTURBANCE PERMIT FROM THE ENVIRONMENTAL HEALTH DIVISION PRIOR TO CONSTRUCTION.
2. CITY OF ALBUQUERQUE STANDARD SPECIFICATIONS FOR PUBLIC WORKS CONSTRUCTION, LATEST EDITION SHALL GOVERN ALL WORK.
3. THE CONTRACTOR SHALL CONFORM TO ALL CITY, COUNTY, STATE AND FEDERAL DUST CONTROL MEASURES AND REQUIREMENTS AND WILL BE RESPONSIBLE FOR PREPARING AND OBTAINING ALL NECESSARY APPLICATIONS AND APPROVALS.
4. THE CONTRACTOR SHALL ENSURE THAT NO SOIL ERODES FROM THE LOTS INTO PUBLIC RIGHT-OF-WAY. THIS CAN BE ACHIEVED BY CONSTRUCTING TEMPORARY BERMS AND METTING THE SOIL TO KEEP IT FROM BLOWING
5. THE EARTHWORK CONTRACTOR SHALL STOCKPILE ENOUGH MATERIAL ADJACENT TO RETAINING WALL LOCATIONS TO BE UTILIZED FOR WALL BACKFILL.

KEYED NOTES

- ① TOTAL OF 2 TYPE "A" INLETS PER C.O.A. STANDARD
DETAIL #2202
TOP GRATE= 76.95
INV. EL= 73.95
- ② TOTAL OF 2 TYPE "C" DOUBLE INLETS PER C.O.A.
STANDARD DETAIL #2205.
TOP GRATE= 75.83
INV. EL= 72.83
- ③ TOTAL OF 1 TYPE "C" DOUBLE INLET PER C.O.A.
STANDARD DETAIL #2205.
TOP GRATE= 74.33
INV. EL= 71.33
- ④ NEW 18" RCP STORM DRAIN PIPE.
- ⑤ 8' DIAMETER TYPE "C" MANHOLE PER C.O.A.
STANDARD DETAIL #2101.
RIM EL= 74.65
INV. IN= 71.25
INV. OUT= 71.10
- ⑥ NEW 10" WIDE CURB OUT. INV. EL= 74.75
- ⑦ NEW 10" WIDE CONCRETE ROUNDOFF @ 0.48% SLOPE
PER DETAIL THIS SHEET.
- ⑧ 5'- 2" WIDE SIDEWALK CULVERTS PER C.O.A.
STANDARD DETAIL #2236.
- ⑨ 6' DIAMETER TYPE "C" MANHOLE PER C.O.A.
STANDARD DETAIL #2101.
RIM EL= 74.54
INV. IN= 70.40
INV. OUT= 70.30
- ⑩ NEW 24" RCP STORM DRAIN PIPE

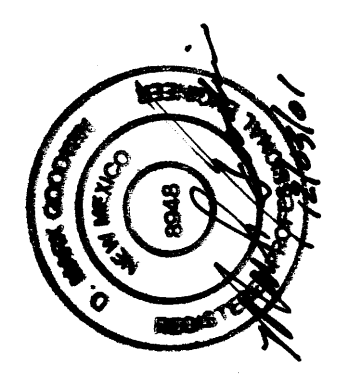


ENGINEER'S SEAL

[illegible]




VICINITY MAP ZONE MAP: K-11-Z

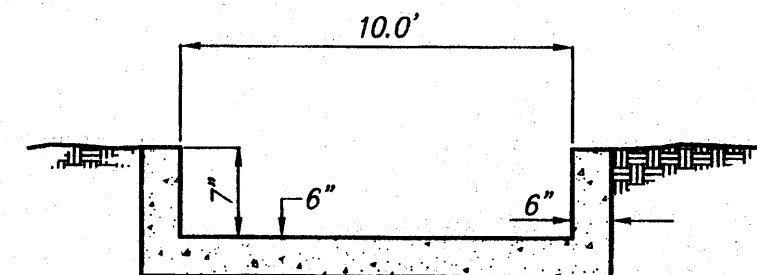

NOTE: PROVIDE 6x6 WWF AND EXPANSION JOINTS @ MIN. OF 10' O.C.

CONCRETE RUNDOWN SECTION
N.T.S.

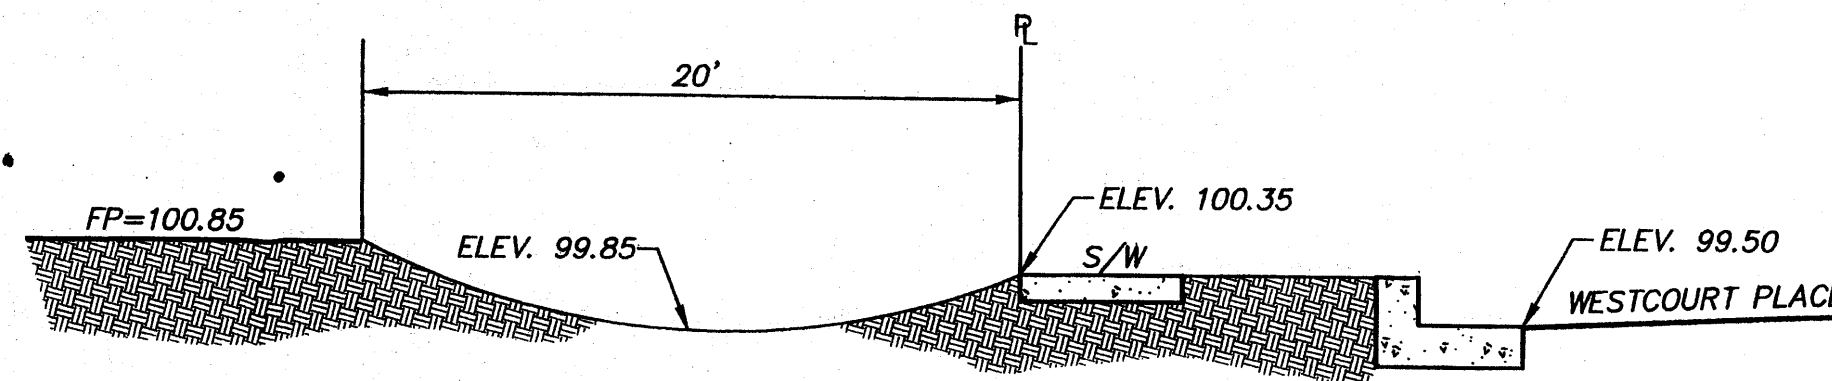



EROSION CONTROL SWALE DETAIL
N.T.S.

NOTES


1. CONTRACTOR MUST OBTAIN A TOPSOIL DISTURBANCE PERMIT FROM THE ENVIRONMENTAL HEALTH DIVISION PRIOR TO CONSTRUCTION.
2. CITY OF ALBUQUERQUE STANDARD SPECIFICATIONS FOR PUBLIC WORKS CONSTRUCTION, LATEST EDITION SHALL GOVERN ALL WORK.
3. THE CONTRACTOR SHALL CONFORM TO ALL CITY, COUNTY, STATE AND FEDERAL DUST CONTROL MEASURES AND REQUIREMENTS AND WILL BE RESPONSIBLE FOR PREPARING AND OBTAINING ALL NECESSARY APPLICATIONS AND APPROVALS.
4. THE CONTRACTOR SHALL ENSURE THAT NO SOIL ERODES FROM THE LOTS INTO PUBLIC RIGHT-OF-WAY. THIS CAN BE ACHIEVED BY CONSTRUCTING TEMPORARY BERMS AND WETTING THE SOIL TO KEEP IT FROM BLOWING.
5. THE EARTHWORK CONTRACTOR SHALL STOCKPILE ENOUGH MATERIAL ADJACENT TO RETAINING WALL LOCATIONS TO BE UTILIZED FOR WALL BACKFILL.

KEYED NOTES

1. TOTAL OF 2 TYPE "A" INLETS PER C.O.A. STANDARD DETAIL #2202.
TOP GRADE = 76.95
INV. EL = 73.95
2. TOTAL OF 2 TYPE "C" DOUBLE INLETS PER C.O.A. STANDARD DETAIL #2205.
TOP GRADE = 75.83
INV. EL = 72.83
3. TOTAL OF 1 TYPE "C" DOUBLE INLET PER C.O.A. STANDARD DETAIL #2205.
TOP GRADE = 74.33
INV. EL = 71.33
4. NEW 18" RCP STORM DRAIN PIPE.
5. 8" DIAMETER TYPE "C" MANHOLE PER C.O.A. STANDARD DETAIL #2101.
RM EL = 74.65
INV. IN = 71.25
INV. OUT = 71.10
6. NEW 10" WIDE CURB OUT. INV. EL = 74.75
7. NEW 10" WIDE CONCRETE RUNDOWN @ 0.48% SLOPE PER DETAIL THIS SHEET.
8. 5-2' WIDE SIDEWALK CULVERTS PER C.O.A. STANDARD DETAIL #2236.
9. 6" DIAMETER TYPE "C" MANHOLE PER C.O.A. STANDARD DETAIL #2101.
RM EL = 74.54
INV. IN = 70.40
INV. OUT = 70.30

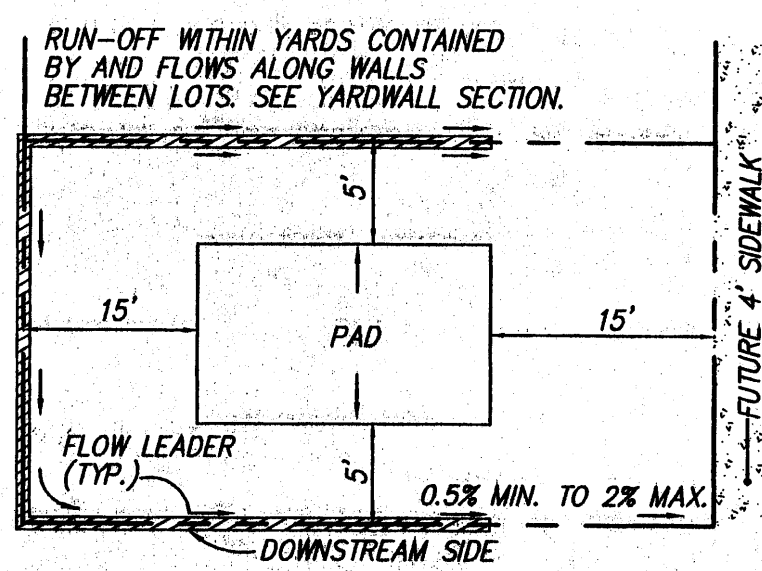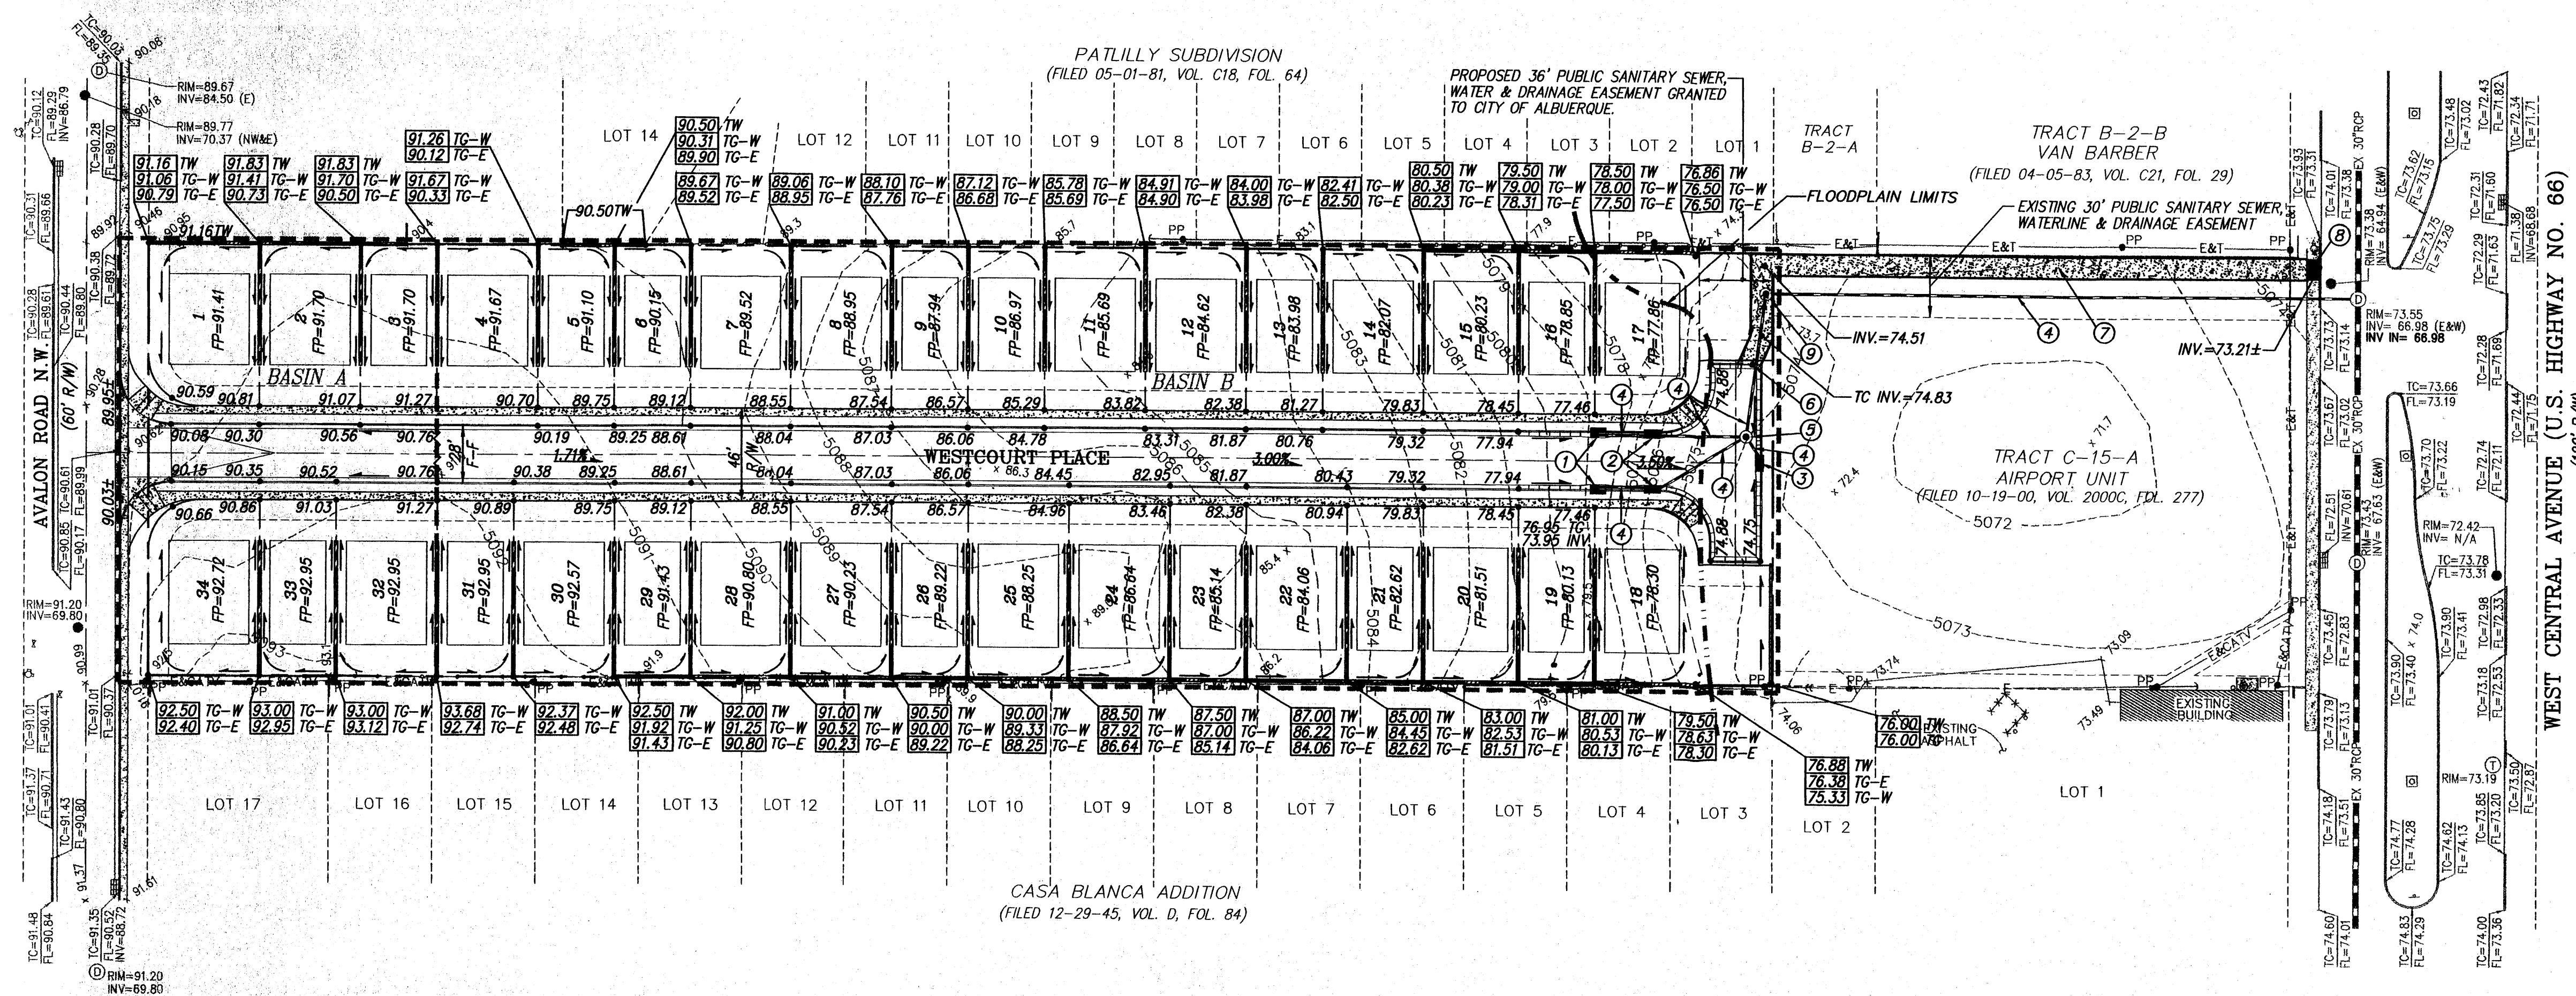


TYPICAL LOT LAYOUT PLAN
N.T.S.

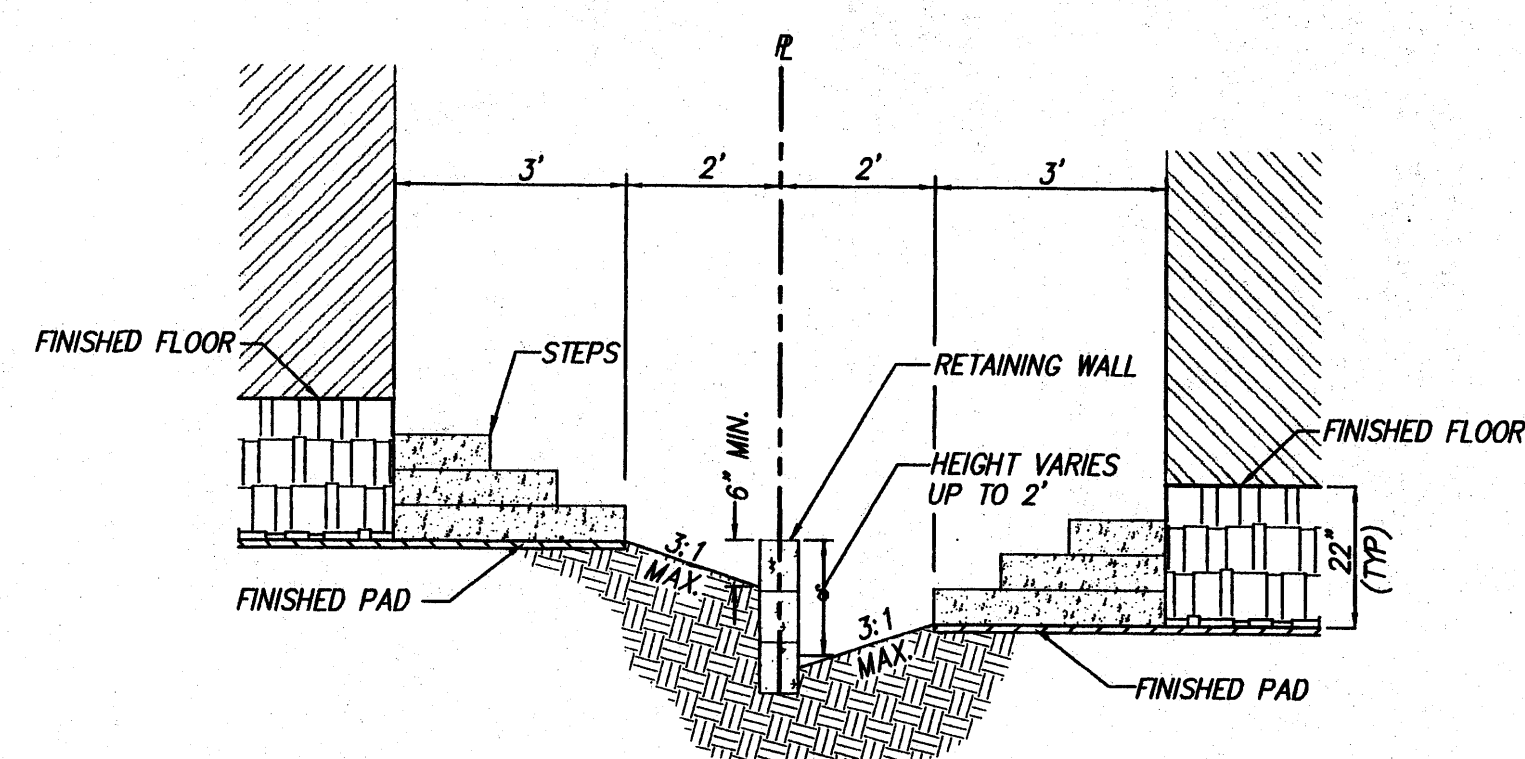

TYPICAL LOT LAYOUT SECTION
N.T.S.


LEGEND

- | | |
|---|--|
| — MOUNTABLE CURB & GUTTER | — 5135 — EXISTING CONTOUR MAJOR |
| — STANDARD 8" CURB & GUTTER | — 5135 — EXISTING CONTOUR MINOR |
| FP = 30.38 FINISHED PAD ELEVATION | — EXISTING FIRE HYDRANT |
| 00.00 PROPOSED SPOT ELEVATION | — EXISTING WATER VALVE |
| 85.00 TW PROPOSED TOP OF WALL ELEVATION | — EXISTING SANITARY SEWER MANHOLE |
| 84.45 TW PROPOSED TOP GROUND ELEVATION—WEST | — EXISTING STORM DRAIN MANHOLE |
| 83.37 TW PROPOSED TOP GROUND ELEVATION—EAST | — EXISTING STORM DRAIN INLET |
| — PROPOSED SLOPE | — EXISTING TOP OF CURB ELEVATION |
| — FLOODPLAIN LINE | — EXISTING FLOW LINE ELEVATION |
| — PROPOSED WATER BLOCK | — EXISTING SPOT ELEVATION |
| — PROPOSED 4' SIDEWALK | — EXISTING OVERHEAD ELECTRIC & CABLE TV LINE |
| — TRACT/LOT BOUNDARY LINE | — EXISTING POWER POLE |
| — RIGHT OF WAY LINE | — EXISTING TELEPHONE MANHOLE |
| — EASEMENT LINE | — EXISTING STREET LIGHT |
| — FLOW DIRECTION | — EXISTING CHAIN LINK FENCE |
| — PROPOSED SWALE | — EXISTING WOOD FENCE |
| — PROPOSED RETAINING WALL | — DRAINAGE BASIN LINE |
| — PROPOSED STORM DRAIN PIPE | |
| — PROPOSED STORM DRAIN MANHOLE | |
| — PROPOSED STORM DRAIN INLET | |

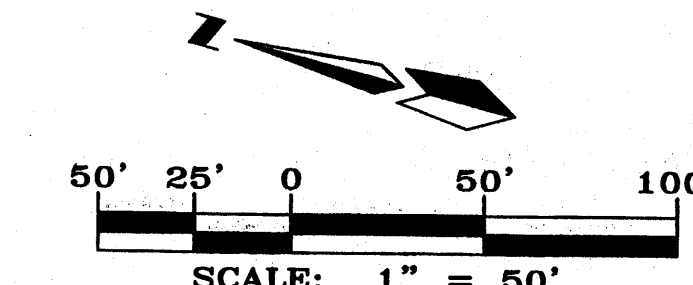

MARK GOODWIN & ASSOCIATES, P.A. CONSULTING ENGINEERS P.O. BOX 90606 ALBUQUERQUE, NEW MEXICO 87199 (505) 828-2200, FAX (505) 797-9539	
TITLE: St. JOSEPH'S PLACE GRADING AND DRAINAGE PLAN	
DESIGN REVIEW COMMITTEE	CITY ENGINEER APPROVAL
DATE	DATE
MO./DAY/YR.	MO./DAY/YR.
CITY PROJECT NO. 6760.81	ZONE MAP NO. K-11-Z
SHEET 4	OF 8

A1024an\A1024gd3.dwg\12-03-01\DER

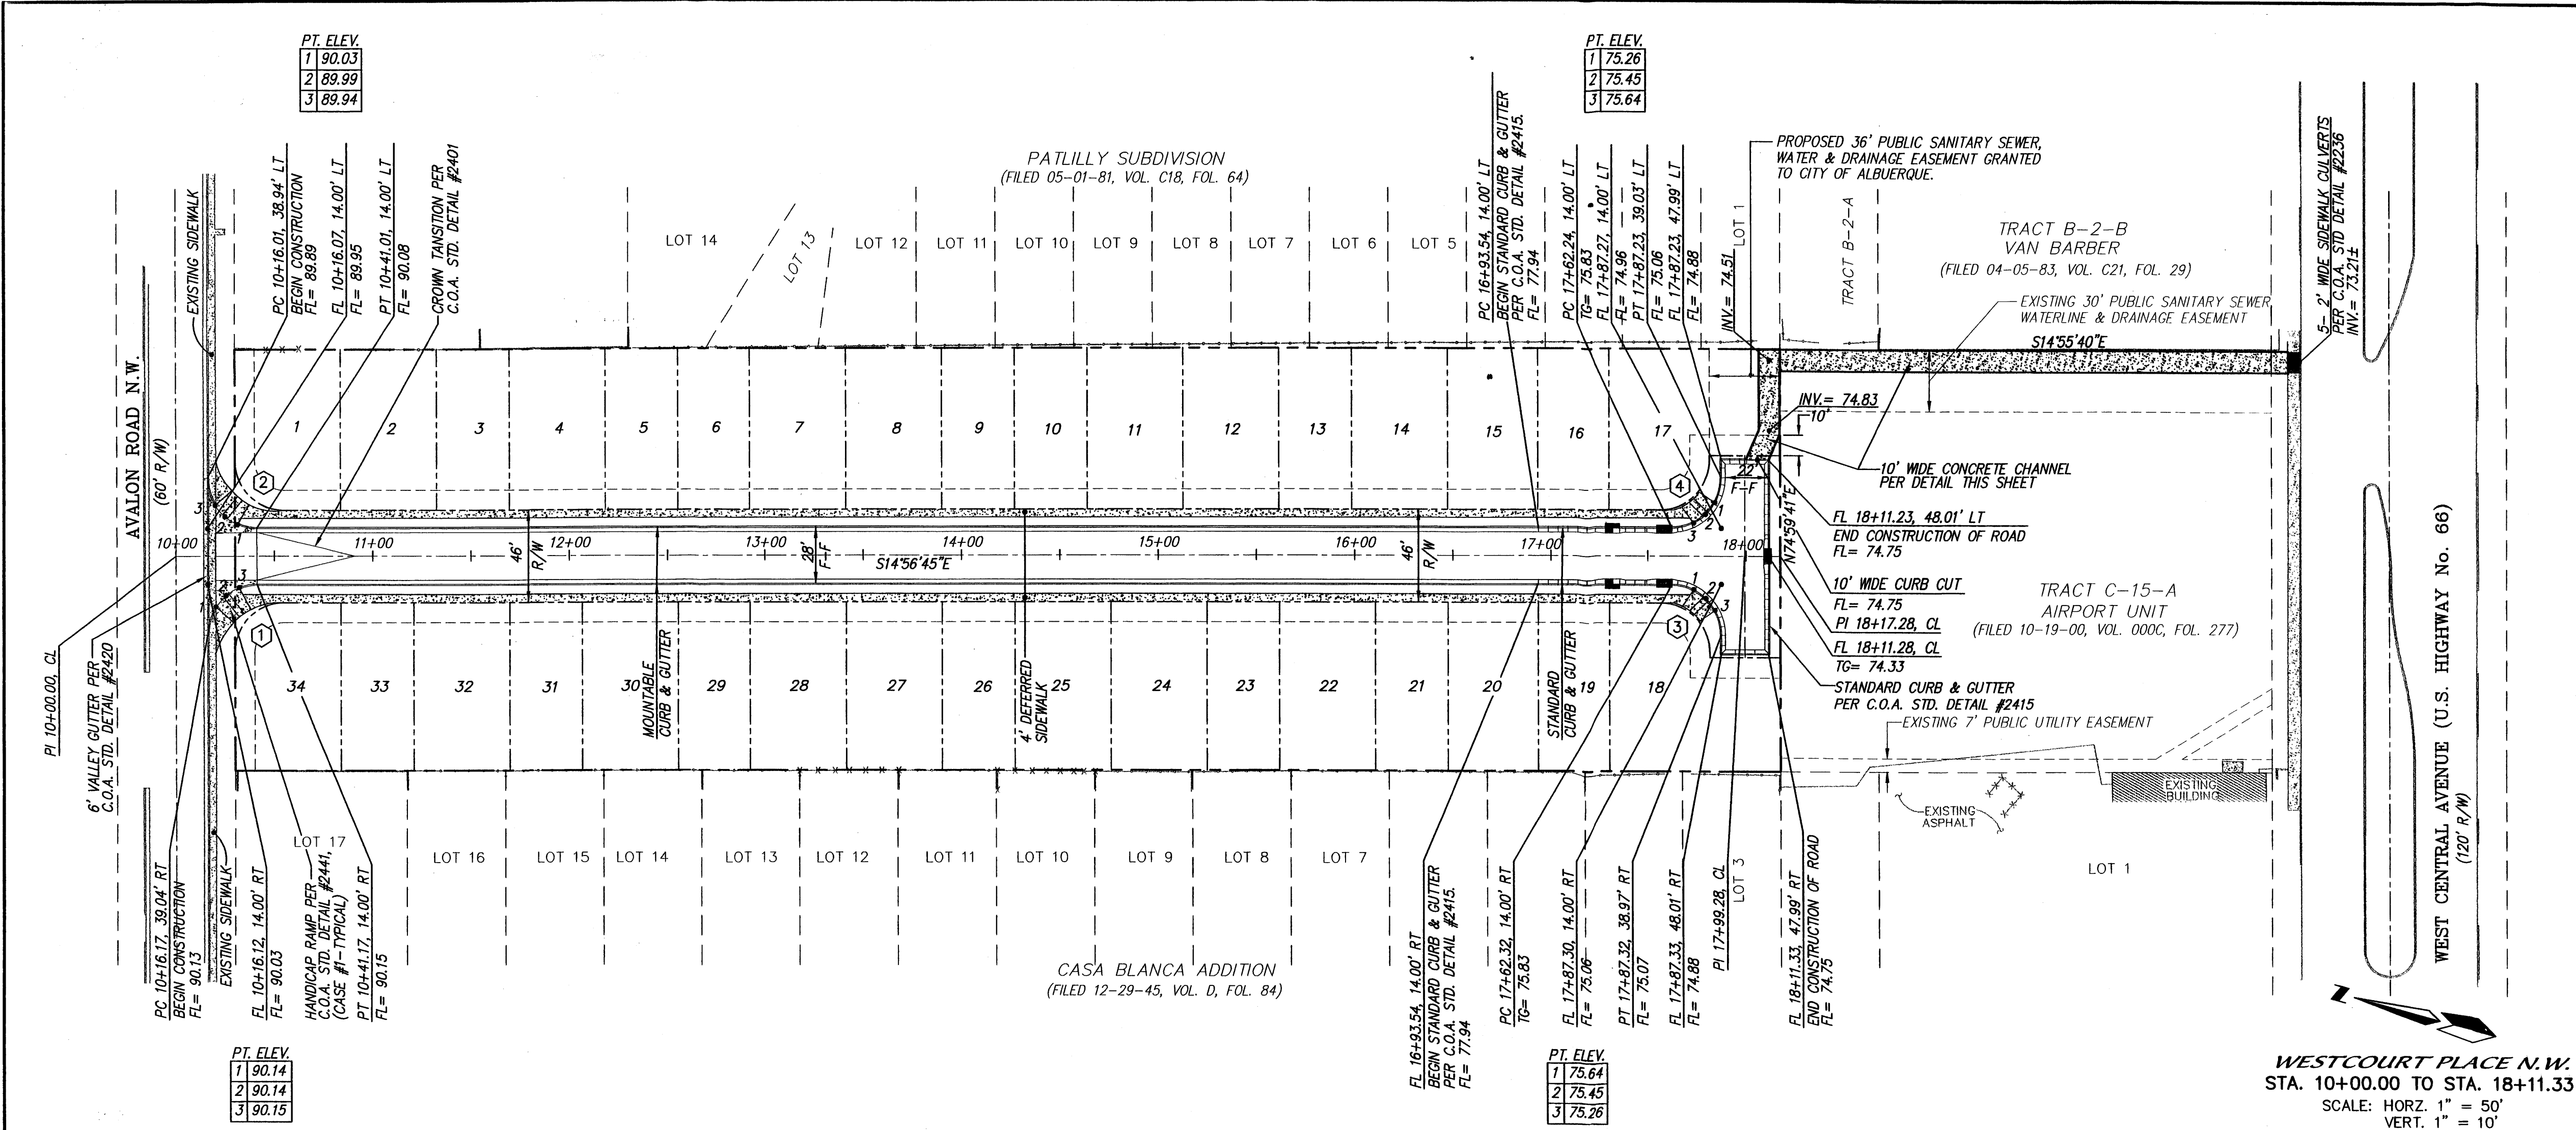

NOTES

- ALL STATIONING IS CENTERLINE STATIONING.
- PAVING PER C.O.A. STD. DETAIL #2405 AND PAVING SECTION DETAIL THIS SHEET.
- TRANSITION EXISTING SIDEWALK ON AVALON ROAD TO NEW WHEEL CHAIR RAMPS.

CURVE DATA - DESCRIBES FACE OF NEW CURB

① Δ = 90°05'54"	② Δ = 89°51'59"	③ Δ = 89°56'26"
R = 25.00'	R = 25.00'	R = 25.00'
L = 39.31'	L = 39.21'	L = 39.24'
T = 25.04'	T = 24.94'	T = 24.97'

④ Δ = 90°03'34"

R = 25.00'

L = 39.30'

T = 25.03'

CONCRETE RUNDOWN SECTION


N.T.S.

WESTCOURT PLACE N.W.

STA. 10+00.00 TO STA. 18+11.33

SCALE: HORIZ. 1" = 50'

VERT. 1" = 10'

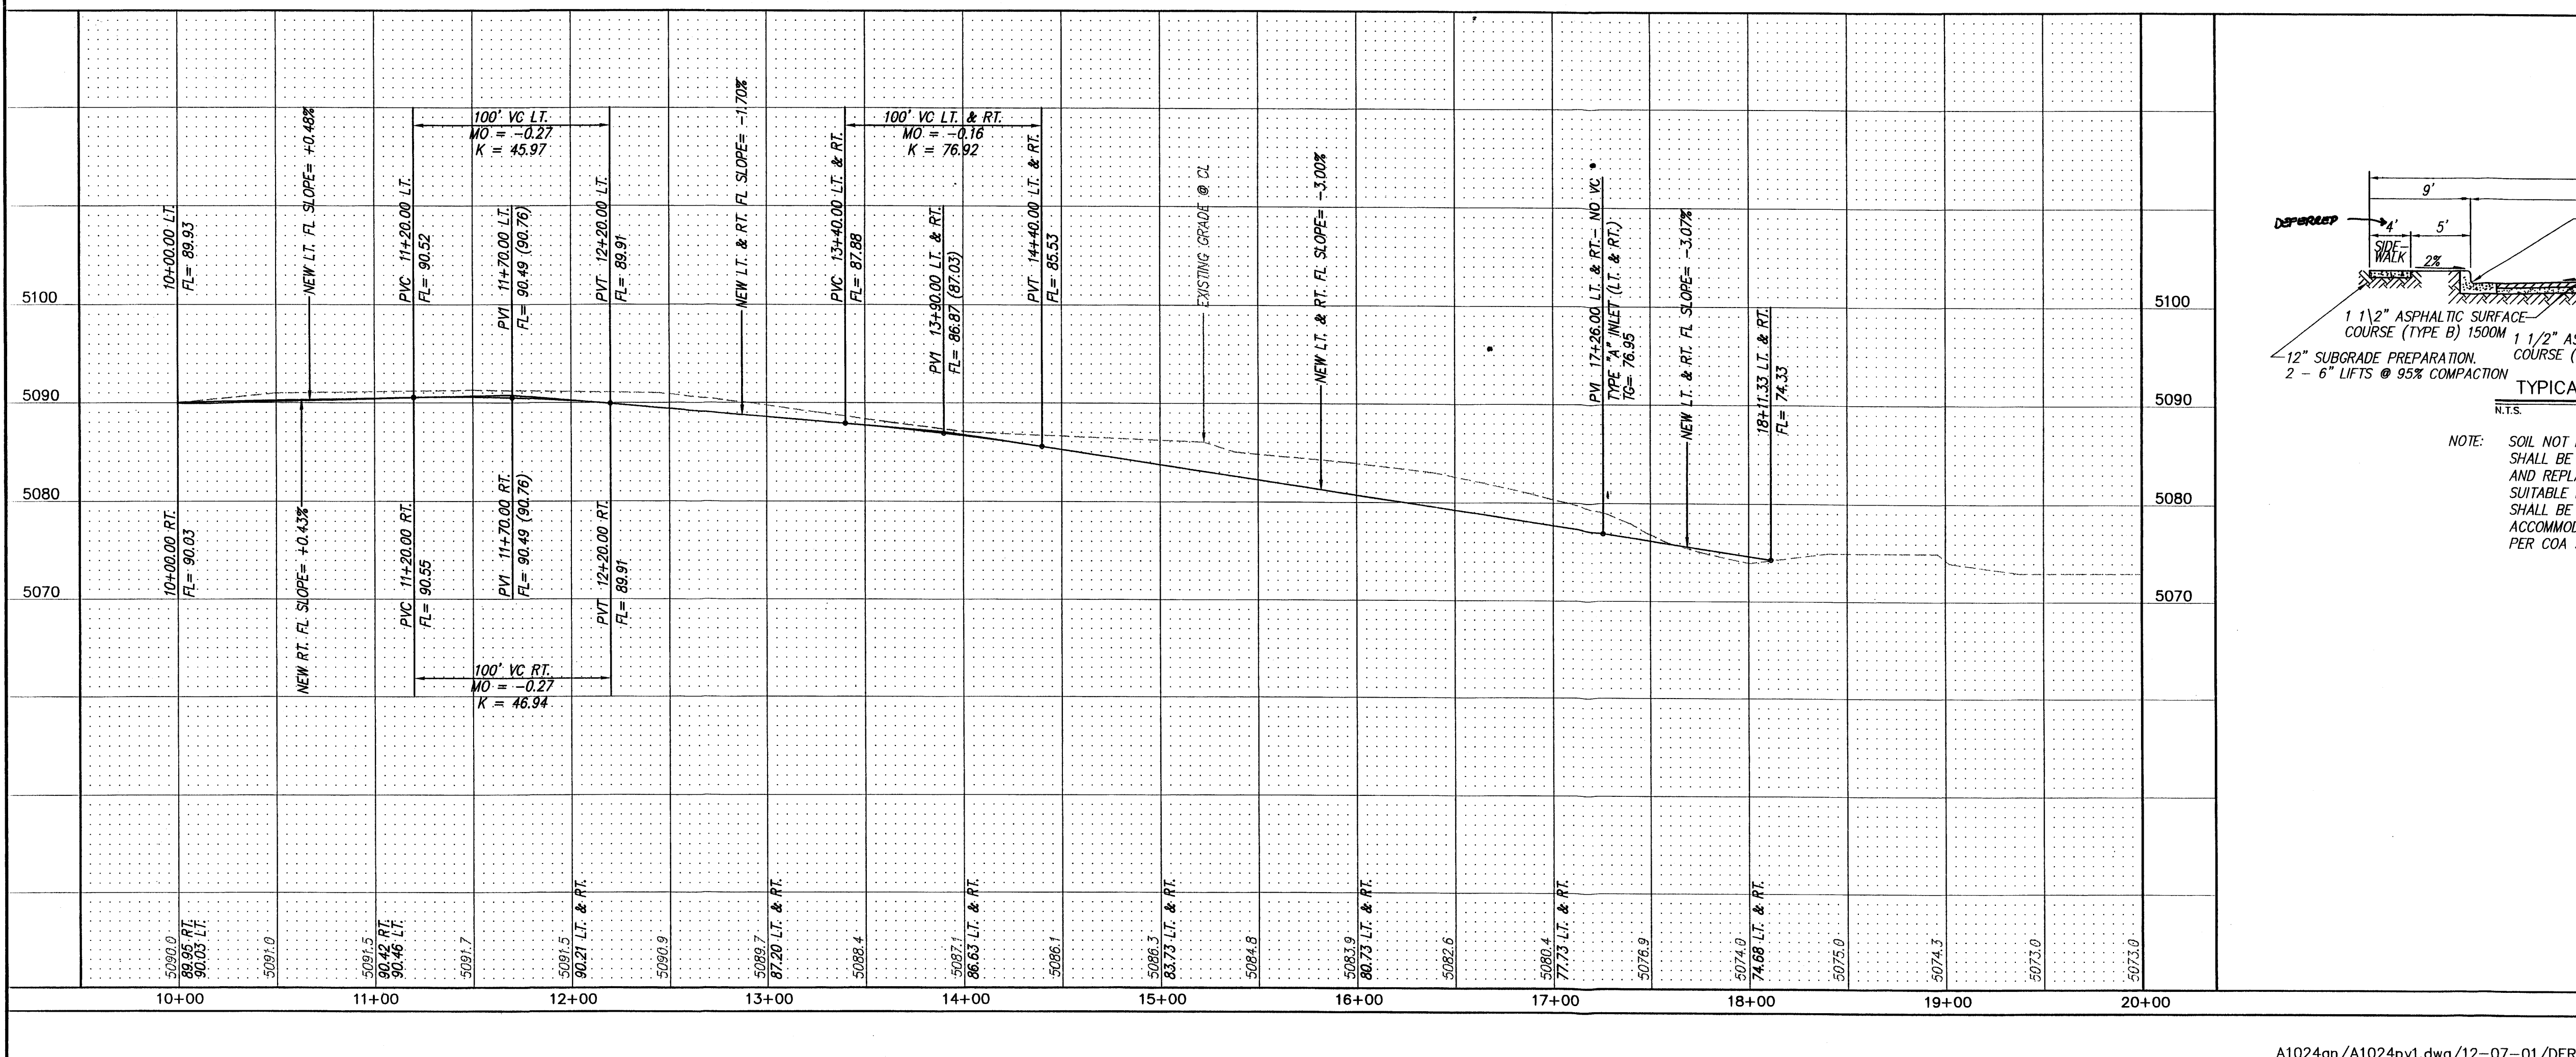

TYPICAL 28' STREET SECTION

N.T.S.

NOTE: SOIL NOT HAVING THE MINIMUM R-VALUE OF 50 SHALL BE REMOVED TO A DEPTH OF 2 FEET AND REPLACED, BY THE CONTRACTOR, WITH SUITABLE MATERIAL, OR A PAVEMENT SECTION SHALL BE DESIGNED BY THE CONSULTANT ACCOMMODATING THE EXISTING R-VALUE PER COA STANDARD SPECIFICATIONS.

CITY OF ALBUQUERQUE

PUBLIC WORKS DEPARTMENT



ST. JOSEPH'S PLACE

WESTCOURT PLACE N.W.

PAVING PLAN AND PROFILE PLAN

DESIGN REVIEW COMMITTEE	CITY ENGINEER APPROVAL	MO./DAY/YR.	MO./DAY/YR.
DATE	DATE	DATE	DATE


CITY PROJECT NO. **6760.81** ZONE MAP NO. **K-11-Z** SHEET **5** OF **8**

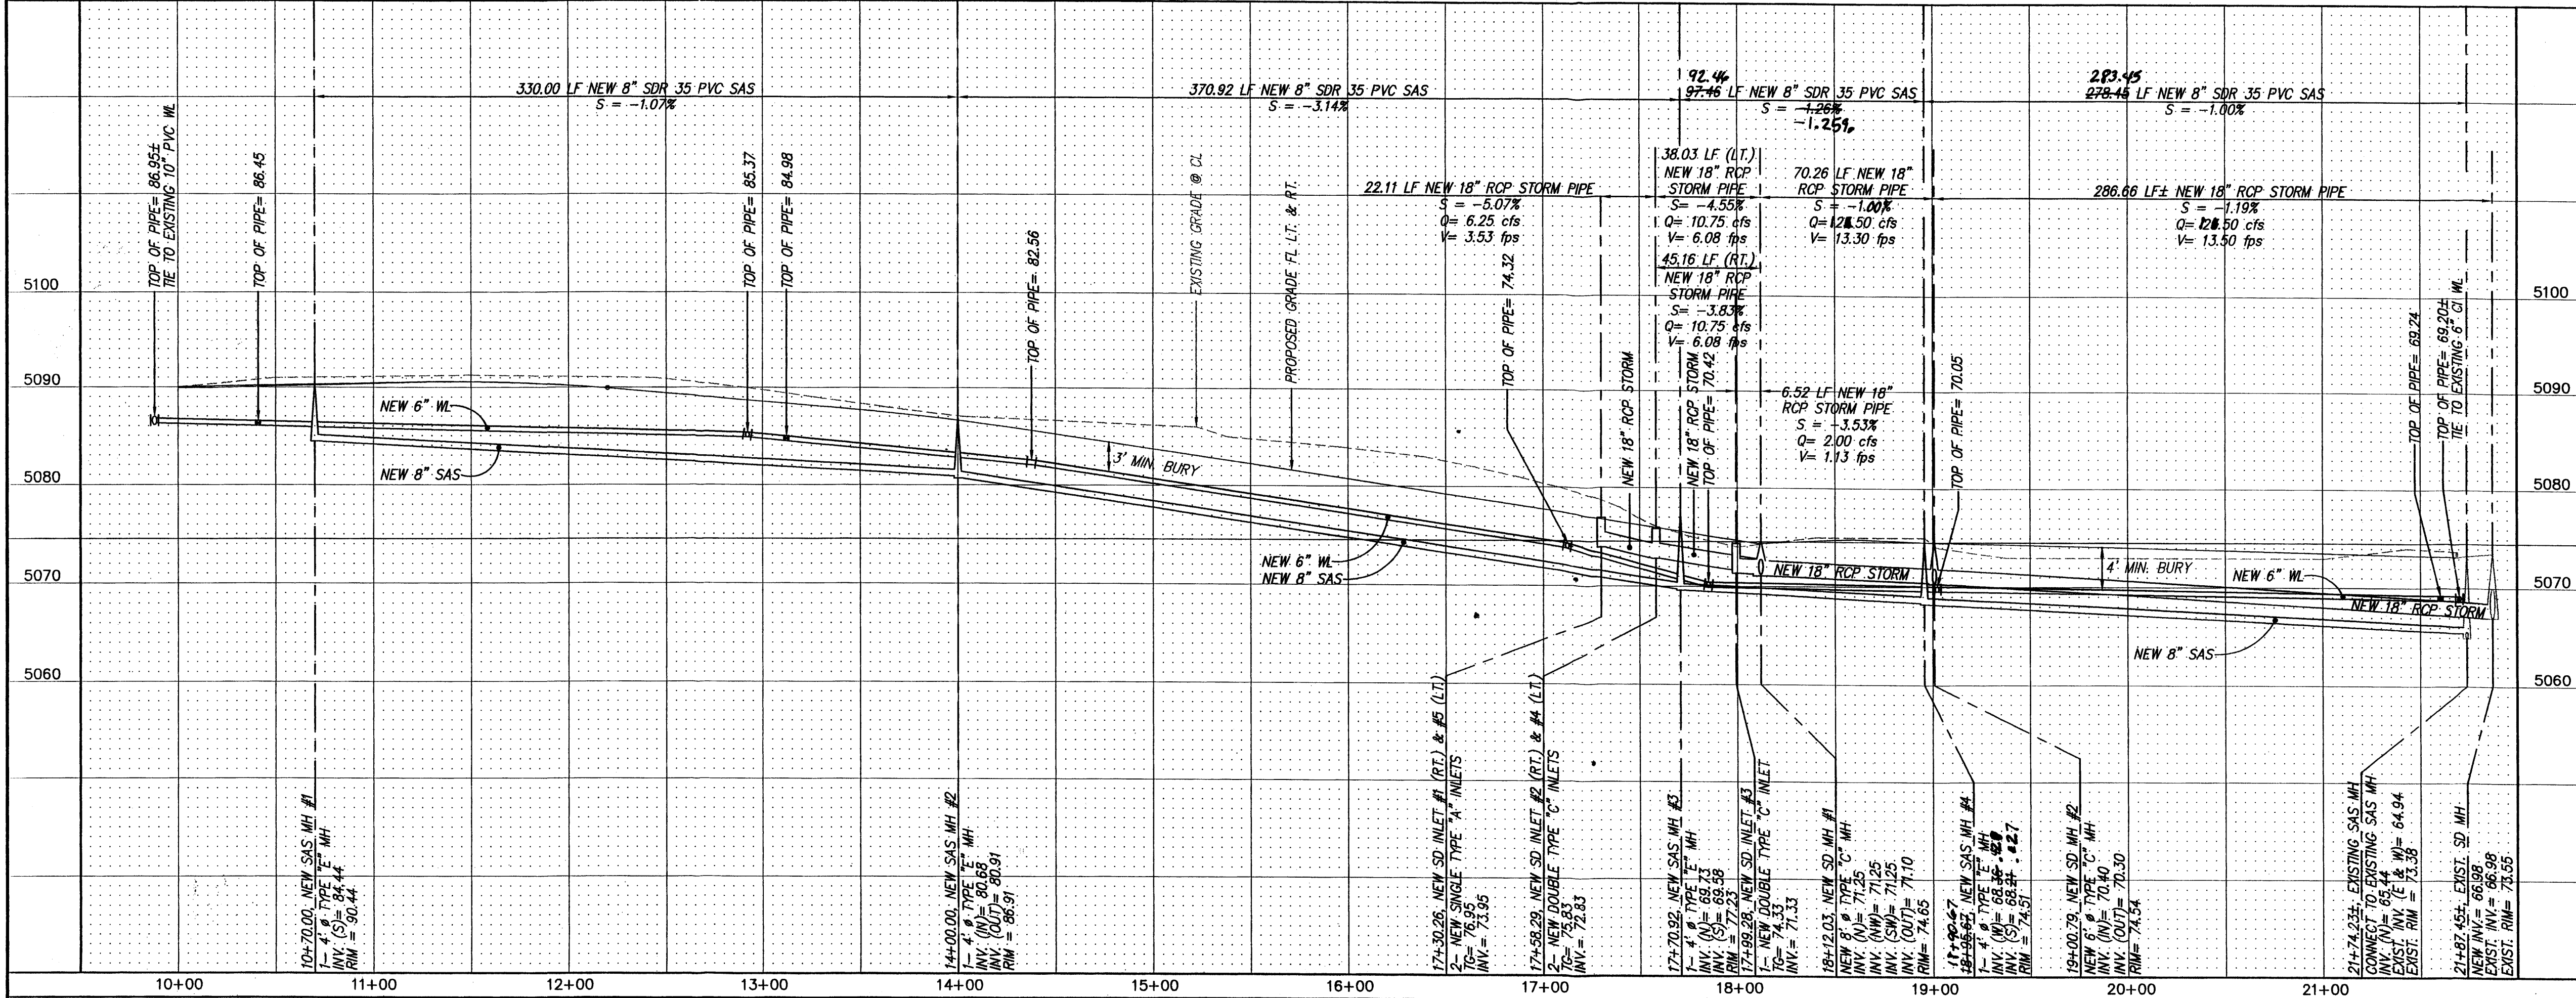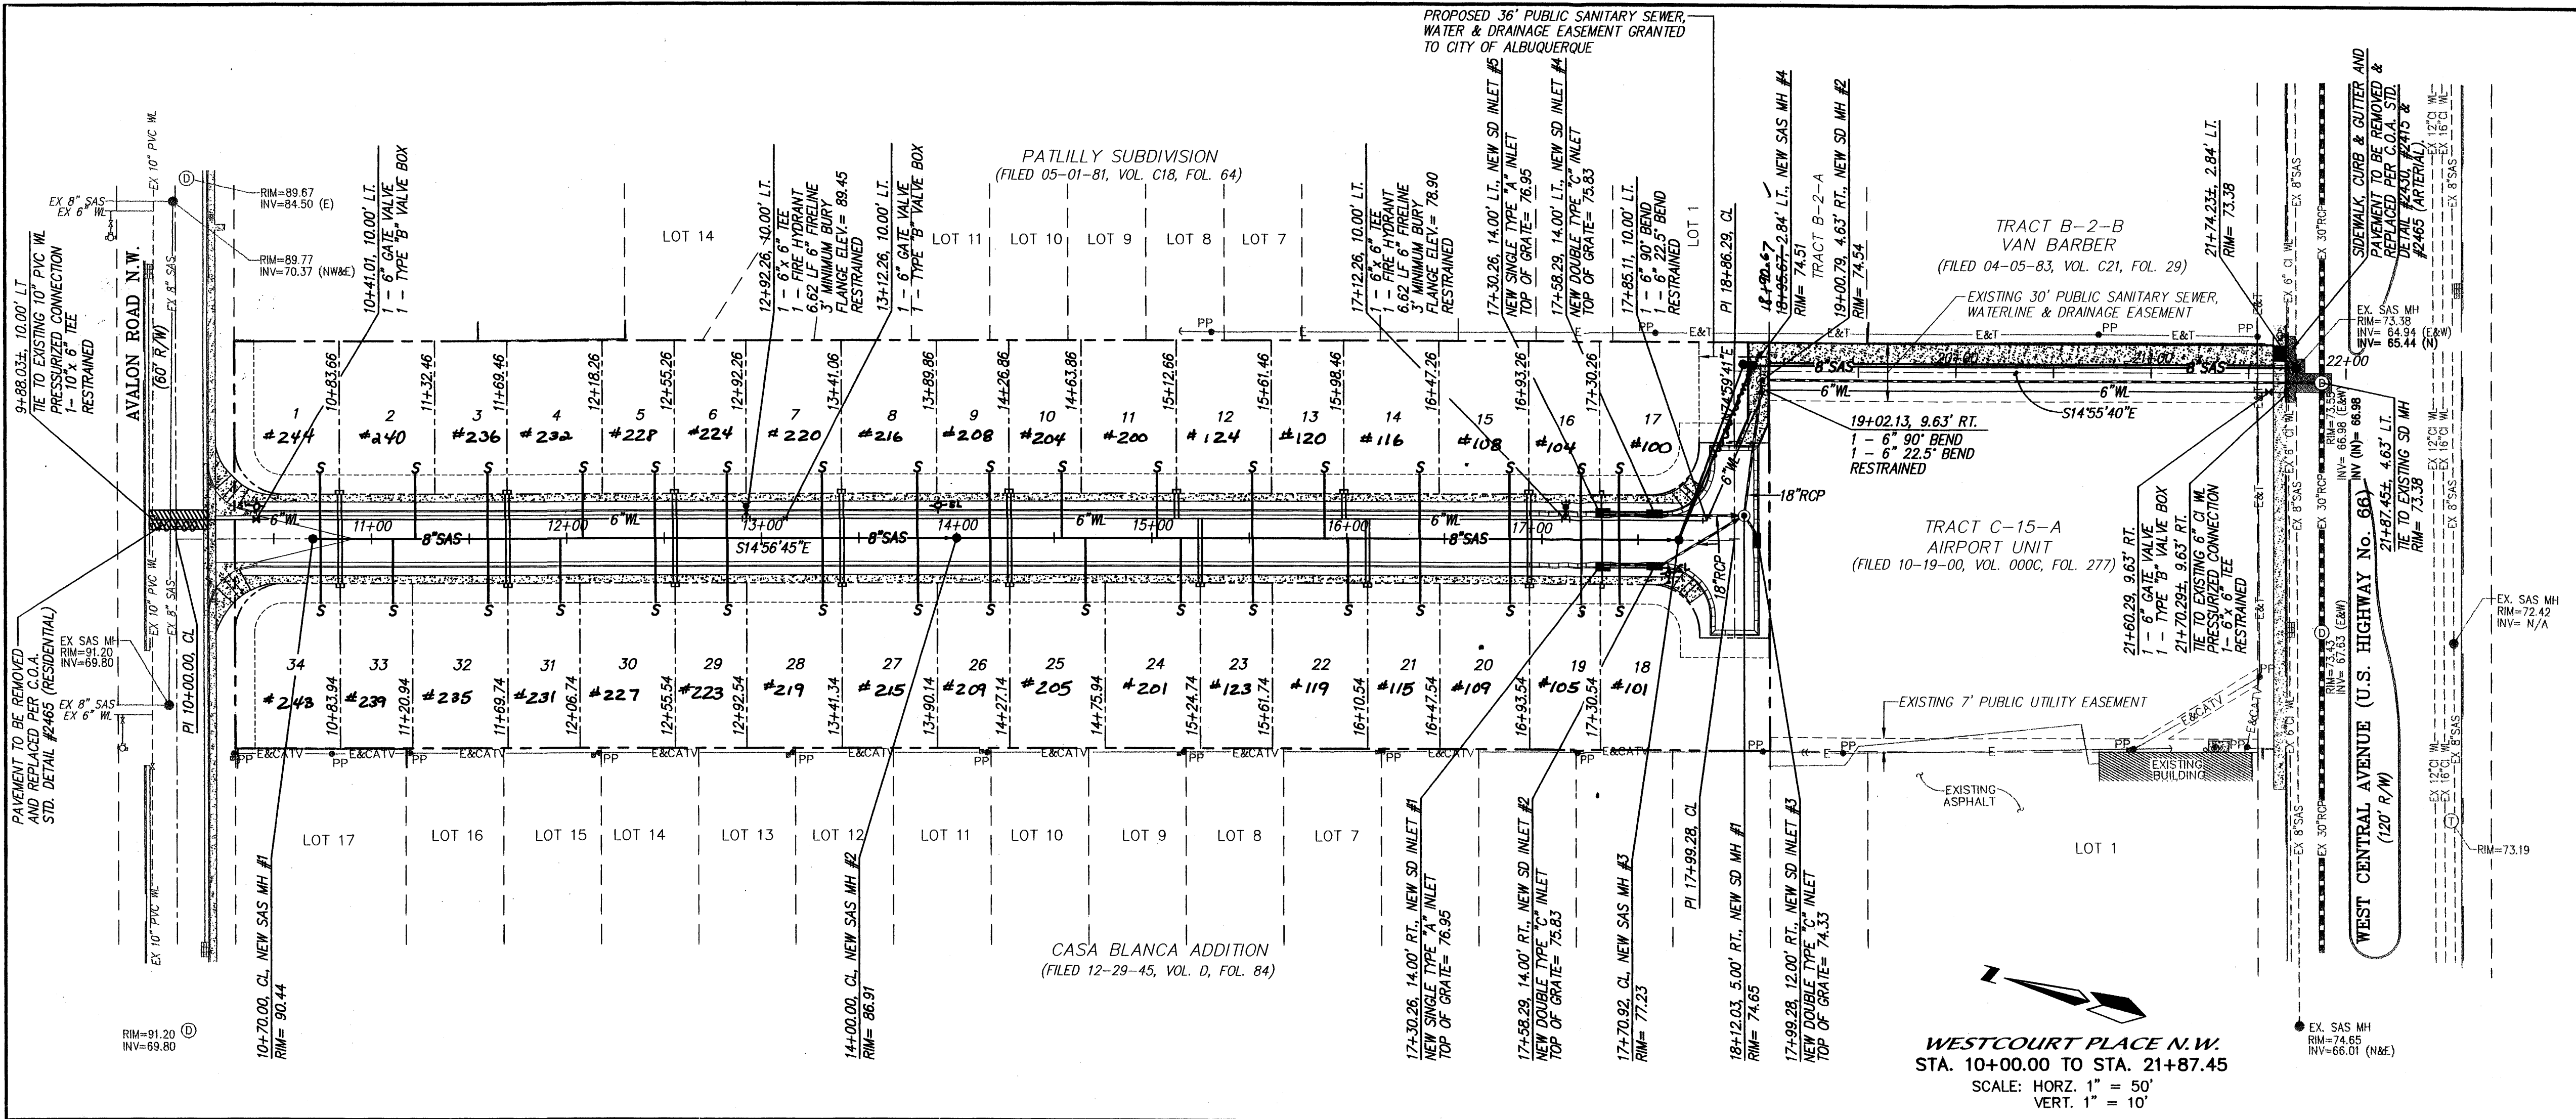

- NOTES**
1. ALL STATIONING IS CENTERLINE STATIONING TO PI STATION 17+99.28, STATIONING AFTER PI IS CENTERLINE OF EASEMENT.
 2. RESTRAINED JOINTS PER TABLE THIS SHEET.

WATER SHUT-OFF PLAN

1. CONTRACTOR WILL CONTACT WATER SYSTEMS AT 857-8200 FIVE (5) DAYS PRIOR TO NECESSARY SHUT-OFF.
2. ALL VALVES SHALL ONLY BE OPERATED BY CITY WATER EMPLOYEES.
3. CLOSE EXISTING VALVE #113 & #122 IN AVALON ROAD AND #593 IN CENTRAL AVENUE PER DETAIL THIS SHEET.

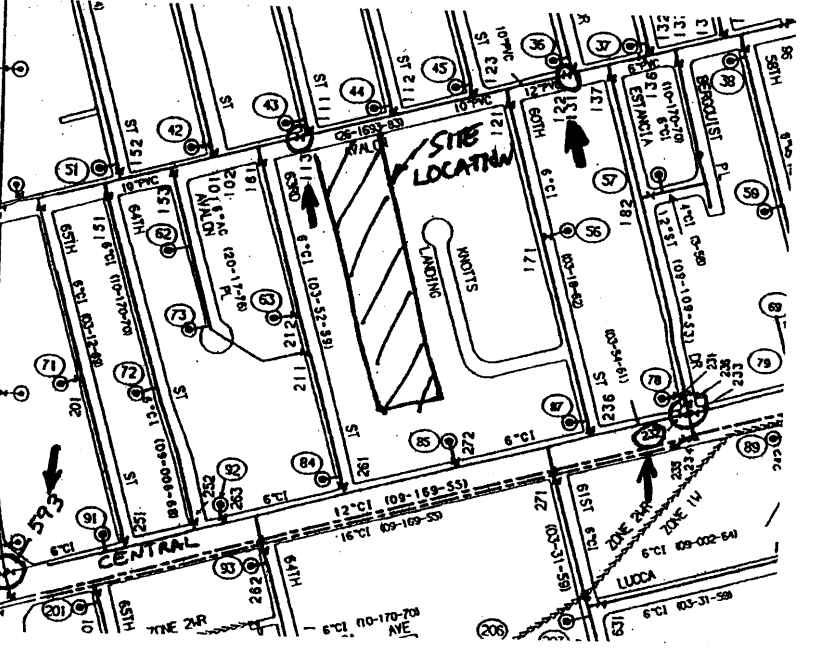

SANITARY SEWER SERVICES				
BLOCK	LOT	STATION AT PUE	INV. AT PUE	LENGTH AT PUE
1	1	10+73.66	85.26	33.00'
2	2	11+22.46	85.71	33.00'
3	3	11+59.46	85.54	33.00'
4	4	12+08.26	85.08	33.00'
5	5	12+45.26	85.46	33.00'
6	6	12+82.26	83.84	33.00'
7	7	13+31.06	83.01	33.00'
8	8	13+79.86	82.07	33.00'
9	9	14+16.86	81.15	33.00'
10	10	14+53.86	80.06	33.00'
11	11	15+02.66	78.59	33.00'
12	12	15+51.46	77.13	33.00'
13	13	15+88.46	76.02	33.00'
14	14	16+37.26	74.56	33.00'
15	15	16+83.26	73.18	33.00'
16	16	17+20.26	72.07	33.00'
17	17	17+40.26	71.45	33.00'
18	18	17+40.54	71.44	33.00'
19	19	17+20.54	72.06	33.00'
20	20	16+83.54	73.17	33.00'
21	21	16+37.54	74.56	33.00'
22	22	16+00.54	75.66	33.00'
23	23	15+51.74	77.12	33.00'
24	24	15+14.74	78.23	33.00'
25	25	14+65.94	80.06	33.00'
26	26	14+17.14	81.14	33.00'
27	27	13+80.14	82.06	33.00'
28	28	13+31.34	83.01	33.00'
29	29	12+82.54	83.83	33.00'
30	30	12+45.54	84.46	33.00'
31	31	11+96.74	85.24	33.00'
32	32	11+59.74	85.54	33.00'
33	33	11+10.94	85.47	33.00'
34	34	10+73.94	85.35	33.00'

RESTRAINED JOINT LENGTH FOR BENDS, VALVES, DEAD ENDS (FT.)				
PIPE SIZE	90°	45°	22.5°	VALVE
6"	—	7'	—	46'

LENGTH OF RESTRAINED PIPE ON EACH SIDE OF THE BEND. RESTRAIN BRANCH AT FITTING ONLY MINIMUM ATTACHED PIPE LENGTH, RUN SIDE OF TEE: 10.00 FEET.

RESTRAINED JOINT LENGTH FOR TEES (FT.)		
PIPE SIZE	RUN	BRANCH
10"x10"x6"	6'	1'
6"x6"x6"	10'	2'

dmg MARK GOODWIN & ASSOCIATES, P.A.
CONSULTING ENGINEERS
P.O. BOX 90606
ALBUQUERQUE, NEW MEXICO 87199
(505) 828-2200, FAX (505) 797-9539

CITY OF ALBUQUERQUE
PUBLIC WORKS DEPARTMENT

TITLE: **St. JOSEPH'S PLACE**
WESTCOURT PLACE N.W.
UTILITY & STORM DRAIN PLAN AND PROFILE

DESIGN REVIEW COMMITTEE	CITY ENGINEER APPROVAL	MO./DAY/YR.	MO./DAY/YR.

CITY PROJECT NO. **6760.81** ZONE MAP NO. **K-11-Z** SHEET **6** OF **8**

AS BUILT INFORMATION

CONTRACTOR	WORK	DATE

BENCH MARKS

CONTRACTOR	WORK	DATE

FIELD INFORMATION


NO.	DATE	BY

ENGINEER'S SEAL


REVISIONS

NO.	DATE	REMARKS


DESIGNED BY **ALD** DATE **11/01**
DRAWN BY **DER** DATE **11/01**
CHECKED BY **DMG** DATE **11/01**

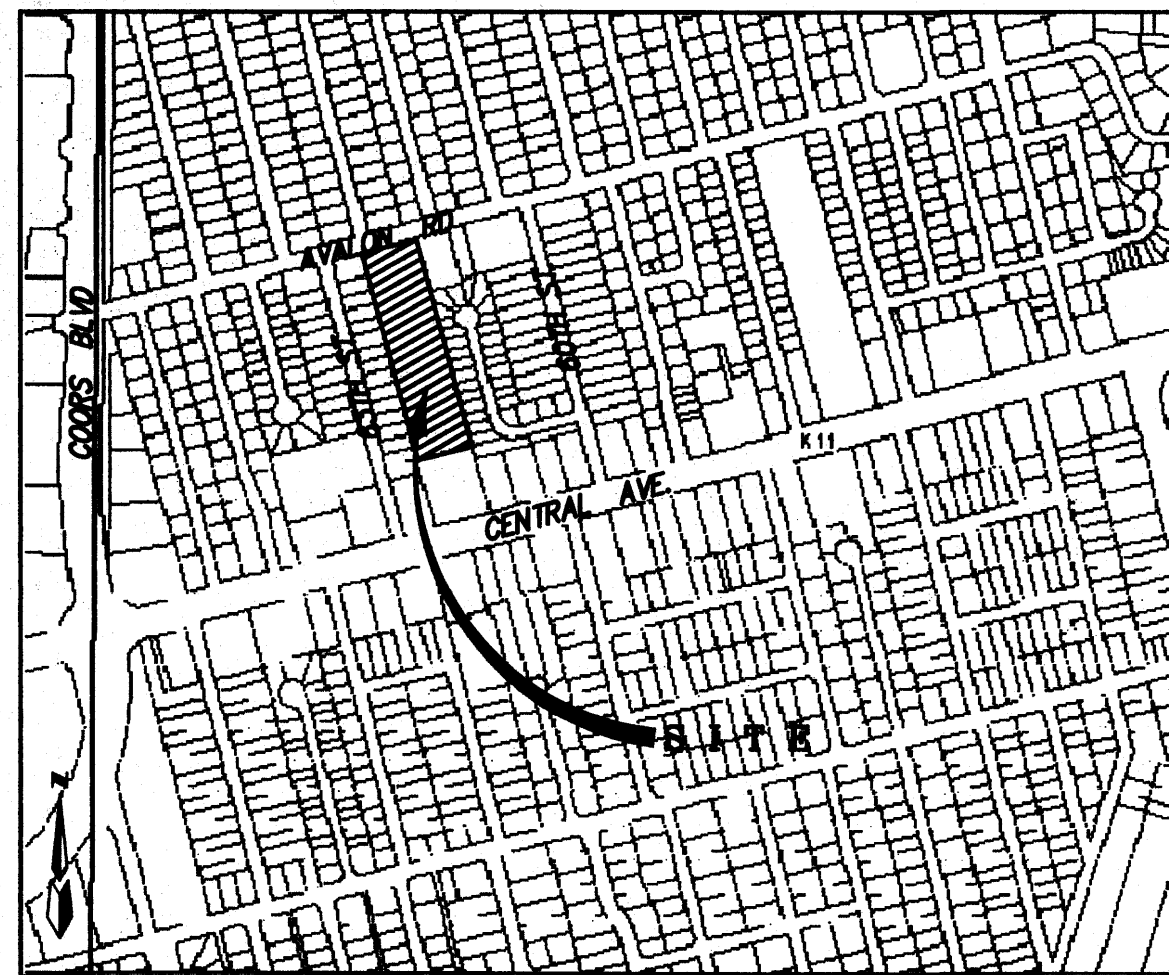


VICINITY MAP ZONE MAP: K-11-Z

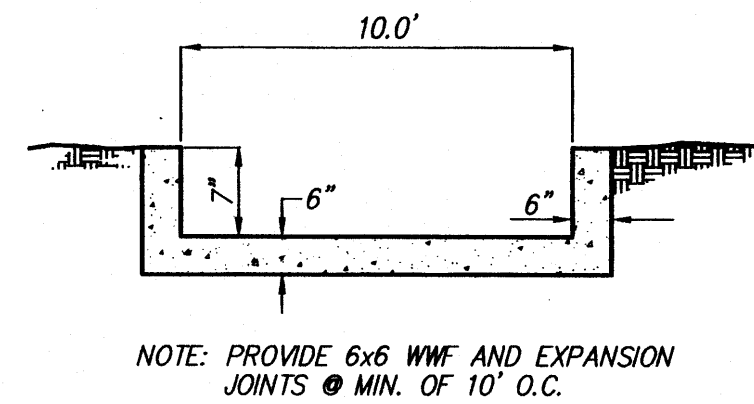

CONCRETE RUNDOWN SECTION
N.T.S.

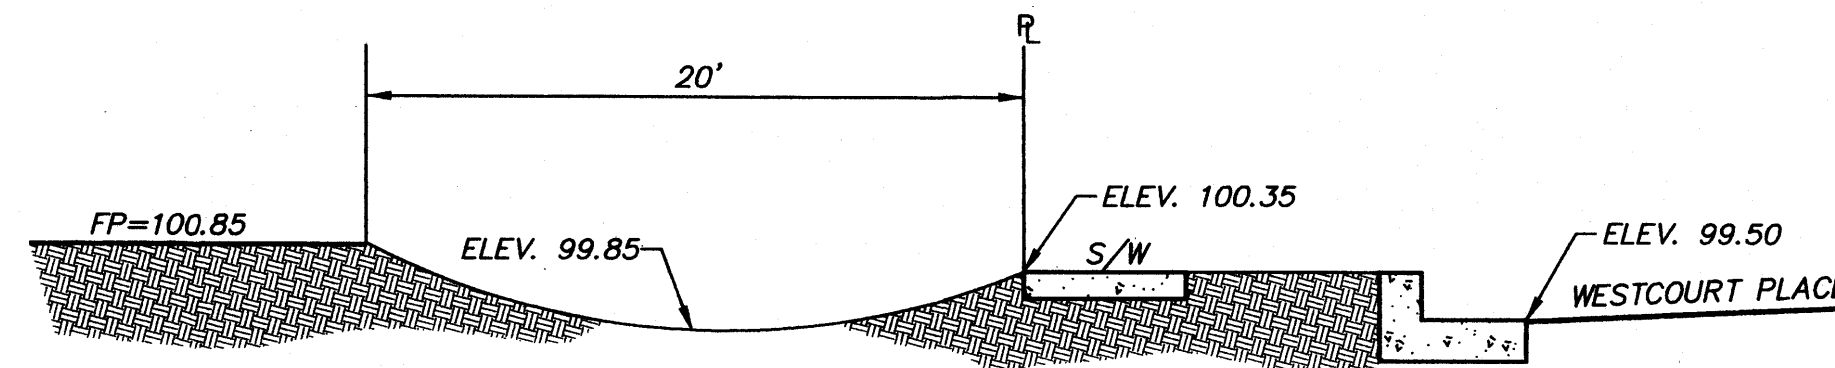

EROSION CONTROL SWALE DETAIL
N.T.S.

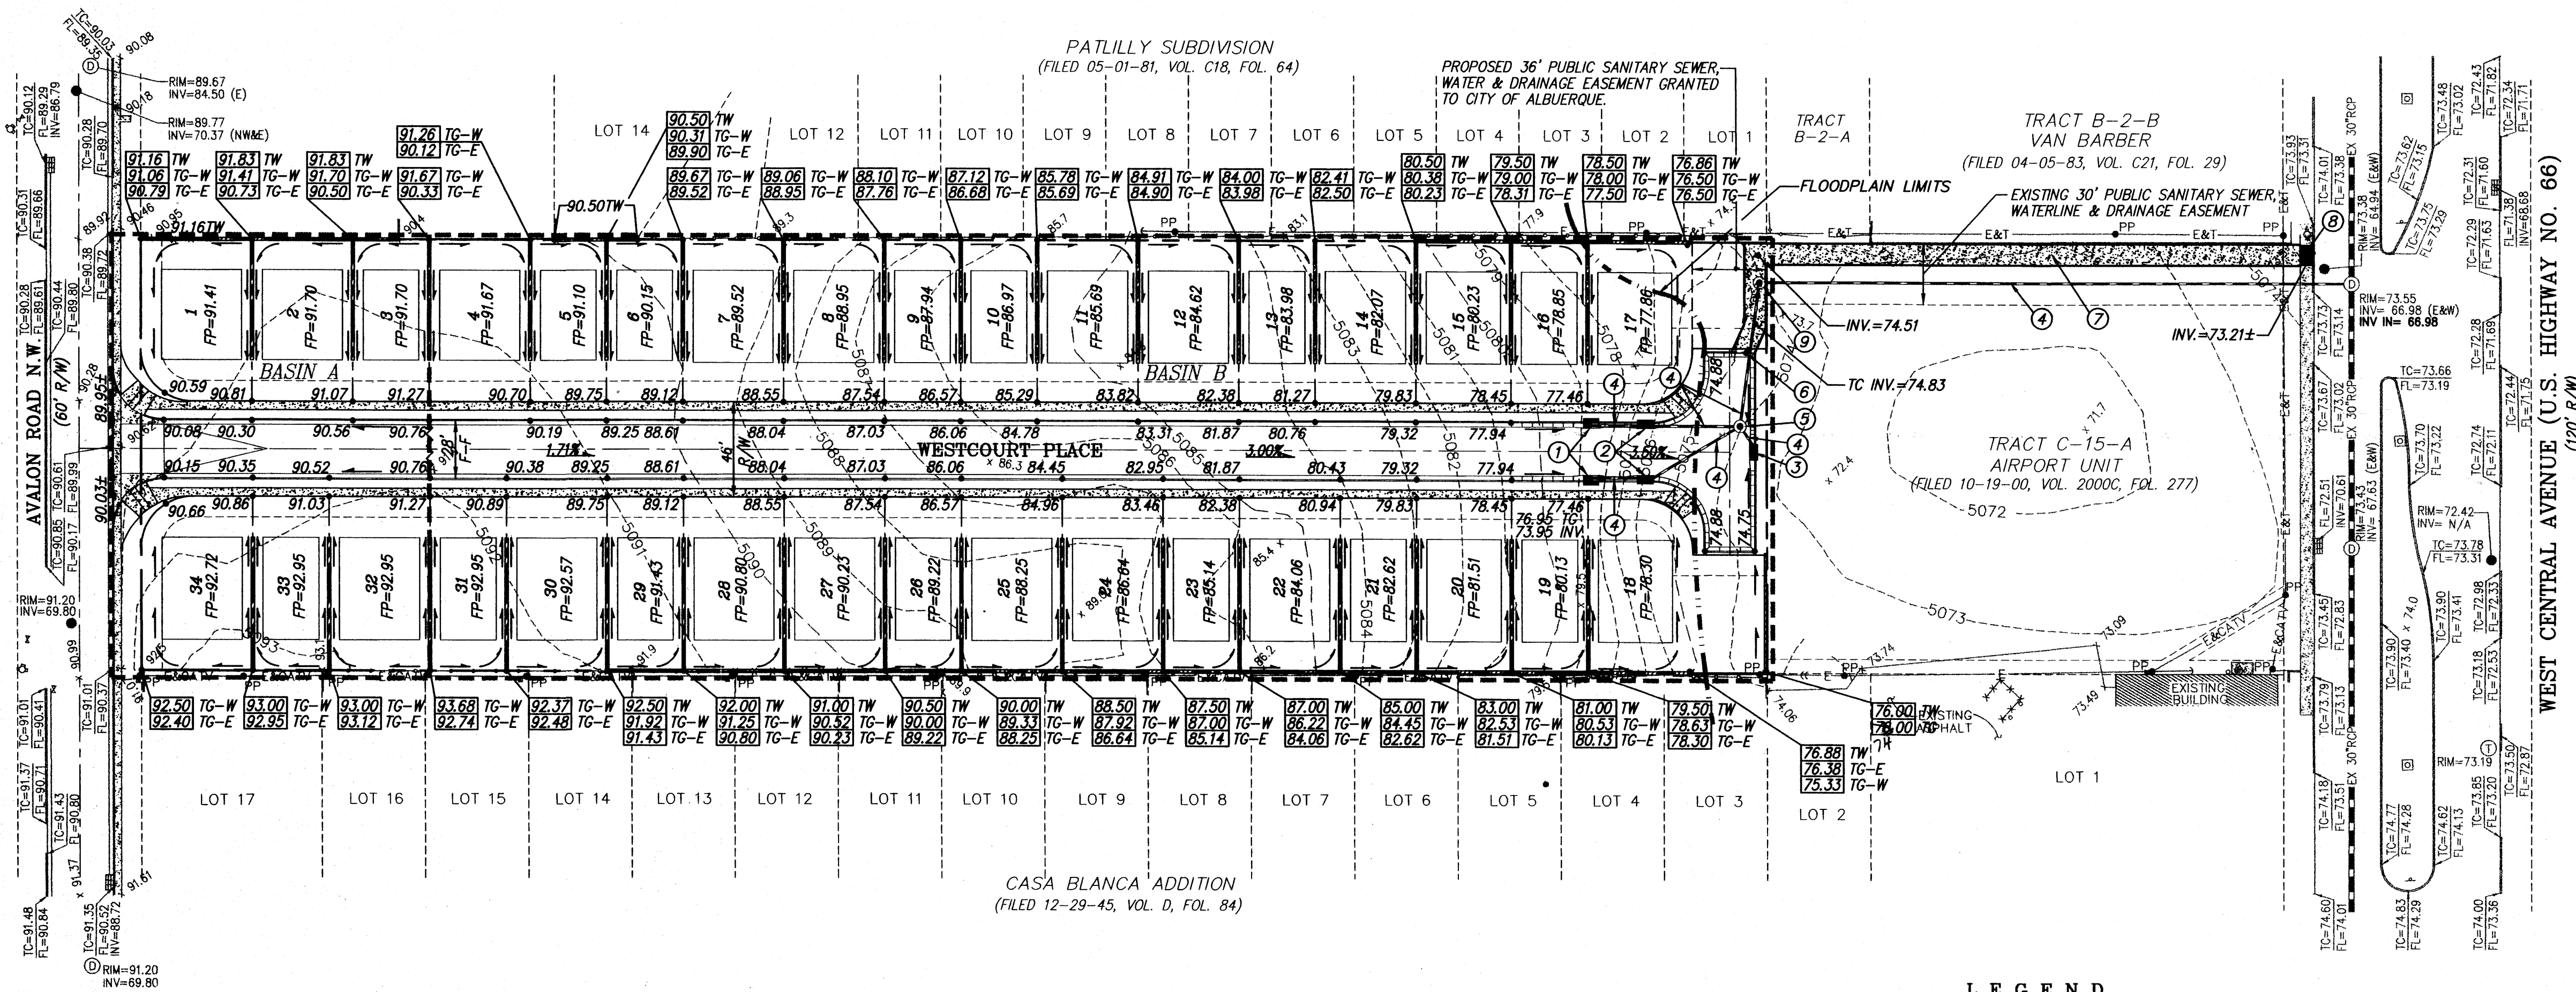

NOTES


- CONTRACTOR MUST OBTAIN A TOPSOIL DISTURBANCE PERMIT FROM THE ENVIRONMENTAL HEALTH DIVISION PRIOR TO CONSTRUCTION.
- CITY OF ALBUQUERQUE STANDARD SPECIFICATIONS FOR PUBLIC WORKS CONSTRUCTION, LATEST EDITION SHALL GOVERN ALL WORK.
- THE CONTRACTOR SHALL CONFORM TO ALL CITY, COUNTY, STATE AND FEDERAL DUST CONTROL MEASURES AND REQUIREMENTS AND WILL BE RESPONSIBLE FOR PREPARING AND OBTAINING ALL NECESSARY APPLICATIONS AND APPROVALS.
- THE CONTRACTOR SHALL ENSURE THAT NO SOIL ERODES FROM THE LOTS INTO PUBLIC RIGHT-OF-WAY. THIS CAN BE ACHIEVED BY CONSTRUCTING TEMPORARY BERMS AND WETTING THE SOIL TO KEEP IT FROM BLOWING.
- THE EARTHWORK CONTRACTOR SHALL STOCKPILE ENOUGH MATERIAL ADJACENT TO RETAINING WALL LOCATIONS TO BE UTILIZED FOR WALL BACKFILL.

KEYED NOTES


- TOTAL OF 2 TYPE "A" INLETS PER C.O.A. STANDARD DETAIL #2202.
TOP GRADE= 76.95
INV. EL= 73.95
- TOTAL OF 2 TYPE "C" DOUBLE INLETS PER C.O.A. STANDARD DETAIL #2205.
TOP GRADE= 75.83
INV. EL= 72.83
- TOTAL OF 1 TYPE "C" DOUBLE INLET PER C.O.A. STANDARD DETAIL #2205.
TOP GRADE= 74.33
INV. EL= 71.33
- NEW 18" RCP STORM DRAIN PIPE.
- 8' DIAMETER TYPE "C" MANHOLE PER C.O.A. STANDARD DETAIL #2101.
RIM EL= 74.65
INV. IN= 71.25
INV. OUT= 71.10
- NEW 10' WIDE CURB CUT. INV. EL=74.75
- NEW 10' WIDE CONCRETE RUNDOWN @ 0.48% SLOPE PER DETAIL THIS SHEET.
- 5'-2" WIDE SIDEWALK CULVERTS PER C.O.A. STANDARD DETAIL #2236.
- 6' DIAMETER TYPE "C" MANHOLE PER C.O.A. STANDARD DETAIL #2101.
RIM EL= 74.54
INV. IN= 70.40
INV. OUT= 70.30

LEGEND


- | | |
|---|--|
| — MOUNTABLE CURB & GUTTER | — 51.35 — EXISTING CONTOUR MAJOR |
| — STANDARD 8" CURB & GUTTER | — 51.35 — EXISTING CONTOUR MINOR |
| FP= 30.38 FINISHED PAD ELEVATION | — 51.35 — EXISTING FIRE HYDRANT |
| 00.00 PROPOSED SPOT ELEVATION | — 51.35 — EXISTING WATER VALVE |
| 85.00 TW PROPOSED TOP OF WALL ELEVATION | — 51.35 — EXISTING SANITARY SEWER MANHOLE |
| 84.45 TG-W PROPOSED TOP GROUND ELEVATION—WEST | — 51.35 — EXISTING STORM DRAIN MANHOLE |
| 83.37 TG-E PROPOSED TOP GROUND ELEVATION—EAST | — 51.35 — EXISTING STORM DRAIN INLET |
| — PROPOSED SLOPE | — 51.35 — EXISTING TOP OF CURB ELEVATION |
| — FLOODPLAIN LINE | — 51.35 — EXISTING FLOW LINE ELEVATION |
| — PROPOSED WATER BLOCK | — 51.35 — EXISTING SPOT ELEVATION |
| — PROPOSED 4' SIDEWALK | — 51.35 — EXISTING OVERHEAD ELECTRIC & CABLE TV LINE |
| — TRACT/LOT BOUNDARY LINE | — 51.35 — EXISTING POWER POLE |
| — RIGHT OF WAY LINE | — 51.35 — EXISTING TELEPHONE MANHOLE |
| — EASEMENT LINE | — 51.35 — EXISTING STREET LIGHT |
| — FLOW DIRECTION | — 51.35 — EXISTING CHAIN LINK FENCE |
| — PROPOSED SWALE | — 51.35 — EXISTING WOOD FENCE |
| — PROPOSED RETAINING WALL | — 51.35 — DRAINAGE BASIN LINE |
| — PROPOSED STORM DRAIN PIPE | |
| — PROPOSED STORM DRAIN MANHOLE | |
| — PROPOSED STORM DRAIN INLET | |

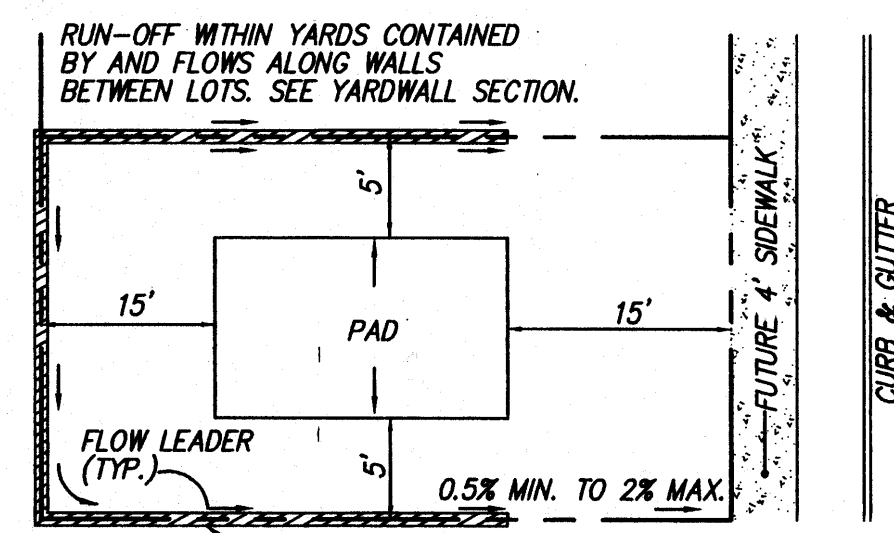


TYPICAL LOT LAYOUT PLAN
N.T.S.

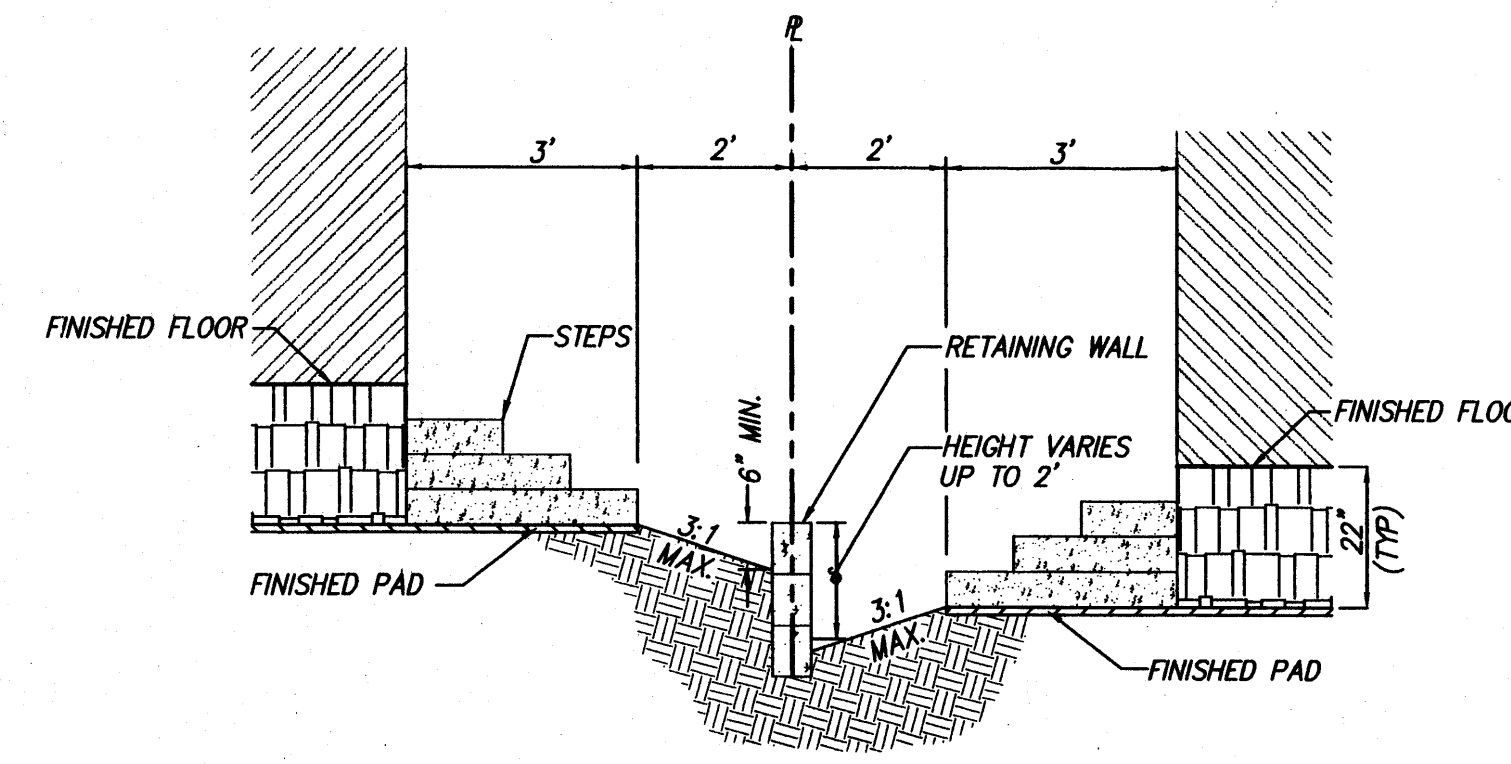


TYPICAL LOT LAYOUT SECTION
N.T.S.

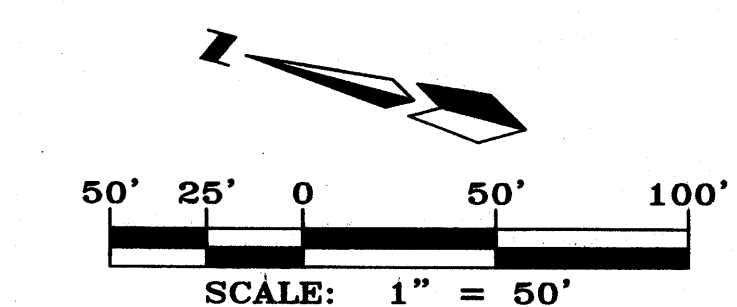

MARK GOODWIN & ASSOCIATES, P.A. CONSULTING ENGINEERS P.O. BOX 90606 ALBUQUERQUE, NEW MEXICO 87199 (505) 828-2200, FAX (505) 797-9539	
CITY OF ALBUQUERQUE PUBLIC WORKS DEPARTMENT	
TITLE: ST. JOSEPH'S PLACE GRADING AND DRAINAGE PLAN	
DESIGN REVIEW COMMITTEE	CITY ENGINEER APPROVAL
CITY PROJECT NO. 6760.81	ZONE MAP NO. K-11-Z
SHEET 4	OF 8

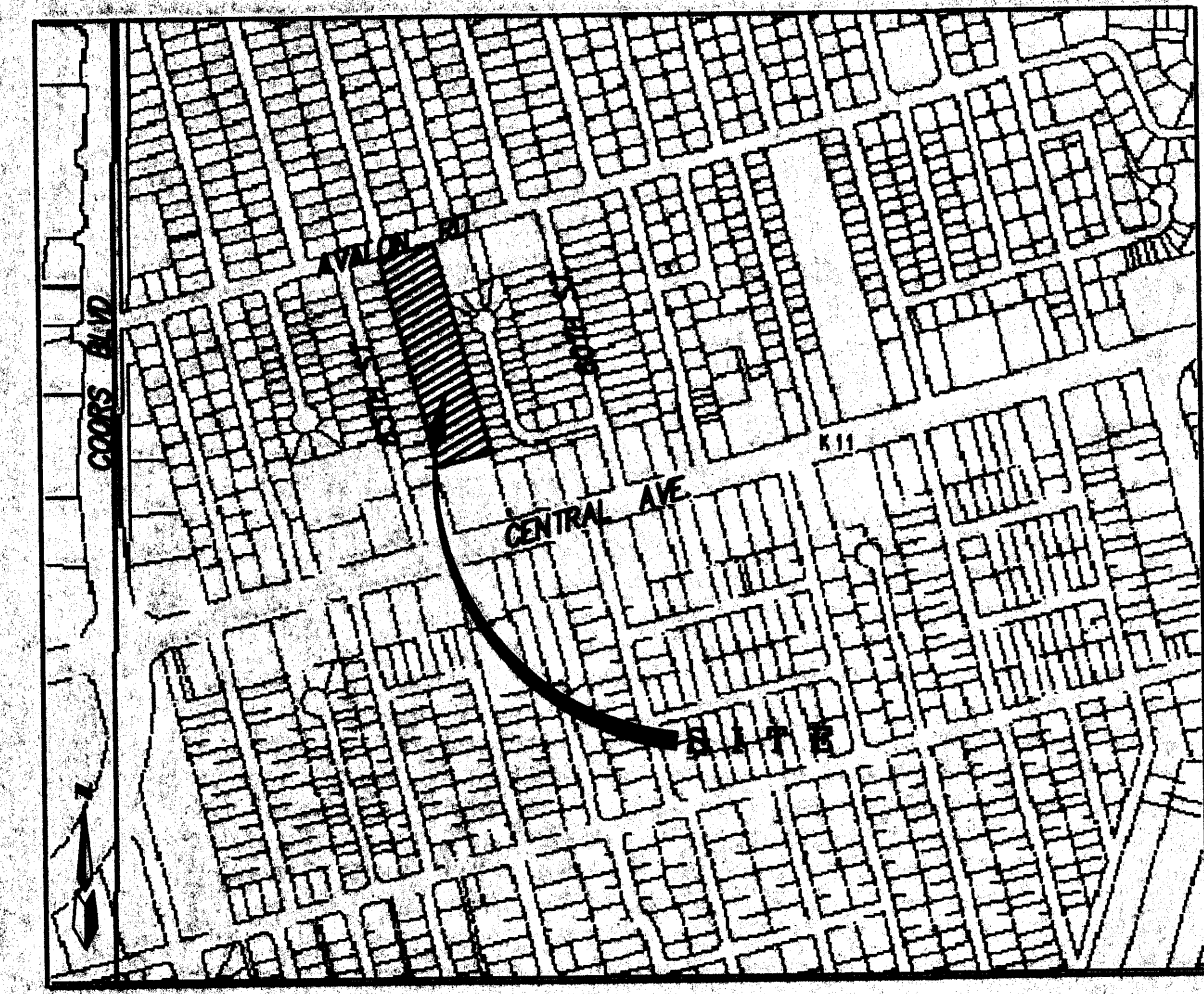


VICINITY MAP ZONE MAP: K-11-Z

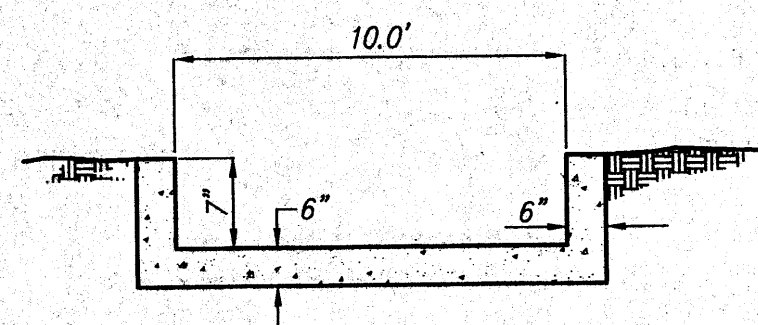


NOTE: PROVIDE 6x6 WMF AND EXPANSION JOINTS @ MIN. OF 10' O.C.

CONCRETE RUNDOWN SECTION
N.T.S.

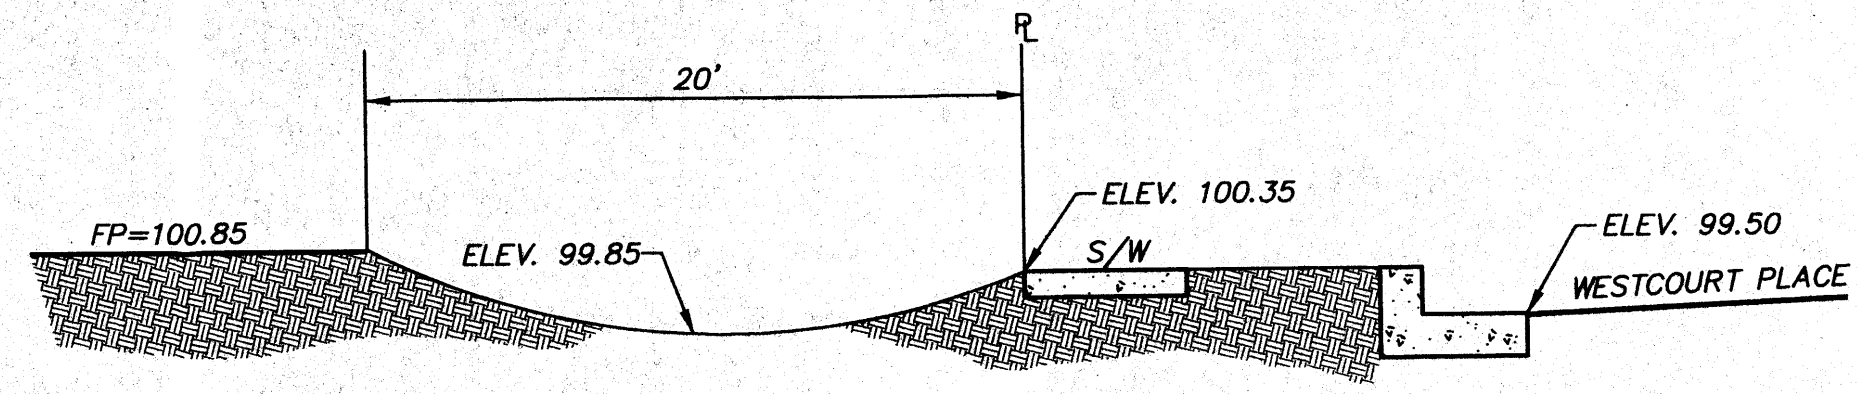


EROSION CONTROL SWALE DETAIL
N.T.S.

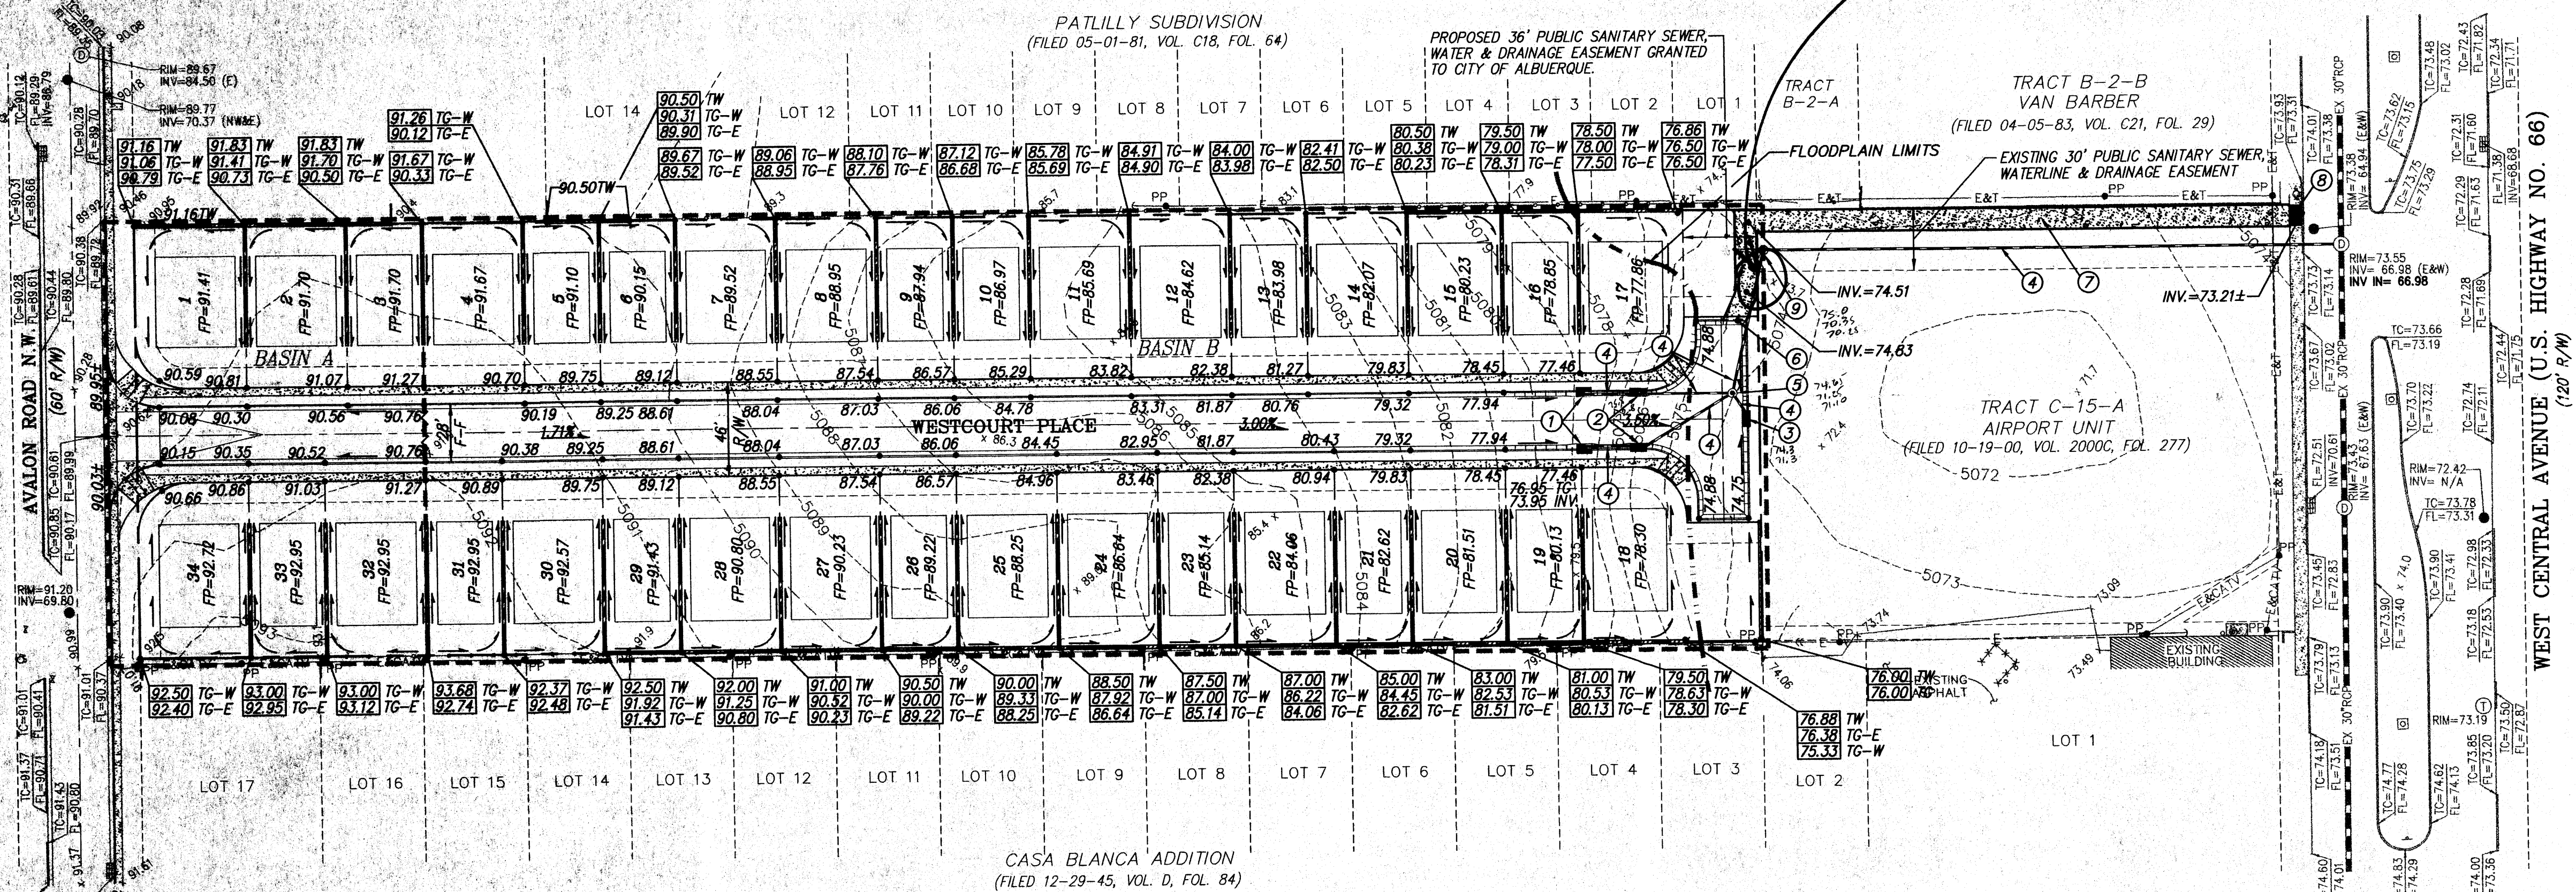


- NOTES
- CONTRACTOR MUST OBTAIN A TOPSOIL DISTURBANCE PERMIT FROM THE ENVIRONMENTAL HEALTH DIVISION PRIOR TO CONSTRUCTION.
 - CITY OF ALBUQUERQUE STANDARD SPECIFICATIONS FOR PUBLIC WORKS CONSTRUCTION, LATEST EDITION SHALL GOVERN ALL WORK.
 - THE CONTRACTOR SHALL CONFORM TO ALL CITY, COUNTY, STATE AND FEDERAL DUST CONTROL MEASURES AND REQUIREMENTS AND WILL BE RESPONSIBLE FOR PREPARING AND OBTAINING ALL NECESSARY APPLICATIONS AND APPROVALS.
 - THE CONTRACTOR SHALL ENSURE THAT NO SOIL ERODES FROM THE LOTS INTO PUBLIC RIGHT-OF-WAY. THIS CAN BE ACHIEVED BY CONSTRUCTING TEMPORARY BERMS AND WETTING THE SOIL TO KEEP IT FROM BLOWING.
 - THE EARTHWORK CONTRACTOR SHALL STOCKPILE ENOUGH MATERIAL ADJACENT TO RETAINING WALL LOCATIONS TO BE UTILIZED FOR WALL BACKFILL.

- KEYED NOTES
- TOTAL OF 2 TYPE "A" INLETS PER C.O.A. STANDARD DETAIL #2202.
TOP GRADE= 76.95
INV. EL= 73.95
 - TOTAL OF 2 TYPE "C" DOUBLE INLETS PER C.O.A. STANDARD DETAIL #2205.
TOP GRADE= 75.83
INV. EL= 72.83
 - TOTAL OF 1 TYPE "C" DOUBLE INLET PER C.O.A. STANDARD DETAIL #2205.
TOP GRADE= 74.33
INV. EL= 71.33
 - NEW 18" RCP STORM DRAIN PIPE.
 - 8" DIAMETER TYPE "C" MANHOLE PER C.O.A. STANDARD DETAIL #2101.
RIM EL= 74.65
INV. IN= 71.25
INV. OUT= 71.10
 - NEW 10" WIDE CURB CUT. INV. EL=74.75
 - NEW 10" WIDE CONCRETE RUNDOWN @ 0.48% SLOPE PER DETAIL THIS SHEET.
 - 5'-2" WIDE SIDEWALK CULVERTS PER C.O.A. STANDARD DETAIL #2236.
 - 6" DIAMETER TYPE "C" MANHOLE PER C.O.A. STANDARD DETAIL #2101.
RIM EL= 75.00
INV. IN= 70.35
INV. OUT= 70.25

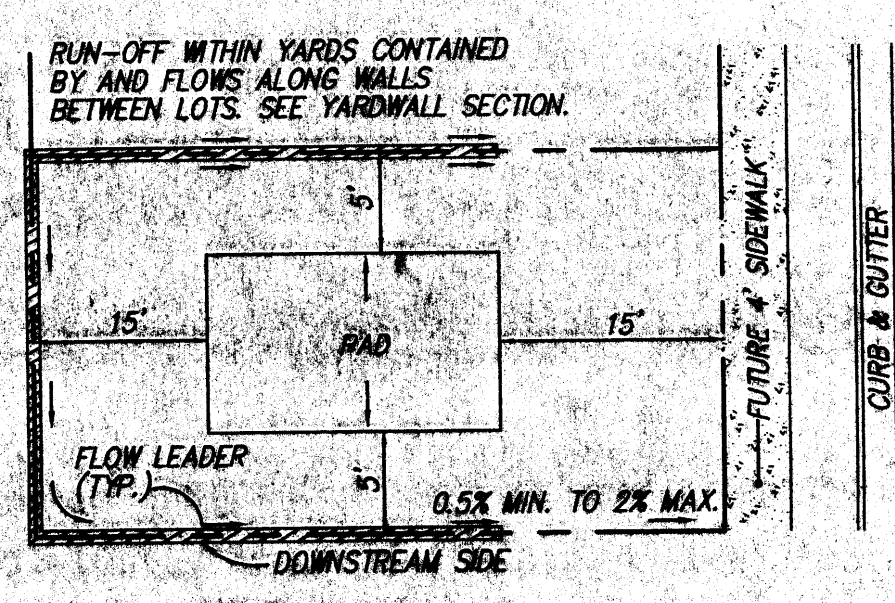


TYPICAL LOT LAYOUT PLAN
N.T.S.

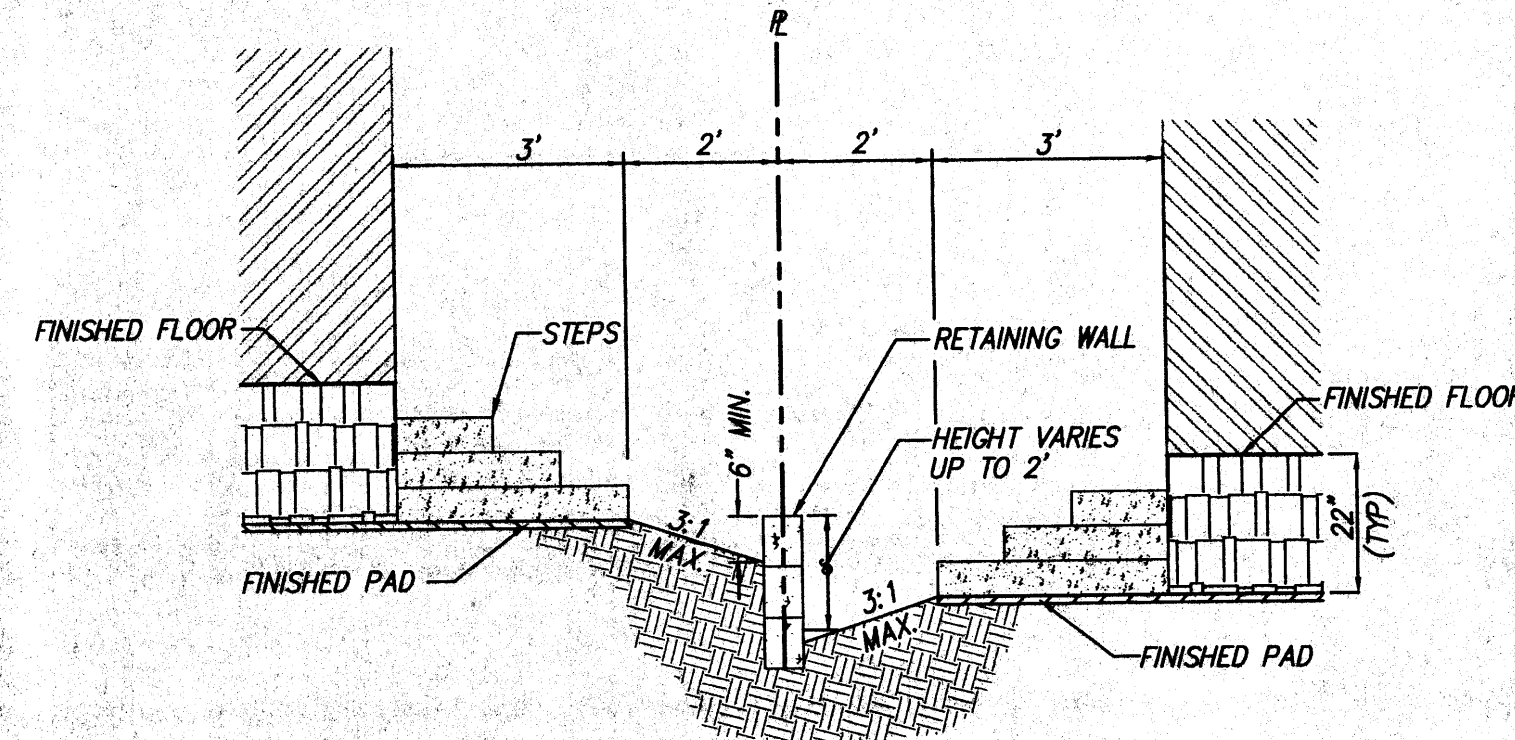

TYPICAL LOT LAYOUT SECTION
N.T.S.

- LEGEND
- MOUNTABLE CURB & GUTTER
 - STANDARD 8" CURB & GUTTER
 - FP= 30.38 FINISHED PAD ELEVATION
 - 00.00 PROPOSED SPOT ELEVATION
 - 85.00 TW PROPOSED TOP OF WALL ELEVATION
 - 84.45 TC-W PROPOSED TOP GROUND ELEVATION-WEST
 - 83.37 TC-E PROPOSED TOP GROUND ELEVATION-EAST
 - PROPOSED SLOPE
 - FLOODPLAIN LINE
 - PROPOSED WATER BLOCK
 - PROPOSED 4' SIDEWALK
 - TRACT/LOT BOUNDARY LINE
 - RIGHT OF WAY LINE
 - EASEMENT LINE
 - FLOW DIRECTION
 - PROPOSED SWALE
 - PROPOSED RETAINING WALL
 - PROPOSED STORM DRAIN PIPE
 - PROPOSED STORM DRAIN MANHOLE
 - PROPOSED STORM DRAIN INLET
 - EXISTING CONTOUR MAJOR
 - EXISTING CONTOUR MINOR
 - EXISTING FIRE HYDRANT
 - EXISTING WATER VALVE
 - EXISTING SANITARY SEWER MANHOLE
 - EXISTING STORM DRAIN MANHOLE
 - EXISTING STORM DRAIN INLET
 - EXISTING TOP OF CURB ELEVATION
 - EXISTING FLOW LINE ELEVATION
 - EXISTING SPOT ELEVATION
 - EXISTING OVERHEAD ELECTRIC & CABLE TV LINE
 - EXISTING POWER POLE
 - EXISTING TELEPHONE MANHOLE
 - EXISTING STREET LIGHT
 - EXISTING CHAIN LINK FENCE
 - EXISTING WOOD FENCE
 - DRAINAGE BASIN LINE

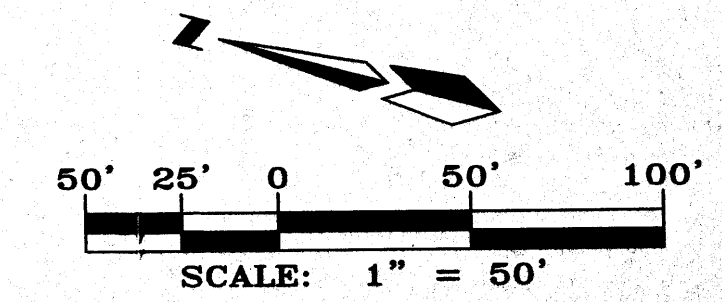

MARK GOODWIN & ASSOCIATES, P.A.
CONSULTING ENGINEERS
P.O. BOX 90606
ALBUQUERQUE, NEW MEXICO 87199
(505) 828-2200, FAX (505) 797-9539

CITY OF ALBUQUERQUE
PUBLIC WORKS DEPARTMENT

TITLE: **St. JOSEPH'S PLACE
GRADING AND DRAINAGE PLAN**

DESIGN REVIEW COMMITTEE	CITY ENGINEER APPROVAL	LAST DESIGN UPDATE	MO./DAY/YR.	MO./DAY/YR.

CITY PROJECT NO. _____ ZONE MAP NO. **K-11-Z** SHEET **4** OF **8**

DESIGNED BY **ALD** DATE **11/01**
DRAWN BY **DER** DATE **11/01**
CHECKED BY **DMG** DATE **11/01**

PRELIMINARY PLAT
St. Joseph's Place
SUBDIVISION

WITHIN THE
TOWN OF ATRISCO GRANT
PROJECTED SECTION 23
TOWNSHIP 10, NORTH, RANGE 2 EAST, NMPM
CITY OF ALBUQUERQUE
BERNALILLO COUNTY, NEW MEXICO
MAY, 2001

SUBDIVISION DATA

GROSS ACREAGE. 3.7909 Ac
ZONE/ATLAS NO. K-11-Z
NO. OF EXISTING TRACTS. 1
NO. OF TRACTS/LOTS CREATED. 2 TRACTS/34 LOTS
NO. OF TRACTS ELIMINATED 1
AREA DEDICATED TO CITY OF ALBUQUERQUE. 0.8648 AC
DATE OF SURVEY. MARCH, 2001

OWNERS

WESTCOR PROPERTIES LLC
11600 ACADEMY N.E.
ALBUQUERQUE, N.M. 87111
(505) 237-9311

ENGINEERS

D. MARK GOODWIN & ASSOCIATES, P.A.
CONSULTING ENGINEERS
P.O. BOX 90606
ALBUQUERQUE, NEW MEXICO 87199
(505) 828-2200

SURVEYOR

ALDRICH LAND SURVEY
P.O. BOX 30701
ALBUQUERQUE, N.M. 87190-0701
(505) 884-1990

OWNER:

Charles Bachelier
CHARLES BACHELLER DATE
PRESIDENT OF WESTCOR PROPERTIES LLC.



LOCATION MAP
NOT TO SCALE

APPROVED FOR MONUMENTATION AND STREET NAMES

[Signature]
City Surveyor, City of Albuquerque, N.M. 5-22-01 Date

PURPOSE OF PLAT

1. SUBDIVIDE ONE TRACT INTO 34 RESIDENTIAL LOTS AND 2 TRACTS
2. DEDICATED RIGHT-OF-WAY AS SHOWN
3. GRANT NEW EASEMENTS AS SHOWN

LEGAL DESCRIPTION

A tract of land situate within the Town of Atrisco Grant, projected Section 23, Township 10 North, Range 2 East, New Mexico Principal Meridian, City of Albuquerque, Bernalillo County, New Mexico being all of Tract C-15-B, Airport unit filed in the office of the Bernalillo County Clerk on October 19, 2000, Volume 200C, Folio 277, and containing 3.7909 acres more or less.

NOTES

1. UNLESS OTHERWISE NOTED ALL POINTS ARE "SET 5/8" REBAR WITH CAP "ALS LS 7719".
2. ALL STREET CENTERLINE MONUMENTATION SHALL BE INSTALLED AT ALL CENTERLINE PC'S, PT'S, ANGLE POINTS, AND STREET INTERSECTIONS AND SHOWN THUS ▲, WILL BE MARKED BY A FOUR INCH (4") ALUMINUM CAP STAMPED:
"CITY OF ALBUQUERQUE CENTERLINE MONUMENTATION"
"DO NOT DISTURB"
"PLS # 7719".
3. BOUNDARY SHALL BE TIED TO THE NEW MEXICO STATE PLANE COORDINATE SYSTEM AS SHOWN.
4. BASIS OF BEARING SHALL BE NEW MEXICO STATE PLANE GRID BEARINGS.
5. ALL DISTANCES SHALL BE GROUND DISTANCES.
6. MANHOLES WILL BE OFFSET AT ALL POINTS OF CURVATURE, POINTS OF TANGENCY, STREET INTERSECTIONS, AND ALL OTHER ANGLE POINTS TO ALLOW USE OF CENTERLINE MONUMENTATION.

FAMILY HOUSING DEVELOPMENT NOTICE



THIS SUBDIVISION QUALIFIES UNDER THE CITY'S FAMILY HOUSING DEVELOPMENT PROGRAM. THE CONTROLLING MINIMUM LOT WIDTH AND AREA HAVE ALL BEEN REDUCED AS SPECIFIED UNDER THE ZONING REGULATIONS. ALL OF THE STANDARD SETBACK AND OPEN SPACE REQUIREMENTS OF THE ZONE MUST BE MET FOR ALL LOTS WITHIN THE FAMILY HOUSING DEVELOPMENT.

PRELIMINARY PLAT **St. Joseph's Place** **SUBDIVISION**

WITHIN THE
TOWN OF ATRISCO GRANT
PROJECTED SECTION 23
TOWNSHIP 10 NORTH, RANGE 2 EAST, NMPM
CITY OF ALBUQUERQUE
BERNALILLO COUNTY, NEW MEXICO
MAY, 2001

EXISTING EASEMENTS

- ① 7' PUE
(10-19-00, 000C-277)
- ② 20' SEWER, WATER AND DRAINAGE EASEMENT
(10-19-00, 000C-277)
- ③ 30' PUBLIC SEWER, WATER AND DRAINAGE EASEMENT
(01-18-01, A14-3887)

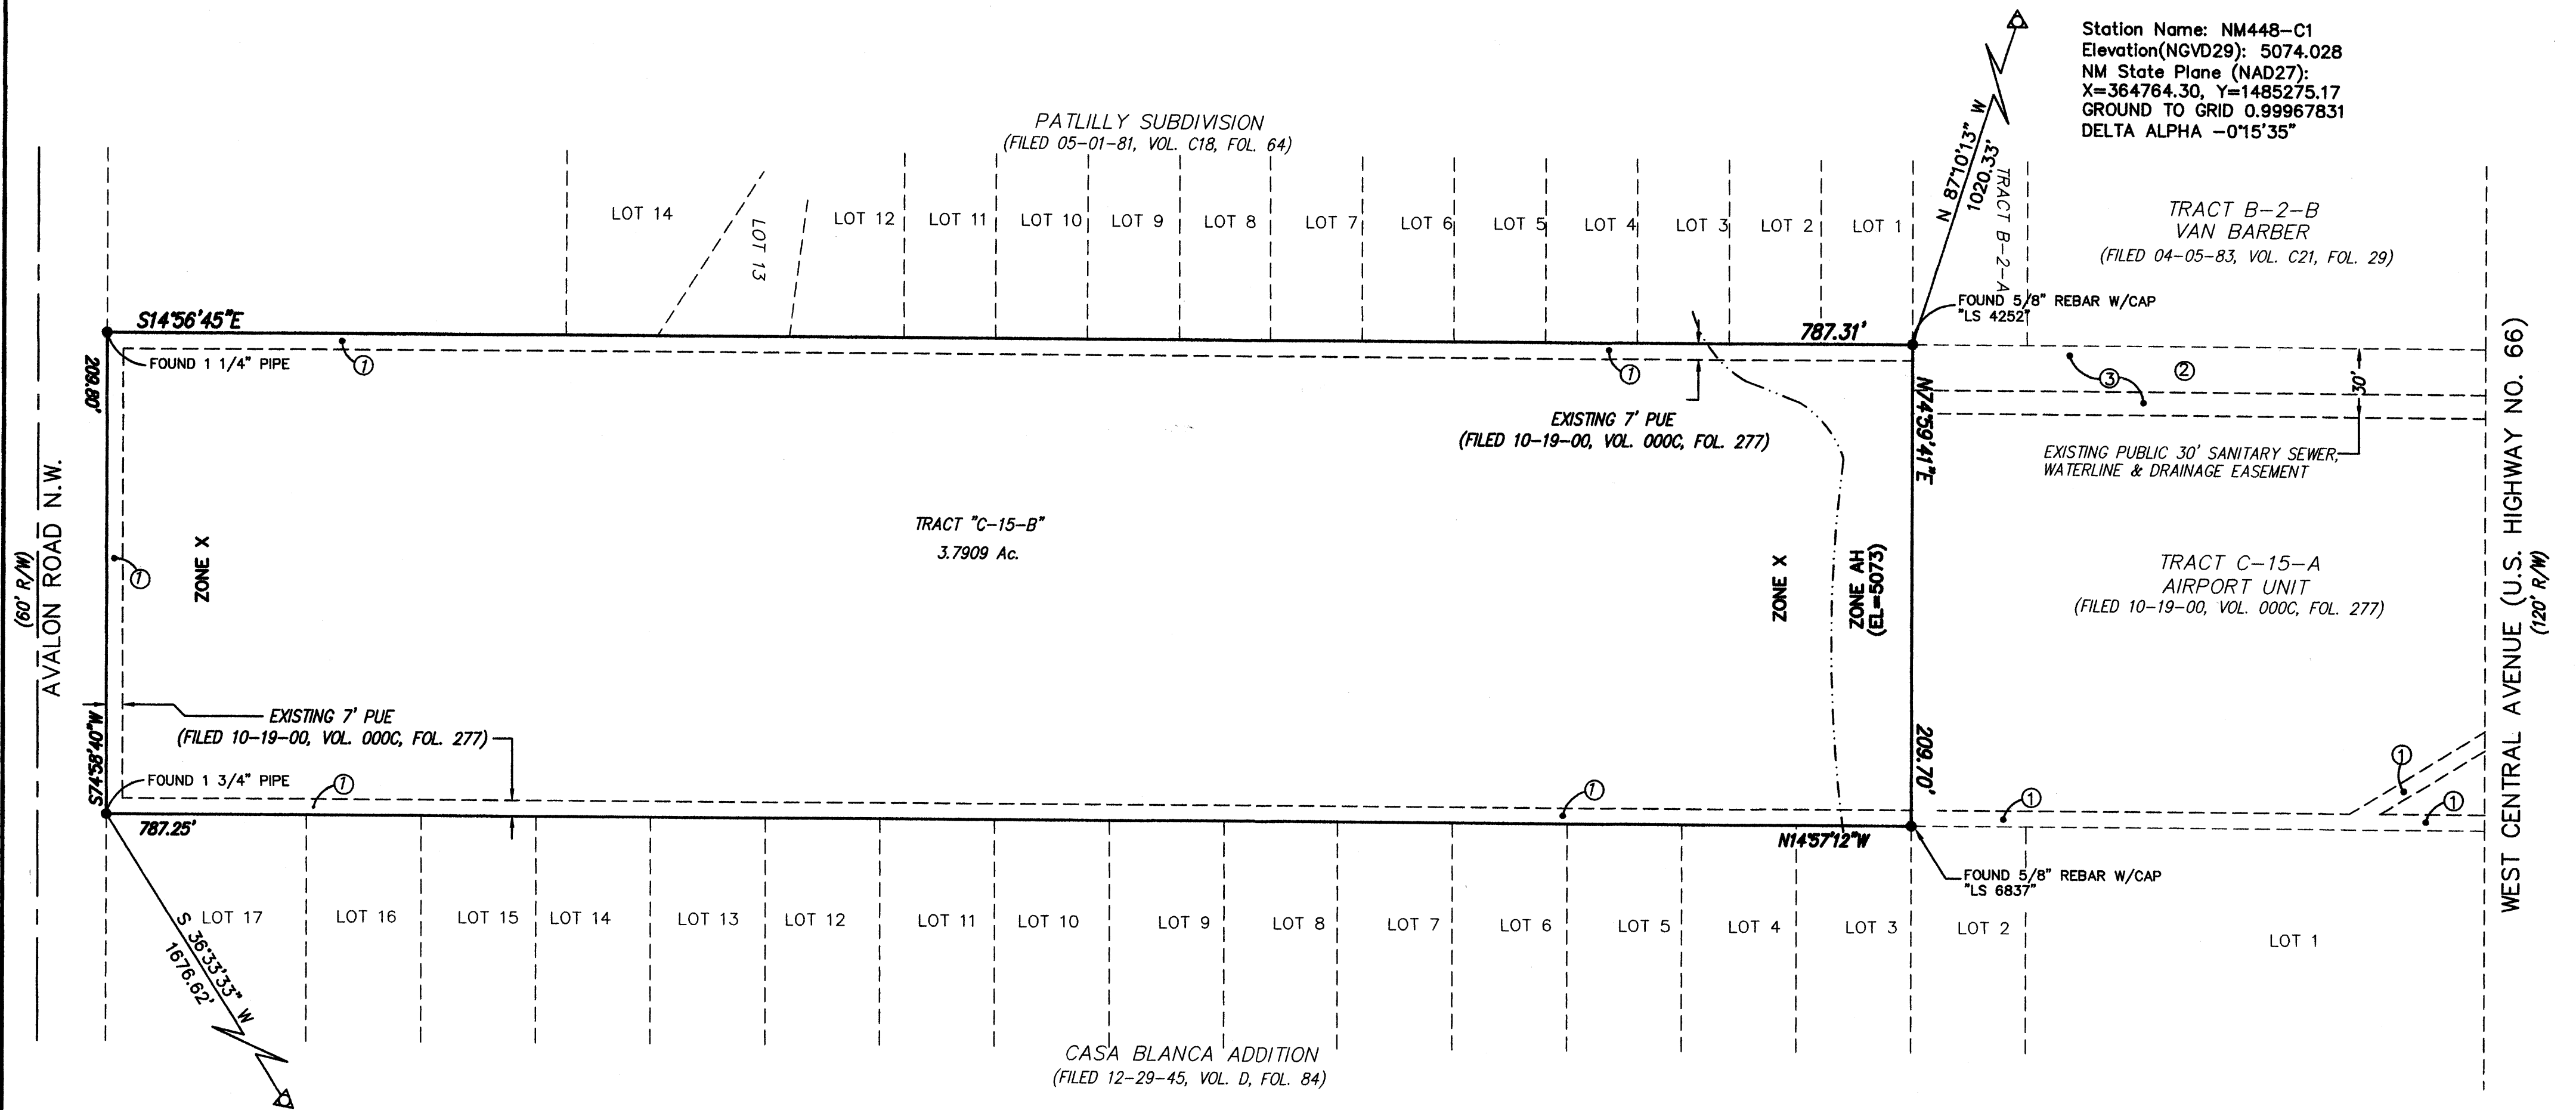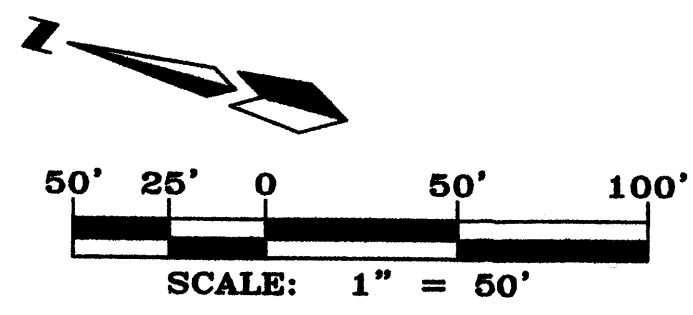


Dwg: A01024SHT2	Drawn: SPS	Checked: ALS	Sheet 2 of 3
Scale: 1"=50'	Date: 05/22/01	Job: A01024	

F:\AU055\A1024an\PREL-PLAT\A01024SHT2.dwg Tue Sep 04 08:26:03 2001 by der


NOTE:

1. ALL STREETS SHOWN HEREON ARE HEREBY DEDICATED AS PUBLIC RIGHT-OF-WAY.
2. AT THE TIME OF INDIVIDUAL BUILDING PERMIT APPLICATION, THE APPLICANT SHALL BE REQUIRED TO DEMONSTRATE THAT THERE EXISTS AT LEAST 600 S.F. OF OPEN SPACE ON EACH LOT. DEFICIENCIES IN OPEN SPACE MAY BE COMPENSATED FOR ACCORDING TO SECTION 14-16-3-8A OF THE ZONING CODE
3. AN "AH" FLOOD ZONE (ELEV. 5073) EXISTS AT THE FAR SOUTH END OF THE SUBDIVISION. FLOOD INSURANCE MAY BE REQUIRED FOR HOMEOWNERS AFFECTED BY THIS FLOOD ZONE, UNTIL SUCH TIME THAT A LOMR IS OBTAINED.
4. CENTERLINE (IN LIEU OF R/W) MONUMENTATION IS TO BE INSTALLED AT ALL CENTERLINE PC'S, PT'S, ANGLE POINTS AND STREET INTERSECTIONS AS SHOWN HEREON, AND WILL CONSIST OF A FOUR INCH (4") ALUMINUM ALLOY CAP STAMPED "CITY OF ALBUQUERQUE", "CENTERLINE MONUMENT", "DO NOT DISTURB", "PLS # 7719".

CURVE TABLE						
CURVE	LENGTH	RADIUS	DELTA	TANGENT	CH-BEARING=	CH-DIST=
C1	39.30	25.00	90°04'35"	25.03	N59°59'03"W	35.38
C2	37.34	25.00	85°34'25"	23.14	S27°50'27"W	33.96
C3	39.30	25.00	90°03'34"	25.03	S59°58'32"E	35.37
C4	39.24	25.00	89°56'26"	24.97	N30°01'28"E	35.34

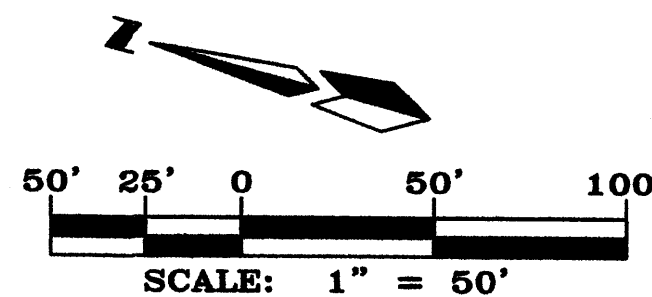

PRELIMINARY PLAT
St. Joseph's Place
SUBDIVISION
 WITHIN THE
 TOWN OF ATRISCO GRANT
 PROJECTED SECTION 23
 TOWNSHIP 10 NORTH, RANGE 2 EAST, NMPM
 CITY OF ALBUQUERQUE
 BERNALILLO COUNTY, NEW MEXICO
 APRIL, 2001

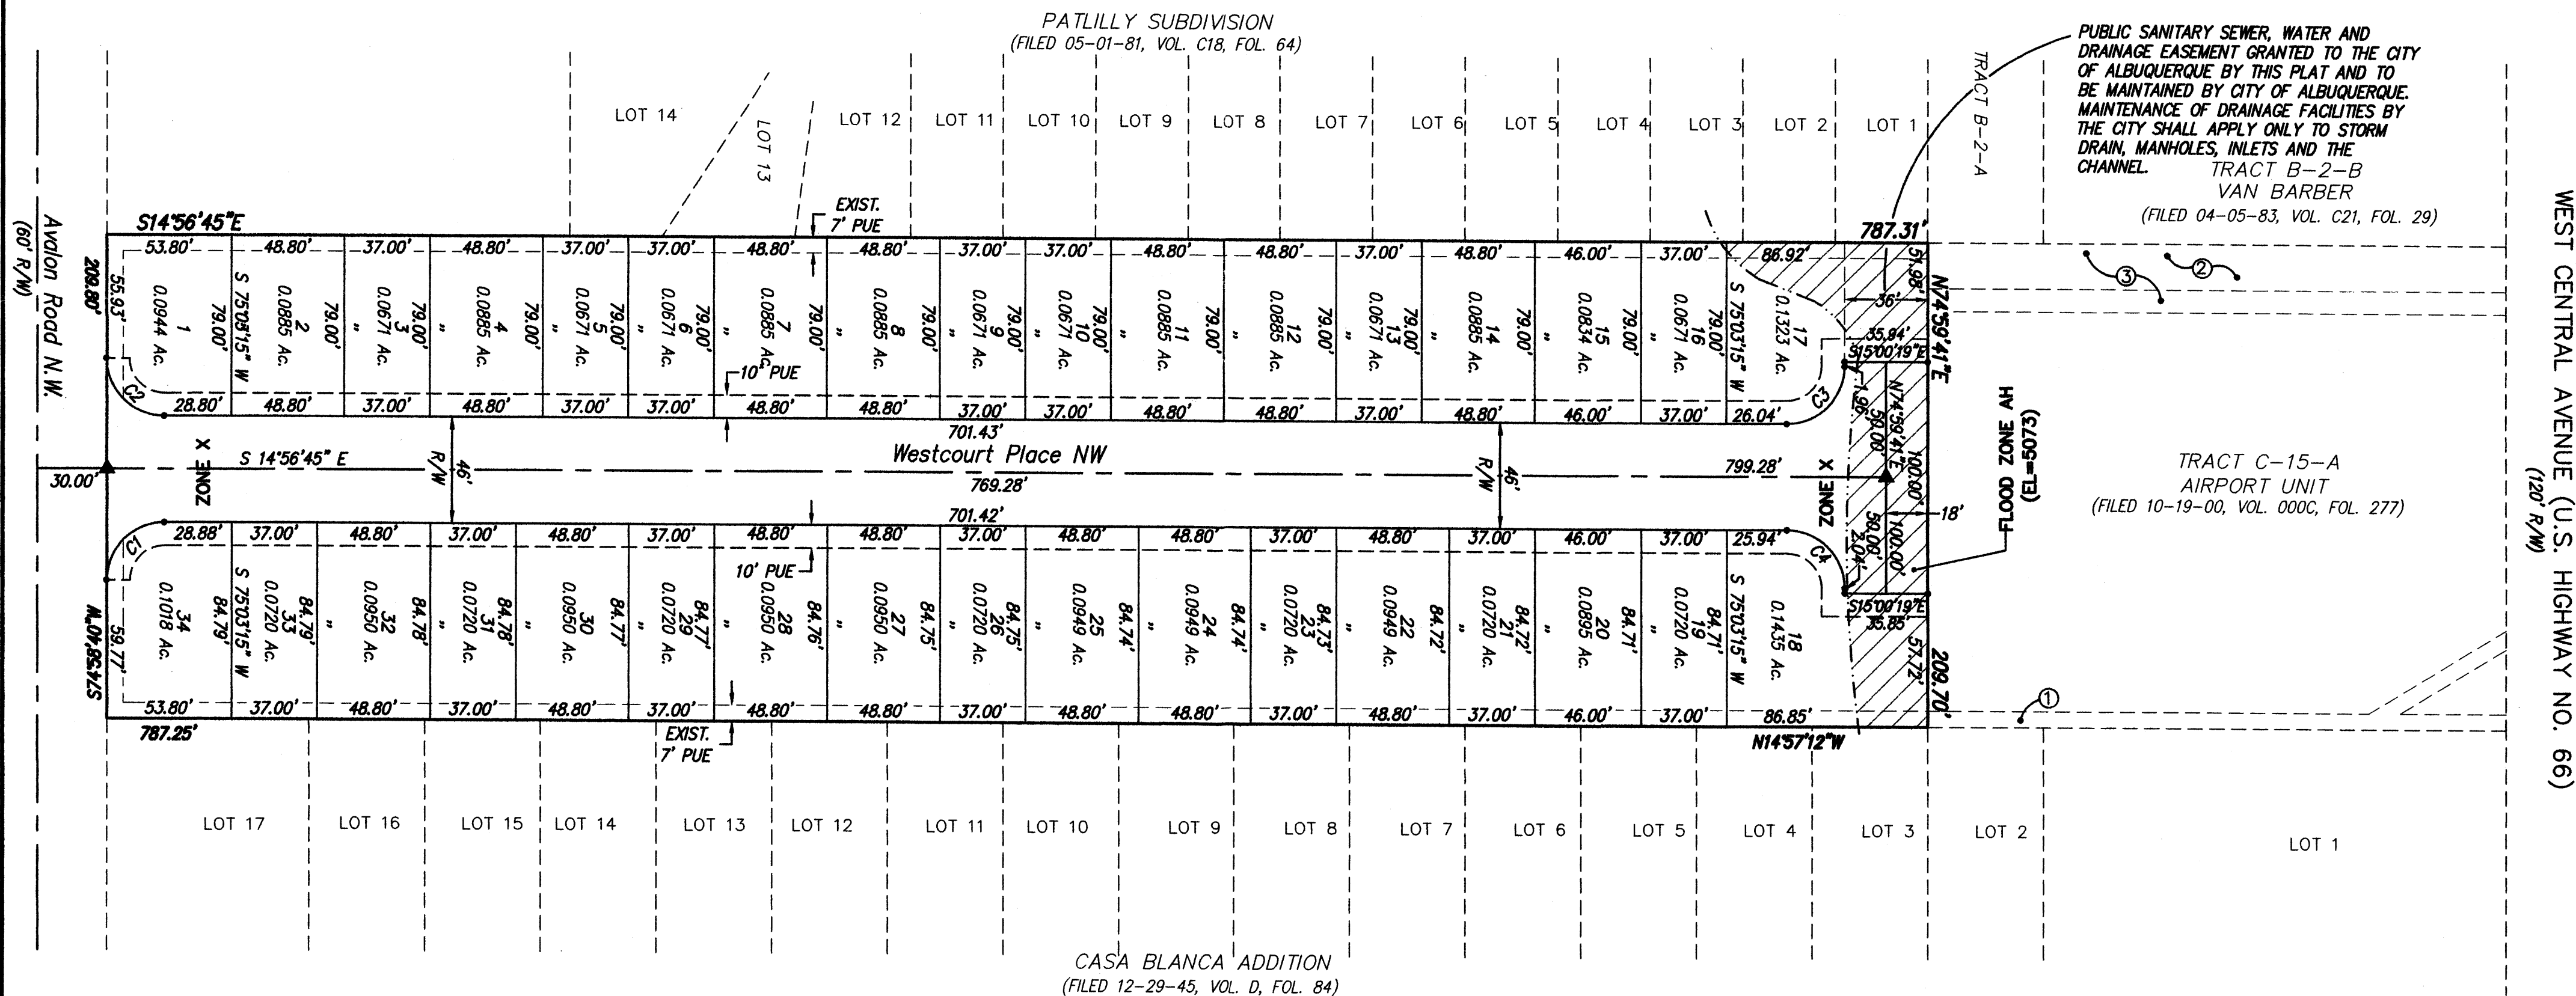

EXISTING EASEMENTS

- ① 7' PUE (10-19-00, 000C-277)
- ② 20' SEWER, WATER AND DRAINAGE EASEMENT (10-19-00, 000C-277)
- ③ 30' PUBLIC SEWER, WATER AND DRAINAGE EASEMENT (01-18-01, A14-3887)

Dwg: A01024SHT3	Drawn: SPS/JMM	Checked: ALS	Sheet 3 of 3
Scale: 1"=50'	Date: 08/31/01	Job: A01024	

PRELIMINARY PLAT

St. Joseph's Place

SUBDIVISION

WITHIN THE
TOWN OF ATRISCO GRANT
PROJECTED SECTION 23
TOWNSHIP 10, NORTH, RANGE 2 EAST, NMPM
CITY OF ALBUQUERQUE
BERNALILLO COUNTY, NEW MEXICO
MAY, 2001

SUBDIVISION DATA

GROSS ACREAGE 3.7909 Ac
ZONE/ATLAS NO. K-11-Z
NO. OF EXISTING TRACTS 1
NO. OF TRACTS/LOTS CREATED 2 TRACTS/34 LOTS
NO. OF TRACTS ELIMINATED 1
AREA DEDICATED TO CITY OF ALBUQUERQUE 0.8648 AC
DATE OF SURVEY MARCH, 2001

OWNERS

WESTCOR PROPERTIES LLC
11600 ACADEMY N.E.
ALBUQUERQUE, N.M. 87111
(505) 237-9311

ENGINEERS

D. MARK GOODWIN & ASSOCIATES, P.A.
CONSULTING ENGINEERS
P.O. BOX 90606
ALBUQUERQUE, NEW MEXICO 87199
(505) 828-2200

SURVEYOR

ALDRICH LAND SURVEY
P.O. BOX 30701
ALBUQUERQUE, N.M. 87190-0701
(505) 884-1990

OWNER:

Charles Bacheiller
CHARLES BACHELLER DATE
PRESIDENT OF WESTCOR PROPERTIES LLC.



LOCATION MAP
NOT TO SCALE

APPROVED FOR MONUMENTATION AND STREET NAMES

W. B. Hart
City Surveyor, City of Albuquerque, N.M. 5-22-01 Date

PURPOSE OF PLAT

1. SUBDIVIDE ONE TRACT INTO 34 RESIDENTIAL LOTS AND 2 TRACTS
2. DEDICATED RIGHT-OF-WAY AS SHOWN
3. GRANT NEW EASEMENTS AS SHOWN

LEGAL DESCRIPTION

A tract of land situate within the Town of Atrisco Grant, projected Section 23, Township 10 North, Range 2 East, New Mexico Principal Meridian, City of Albuquerque, Bernalillo County, New Mexico being all of Tract C-15-B, Airport unit filed in the office of the Bernalillo County Clerk on October 19, 2000, Volume 200C, Folio 277, and containing 3.7909 acres more or less.

NOTES

1. UNLESS OTHERWISE NOTED ALL POINTS ARE "SET 5/8" REBAR WITH CAP "ALS LS 7719".
2. ALL STREET CENTERLINE MONUMENTATION SHALL BE INSTALLED AT ALL CENTERLINE PC'S, PT'S, ANGLE POINTS, AND STREET INTERSECTIONS AND SHOWN THUS ▲, WILL BE MARKED BY A FOUR INCH (4") ALUMINUM CAP STAMPED:
"CITY OF ALBUQUERQUE CENTERLINE MONUMENTATION"
"DO NOT DISTURB"
"PLS # 7719".
3. BOUNDARY SHALL BE TIED TO THE NEW MEXICO STATE PLANE COORDINATE SYSTEM AS SHOWN.
4. BASIS OF BEARING SHALL BE NEW MEXICO STATE PLANE GRID BEARINGS.
5. ALL DISTANCES SHALL BE GROUND DISTANCES.
6. MANHOLES WILL BE OFFSET AT ALL POINTS OF CURVATURE, POINTS OF TANGENCY, STREET INTERSECTIONS, AND ALL OTHER ANGLE POINTS TO ALLOW USE OF CENTERLINE MONUMENTATION.
7. TRACTS "A" AND "B" ARE TO BE DEEDED AS JOINT USE RECREATIONAL AREAS TO THE HOME OWNER'S ASSOCIATION AND MAINTAINED BY THE HOME OWNER'S ASSOCIATION.


Dwg: A01024SHT1	Drawn: SPS	Checked: ALS	Sheet 1 of 3
Scale: AS SHOWN	Date: 05/01/01	Job: A01024	

PRELIMINARY PLAT
St. Joseph's Place
SUBDIVISION

WITHIN THE
TOWN OF ATRISCO GRANT
PROJECTED SECTION 23
TOWNSHIP 10 NORTH, RANGE 2 EAST, NMPM
CITY OF ALBUQUERQUE
BERNALILLO COUNTY, NEW MEXICO
MAY, 2001

EXISTING EASEMENTS

- ① 7' PUE
(10-19-00, 000C-277)
- ② 20' SEWER, WATER AND DRAINAGE EASEMENT
(10-19-00, 000C-277)
- ③ 30' PUBLIC SEWER, WATER AND DRAINAGE EASEMENT
(01-18-01, A14-3887)

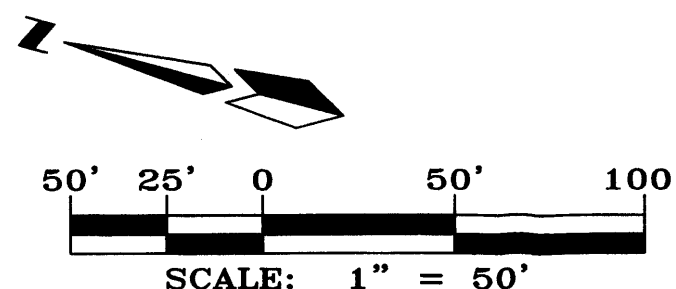

Station Name: NM448-C1
Elevation(NGVD29): 5074.028
NM State Plane (NAD27):
X=364764.30, Y=1485275.17
GROUND TO GRID 0.99967831
DELTA ALPHA -0°15'35"

PATILLY SUBDIVISION
(FILED 05-01-81, VOL. C18, FOL. 64)

TRACT B-2-B
VAN BARBER
(FILED 04-05-83, VOL. C21, FOL. 29)

DISCUSS
MM?

EXISTING PUBLIC 30' SANITARY SEWER,
WATERLINE & DRAINAGE EASEMENT

TRACT C-15-A
AIRPORT UNIT
(FILED 10-19-00, VOL. 000C, FOL. 277)

TRACT "C-15-B"
3.7909 Ac.

EXISTING 7' PUE
(FILED 10-19-00, VOL. 000C, FOL. 277)
VACATED BY THIS PLAT
(01410-00000-00930 VPE)

ZONE AH
(EL=5073)

ZONE X

ZONE X

EXISTING 7' PUE
(FILED 10-19-00, VOL. 000C, FOL. 277)
VACATED BY THIS PLAT
(01410-00000-00930 VPE)

FOUND 5/8" REBAR W/CAP
"LS 6837"

FOUND 5/8" REBAR W/CAP
"LS 4252"

CASA BLANCA ADDITION
(FILED 12-29-45, VOL. D, FOL. 84)


ACS MONUMENT "5-K10"
Y=1484685.30, Y=362341.63
GROUND TO GRID 0.99967811
DELTA ALPHA -00
CENTRAL ZONE "15'52"
(NAD 1927/SLD 1929)
ELEVATION =5093.73

Dwg: A01024SHT2	Drawn: SPS	Checked: ALS	Sheet 2 of 3
Scale: 1"=50'	Date: 05/22/01	Job: A01024	


NOTE:

- ALL STREETS SHOWN HEREON ARE HEREBY DEDICATED AS PUBLIC RIGHT-OF-WAY.
- AT THE TIME OF INDIVIDUAL BUILDING PERMIT APPLICATION, THE APPLICANT SHALL BE REQUIRED TO DEMONSTRATE THAT THERE EXISTS AT LEAST 600 S.F. OF OPEN SPACE ON EACH LOT. DEFICIENCIES IN OPEN SPACE MAY BE COMPENSATED FOR ACCORDING TO SECTION 14-16-3-8A OF THE ZONING CODE
- AN "AH" FLOOD ZONE (ELEV. 5073) EXISTS AT THE FAR SOUTH END OF THE SUBDIVISION. FLOOD INSURANCE MAY BE REQUIRED FOR HOMEOWNERS AFFECTED BY THIS FLOOD ZONE, UNTIL SUCH TIME THAT A LOMR IS OBTAINED.
- CENTERLINE (IN LIEU OF R/W) MONUMENTATION IS TO BE INSTALLED AT ALL CENTERLINE PC'S, PT'S, ANGLE POINTS AND STREET INTERSECTIONS AS SHOWN HEREON, AND WILL CONSIST OF A FOUR INCH (4") ALUMINUM ALLOY CAP STAMPED "CITY OF ALBUQUERQUE", "CENTERLINE MONUMENT", "DO NOT DISTURB", "PLS # 7719".

CURVE TABLE						
CURVE	LENGTH	RADIUS	DELTA	TANGENT	CH-BEARING=	CH-DIST=
C1	39.30	25.00	90°04'35"	25.03	N59°59'03"W	35.38
C2	37.34	25.00	85°34'25"	23.14	S27°50'27"W	33.96
C3	39.30	25.00	90°03'34"	25.03	S59°58'32"E	35.37
C4	39.24	25.00	89°56'26"	24.97	N30°01'28"E	35.34

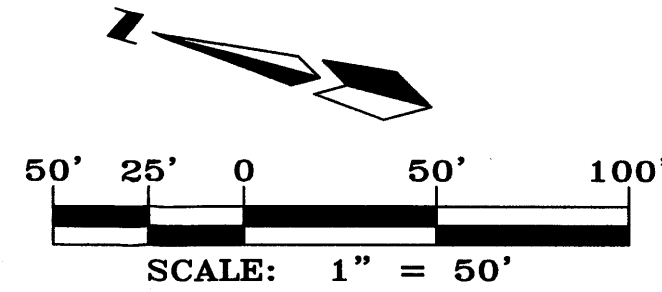

PRELIMINARY PLAT
St. Joseph's Place
SUBDIVISION
 WITHIN THE
 TOWN OF ATRISCO GRANT
 PROJECTED SECTION 23
 TOWNSHIP 10 NORTH, RANGE 2 EAST, NMPM
 CITY OF ALBUQUERQUE
 BERNALILLO COUNTY, NEW MEXICO
 APRIL, 2001

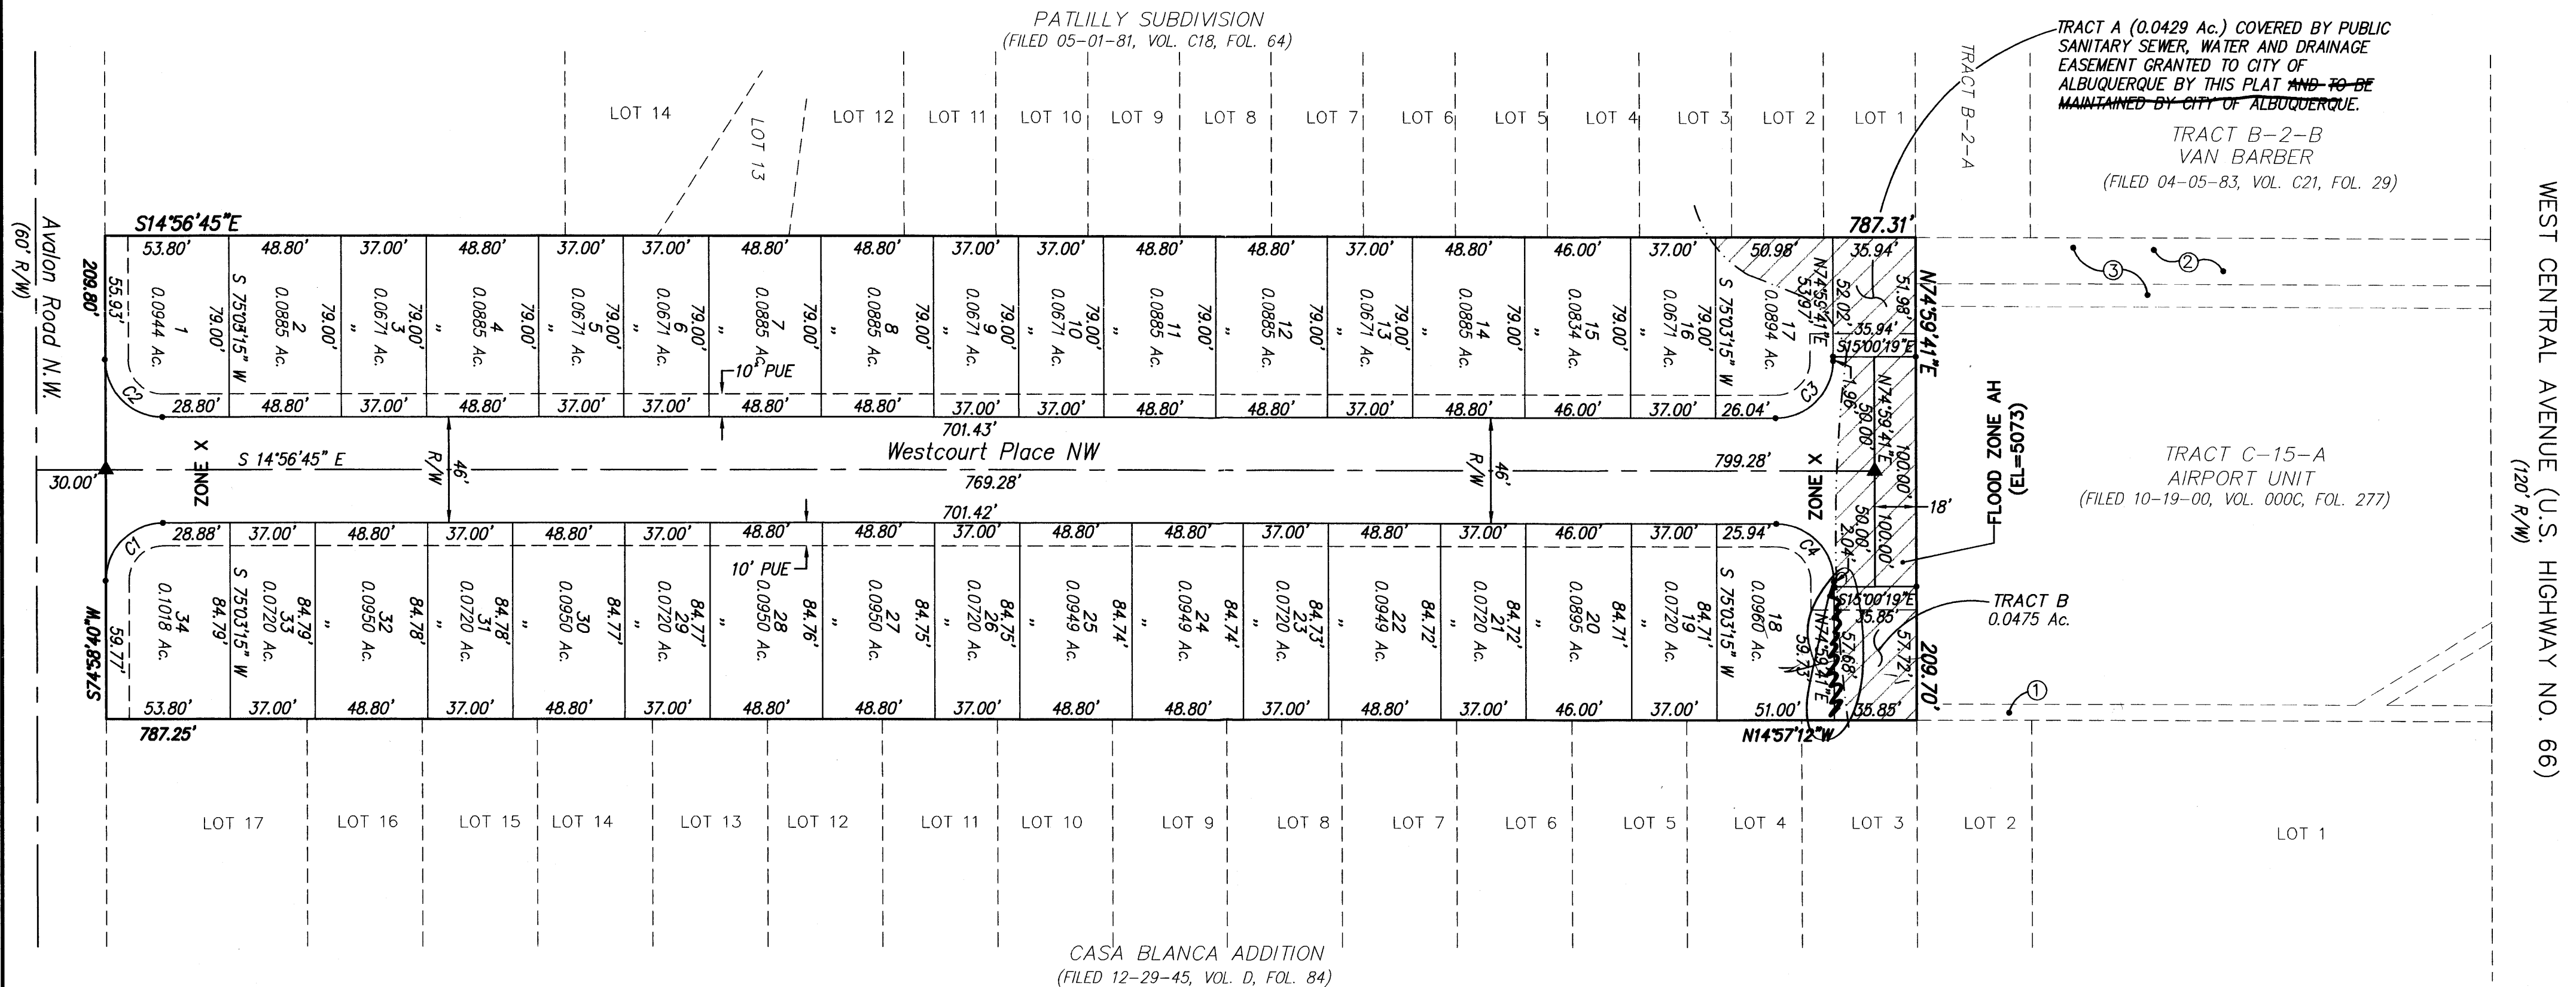

EXISTING EASEMENTS

- 7' PUE (10-19-00, 000C-277)
- 20' SEWER, WATER AND DRAINAGE EASEMENT (10-19-00, 000C-277)
- 30' PUBLIC SEWER, WATER AND DRAINAGE EASEMENT (01-18-01, A14-3887)

Dwg: A01024SHT3	Drawn: SPS	Checked: ALS	Sheet 3 of 3
Scale: 1"=50'	Date: 08/21/01	Job: A01024	

PRELIMINARY PLAT

St. Joseph's Place

SUBDIVISION

WITHIN THE
TOWN OF ATRISCO GRANT
PROJECTED SECTION 23
TOWNSHIP 10, NORTH, RANGE 2 EAST, NMPM
CITY OF ALBUQUERQUE
BERNALILLO COUNTY, NEW MEXICO
MAY, 2001

SUBDIVISION DATA

GROSS ACREAGE 3.7909 Ac
ZONE/ATLAS NO. K-11-Z
NO. OF EXISTING TRACTS 1
NO. OF TRACTS/LOTS CREATED 2 TRACTS/34 LOTS
NO. OF TRACTS ELIMINATED 1
AREA DEDICATED TO CITY OF ALBUQUERQUE 0.8648 AC
DATE OF SURVEY MARCH, 2001

OWNERS

WESTCOR PROPERTIES LLC
11600 ACADEMY N.E.
ALBUQUERQUE, N.M. 87111
(505) 237-9311

ENGINEERS


D. MARK GOODWIN & ASSOCIATES, P.A.
CONSULTING ENGINEERS
P.O. BOX 90606
ALBUQUERQUE, NEW MEXICO 87199
(505) 828-2200

SURVEYOR

ALDRICH LAND SURVEY
P.O. BOX 30701
ALBUQUERQUE, N.M. 87190-0701
(505) 884-1990

OWNER:

Charles Bachelier
CHARLES BACHELLER
PRESIDENT OF WESTCOR PROPERTIES LLC.

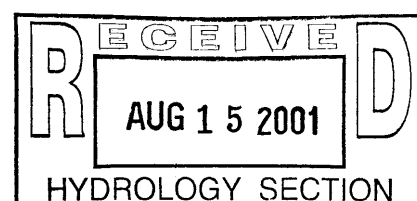

LOCATION MAP
NOT TO SCALE

APPROVED FOR MONUMENTATION AND STREET NAMES

W. B. Hunt
City Surveyor, City of Albuquerque, N.M. 5-22-01 Date

PURPOSE OF PLAT

1. SUBDIVIDE ONE TRACT INTO 34 RESIDENTIAL LOTS AND 2 TRACTS
2. DEDICATED RIGHT-OF-WAY AS SHOWN
3. GRANT NEW EASEMENTS AS SHOWN

LEGAL DESCRIPTION

A tract of land situate within the Town of Atrisco Grant, projected Section 23, Township 10 North, Range 2 East, New Mexico Principal Meridian, City of Albuquerque, Bernalillo County, New Mexico being all of Tract C-15-B, Airport unit filed in the office of the Bernalillo County Clerk on October 19, 2000, Volume 200C, Folio 277, and containing 3.7909 acres more or less.

NOTES

1. UNLESS OTHERWISE NOTED ALL POINTS ARE "SET 5/8" REBAR WITH CAP "ALS LS 7719".
2. ALL STREET CENTERLINE MONUMENTATION SHALL BE INSTALLED AT ALL CENTERLINE PC'S, PT'S, ANGLE POINTS, AND STREET INTERSECTIONS AND SHOWN THUS ▲, WILL BE MARKED BY A FOUR INCH (4") ALUMINUM CAP STAMPED:
"CITY OF ALBUQUERQUE CENTERLINE MONUMENTATION"
"DO NOT DISTURB"
"PLS # 7719".
3. BOUNDARY SHALL BE TIED TO THE NEW MEXICO STATE PLANE COORDINATE SYSTEM AS SHOWN.
4. BASIS OF BEARING SHALL BE NEW MEXICO STATE PLANE GRID BEARINGS.
5. ALL DISTANCES SHALL BE GROUND DISTANCES.
6. MANHOLES WILL BE OFFSET AT ALL POINTS OF CURVATURE, POINTS OF TANGENCY, STREET INTERSECTIONS, AND ALL OTHER ANGLE POINTS TO ALLOW USE OF CENTERLINE MONUMENTATION.
7. TRACTS "A" AND "B" ARE TO BE DEEDED AS JOINT USE RECREATIONAL AREAS TO THE HOME OWNER'S ASSOCIATION AND MAINTAINED BY THE HOME OWNER'S ASSOCIATION.


Dwg:	A01024SHT1	Drawn:	SPS	Checked:	ALS	Sheet	1 of 3
Scale:	AS SHOWN	Date:	05/01/01	Job:	A01024		

PRELIMINARY PLAT
St. Joseph's Place
SUBDIVISION

WITHIN THE
TOWN OF ATRISCO GRANT
PROJECTED SECTION 23
TOWNSHIP 10 NORTH, RANGE 2 EAST, NMPM
CITY OF ALBUQUERQUE
BERNALILLO COUNTY, NEW MEXICO
MAY, 2001

EXISTING EASEMENTS

- ① 7' PUE
(10-19-00, 000C-277)
- ② 20' SEWER, WATER AND DRAINAGE EASEMENT
(10-19-00, 000C-277)
- ③ 30' PUBLIC SEWER, WATER AND DRAINAGE EASEMENT
(01-18-01, A14-3887)

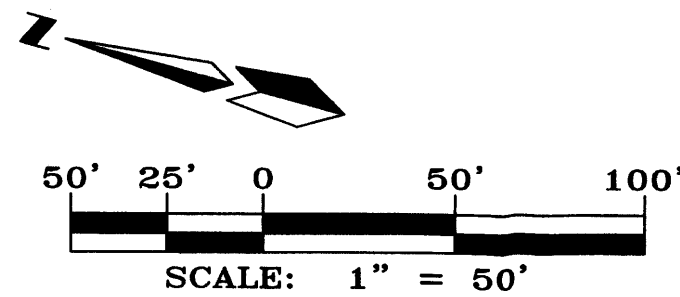

PATILLY SUBDIVISION
(FILED 05-01-81, VOL. C18, FOL. 64)

Station Name: NM448-C1
Elevation(NGVD29): 5074.028
NM State Plane (NAD27):
X=364764.30, Y=1485275.17
GROUND TO GRID 0.99967831
DELTA ALPHA -0°15'35"

TRACT B-2-B
VAN BARBER
(FILED 04-05-83, VOL. C21, FOL. 29)

EXISTING PUBLIC 30' SANITARY SEWER,
WATERLINE & DRAINAGE EASEMENT

TRACT C-15-A
AIRPORT UNIT
(FILED 10-19-00, VOL. 000C, FOL. 277)


TRACT "C-15-B"
3.7909 Ac.

EXISTING 7' PUE
(FILED 10-19-00, VOL. 000C, FOL. 277)
VACATED BY THIS PLAT
(01410-00000-00930 VPE)

EXISTING 7' PUE
(FILED 10-19-00, VOL. 000C, FOL. 277)
VACATED BY THIS PLAT
(01410-00000-00930 VPE)

CASA BLANCA ADDITION
(FILED 12-29-45, VOL. D, FOL. 84)

ACS MONUMENT "5-K10"
Y=1484685.30, Y=362341.63
GROUND TO GRID 0.99967811
DELTA ALPHA -00
CENTRAL ZONE 15°52"
(NAD 1927/SLD 1929)
ELEVATION =5093.73

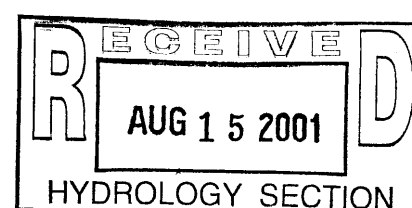


Dwg: A01024SHT2	Drawn: SPS	Checked: ALS	Sheet 2 of 3
Scale: 1"=50'	Date: 05/22/01	Job: A01024	

NOTE:


- ALL STREETS SHOWN HEREON ARE HEREBY DEDICATED AS PUBLIC RIGHT-OF-WAY.
- AT THE TIME OF INDIVIDUAL BUILDING PERMIT APPLICATION, THE APPLICANT SHALL BE REQUIRED TO DEMONSTRATE THAT THERE EXISTS AT LEAST 600 S.F. OF OPEN SPACE ON EACH LOT. DEFICIENCIES IN OPEN SPACE MAY BE COMPENSATED FOR ACCORDING TO SECTION 14-16-3-8A OF THE ZONING CODE
- TRACTS A AND B ARE ENCUMBERED BY A BLANKET DRAINAGE EASEMENT FOR THE PURPOSE OF STORM WATER DETENTION. THE EASEMENT SHALL REMAIN UNTIL EXISTING DOWNSTREAM PUBLIC DRAINAGE CAPACITY IS INCREASED AT WHICH TIME THE TRACTS MAY BE RECLAIMED, SUBJECT TO C.O.A. HYDROLOGY DIVISION APPROVAL.
- AN "AH" FLOOD ZONE (ELEV. 5073) EXISTS AT THE FAR SOUTH END OF THE SUBDIVISION. FLOOD INSURANCE MAY BE REQUIRED FOR HOMEOWNERS AFFECTED BY THIS FLOOD ZONE, UNTIL SUCH TIME THAT A LOMR IS OBTAINED.
- CENTERLINE (IN LIEU OF R/W) MONUMENTATION IS TO BE INSTALLED AT ALL CENTERLINE PC'S, PT'S, ANGLE POINTS AND STREET INTERSECTIONS AS SHOWN HEREON, AND WILL CONSIST OF A FOUR INCH (4") ALUMINUM ALLOY CAP STAMPED "CITY OF ALBUQUERQUE", "CENTERLINE MONUMENT", "DO NOT DISTURB", "PLS # 7719".

CURVE TABLE						
CURVE	LENGTH	RADIUS	DELTA	TANGENT	CH-BEARING=	CH-DIST=
C1	39.30	25.00	90°04'35"	25.03	N59°59'03"W	35.38
C2	37.34	25.00	85°34'25"	23.14	S27°50'27"W	33.96
C3	39.30	25.00	90°03'34"	25.03	S59°58'32"E	35.37
C4	39.24	25.00	89°56'26"	24.97	N30°01'28"E	35.34

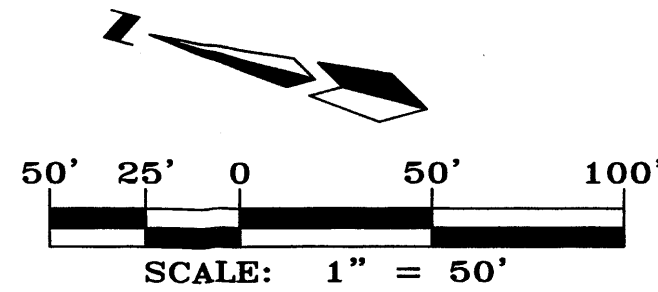


PRELIMINARY PLAT
St. Joseph's Place
SUBDIVISION
 WITHIN THE
 TOWN OF ATRISCO GRANT
 PROJECTED SECTION 23
 TOWNSHIP 10 NORTH, RANGE 2 EAST, NMPM
 CITY OF ALBUQUERQUE
 BERNALILLO COUNTY, NEW MEXICO
 APRIL, 2001

PATILLY SUBDIVISION
 (FILED 05-01-81, VOL. C18, FOL. 64)

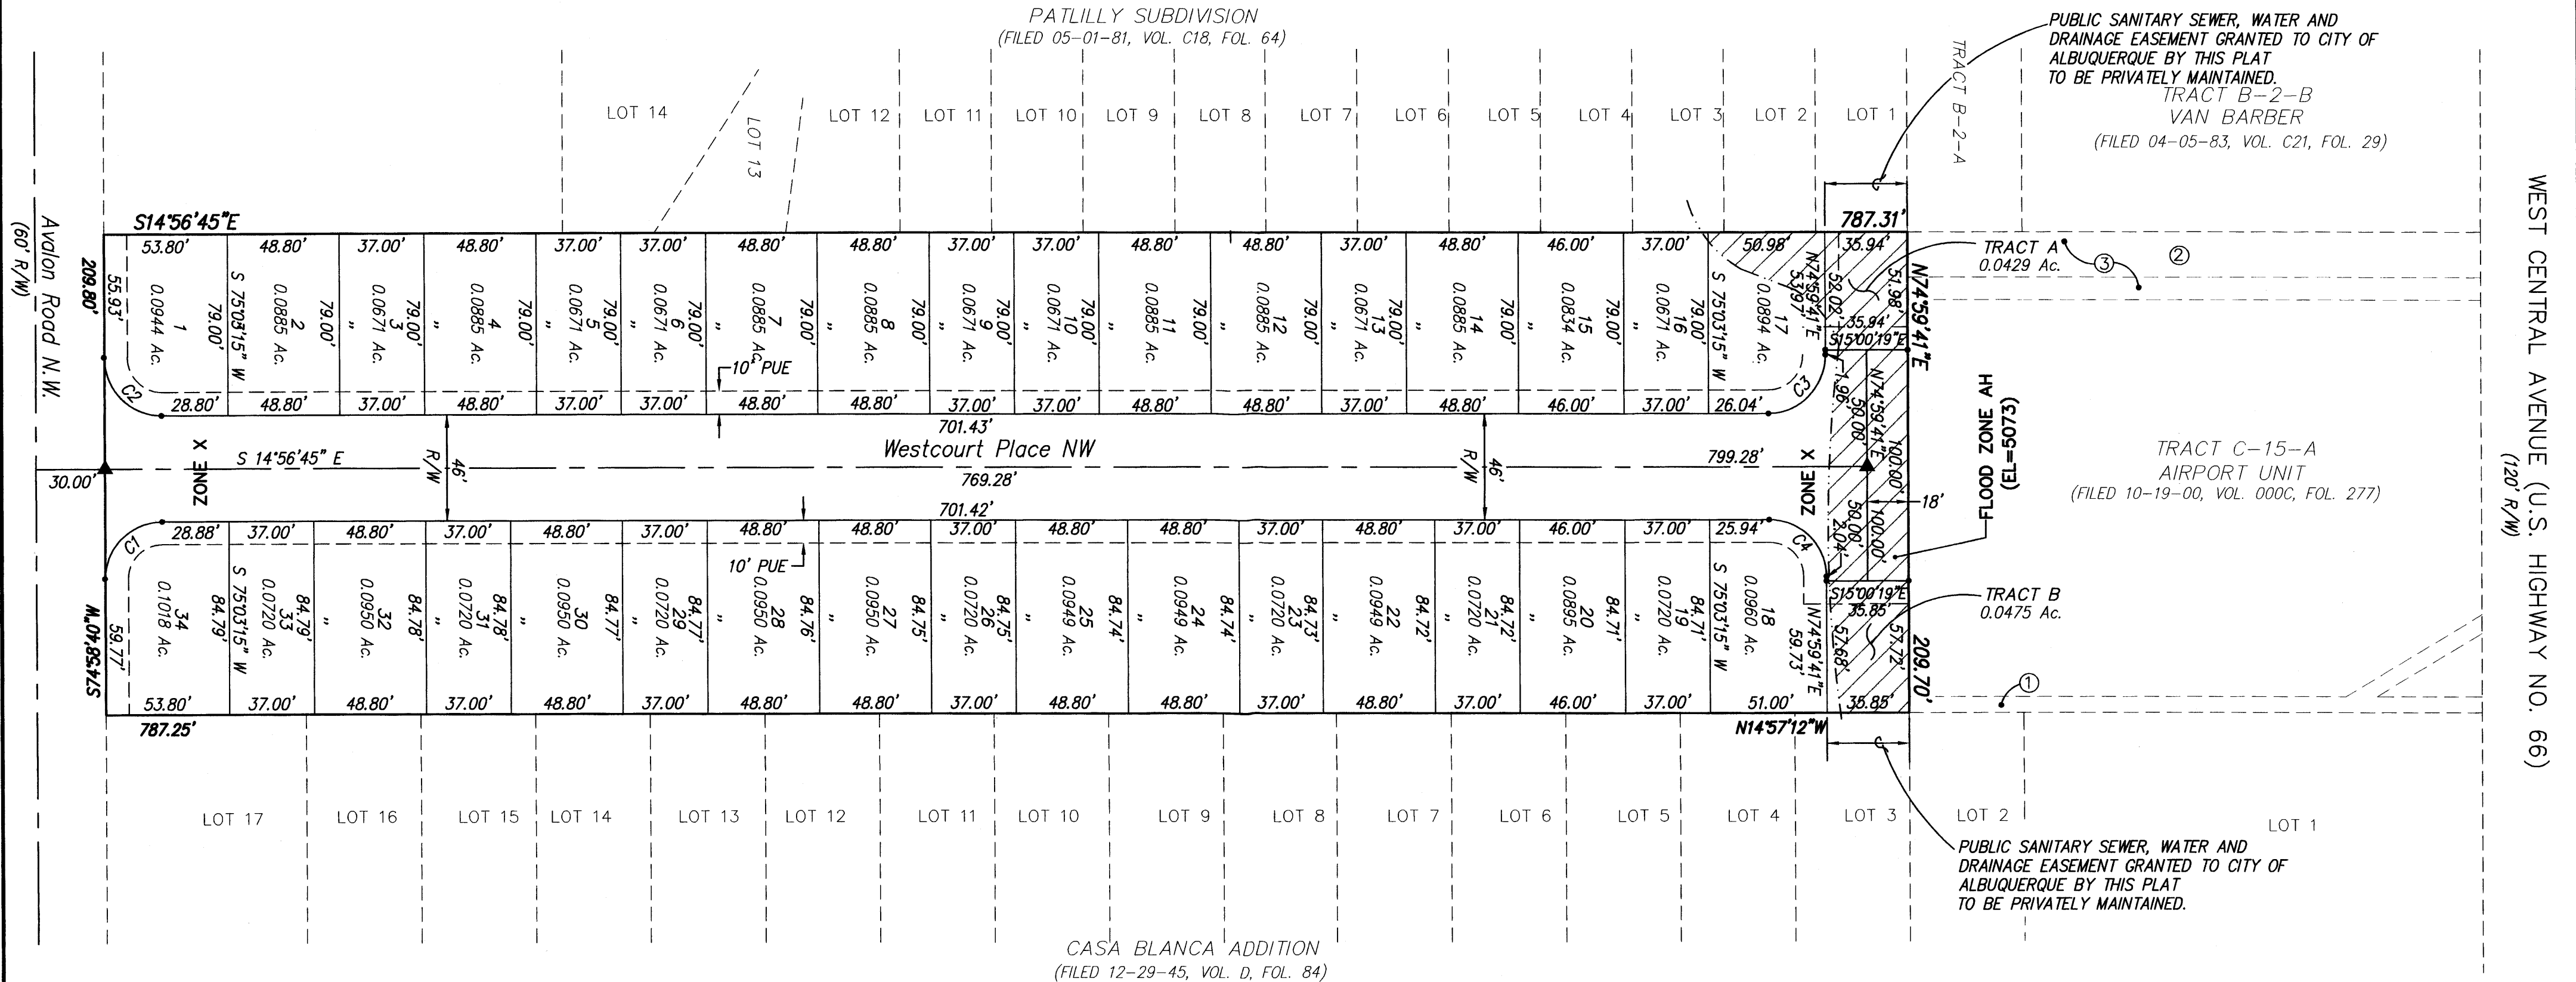


EXISTING EASEMENTS


- 7' PUE
 (10-19-00, 000C-277)
- 20' SEWER, WATER AND DRAINAGE EASEMENT
 (10-19-00, 000C-277)
- 30' PUBLIC SEWER, WATER AND DRAINAGE EASEMENT
 (01-18-01, A14-3887)

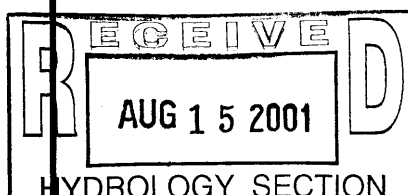


Dwg: A01024SHT3	Drawn: SPS	Checked: ALS	Sheet 3 of 3
Scale: 1"=50'	Date: 06/28/01	Job: A01024	

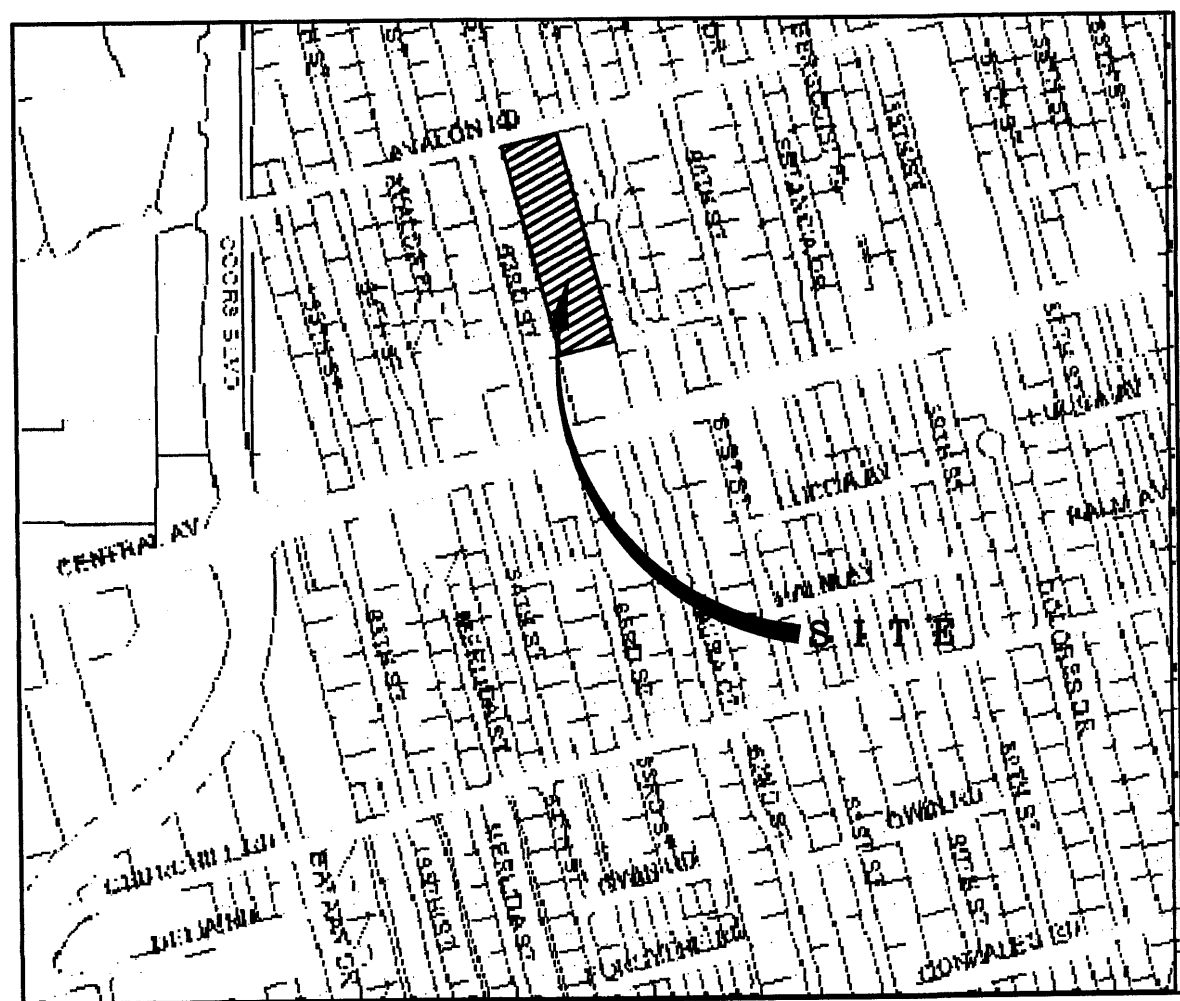


VICINITY MAP ZONE MAP: K-11-Z

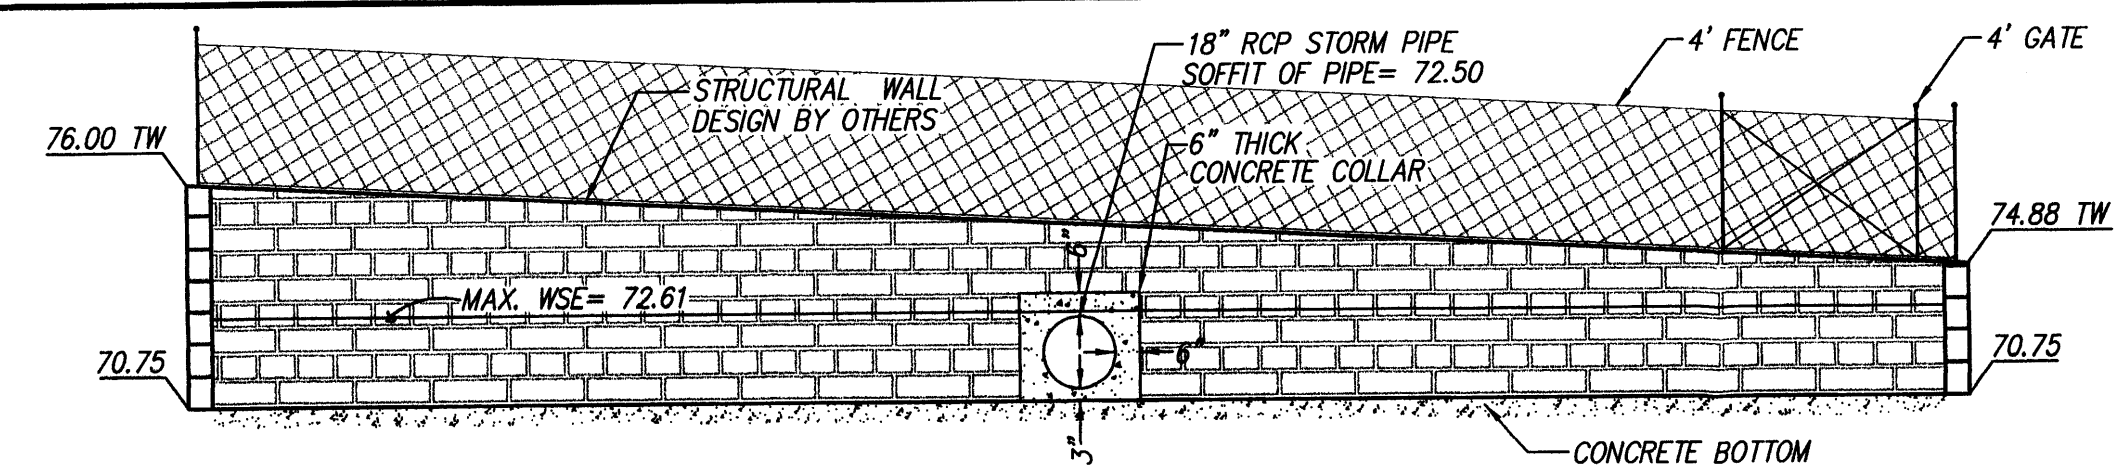



WALL SECTION A-A (TYP)
N.T.S.

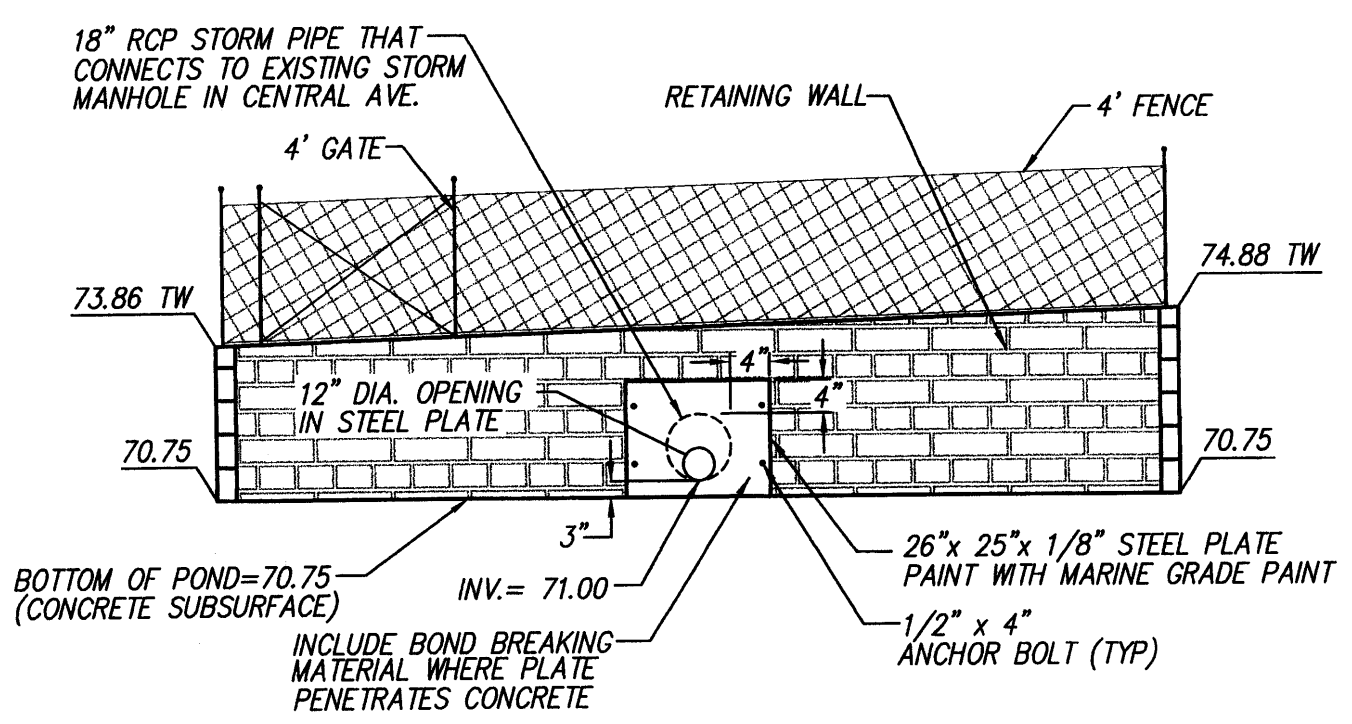


ORIFICE PLATE - SECTION B-B
N.T.S.

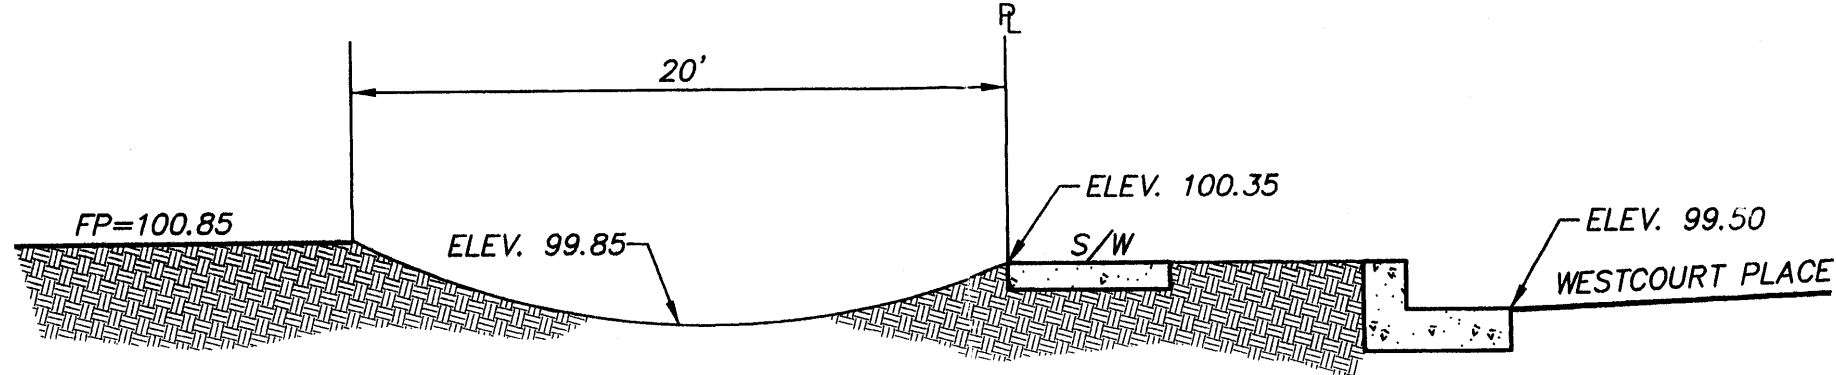

EROSION CONTROL SWALE DETAIL
N.T.S.

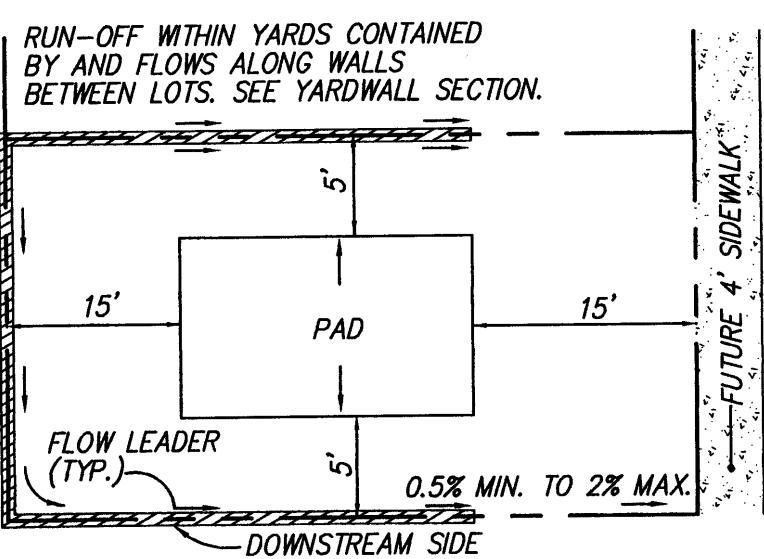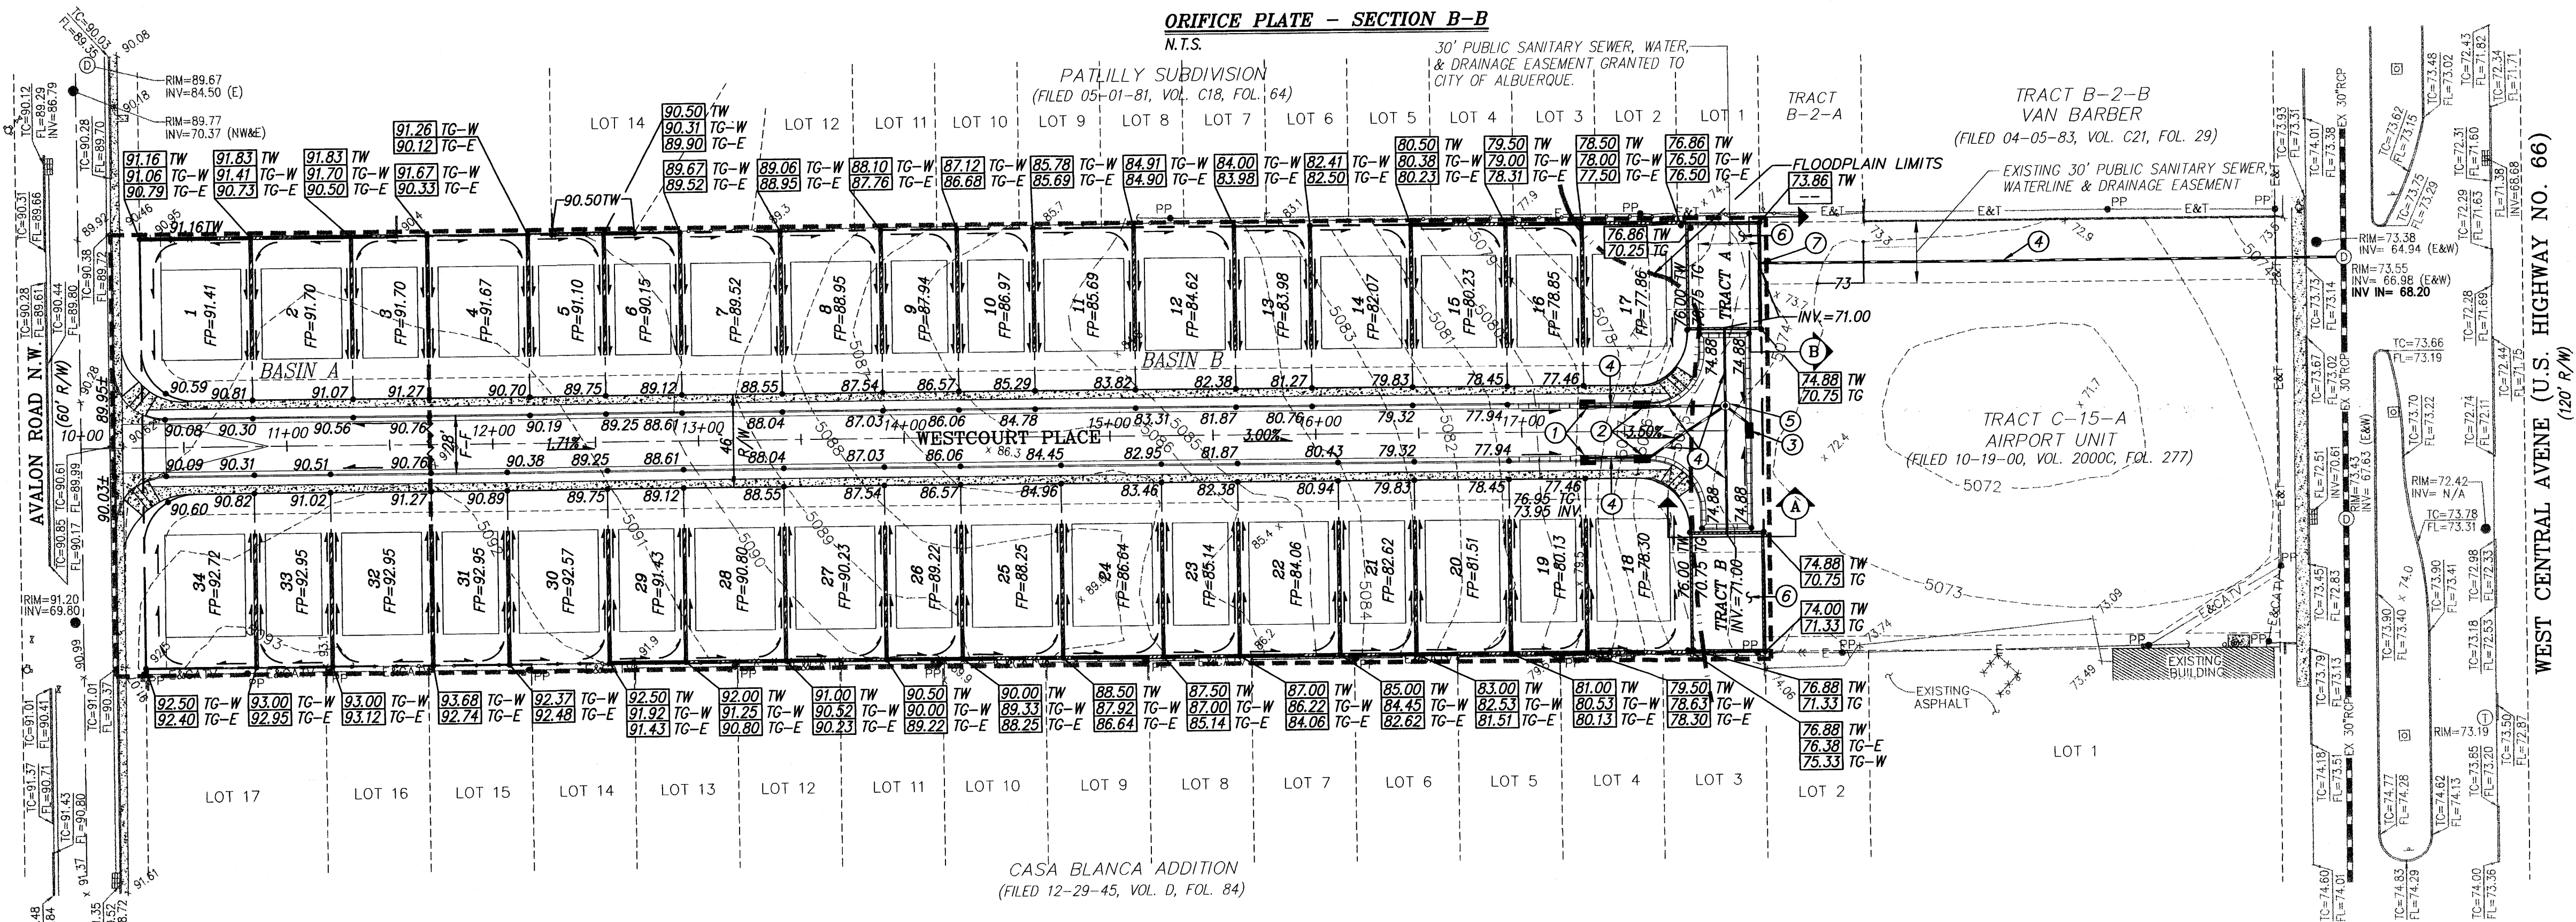

TYPICAL LOT LAYOUT PLAN
N.T.S.

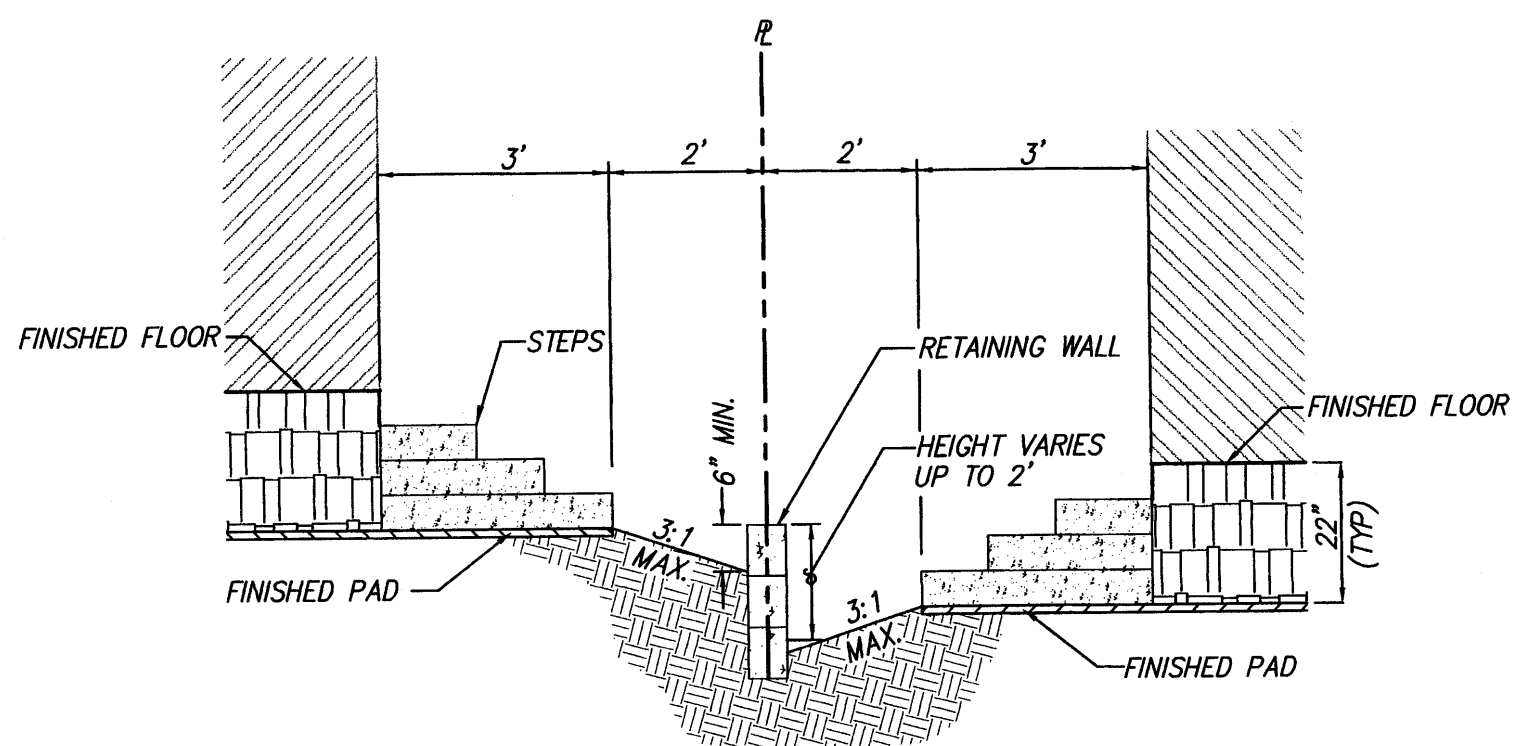

TYPICAL LOT LAYOUT SECTION
N.T.S.


LEGEND	
—	MOUNTABLE CURB & GUTTER
—	STANDARD 8" CURB & GUTTER
FP= 30.38	FINISHED PAD ELEVATION
00.00	PROPOSED SPOT ELEVATION
85.00 TW	PROPOSED TOP OF WALL ELEVATION
84.45 TG-W	PROPOSED TOP GROUND ELEVATION-WEST
83.37 TG-E	PROPOSED TOP GROUND ELEVATION-EAST
—	PROPOSED SLOPE
—	FLOODPLAIN LINE
—	PROPOSED WATER BLOCK
—	PROPOSED 4' SIDEWALK
—	TRACT/LOT BOUNDARY LINE
—	RIGHT OF WAY LINE
—	EASEMENT LINE
—	FLOW DIRECTION
—	PROPOSED SWALE
—	PROPOSED RETAINING WALL
—	PROPOSED STORM DRAIN PIPE
—	PROPOSED STORM DRAIN MANHOLE
—	PROPOSED STORM DRAIN INLET
—	EXISTING CONTOUR MAJOR
—	EXISTING CONTOUR MINOR
—	EXISTING FIRE HYDRANT
—	EXISTING WATER VALVE
—	EXISTING SANITARY SEWER MANHOLE
—	EXISTING STORM DRAIN MANHOLE
—	EXISTING STORM DRAIN INLET
—	EXISTING TOP OF CURB ELEVATION
—	EXISTING FLOW LINE ELEVATION
—	EXISTING SPOT ELEVATION
—	EXISTING OVERHEAD ELECTRIC & CABLE TV LINE
—	EXISTING POWER POLE
—	EXISTING TELEPHONE MANHOLE
—	EXISTING STREET LIGHT
—	EXISTING CHAIN LINK FENCE
—	EXISTING WOOD FENCE
—	DRAINAGE BASIN LINE

NOTES


1. CONTRACTOR MUST OBTAIN A TOPSOIL DISTURBANCE PERMIT FROM THE ENVIRONMENTAL HEALTH DIVISION PRIOR TO CONSTRUCTION.
2. CITY OF ALBUQUERQUE STANDARD SPECIFICATIONS FOR PUBLIC WORKS CONSTRUCTION, LATEST EDITION SHALL GOVERN ALL WORK.
3. THE CONTRACTOR SHALL CONFORM TO ALL CITY, COUNTY, STATE AND FEDERAL DUST CONTROL MEASURES AND REQUIREMENTS AND WILL BE RESPONSIBLE FOR PREPARING AND OBTAINING ALL NECESSARY APPLICATIONS AND APPROVALS.
4. THE CONTRACTOR SHALL ENSURE THAT NO SOIL ERODES FROM THE LOTS INTO PUBLIC RIGHT-OF-WAY. THIS CAN BE ACHIEVED BY CONSTRUCTING TEMPORARY BERMS AND WETTING THE SOIL TO KEEP IT FROM BLOWING.
5. THE EARTHWORK CONTRACTOR SHALL STOCKPILE ENOUGH MATERIAL ADJACENT TO RETAINING WALL LOCATIONS TO BE UTILIZED FOR WALL BACKFILL.


KEYED NOTES


1. TOTAL OF 2 TYPE "A" INLETS PER C.O.A. STANDARD DETAIL #2202. TOP GRADE= 76.95. INV. EL= 73.95.
2. TOTAL OF 4 TYPE "C" SINGLE INLETS PER C.O.A. STANDARD DETAIL #2205. TOP GRADE= 75.83. INV. EL= 72.83.
3. TOTAL OF 2 TYPE "C" SINGLE INLETS PER C.O.A. STANDARD DETAIL #2205. TOP GRADE= 74.33. INV. EL= 71.33.
4. NEW 18" RCP STORM DRAIN PIPE.
5. 8" DIAMETER TYPE "C" MANHOLE PER C.O.A. STANDARD DETAIL #2101. RM EL= 74.50. INV. IN= 71.15. INV. OUT= 71.00.
6. NEW DETENTION POND WITH CONCRETE BOTTOM AND MAX. WATER SURFACE ELEVATION OF 72.61. PROVIDE FENCE ENCLOSING POND AND GATE WITH LADDER TO BOTTOM.
7. NEW ORIFICE PLATE PER DETAIL THIS SHEET.

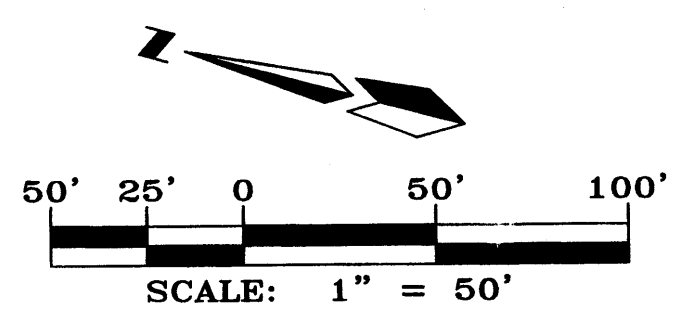

CITY OF ALBUQUERQUE PUBLIC WORKS DEPARTMENT	
TITLE: St. JOSEPH'S PLACE GRADING AND DRAINAGE PLAN	
DESIGN REVIEW COMMITTEE	CITY ENGINEER APPROVAL
LAST DESIGN UPDATE	MO./DAY/YR.
CITY PROJECT NO.	ZONE MAP NO. K-11-Z
DESIGNED BY JMM	DATE 05/01
DRAWN BY DER	DATE 05/01
CHECKED BY DMG	DATE 05/01

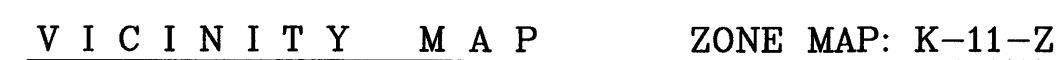

 - | | | | |
|---|------------------------------------|---|--|
|  | MOUNTABLE CURB & GUTTER |  | EXISTING CONTOUR MAJOR |
|  | STANDARD 8" CURB & GUTTER |  | EXISTING CONTOUR MINOR |
| FP= 30.38 | FINISHED PAD ELEVATION |  | EXISTING FIRE HYDRANT |
| 00.00 | PROPOSED SPOT ELEVATION |  | EXISTING WATER VALVE |
|  | PROPOSED TOP OF WALL ELEVATION |  | EXISTING SANITARY SEWER MANHOLE |
|  | PROPOSED TOP GROUND ELEVATION—WEST |  | EXISTING STORM DRAIN MANHOLE |
|  | PROPOSED TOP GROUND ELEVATION—EAST |  | EXISTING STORM DRAIN INLET |
|  | PROPOSED SLOPE |  | EXISTING TOP OF CURB ELEVATION |
|  | FLOODPLAIN LINE |  | EXISTING FLOW LINE ELEVATION |
|  | PROPOSED WATER BLOCK |  | EXISTING SPOT ELEVATION |
|  | PROPOSED 4' SIDEWALK |  | EXISTING OVERHEAD ELECTRIC & CABLE TV LINE |
|  | TRACT/LOT BOUNDARY LINE |  | EXISTING POWER POLE |
|  | RIGHT OF WAY LINE |  | EXISTING TELEPHONE MANHOLE |
|  | EASEMENT LINE |  | EXISTING STREET LIGHT |
|  | FLOW DIRECTION |  | EXISTING CHAIN LINK FENCE |
|  | PROPOSED SWALE |  | EXISTING WOOD FENCE |
|  | PROPOSED RETAINING WALL |  | DRAINAGE BASIN LINE |
|  | PROPOSED STORM DRAIN PIPE | | |
|  | PROPOSED STORM DRAIN MANHOLE | | |
|  | PROPOSED STORM DRAIN INLET | | |

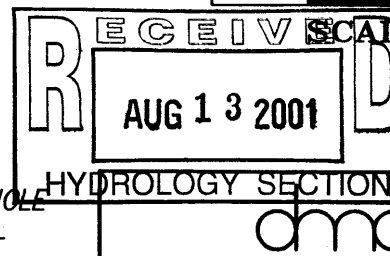

HYDROLOGY SECTION	MARK GOODWIN & ASSOCIATES, P.A. CONSULTING ENGINEERS P.O. BOX 90606 ALBUQUERQUE, NEW MEXICO 87199 (505) 828-2200, FAX (505) 797-9539
-------------------	--

CITY OF ALBUQUERQUE
PUBLIC WORKS DEPARTMENT

TITLE: *St. JOSEPH'S PLACE
GRADING AND DRAINAGE PLAN*


DESIGN REVIEW COMMITTEE	CITY ENGINEER APPROVAL	LAST DESIGN UPDATE	MO./DAY/YR.	MO./DAY/YR.
CITY PROJECT NO.	ZONE MAP NO.	SHEET	OF	
	K-11-7			


- ## NOTES

1. CONTRACTOR MUST OBTAIN A TOPSOIL DISTURBANCE PERMIT FROM THE ENVIRONMENTAL HEALTH DIVISION PRIOR TO CONSTRUCTION.
2. CITY OF ALBUQUERQUE STANDARD SPECIFICATIONS FOR PUBLIC WORKS CONSTRUCTION, LATEST EDITION SHALL GOVERN ALL WORK.
3. THE CONTRACTOR SHALL CONFORM TO ALL CITY, COUNTY, STATE AND FEDERAL DUST CONTROL MEASURES AND REQUIREMENTS AND WILL BE RESPONSIBLE FOR PREPARING AND OBTAINING ALL NECESSARY APPLICATIONS AND APPROVALS.
4. THE CONTRACTOR SHALL ENSURE THAT NO SOIL ERODES FROM THE LOTS INTO PUBLIC RIGHT-OF-WAY. THIS CAN BE ACHIEVED BY CONSTRUCTING TEMPORARY BERMS AND WETTING THE SOIL TO KEEP IT FROM BLOWING
5. THE EARTHWORK CONTRACTOR SHALL STOCKPILE ENOUGH MATERIAL ADJACENT TO RETAINING WALL LOCATIONS TO BE UTILIZED FOR WALL BACKFILL.


K E Y E D N O T E S

- ① TOTAL OF 2 TYPE "A" INLETS PER C.O.A. STANDARD
DETAIL #2202.
TOP GRATE= 76.95
INV. EL= 73.95
- ② TOTAL OF 4 TYPE "C" SINGLE INLETS PER C.O.A.
STANDARD DETAIL #2205.
TOP GRATE= 75.83
INV. EL= 72.83
- ③ TOTAL OF 2 TYPE "C" SINGLE INLETS PER C.O.A.
STANDARD DETAIL #2205.
TOP GRATE= 74.33
INV. EL= 71.33
- ④ NEW 18" RCP STORM DRAIN PIPE.
- ⑤ 8" DIAMETER TYPE "C" MANHOLE PER C.O.A.
STANDARD DETAIL #2101.
RIM EL= 74.50
INV. IN= 71.15
INV. OUT= 71.00
- ⑥ NEW DETENTION POND WITH CONCRETE BOTTOM
AND MAXIMUM WATER SURFACE ELEVATION OF 72.61.
PROVIDE FENCE ENCLOSING POND AND GATE
WITH LADDER TO BOTTOM.
- ⑦ NEW ORIFICE PLATE PER DETAIL THIS SHEET.

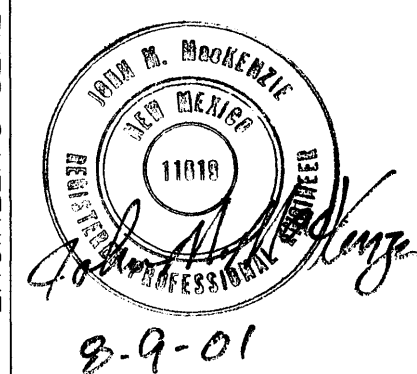


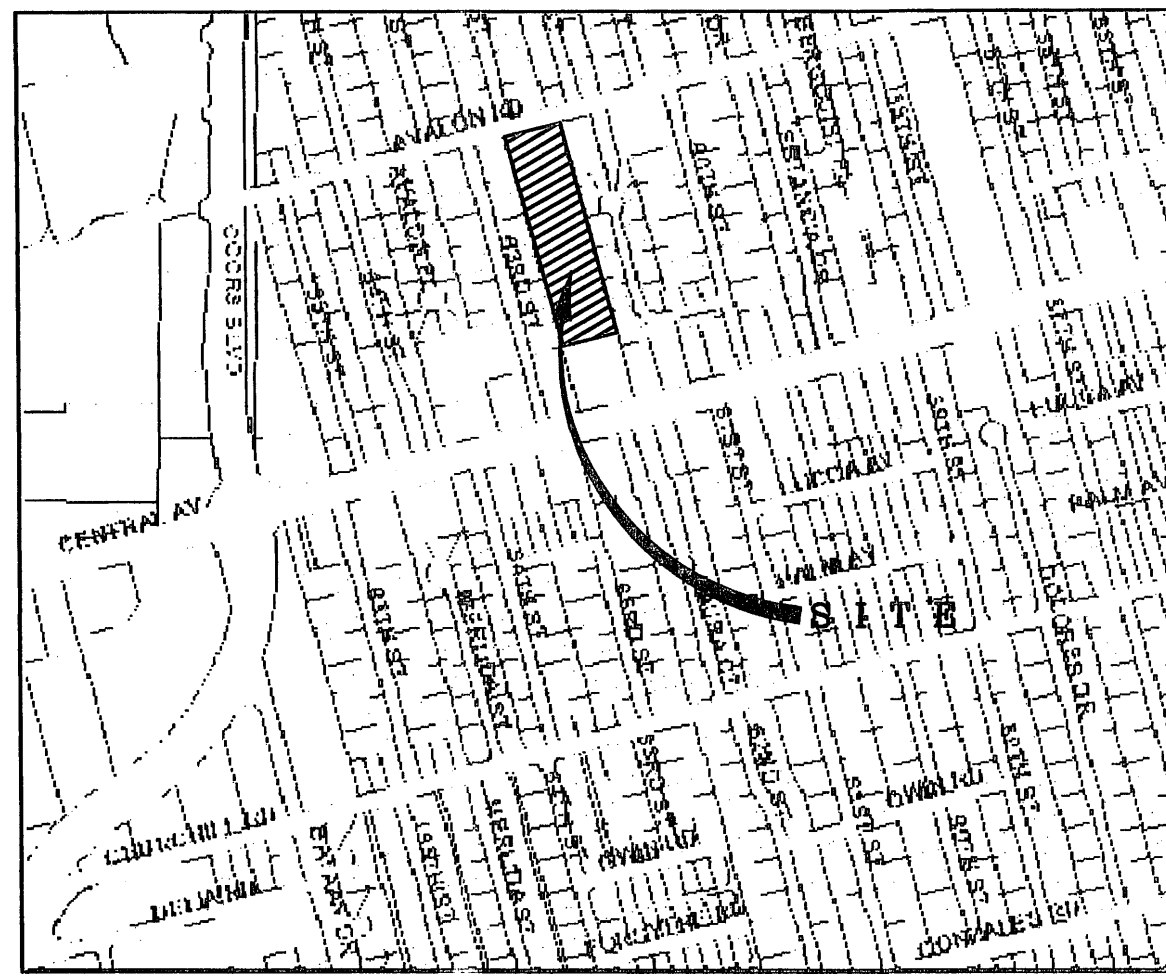


VICINITY MAP ZONE MAP: K-11-Z

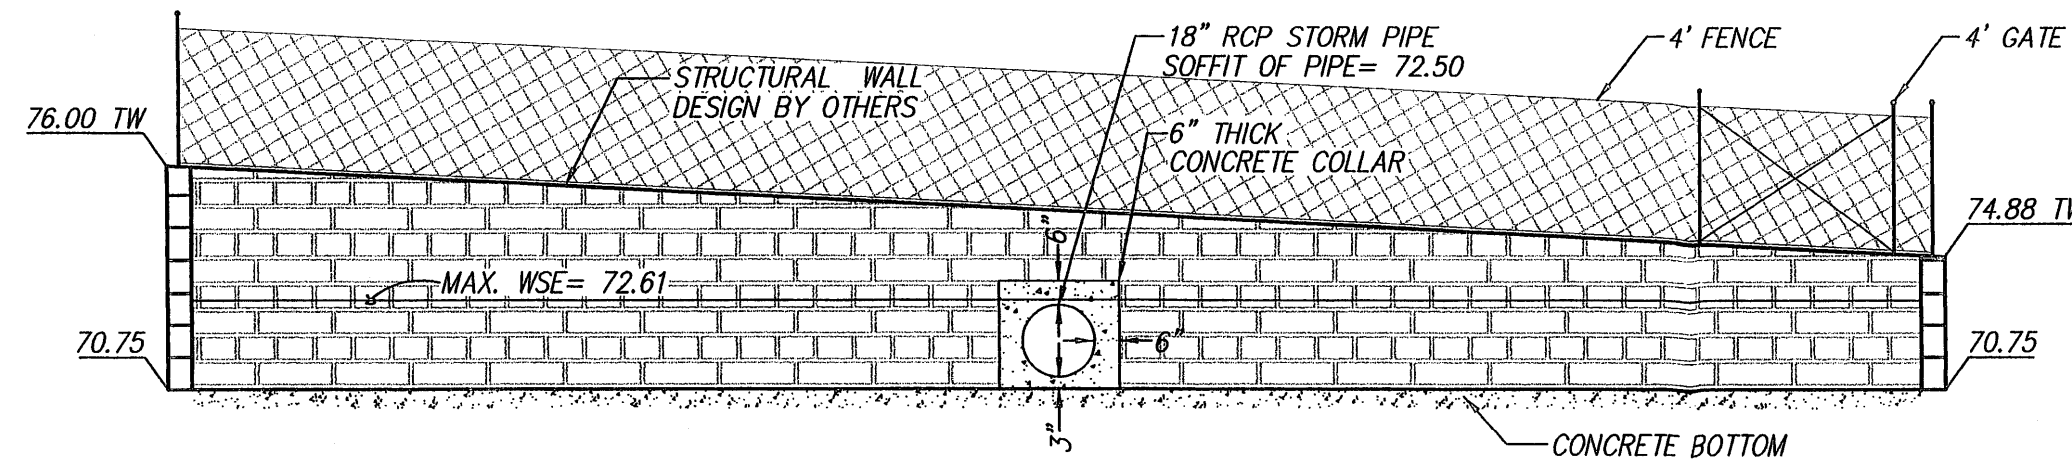

WALL SECTION A-A (TYP)
N.T.S.

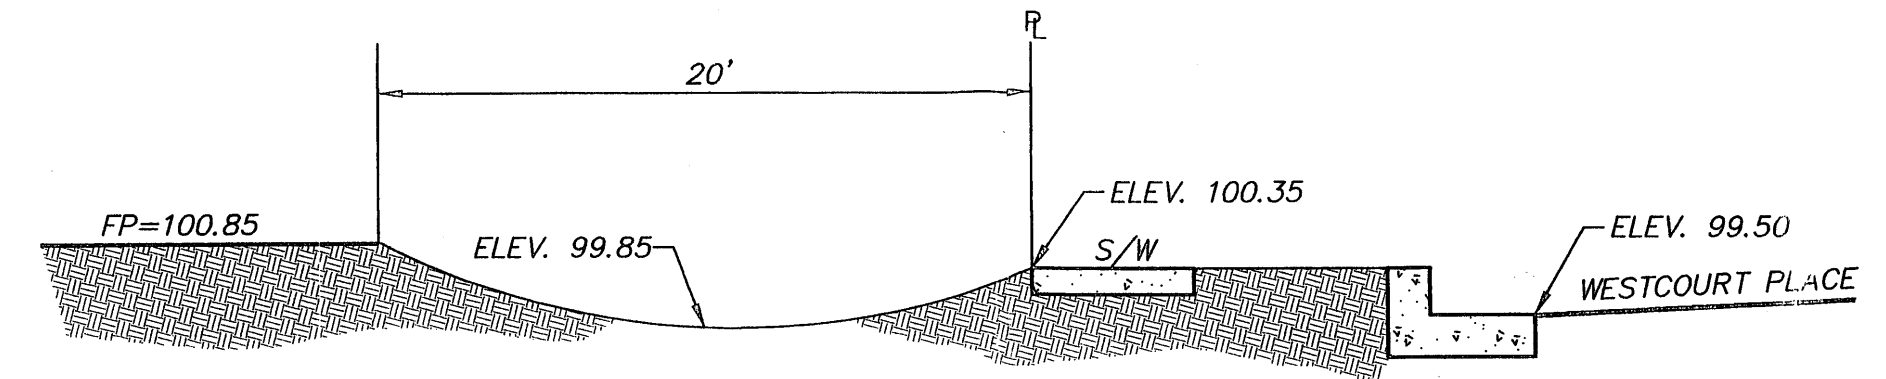

EROSION CONTROL SWALE DETAIL
N.T.S.

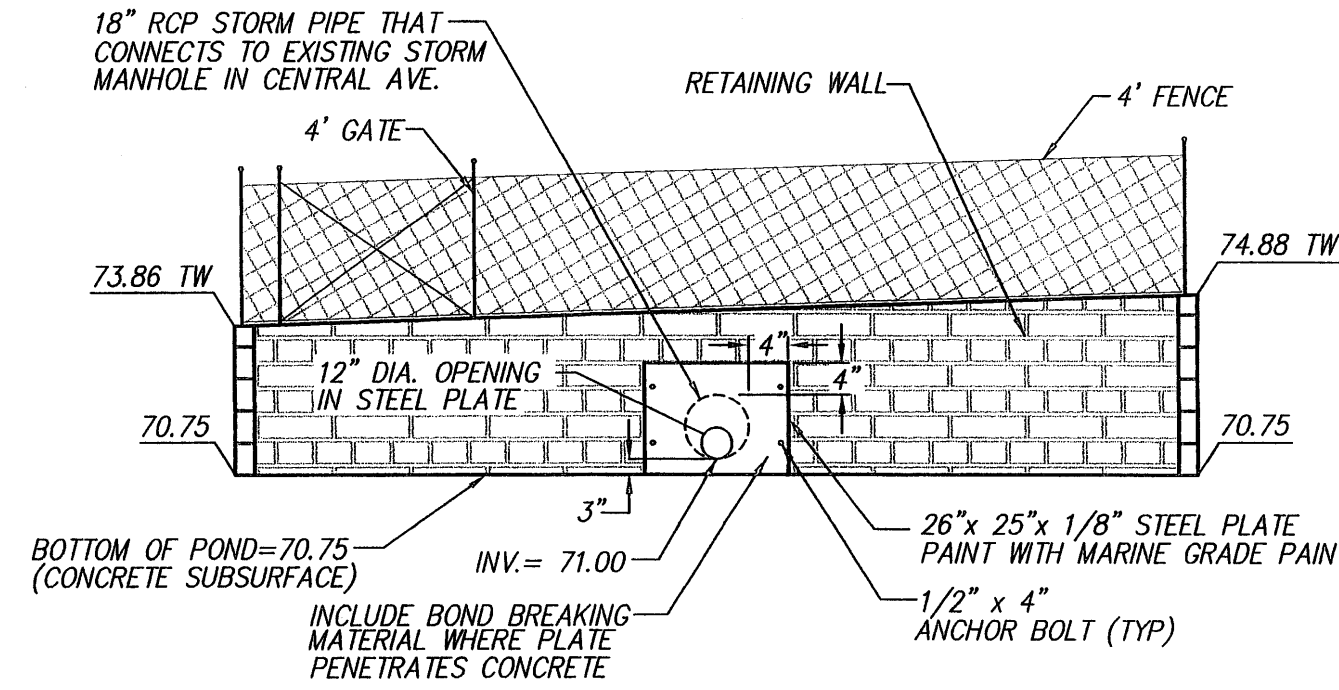


ORIFICE PLATE - SECTION B-B
N.T.S.

NOTES

- CONTRACTOR MUST OBTAIN A TOPSOIL DISTURBANCE PERMIT FROM THE ENVIRONMENTAL HEALTH DIVISION PRIOR TO CONSTRUCTION.
- CITY OF ALBUQUERQUE STANDARD SPECIFICATIONS FOR PUBLIC WORKS CONSTRUCTION, LATEST EDITION SHALL GOVERN ALL WORK.
- THE CONTRACTOR SHALL CONFORM TO ALL CITY, COUNTY, STATE AND FEDERAL DUST CONTROL MEASURES AND REQUIREMENTS AND WILL BE RESPONSIBLE FOR PREPARING AND OBTAINING ALL NECESSARY APPLICATIONS AND APPROVALS.
- THE CONTRACTOR SHALL ENSURE THAT NO SOIL ERODES FROM THE LOTS INTO PUBLIC RIGHT-OF-WAY. THIS CAN BE ACHIEVED BY CONSTRUCTING TEMPORARY BERMS AND WETTING THE SOIL TO KEEP IT FROM BLOWING.
- THE EARTHWORK CONTRACTOR SHALL STOCKPILE ENOUGH MATERIAL ADJACENT TO RETAINING WALL LOCATIONS TO BE UTILIZED FOR WALL BACKFILL.

KEYED NOTES



- TOTAL OF 2 TYPE "A" INLETS PER C.O.A. STANDARD DETAIL #2202.
TOP GRADE = 76.95
INV. EL = 73.95
- TOTAL OF 4 TYPE "C" SINGLE INLETS PER C.O.A. STANDARD DETAIL #2205.
TOP GRADE = 75.83
INV. EL = 72.83
- TOTAL OF 2 TYPE "C" SINGLE INLETS PER C.O.A. STANDARD DETAIL #2205.
TOP GRADE = 74.33
INV. EL = 71.33
- NEW 18" RCP STORM DRAIN PIPE.
- 8" DIAMETER TYPE "C" MANHOLE PER C.O.A. STANDARD DETAIL #2101.
RM EL = 74.50
INV. IN = 71.15
INV. OUT = 71.00
- NEW DETENTION POND WITH CONCRETE BOTTOM AND MAX. WATER SURFACE ELEVATION OF 72.61. PROVIDE FENCE ENCLOSING POND AND GATE WITH LADDER TO BOTTOM.
- NEW ORIFICE PLATE PER DETAIL THIS SHEET.

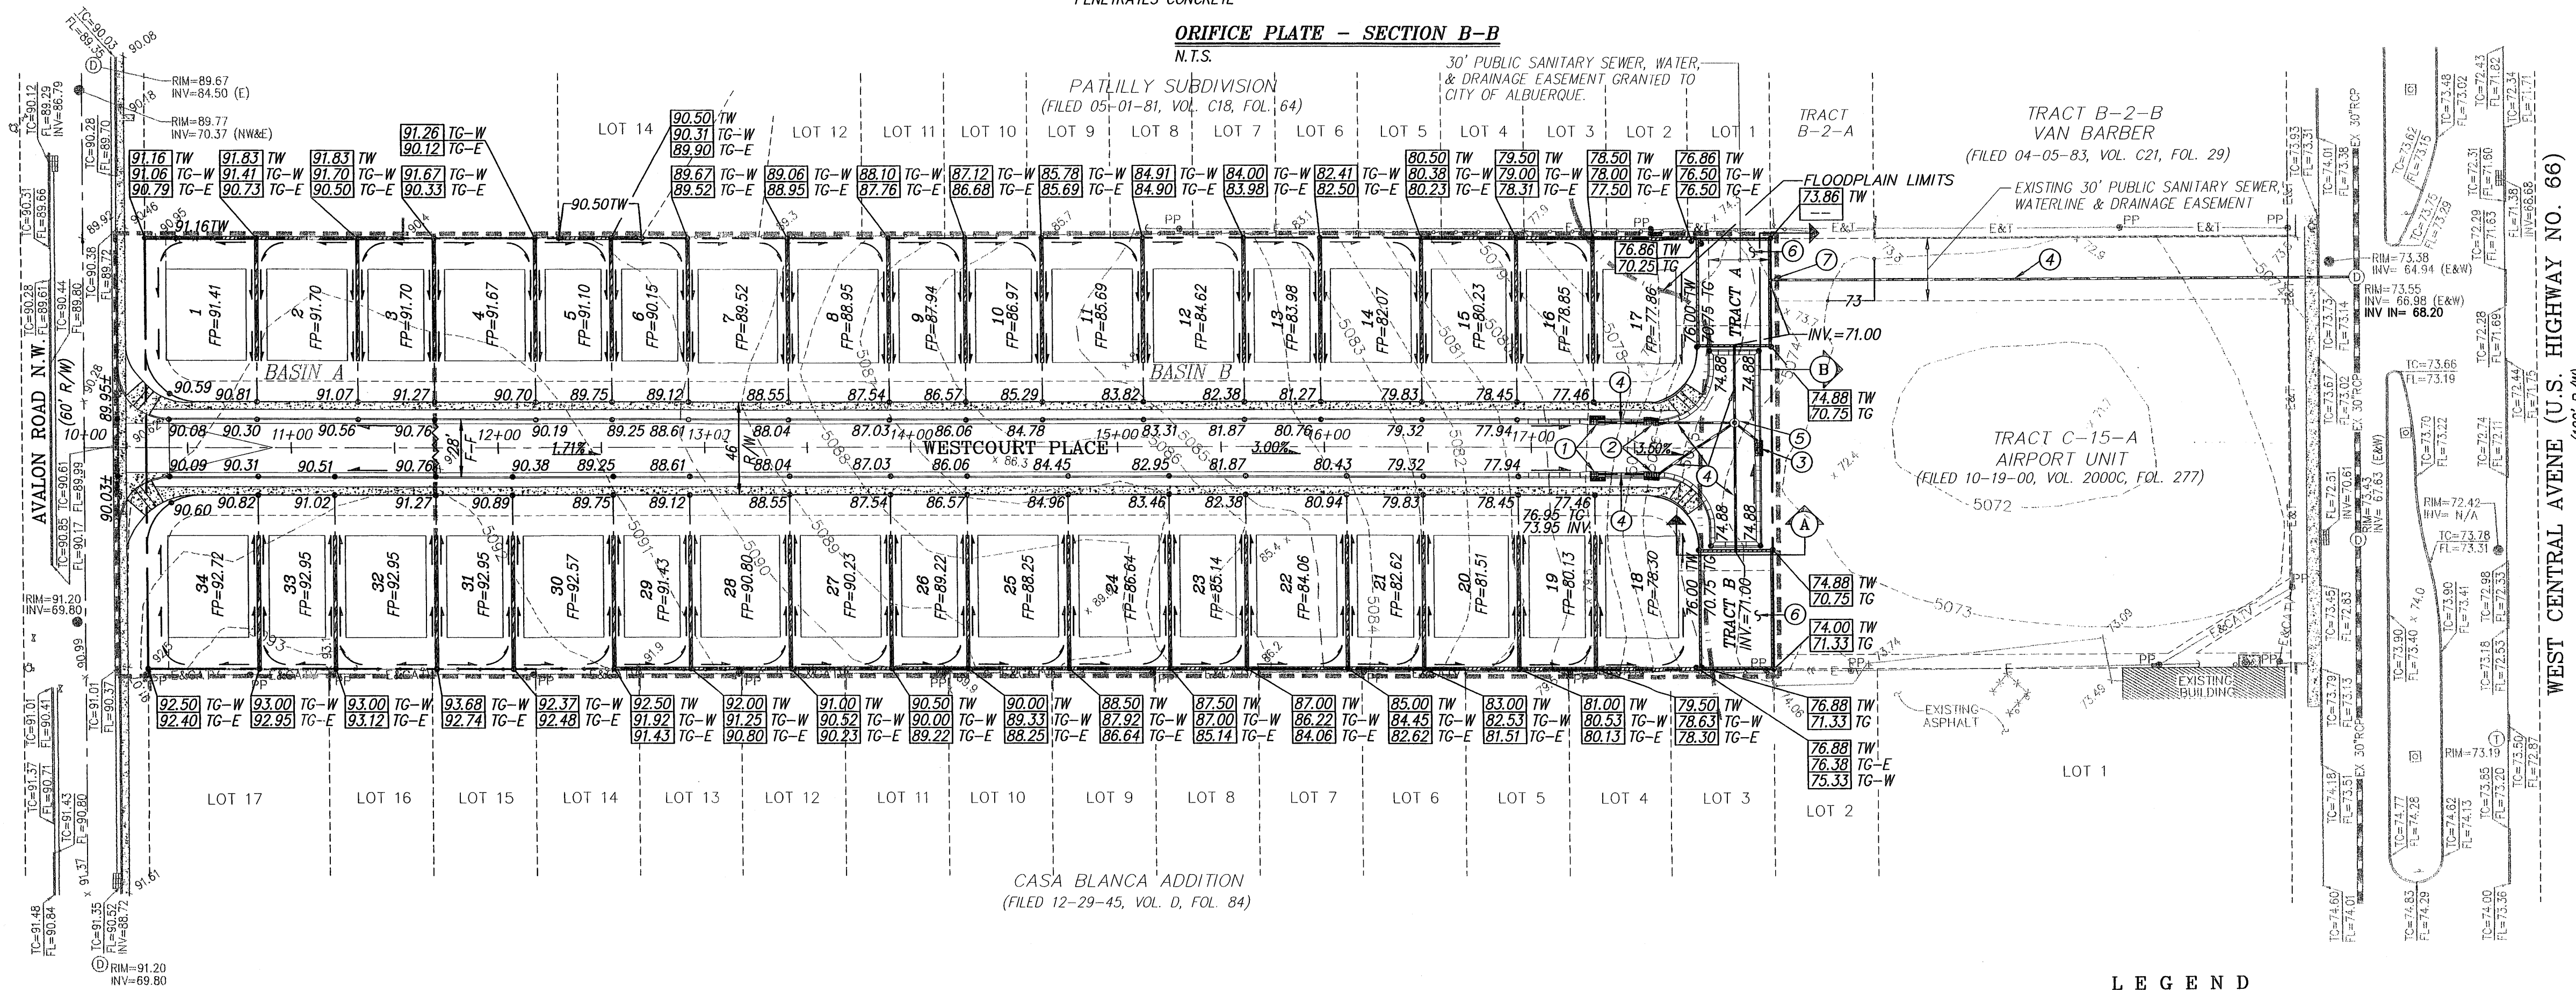


CASA BLANCA ADDITION
(FILED 12-29-45, VOL. 0, FOL. 84)

LEGEND


— MOUNTABLE CURB & GUTTER	— 51.35 — EXISTING CONTOUR MAJOR
— STANDARD 8" CURB & GUTTER	— 51.35 — EXISTING CONTOUR MINOR
FP = 30.38 FINISHED PAD ELEVATION	— EXISTING FIRE HYDRANT
00.00, PROPOSED SPOT ELEVATION	— EXISTING WATER VALVE
— PROPOSED TOP OF WALL ELEVATION	— EXISTING SANITARY SEWER MANHOLE
— PROPOSED TOP GROUND ELEVATION—WEST	— EXISTING STORM DRAIN MANHOLE
— PROPOSED TOP GROUND ELEVATION—EAST	— EXISTING STORM DRAIN INLET
— PROPOSED SLOPE	— EXISTING TOP OF CURB ELEVATION
— FLOODPLAIN LINE	— EXISTING FLOW LINE ELEVATION
— PROPOSED WATER BLOCK	— EXISTING SPOT ELEVATION
— PROPOSED 4' SIDEWALK	— EXISTING OVERHEAD ELECTRIC & CABLE TV LINE
— TRACT/LOT BOUNDARY LINE	— EXISTING POWER POLE
— RIGHT OF WAY LINE	— EXISTING TELEPHONE MANHOLE
— EASEMENT LINE	— EXISTING STREET LIGHT
— FLOW DIRECTION	— EXISTING CHAIN LINK FENCE
— PROPOSED SWALE	— EXISTING WOOD FENCE
— PROPOSED RETAINING WALL	— DRAINAGE BASIN LINE
— PROPOSED STORM DRAIN PIPE	
— PROPOSED STORM DRAIN MANHOLE	
— PROPOSED STORM DRAIN INLET	

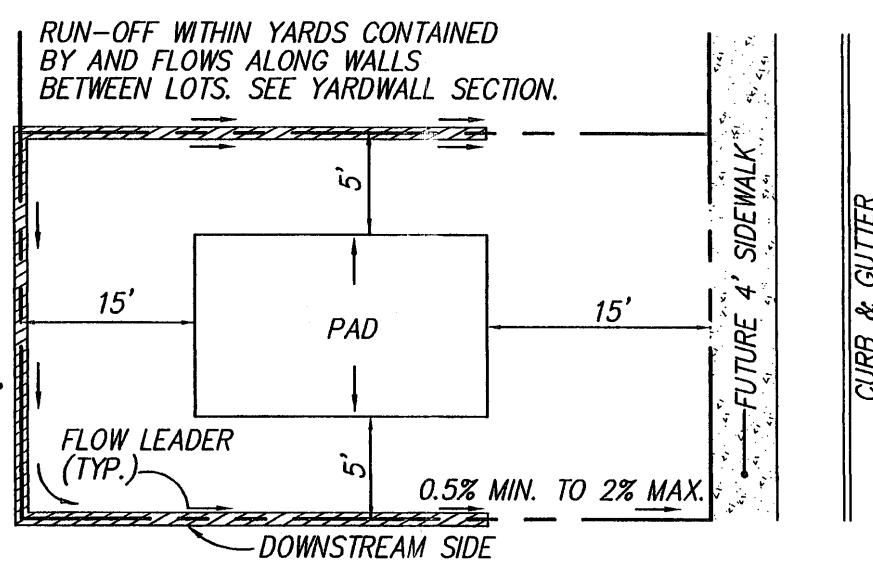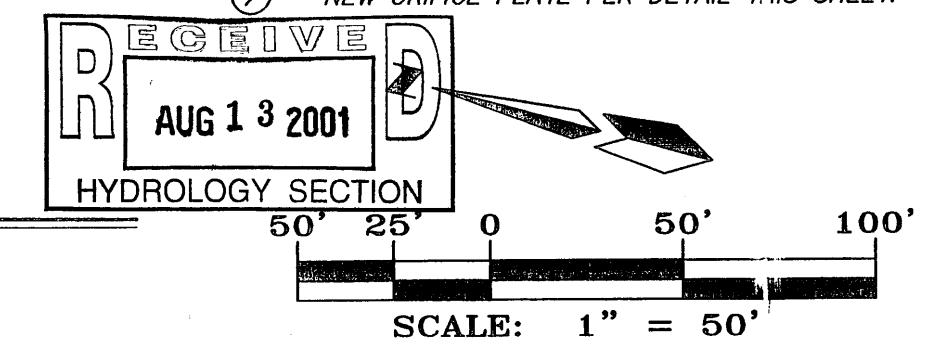

TYPICAL LOT LAYOUT PLAN
N.T.S.

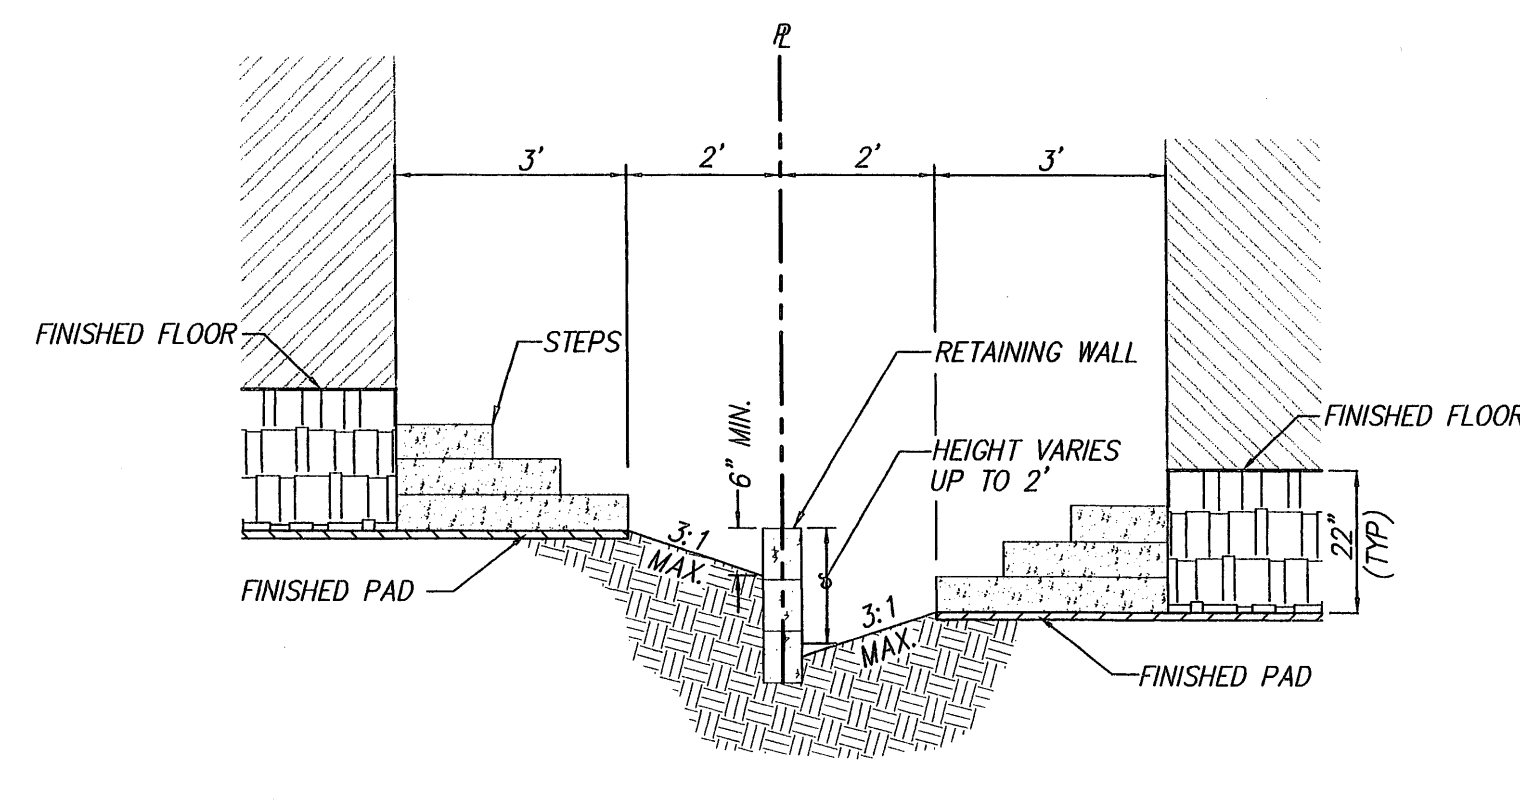

TYPICAL LOT LAYOUT SECTION
N.T.S.

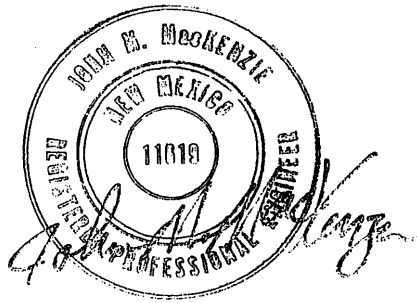

8-9-01

MARK GOODWIN & ASSOCIATES, P.A.
CONSULTING ENGINEERS
P.O. BOX 90606
ALBUQUERQUE, NEW MEXICO 87199
(505) 828-2200, FAX (505) 797-9539

CITY OF ALBUQUERQUE
PUBLIC WORKS DEPARTMENT

TITLE: **St. JOSEPH'S PLACE
GRADING AND DRAINAGE PLAN**

DESIGN REVIEW COMMITTEE	CITY ENGINEER APPROVAL	LAST DESIGN UPDATE	MO./DAY/YR.	MO./DAY/YR.

CITY PROJECT NO. ZONE MAP NO. SHEET OF

K-11-Z

PRELIMINARY PLAT

St. Joseph's Place

SUBDIVISION

WITHIN THE
TOWN OF ATRISCO GRANT
PROJECTED SECTION 23
TOWNSHIP 10, NORTH, RANGE 2 EAST, NMPM
CITY OF ALBUQUERQUE
BERNALILLO COUNTY, NEW MEXICO
MAY, 2001

SUBDIVISION DATA

GROSS ACREAGE 3.7909 Ac
ZONE/ATLAS NO. K-11-Z
NO. OF EXISTING TRACTS 1
NO. OF TRACTS/LOTS CREATED 2 TRACTS/34 LOTS
NO. OF TRACTS ELIMINATED 1
AREA DEDICATED TO CITY OF ALBUQUERQUE 0.8648 AC
DATE OF SURVEY MARCH, 2001

OWNERS

WESTCOR PROPERTIES LLC
11600 ACADEMY N.E.
ALBUQUERQUE, N.M. 87111
(505) 237-9311


ENGINEERS

D. MARK GOODWIN & ASSOCIATES, P.A.
CONSULTING ENGINEERS
P.O. BOX 90606
ALBUQUERQUE, NEW MEXICO 87199
(505) 828-2200

SURVEYOR

ALDRICH LAND SURVEY
P.O. BOX 30701
ALBUQUERQUE, N.M. 87190-0701
(505) 884-1990

OWNER:

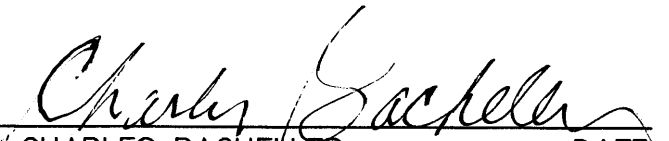
CHARLES BACHEILLER DATE
PRESIDENT OF WESTCOR PROPERTIES LLC.



LOCATION MAP
NOT TO SCALE

APPROVED FOR MONUMENTATION AND STREET NAMES


City Surveyor, City of Albuquerque, N.M. 5-22-01 Date

PURPOSE OF PLAT


1. SUBDIVIDE ONE TRACT INTO 34 RESIDENTIAL LOTS AND 2 TRACTS
2. DEDICATED RIGHT-OF-WAY AS SHOWN
3. GRANT NEW EASEMENTS AS SHOWN

LEGAL DESCRIPTION

A tract of land situate within the Town of Atrisco Grant, projected Section 23, Township 10 North, Range 2 East, New Mexico Principal Meridian, City of Albuquerque, Bernalillo County, New Mexico being all of Tract C-15-B, Airport unit filed in the office of the Bernalillo County Clerk on October 19, 2000, Volume 200C, Folio 277, and containing 3.7909 acres more or less.

NOTES

1. UNLESS OTHERWISE NOTED ALL POINTS ARE "SET 5/8" REBAR WITH CAP "ALS LS 7719".
2. ALL STREET CENTERLINE MONUMENTATION SHALL BE INSTALLED AT ALL CENTERLINE PC'S, PT'S, ANGLE POINTS, AND STREET INTERSECTIONS AND SHOWN THUS ▲, WILL BE MARKED BY A FOUR INCH (4") ALUMINUM CAP STAMPED:
"CITY OF ALBUQUERQUE CENTERLINE MONUMENTATION"
"DO NOT DISTURB"
"PLS # 7719".
3. BOUNDARY SHALL BE TIED TO THE NEW MEXICO STATE PLANE COORDINATE SYSTEM AS SHOWN.
4. BASIS OF BEARING SHALL BE NEW MEXICO STATE PLANE GRID BEARINGS.
5. ALL DISTANCES SHALL BE GROUND DISTANCES.
6. MANHOLES WILL BE OFFSET AT ALL POINTS OF CURVATURE, POINTS OF TANGENCY, STREET INTERSECTIONS, AND ALL OTHER ANGLE POINTS TO ALLOW USE OF CENTERLINE MONUMENTATION.
7. TRACTS "A" AND "B" ARE TO BE DEEDED AS JOINT USE RECREATIONAL AREAS TO THE HOME OWNER'S ASSOCIATION AND MAINTAINED BY THE HOME OWNER'S ASSOCIATION.


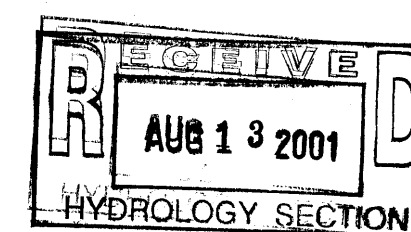


Dwg:	A01024SHT1	Drawn:	SPS	Checked:	ALS	Sheet	1 of 3
Scale:	AS SHOWN	Date:	05/01/01	Job:	A01024		

PRELIMINARY PLAT
St. Joseph's Place
SUBDIVISION
 WITHIN THE
 TOWN OF ATRISCO GRANT
 PROJECTED SECTION 23
 TOWNSHIP 10 NORTH, RANGE 2 EAST, NMPM
 CITY OF ALBUQUERQUE
 BERNALILLO COUNTY, NEW MEXICO
 MAY, 2001

EXISTING EASEMENTS

- ① 7' PUE
(10-19-00, 000C-277)
- ② 20' SEWER, WATER AND DRAINAGE EASEMENT
(10-19-00, 000C-277)
- ③ 30' PUBLIC SEWER, WATER AND DRAINAGE EASEMENT
(01-18-01, A14-3887)

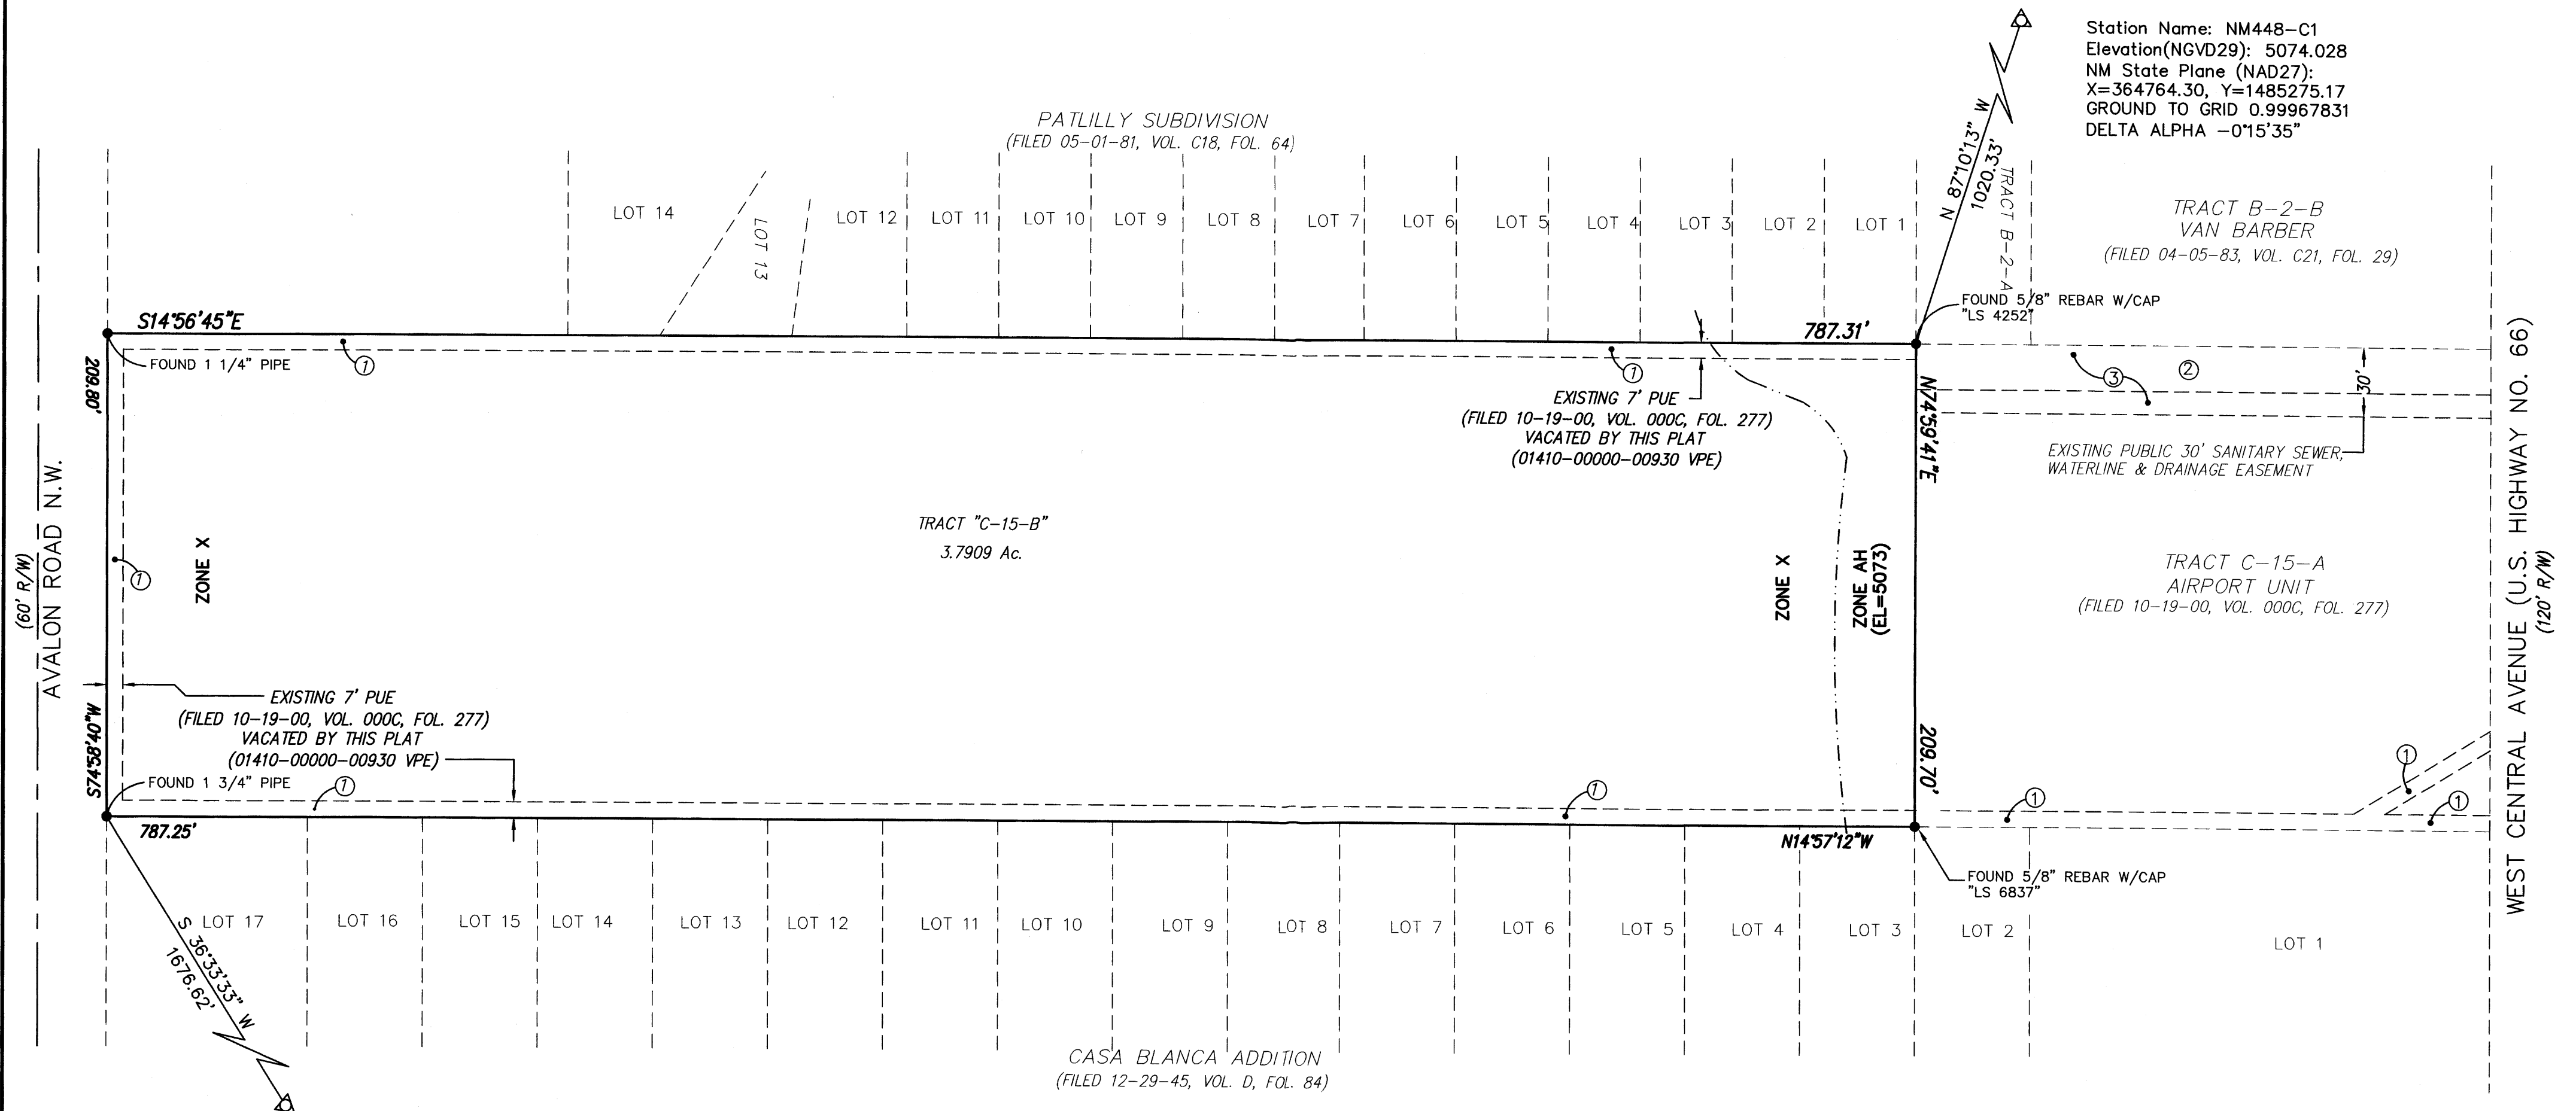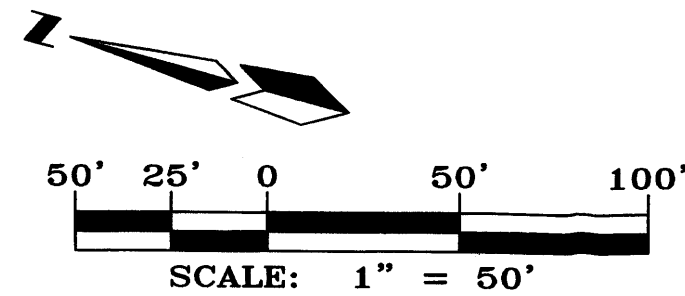


Dwg: A01024SHT2	Drawn: SPS	Checked: ALS	Sheet 2 of 3
Scale: 1"=50'	Date: 05/22/01	Job: A01024	


NOTE:

- ALL STREETS SHOWN HEREON ARE HEREBY DEDICATED AS PUBLIC RIGHT-OF-WAY.
- AT THE TIME OF INDIVIDUAL BUILDING PERMIT APPLICATION, THE APPLICANT SHALL BE REQUIRED TO DEMONSTRATE THAT THERE EXISTS AT LEAST 600 S.F. OF OPEN SPACE ON EACH LOT. DEFICIENCIES IN OPEN SPACE MAY BE COMPENSATED FOR ACCORDING TO SECTION 14-16-3-8A OF THE ZONING CODE
- TRACTS A AND B ARE ENCUMBERED BY A BLANKET DRAINAGE EASEMENT FOR THE PURPOSE OF STORM WATER DETENTION. THE EASEMENT SHALL REMAIN UNTIL EXISTING DOWNSTREAM PUBLIC DRAINAGE CAPACITY IS INCREASED AT WHICH TIME THE TRACTS MAY BE RECLAIMED, SUBJECT TO C.O.A. HYDROLOGY DIVISION APPROVAL.
- AN "AH" FLOOD ZONE (ELEV. 5073) EXISTS AT THE FAR SOUTH END OF THE SUBDIVISION. FLOOD INSURANCE MAY BE REQUIRED FOR HOMEOWNERS AFFECTED BY THIS FLOOD ZONE, UNTIL SUCH TIME THAT A LOMR IS OBTAINED.
- CENTERLINE (IN LIEU OF R/W) MONUMENTATION IS TO BE INSTALLED AT ALL CENTERLINE PC'S, PT'S, ANGLE POINTS AND STREET INTERSECTIONS AS SHOWN HEREON, AND WILL CONSIST OF A FOUR INCH (4") ALUMINUM ALLOY CAP STAMPED "CITY OF ALBUQUERQUE", "CENTERLINE MONUMENT", "DO NOT DISTURB", "PLS # 7719".

CURVE TABLE						
CURVE	LENGTH	RADIUS	DELTA	TANGENT	CH-BEARING=	CH-DIST=
C1	39.30	25.00	90°04'35"	25.03	N59°59'03"W	35.38
C2	37.34	25.00	85°34'25"	23.14	S27°50'27"W	33.96
C3	39.30	25.00	90°03'34"	25.03	S59°58'32"E	35.37
C4	39.24	25.00	89°56'26"	24.97	N30°01'28"E	35.34

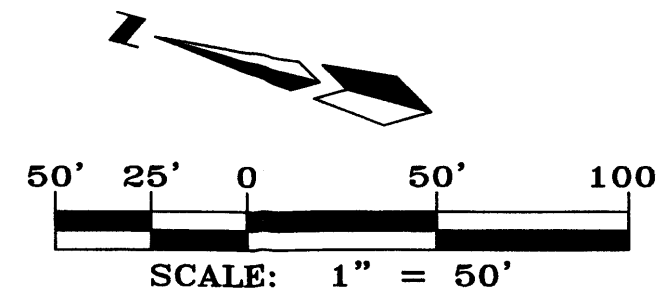




PRELIMINARY PLAT
St. Joseph's Place
SUBDIVISION
 WITHIN THE
 TOWN OF ATRISCO GRANT
 PROJECTED SECTION 23
 TOWNSHIP 10 NORTH, RANGE 2 EAST, NMPM
 CITY OF ALBUQUERQUE
 BERNALILLO COUNTY, NEW MEXICO
 APRIL, 2001

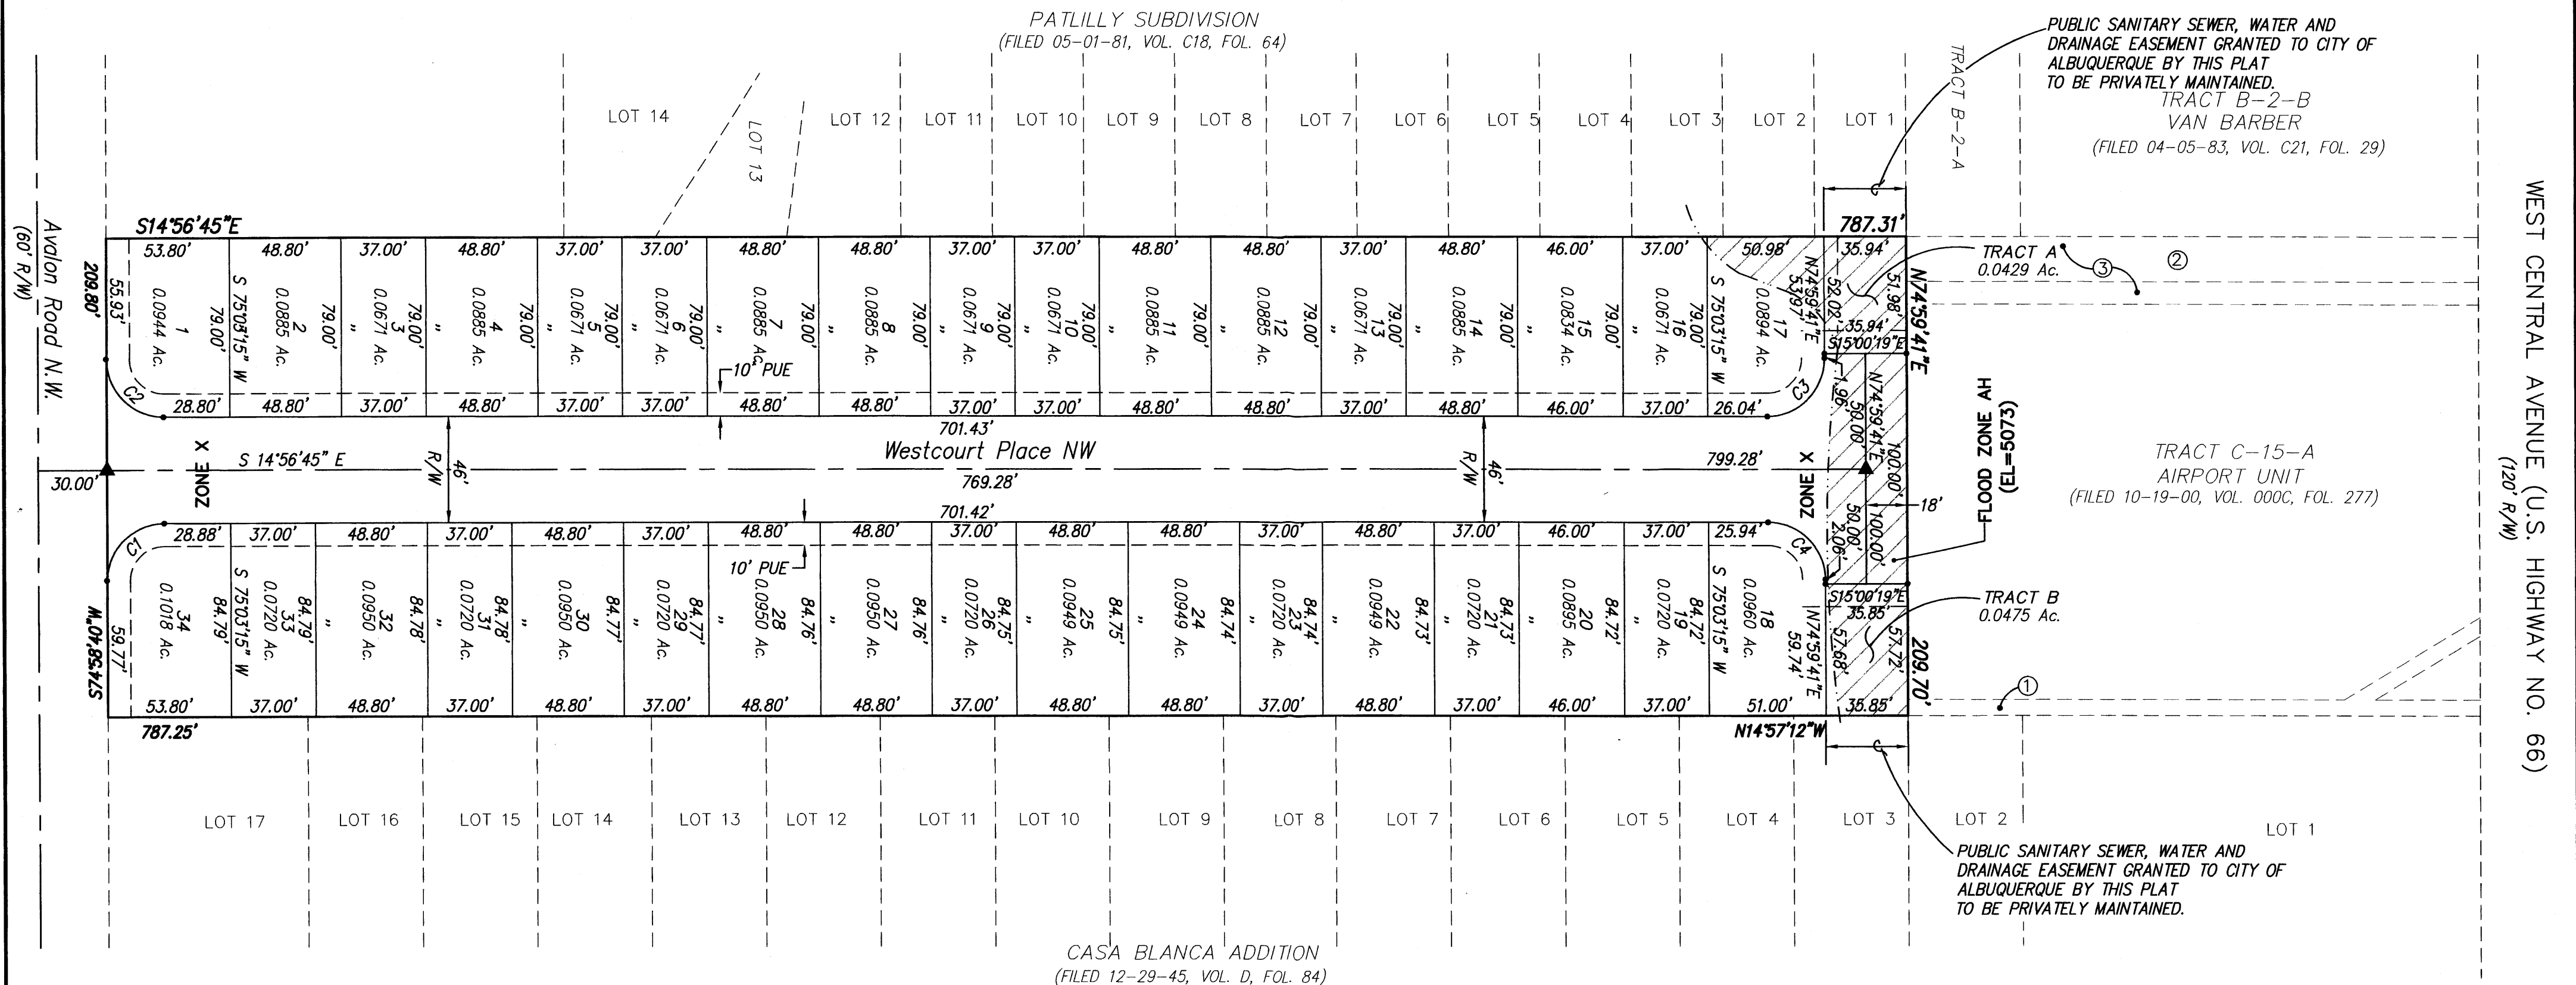

EXISTING EASEMENTS

- 7' PUE
(10-19-00, 000C-277)
- 20' SEWER, WATER AND DRAINAGE EASEMENT
(10-19-00, 000C-277)
- 30' PUBLIC SEWER, WATER AND DRAINAGE EASEMENT
(01-18-01, A14-3887)

Dwg: A01024SHT3	Drawn: SPS	Checked: ALS	Sheet 3 of 3
Scale: 1"=50'	Date: 06/28/01	Job: A01024	

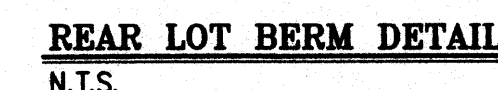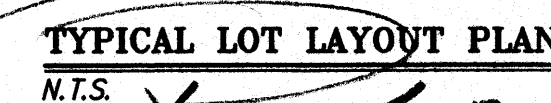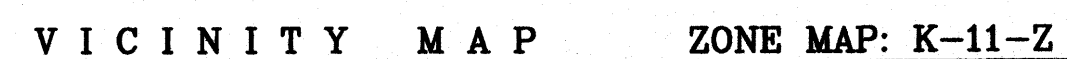

- ① TOTAL OF 2 TYPE "A" INLETS PER C.O.A. STANDARD
DETAIL #2202.
TOP GRATE = 76.95
INV. EL = 73.95
- ② TOTAL OF 4 TYPE "C" SINGLE INLETS PER C.O.A.
STANDARD DETAIL #2205.
TOP GRATE = 75.83
INV. EL = 72.83
- ③ TOTAL OF 2 TYPE "C" SINGLE INLETS PER C.O.A.
STANDARD DETAIL #2205.
TOP GRATE = 74.33
INV. EL = 71.33
- ④ NEW 18" RCP STORM DRAIN PIPE.
- ⑤ 8" DIAMETER TYPE "C" MANHOLE PER C.O.A.
STANDARD DETAIL #2101.
RIM EL = 74.50
INV. IN = 71.15
INV. OUT = 71.00
- ⑥ NEW DETENTION POND WITH 4'-6" RIP-RAP
IN BOTTOM AND MAX. WATER SURFACE ELEVATION
OF 72.61. BOTTOM POND = 70.75
- ⑦ NEW ORIFICE PLATE PER DETAIL THIS SHEET.



- ### EROSION CONTROL NOTES
1. CONTRACTOR IS RESPONSIBLE FOR OBTAINING A TOPSOIL DISTURBANCE PERMIT PRIOR TO BEGINNING WORK.
 2. CONTRACTOR IS RESPONSIBLE FOR KEEPING ALL SEDIMENT OUT OF EXISTING RIGHT-OF-WAY.
 3. CONTRACTOR IS RESPONSIBLE FOR CLEANING UP ANY SEDIMENT THAT GETS INTO EXISTING RIGHT-OF-WAY.
 4. EROSION CONTROL SWALES ARE REQUIRED AROUND THE ENTIRE SITE.
 5. ALL EROSION CONTROL SWALES MUST BE IN PLACE AND ENGINEER CERTIFIED PRIOR TO BUILDING PERMIT RELEASE.
 6. SWALES TO BE BLOCKED AT EACH PROPERTY LINE.

SURVEY INFORMATION		BENCH MARKS		AS BUILT INFORMATION	
FIELD NOTES					
NO.	BY	DATE		CONTRACTOR	
				WORK NO. BY	DATE
				INSPECTOR'S ACCEPTANCE BY	DATE
				VERIFICATION BY	DATE
				DRAWINGS CONTROLLED BY	DATE
				MICRO-FILM INFORMATION	
				RECORDED BY	DATE
				NO.	

A circular stamp from the Mexican Secretariat of the Interior (SE). The outer ring contains the text "SECRETARÍA DE INTERIOR" at the top and "ESTADOS UNIDOS MEXICANOS" at the bottom. In the center, the number "10448" is stamped. To the right of the center, the date "10/11/1961" is handwritten. There are also some illegible handwritten marks on the right side of the stamp.[illegible]



CITY OF ALBUQUERQUE

PUBLIC WORKS DEPARTMENT

TITLE:

St. JOSEPH'S PLACE

GRADING AND DRAINAGE PLAN

DESIGN REVIEW COMMITTEE	CITY ENGINEER APPROVAL	LAST DESIGN UPDATE	MO./DAY/YR.	MO./DAY/YR.

CITY PROJECT NO.

ZONE MAP NO.

K-11-Z

SHEET OF