

CITY OF ALBUQUERQUE



Richard J. Berry, Mayor

May 12, 2017

Ron Rieger
Area Construction Manager- New Mexico
LGI Homes
Albuquerque, NM

**RE: Sunset Farms / Puesta Del Sol
205 Anna Maria Place SW
Engineer's Certification Dated 5/11/17
Hydrology File: K12D025**

Dear Mr. Rieger:

PO Box 1293

Based upon the information provided in your Certification received 5/12/17, the above referenced Certification is acceptable for Building Pad Certification for Lot 3A1-P1.

Albuquerque

As a reminder once this lot is ready for Hydrology approval for Certificate of Occupancy, please submit the Drainage Info Sheet along with the Engineering Certification from Mark Goodwin & Associates, P.A. for the as-built grading.

New Mexico 87103

If you have any questions, please contact me at 924-3995 or rbrissette@cabq.gov.

Sincerely,

www.cabq.gov

Renee C. Brissette

Reneé C. Brissette, P.E.
Senior Engineer, Hydrology
Planning Department



City of Albuquerque

Planning Department

Development & Building Services Division

DRAINAGE AND TRANSPORTATION INFORMATION SHEET (REV 09/2015)

Project Title: _____ **Building Permit #:** _____ **City Drainage #:** _____

DRB#: _____ **EPC#:** _____ **Work Order#:** _____

Legal Description: _____

City Address: _____

Engineering Firm: _____ **Contact:** _____

Address: _____

Phone#: _____ **Fax#:** _____ **E-mail:** _____

Owner: _____ **Contact:** _____

Address: _____

Phone#: _____ **Fax#:** _____ **E-mail:** _____

Architect: _____ **Contact:** _____

Address: _____

Phone#: _____ **Fax#:** _____ **E-mail:** _____

Other Contact: _____ **Contact:** _____

Address: _____

Phone#: _____ **Fax#:** _____ **E-mail:** _____

Check all that Apply:

DEPARTMENT:

- ☐ HYDROLOGY/ DRAINAGE
☐ TRAFFIC/ TRANSPORTATION
☐ MS4/ EROSION & SEDIMENT CONTROL

TYPE OF SUBMITTAL:

- ☐ ENGINEER/ ARCHITECT CERTIFICATION
- ☐ CONCEPTUAL G & D PLAN
☐ GRADING PLAN
☐ DRAINAGE MASTER PLAN
☐ DRAINAGE REPORT
☐ CLOMR/LOMR
- ☐ TRAFFIC CIRCULATION LAYOUT (TCL)
☐ TRAFFIC IMPACT STUDY (TIS)
☐ EROSION & SEDIMENT CONTROL PLAN (ESC)
- ☐ OTHER (SPECIFY) _____

CHECK TYPE OF APPROVAL/ACCEPTANCE SOUGHT:

- ☐ BUILDING PERMIT APPROVAL
☐ CERTIFICATE OF OCCUPANCY
- ☐ PRELIMINARY PLAT APPROVAL
☐ SITE PLAN FOR SUB'D APPROVAL
☐ SITE PLAN FOR BLDG. PERMIT APPROVAL
☐ FINAL PLAT APPROVAL
☐ SIA/ RELEASE OF FINANCIAL GUARANTEE
☐ FOUNDATION PERMIT APPROVAL
☐ GRADING PERMIT APPROVAL
☐ SO-19 APPROVAL
☐ PAVING PERMIT APPROVAL
☐ GRADING/ PAD CERTIFICATION
☐ WORK ORDER APPROVAL
☐ CLOMR/LOMR
- ☐ PRE-DESIGN MEETING
☐ OTHER (SPECIFY) _____

IS THIS A RESUBMITTAL?: ☐ Yes ☐ No

DATE SUBMITTED: _____ **By:** _____

COA STAFF: _____ ELECTRONIC SUBMITTAL RECEIVED: _____

LGI HOMES
9150 E DEL CAMINO DRIVE, SUITE 118
SCOTTSDALE, AZ 85258

MARK GOODWIN & ASSOCIATES, P.A.
CONSULTING ENGINEERS
P.O. BOX 90606
ALBUQUERQUE, NEW MEXICO 87199
OFFICE (505) 828-2200, FAX (505) 797-9539

① $\Delta = 10.46'28"$
 $L = 18.24$
 $R = 97.00$
 $Tan = 9.15$

ANNA MARIA PLACE SW

LOT 3A1-P1
SUNSET FARM/ PUESTA DEL SOL
SUBDIVISION
205 ANNA MARIA PLACE SW
AREA=6480 SF

PAD CERTIFICATION


- NOTE:
1. THERE SHALL BE A DISTANCE OF NOT LESS THAN TEN (10) FEET BETWEEN RESIDENTIAL BUILDINGS.
 2. PROVIDE 18' WIDE DRIVEWAY.
 3. 4' SIDEWALK TO BE CONSTRUCTED WITH THIS PERMIT.
 4. NO PART OF THIS STRUCTURE WILL BE CLOSER THAN 20' FROM FRONT OF PROPERTY LINE.
 5. POND AS REQUIRED BY THE CITY OF ALBUQUERQUE
 6. NO CURBS OR CURB CUTS IN SUBDIVISION

I, MARK GOODWIN, NMPE 8948, OF THE FIRM MARK GOODWIN & ASSOCIATES, P.A. HEREBY CERTIFY THAT THIS PROJECT HAS BEEN GRADED AND WILL DRAIN IN ACCORDANCE WITH THE DESIGN INTENT OF THE APPROVED PLAN. THE RECORD INFORMATION EDITED ONTO THE ORIGINAL DESIGN DOCUMENT HAS BEEN OBTAINED BY RUSS HUGG NMPS 9750 OF THE FIRM SURBY-TEK. I FURTHER CERTIFY THAT I OR OTHERS UNDER MY DIRECT SUPERVISION HAVE PERSONALLY VISITED THE PROJECT SITE ON 5/10/2017 AND HAVE DETERMINED BY VISUAL INSPECTION THAT THE SURVEY DATA PROVIDED IS REPRESENTATIVE OF ACTUAL SITE CONDITIONS AND IS TRUE AND CORRECT TO THE BEST OF MY KNOWLEDGE AND BELIEF. THIS CERTIFICATION IS SUBMITTED IN SUPPORT OF A REQUEST FOR PAD CERTIFICATION FOR BUILDING PERMIT RELEASE. THE RECORD INFORMATION PRESENTED HEREON IS NOT NECESSARILY COMPLETE AND INTENDED ONLY TO VERIFY SUBSTANTIAL COMPLIANCE OF THE GRADING AND DRAINAGE ASPECTS OF THIS PROJECT. THOSE RELYING ON THE RECORD DOCUMENT ARE ADVISED TO OBTAIN INDEPENDENT VERIFICATION OF THIS ACCURACY BEFORE USING IT FOR ANY OTHER PURPOSE.

MARK GOODWIN NMPE 8948 5/11/17




SCALE: 1" = 20'

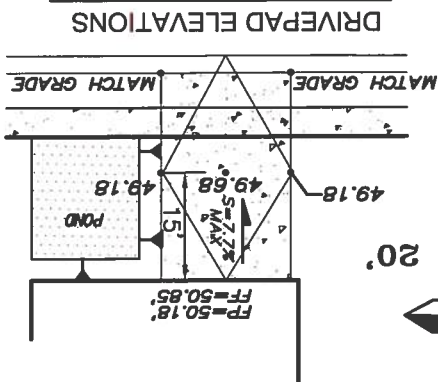

LEGEND

- CABLE TV
- TELEPHONE
- TRANSFORMER
- RETAINING WALL
- BUILDING SETBACK
- NEW SPOT ELEVATIONS
- EXISTING ELEVATIONS

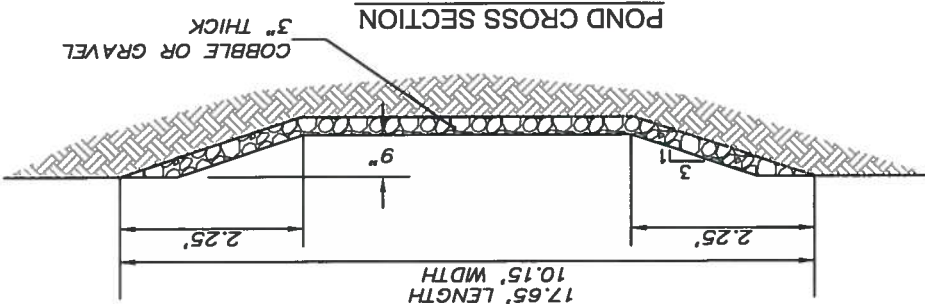

POND CROSS SECTION
VOLUME REQUIRED= 116 cf
DEPTH = 9" SIDE SLOPES 3:1
POND BOTTOM: AREA = 75.0 SF @ ELEVATION=48.55'
POND TOP: AREA = 180 SF @ ELEVATION=49.30'
VOLUME PROVIDED = 123 CF

