
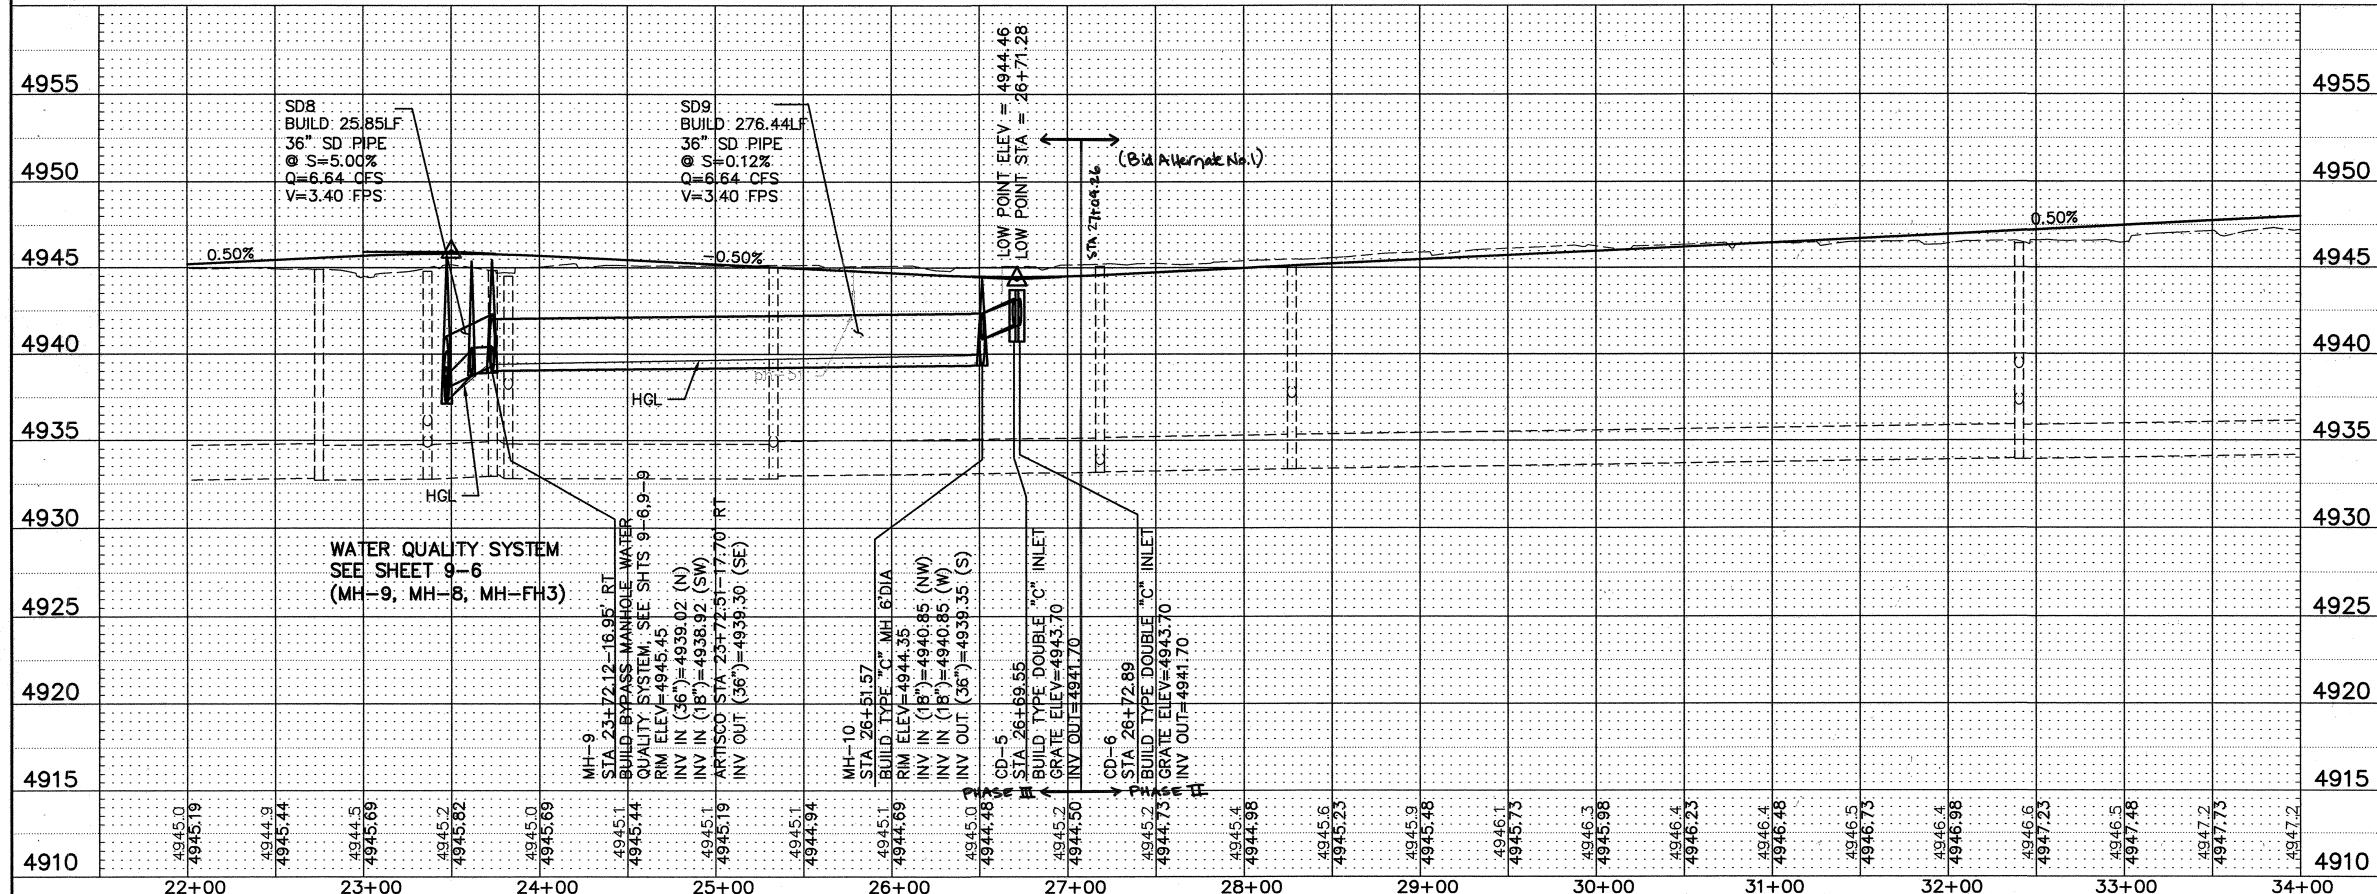


X:\Public\PROJECTS\96068-01\T\Sect9\subasedwg 8/17/2005 2:25:20 PM MDT

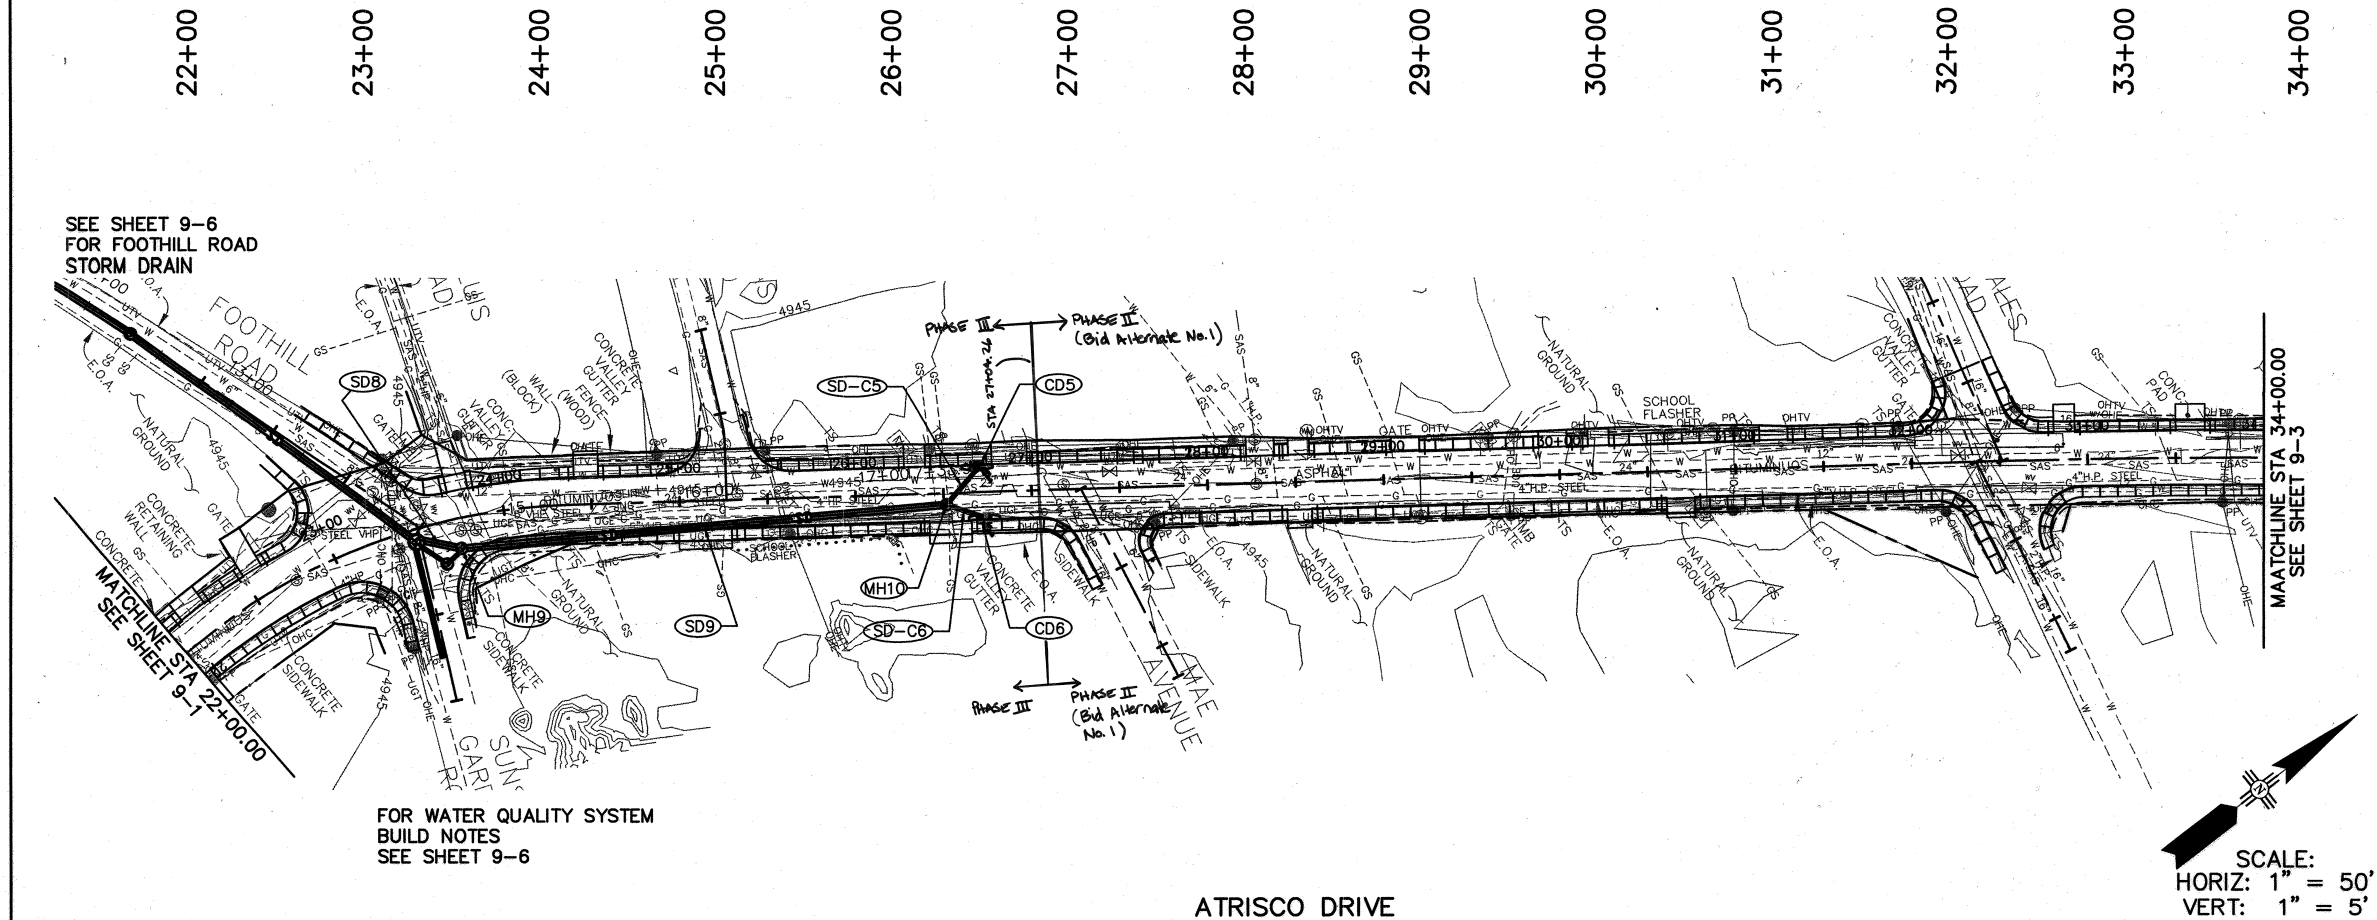

CONSTRUCTION BUILD NOTES
CONCRETE DROP INLET

(CD5) STA 26+69.55-15.50' LT
BUILD TYPE DOUBLE "C" INLET
GRATE ELEV=4943.70
INV OUT=4941.70

(CD6) STA 26+72.89-15.50' RT
BUILD TYPE DOUBLE "C" INLET
GRATE ELEV=4943.70
INV OUT=4941.70

CONSTRUCTION BUILD NOTES
STORM DRAIN MANHOLE

(MH10) STA 26+51.57-6.57' RT
BUILD TYPE "C" MANHOLE 6' DIA
SEE COA STD DWG 2101
RIM ELEV=4944.35
INV IN (18")=4940.85 (NW)
INV IN (18")=4940.85 (W)
INV OUT (36")=4939.35 (S)

(MH-FH3) ARTISCO STA 23+61.87-29.54' RT
FOOTHILL STA 14+53.10-15.21' RT
BUILD TYPE "C" MANHOLE 4' DIA
SEE COA STD DWG 2101
RIM ELEV=4945.22
INV IN (18")=4938.13 (E)
INV OUT (18")=4938.03 (SW)

(MH-9) ARTISCO STA 23+72.12-16.95' RT
BUILD BYPASS MANHOLE WATER QUALITY
SEE SHEET 9-9
RIM ELEV=4945.45
INV IN (36")=4939.02 (N)
INV OUT (18")=4938.92 (SW)
ARTISCO STA 23+72.51-17.70' RT
INV OUT (36")=4939.30 (SE)

CONSTRUCTION BUILD NOTES
STORM DRAIN PIPE

(SD8) BUILD 25.85LF OF 36" SD PIPE
@ S=5.00%

(SD9) BUILD 276.44LF OF 36" SD PIPE
@ S=0.12%

(SD-C5) BUILD 26.93LF OF 18" SD PIPE
@ S=3.16%

(SD-C6) BUILD 21.07LF OF 18" SD PIPE
@ S=4.03%

Notice Of Extended Payment Provision


This Contract allows the Owner to make payment within 45 days after submission of an undisputed request for payment.

CITY OF ALBUQUERQUE PUBLIC WORKS DEPARTMENT ENGINEERING GROUP	
ATRISCO DRIVE CORRIDOR IMPROVEMENTS STORM DRAIN PLAN & PROFILE	
Design Review Committee	City Engineer Approval
City Project No. COA 5337-02	Zone Map No. K-12
Sheet 9-2	Of

WILSON
& COMPANY

Sheet 56 of 67

47/53

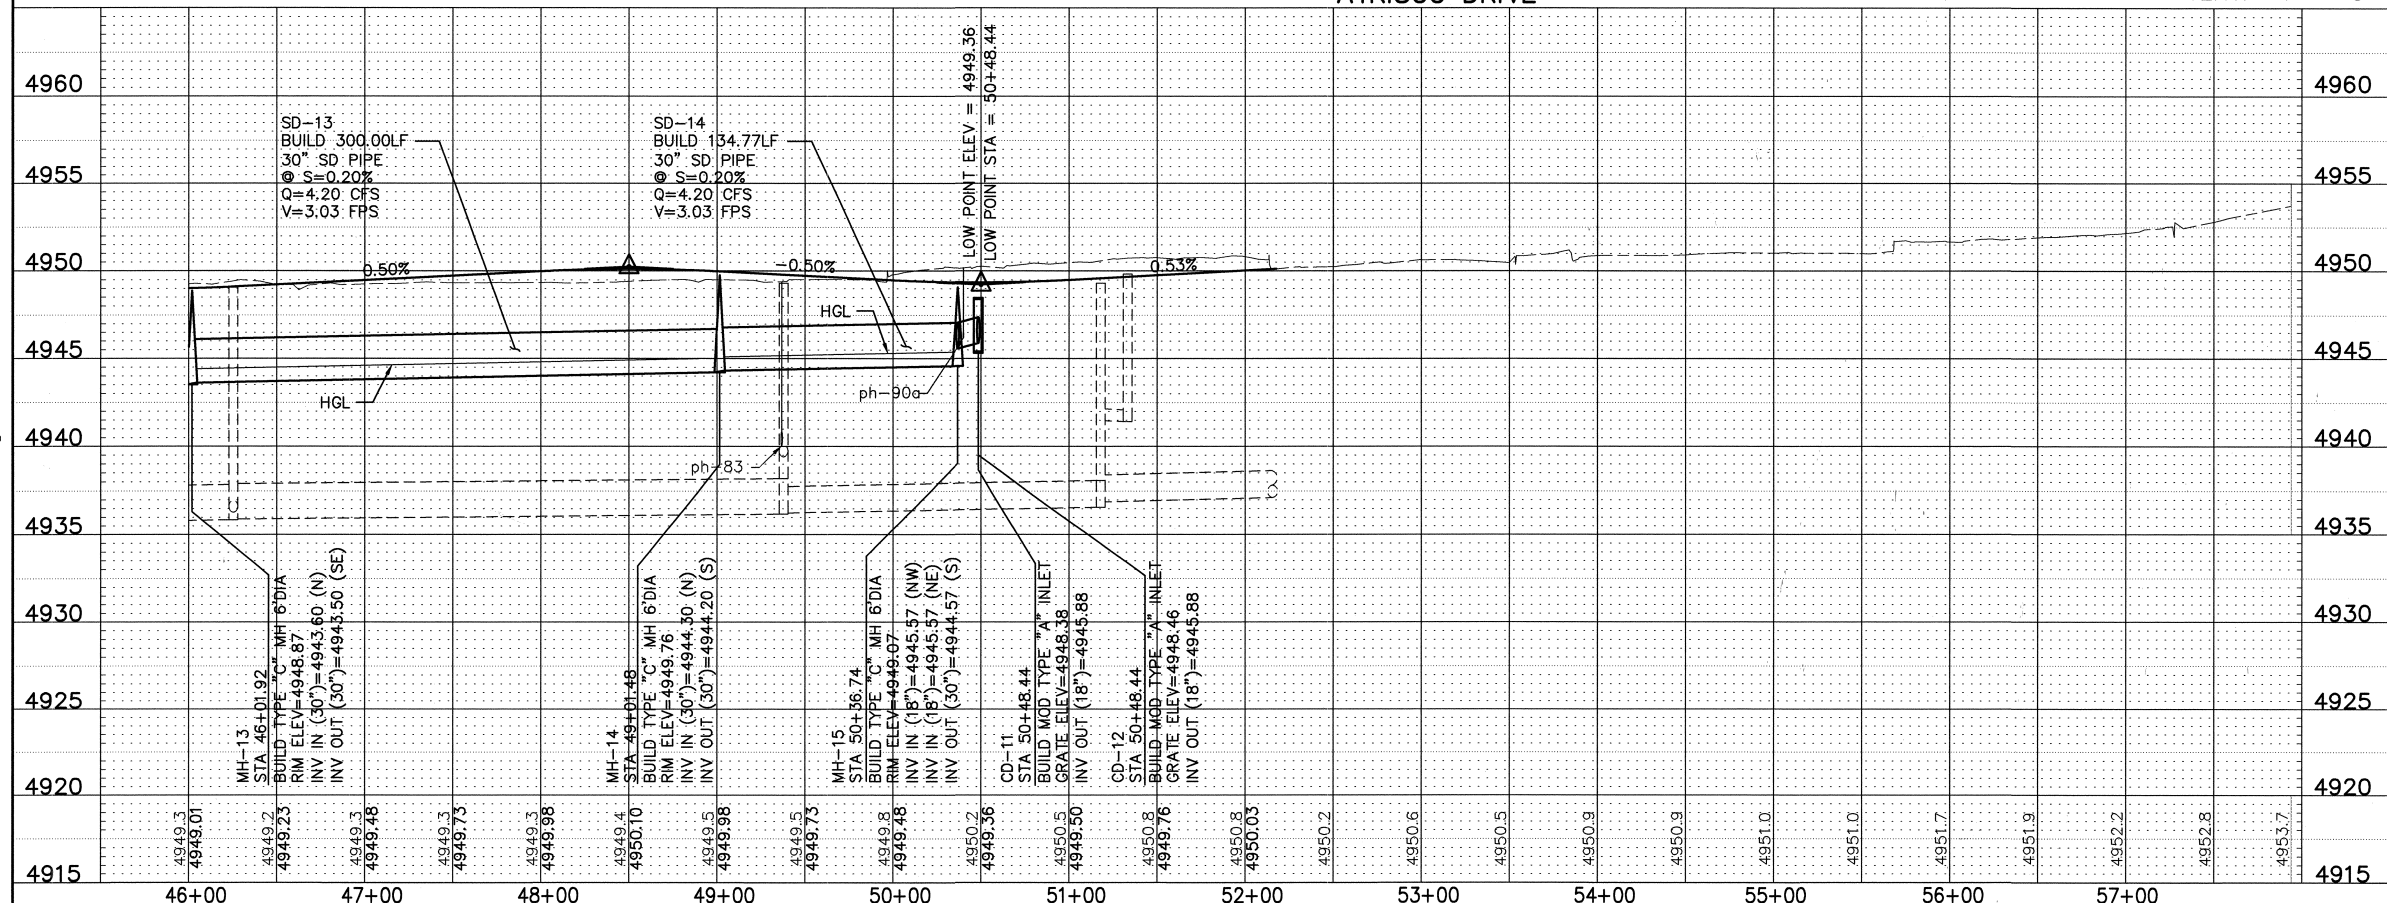

ATRISCO DRIVE

RECORD DRAWING
DATE: 07/13/09

SCALE:
HORIZ: 1" = 50'
VERT: 1" = 5'

CONSTRUCTION BUILD NOTES
CONCRETE DROP INLET

- (CD11) STA 50+48.44-32.98' LT
BUILD MODIFIED TYPE "A" INLET
GRATE ELEV=4948.38
INV OUT (18")=4945.88
- (CD12) STA 50+48.44-28.86' RT
BUILD MODIFIED TYPE "A" INLET
GRATE ELEV=4948.46
INV OUT (18")=4945.88

CONSTRUCTION BUILD NOTES
STORM DRAIN MANHOLE

- (MH13) STA 46+01.92-7.00' LT
BUILD TYPE "C" MANHOLE 6' DIA
SEE COA STD DWG 2101
RIM ELEV=4948.87
INV IN (30")=4943.60 (N)
INV OUT (30")= 4943.50 (SE)
- (MH14) STA 49+01.48-10.34' LT
BUILD TYPE "C" MANHOLE 6' DIA
SEE COA STD DWG 2101
RIM ELEV=4949.76
INV IN (30")=4944.30 (N)
INV OUT (30")= 4944.20 (S)
- (MH15) STA 50+36.74-15.23' LT
BUILD TYPE "C" MANHOLE 6' DIA
SEE COA STD DWG 2101
RIM ELEV=4949.07
INV IN (18")=4945.57 (NW)
INV IN (18")=4945.57 (NE)
INV OUT (30")= 4944.57 (S)

CONSTRUCTION BUILD NOTES
STORM DRAIN PIPE

- (SD13) BUILD 300.00LF OF 30" SD PIPE
@ S=0.20%
- (SD14) BUILD 134.77LF OF 30" SD PIPE
@ S=0.20%
- (SD-C11) BUILD 19.39LF OF 18" SD PIPE
@ S=1.60%
- (SD-C12) BUILD 43.74LF OF 18" SD PIPE
@ S=0.71%

Notice Of Extended Payment Provision
This Contract allows the Owner to make payment within 45 days after submission of an undisputed request for payment.


CITY OF ALBUQUERQUE
PUBLIC WORKS DEPARTMENT
ENGINEERING GROUP
ATRISCO DRIVE CORRIDOR IMPROVEMENTS
STORM DRAIN PLAN & PROFILE

Design Review Committee	City Engineer Approval	Last Design Update	Mo./Day/Yr.	Mo./Day/Yr.


City Project No. COA 5337-02 Zone Map No. K-12 Sheet 9-4 Of

WILSON
& COMPANY

X:\Public\PROJECTS\96068-01\T\Sect9\waterline.dwg 8/17/2005 2:24:34 PM MDT

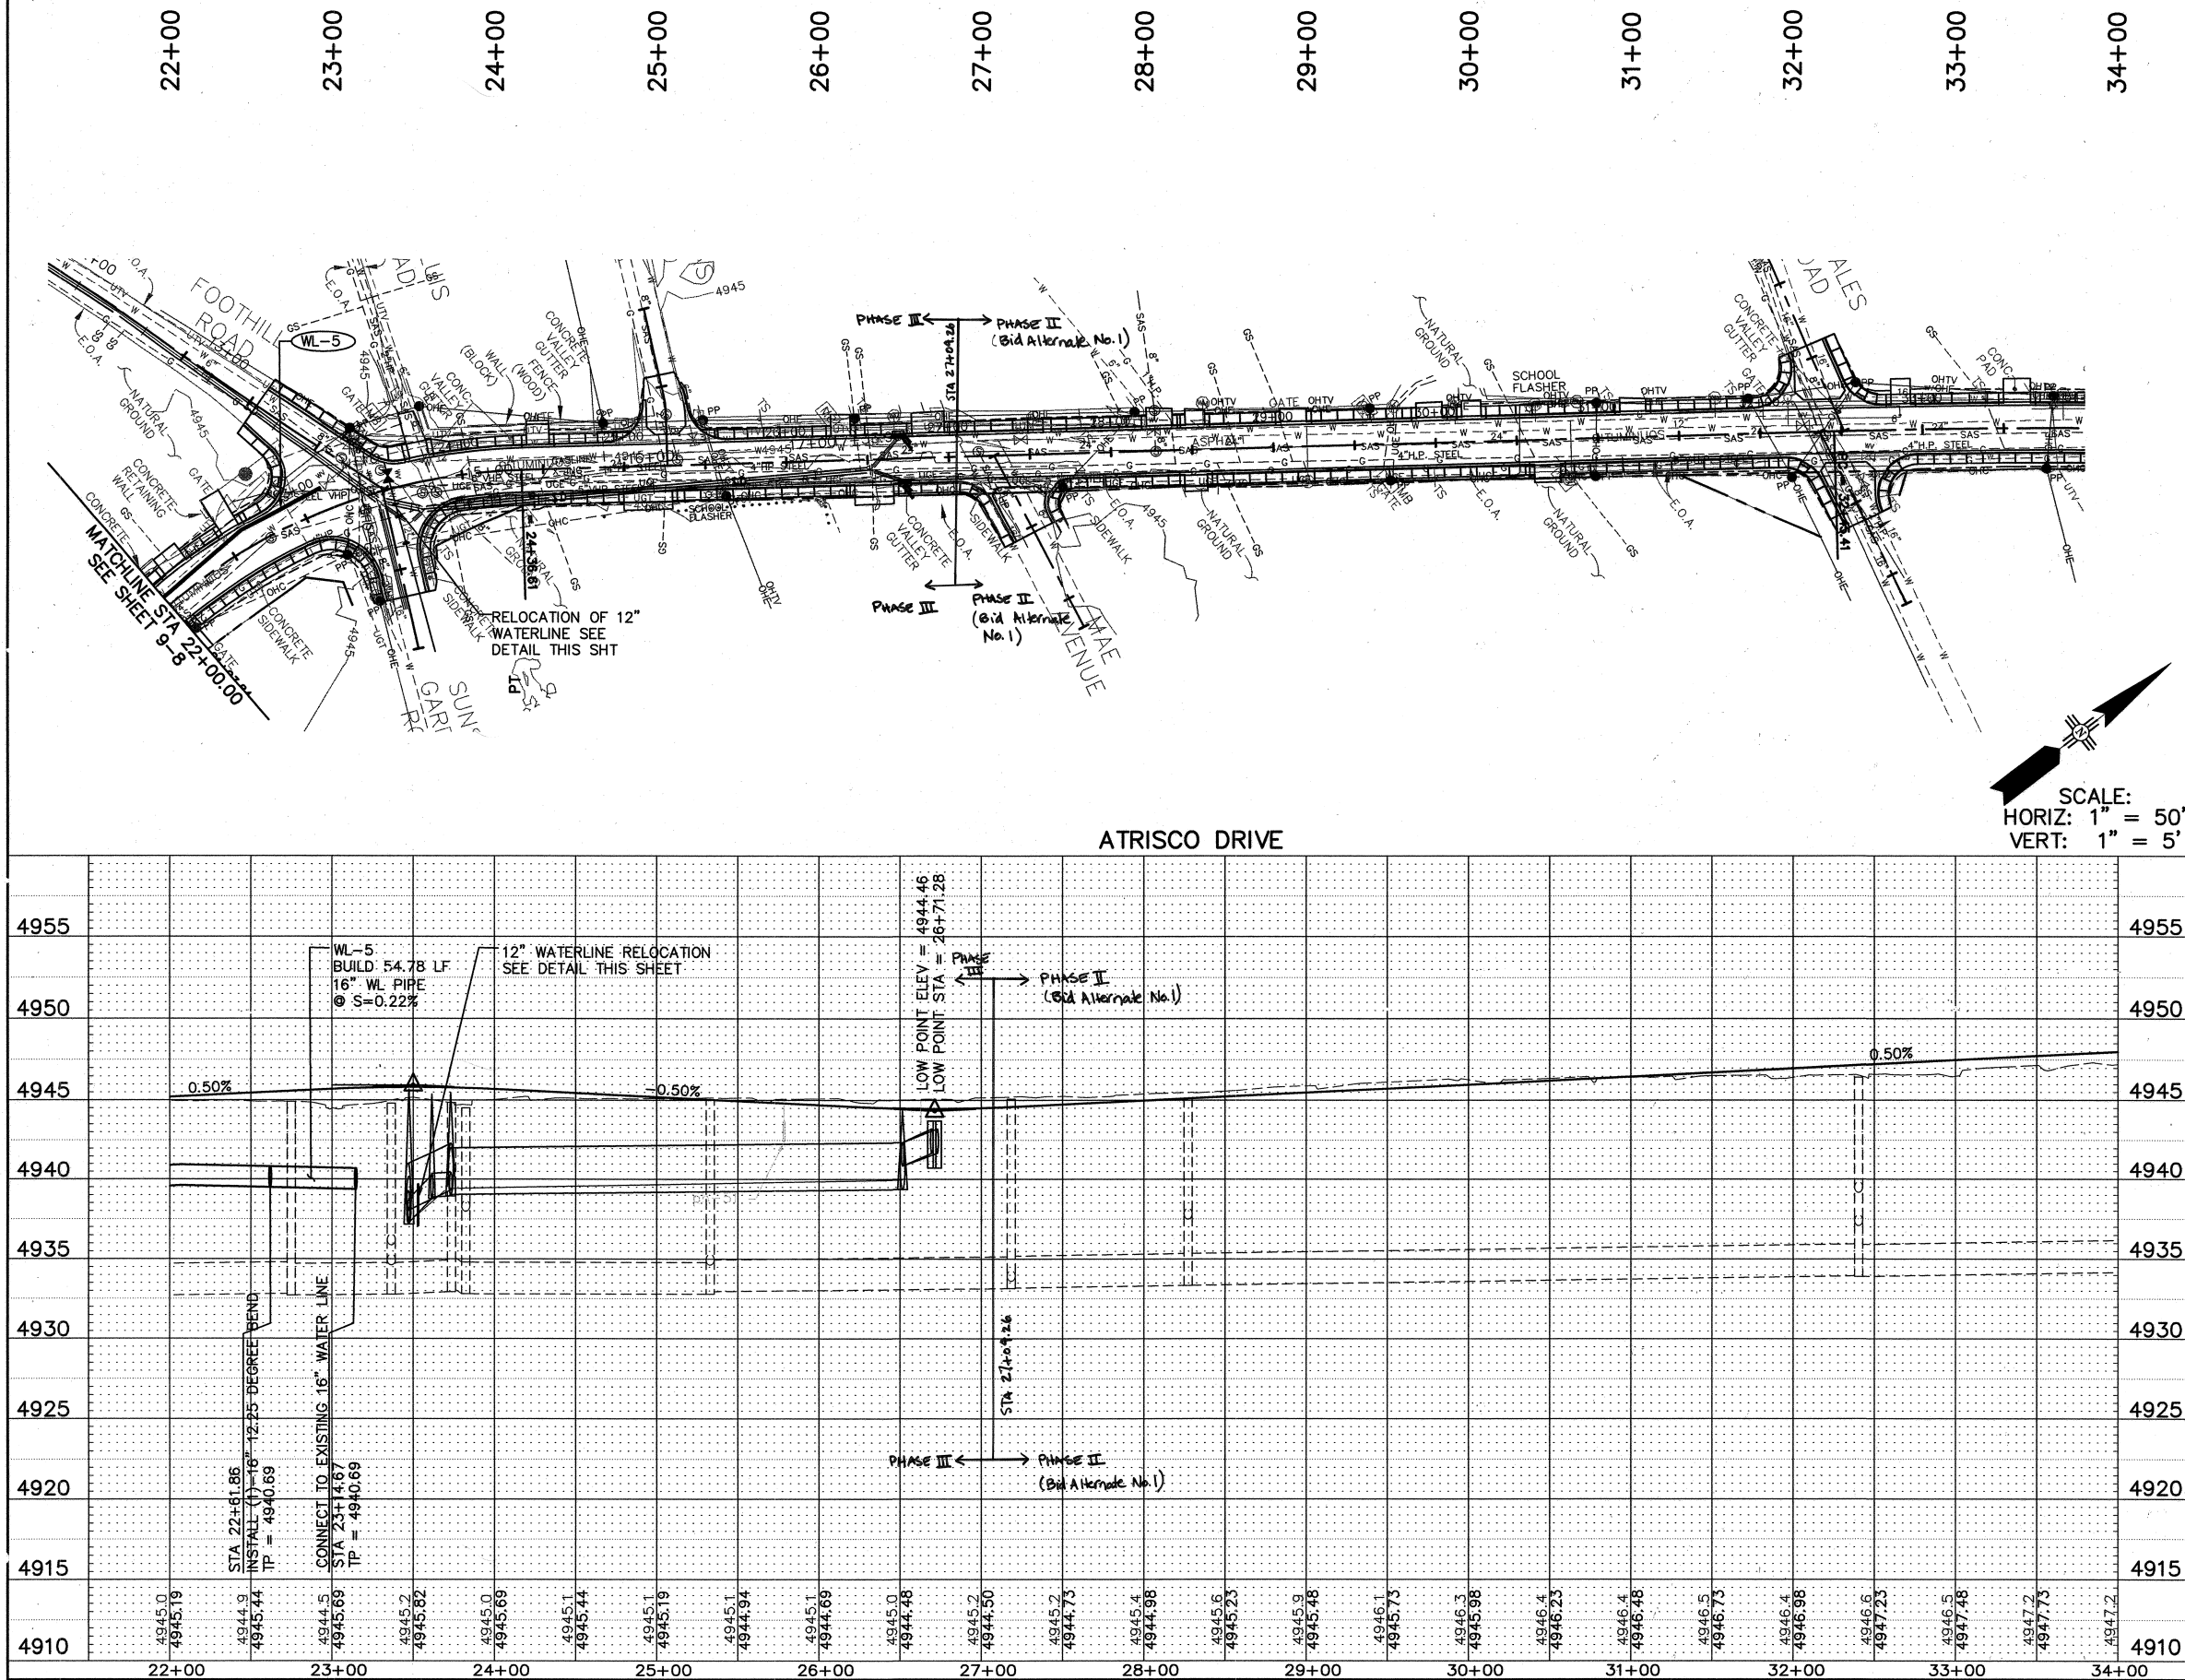

CONSTRUCTION BUILD NOTES
WATER LINE
WL-5
BUILD 54.78 LF OF 16" WL PIPE
@ S=0.22%
CONNECT TO EXISTING 16" WL PIPE
CONTRACTOR SHALL VERIFY
AS-BUILT LOCATION OF EXISTING
16" WATER LINE

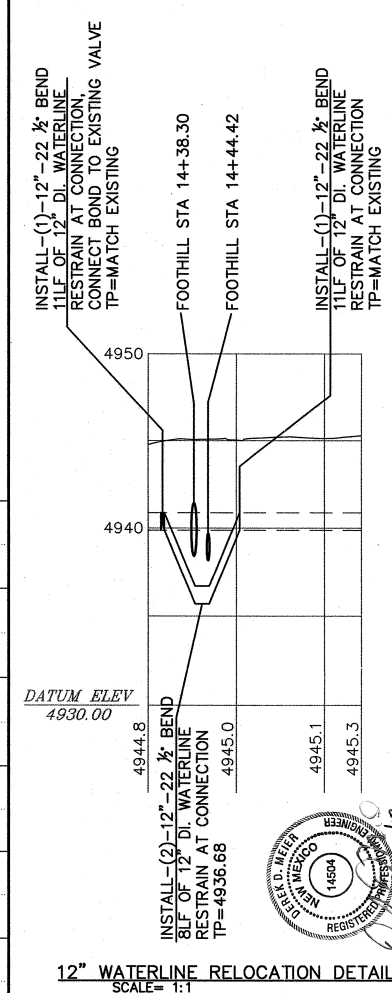

Notice Of Extended Payment Provision
This Contract allows the Owner to make payment within 45 days after submission of an undisputed request for payment.

CITY OF ALBUQUERQUE PUBLIC WORKS DEPARTMENT ENGINEERING GROUP			
ATRISCO DRIVE CORRIDOR IMPROVEMENTS WATER LINE PLAN & PROFILE			
Design Review Committee	City Engineer Approval	Last Design Update	
Mo./Day/Yr.	Mo./Day/Yr.	Mo./Day/Yr.	
City Project No. COA 5337-02		Zone Map No. K-12	Sheet 9-8

WILSON
& COMPANY

AS-BUILT INFORMATION		BENCH MARKS		SURVEY INFORMATION		ENGINEER'S SEAL		REVISIONS		NOTES	
CONTRACTOR	DATE	THE STA. IS A ACS 3-1/4" ALUMINUM TABLET	DATE	NO.	BY	DATE	NO.	DATE	BY	DATE	BY
INSPECTOR	DATE	STAMPED "ACS. 2-K12B. 1983" SET FLUSH WITH THE TOP OF CURB. THE STA. IS LOCATED 1.8 MI. WEST OF DOWNTOWN ALBQ. TO REACH THE STA. FROM THE WEST END OF OLD TOWN BRIDGE.	DATE								
ACCEPTANCE BY	DATE	FROM THE WEST END OF OLD TOWN BRIDGE, TRAVEL WEST ON CENTRAL AVE. 0.2 MI. TO THE INTX. OF CENTRAL AVE. & ATRISCO DR. THE STA. IS AT THE SE CORNER OF THE INTERSECTION.	DATE								
DRAWINGS BY	DATE	ELEV. = 4954.32 FT. (3rd ORDER) (NGVD 29)	DATE								
RECORD BY	DATE										
NO.											