



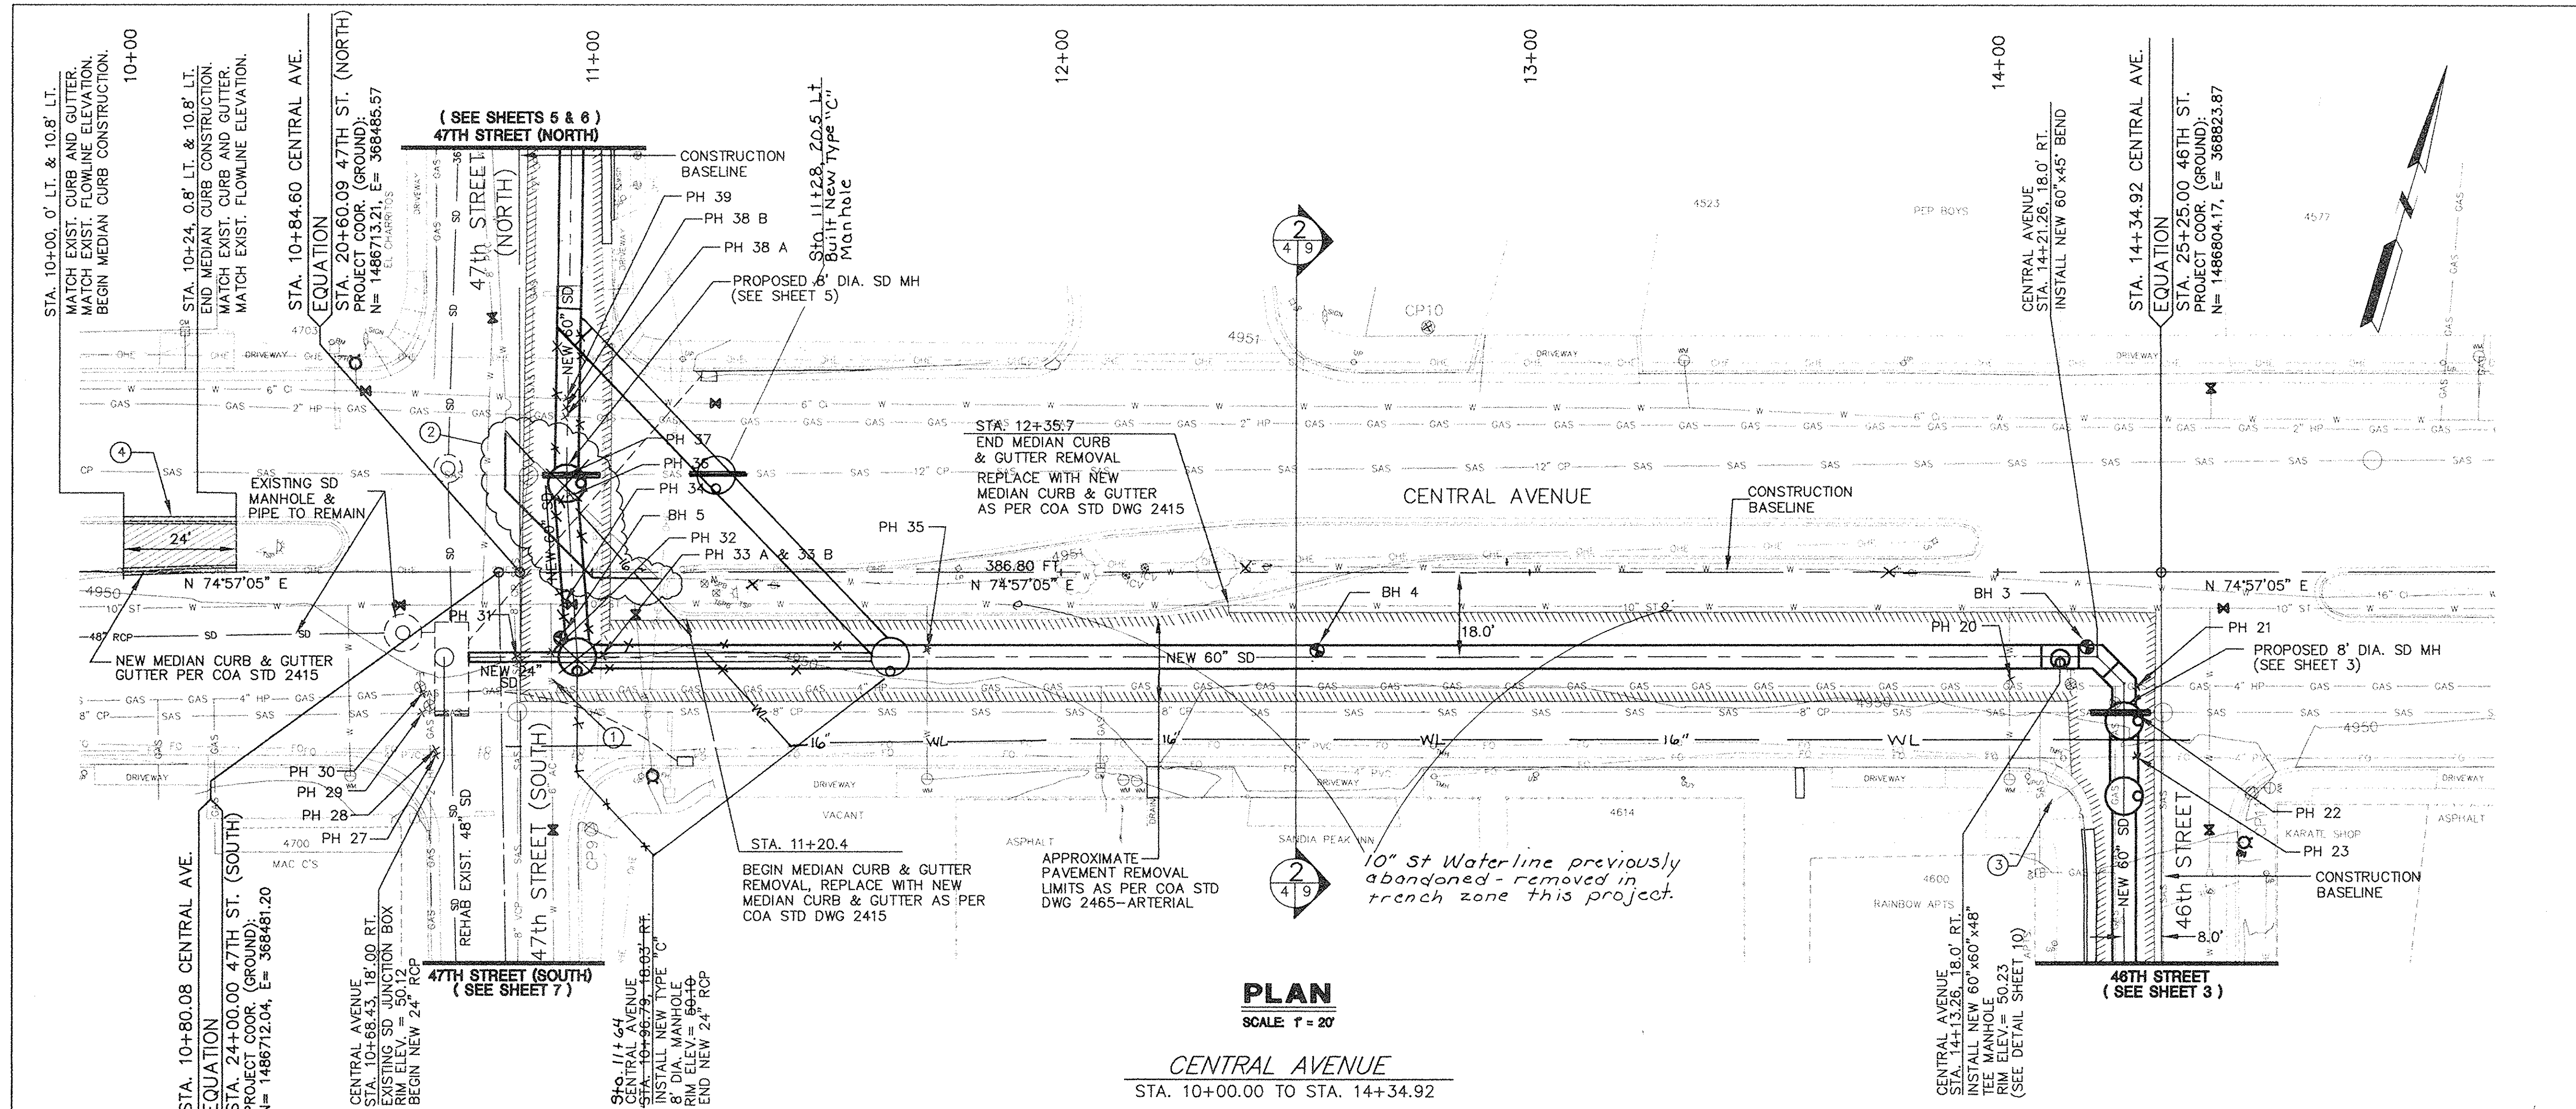

PLAN
SCALE 1" = 20'

CENTRAL AVENUE
STA. 10+00.00 TO STA. 14+34.92

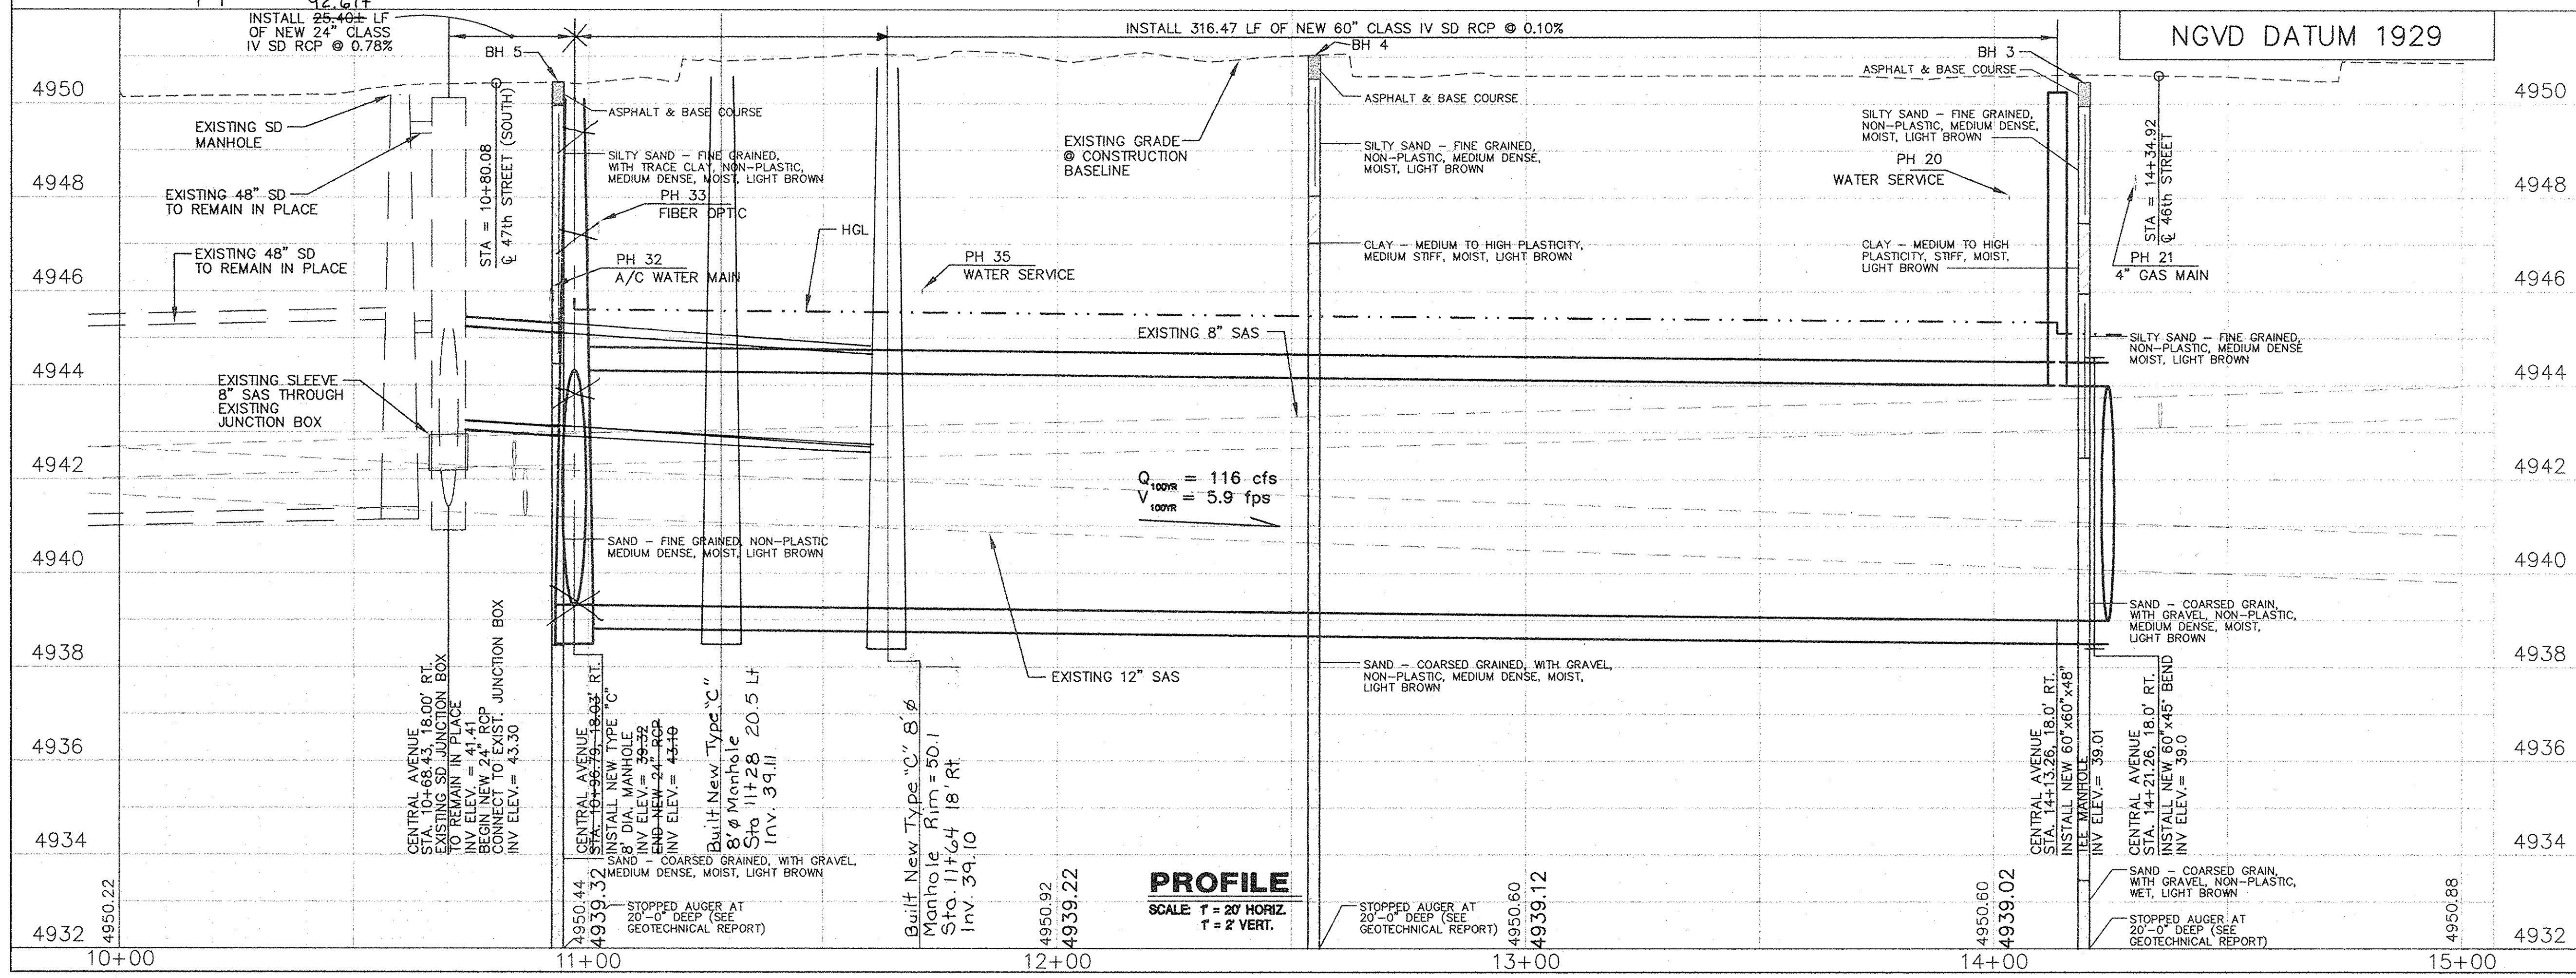

PROFILE
SCALE 1" = 20' HORIZ.
1" = 2' VERT.

POTHOLE INFORMATION

POTHOLE #	GROUND ELEVATION	PIPE ELEV. INFORMATION
20	50.30	48.13
21	50.18	48.43
22	50.06	43.64
23	49.81	45.31
		43.81
31	50.11	42.78
32	50.17	46.09
33	50.15	47.07 TOP
		46.73 BOTTOM

KEYED NOTES

- Shut down and protect existing water line during construction in this area. See sheet 21 for Water Shut-off Plan.
- See sheet 5 for water line construction this area.
- Existing wheelchair ramp is to remain. If the wheelchair ramp is disturbed by construction, it shall be replaced in its entirety.
- Remove median curb for temporary access purposes and install temporary pavement within median during Construction Phase V see temporary pavement section sheet 9. Following Construction Phase V, build new median curb per COA Std. Dwg. 2415. Match existing flowline grade for curb.

RECORD DRAWING
09/04

NOTE

Any water service lines that need to be replaced shall be replaced with copper tubing and no splices from meter to main. As per C.O.A. Std Dwg. 2362

Any existing utilities exposed during construction shall be supported and protected during construction. This shall be considered incidental to project construction and no separate payment will be made.

PH # = Pot hole location for existing utilities



CITY OF ALBUQUERQUE
PUBLIC WORKS DEPARTMENT
ENGINEERING DIVISION

TITLE: **CENTRAL - ATRISCO DRAINAGE IMPROVEMENTS**
CENTRAL AVENUE
PLAN & PROFILE STA 10+00 TO 14+34.92

Design Review Committee	City Engineer Approval	Mo./Day/Yr.	Mo./Day/Yr.

City Project No. 674902 Zone Map No. K-12-Z Sheet 4 of 21