


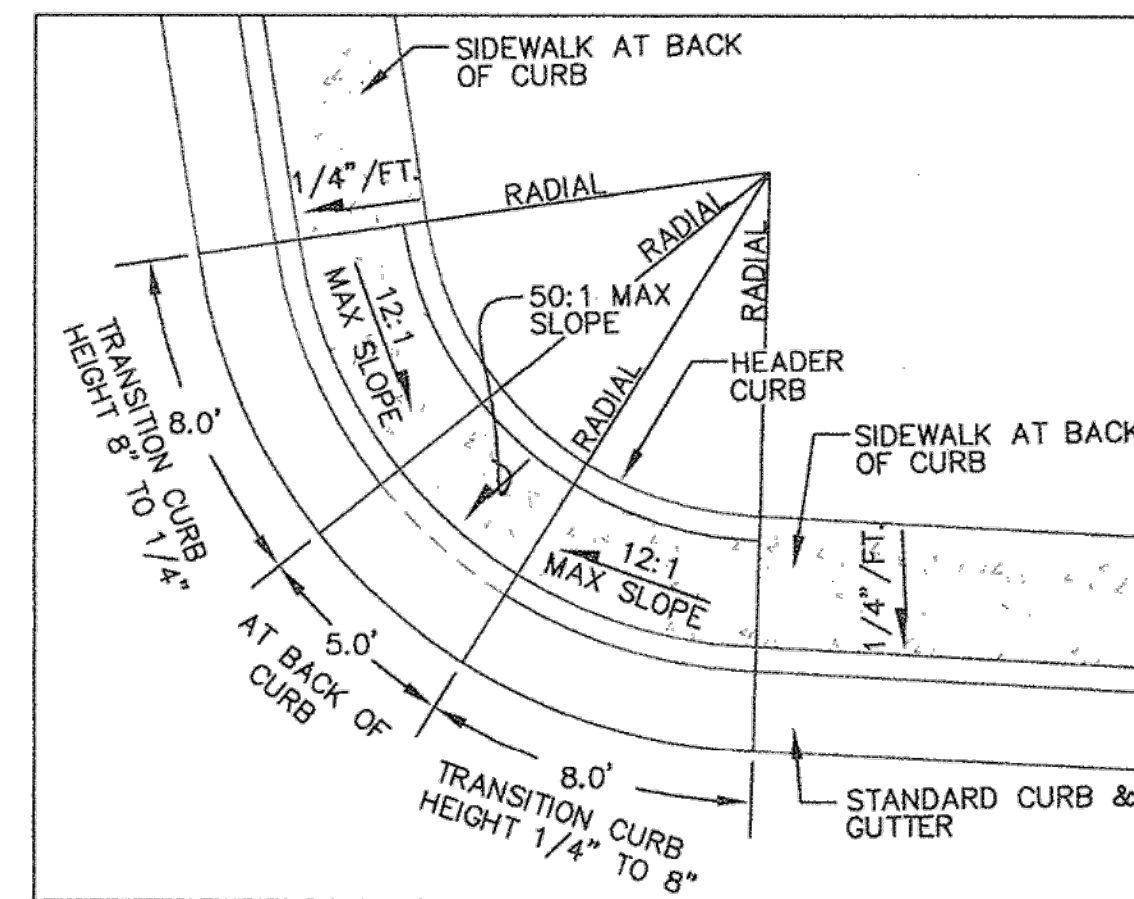

CASE I (MODIFIED) WHEELCHAIR RAMP DETAIL
SEE C.O.A. STD. DWG. NO. 2441 FOR ADDITIONAL DETAILS.

POTHOLE # (PH)	GROUND ELEVATION	PIPE ELEV. INFORMATION
1 A	49.00	46.83
B		46.58
2 A	49.00	47.00
B		46.75
3	49.16	47.74
4 A	49.17	47.42
B		47.17
5	49.98	45.81
6 A	49.64	47.39
B		47.14
7	49.80	47.38
8 A	49.96	47.54
B		47.13
9	50.22	48.14

RECORD DRAWINGS WERE PREPARED
FROM INFORMATION PROVIDED BY
THE CONTRACTOR

FROM INFORMATION PROVIDED BY
THE CONTRACTOR

RECORD DRAWING
09/04
REV.11/17

NOTE

Any water service lines that need to be replaced shall be replaced with copper tubing and no splices from meter to main. As per C.O.A. Std Dwg. 2362

Any existing utilities exposed during construction shall be supported and protected during construction. This shall be considered incidental to project construction and no separate payment will be made.

PH # = Pot hole location for existing utilities
Existing curb and gutter at the Glendale/47th St.
intersection is to remain undisturbed.



2002-0021-28

CITY OF ALBUQUERQUE
PUBLIC WORKS DEPARTMENT
ENGINEERING DIVISION

TITLE: CENTRAL - ATRISCO DRAINAGE IMPROVEMENTS
47th STREET (NORTH)
PLAN & PROFILE STA 25+00 TO 28+36.17

Design Review Committee	City Engineer Approval	Last Design Update	Mo./Day/Yr.	Mo./Day/Yr.
City Project No.	Zone Map No.	Sheet	Of	
674902	K-12-Z	6	21	

AS BUILT INFORMATION			
CONTRACTOR	WORK	DATE	
STAINED BY	DESCRIPTIONS	DATE	
ACCEPTANCE BY	FIELD	DATE	
VERIFICATION BY		DATE	
RECORDED BY		DATE	
MICRO-FILM INFORMATION			
RECORDED BY		DATE	
RECORDED BY		DATE	

BENCH MARKS

ALBUQUERQUE CONTROL SURVEY B.M. NO. 17-112
LOCATED 2.3 MILES WEST OF DOWNTOWN ALBUQUERQUE
SOUTHWEST SIDE OF ATRISCO RD.
THE STATION IS AN ACS 3 1/4" ALUM. CAP RIVETED TO A
PIPE 0.25 FT. ABOVE GROUND AND IS STAMPED "17-112, 1989".
PLANE COORDINATES: X=467999.51, Y=489040.30, EL= 4955.128

SURVEY INFORMATION			DATE
FIELD NOTES			
NO.	BY		
1			
2			
3			
4			
5			
6			
7			

ENGINEER'S SEAL



4			
3			
2			
1			
NO.	DATE	REMARKS	BY
▲ R E V I S I O N S ▲			
DESIGN			
DESIGNED BY: R.L.			DATE: JUL 2003
DRAWN BY: A.B./P.R.			DATE: JUL 2003
CHECKED BY: J.A.A			DATE: JUL 2003