


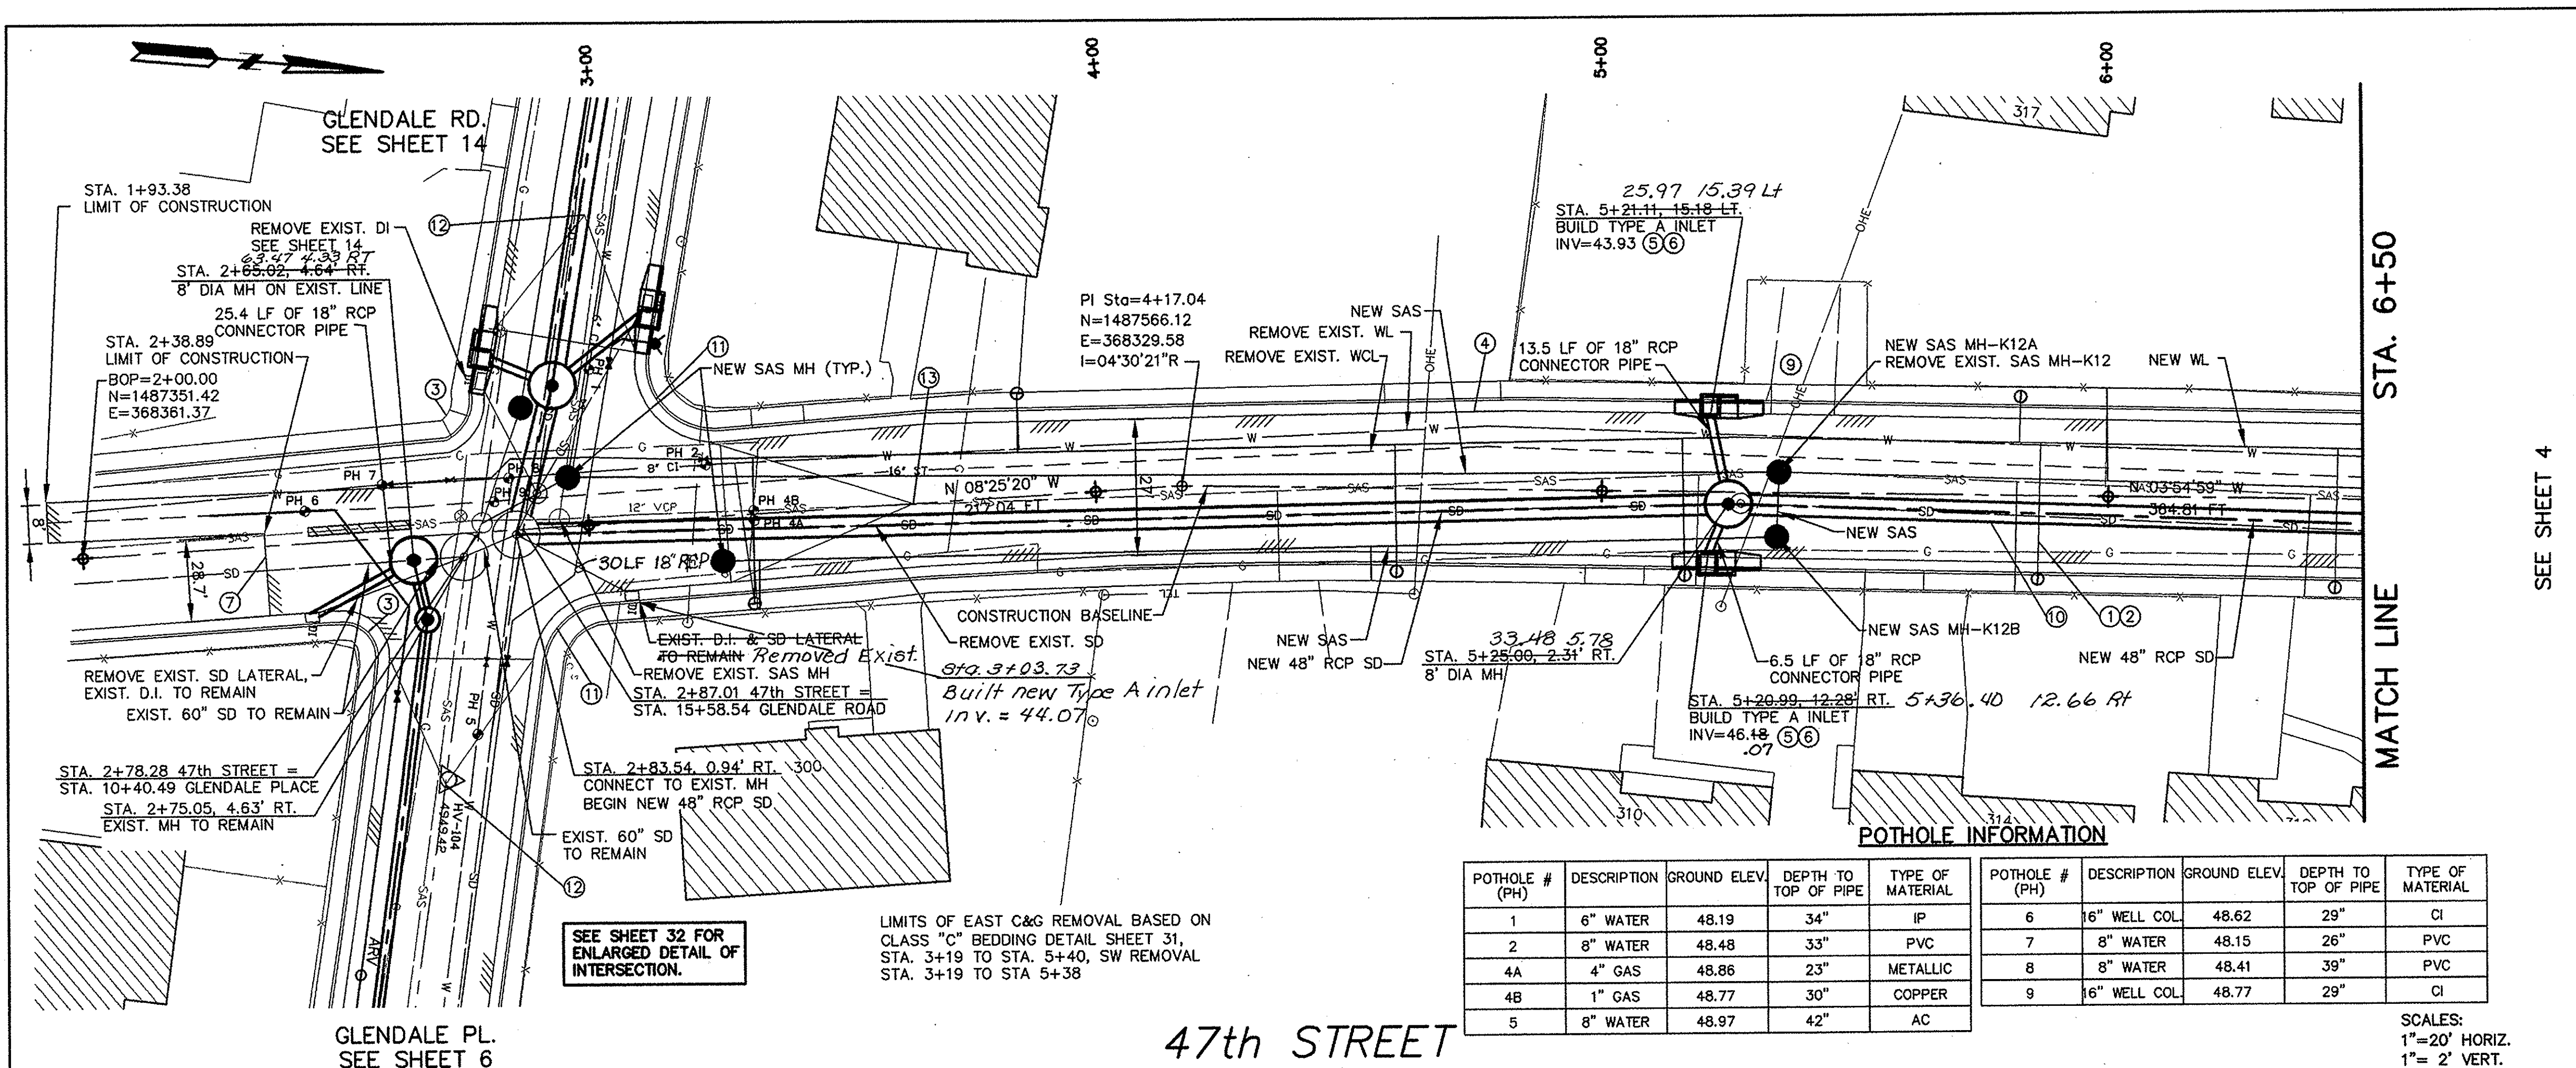

- KEYED NOTES**
- REPLACED WATER SERVICE LINES SHALL BE REPLACED WITH COPPER TUBING WITH NO SPLICES FROM METER TO MAIN PER COA STD. DWG. 2362.
 - ANY EXISTING UTILITIES EXPOSED DURING CONSTRUCTION SHALL BE SUPPORTED AND PROTECTED DURING CONSTRUCTION. THIS SUPPORT AND PROTECTION SHALL BE CONSIDERED INCIDENTAL TO PROJECT CONSTRUCTION AND NO SEPARATE PAYMENT WILL BE MADE.
 - THE DISTURBANCE OF ANY EXISTING WHEELCHAIR RAMP DURING CONSTRUCTION SHALL REQUIRE THE REPLACEMENT OF THE ENTIRE WHEELCHAIR RAMP PER COA STD. DWG. 2441, CASE I, OR CASE II WITH HEADER CURB USING TRUNCATED DOMES, DETECTABLE SURFACE, ON SURFACE.
 - MAJOR LOCAL PAVEMENT SHALL BE REPLACED PER COA STD. DWG. 2405. SEE SHEET 31.
 - CURB AND GUTTER REPLACEMENT SHALL BE PER COA STD. DWG. 2415A. SEE SHEET 2 NOTES.
 - STORM DRAIN INLETS SHALL BE PER COA STD. DWG. 2201. INLET GRATES WILL BE PER COA STD. DWG. 2220.
 - ALL PAVEMENT CUTS TO BE MADE PERPENDICULAR TO TRAFFIC FLOW. PAVEMENT CUTS AT CURB RADIUS WILL BE MADE RADIAL TO THE CURB.
 - NOT USED THIS SHEET
 - DRIVEPADS AFFECTED BY CONSTRUCTION SHALL BE RECONSTRUCTED PER COA STD. DWG. 2425.
 - VERIFY SEWER LATERAL CLEARANCE PRIOR TO INSTALLATION OF STORM DRAIN, TYP.
 - INSTALL WHEEL CHAIR RAMP PER COA STD. DWG. 2441, CASE I, OR CASE II WITH HEADER CURB USING TRUNCATED DOMES, DETECTABLE SURFACE, ON SURFACE.
 - 25' HALF CROWN TRANSITION PER COA STD. DWG. 2401.
 - 50' FULL CROWN TRANSITION PER COA STD. DWG. 2401.

RECORD DRAWING
JUNE 2007



CITY OF ALBUQUERQUE
DEPARTMENT OF MUNICIPAL DEVELOPMENT
STORM DRAINAGE DESIGN DIVISION

TITLE: **CENTRAL - ATRISCO DRAINAGE IMPROVEMENTS PHASE II**
47th STREET STA. 2+00 TO 6+50

DESIGN	REVIEW	DATE	BY
APPROVED	APPROVED	JUN 08 2006	JUN 08 2006
DESIGN COMMITTEE	CITY ENGINEER		

Project No. 674903 Zone Map No. K-11-Z Sheet 3 of 32

AS BUILT INFORMATION

CONTRACTOR: New Mexico Underground

INSPECTOR: Terra Land Surveys DATE: 9/06

ACCEPTANCE BY: C.O.A. DATE: 5/07

REVISIONS

NO.	DATE	BY	REMARKS
1			

ENGINEER'S SEAL

DESIGNED BY: XX
DRAWN BY: XX
CHECKED BY: XX