



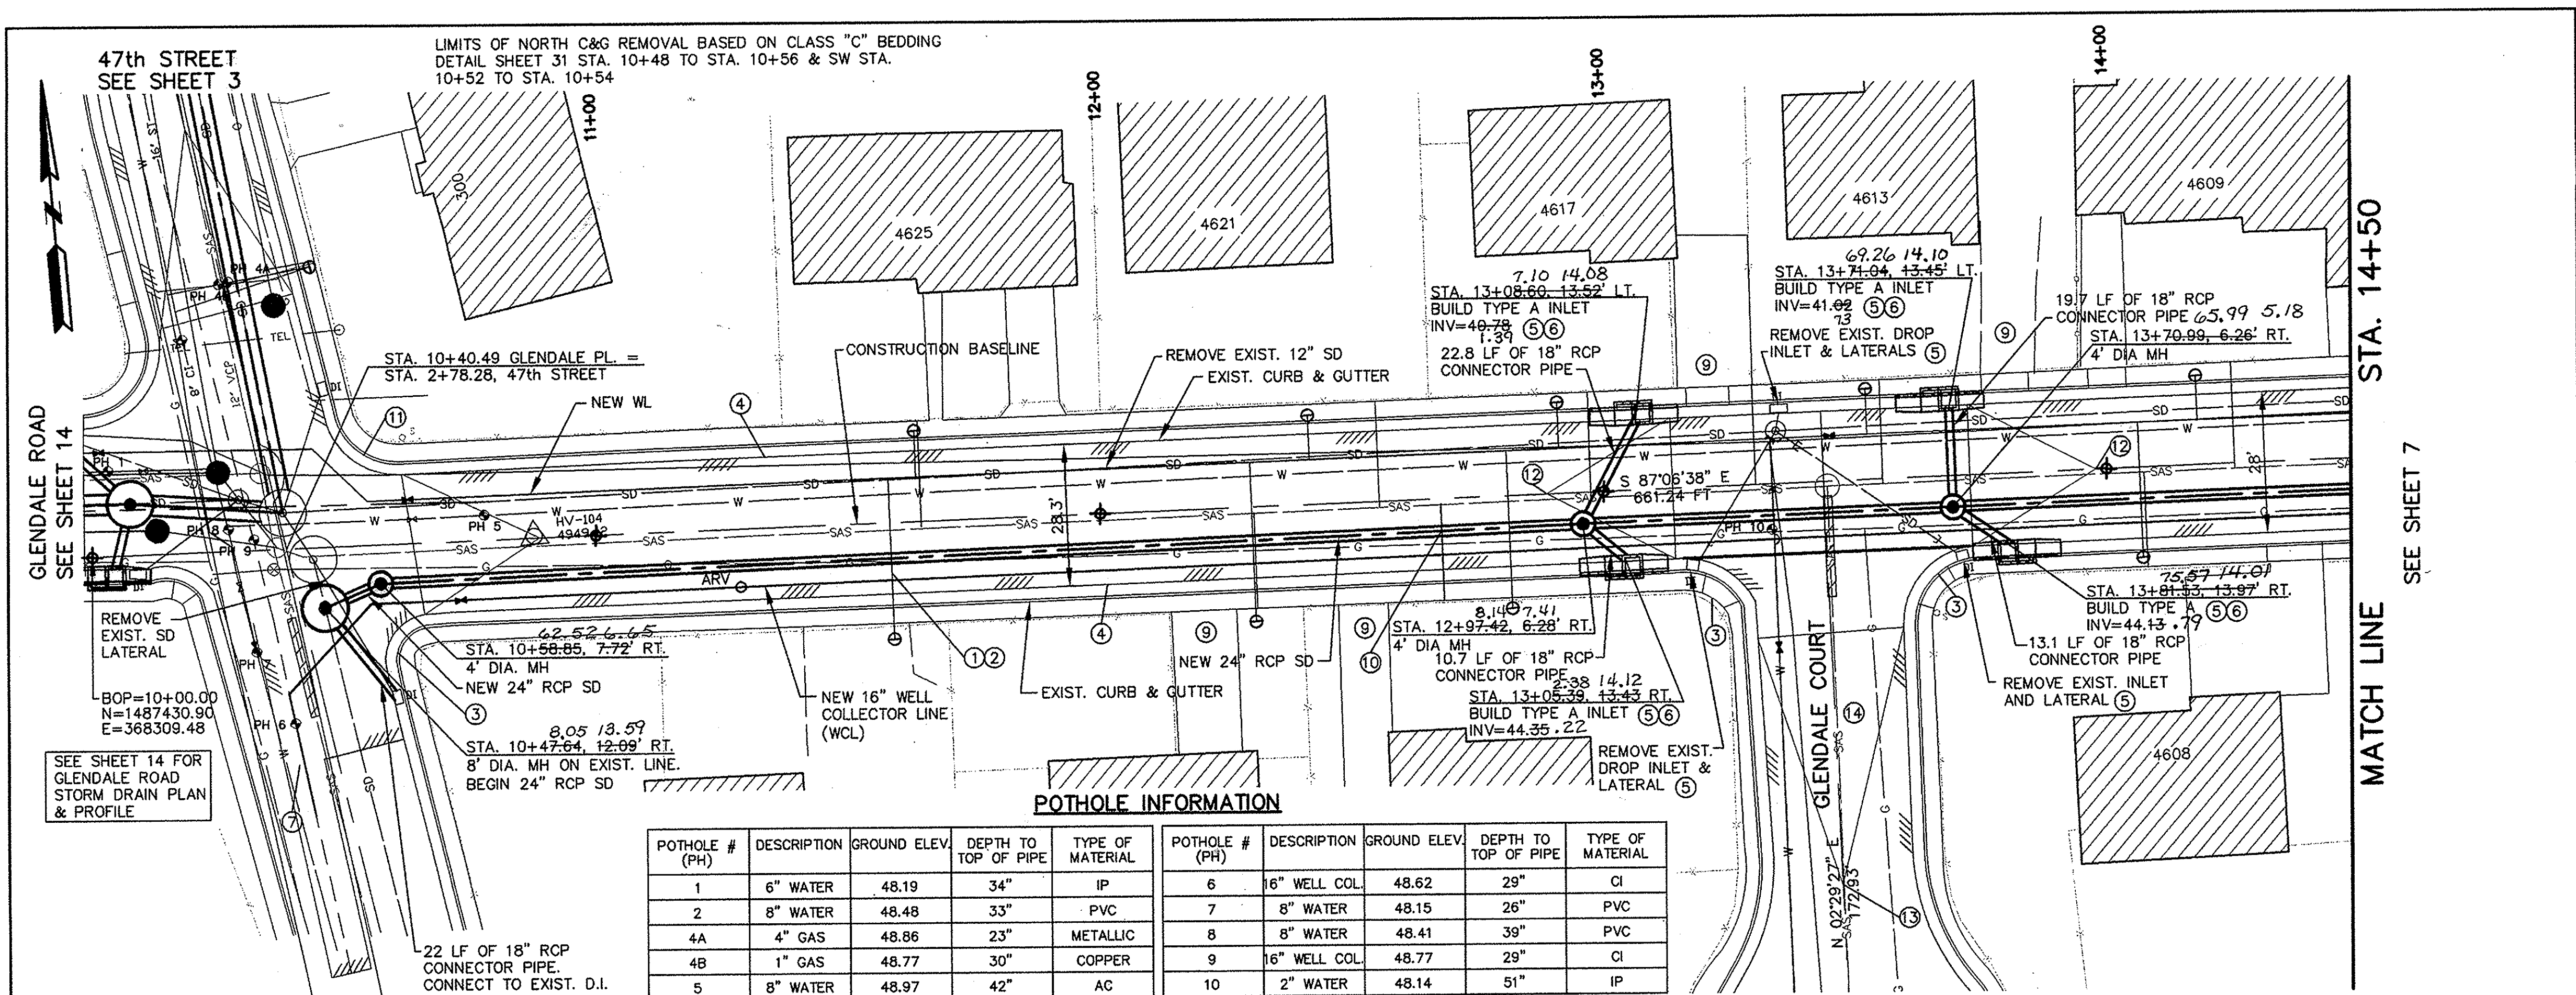

POTHOLE INFORMATION					POTHOLE INFORMATION				
POTHOLE # (PH)	DESCRIPTION	GROUND ELEV.	DEPTH TO TOP OF PIPE	TYPE OF MATERIAL	POTHOLE # (PH)	DESCRIPTION	GROUND ELEV.	DEPTH TO TOP OF PIPE	TYPE OF MATERIAL
1	6" WATER	48.19	34"	IP	6	16" WELL COL.	48.62	29"	CI
2	8" WATER	48.48	33"	PVC	7	8" WATER	48.15	26"	PVC
4A	4" GAS	48.86	23"	METALLIC	8	8" WATER	48.41	39"	PVC
4B	1" GAS	48.77	30"	COPPER	9	16" WELL COL.	48.77	29"	CI
5	8" WATER	48.97	42"	AC	10	2" WATER	48.14	51"	IP

GLENDAL PLACE

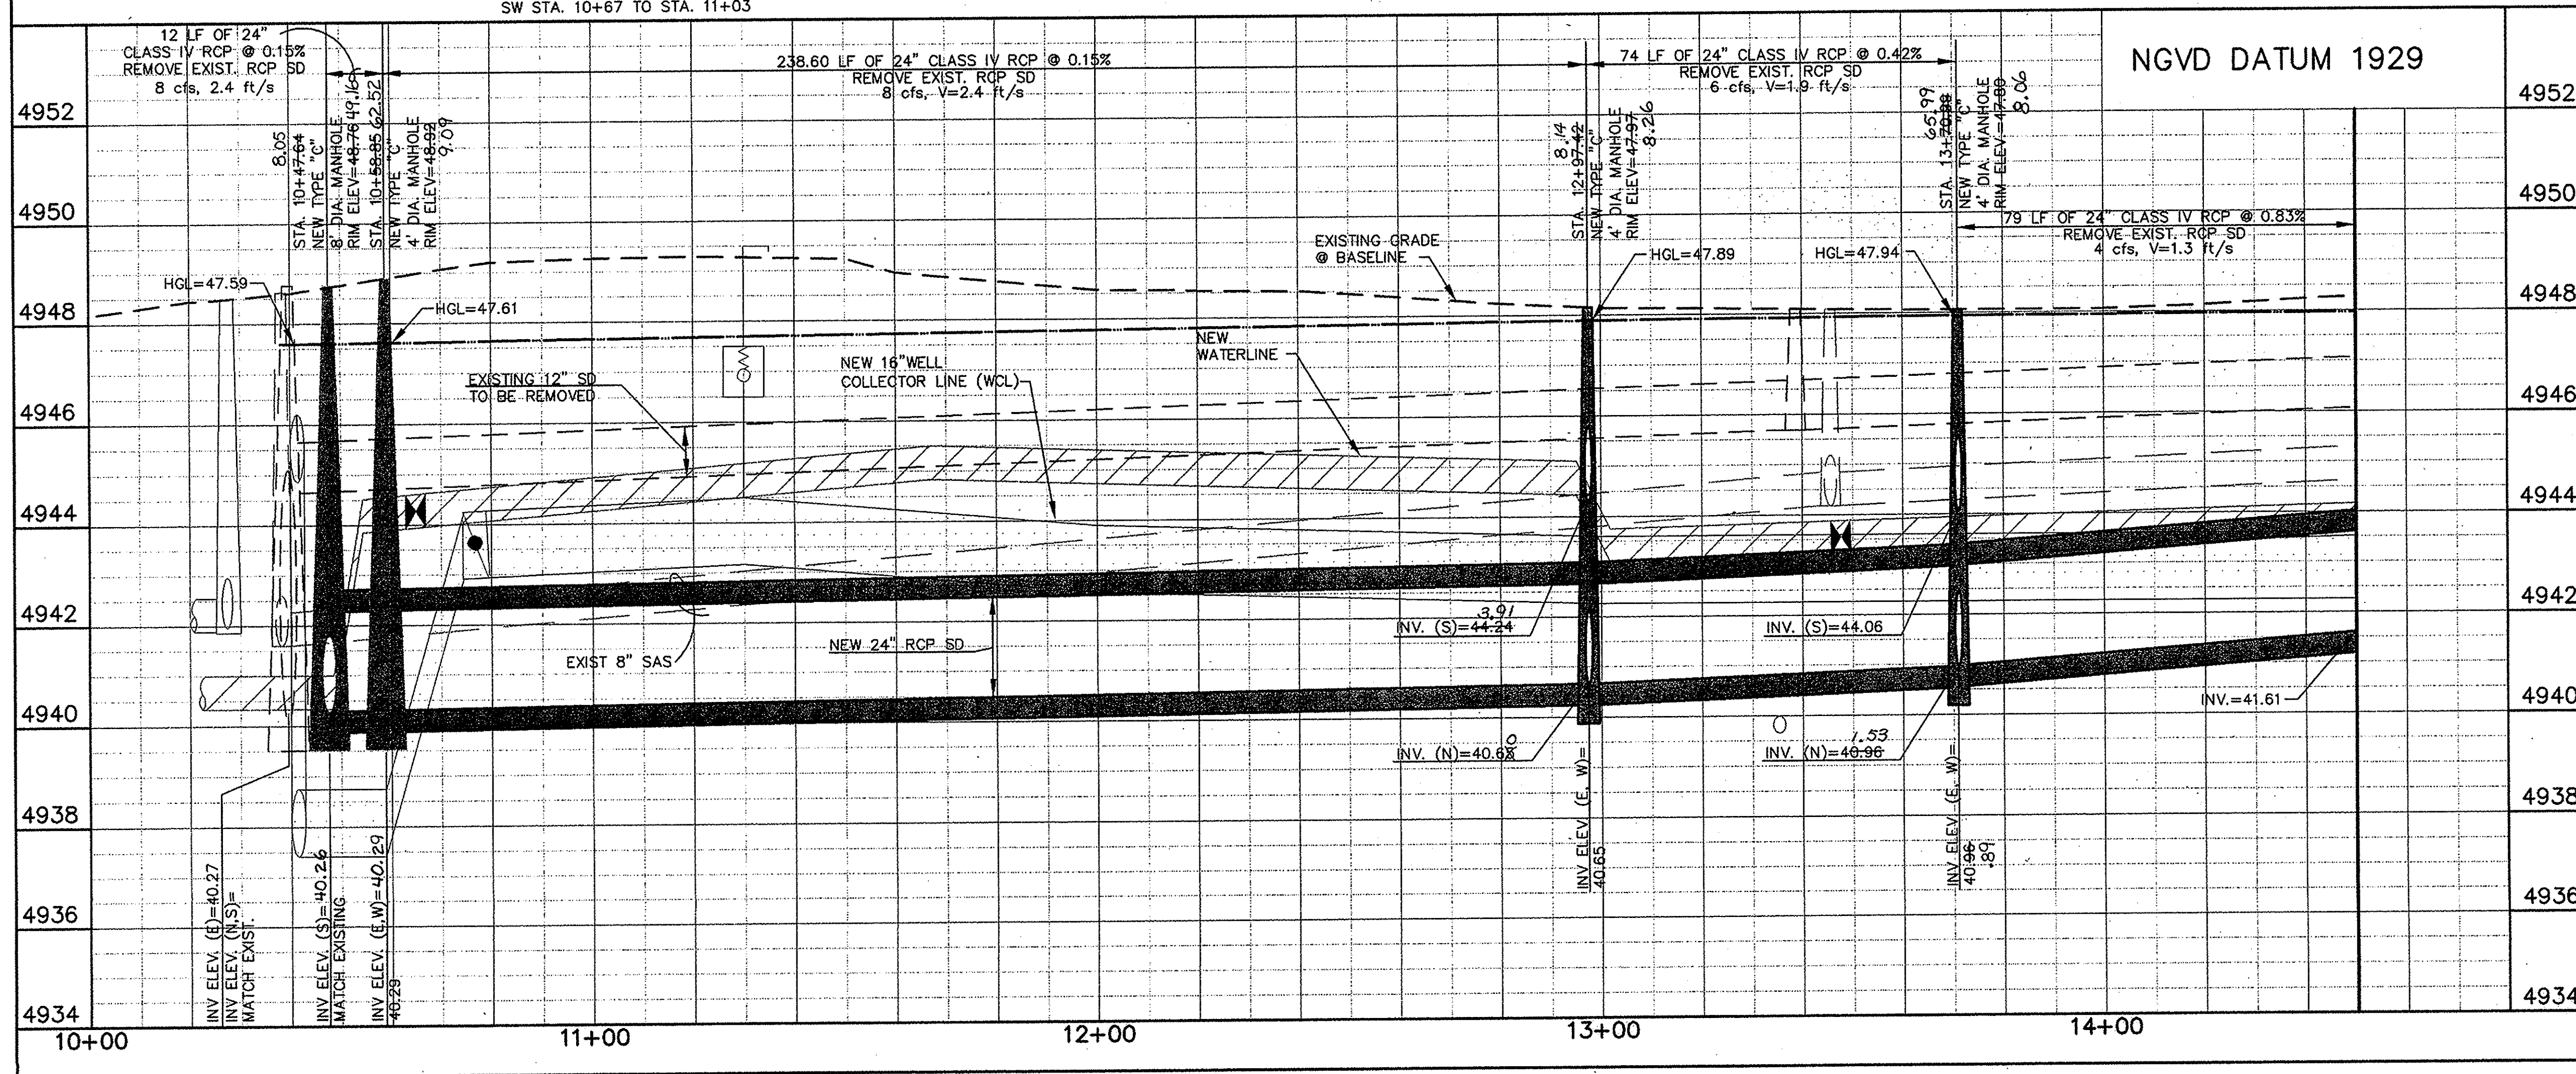

KEYED NOTES

- REPLACED WATER SERVICE LINES SHALL BE REPLACED WITH COPPER TUBING WITH NO SPLICES FROM METER TO MAIN PER COA STD. DWG. 2362.
- ANY EXISTING UTILITIES EXPOSED DURING CONSTRUCTION SHALL BE SUPPORTED AND PROTECTED DURING CONSTRUCTION. THIS SUPPORT AND PROTECTION SHALL BE CONSIDERED INCIDENTAL TO PROJECT CONSTRUCTION AND NO SEPARATE PAYMENT WILL BE MADE.
- THE DISTURBANCE OF ANY EXISTING WHEELCHAIR RAMP DURING CONSTRUCTION SHALL REQUIRE THE REPLACEMENT OF THE ENTIRE WHEELCHAIR RAMP PER COA STD. DWG. 2441, CASE I, OR CASE II WITH HEADER CURB USING TRUNCATED DOMES, DETECTABLE SURFACE, ON SURFACE.
- MAJOR LOCAL PAVEMENT SHALL BE REPLACED PER COA STD. DWG. 2405. SEE SHEET 31.
- CURB AND GUTTER REPLACEMENT SHALL BE PER COA STD. DWG. 2415A. SEE SHEET 2 NOTES.
- STORM DRAIN INLETS SHALL BE PER COA STD. DWG. 2201. INLET GRATES WILL BE PER COA STD. DWG. 2220.
- ALL PAVEMENT CUTS TO BE MADE PERPENDICULAR TO TRAFFIC FLOW. PAVEMENT CUTS AT CURB RADIUS WILL BE MADE RADIAL TO THE CURB.
- NOT USED THIS SHEET
- DRIVEPADS AFFECTED BY CONSTRUCTION SHALL BE RECONSTRUCTED PER COA STD. DWG. 2425.
- VERIFY SEWER LATERAL CLEARANCE PRIOR TO INSTALLATION OF STORM DRAIN, TYP.
- INSTALL WHEEL CHAIR RAMP PER COA STD. DWG. 2441, CASE I, OR CASE II WITH HEADER CURB USING TRUNCATED DOMES, DETECTABLE SURFACE, ON SURFACE.
- 25' HALF CROWN TRANSITION PER COA STD. DWG. 2401.
- 50' FULL CROWN TRANSITION PER COA STD. DWG. 2401.
- MAJOR LOCAL, SEE SHEET 31.

RECORD DRAWING
JUNE 2007

LARKIN GROUP INC.
CONSULTING ENGINEERS AND SURVEYORS
6300 MENAUL BLVD., NE #4-440
ALBUQUERQUE, NEW MEXICO 87112
(505) 275-7500 FAX (505) 275-0748

CITY OF ALBUQUERQUE
DEPARTMENT OF MUNICIPAL DEVELOPMENT
STORM DRAINAGE DESIGN DIVISION

TITLE: **CENTRAL - ATRISCO DRAINAGE IMPROVEMENTS PHASE II**
GLENDAL PLACE STA 10+00 TO 14+50

DESIGN REVIEW COMMITTEE APPROVED JUN 08 2006
CITY ENGINEER APPROVED JUN 08 2006

Project No. 674903 Zone Map No. K-12-Z Sheet 6 of 32

AS BUILT INFORMATION			
CONTRACTOR	NEW MEXICO UNDERGROUND	DATE	9/02
DESIGNED BY	TERRE LAND SURVEYS	DATE	5/07
CHECKED BY	C.O.A.	DATE	5/07
RECORDED BY	TERRE LAND SURVEYS	DATE	7/07
PROJECT NO.	674903	PROJECT NAME	CENTRAL - ATRISCO DRAINAGE IMPROVEMENTS PHASE II
ZONE MAP NO.	K-12-Z	PROJECT LOCATION	GLENDAL PLACE STA 10+00 TO 14+50
ENGINEER'S SEAL			

SURVEY INFORMATION			
CITY	ALBUQUERQUE	STATION	2-K12B
DATE	9/02	BY	TERRE LAND SURVEYS
NO.	1	REMARKS	DESIGN
DESIGNED BY	XX	CHECKED BY	XX
DRAWN BY	XX	PROJECT NO.	674903
CHECKED BY	XX	ZONE MAP NO.	K-12-Z
		SHEET	6 of 32