


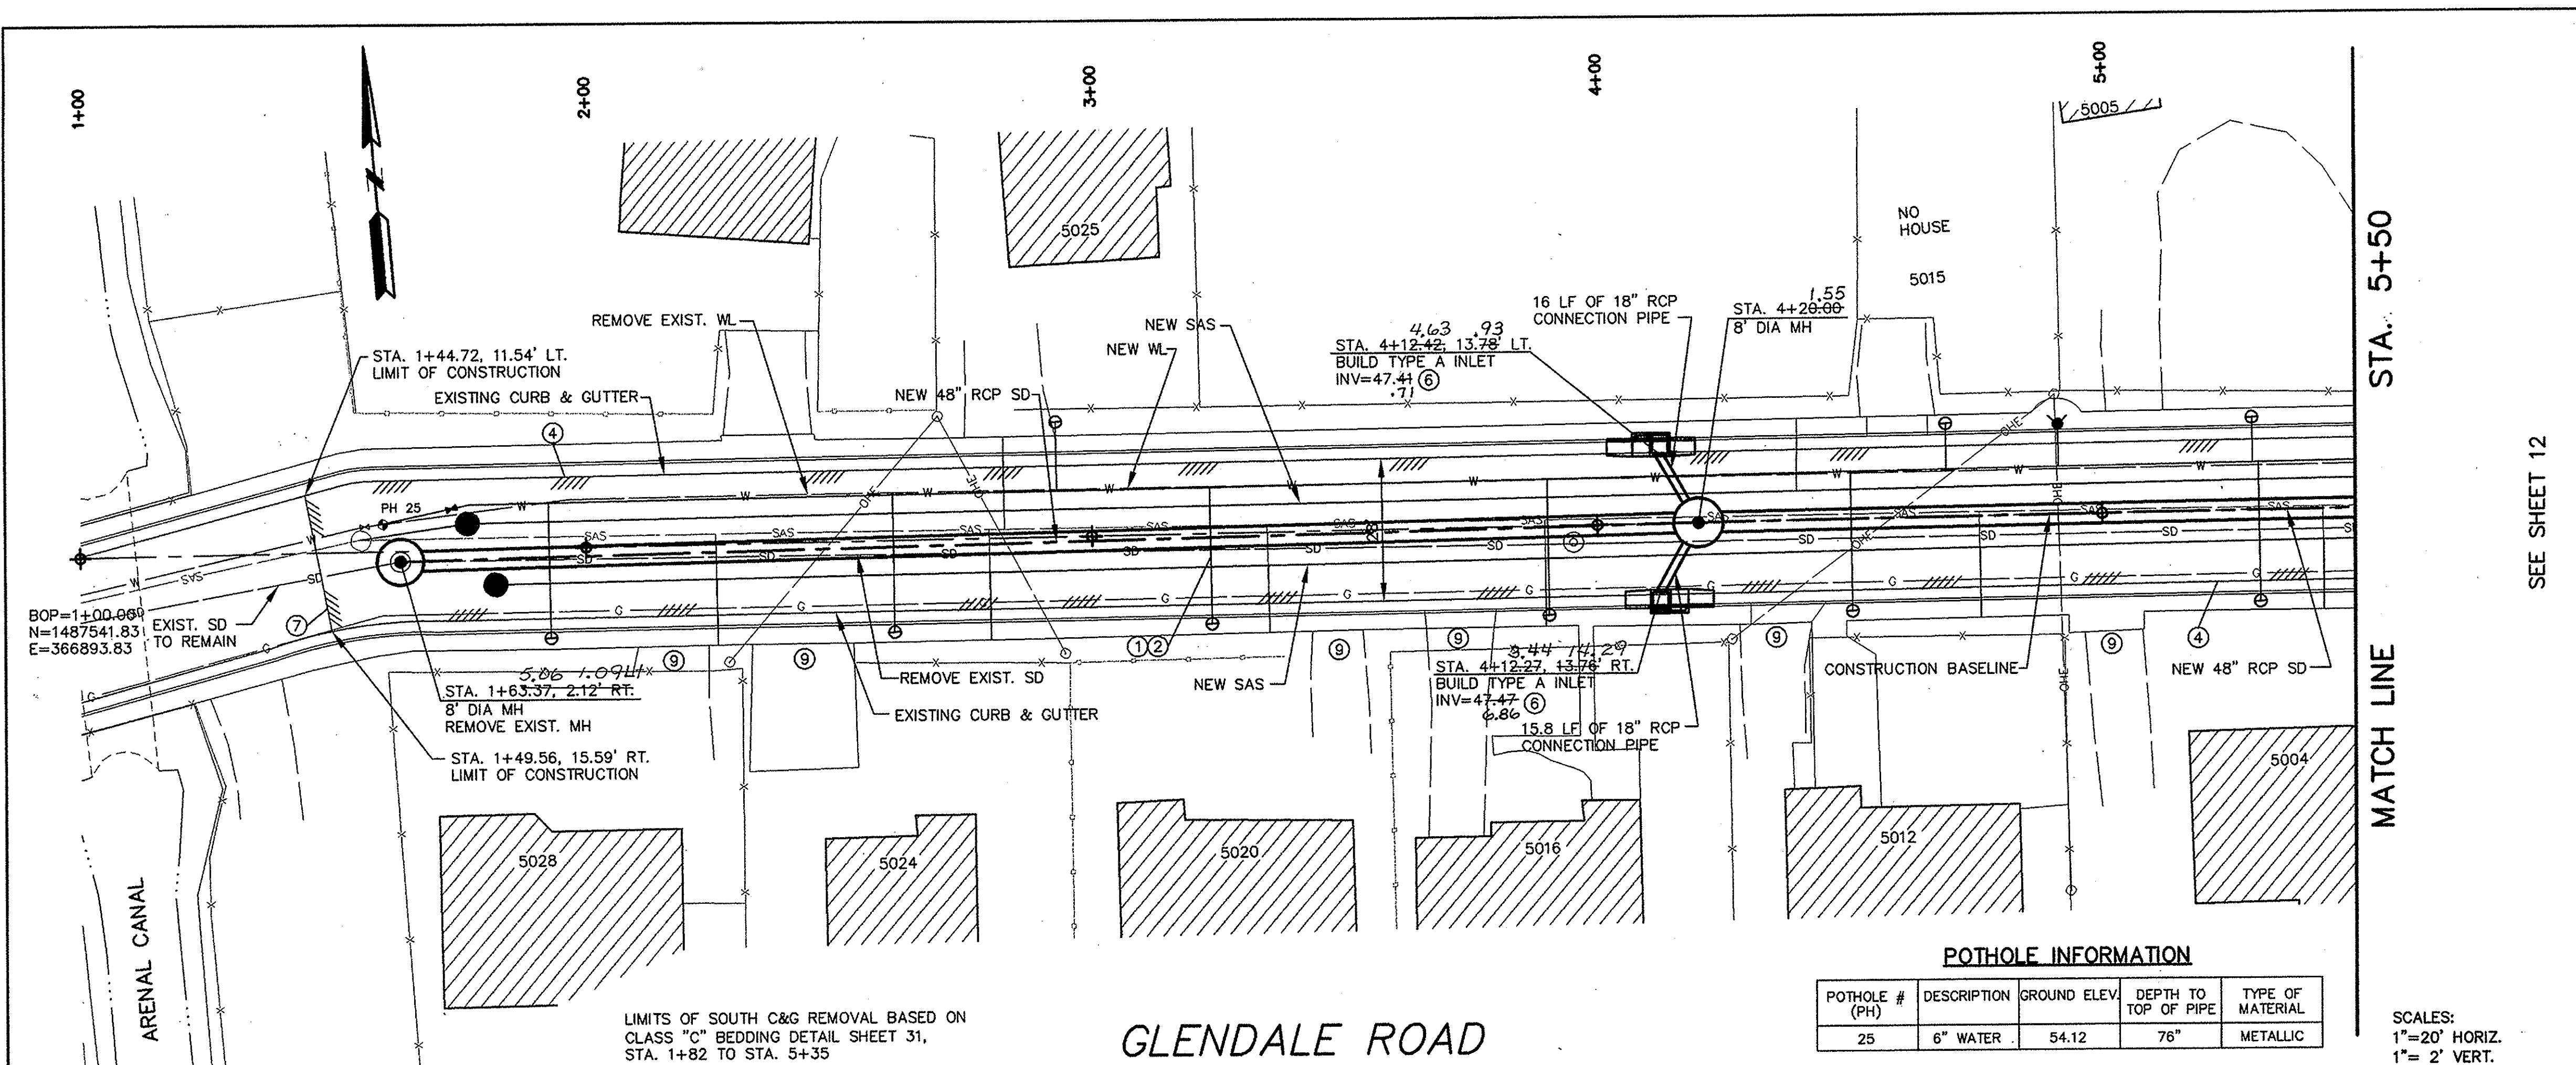

KEYED NOTES

- REPLACED WATER SERVICE LINES SHALL BE REPLACED WITH COPPER TUBING WITH NO SPLICES FROM METER TO MAIN PER COA STD. DWG. 2362.
- ANY EXISTING UTILITIES EXPOSED DURING CONSTRUCTION SHALL BE SUPPORTED AND PROTECTED DURING CONSTRUCTION. THIS SUPPORT AND PROTECTION SHALL BE CONSIDERED INCIDENTAL TO PROJECT CONSTRUCTION AND NO SEPARATE PAYMENT WILL BE MADE.
- NOT USED THIS SHEET
- MAJOR LOCAL PAVEMENT SHALL BE REPLACED PER COA STD. DWG. 2405. SEE SHEET 31.
- CURB AND GUTTER REPLACEMENT SHALL BE PER COA STD. DWG. 2415A. SEE SHEET 2 NOTES.
- STORM DRAIN INLETS SHALL BE PER COA STD. DWG. 2201. INLET GRATES WILL BE PER COA STD. DWG. 2220.
- ALL PAVEMENT CUTS TO BE MADE PERPENDICULAR TO TRAFFIC FLOW. PAVEMENT CUTS AT CURB RADIUS WILL BE MADE RADIAL TO THE CURB.
- NOT USED THIS SHEET
- DRIVEPADS AFFECTED BY CONSTRUCTION SHALL BE RECONSTRUCTED PER COA STD. DWG. 2425.
- NOT USED THIS SHEET
- NOT USED THIS SHEET
- NOT USED THIS SHEET

AS BUILT INFORMATION

CONTRACTOR	NEW MEXICO UNDERGROUND
DATE	5/10/07
INSPECTOR	DATE 5/10/07
DESIGNED BY	DATE 5/10/07
CHECKED BY	DATE 5/10/07
RECORDED BY	DATE 5/10/07


BENCH MARKS

CITY OF ALBUQUERQUE STATION 2-K12B	DATE
BEING A 3 1/4" ALUMINUM TABLE SET IN THE TOP OF CURB AT THE SOUTHEAST QUADRANT OF CENTRAL & ATRISCO SW	DATE
COORDINATES ARE MODIFIED GROUND VALUES BASED ON NAD 27 U.S. SURVEY FEET	DATE
NORTHING=1487200.84	DATE
EASTING=370304.57	DATE
GF=0.99961630	DATE
ELEV.=4954.92	DATE

POT HOLE INFORMATION

POT HOLE # (PH)	DESCRIPTION	GROUND ELEV.	DEPTH TO TOP OF PIPE	TYPE OF MATERIAL
25	6" WATER	54.12	76"	METALLIC

SCALES:
1"=20' HORIZ.
1"= 2' VERT.

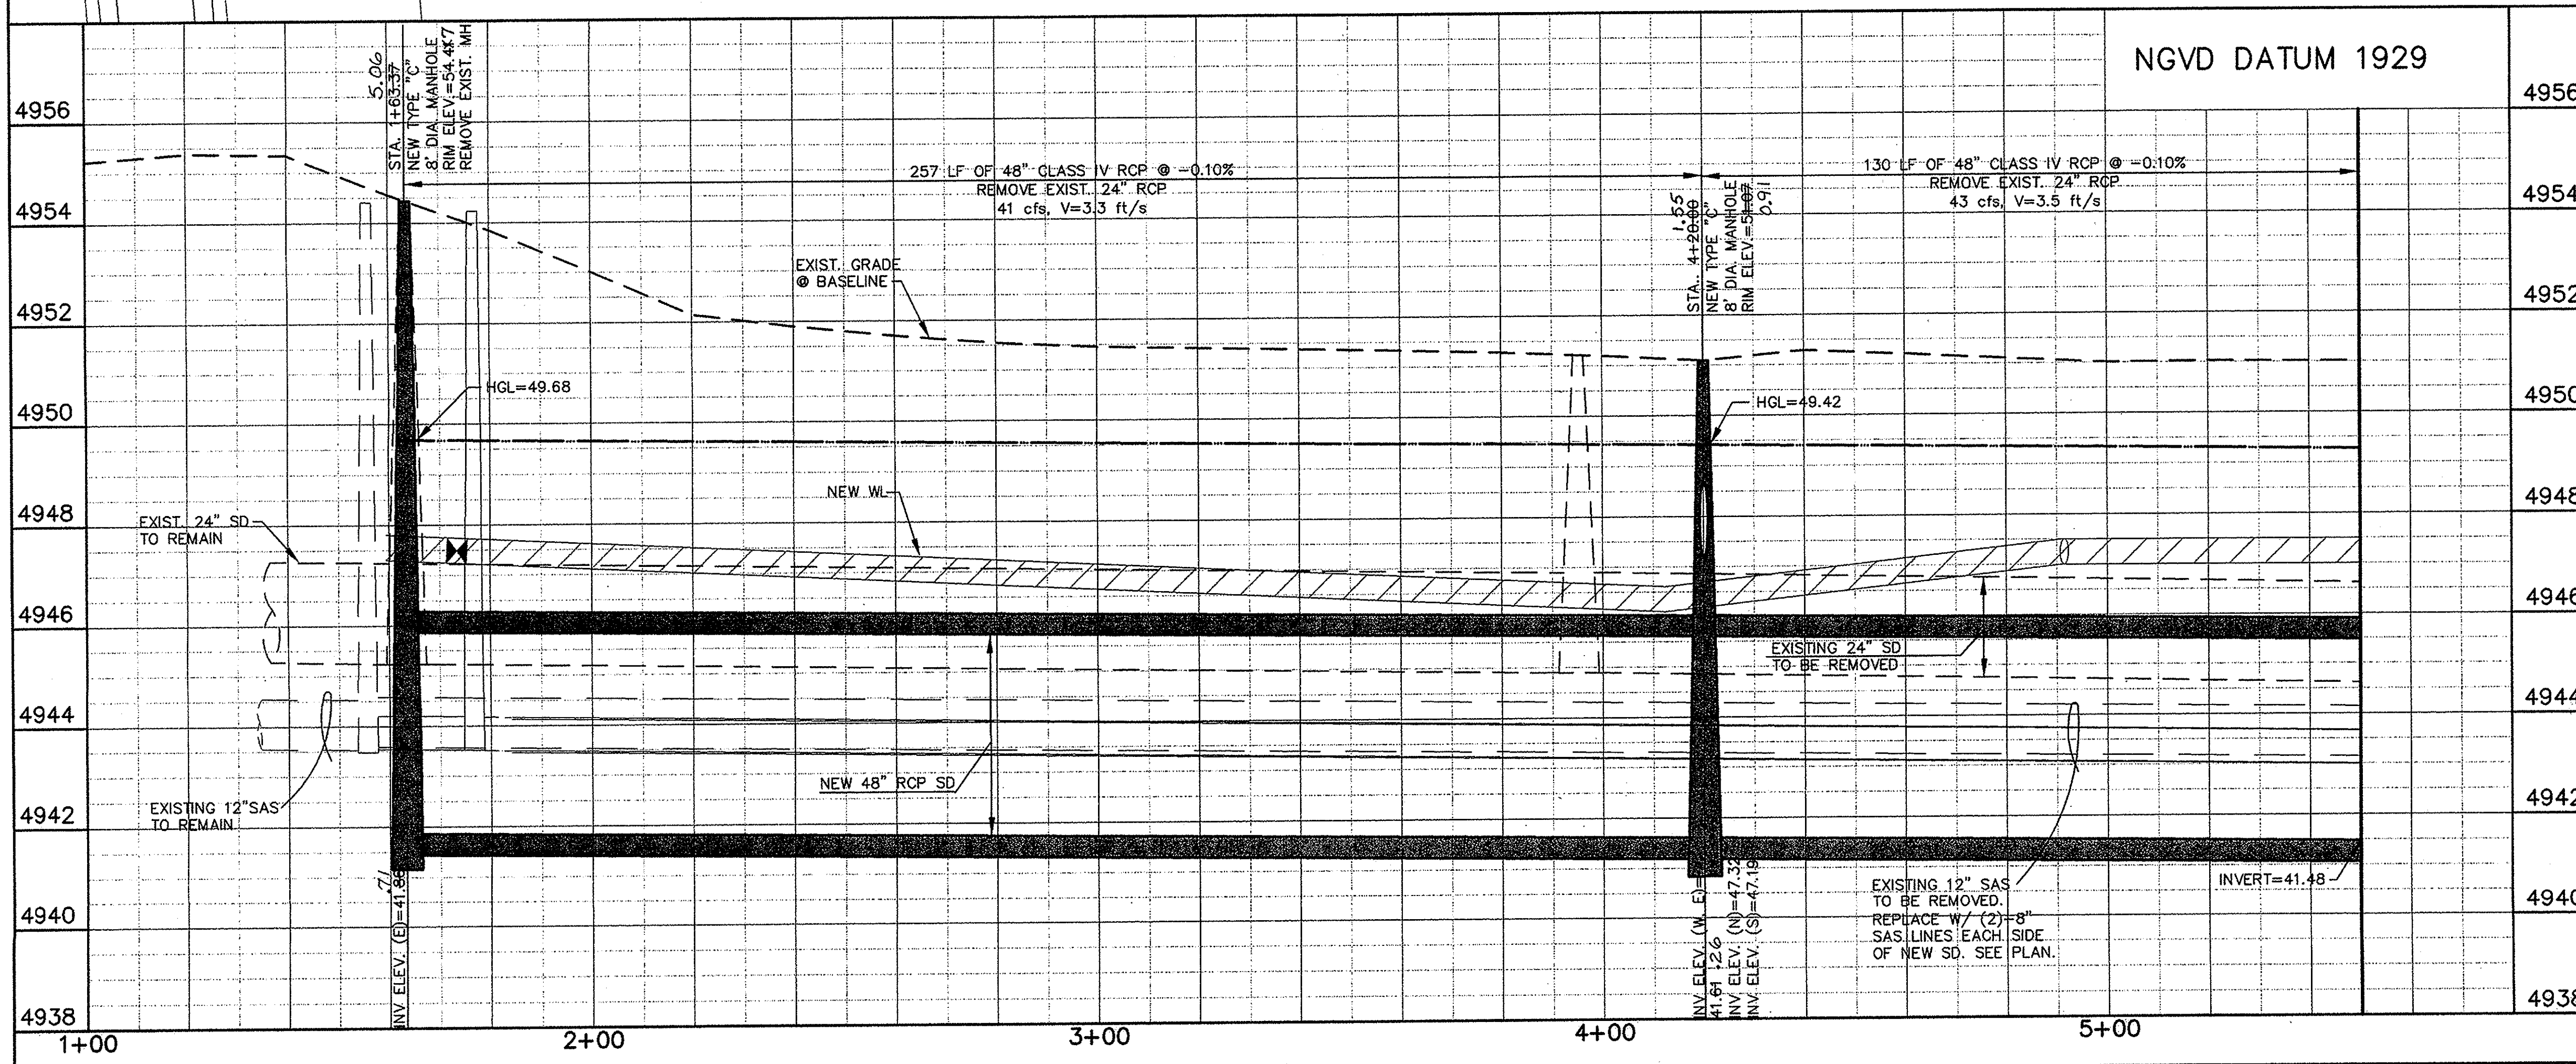

RECORD DRAWING
JUNE 2007

LARKIN GROUP
CONSULTING ENGINEERS AND SURVEYORS
8500 MENAUL BLVD, NE A-140
ALBUQUERQUE, NEW MEXICO 87112
(505) 275-7500 FAX (505) 275-0748

CITY OF ALBUQUERQUE
DEPARTMENT OF MUNICIPAL DEVELOPMENT
STORM DRAINAGE DESIGN DIVISION

TITLE: CENTRAL - ATRISCO DRAINAGE IMPROVEMENTS PHASE II
GLENDALE ROAD STA. 1+00 TO 5+50

DESIGNED BY: XX	DATE
DRAWN BY: XX	DATE
CHECKED BY: XX	DATE

NO.	DATE	REMARKS	BY
1		DESIGN	

Project No.	674903	Zone Map No.	K-11-Z	Sheet	11 of 32
-------------	--------	--------------	--------	-------	----------