


SEE SHEET 11

STA. 5+50

MATCH LINE

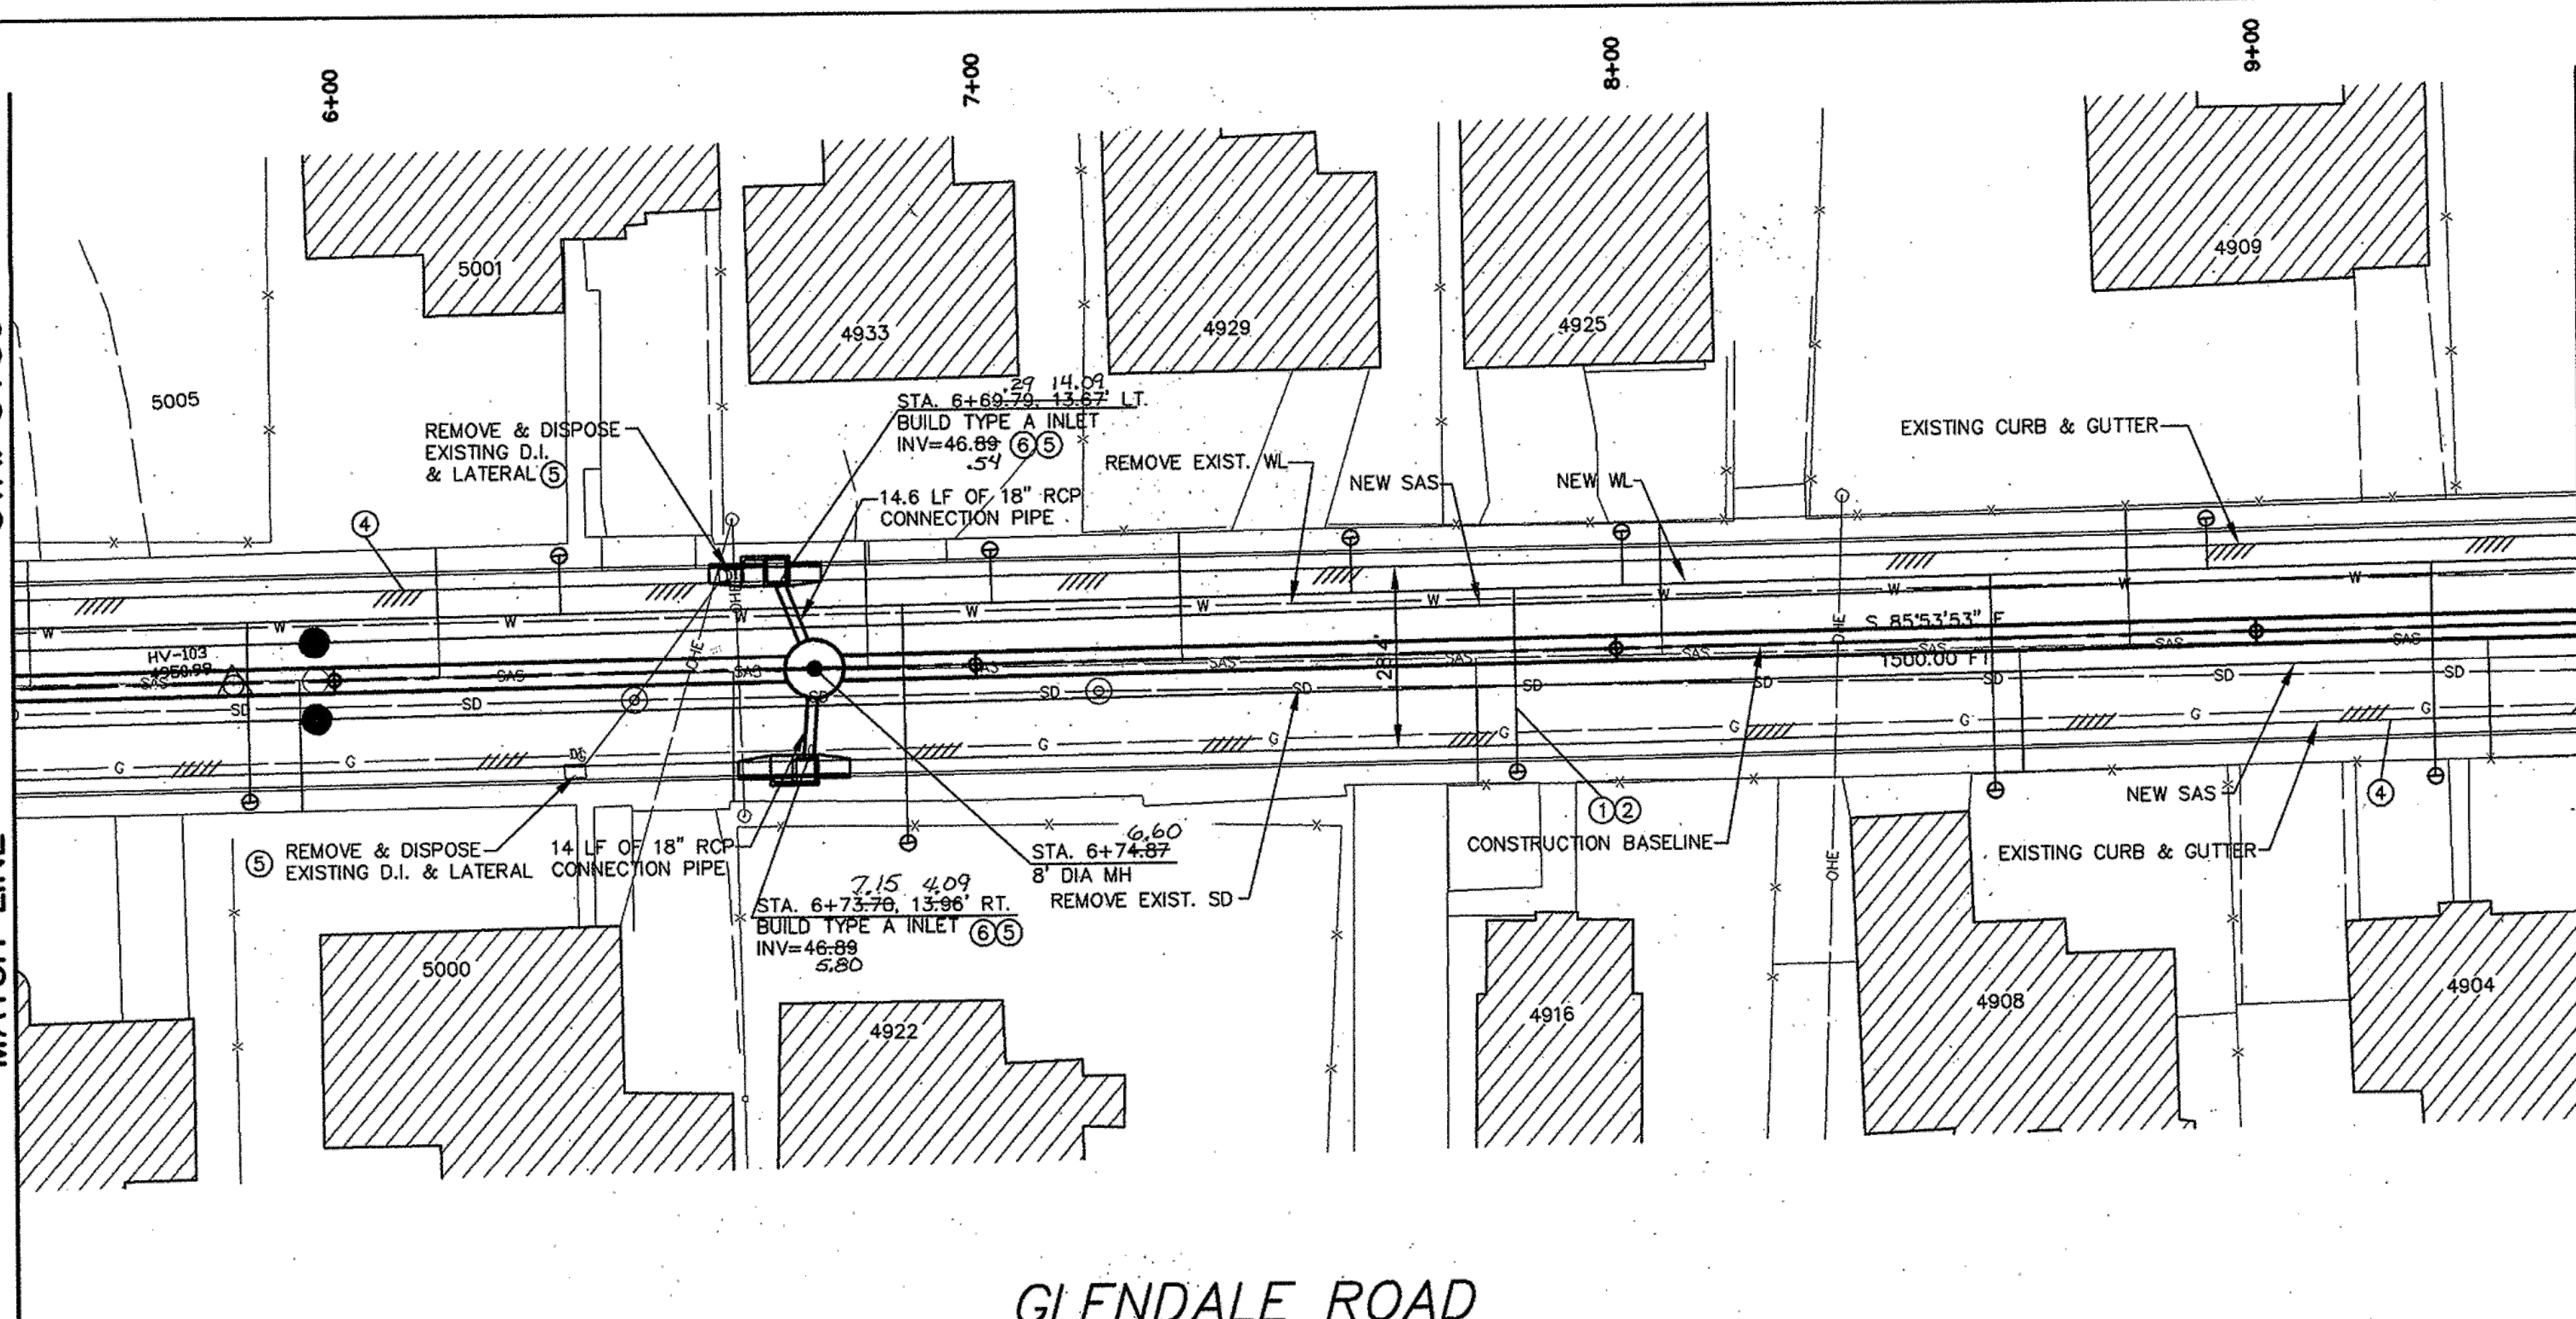

STA. 9+50


MATCH LINE

SEE SHEET 13

GLENDAL ROAD

SCALES:
1"=20' HORIZ.
1"= 2' VERT.

NGVD DATUM 1929

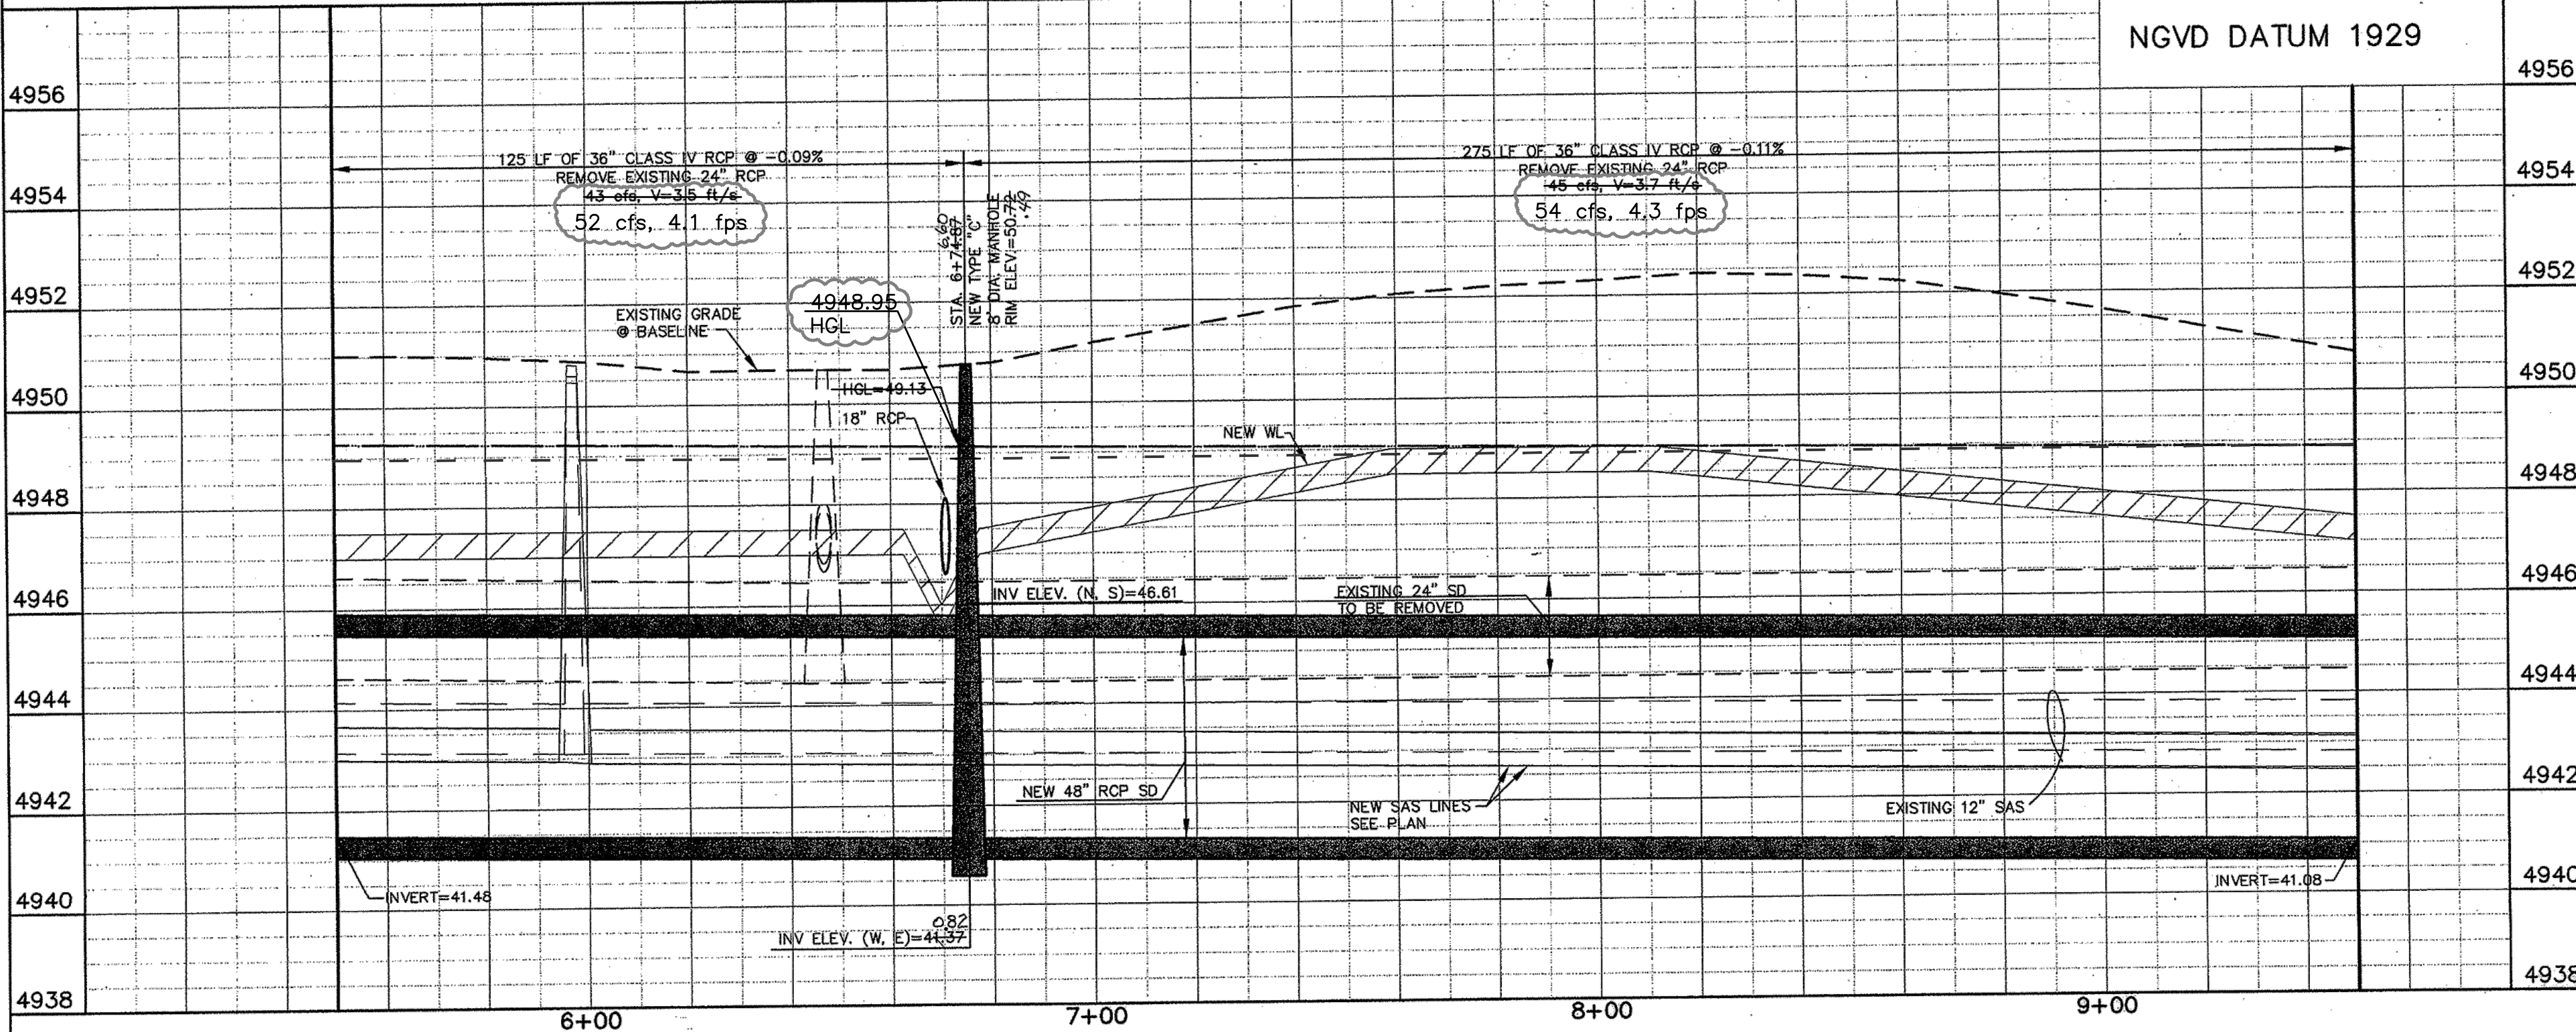

KEYED NOTES

- 1 REPLACED WATER SERVICE LINES SHALL BE REPLACED WITH COPPER TUBING WITH NO SPLICES FROM METER TO MAIN PER COA STD. DWG. 2362.
- 2 ANY EXISTING UTILITIES EXPOSED DURING CONSTRUCTION SHALL BE SUPPORTED AND PROTECTED DURING CONSTRUCTION. THIS SUPPORT AND PROTECTION SHALL BE CONSIDERED INCIDENTAL TO PROJECT CONSTRUCTION AND NO SEPARATE PAYMENT WILL BE MADE.
- 3 NOT USED THIS SHEET
- 4 MAJOR LOCAL PAVEMENT SHALL BE REPLACED PER COA STD. DWG. 2405. SEE SHEET 31.
- 5 CURB AND GUTTER REPLACEMENT SHALL BE PER COA STD. DWG. 2415A. SEE SHEET 2 NOTES.
- 6 STORM DRAIN INLETS SHALL BE PER COA STD. DWG. 2201. INLET GRATES WILL BE PER COA STD. DWG. 2220.
- 7 NOT USED THIS SHEET
- 8 NOT USED THIS SHEET
- 9 NOT USED THIS SHEET
- 10 NOT USED THIS SHEET
- 11 NOT USED THIS SHEET
- 12 NOT USED THIS SHEET
- 13 NOT USED THIS SHEET

AS BUILT INFORMATION

CONTRACTOR: New Mexico Underground
REVISIONS: 1
DATE: 5/07
BY: C.O.A.
CHECKED BY: C.O.A.
DATE: 5/07
DESIGNED BY: C.O.A.
DATE: 5/07
RECORDED BY: C.O.A.
DATE: 5/07
ELEV. = 4954.92 NGVD 29


BENCH MARKS

CITY OF ALBUQUERQUE STATION 2-K12B
BENCH MARK: 3 1/4\"/>

SURVEY INFORMATION

FIELD NOTES
NO. 1
DATE
BY

ENGINEER'S SEAL

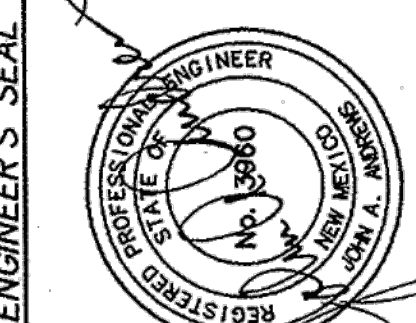

RECORD DRAWING
JUNE 2007
REV. 11/17

2002-0021-28
LARKIN GROUP
CONSULTING ENGINEERS AND SURVEYORS
3500 MENAUL BLVD., N.E. #140
ALBUQUERQUE, NEW MEXICO 87112
(505) 275-7500 FAX (505) 275-0740

CITY OF ALBUQUERQUE
DEPARTMENT OF MUNICIPAL DEVELOPMENT
STORM DRAINAGE DESIGN DIVISION

TITLE: **CENTRAL - ATRISCO DRAINAGE IMPROVEMENTS PHASE II**
GLENDAL ROAD STA. 5+50 TO 9+50

DESIGN REVIEW COMMITTEE
APPROVED
JUN 08 2007
CITY ENGINEER

Project No. 674903
Zone Map No. K-11-Z
Sheet 12 of 32