



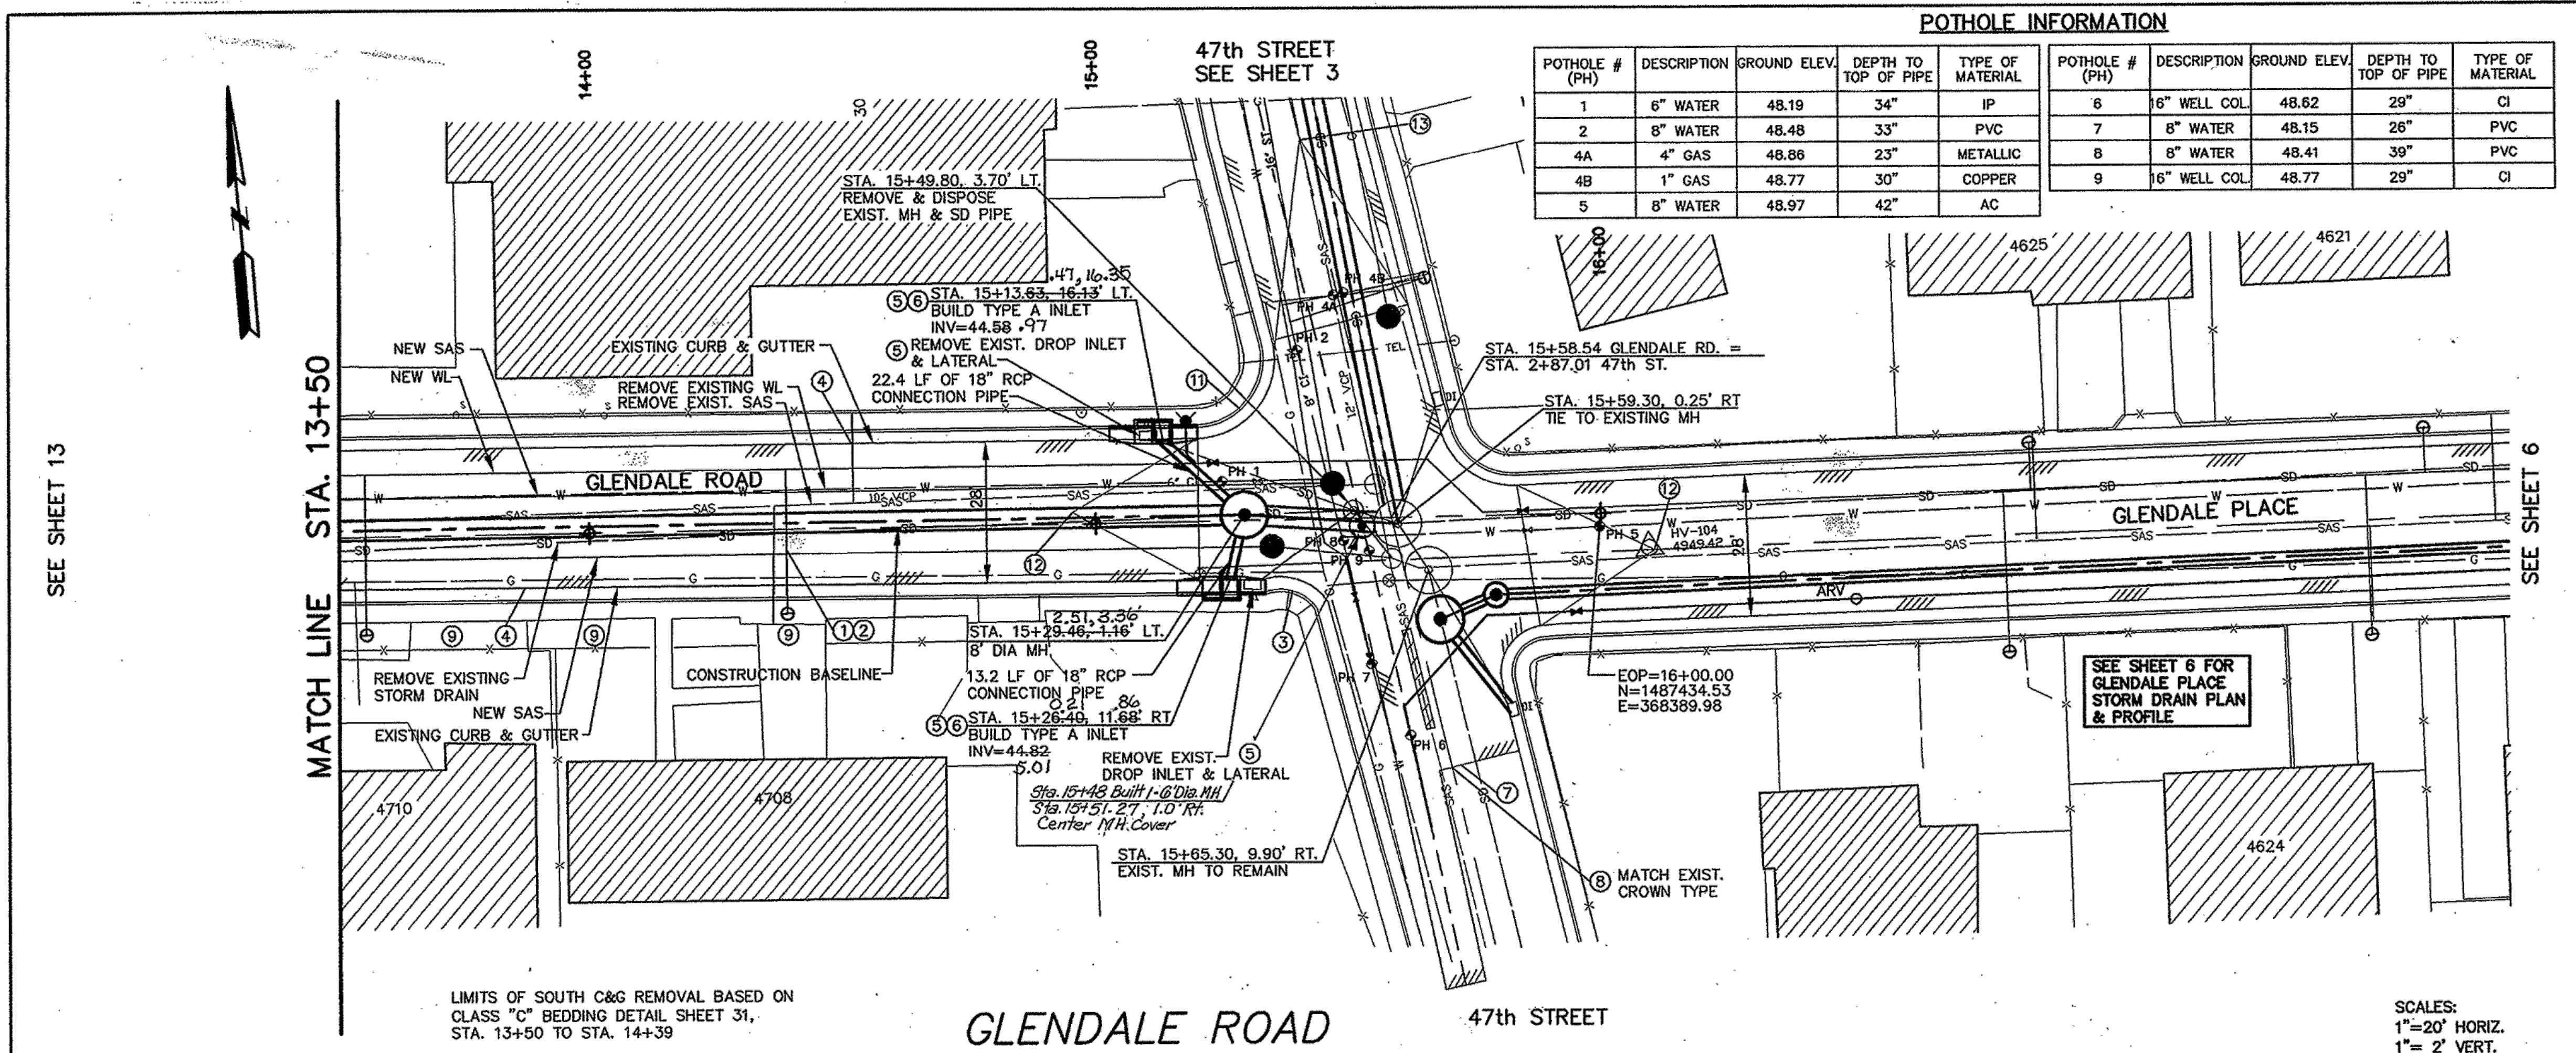

POT HOLE INFORMATION					POT HOLE INFORMATION				
POT HOLE #	DESCRIPTION	GROUND ELEV.	DEPTH TO TOP OF PIPE	TYPE OF MATERIAL	POT HOLE #	DESCRIPTION	GROUND ELEV.	DEPTH TO TOP OF PIPE	TYPE OF MATERIAL
1	6" WATER	48.19	34"	IP	6	6" WELL COL	48.62	29"	CI
2	8" WATER	48.48	33"	PVC	7	8" WATER	48.15	26"	PVC
4A	4" GAS	48.86	23"	METALLIC	8	8" WATER	48.41	39"	PVC
4B	1" GAS	48.77	30"	COPPER	9	6" WELL COL	48.77	29"	CI
5	8" WATER	48.97	42"	AC					

- KEYED NOTES**
- REPLACED WATER SERVICE LINES SHALL BE REPLACED WITH COPPER TUBING WITH NO SPLICES FROM METER TO MAIN PER COA STD. DWG. 2362.
 - ANY EXISTING UTILITIES EXPOSED DURING CONSTRUCTION SHALL BE SUPPORTED AND PROTECTED DURING CONSTRUCTION. THIS SUPPORT AND PROTECTION SHALL BE CONSIDERED INCIDENTAL TO PROJECT CONSTRUCTION AND NO SEPARATE PAYMENT WILL BE MADE.
 - THE DISTURBANCE OF ANY EXISTING WHEELCHAIR RAMP DURING CONSTRUCTION SHALL REQUIRE THE REPLACEMENT OF THE ENTIRE WHEELCHAIR RAMP PER COA STD. DWG. 2441, CASE I, OR CASE II WITH HEADER CURB USING TRUNCATED DOMES, DETECTABLE SURFACE, ON SURFACE.
 - MAJOR LOCAL PAVEMENT SHALL BE REPLACED PER COA STD. DWG. 2405. SEE SHEET 31.
 - CURB AND GUTTER REPLACEMENT SHALL BE PER COA STD. DWG. 2415A. SEE SHEET 2 NOTES.
 - STORM DRAIN INLETS SHALL BE PER COA STD. DWG. 2201. INLET GRATES WILL BE PER COA STD. DWG. 2220.
 - ALL PAVEMENT CUTS TO BE MADE PERPENDICULAR TO TRAFFIC FLOW. PAVEMENT CUTS AT CURB RADIUS WILL BE MADE RADIAL TO THE CURB.
 - PAVEMENT CROWN TRANSITIONS SHALL BE PER COA STD. DWG. 2401.
 - DRIVEPADS AFFECTED BY CONSTRUCTION SHALL BE RECONSTRUCTED PER COA STD. DWG. 2425.
 - NOT USED THIS SHEET
 - INSTALL WHEEL CHAIR RAMP PER COA STD. DWG. 2441, CASE I, OR CASE II WITH HEADER CURB USING TRUNCATED DOMES, DETECTABLE SURFACE, ON SURFACE.
 - 25' HALF CROWN TRANSITION PER COA STD. DWG. 2401.
 - 50' FULL CROWN TRANSITION PER COA STD. DWG. 2401.

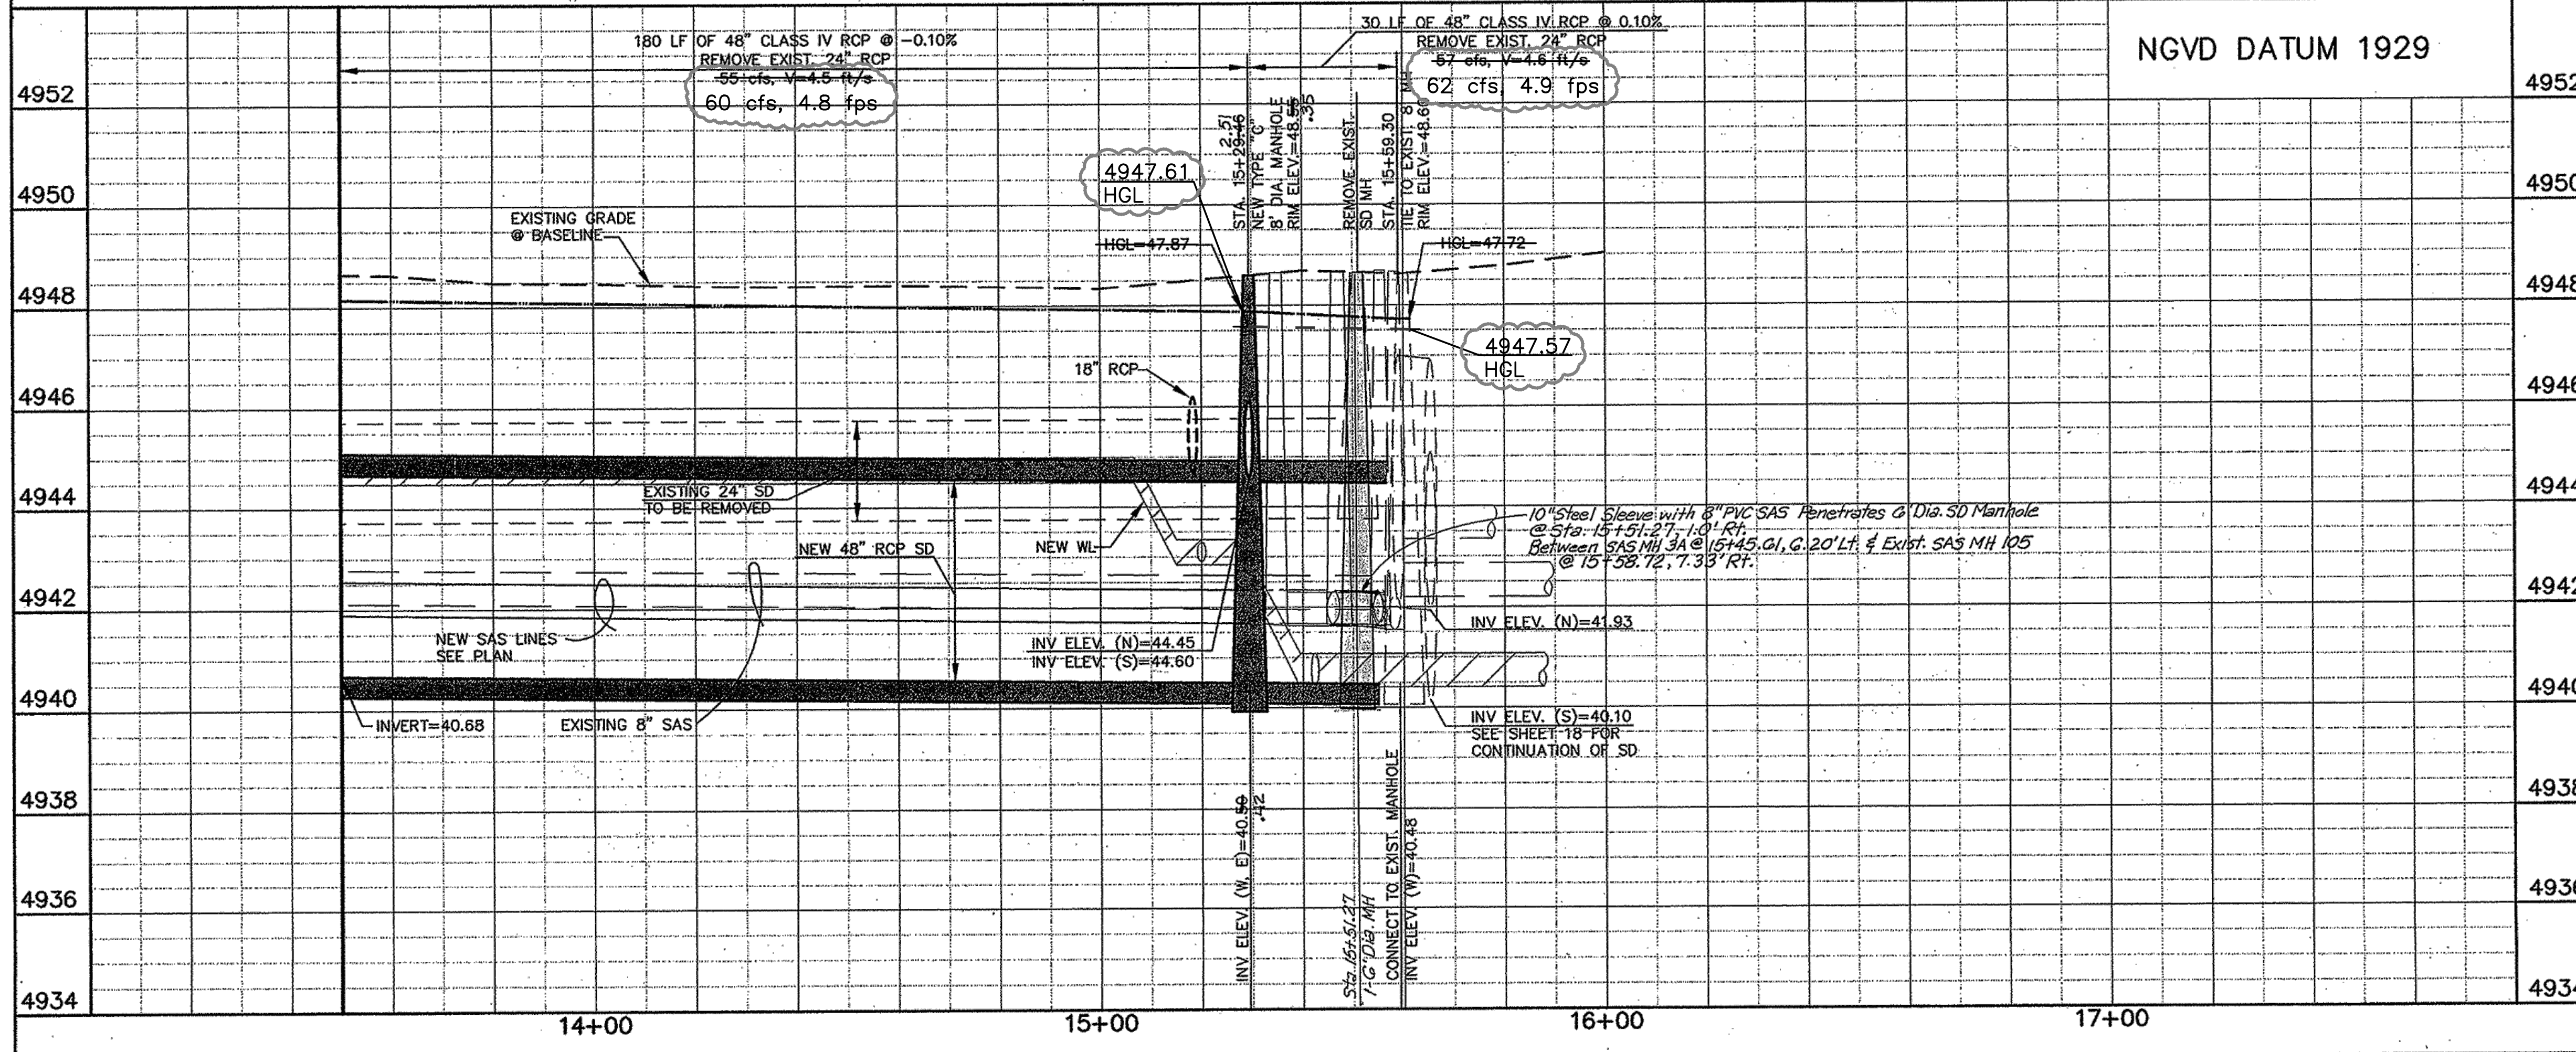

RECORD DRAWING
JUNE 2007
REV.11/17

2002-0021-28
LARKIN GROUP
CONSULTING ENGINEERS AND SURVEYORS
2500 MENAUL BLVD., NE A-440
ALBUQUERQUE, NEW MEXICO 87112
(505) 275-7500 FAX (505) 275-0748

CITY OF ALBUQUERQUE
DEPARTMENT OF MUNICIPAL DEVELOPMENT
STORM DRAINAGE DESIGN DIVISION

TITLE: **CENTRAL - ATRISCO DRAINAGE IMPROVEMENTS PHASE II**
GLENDALE ROAD STA 13+50 TO 16+00

DESIGN REVIEW COMMITTEE
APPROVED JUN 08 2006
DESIGN REVIEW COMMITTEE

CITY ENGINEER
APPROVED JUN 08 2006
CITY ENGINEER

Project No. 674903 Zone Map No. K-12-Z Sheet 14 OF 32

SEE SHEET 13

MATCH LINE STA. 13+50

SEE SHEET 6