

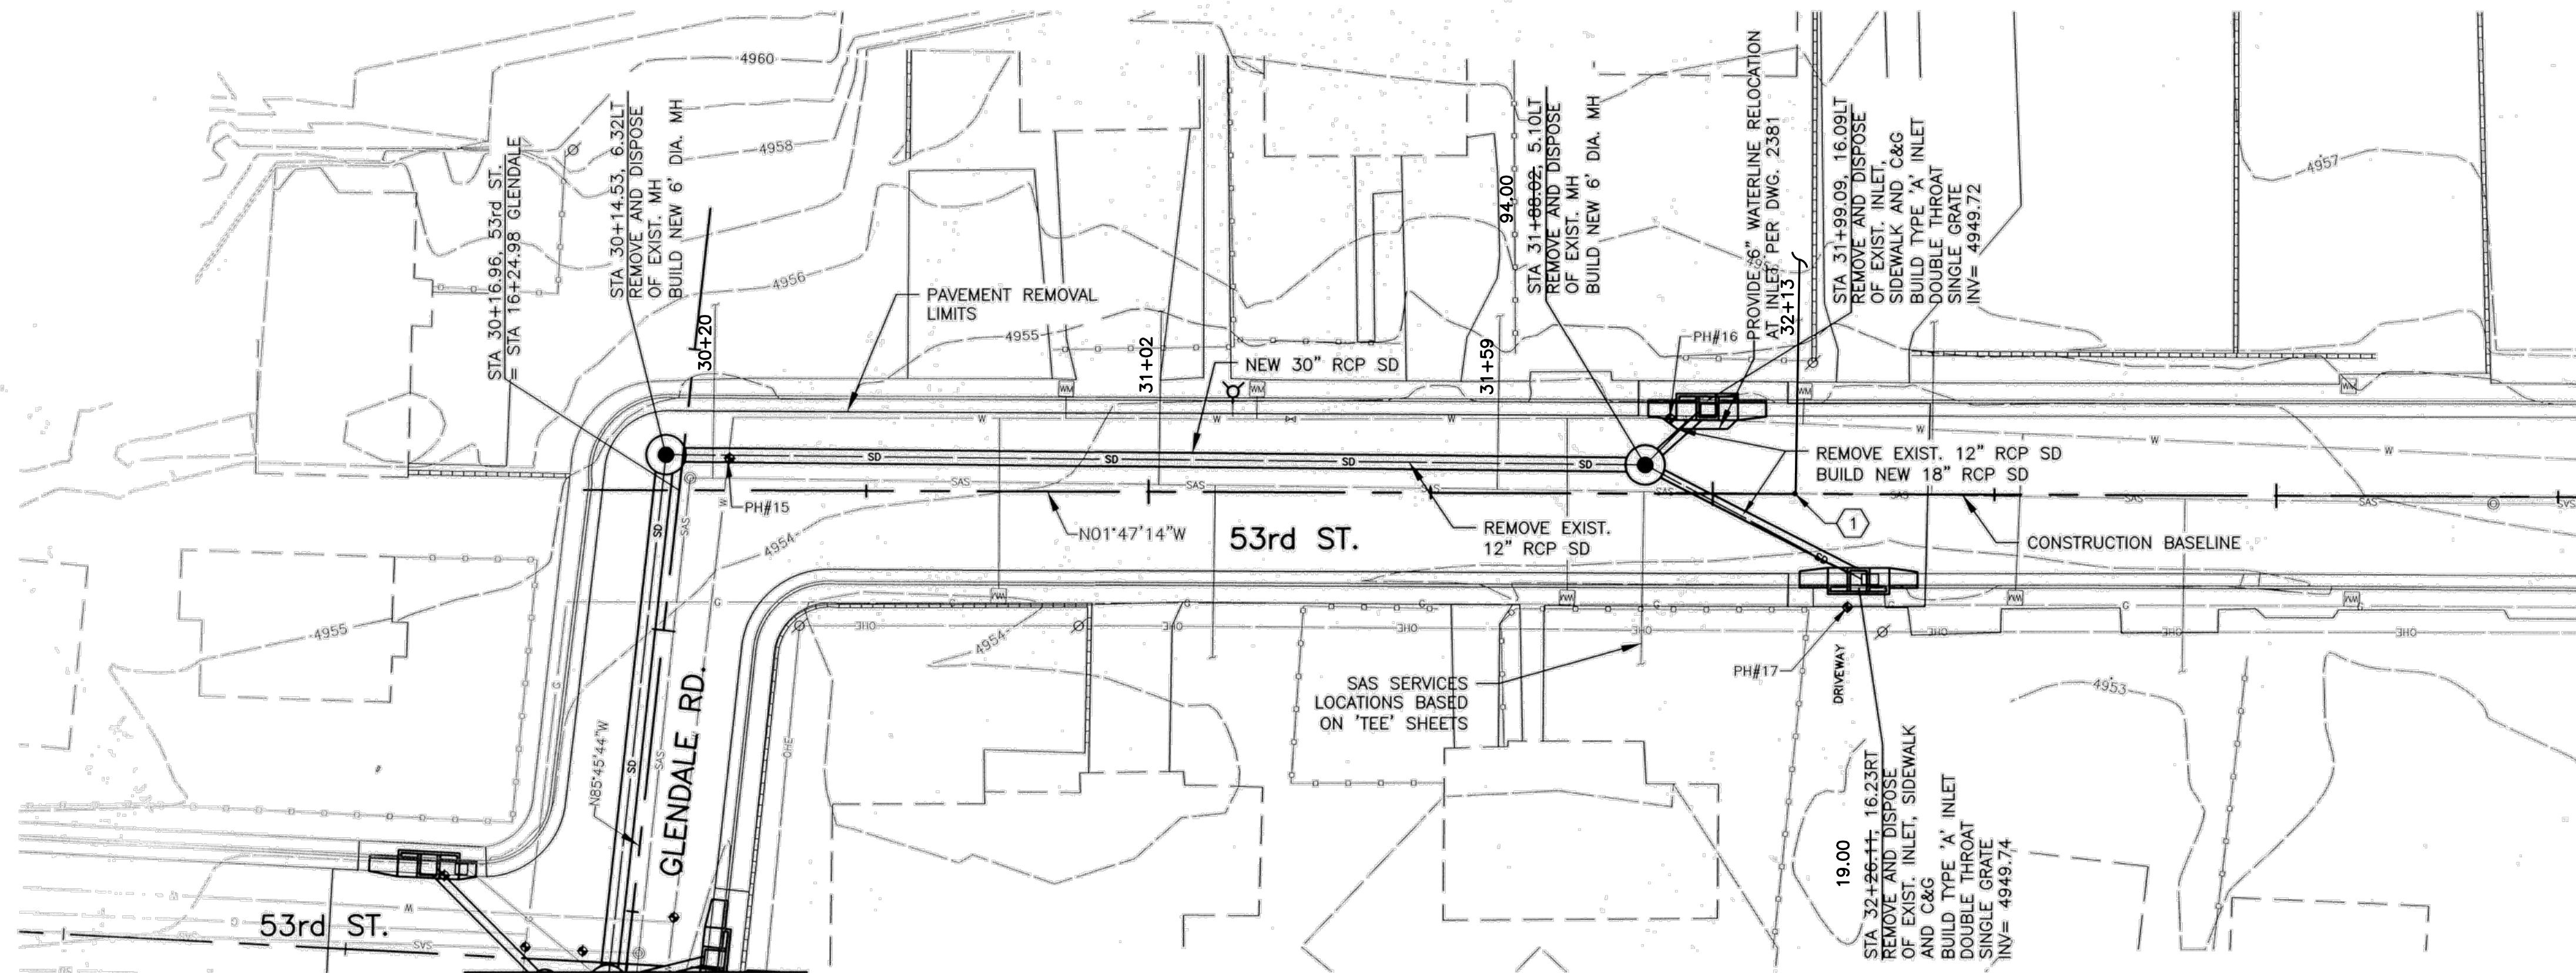


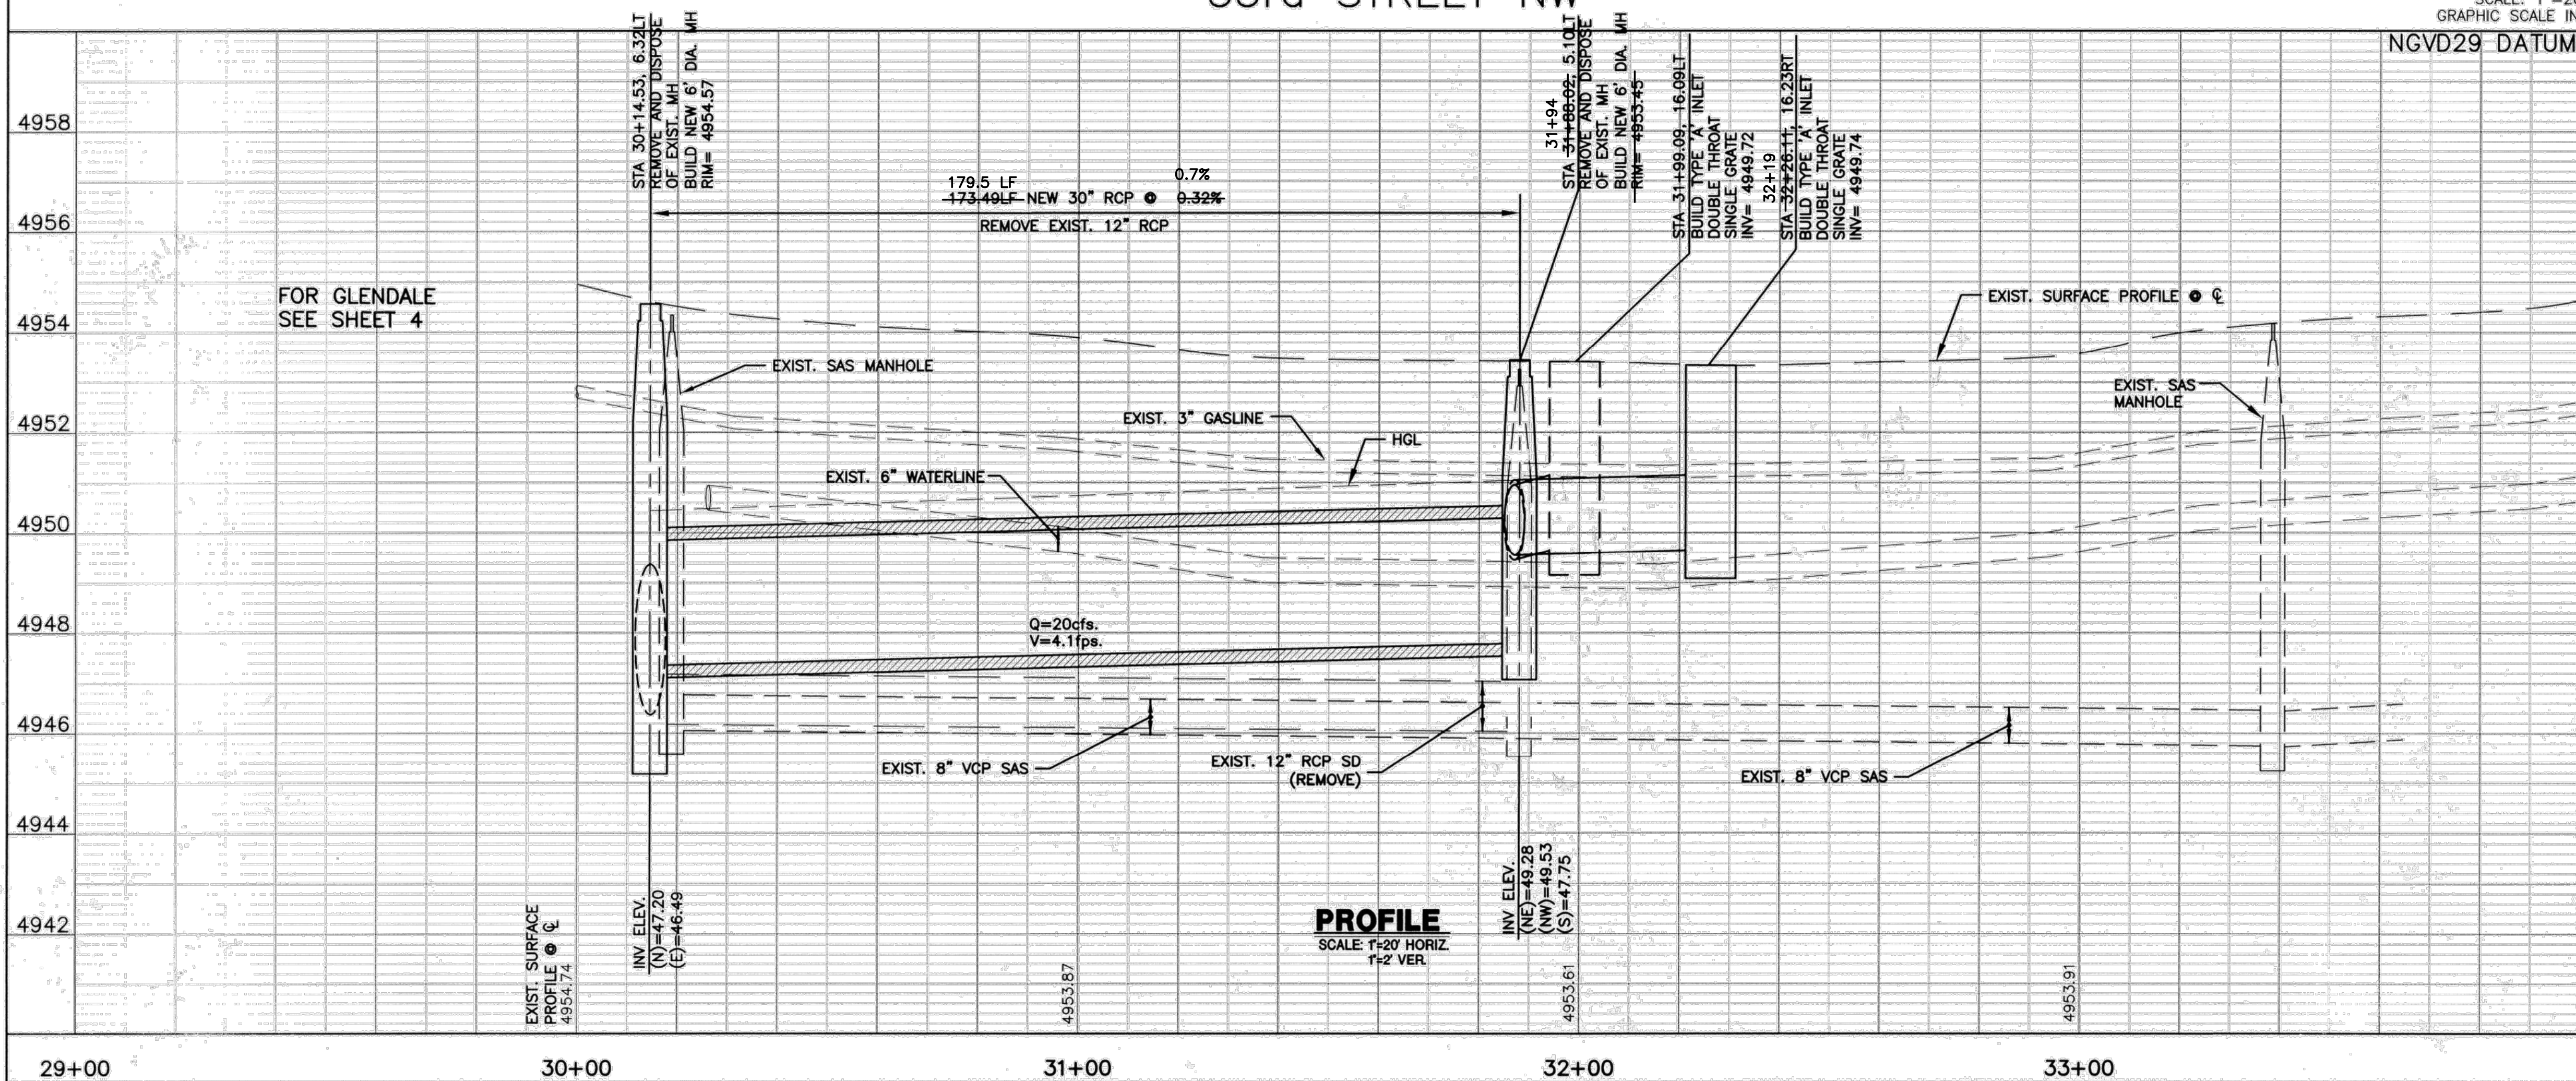

FOR GLENDALE
SEE SHEET 4

PLAN
SCALE: 1"=20'
53rd STREET NW

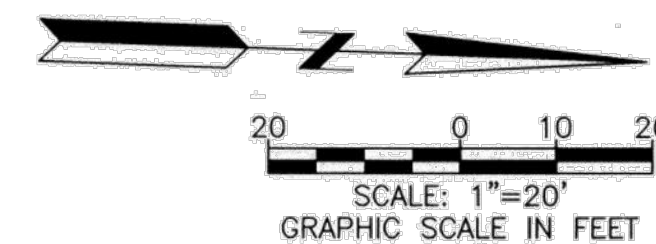

PROFILE
SCALE: 1"=20' HORIZ.
1"=2' VER.

KEYED NOTES

- ① 8" VCP SERVICE TO VCP MAIN
REPAIR PER DETAIL SHEET 11.

POTHOLE INFORMATION

POTHOLE # (PH)	TYPE & MATERIAL	GROUND ELEV.	DEPTH TO TOP OF PIPE
15	WATER/COATED STEEL	4954.72	39"
16	WATER/PVC	4953.38	46"
17	GAS/POLY	4953.78	32"

* PIPE SIZES & TYPES ARE BEST ESTIMATE
TO BE CONFIRMED BY CONTRACTOR.

NOTES

- A. ANY WATER SERVICE LINES THAT NEED TO BE REPLACED SHALL BE REPLACED WITH COPPER TUBING AND NO SPLICES FROM METER TO MAIN. AS PER COA STD DWG. 2362
- B. ANY EXISTING UTILITIES EXPOSED DURING CONSTRUCTION SHALL BE SUPPORTED AND PROTECTED DURING CONSTRUCTION. THIS SUPPORT AND PROTECTION SHALL BE CONSIDERED INCIDENTAL TO PROJECT CONSTRUCTION AND NO SEPARATE PAYMENT WILL BE MADE.
- C. THE DISTURBANCE OF ANY EXISTING WHEELCHAIR RAMP DURING CONSTRUCTION WILL REQUIRE THE REPLACEMENT OF THE ENTIRE WHEELCHAIR RAMP. AS PER COA STD DWG 2441. CASE I, OR CASE II WITH HEADER CURB.
- D. RESIDENTIAL PAVEMENT WILL BE REPLACED AS PER COA STD DWG 2465 (RESIDENTIAL).
- E. CURB AND GUTTER WILL BE REPLACED AS PER COA STD DWG 2451A.
- F. STORM DRAIN INLETS WILL BE AS PER COA STD DWG 2201. WITH GRATES AS PER COA STD DWG 2220.
- G. ALL PAVEMENT CUTS TO BE MADE PERPENDICULAR TO TRAFFIC FLOW. PAVEMENT CUTS AT A CURB RADIUS WILL BE MADE RADIAL TO THE CURB.
- H. SIDEWALKS WILL BE REPLACED AS PER COA STD DWG 2430.
- I. DISTURBED DRIVEPADS WILL BE REPLACED AS PER COA STD DWG 2425.
- J. ALL RCP SHALL BE CLASS IV UNLESS OTHERWISE NOTED.

RECORD DRAWING
APRIL 2017



CITY OF ALBUQUERQUE
DEPARTMENT OF MUNICIPAL DEVELOPMENT
ENGINEERING DIVISION
TITLE: **CENTRAL-ATRISCO DRAINAGE
IMPROVEMENTS PHASE III**
53rd STREET
STA 30+00 TO 33+00

Design Review Committee	City Engineer Approval	Mo./Day/Yr.	Mo./Day/Yr.
APPROVED	APPROVED		
Project No.	Zone Map No.	Sheet	of

6749.04 K-11,J-11 7 of 14

DRAINAGE BASE III				ENGINEER'S SEAL				SURVEY INFORMATION				BENCH MARKS				AS BUILT INFORMATION			
DATE OF MEASUREMENT				NO.				BY				DATE				CONTRACTOR			
REMARKS				BY				DATE				STATION IS LOCATED IN MEDIAN OF CENTRAL AVE., WEST OF 59th STREET. THE STATION IS A NMHC BRASS DISC SET FLUSH IN THE TOP OF A CONC. POST AND IS STAMPED "NM448-C1"				WORK STAGED BY			
NO.				DATE				DATE				FIELD NOTES				RECORDED BY			
DESIGNED BY: JAA				DATE: AUG. 2015				DATE				DRAWINGS				DATE			
DRAWN BY: CAJL				DATE: AUG. 2015				DATE				CORRECTED BY				DATE			
CHECKED BY: JAA				DATE: AUG. 2015				DATE				NEW MEXICO STATE PLANE COORD. CENTRAL ZONE X=364,764.30, Y=1485275.17, (NAD 27) ELEVATION= 5074.028 (NGVD 29)				RECORDED BY			
REVISIONS				PROJECT G-G FACTOR: 0.999681630				DATE				MICRO-FILM INFORMATION				DATE			
NO.				DATE				DATE				RECORDED BY				DATE			
BY				DATE				DATE				RECORDED BY				DATE			
REMARKS				DATE				DATE				RECORDED BY				DATE			
DESIGNED BY: JAA				DATE: AUG. 2015				DATE				RECORDED BY				DATE			
DRAWN BY: CAJL				DATE: AUG. 2015				DATE				RECORDED BY				DATE			
CHECKED BY: JAA				DATE: AUG. 2015				DATE				RECORDED BY				DATE			
REVISIONS				PROJECT G-G FACTOR: 0.999681630				DATE				MICRO-FILM INFORMATION				DATE			
NO.				DATE				DATE				RECORDED BY				DATE			
BY				DATE				DATE				RECORDED BY				DATE			
REMARKS				DATE				DATE				RECORDED BY				DATE			
DESIGNED BY: JAA				DATE: AUG. 2015				DATE				RECORDED BY				DATE			
DRAWN BY: CAJL																			