

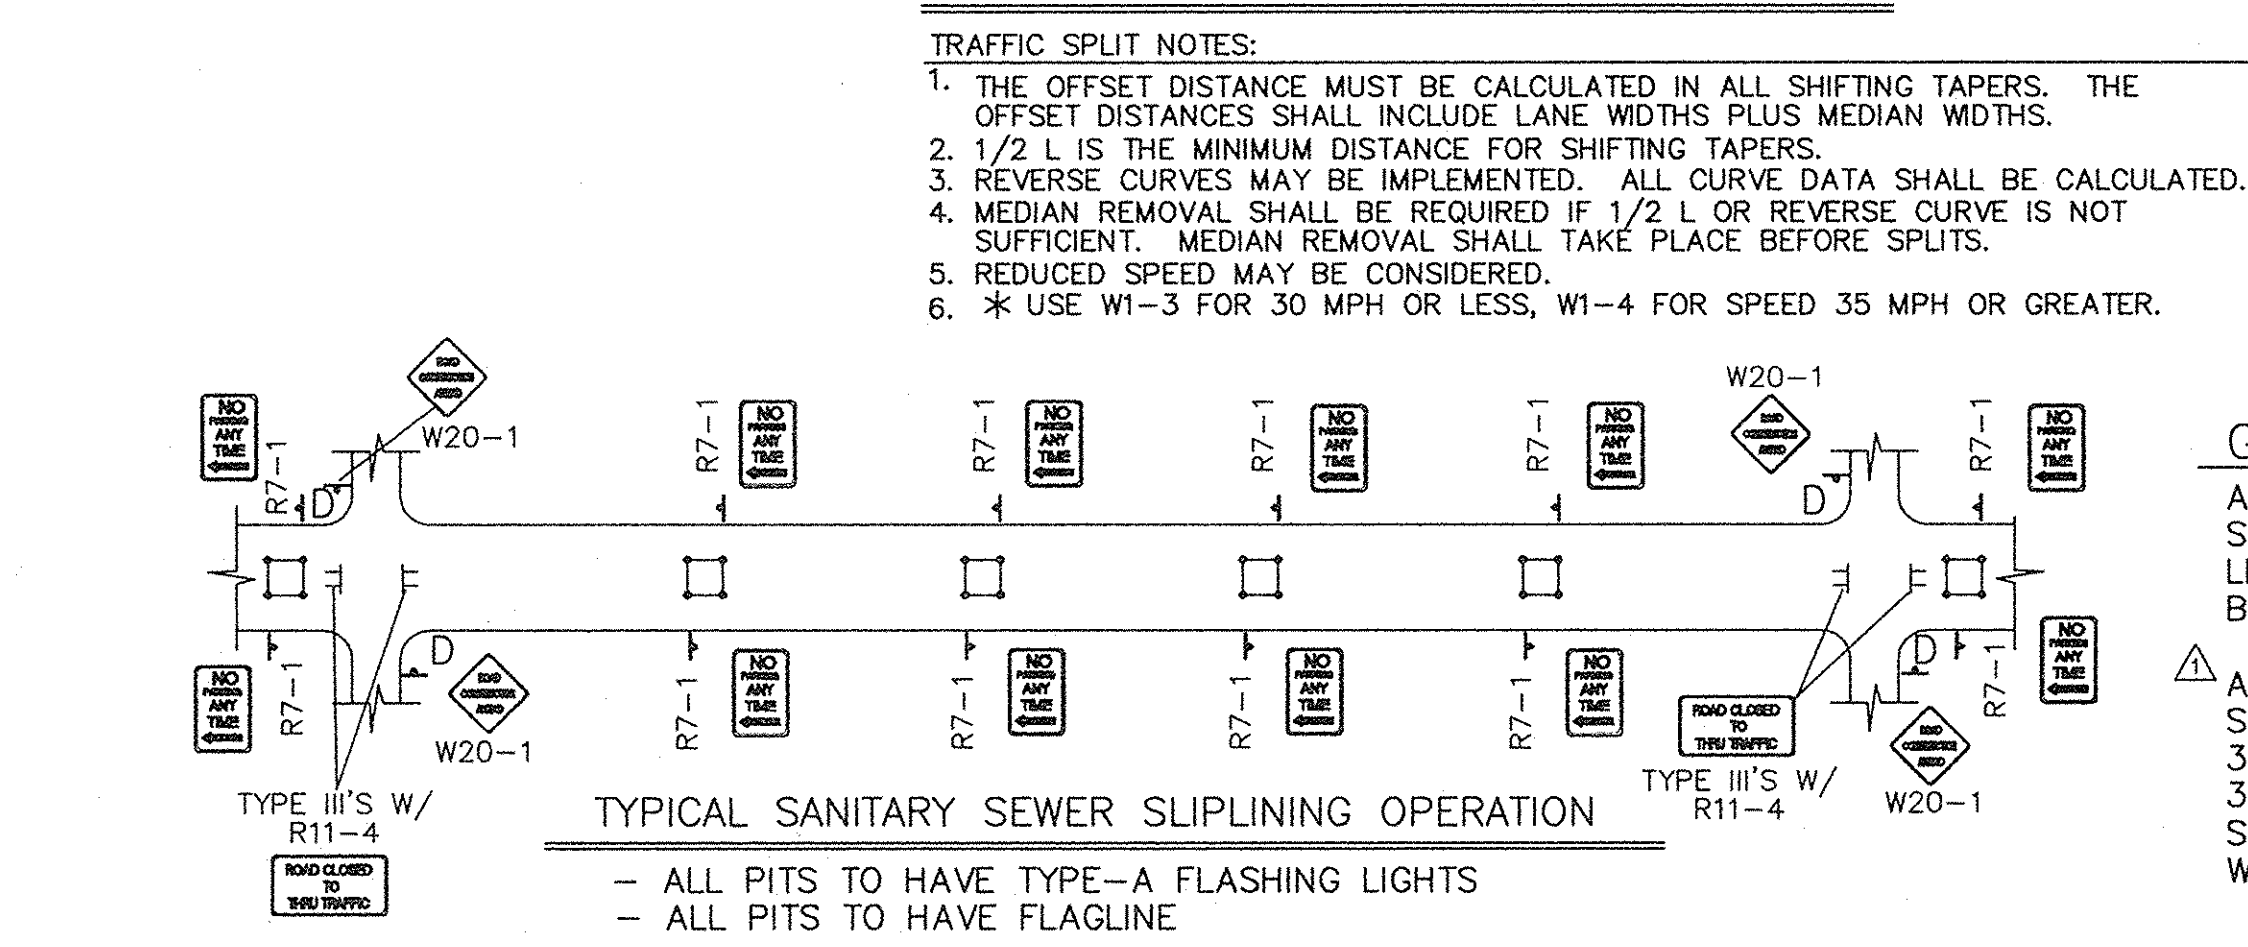
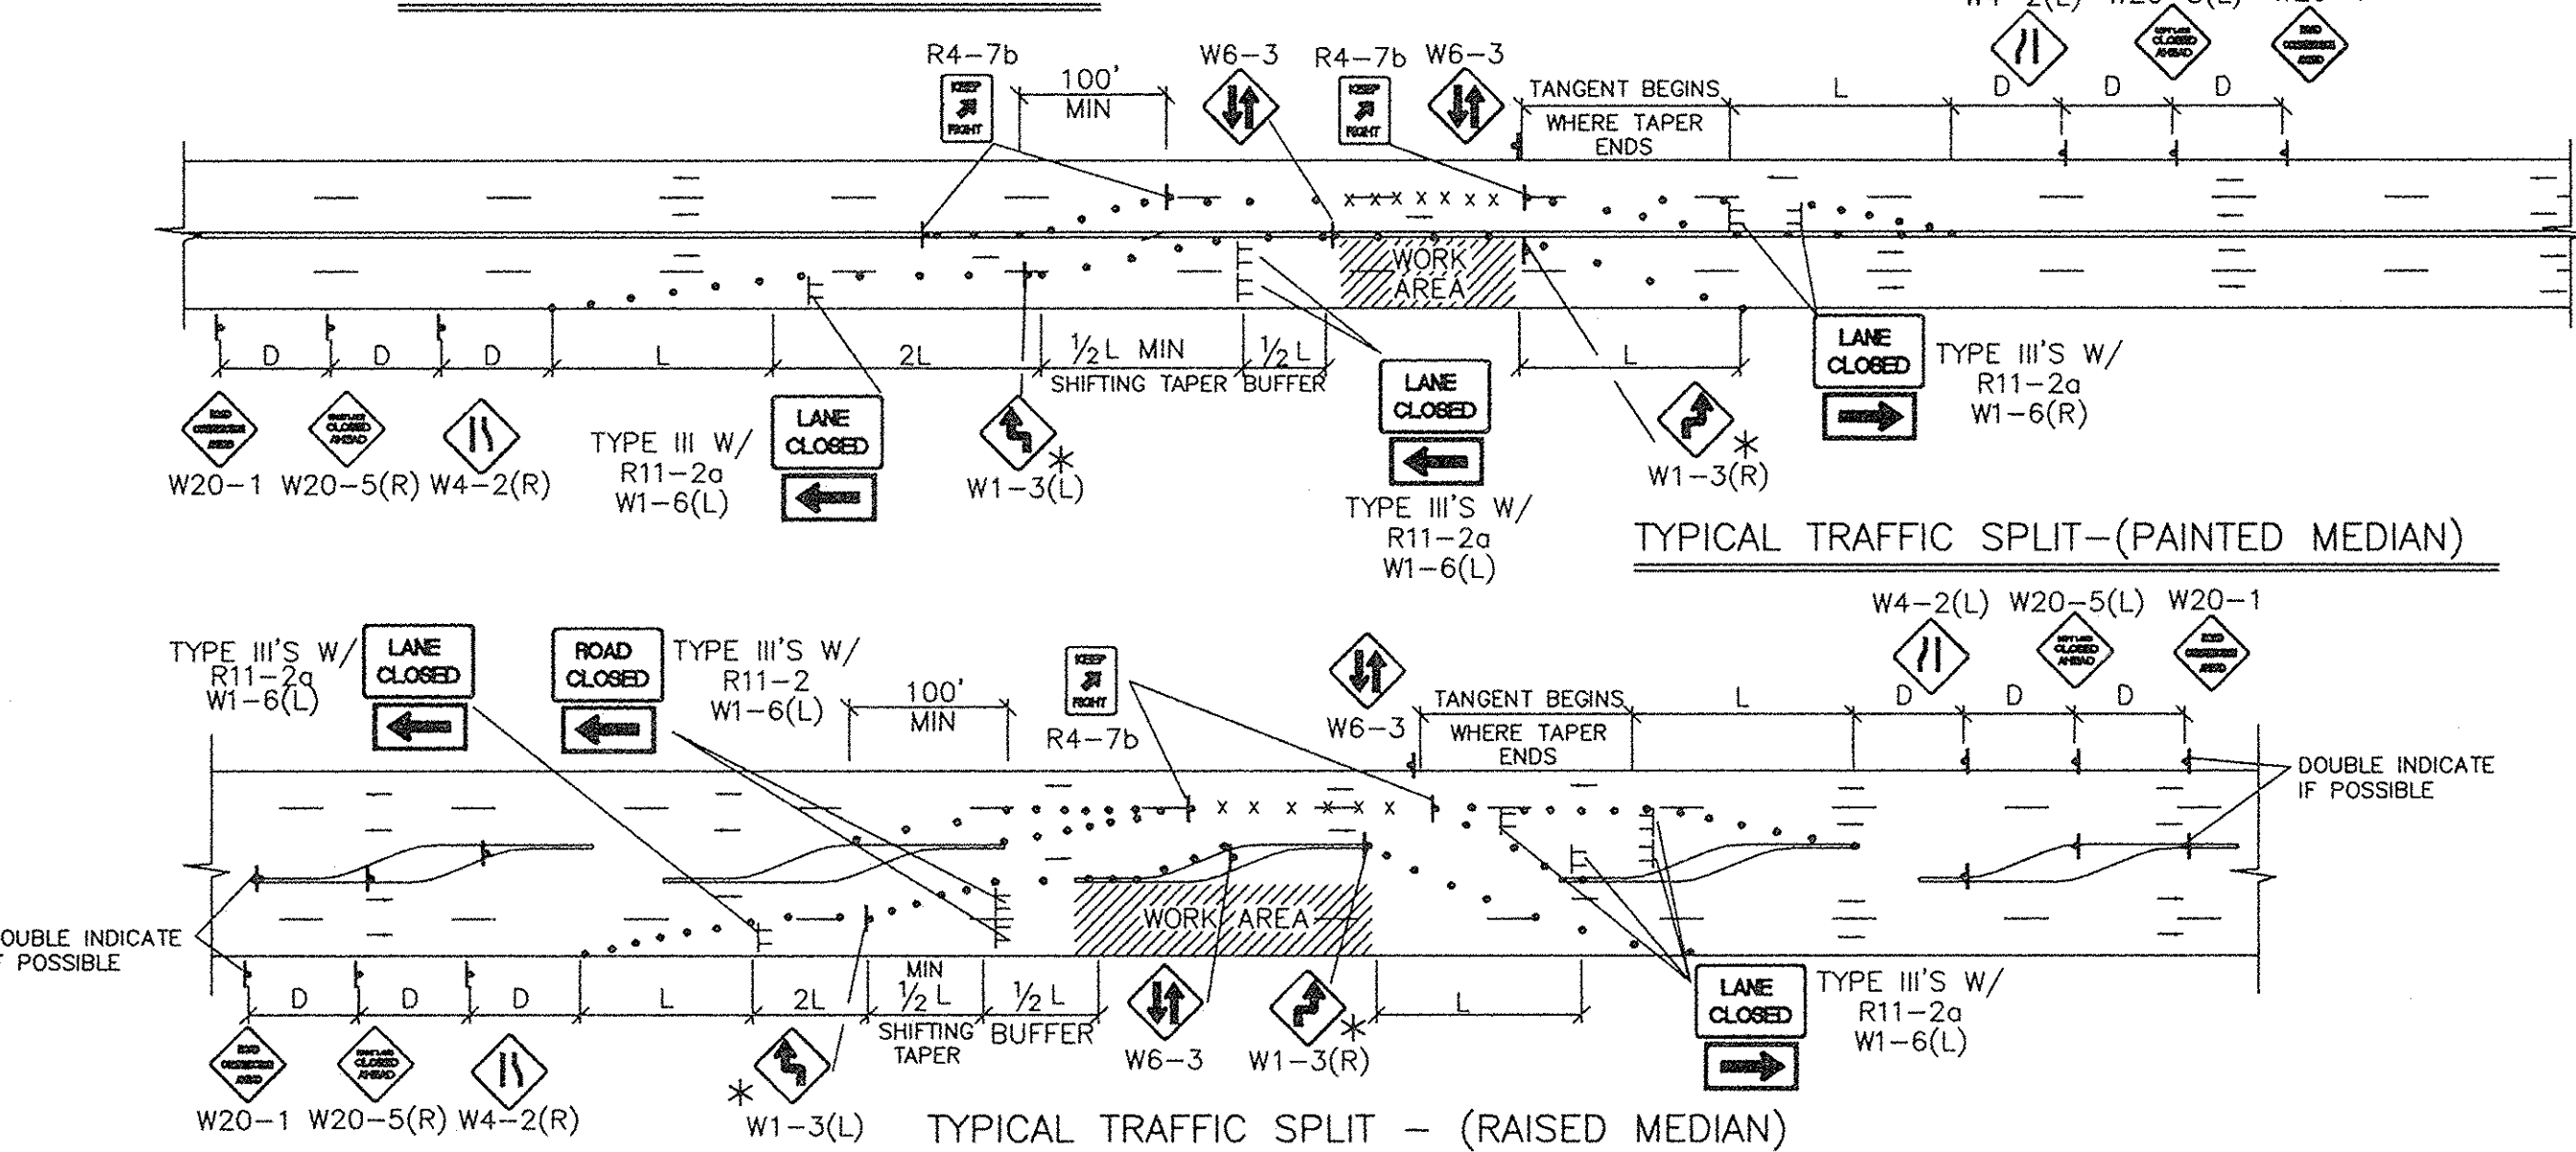
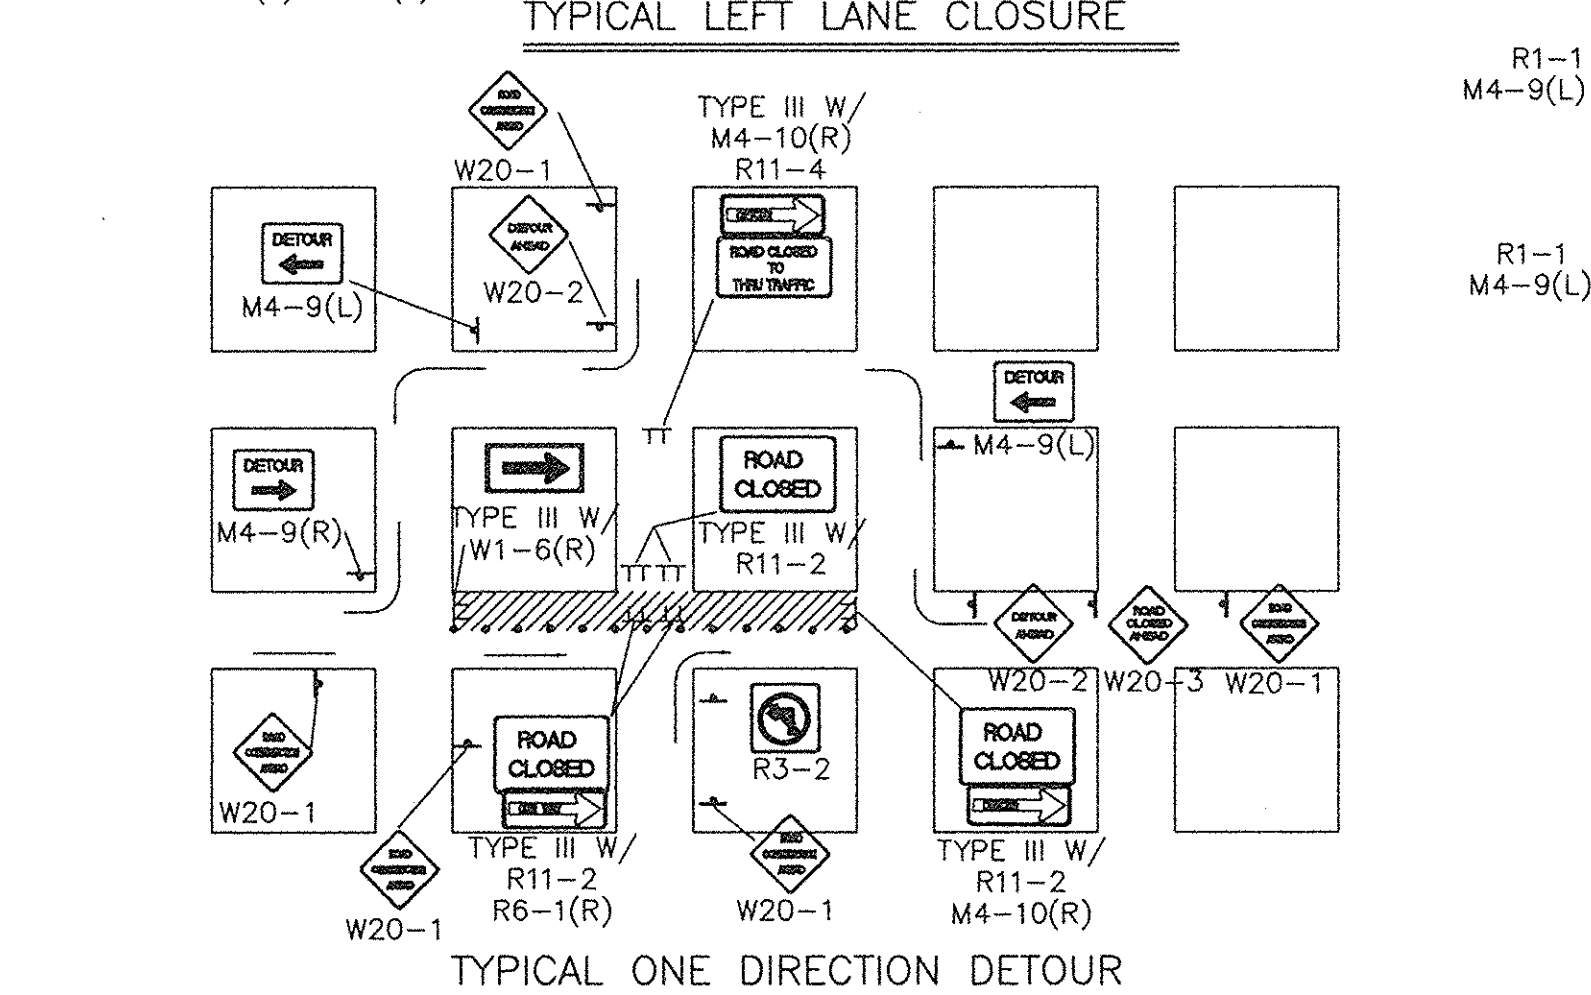
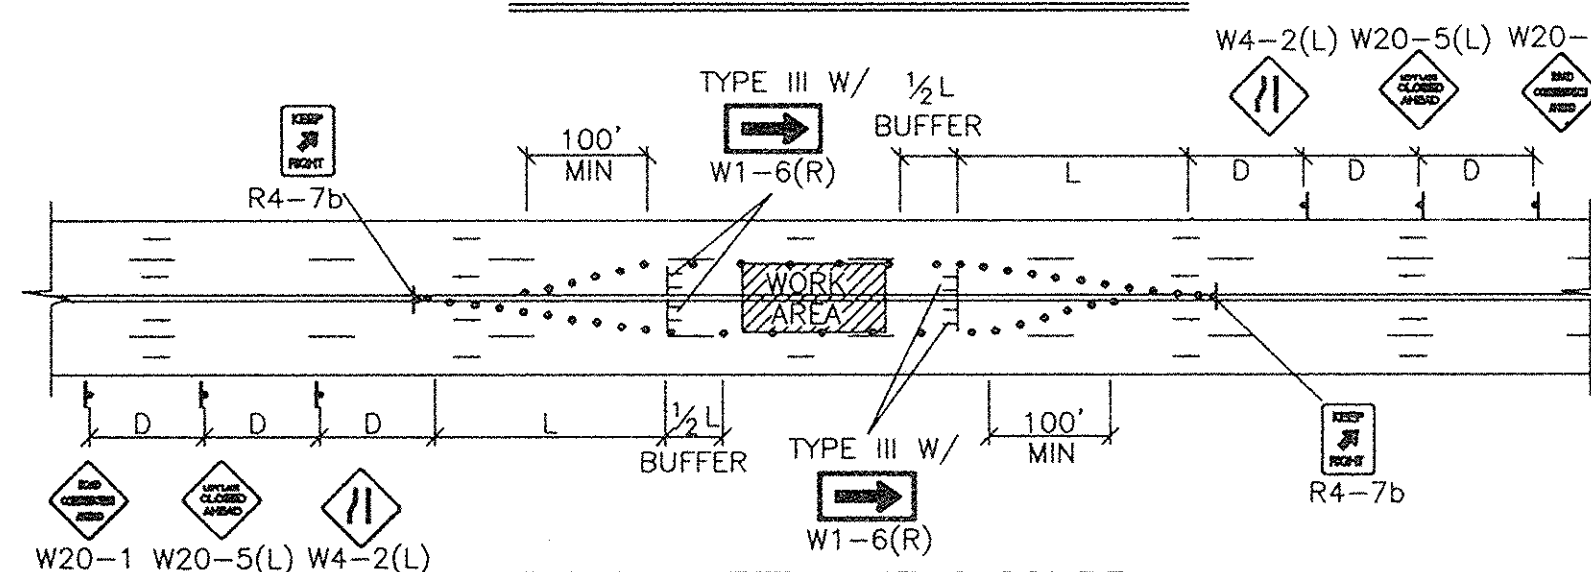
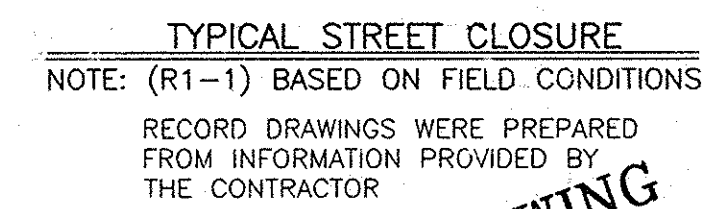
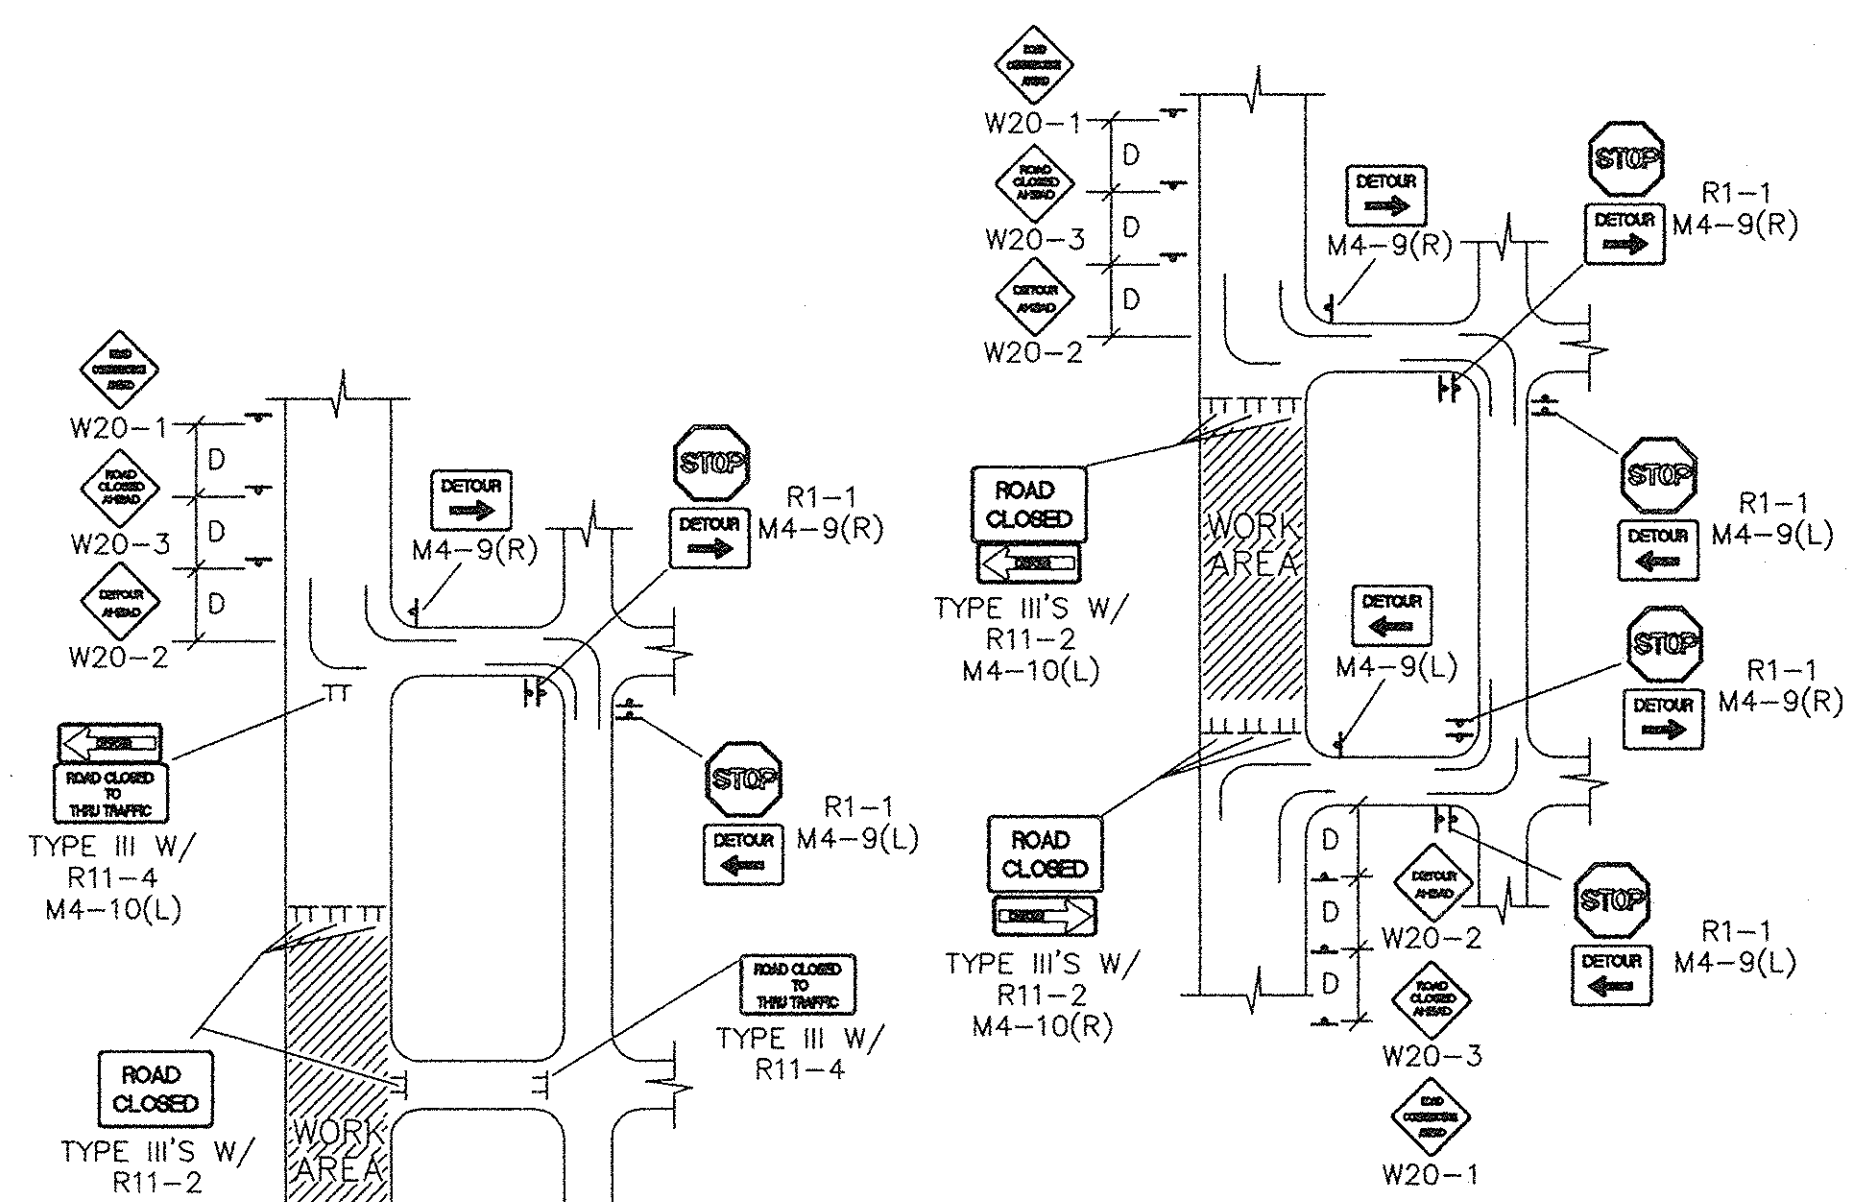
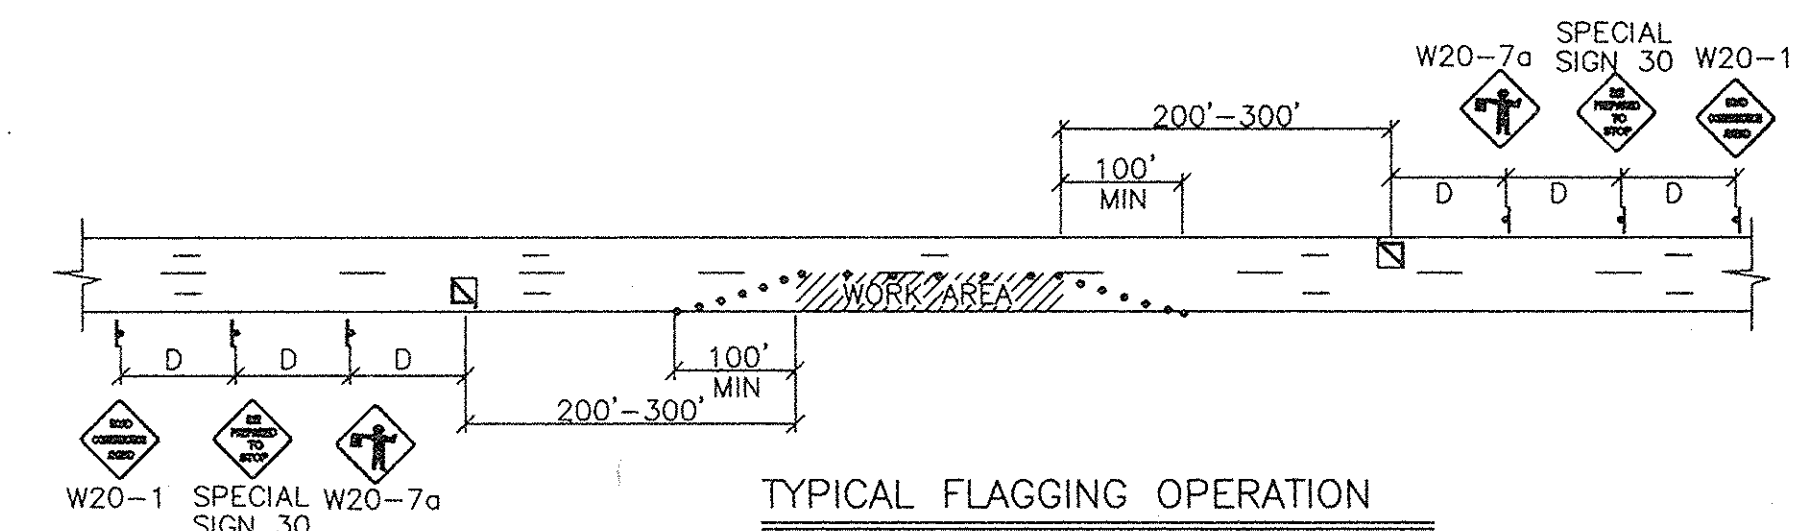
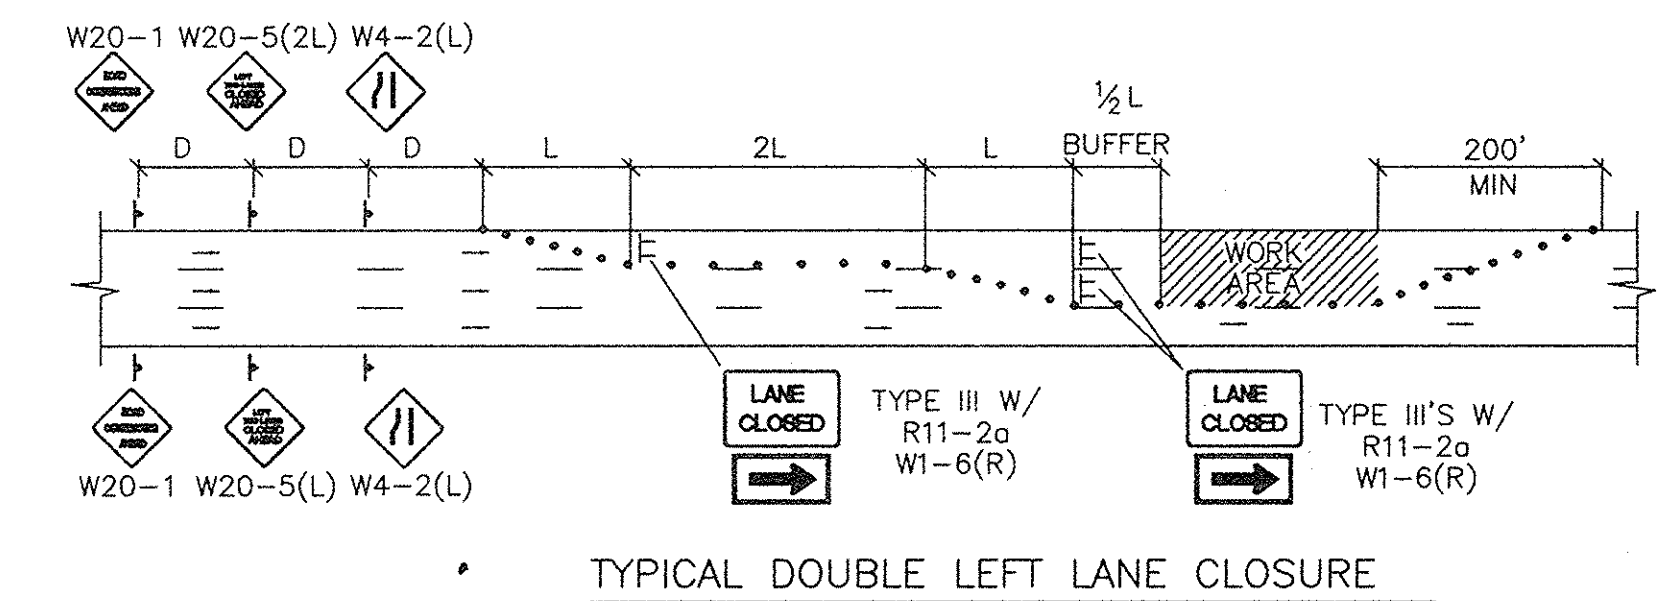
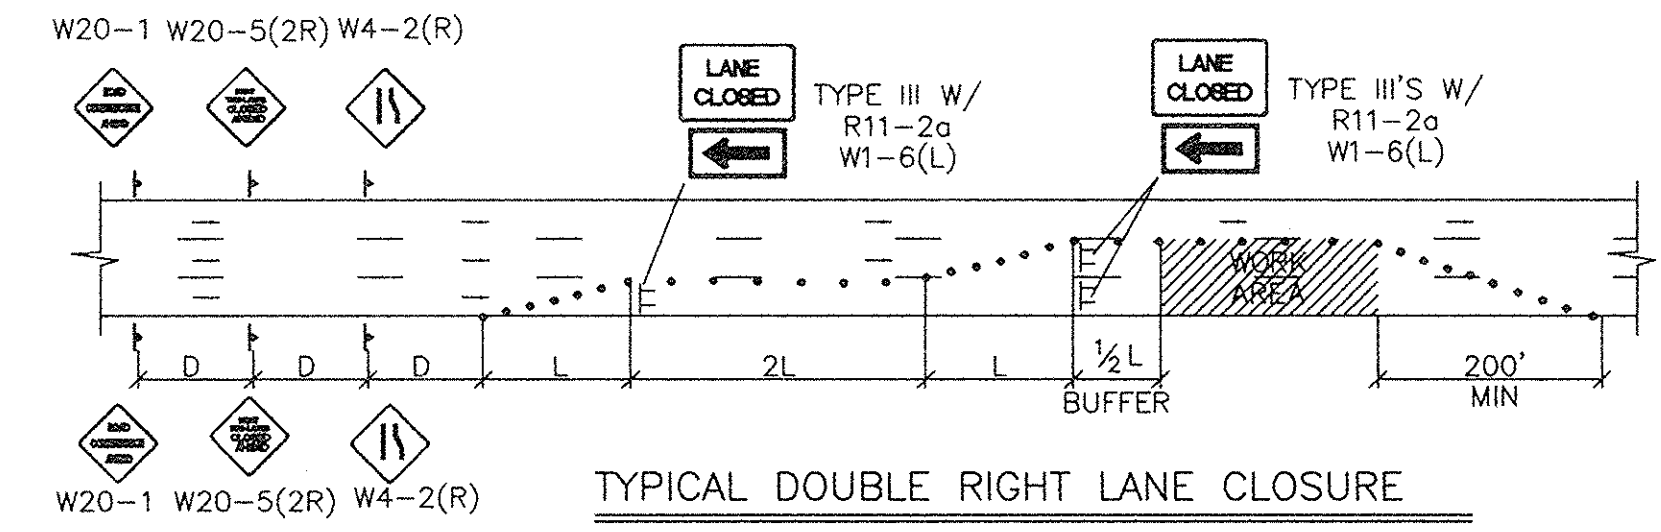
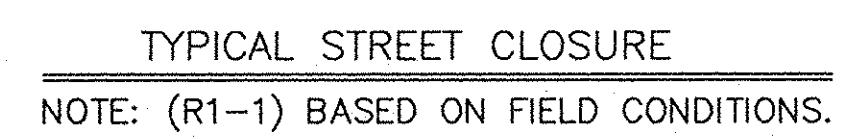
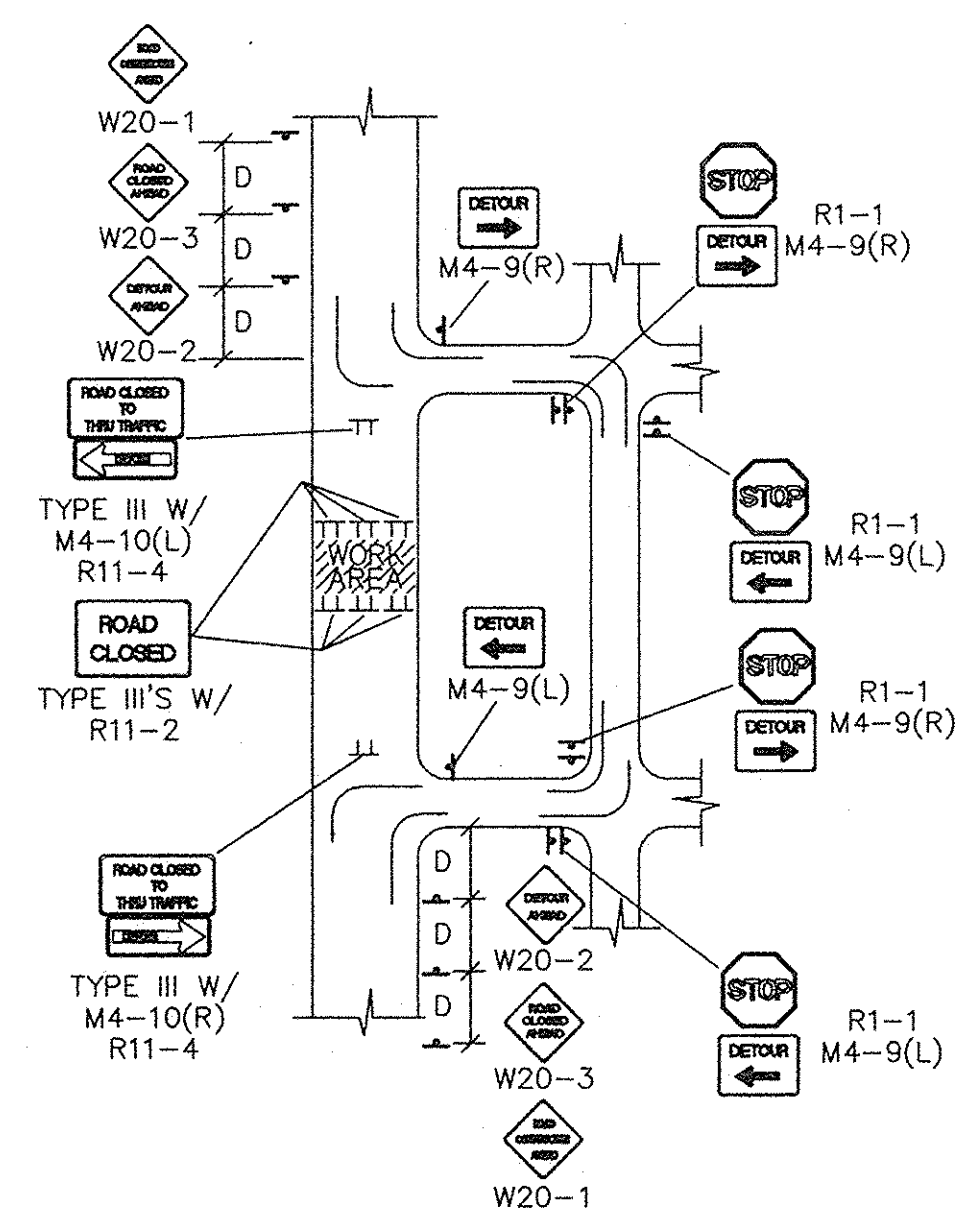
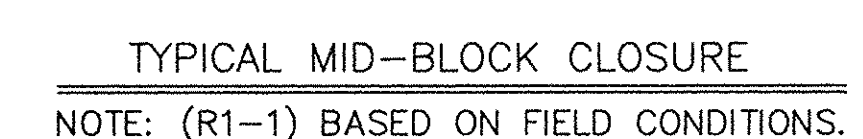


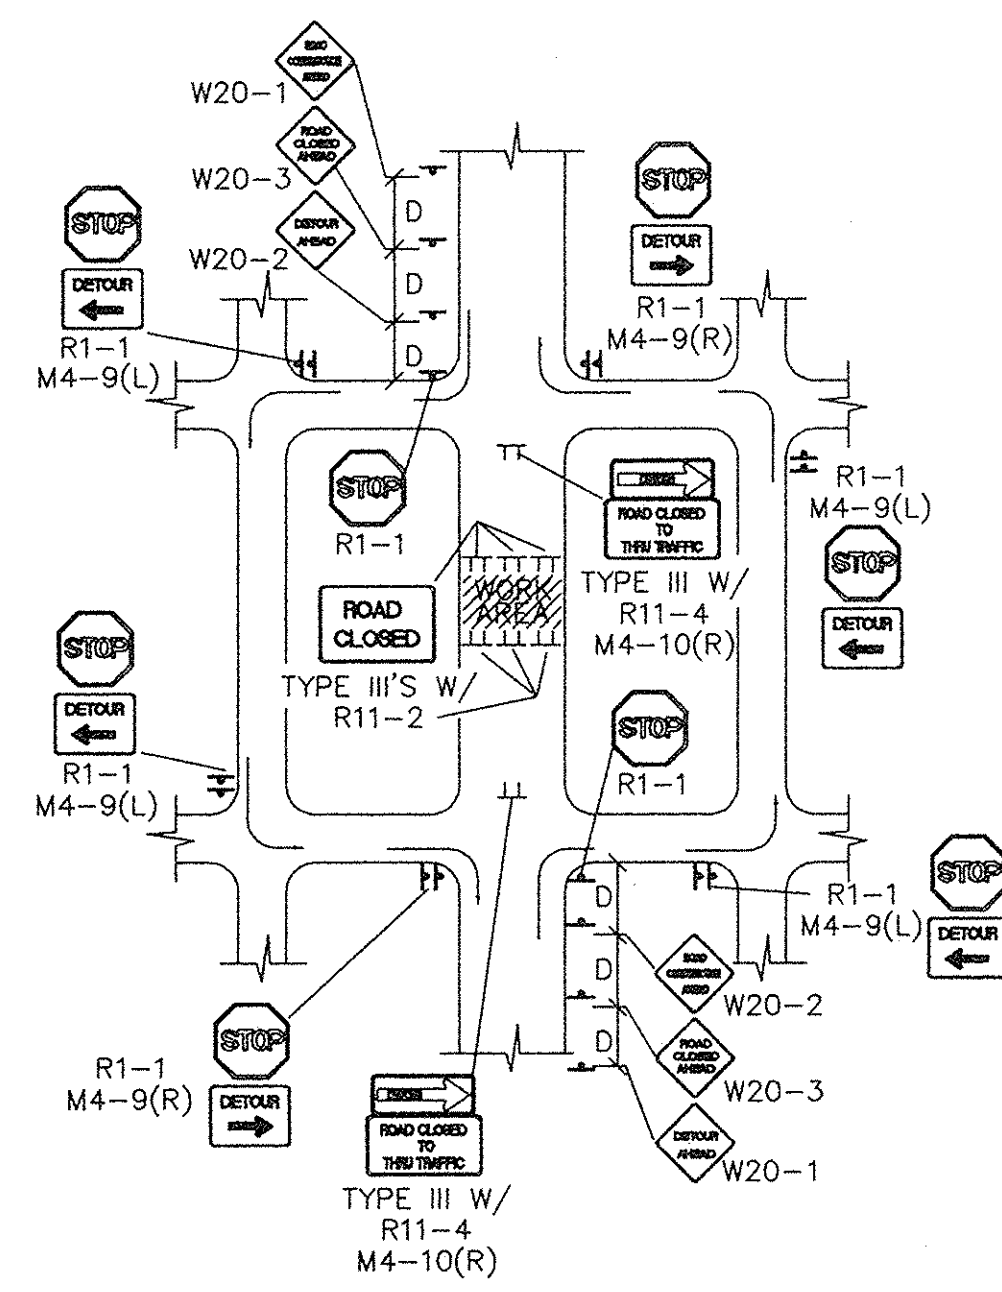



GENERAL NOTE:
ALL CONSTRUCTION WARNING SIGNS SHALL HAVE A BLACK LEGEND ON A ORANGE BACKGROUND.

* ALL ADVANCE WARNING SIGNS SHALL BE A MINIMUM OF 36" THIRTY SIX INCHES BY 36" THIRTY SIX INCHES IN SIZE AND SHALL HAVE ONE WARNING LIGHT.

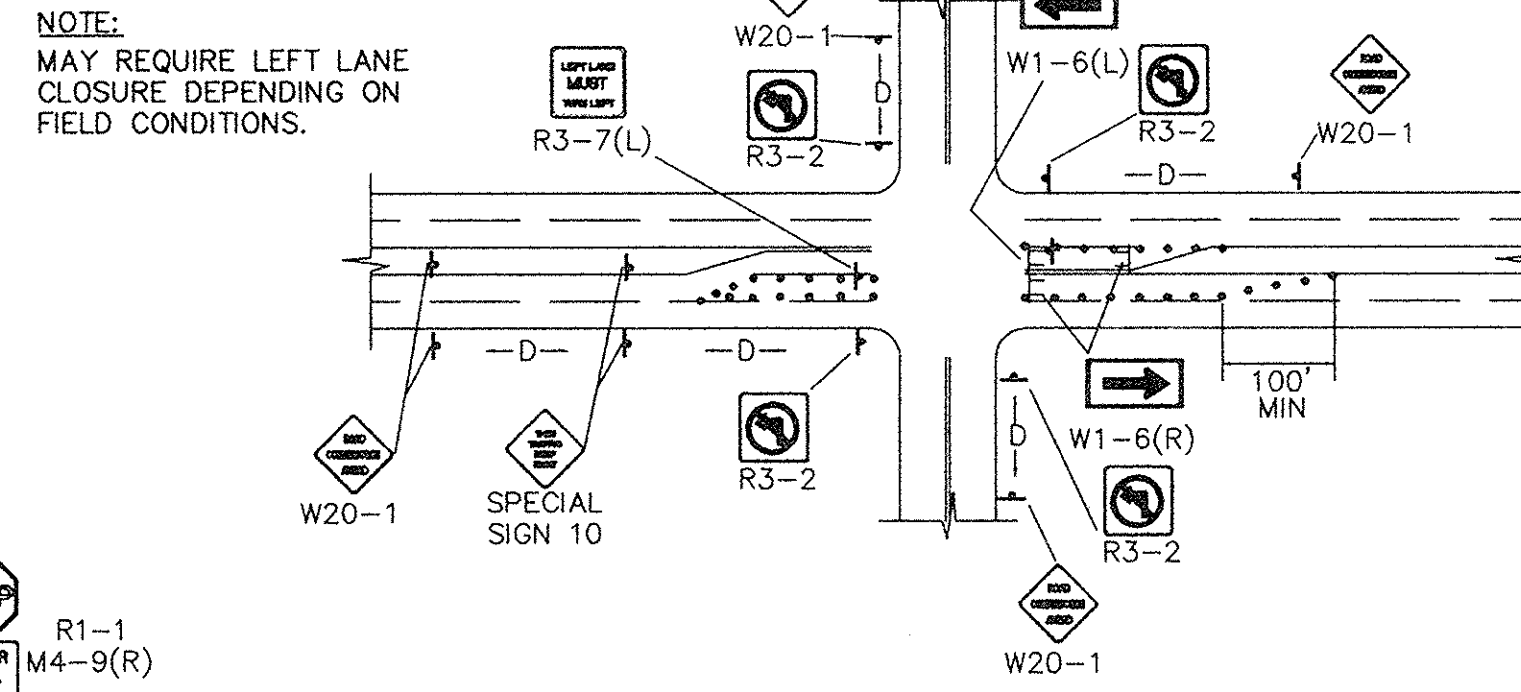

FROM INFORMATION PROVIDED BY
THE CONTRACTOR

RECORD DRAWING
09/04

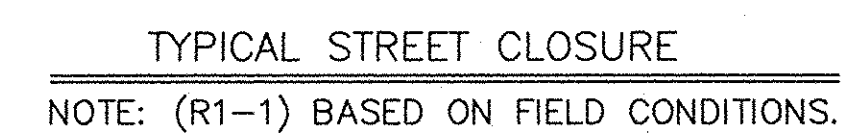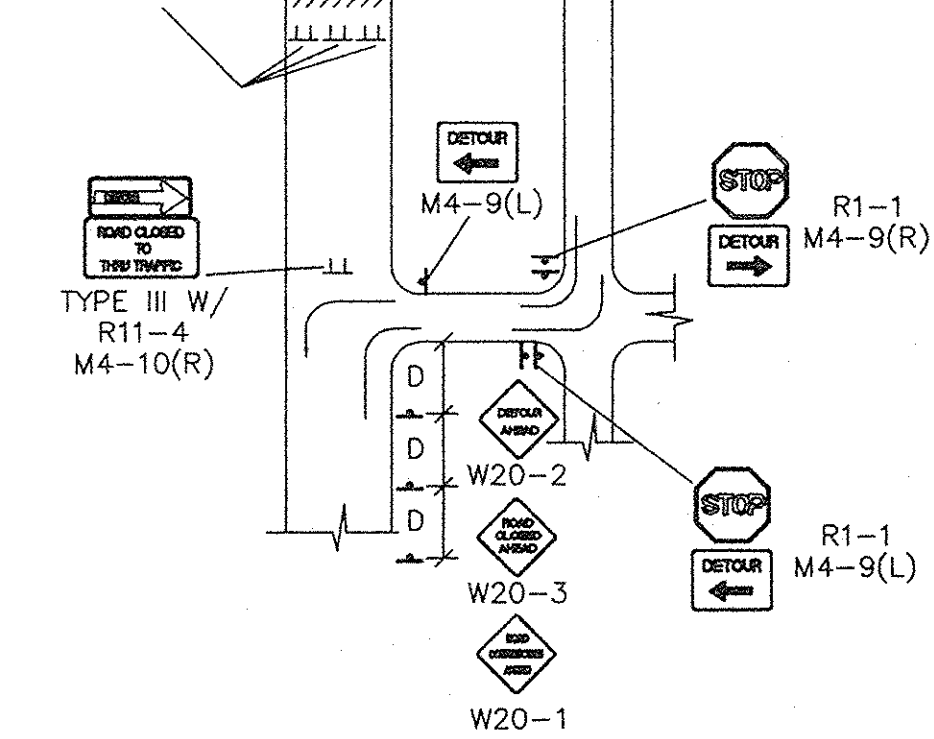

DATE		ENGINEER'S SEAL		SURVEY INFORMATION		BENCH MARKS		AS-BUILT INFORMATION	
				FIELD NOTES				CONTRACTOR	
				NO. - BY				STARTED BY	
				J.D.L.		DATE		DATE	
		REVISED GENERAL NOTE		BY				INSPECTOR'S	
		NO. DATE		REMARKS				FIELD	
				REVISIONS				OBSERVATION BY	
				DESIGN				CORRECTED BY	
		DESIGNED BY BOHANNAN HUSTON		DATE: JUL. 2003				MICRO-FILM INFORMATION	
		DRAWN BY BOHANNAN HUSTON		DATE: JUL. 2003				RECORDED BY	
		CHECKED BY BOHANNAN HUSTON		DATE: JUL. 2003				NO.	

DATE

ENGINEER'S SEAL

SURVEY INFORMATION

BENCH MARKS

AS-BUILT INFORMATION

FIELD NOTES

CONTRACTOR

STARTED BY

DATE

INSPECTOR'S

FIELD

OBSERVATION BY

CORRECTED BY

MICRO-FILM INFORMATION

RECORDED BY

NO.

DESIGNED BY BOHANNAN HUSTON

DATE: JUL. 2003

DRAWN BY BOHANNAN HUSTON

DATE: JUL. 2003

CHECKED BY BOHANNAN HUSTON

DATE: JUL. 2003