

PLAN
SCALE: 1" = 60'

46th STREET
TRAFFIC CONTROL PLAN
PHASE I

CONSTRUCTION PHASE I:
CONSTRUCT STORM DRAIN FROM
STA. 20+00 TO STA. 24+75
ON 46TH STREET.

CONSTRUCT TEMPORARY
ACCESS FOR SANDIA PEAK INN
(TO BE USED FOR PHASES II
THROUGH V.)
SEE PAGE 15.

RECORD DRAWING
09/04




CITY OF ALBUQUERQUE
PUBLIC WORKS DEPARTMENT
ENGINEERING DIVISION

TITLE: **CENTRAL - ATRISCO DRAINAGE IMPROVEMENTS**
46th STREET
TRAFFIC CONTROL PLAN- PHASE I

Design Review Committee	City Engineer Approval	Mo./Day/Yr.	Mo./Day/Yr.
SEP 10 2003	SEP 10 2003		
Lost Design Update			

City Project No. **674902** Zone Map No. **K-12-Z** Sheet **14** Of **21**

SURVEY INFORMATION		BENCH MARKS		AS BUILT INFORMATION	
NO.	BY	DATE	CONTRACTOR	WORK	DATE
1			ALBUQUERQUE CONTROL SURVEY B.M. NO. 17-412	STAMPED BY	DATE
2			LOCATED 2.3 MILES WEST OF DOWNTOWN ALBUQUERQUE	ACCEPTANCE BY	DATE
3			SOUTHWEST SIDE OF ATRISCO RD.	FIELD	DATE
4			THE STATION IS AN ACS 3 1/4" ALUM. CAP RIVETED TO A	REVISIONS	DATE
5			PIPE 0.25 FT. ABOVE GROUND AND IS STAMPED "17-J12, 1989"	RECORDED BY	DATE
6			PLANE COORDINATES: X=357989.51, Y=1489048.30, EL= 4955.128	RECORDED BY	DATE
7				RECORDED BY	DATE

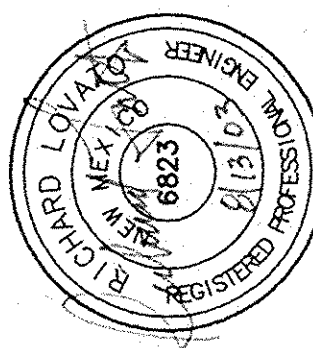

NO.	DATE	REMARKS	BY
1		DESIGN	
2			
3			
4			
5			
6			
7			