



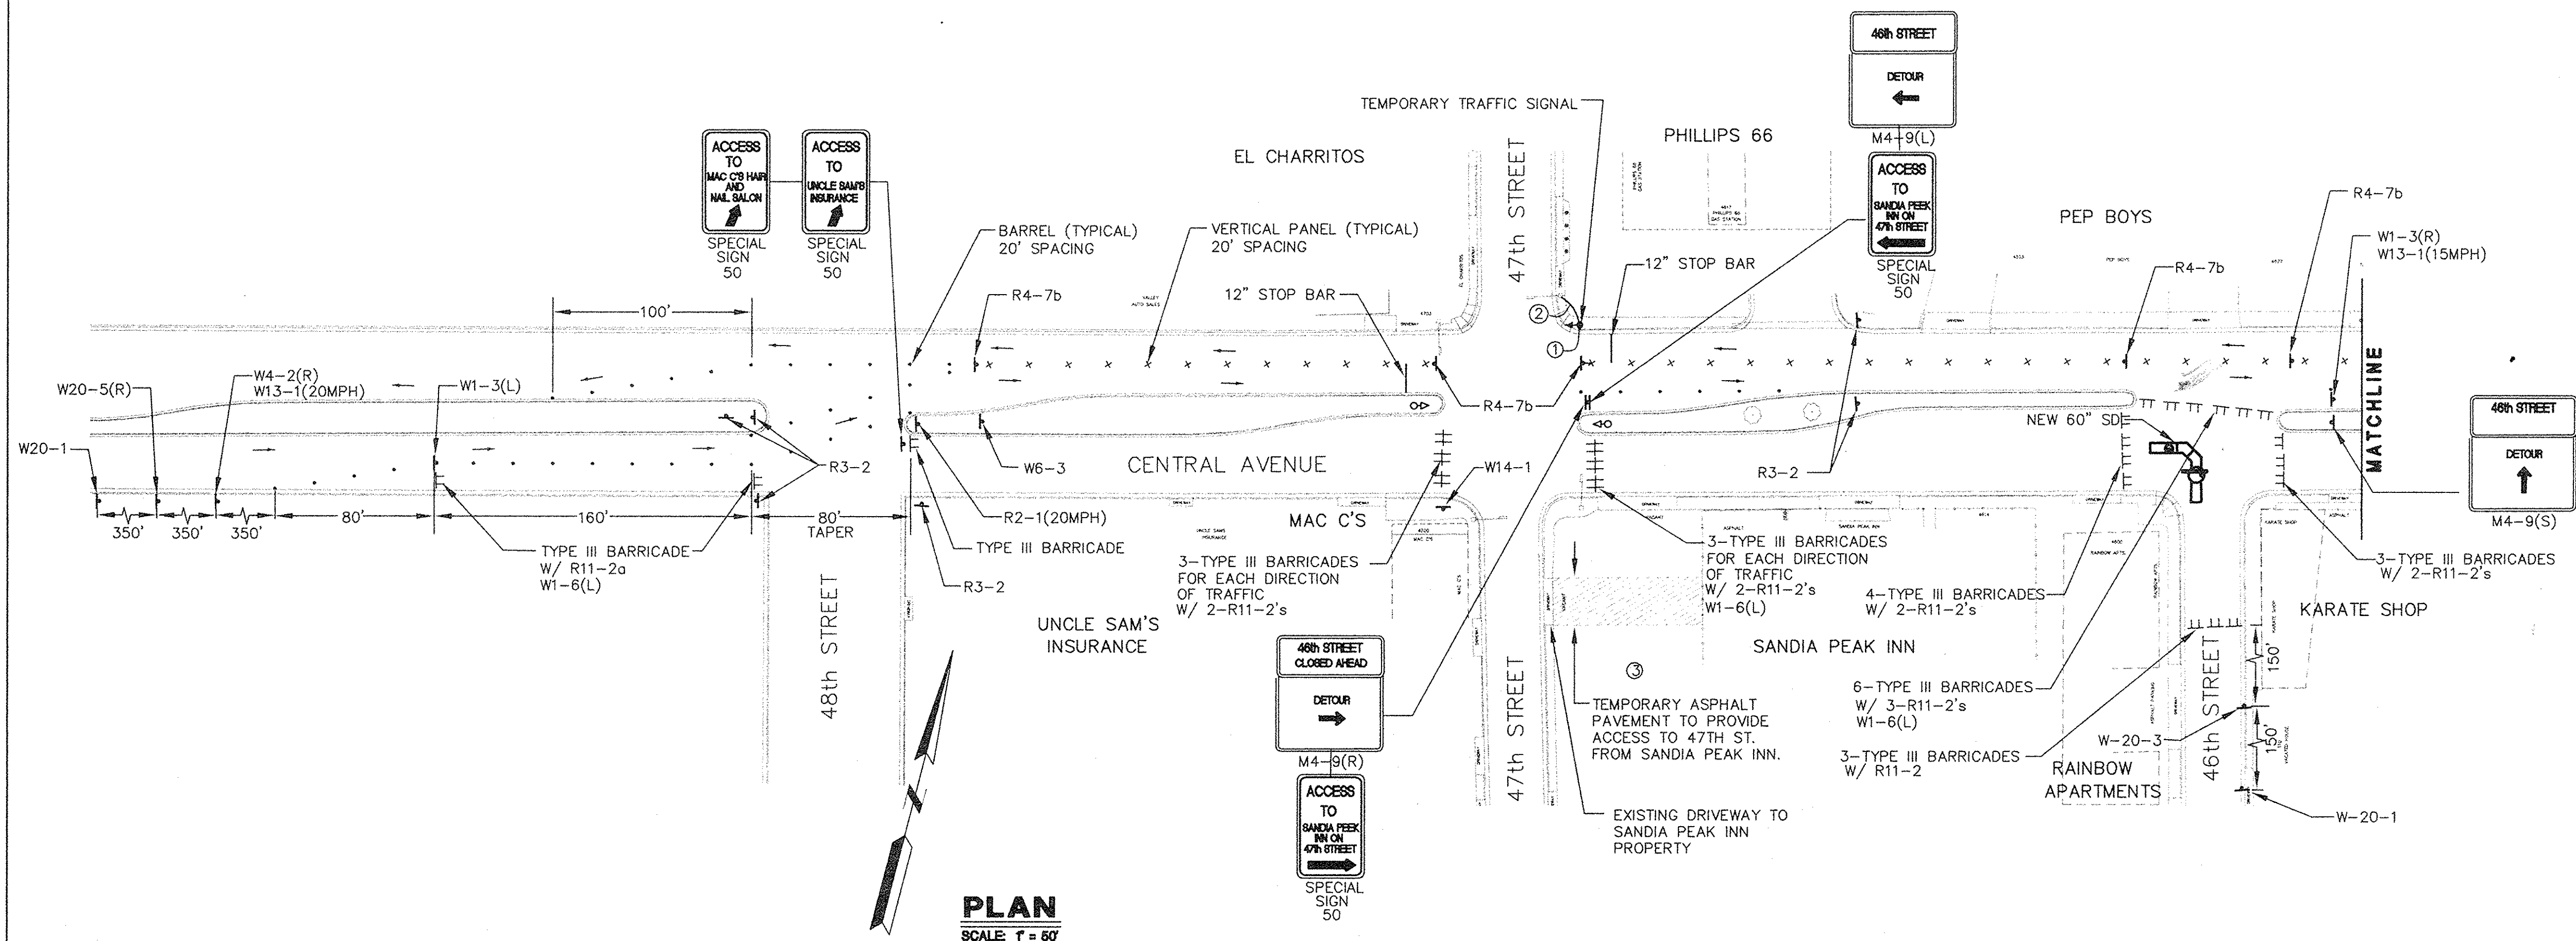

PLAN
SCALE: 1" = 60'

CENTRAL AVENUE
TRAFFIC CONTROL PLAN
PHASE II

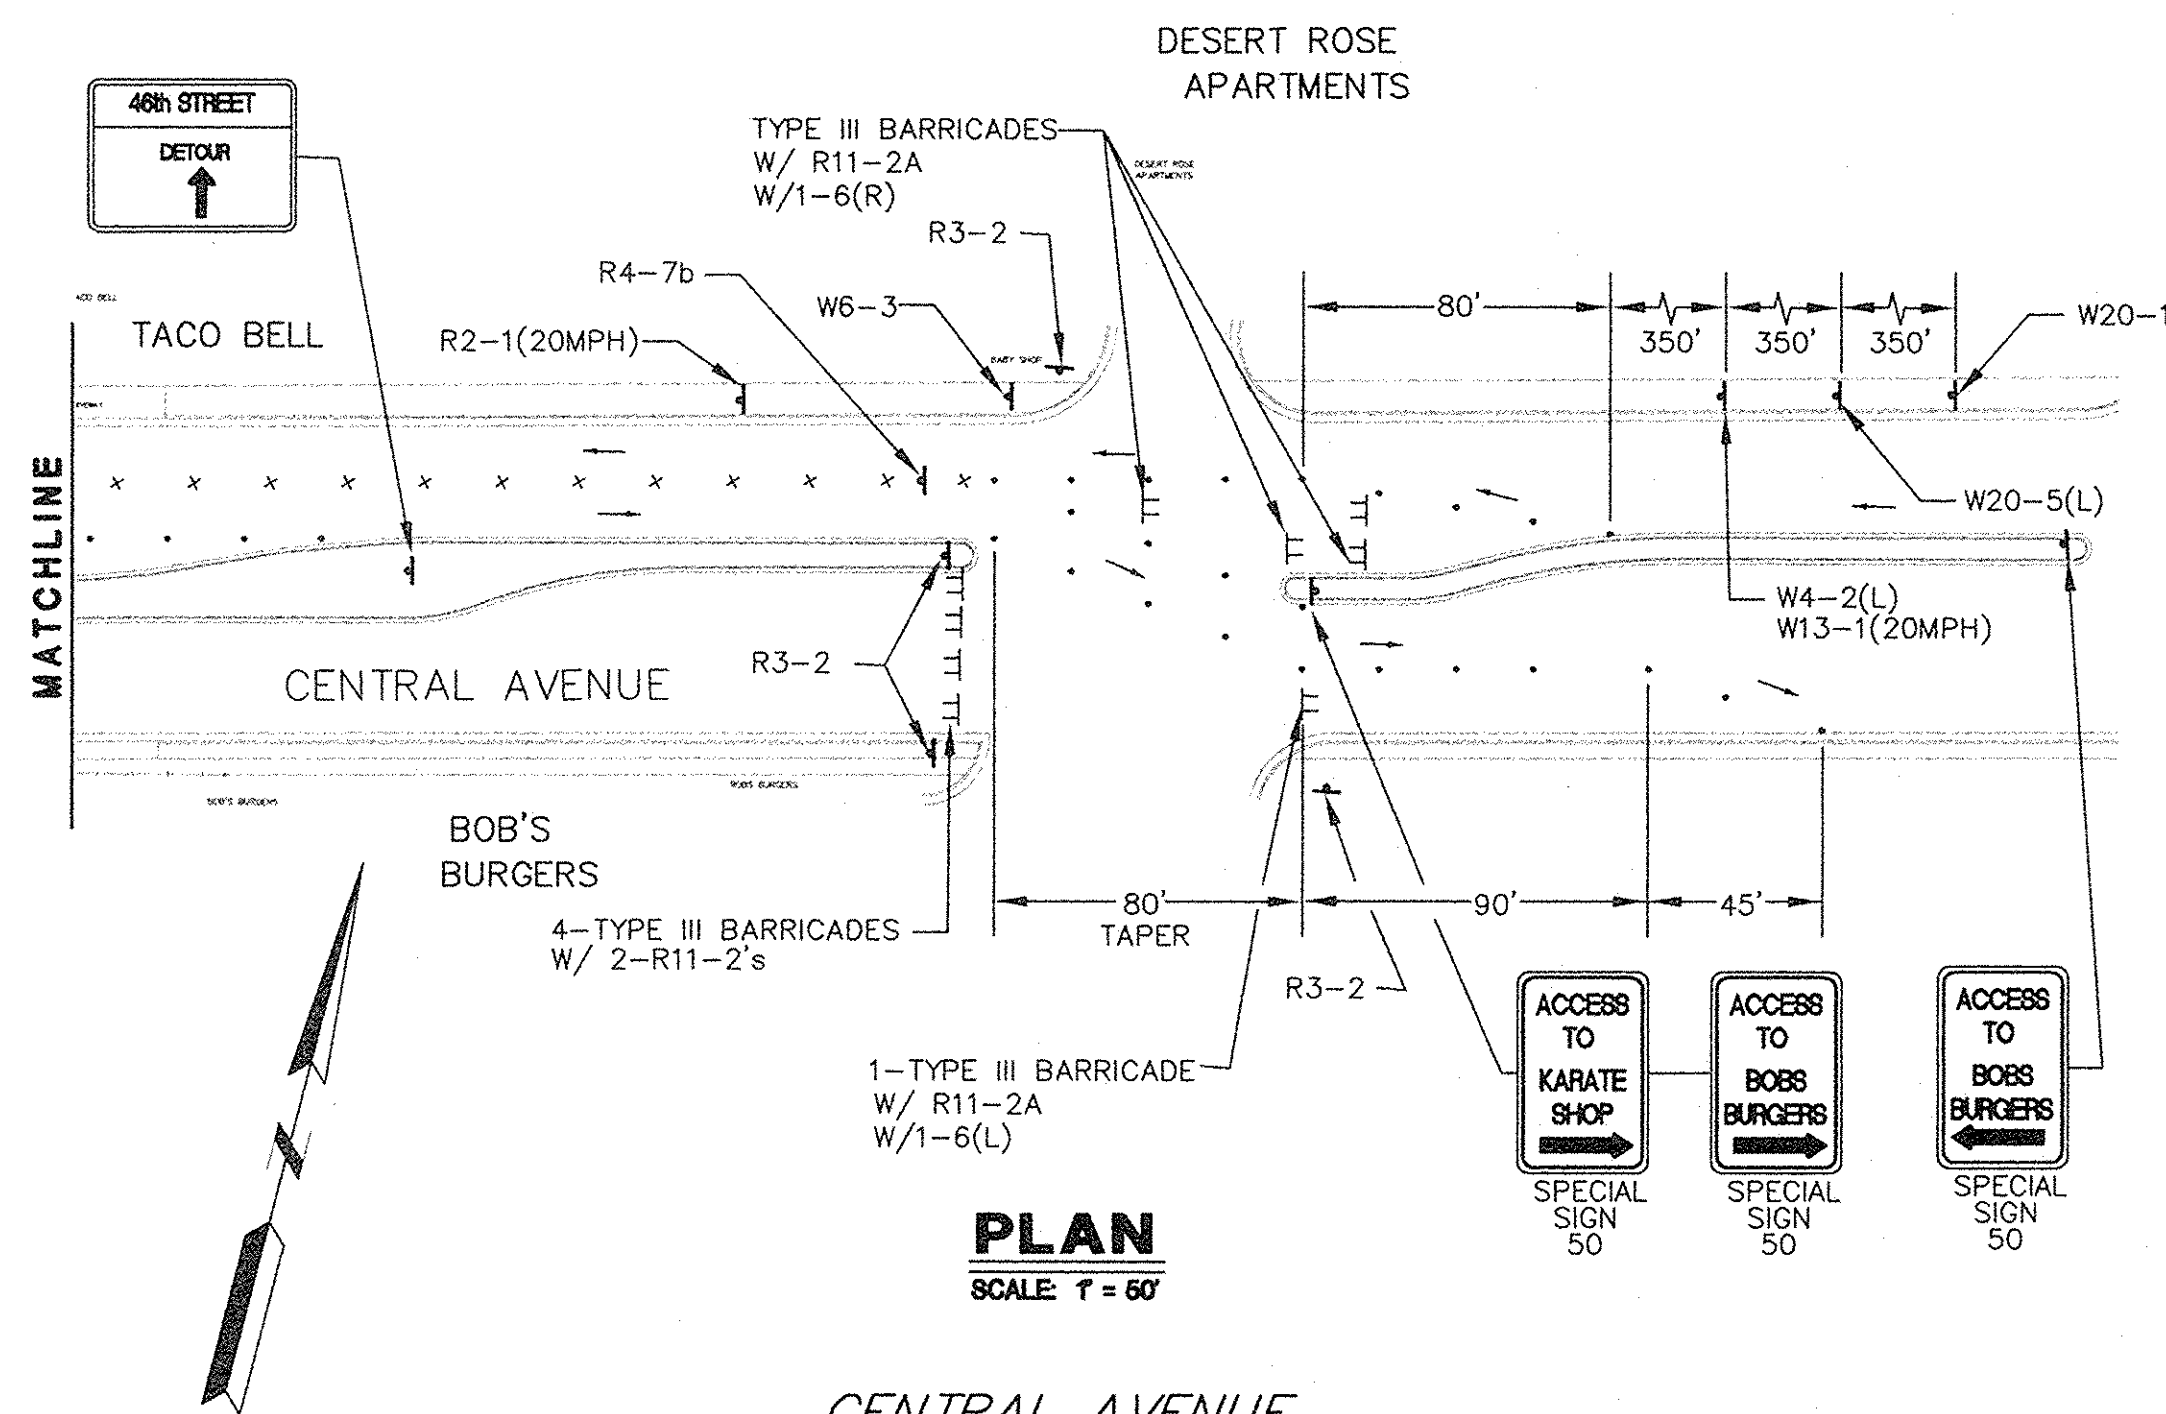

PLAN
SCALE: 1" = 60'

CENTRAL AVENUE
TRAFFIC CONTROL PLAN
PHASE II

**PLACEMENT OF ADVANCE SIGNAGE
AND MESSAGE BOARDS
(PHASES II THROUGH V)**

FOR CONSTRUCTION PHASES II THROUGH V,
PLACE A MESSAGE BOARD INDICATING
"CENTRAL AVENUE CONSTRUCTION AHEAD.
EXPECT DELAYS" AT THE TWO FOLLOWING
LOCATIONS:

1. FOR EASTBOUND CENTRAL AVENUE TRAFFIC:
APPROXIMATELY 500' WEST OF YUCCA DRIVE
ON THE CENTRAL AVENUE MEDIAN.
2. FOR WESTBOUND CENTRAL AVENUE TRAFFIC:
WEST OF TINGLEY DRIVE ON THE WIDE PART
OF THE CENTRAL AVENUE MEDIAN.

PLACE CONSTRUCTION SIGNAGE INDICATING
"CENTRAL AVENUE CONSTRUCTION AHEAD.
EXPECT DELAYS." (60" X 36") AT THE FOLLOWING
LOCATIONS:

1. 300 FEET EAST OF THE ATRISCO
DR./CENTRAL AVE. INTERSECTION FOR
WESTBOUND TRAFFIC
2. 100 FEET EAST OF THE OLD COORS
DRIVE/CENTRAL AVE. FOR EASTBOUND
TRAFFIC

CONSTRUCTION PHASE II:

CONSTRUCT STORM DRAIN AT INTERSECTION
OF CENTRAL AVENUE AND 46TH STREET.
BEGIN AT STA. 14+00 ON CENTRAL AVENUE
AND END AT STA. 24+75 ON 46TH STREET.

- KEYED NOTES:**
- ① PLACE TEMPORARY 15' PEDESTAL POLE
WITH 3-SECTION SIGNAL HEAD.
 - ② LAY 2" RIGID CONDUIT WITH 5
CONDUCTOR CABLE ON GROUND FROM
EXISTING MASTARM ON NORTHEAST
CORNER OF INTERSECTION TO TEMPORARY
PEDESTAL POLE.
 - ③ CONTRACTOR SHALL COORDINATE ACCESS
TO SANDIA PEAK INN OFF OF 47TH
STREET WITH PROPERTY OWNER WHICH
MAY INCLUDE PROVIDING A TEMPORARY
DRIVEWAY, AND/OR A TEMPORARY
PARKING LOT, AND SIDEWALK.
CONSTRUCTION ON SANDIA PEAK INN
PROPERTY SHALL BE PAID FOR UNDER
THE BID ITEMS FOR TEMPORARY
PAVEMENT, SIDEWALK, AND REMOVAL AND
REPLACEMENT OF LANDSCAPING.
 - ④ PHASES II THROUGH V SHALL NOT BE
CONSTRUCTED DURING THE ALBUQUERQUE
BALLOON FIESTA PERIOD (OCT. 2ND
THROUGH OCT. 12TH).

4			ENGINEER'S SEAL		SURVEY INFORMATION			BENCH MARKS			AS BUILT INFORMATION		
3					FIELD NOTES			ALBUQUERQUE CONTROL SURVEY B.M. NO. 17-J12 LOCATED 2.3 MILES WEST OF DOWNTOWN ALBUQUERQUE SOUTHWEST SIDE OF ATRISCO RD. THE STATION IS AN ACS 3 1/4" ALUM. CAP RIVETTED TO A PIPE 0.25 FT. ABOVE GROUND AND IS STAMPED "17-J12, 1988". PLANE COORDINATES: X=367999.51, Y=1489049.30, EL= 4955.128			CONTRACTOR WORKED BY INSPECTED BY ACCEPTANCE BY VERIFICATION BY DRAWINGS CORRECTED BY MICRO-FILM INFORMATION		
2													
1													
NO. DATE		REMARKS	BY	DESIGN		DATE: JUL. 2003							
▲ R E V I S I O N S ▲													
						DRAWN BY: A.B.						RECORDED BY: DATE	
						DATE: JUL. 2003						RECORDED BY: DATE	

RECORD DRAWING
09/04

LARKIN GROUP, INC.
CONSULTING ENGINEERS AND SURVEYORS
8500 MENAUL BLVD. NE A-140
(505) 275-7500

CITY OF ALBUQUERQUE
PUBLIC WORKS DEPARTMENT
ENGINEERING DIVISION

TITLE: **CENTRAL - ATRISCO DRAINAGE IMPROVEMENTS**
CENTRAL AVENUE
TRAFFIC CONTROL PLAN- PHASE II

Design Review Committee	City Engineer Approval	Mo./Day/Yr.	Mo./Day/Yr.
City Project No.	Zone Map No.	Sheet	Of
674902	K-12-Z	15	21