
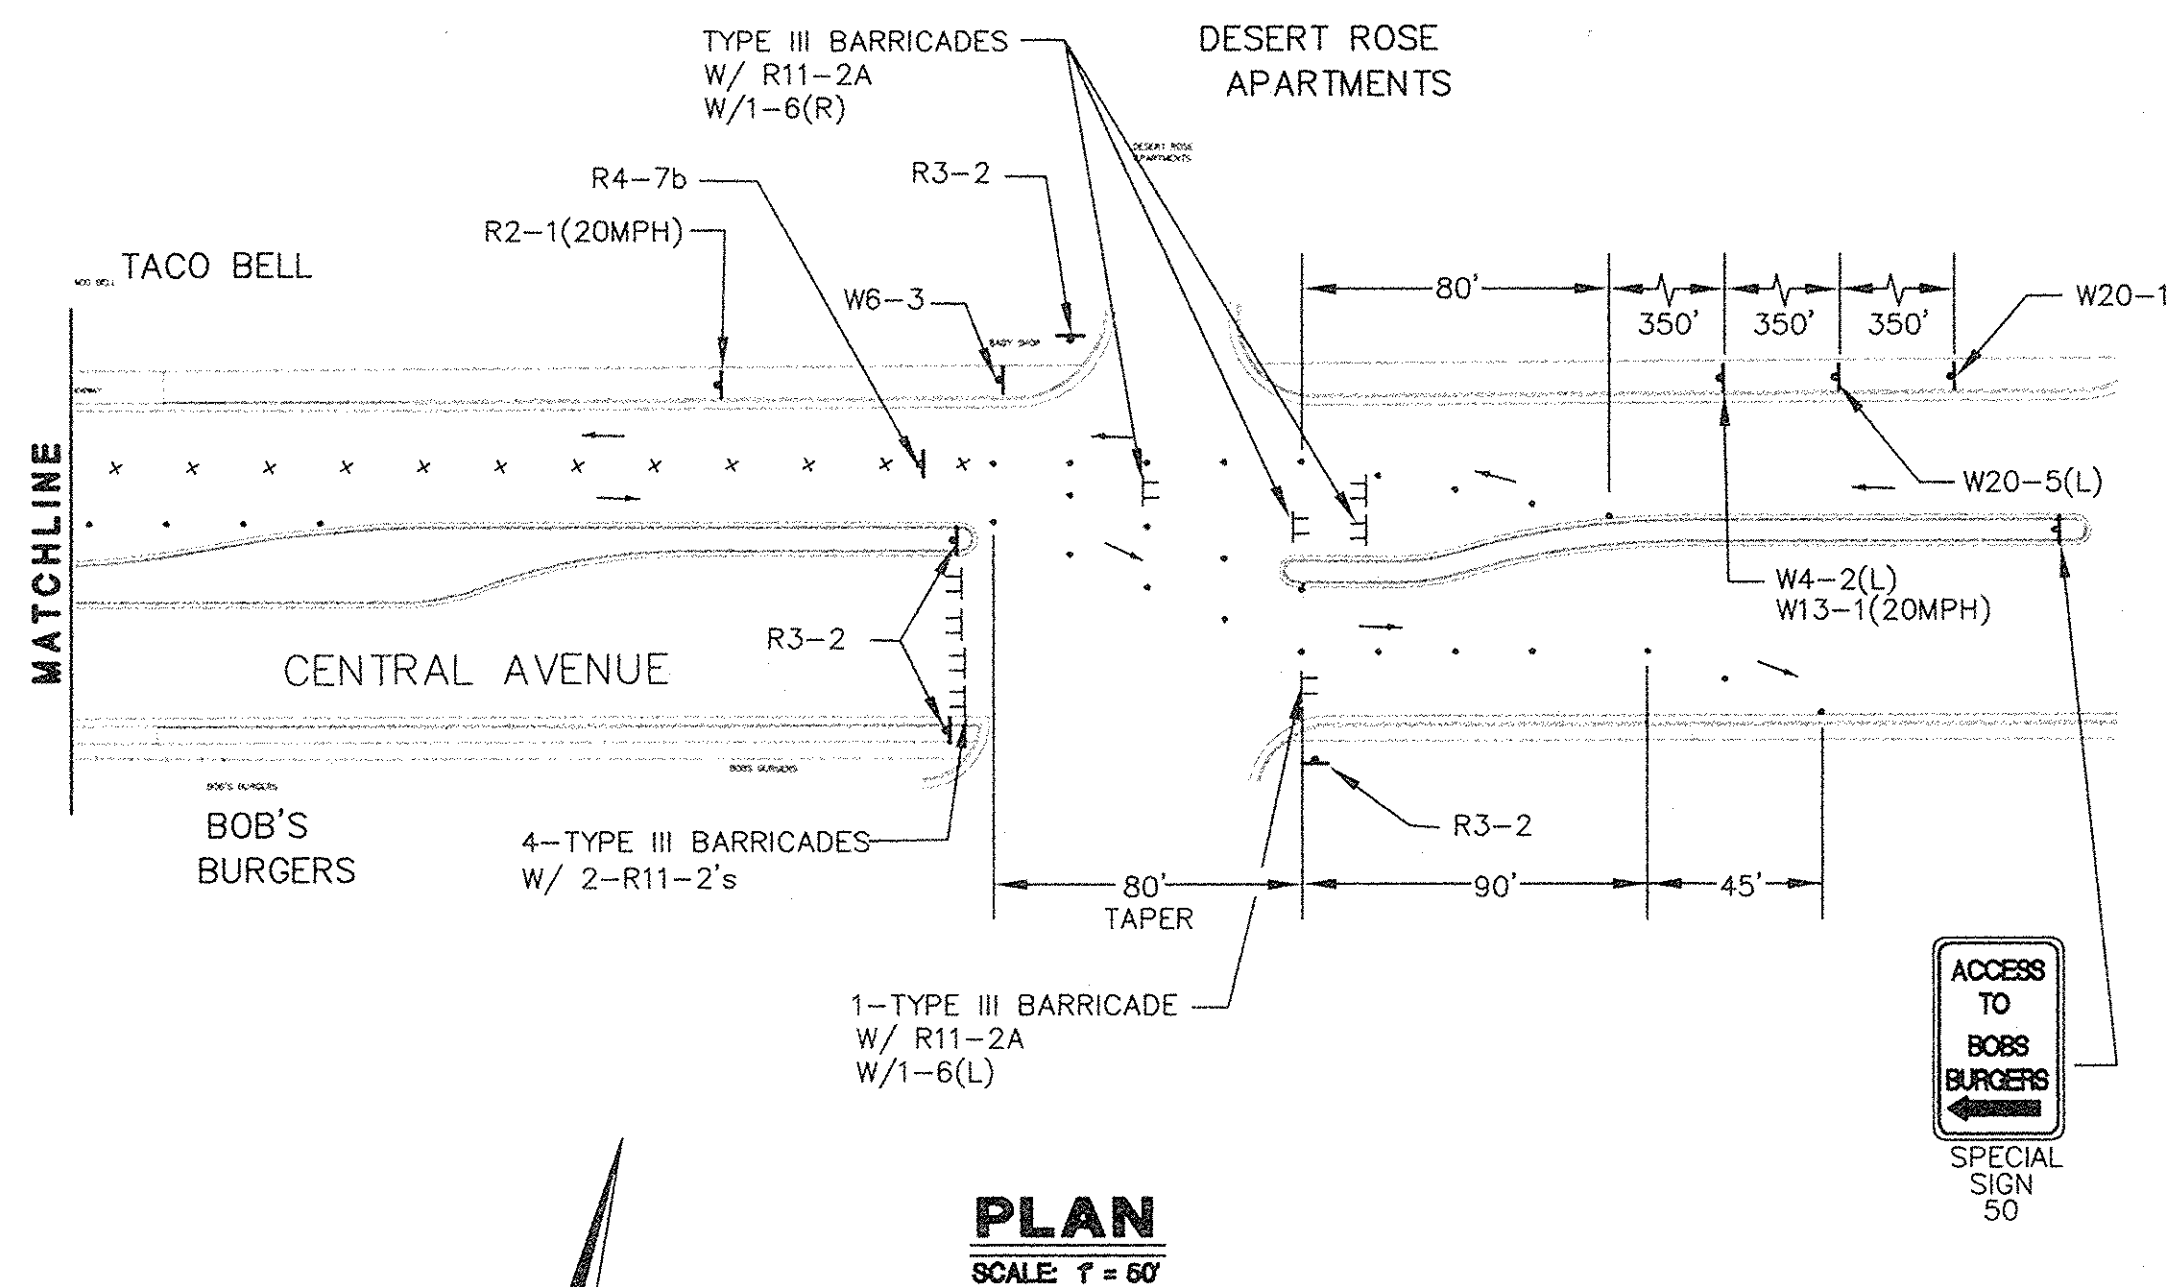


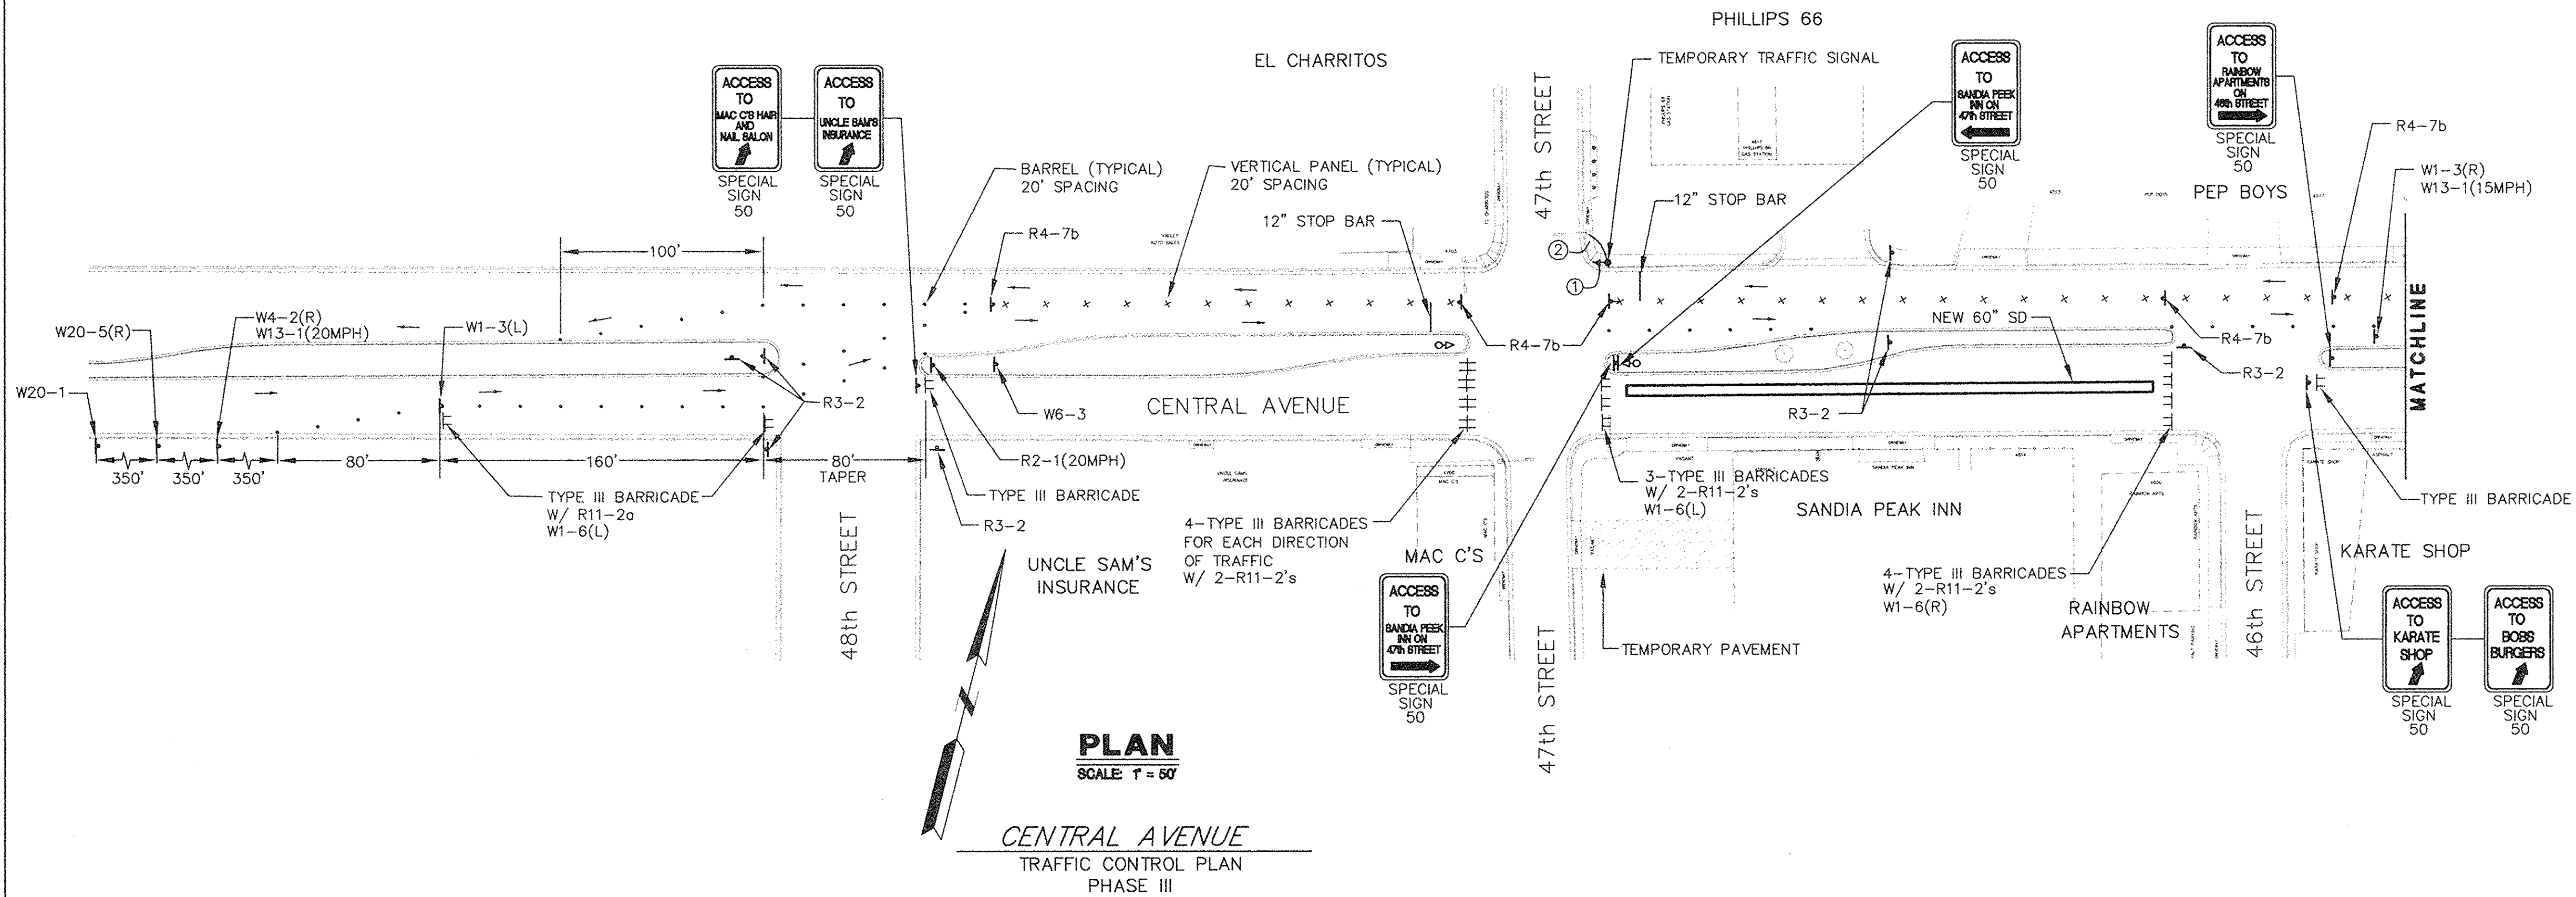

CONSTRUCTION PHASE III:
CONSTRUCT STORM DRAIN FROM
STA. 11+15 TO STA. 14+00 ON
CENTRAL AVENUE.

- KEYED NOTES:
- ① TEMPORARY 15' PEDESTAL POLE WITH 3-SECTION SIGNAL HEAD.
 - ② 2" RIGID CONDUIT WITH 5 CONDUCTOR CABLE ON GROUND FROM EXISTING MASTARM ON NORTHEAST CORNER OF INTERSECTION TO TEMPORARY PEDESTAL POLE.

RECORD DRAWING
09/04

LARKIN GROUP, INC.
CONSULTING ENGINEERS AND SURVEYORS
8500 MENAUL BLVD. NE A-440
(505) 275-7500



CITY OF ALBUQUERQUE
PUBLIC WORKS DEPARTMENT
ENGINEERING DIVISION

TITLE: CENTRAL - ATRISCO DRAINAGE IMPROVEMENTS
CENTRAL AVENUE
TRAFFIC CONTROL PLAN- PHASE III

Design Review Committee	City Engineer Approval	Mo./Day/Yr.	Mo./Day/Yr.
SEP 10 2003	SEP 10 2003		
DESIGN REVIEW COMMITTEE	CITY ENGINEER		

City Project No. 674902 Zone Map No. K-12-Z Sheet 16 Of 21

BENCH MARKS		SURVEY INFORMATION		ENGINEER'S SEAL	
CONTRACTOR	DATE	NO.	BY		
ALBUQUERQUE CONTROL SURVEY B.M. NO. 17-J12		1			
LOCATED 2.3 MILES WEST OF DOWNTOWN ALBUQUERQUE		2			
SOUTHWEST SIDE OF ATRISCO RD.		3			
THE STATION IS AN ACS 3 1/4" ALUM. CAP RIVETED TO A		4			
PIPE 0.25 FT. ABOVE GROUND AND IS STAMPED "17-J12, 1989"		5			
PLANE COORDINATES: X=367999.51, Y=1489049.30, EL= 4955.128		6			
AS BUILT INFORMATION		FIELD NOTES		REVISIONS	
CONTRACTOR	DATE	NO.	BY	NO.	DATE
WORK BY		1		1	
INSPECTOR'S		2		2	
ACCEPTANCE BY		3		3	
REVISION BY		4		4	
DRAWINGS		5		5	
CHECKED BY		6		6	
RECORDED BY		7		7	
DATE				DATE	
DATE				DATE	
DATE				DATE	