


PLAN
SCALE: 1" = 50'

CENTRAL AVENUE
TRAFFIC CONTROL PLAN
PHASE IV

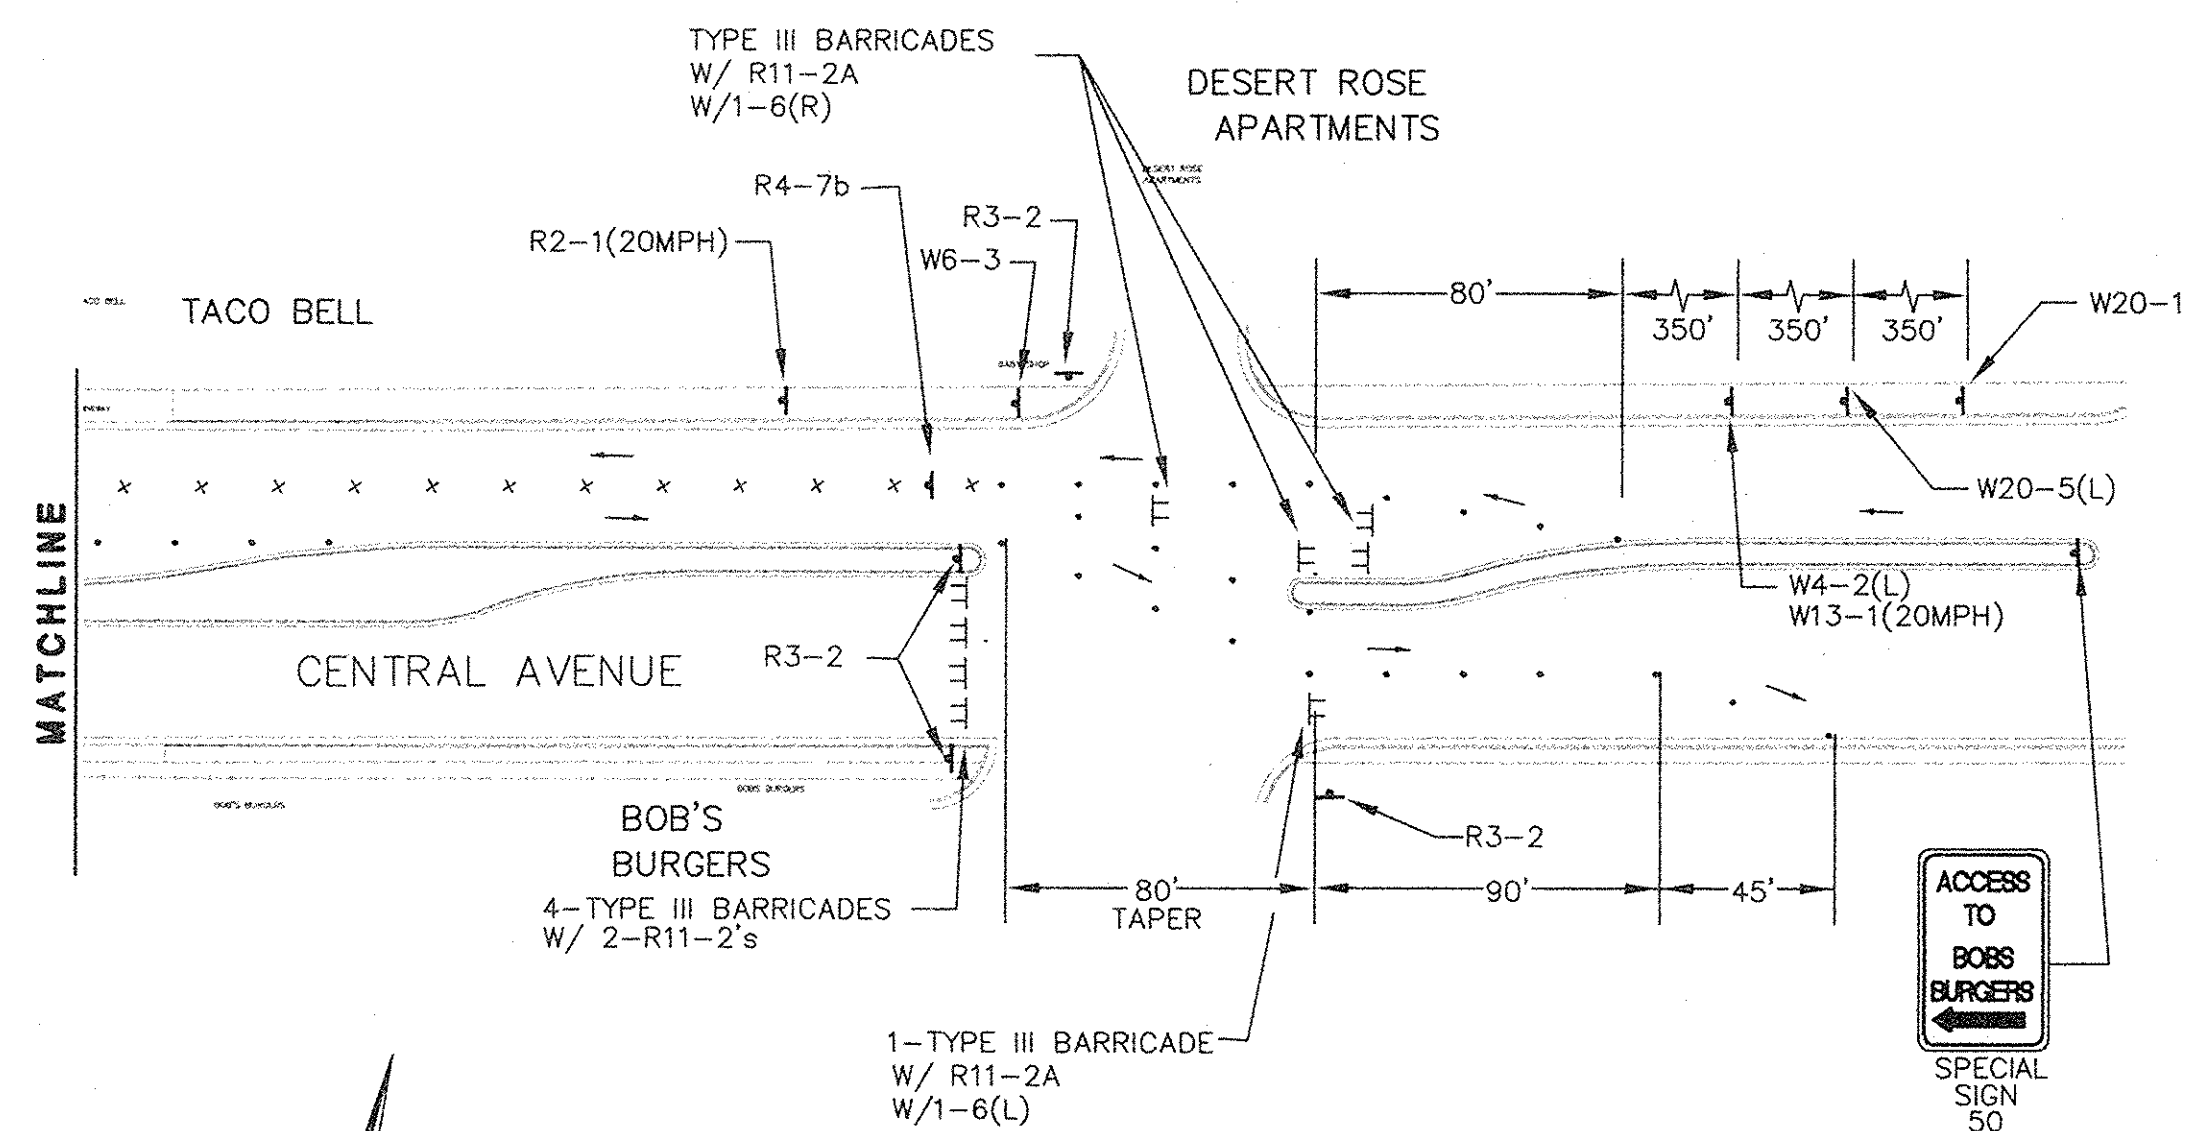

PLAN
SCALE: 1" = 50'

CENTRAL AVENUE
TRAFFIC CONTROL PLAN
PHASE IV

CONSTRUCTION PHASE IV:

CONSTRUCT STORM DRAIN AT INTERSECTION OF CENTRAL AVE./47TH ST. IN THE EASTBOUND LANES FROM STA. 10+68 TO STA. 11+15 ON CENTRAL AVENUE.

KEYED NOTES:

- ① TEMPORARY 15' PEDESTAL POLE WITH 3-SECTION SIGNAL HEAD.
- ② 2" RIGID CONDUIT WITH 5 CONDUCTOR CABLE ON GROUND FROM EXISTING MASTARM ON NORTHEAST CORNER OF INTERSECTION TO TEMPORARY PEDESTAL POLE.

RECORD DRAWING
09/04



CITY OF ALBUQUERQUE
PUBLIC WORKS DEPARTMENT
ENGINEERING DIVISION

TITLE: **CENTRAL - ATRISCO DRAINAGE IMPROVEMENTS**
CENTRAL AVENUE
TRAFFIC CONTROL PLAN - PHASE IV

Design/Review Committee	City Engineer Approval	Mo./Day/Yr.	Mo./Day/Yr.
SEP 10 2003	SEP 10 2003		
DESIGN REVIEW COMMITTEE	CITY ENGINEER		

City Project No.	Zone Map No.	Sheet	Of
674902	K-12-Z	17	21

AS BUILT INFORMATION		BENCH MARKS		SURVEY INFORMATION		ENGINEER'S SEAL		REVISIONS		DESIGN	
CONTRACTOR	DATE	CONTRACTOR	DATE	NO.	BY	NO.	BY	NO.	DATE	REMARKS	BY
ALBUQUERQUE CONTROL SURVEY B.M. NO. 17-J12		ALBUQUERQUE CONTROL SURVEY B.M. NO. 17-J12		1		1		1			
LOCATED 2.3 MILES WEST OF DOWNTOWN ALBUQUERQUE		LOCATED 2.3 MILES WEST OF DOWNTOWN ALBUQUERQUE		2		2		2			
SOUTHWEST SIDE OF ATRISCO RD.		SOUTHWEST SIDE OF ATRISCO RD.		3		3		3			
THE STATION IS AN ACS 3 1/4" ALUM. CAP RIVETED TO A		THE STATION IS AN ACS 3 1/4" ALUM. CAP RIVETED TO A		4		4		4			
PIPE 0.25 FT. ABOVE GROUND AND IS STAMPED "17-J12, 1989"		PIPE 0.25 FT. ABOVE GROUND AND IS STAMPED "17-J12, 1989"		5		5		5			
PLANE COORDINATES: X=367998.51, Y=4955.128		PLANE COORDINATES: X=367998.51, Y=4955.128		6		6		6			
				7		7		7			

