


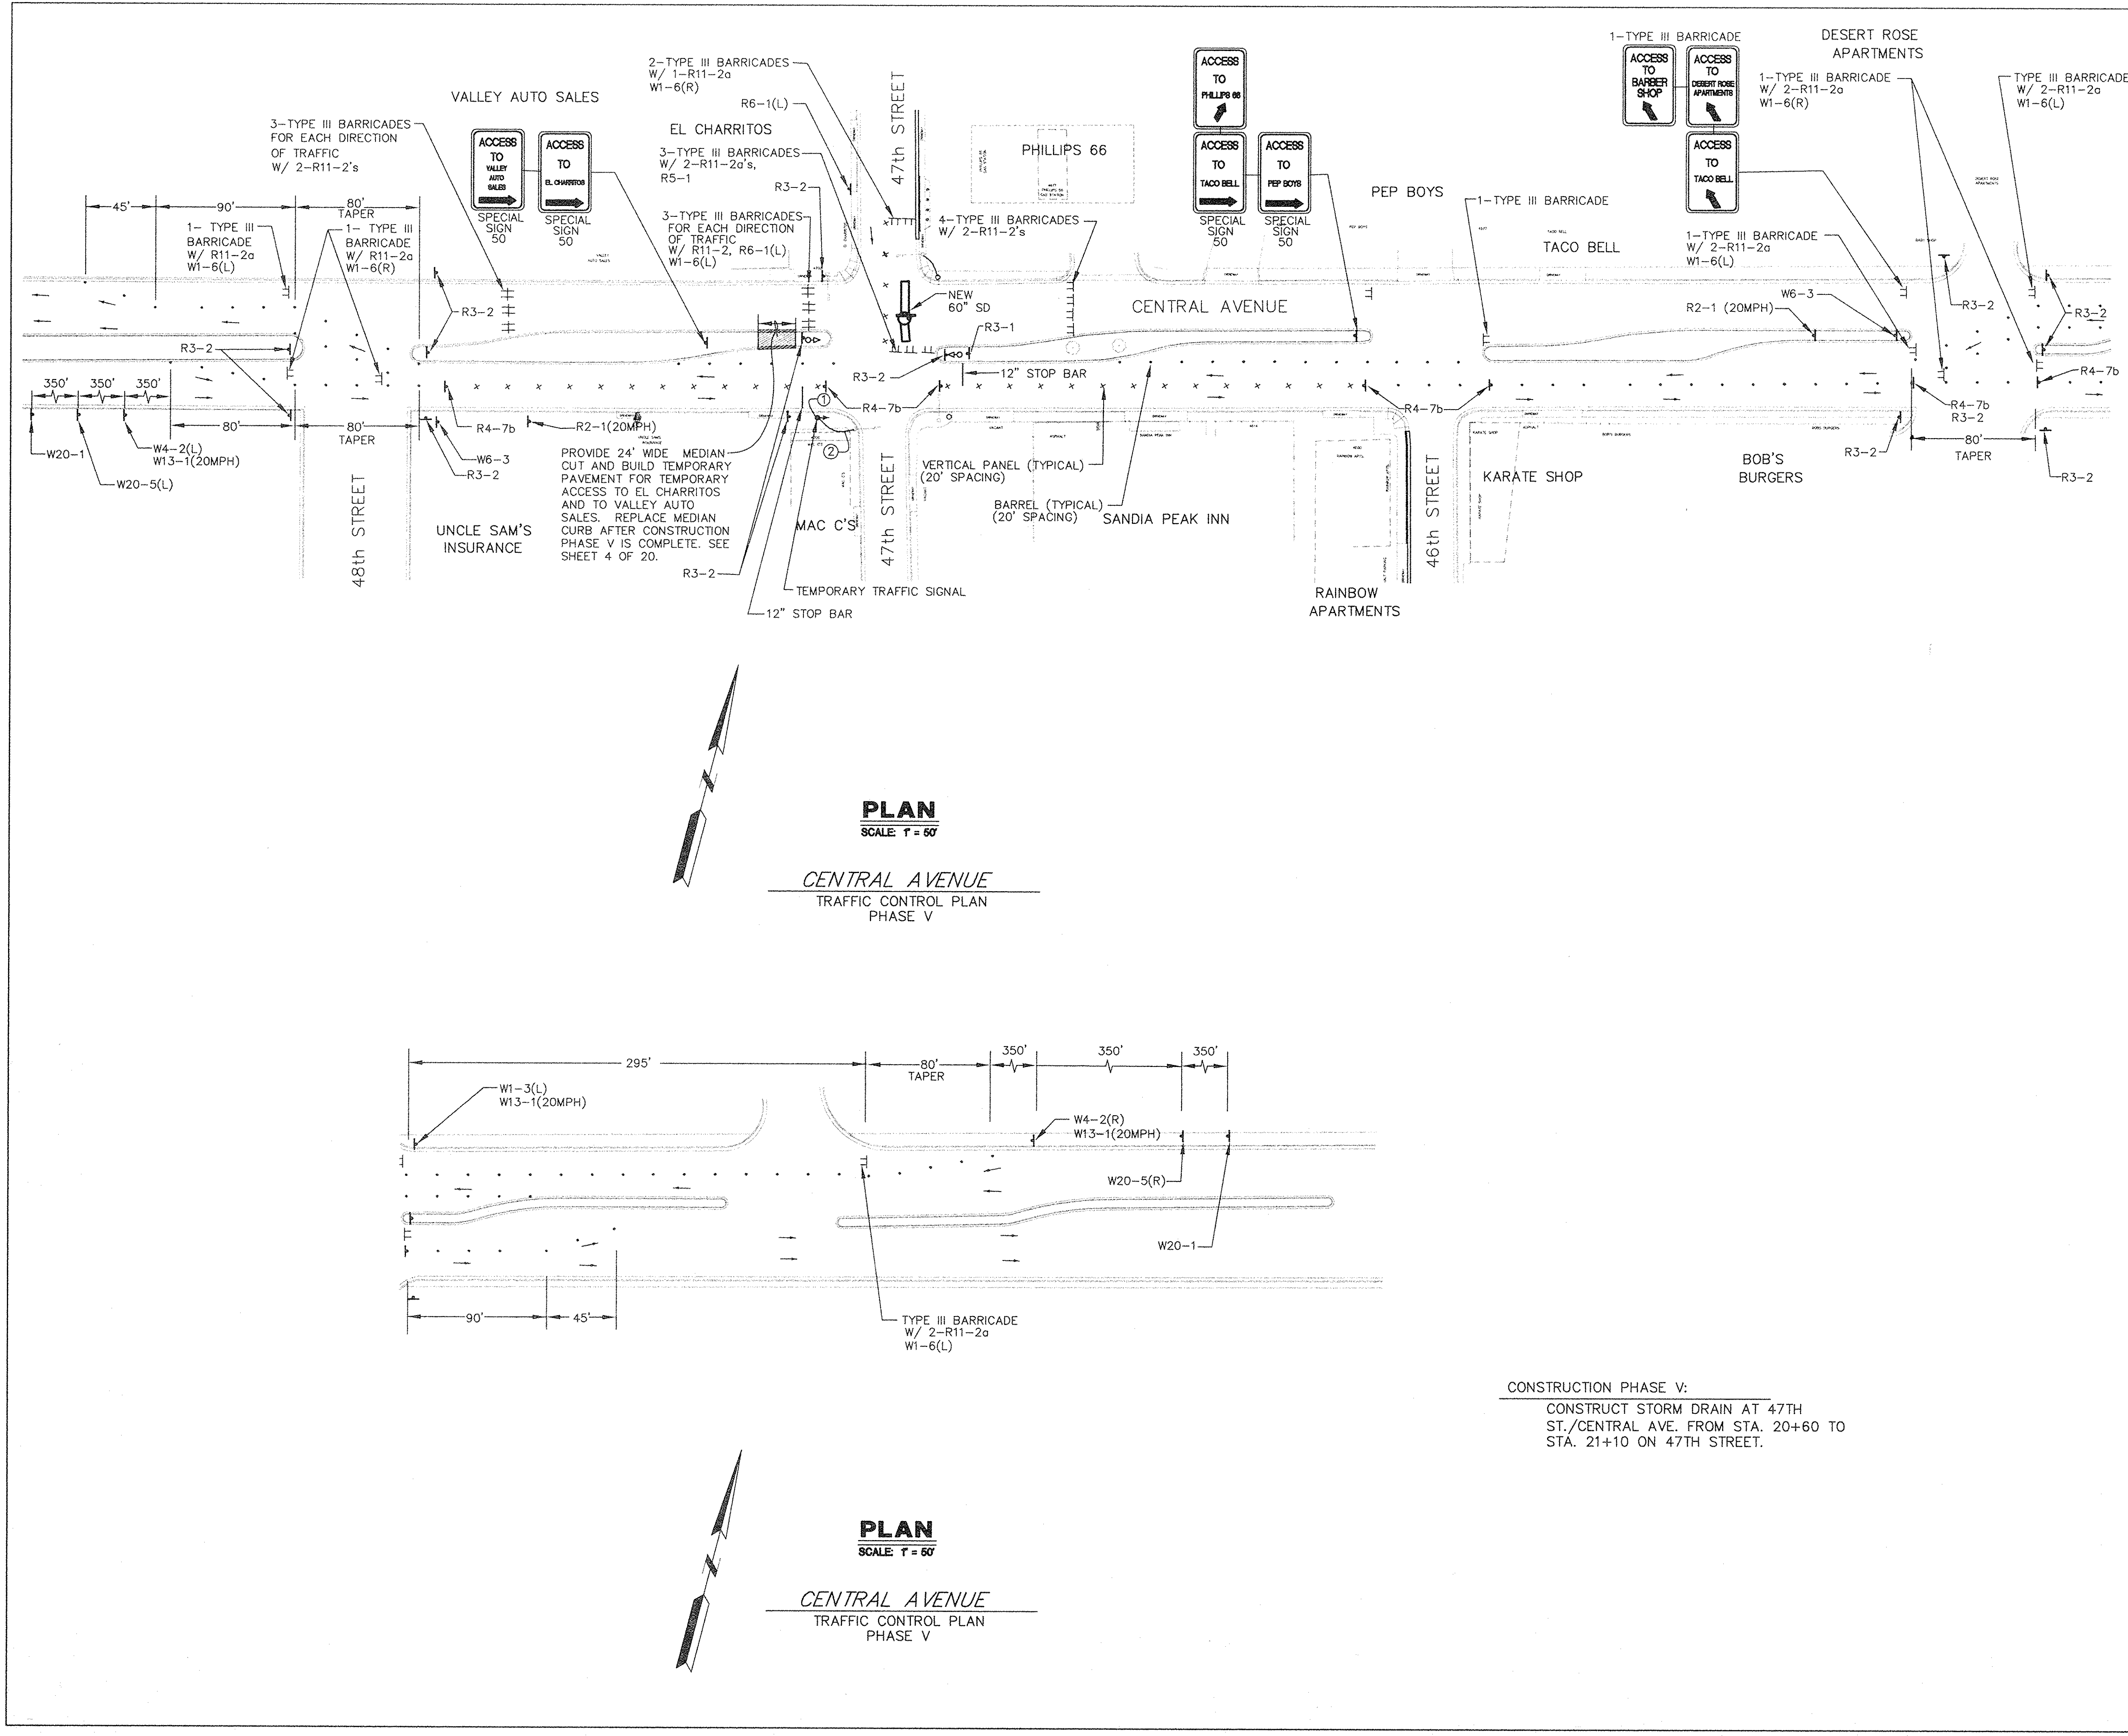

CONSTRUCTION PHASE V:
CONSTRUCT STORM DRAIN AT 47TH ST./CENTRAL AVE. FROM STA. 20+60 TO STA. 21+10 ON 47TH STREET.

- KEYED NOTES:**
- PLACE TEMPORARY 15' PEDESTAL POLE WITH 3-SECTION SIGNAL HEAD.
 - LAY 2" RIGID CONDUIT WITH 5 CONDUCTOR CABLE ON GROUND FROM EXISTING MASTARM ON SOUTHWEST CORNER OF INTERSECTION TO TEMPORARY PEDESTAL POLE.

RECORD DRAWING
09/04



CITY OF ALBUQUERQUE PUBLIC WORKS DEPARTMENT ENGINEERING DIVISION	
TITLE: CENTRAL - ATRISCO DRAINAGE IMPROVEMENTS CENTRAL AVENUE TRAFFIC CONTROL PLAN- PHASE V	
Design Review Committee	City Engineer Approval
City Project No. 674902	Zone Map No. K-12-Z
Sheet 18	Of 21

AS BUILT INFORMATION		BENCH MARKS		SURVEY INFORMATION		ENGINEER'S SEAL		REVISIONS	
CONTRACTOR	DATE	ALBUQUERQUE CONTROL SURVEY B.M. NO. 17-12	DATE	NO.	BY			NO.	DATE
ALBUQUERQUE CONTROL SURVEY B.M. NO. 17-12		LOCATED 2.3 MILES WEST OF DOWNTOWN ALBUQUERQUE		1					
INSPECTOR'S NAME		SOUTHWEST SIDE OF ATRISCO RD.		2					
INSPECTOR'S DATE		THE STATION IS AN ACS 3 1/4" ALUM. CAP RIVETED TO A		3					
FIELD VERIFICATION BY		PIPE 0.25 FT. ABOVE GROUND AND IS STAMPED "17-J12, 1999"		4					
FIELD VERIFICATION DATE		PLANE COORDINATES: X=367999.51, Y=1489049.30, EL= 4955.128		5					
RECORDED BY				6					
RECORDED DATE				7					