

PLAN
SCALE 1" = 60'


47th STREET (NORTH OF CENTRAL)
TRAFFIC CONTROL PLAN
PHASE VI-A

CONSTRUCTION PHASE VI-A:
CONSTRUCT STORM DRAIN FROM
STA. 21+10 TO STA. 23+46 ON
47TH STREET.

- GENERAL NOTES FOR PHASE VI-A:
- CONTRACTOR SHALL MAINTAIN ACCESS TO THE FIRE STATION HOUSE AT ALL TIMES DURING CONSTRUCTION OF THIS PHASE. CONTRACTOR SHALL PROVIDE EMERGENCY VEHICLE ACCESS FROM THE FIRE STATION TO CENTRAL AVENUE AT ALL TIMES DURING CONSTRUCTION.
 - CONTRACTOR SHALL KEEP THE FIRE STATION APPRISED OF WHEN CONSTRUCTION FOR THIS PROJECT BEGINS. CONTRACTOR SHALL NOTIFY THE FIRE STATION 10 DAYS IN ADVANCE OF STARTING CONSTRUCTION ON PHASE VI-A. (CONTACT TERRELL TREAT OR JOE GARCIA AT 836-8740.)
 - CONTRACTOR SHALL CONSTRUCT THE PORTION OF STORM DRAIN PIPE IN FRONT OF THE FIRE STATION (STATIONS 22+71 TO 23+46) BETWEEN 9:00 P.M. AND 4:00 A.M. AT NIGHTTIME TO MAXIMIZE FIRE STATION ACCESS.
 - CONTRACTOR SHALL NOT STORE EQUIPMENT AND PIPE MATERIAL OR PLACE EXCAVATED DIRT WITHIN RIGHT-OF-WAY BETWEEN STATIONS 21+10 AND 23+60 ON 47TH STREET.

AS BUILT INFORMATION	
CONTRACTOR	
WORK STARTED BY	
DATE	
ACCEPTANCE BY	
DATE	
REVISION BY	
DATE	
REVISION BY	
DATE	

SURVEY INFORMATION	
FIELD NOTES	
NO.	BY
1	
2	
3	
4	
5	
6	
7	

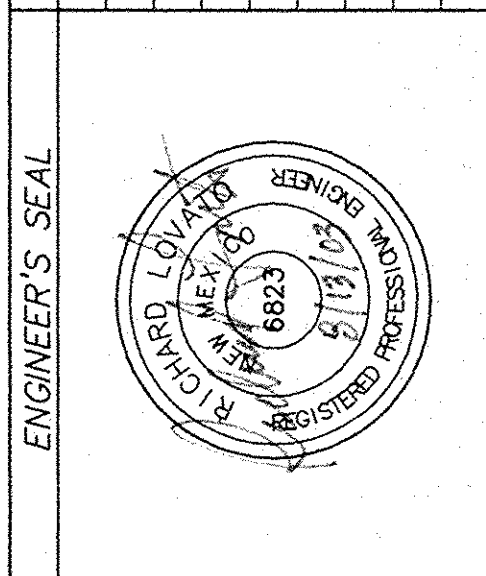

RECORD DRAWING
09/04



CITY OF ALBUQUERQUE
PUBLIC WORKS DEPARTMENT
ENGINEERING DIVISION

TITLE: CENTRAL - ATRISCO DRAINAGE IMPROVEMENTS
47th STREET
TRAFFIC CONTROL PLAN - PHASE VI-A

Design/Review Committee	City Engineer Approval	Mo./Day/Yr.	Mo./Day/Yr.

City Project No. 674902 Zone Map No. K-12-Z Sheet 19 Of 21