

PLAN
SCALE: 1" = 60'

47th STREET (NORTH OF CENTRAL)


TRAFFIC CONTROL PLAN
PHASE VI-B

CONSTRUCTION PHASE VI-B:

CONSTRUCT STORM DRAIN FROM STA. 23+46
TO STA. 28+00 (INCLUDES CONSTRUCTION
OF MANHOLE AT STATION 23+46).

CONSTRUCTION PHASE VII:

REHABILITATE EXISTING 48" STORM DRAIN SOUTH
OF CENTRAL AVENUE ON 47TH STREET.

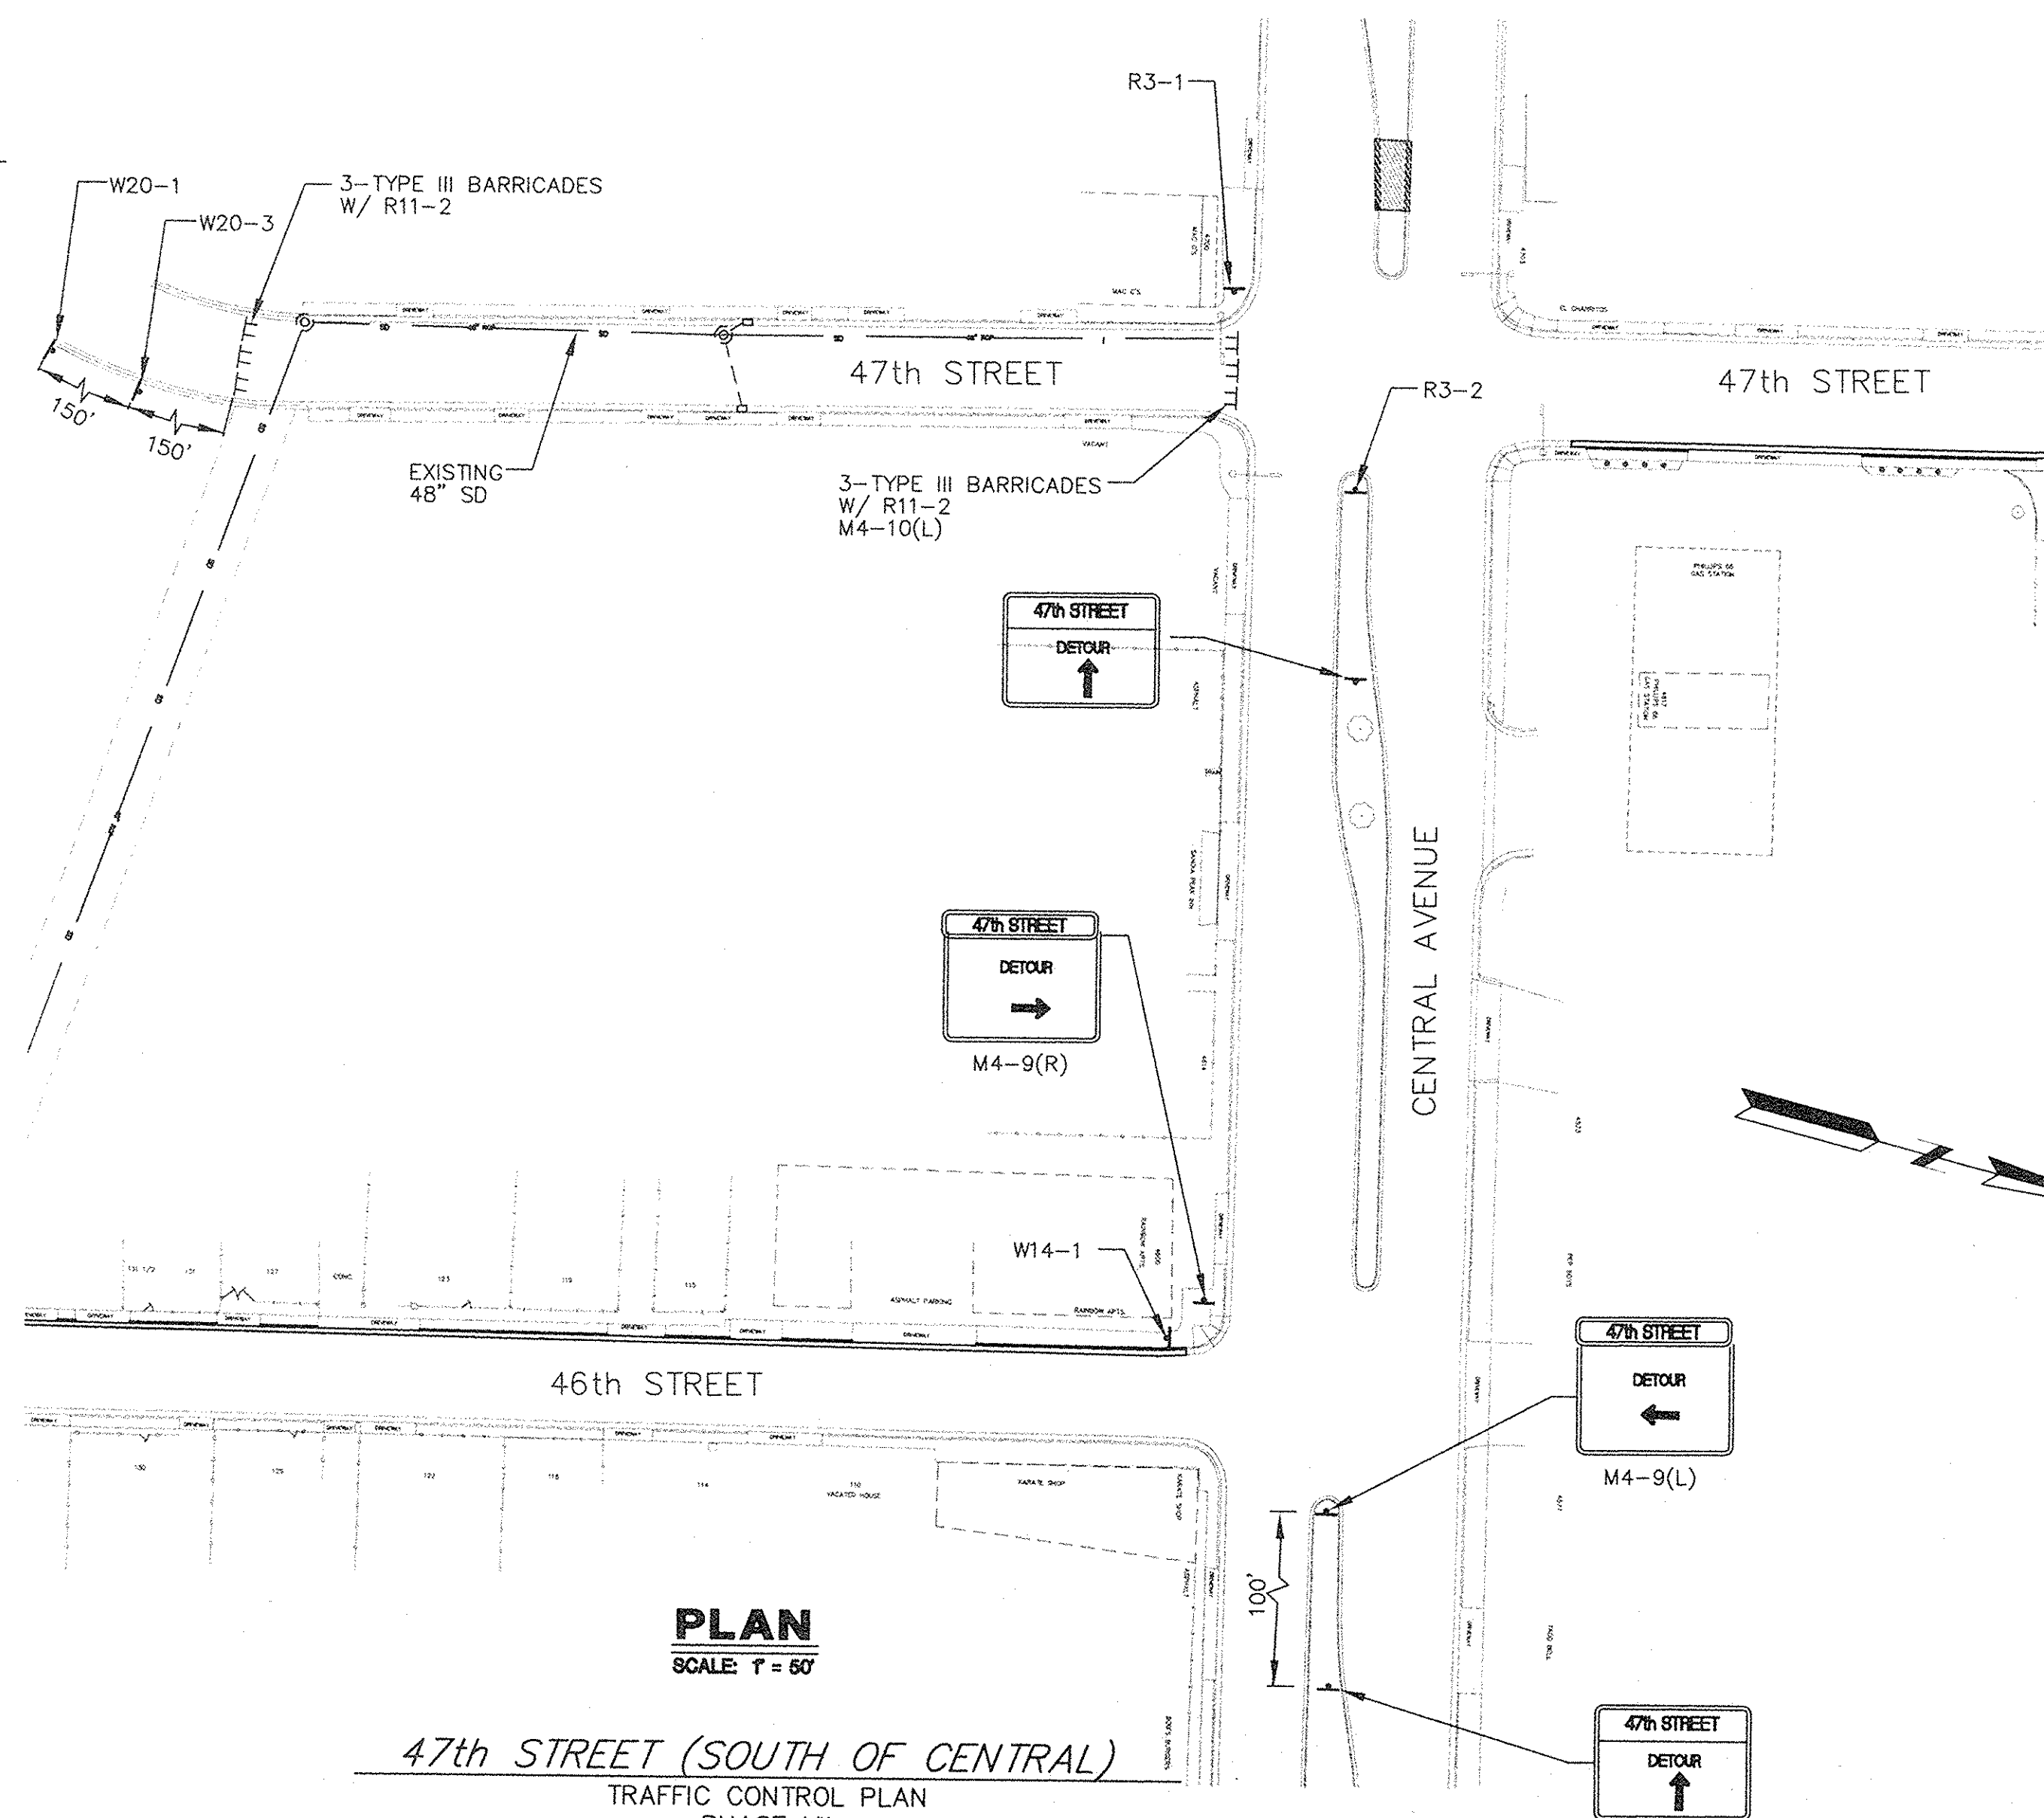

PLAN
SCALE: 1" = 60'

47th STREET (SOUTH OF CENTRAL)

TRAFFIC CONTROL PLAN
PHASE VII

KEYED NOTES:

- CONTRACTOR SHALL MAINTAIN ACCESS TO FIRE STATION AT ALL TIMES DURING CONSTRUCTION PHASE VI-B. THE CONTRACTOR SHALL NOTIFY THE FIRE DEPARTMENT 10 DAYS IN ADVANCE OF STARTING CONSTRUCTION OF PHASE VI-B.

DURING CONSTRUCTION OF THE MANHOLE AT STATION 23+46, MAINTAIN ACCESS TO FIRE STATION FROM STATION 23+32 TO THE SOUTH.

- MAXIMIZE ACCESS TO GLENDALE ROAD FROM 47TH STREET DURING PHASE VI-B. ONLY CLOSE OFF GLENDALE ROAD WHEN PERFORMING WORK AT THE GLENDALE/47TH ST. INTERSECTION.

GENERAL NOTES FOR PHASE VI-B:

- CONTRACTOR SHALL NOTIFY THE FIRE STATION 10 DAYS IN ADVANCE OF STARTING CONSTRUCTION ON PHASE VI-B.
(CONTACT TERRELL TREAT OR JOE GARCIA AT 836-8740.)
- CONTRACTOR SHALL NOT STORE EQUIPMENT AND PIPE MATERIAL OR PLACE EXCAVATED DIRT WITHIN RIGHT-OF-WAY BETWEEN STATIONS 21+10 AND 23+60.

RECORD DRAWINGS WERE PREPARED
FROM INFORMATION PROVIDED BY
THE CONTRACTOR

RECORD DRAWING
09/04

LARKIN GROUP, INC.
CONSULTING ENGINEERS AND SURVEYORS
8500 MENAUL BLVD. NE A-440
(505) 273-7300

CITY OF ALBUQUERQUE
PUBLIC WORKS DEPARTMENT
ENGINEERING DIVISION

TITLE: **CENTRAL - ATRISCO DRAINAGE IMPROVEMENTS**
47th STREET
TRAFFIC CONTROL PLAN - PHASE VI-B TO PHASE VIII

Design Review Committee	City Engineer Approval	Mo./Day/Yr.	Mo./Day/Yr.
SEP 10 2003	SEP 10 2003		

City Project No. **674902** Zone Map No. **K-12-Z** Sheet **20** Of **21**

AS BUILT INFORMATION				BENCH MARKS				SURVEY INFORMATION				ENGINEER'S SEAL				REVISIONS			
CONTRACTOR	DATE	INSPECTOR'S	DATE	ALBUQUERQUE CONTROL SURVEY B.M. NO. 17-J12	DATE	LOCATED 2.3 MILES WEST OF DOWNTOWN ALBUQUERQUE	DATE	NO.	BY	DATE	NO.	DATE	REMARKS	BY	DATE	NO.	DATE	REMARKS	BY
								1			1					1			
								2			2					2			
								3			3					3			
								4			4					4			
								5			5					5			
								6			6					6			
								7			7					7			