


# CENTRAL - ATRISCO DRAINAGE IMPROVEMENTS PHASE II

## INDEX OF SHEETS

DESCRIPTION	SHEET NO.
TITLE SHEET, VICINITY MAP & INDEX	1
GENERAL NOTES	2
STORM DRAIN PLAN & PROFILE SHEETS	
47TH STREET	3, 4, & 5
GLENDAL PLACE (EAST OF 47TH ST.)	6, 7, & 8
RINCON ROAD	9 & 10
GLENDAL ROAD (WEST OF 47TH ST.)	11, 12, 13, & 14
WATER & SEWER PLAN & PROFILE SHEETS	
47TH STREET	15, 16, & 17
GLENDAL PLACE (EAST OF 47TH ST.)	18, 19, & 20
GLENDAL CUL-DE-SAC WEST & GLENDAL PL. CUL-DE-SAC	21
RINCON ROAD	22, 23 & 24
RINCON ROAD STA. 18+50 TO 20+00.	
16" WELL COLLECTION LINE, 46th ST. TO ATRISCO WELL #4.	
6" WATER LINE, HERRERA ROAD	24
RINCON COURT	25
GLENDAL ROAD (WEST OF 47TH ST.)	26, 27, 28, & 29
SHUT OFF PLAN	30
MISCELLANEOUS DETAILS	
TYPICAL STREET SECTIONS	31
STORM DRAINAGE DETAILS	31
47th STREET & GLENDAL	32

CITY OF ALBUQUERQUE  
NEW MEXICO

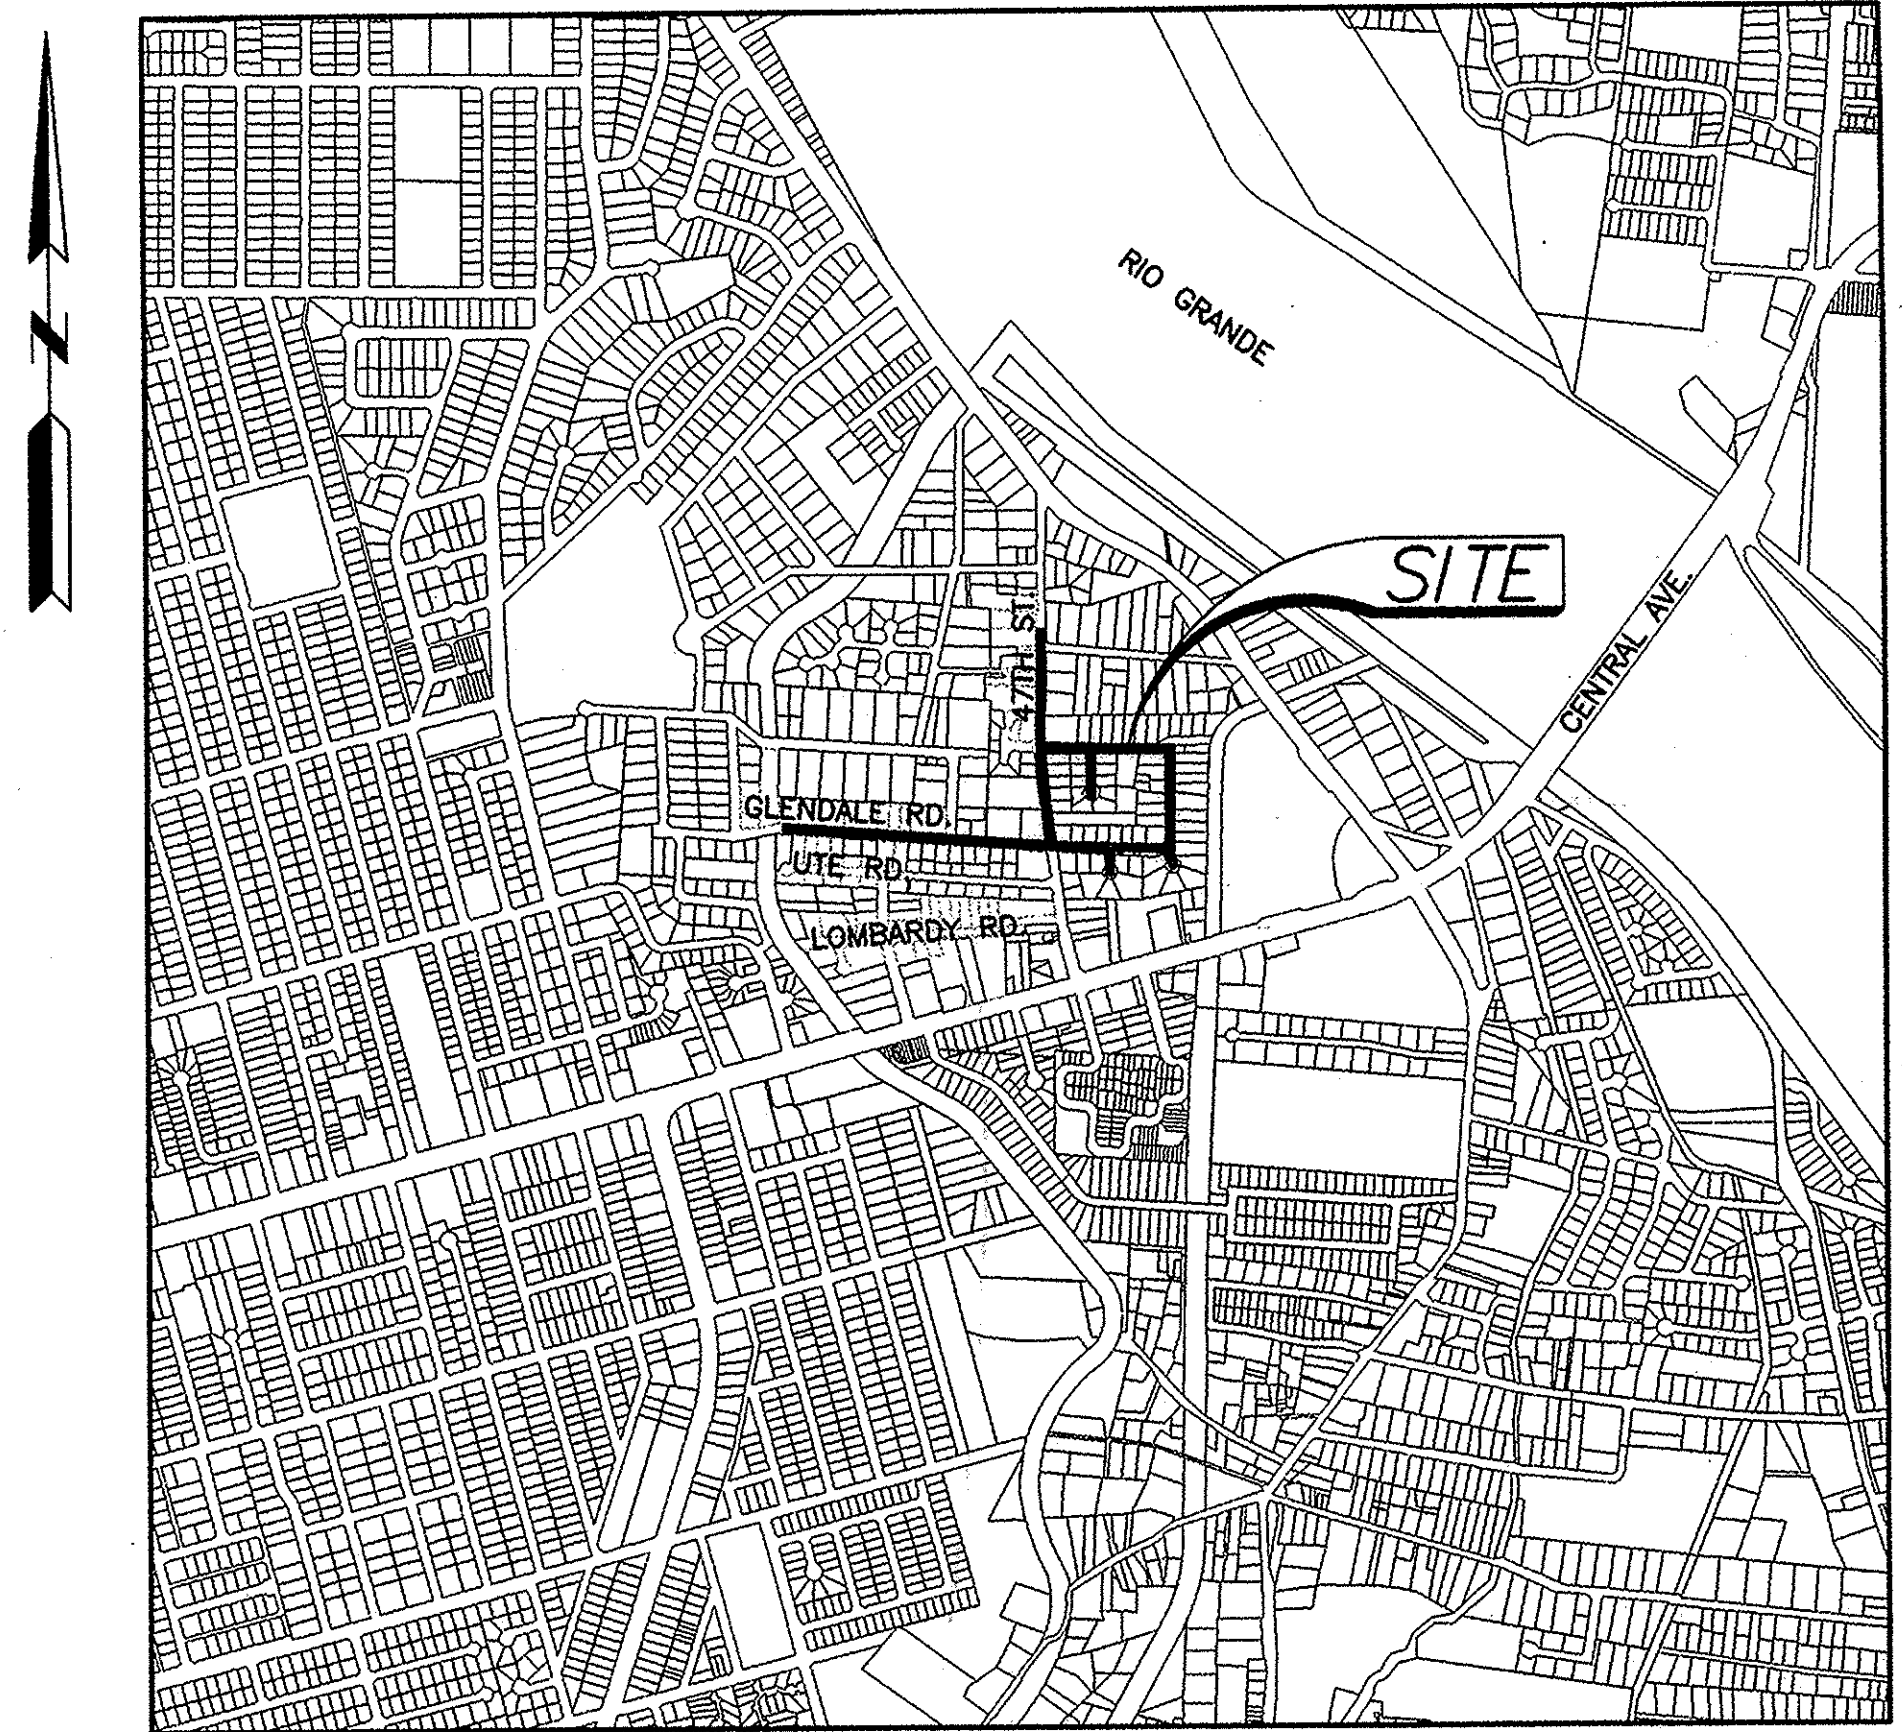

VICINITY MAP  
ZONE ATLAS K-12-2  
SCALE: 1" = 1000'

UTILITY CONTACTS:

PNM Electric & Gas Co.  
Electric  
Jim Hill  
Phone (505) 241-3581  
Gas  
Joe Dunlop  
Phone (505) 241-7771  
jdunlop@pnm.com  
  
Qwest Communications  
Michael D. Velarde  
Phone (505) 245-8352  
  
Comcast Cable Television Co.  
Rita Erickson  
Phone (505) 761-6235  
  
New Mexico One Call System  
Phone (505) 260-1990  
  
Water Systems Division  
Phone (505) 857-8200

RECORD DRAWING  
JUNE 2007

**LARKIN GROUP, INC.**  
8500 MENAUL NE. SUITE A-440  
ALBUQUERQUE, NEW MEXICO 87112  
TELEPHONE (505) 275-7500  
FAX (505) 275-0748

SET NUMBER

REV.	SHEETS	CITY ENGINEER	DATE	USER DEPARTMENT	DATE	USER DEPARTMENT	DATE
ENGINEER'S STAMP & SIGNATURE		APPROVALS		ENGINEER	DATE	*****	
		DRC Chairman			6-8-06	APPROVED FOR CONSTRUCTION	
		Transportation			6/8/06		
		Water/Wastewater			6/7/06		
		Hydrology			6-7-06		
		Constr. Coord.			6-7-6		
City Project No.		674903		Sheet 1 of 32			