


SEE SHEET 3

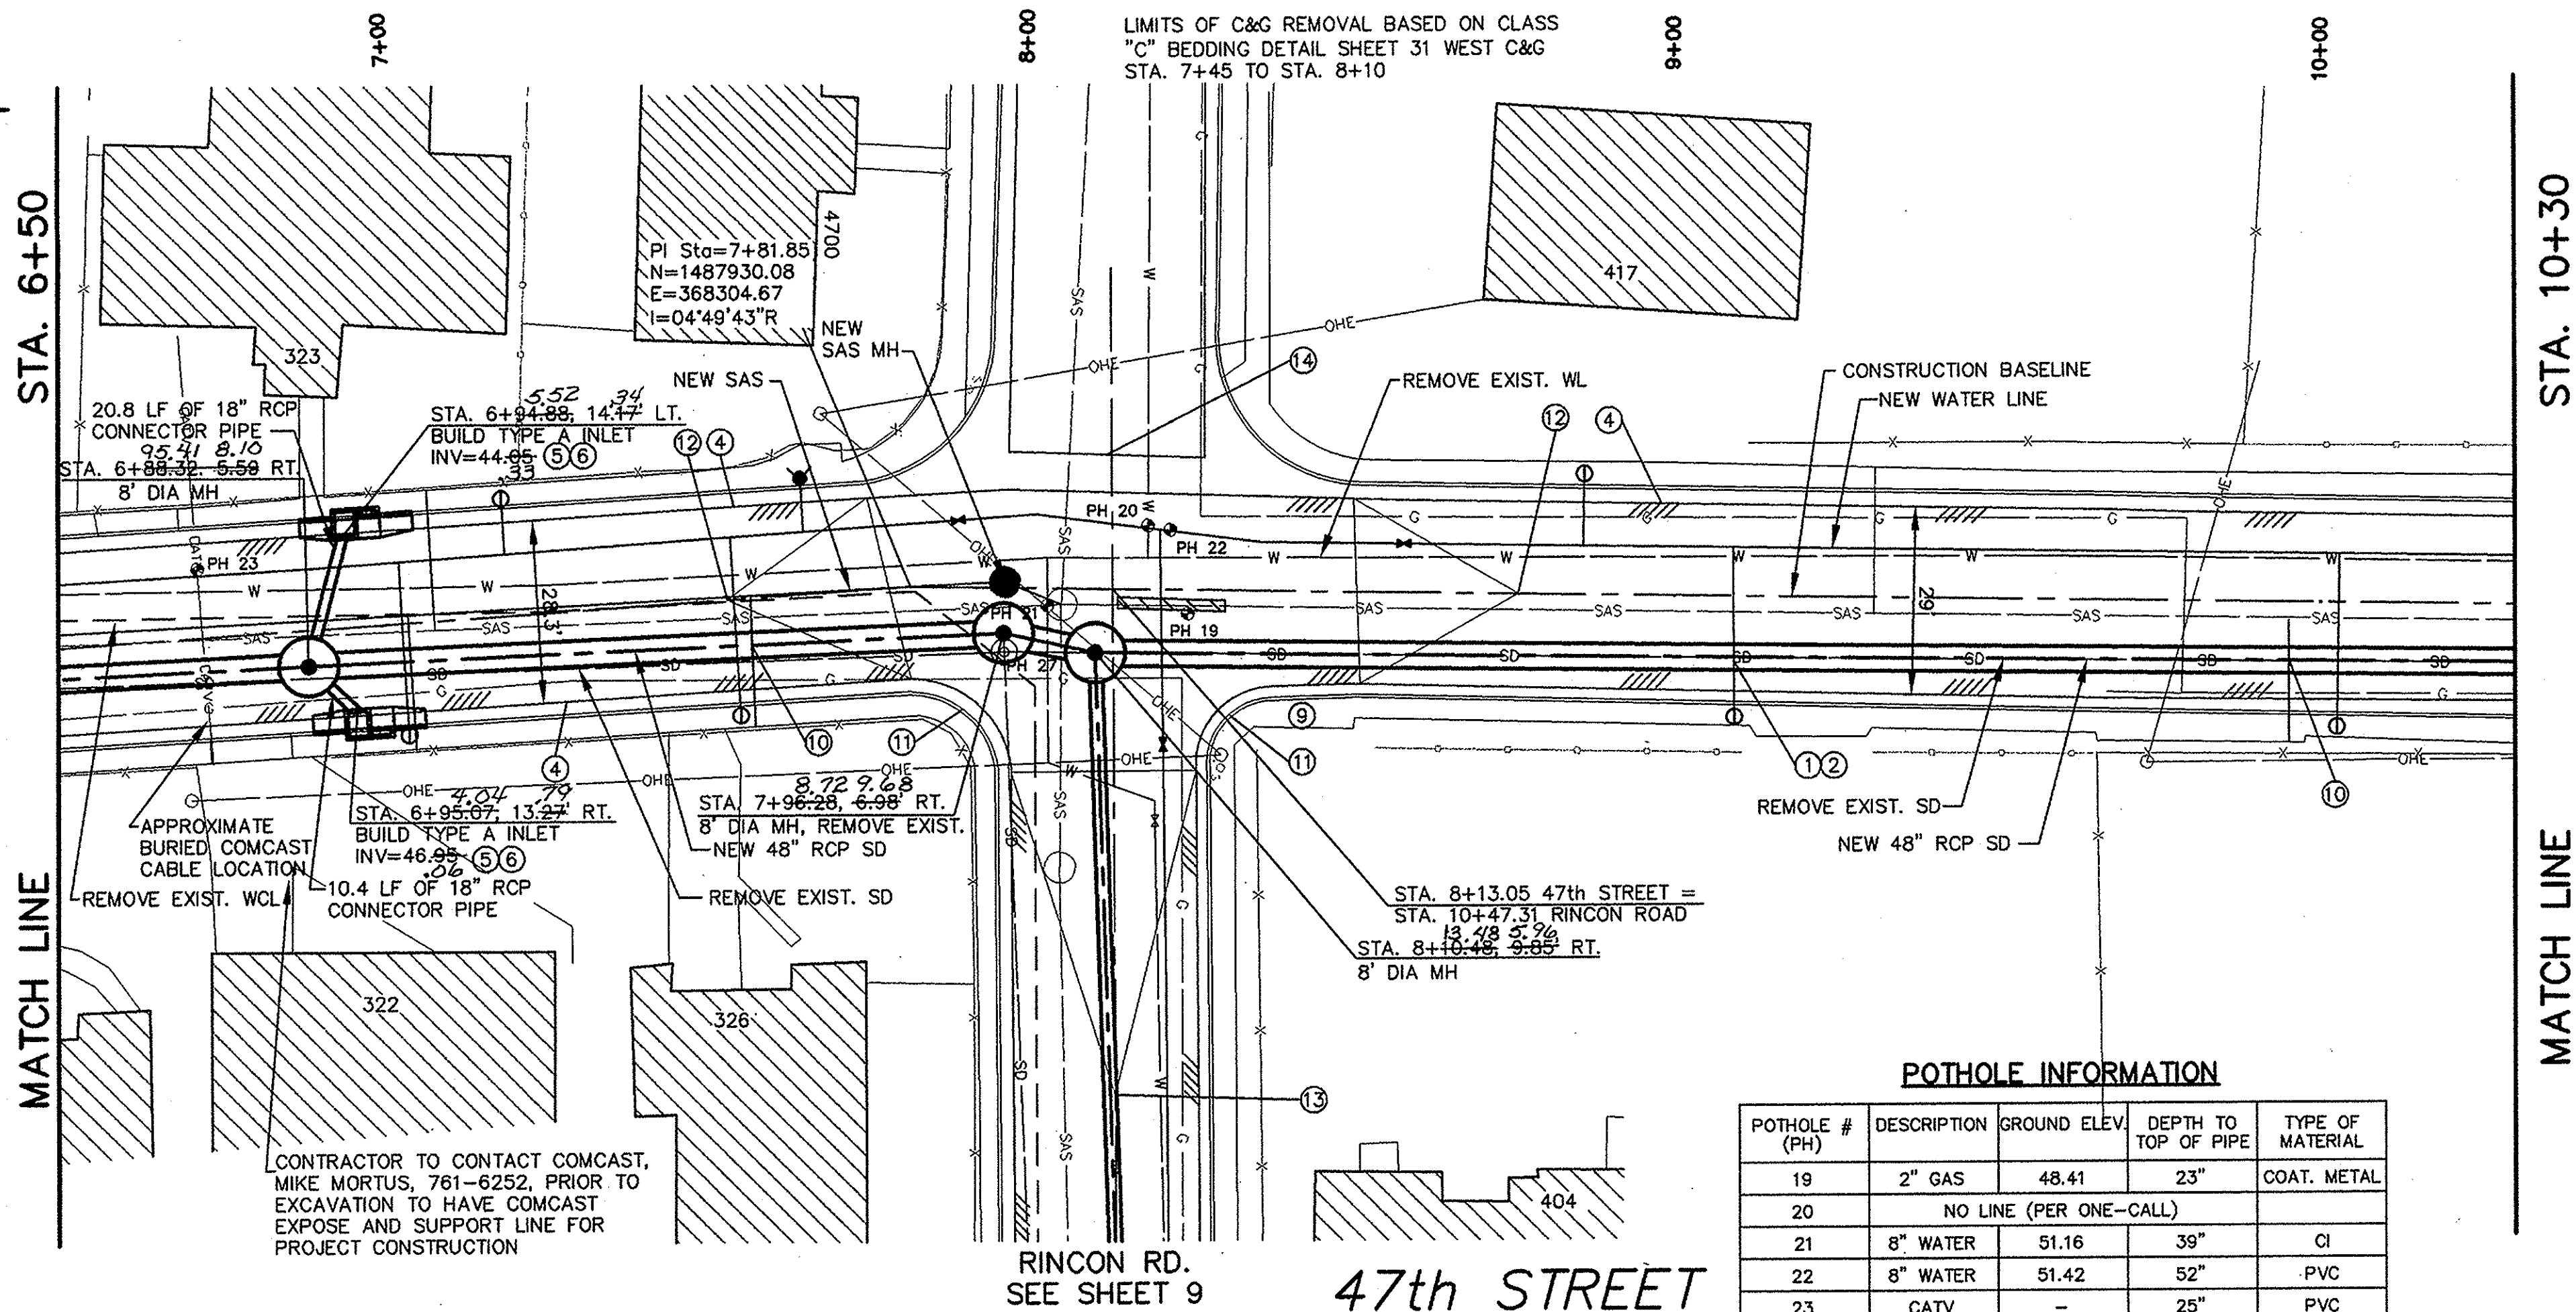


SEE SHEET 5

KEYED NOTES

- REPLACED WATER SERVICE LINES SHALL BE REPLACED WITH COPPER TUBING WITH NO SPLICES FROM METER TO MAIN PER COA STD. DWG. 2362.
- ANY EXISTING UTILITIES EXPOSED DURING CONSTRUCTION SHALL BE SUPPORTED AND PROTECTED DURING CONSTRUCTION. THIS SUPPORT AND PROTECTION SHALL BE CONSIDERED INCIDENTAL TO PROJECT CONSTRUCTION AND NO SEPARATE PAYMENT WILL BE MADE.
- NOT USED THIS SHEET
- MAJOR LOCAL PAVEMENT SHALL BE REPLACED PER COA STD. DWG. 2405. SEE SHEET 31.
- CURB AND GUTTER REPLACEMENT SHALL BE PER COA STD. DWG. 2415A. SEE SHEET 2 NOTES.
- STORM DRAIN INLETS SHALL BE PER COA STD. DWG. 2201. INLET GRATES WILL BE PER COA STD. DWG. 2220.
- NOT USED THIS SHEET
- NOT USED THIS SHEET
- DRIVEPADS AFFECTED BY CONSTRUCTION SHALL BE RECONSTRUCTED PER COA STD. DWG. 2425.
- VERIFY SEWER LATERAL CLEARANCE PRIOR TO INSTALLATION OF STORM DRAIN, TYP.
- INSTALL WHEEL CHAIR RAMP PER COA STD. DWG. 2441, CASE I, OR CASE II WITH HEADER CURB USING TRUNCATED DOMES, DETECTABLE SURFACE, ON SURFACE.
- 25' HALF CROWN TRANSITION PER COA STD. DWG. 2401.
- 50' FULL CROWN TRANSITION PER COA STD. DWG. 2401.
- REPLACE DISTURBED VALLEY GUTTER IN ACCORDANCE WITH COA STD. DWG. 2420.

ENGINEER'S SEAL

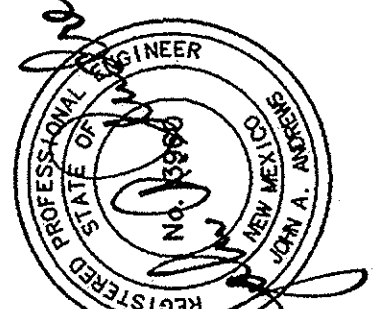

RECORD DRAWING
JUNE 2007

LARKIN GROUP, INC.
CONSULTING ENGINEERS AND SURVEYORS
5500 MENAUL BLVD., NE #4-440
ALBUQUERQUE, NEW MEXICO 87112
(505) 275-7500 FAX (505) 275-0748

CITY OF ALBUQUERQUE
DEPARTMENT OF MUNICIPAL DEVELOPMENT
STORM DRAINAGE DESIGN DIVISION

TITLE: **CENTRAL - ATRISCO DRAINAGE IMPROVEMENTS PHASE II**
47th STREET STA. 6+50 TO 10+30

Design Review Committee	City Engineer Approval	Mo./Day/Yr.	Mo./Day/Yr.
APPROVED JUN 08 2006 DESIGN REVIEW COMMITTEE	APPROVED JUN 08 2006 CITY ENGINEER		

Project No. 674903 Zone Map No. K-12-Z Sheet 4 of 32