


POTHOLE INFORMATION

POTHOLE # (PH)	DESCRIPTION	GROUND ELEV.	DEPTH TO TOP OF PIPE	TYPE OF MATERIAL
10	2" WATER	48.14	51"	IP
11A	WATER	48.93	NO LOC. TO 60"	
11B	2" GAS	48.87	26"	COAT. METAL

SEE SHEET 6

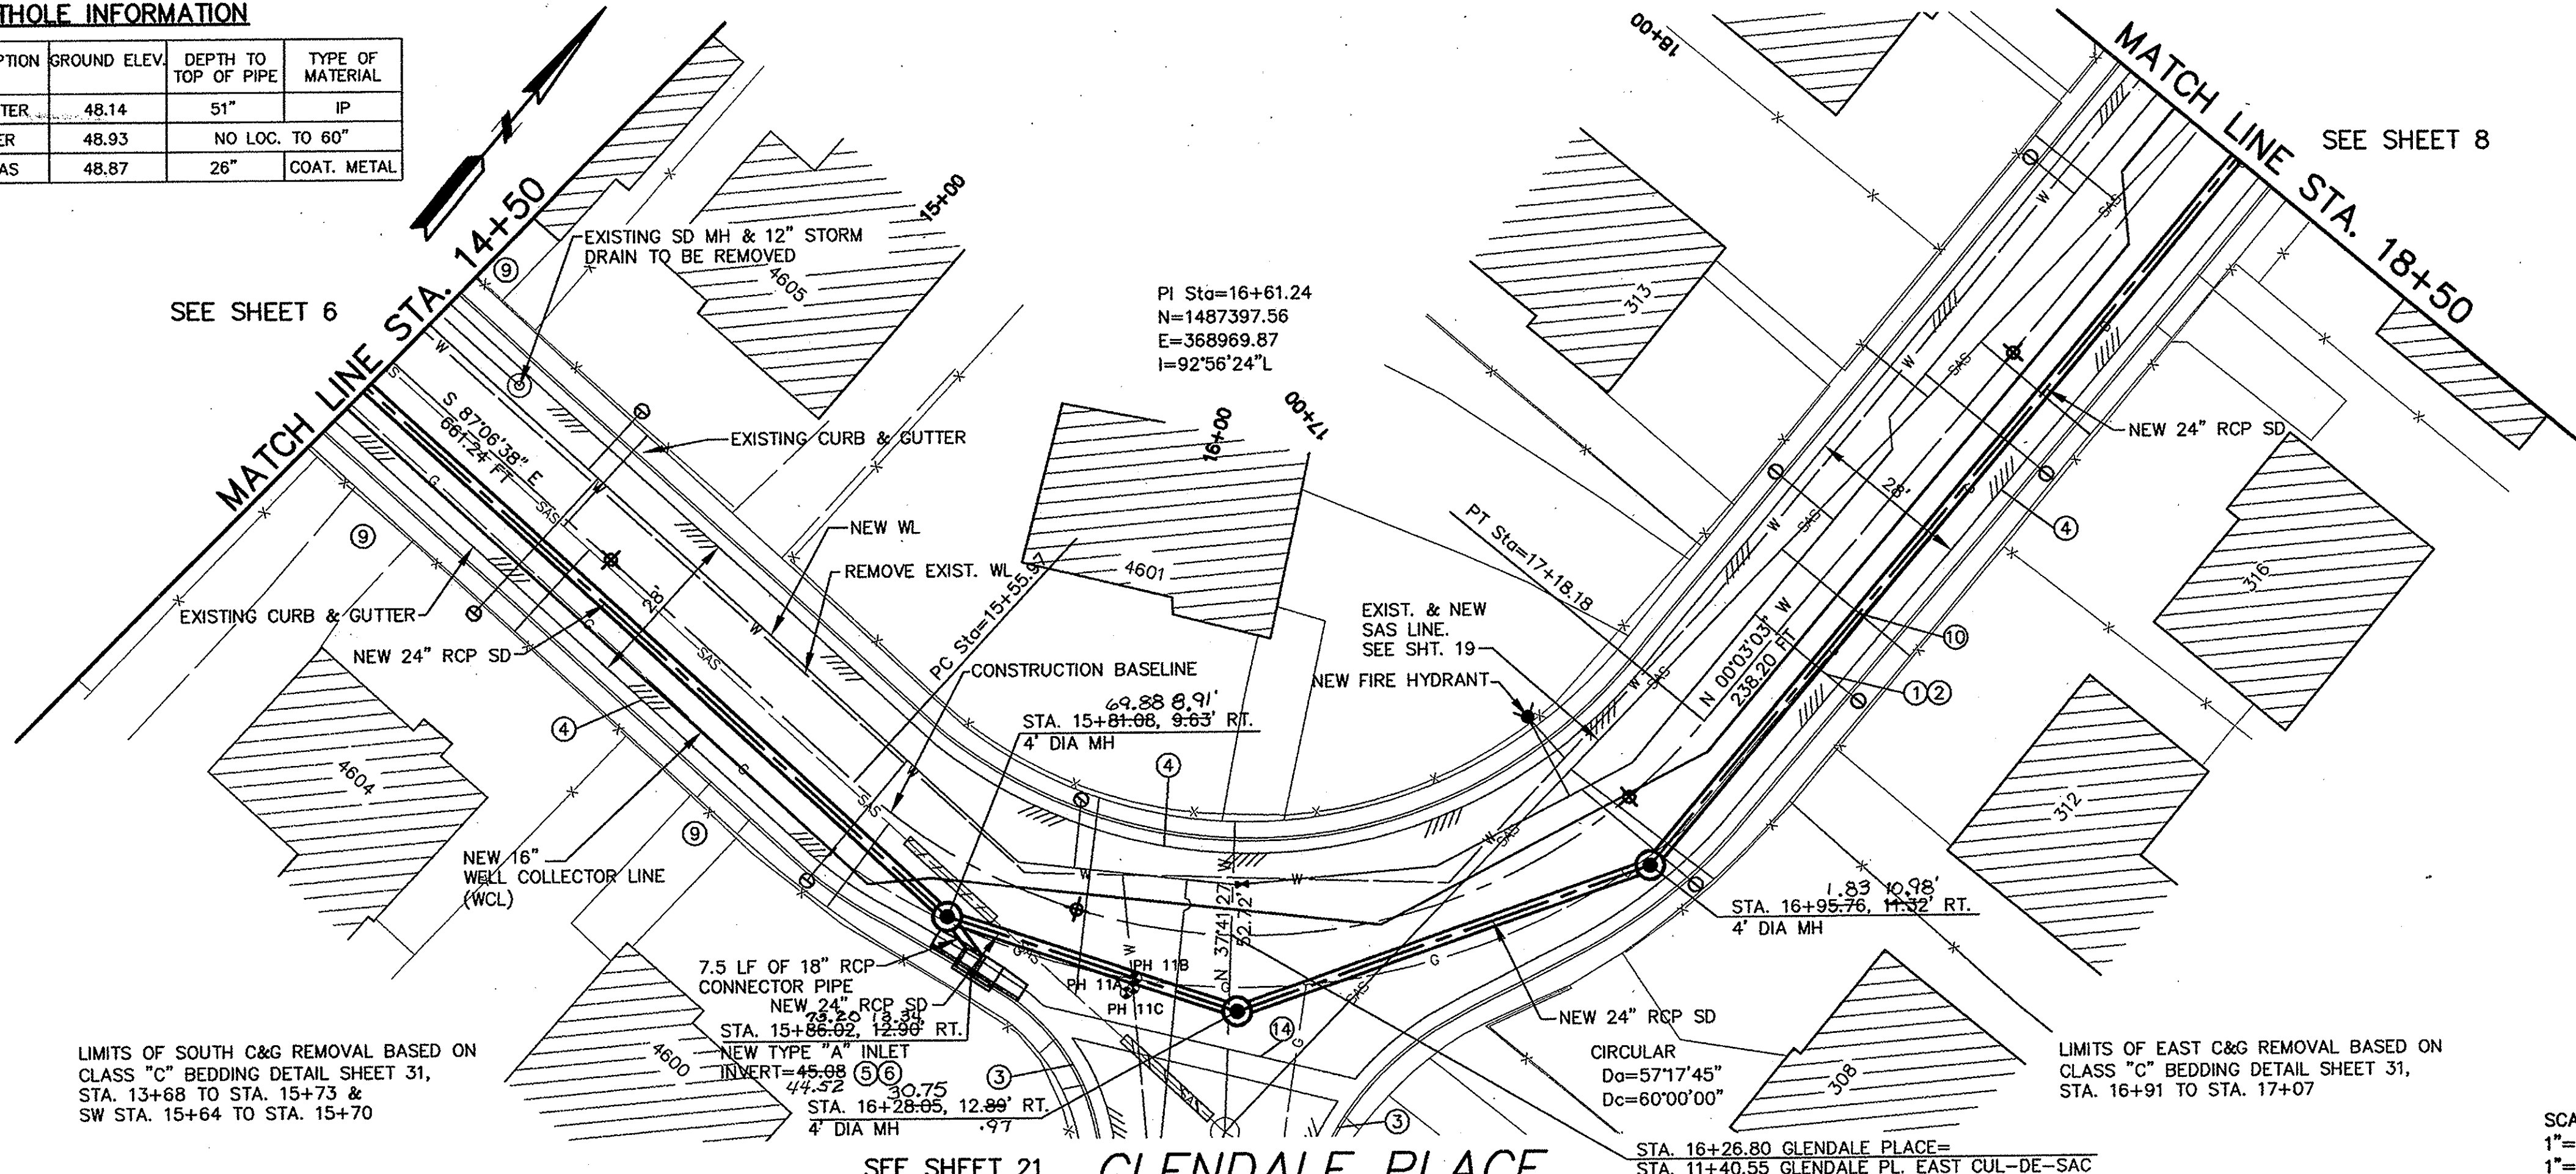

LIMITS OF SOUTH C&G REMOVAL BASED ON CLASS "C" BEDDING DETAIL SHEET 31, STA. 13+68 TO STA. 15+73 & SW STA. 15+64 TO STA. 15+70


SEE SHEET 21

GLENDAL PLACE

STA. 16+26.80 GLENDAL PLACE= STA. 11+40.55 GLENDAL PL. EAST CUL-DE-SAC

SCALES:
1"=20' HORIZ.
1"= 2' VERT.

NGVD DATUM 1929

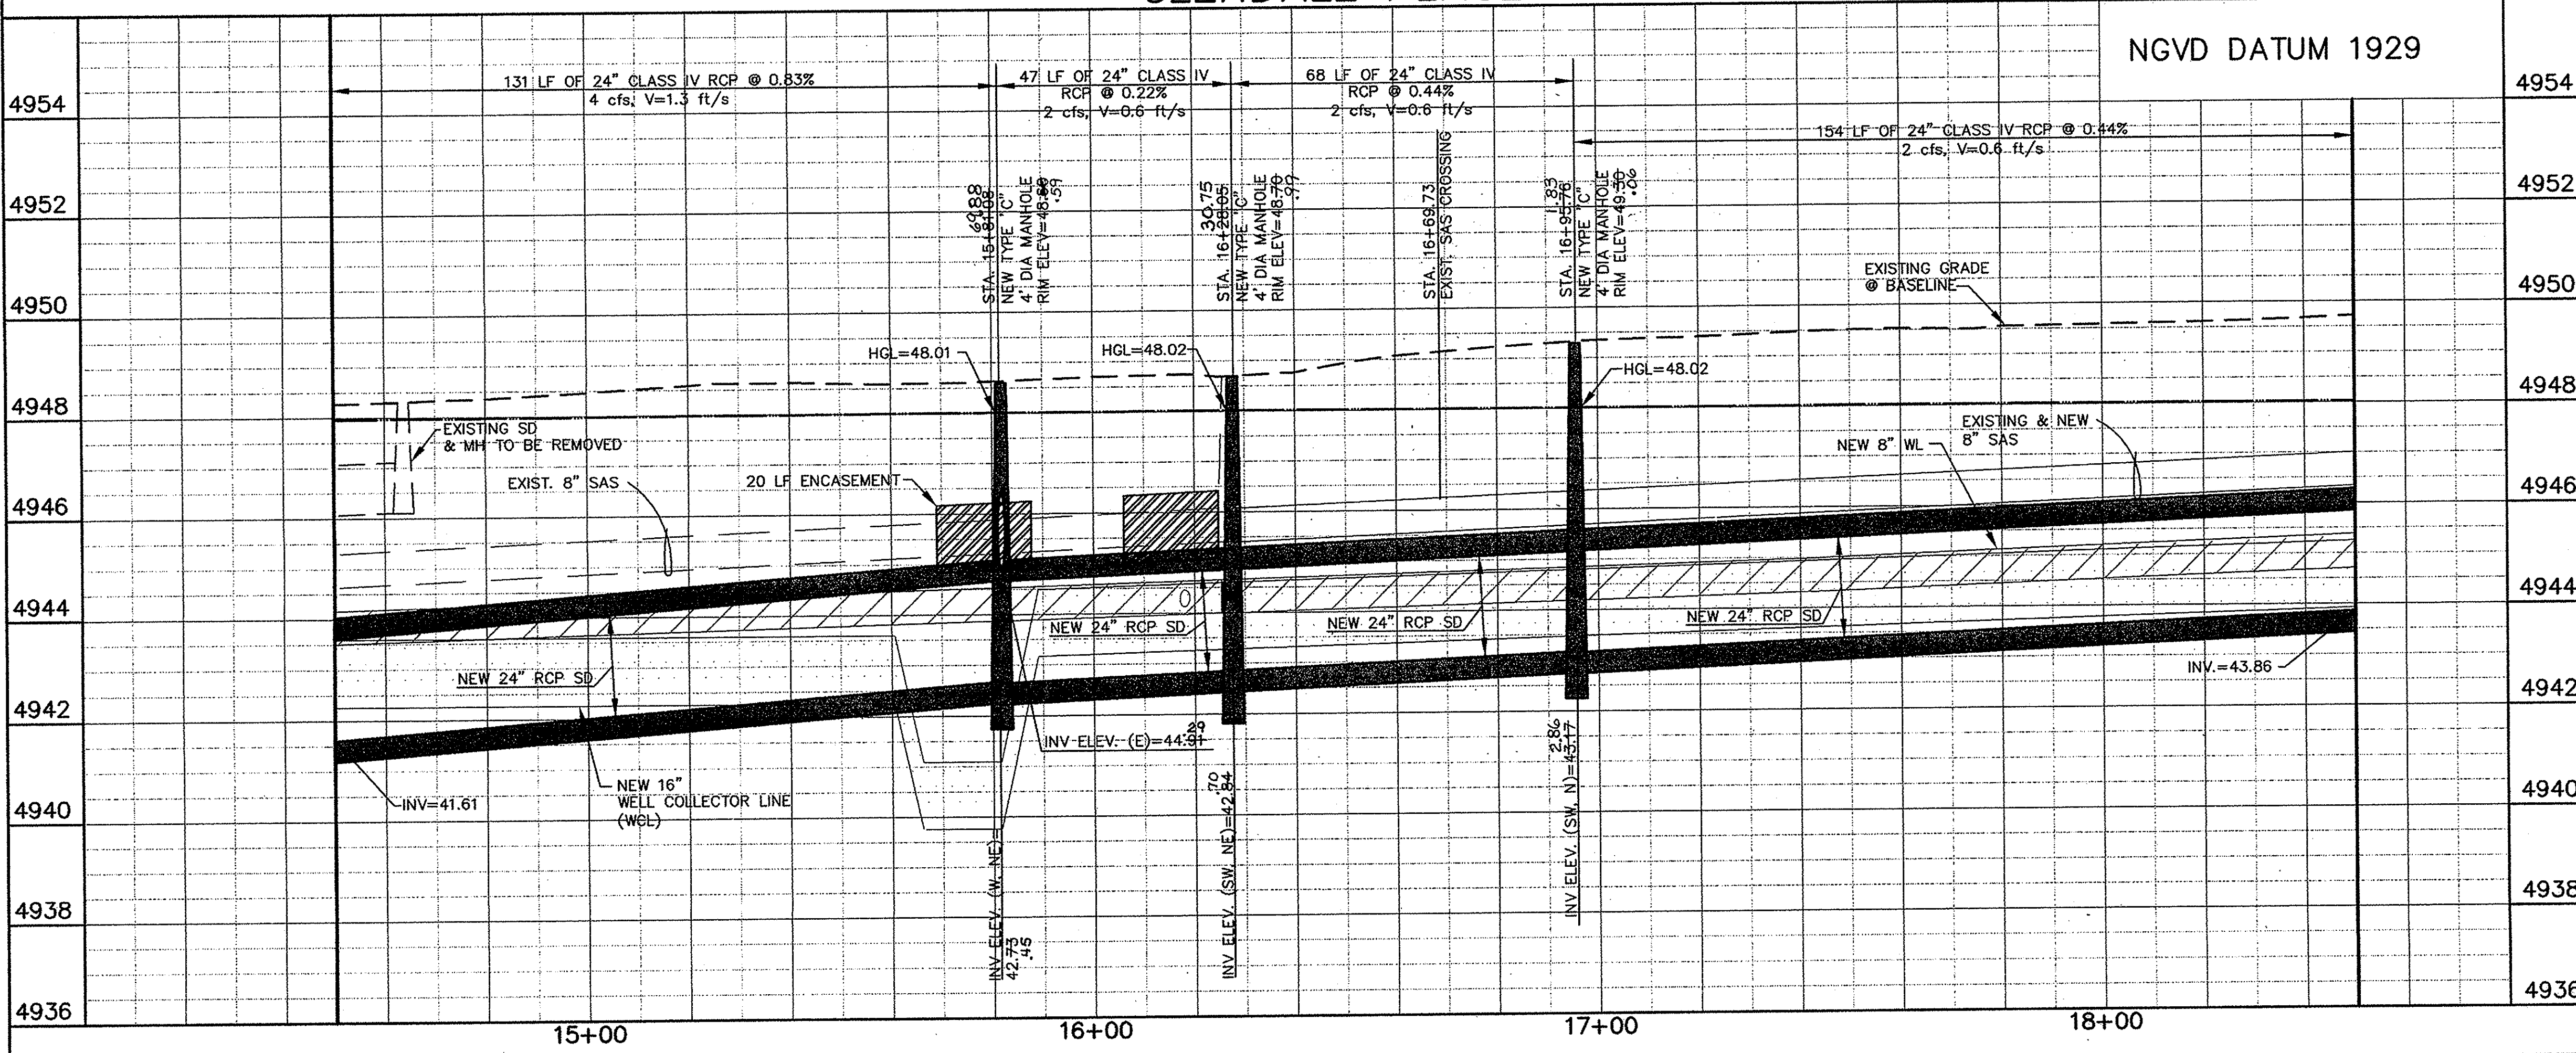

KEYED NOTES

- REPLACED WATER SERVICE LINES SHALL BE REPLACED WITH COPPER TUBING WITH NO SPLICES FROM METER TO MAIN PER COA STD. DWG. 2362.
- ANY EXISTING UTILITIES EXPOSED DURING CONSTRUCTION SHALL BE SUPPORTED AND PROTECTED DURING CONSTRUCTION. THIS SUPPORT AND PROTECTION SHALL BE CONSIDERED INCIDENTAL TO PROJECT CONSTRUCTION AND NO SEPARATE PAYMENT WILL BE MADE.
- THE DISTURBANCE OF ANY EXISTING WHEELCHAIR RAMP DURING CONSTRUCTION SHALL REQUIRE THE REPLACEMENT OF THE ENTIRE WHEELCHAIR RAMP PER COA STD. DWG. 2441, CASE I, OR CASE II WITH HEADER CURB USING TRUNCATED DOMES, DETECTABLE SURFACE, ON SURFACE.
- MAJOR LOCAL PAVEMENT SHALL BE REPLACED PER COA STD. DWG. 2405. SEE SHEET 31.
- CURB AND GUTTER REPLACEMENT SHALL BE PER COA STD. DWG. 2415A. SEE SHEET 2 NOTES.
- STORM DRAIN INLETS SHALL BE PER COA STD. DWG. 2201. INLET GRATES WILL BE PER COA STD. DWG. 2220.
- NOT USED THIS SHEET
- NOT USED THIS SHEET
- DRIVEPADS AFFECTED BY CONSTRUCTION SHALL BE RECONSTRUCTED PER COA STD. DWG. 2425.
- VERIFY SEWER LATERAL CLEARANCE PRIOR TO INSTALLATION OF STORM DRAIN, TYP.
- NOT USED THIS SHEET
- NOT USED THIS SHEET
- NOT USED THIS SHEET
- REPLACE DISTURBED VALLEY GUTTER IN ACCORDANCE WITH COA STD. DWG. 2420.

AS BUILT INFORMATION CONTRACTOR: New Mexico Underground WORK: Storm Drainage Improvements APPROVED BY: Terra Land Surveys, Inc. DATE: 5/07 VERIFICATION BY: Terra Land Surveys, Inc. DATE: 7/07 MICRO-FILM INFORMATION RECORDED BY: [] DATE: [] RECORDED BY: [] DATE: []	
BENCH MARKS CITY OF ALBUQUERQUE STATION 2-K12B BEING A 3 1/4" ALUMINUM TABLE SET IN THE TOP OF CURB AT THE SOUTHEAST QUADRANT OF CENTRAL & ATRISCO SW CORNERS ARE MODIFIED GROUND VALUES BASED ON NAD 27 U.S. SURVEY FEET NORTHING=1487200.64 PROJECT GRID FACTOR EASTING=370304.57 GF=0.999681630 ELEV.=4954.92 NGVD 29	
SURVEY INFORMATION FIELD NOTES NO. 1 DATE: [] BY: []	
ENGINEER'S SEAL 	
RECORD DRAWING JUNE 2007 RECORD DRAWINGS WERE PREPARED FROM INFORMATION PROVIDED BY THE CONTRACTOR	
LARKIN GROUP, INC. CONSULTING ENGINEERS AND SURVEYORS 8500 MENAUL BLVD. NE A-440 ALBUQUERQUE, NEW MEXICO 87112 (505) 275-7500 FAX (505) 275-0748	
CITY OF ALBUQUERQUE DEPARTMENT OF MUNICIPAL DEVELOPMENT STORM DRAINAGE DESIGN DIVISION	
TITLE: CENTRAL - ATRISCO DRAINAGE IMPROVEMENTS PHASE II GLENDAL PLACE STA 14+50 TO 18+50	
Design Review Committee APPROVED JUN 08 2006 DESIGN REVIEW COMMITTEE	City Engineer Approved APPROVED JUN 08 2006 CITY ENGINEER
Project No. 674903	Zone Map No. K-12-Z
Sheet 7 OF 32	