




SURVEY INFORMATION			BENCH MARKS		AS BUILT INFORMATION	
FIELD NOTES						
NO.	BY	DATE				
1			CITY OF ALBUQUERQUE STATION 2-K12B		CONTRACTOR <i>New Mexico Underground</i>	
			BEING A 3 1/4" ALUMINUM TABLET SET IN THE TOP OF CURB AT THE SOUTHEAST QUADRANT OF CENTRAL & ATRISCO SW		WORK STARTED BY <i>TerraLand Surveys</i> DATE <i>9/06</i>	
			COORDINATES ARE MODIFIED SURVEY VALUES BASED ON NAD 27 U.S. SURVEY FEET		FIELD ACCEPTANCE BY <i>C.O.A.</i> DATE <i>5/07</i>	
			NORTHING=1487200.64 PROJECT GRID FACTOR		FIELD REVISION BY <i>TerraLand Surveys</i> DATE <i>5/07</i>	
			EASTING=370304.57 GF=0.999851630		CORRECTED BY <i>Levin Group INC</i> DATE <i>7/07</i>	
			ELEV.=4954.92 NGVD 29		RECORDED BY DATE	
					RECORDED BY DATE	

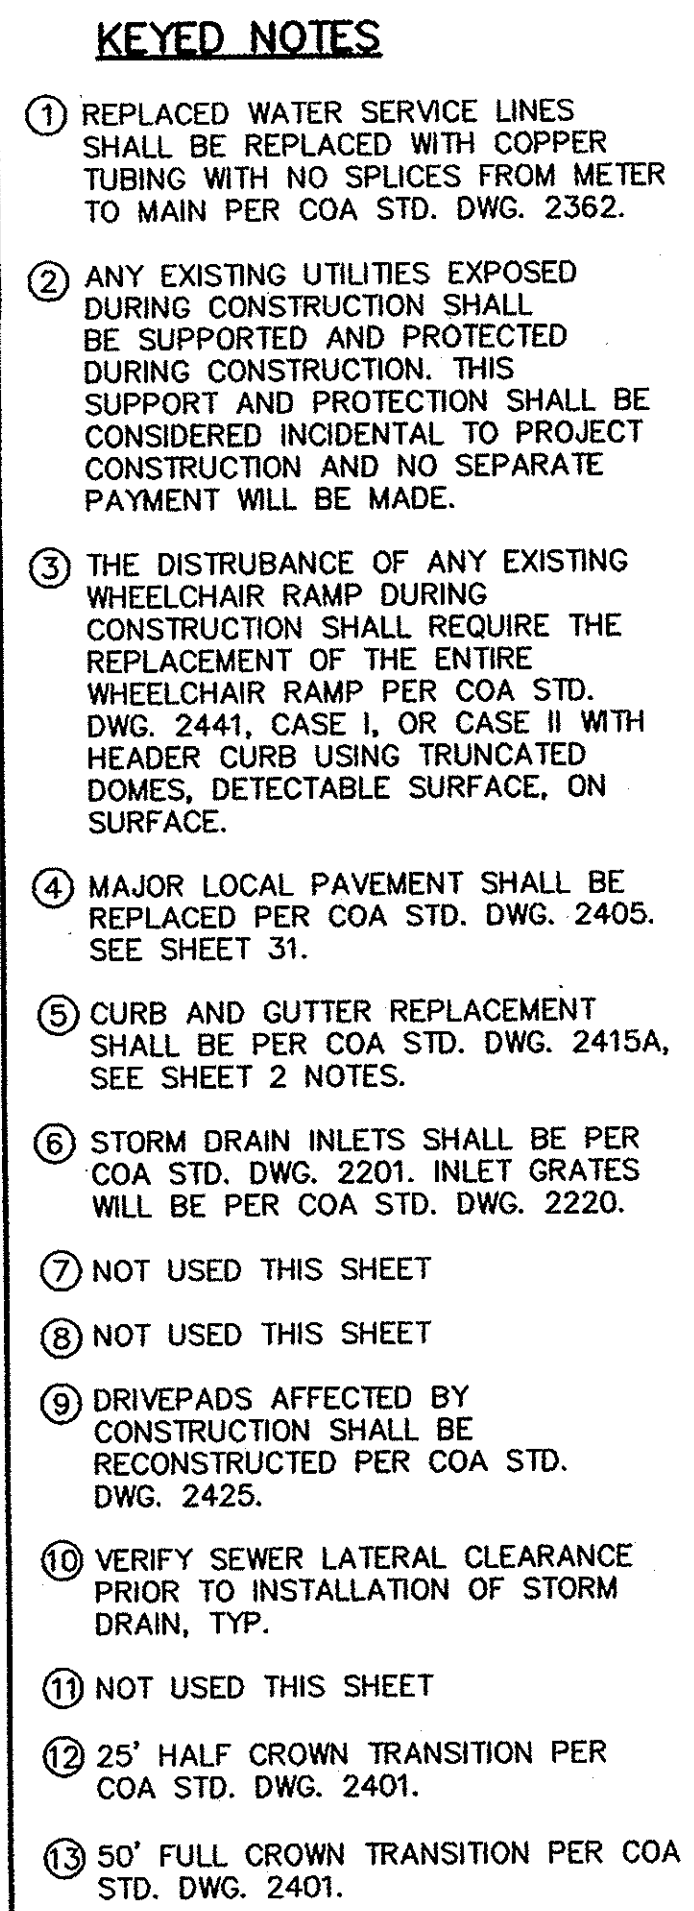