
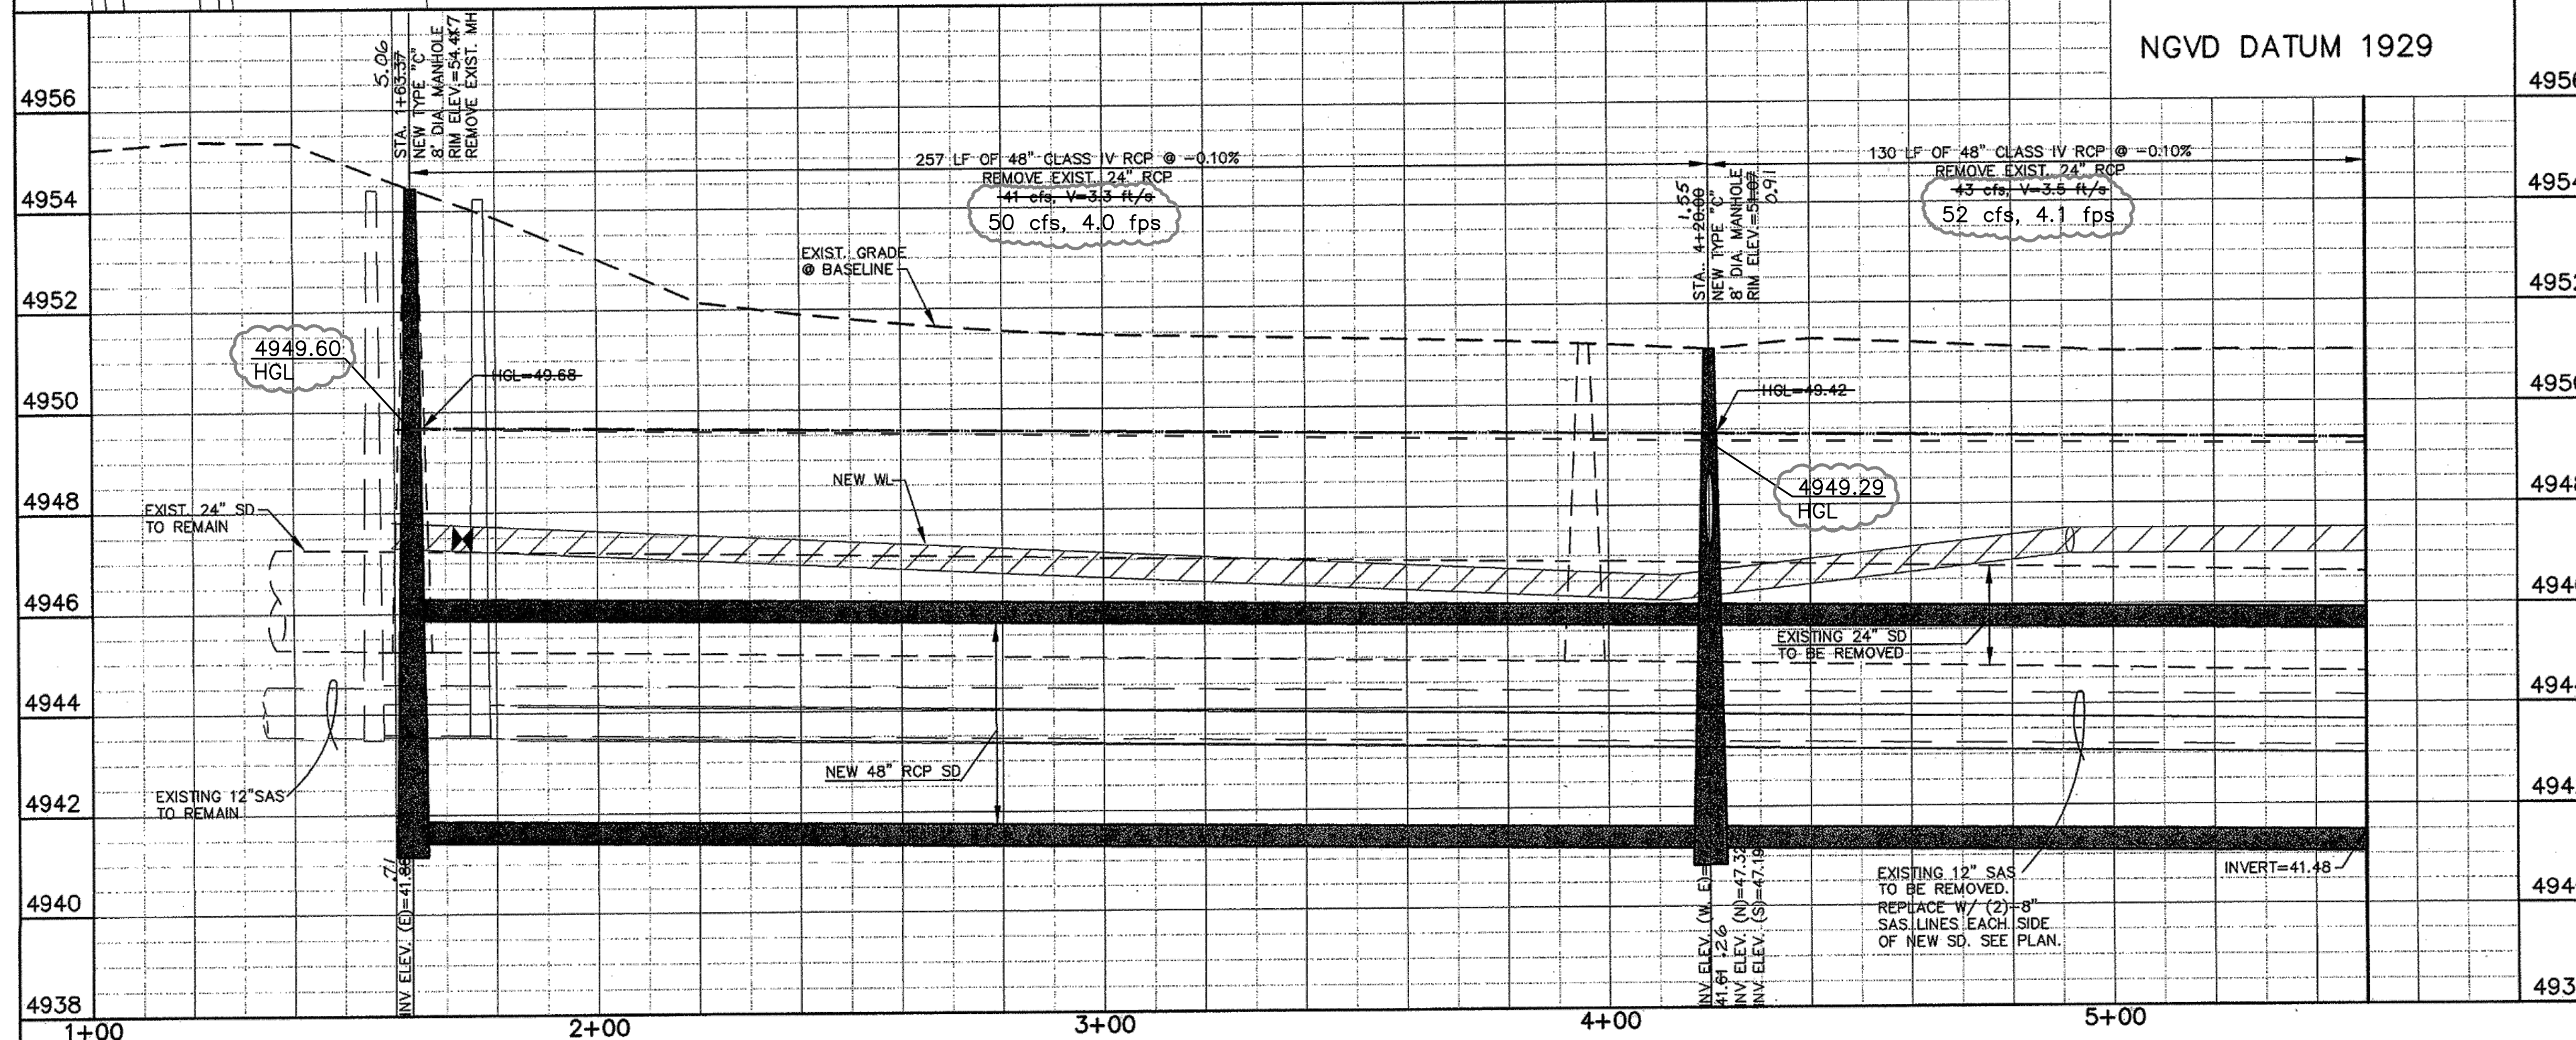


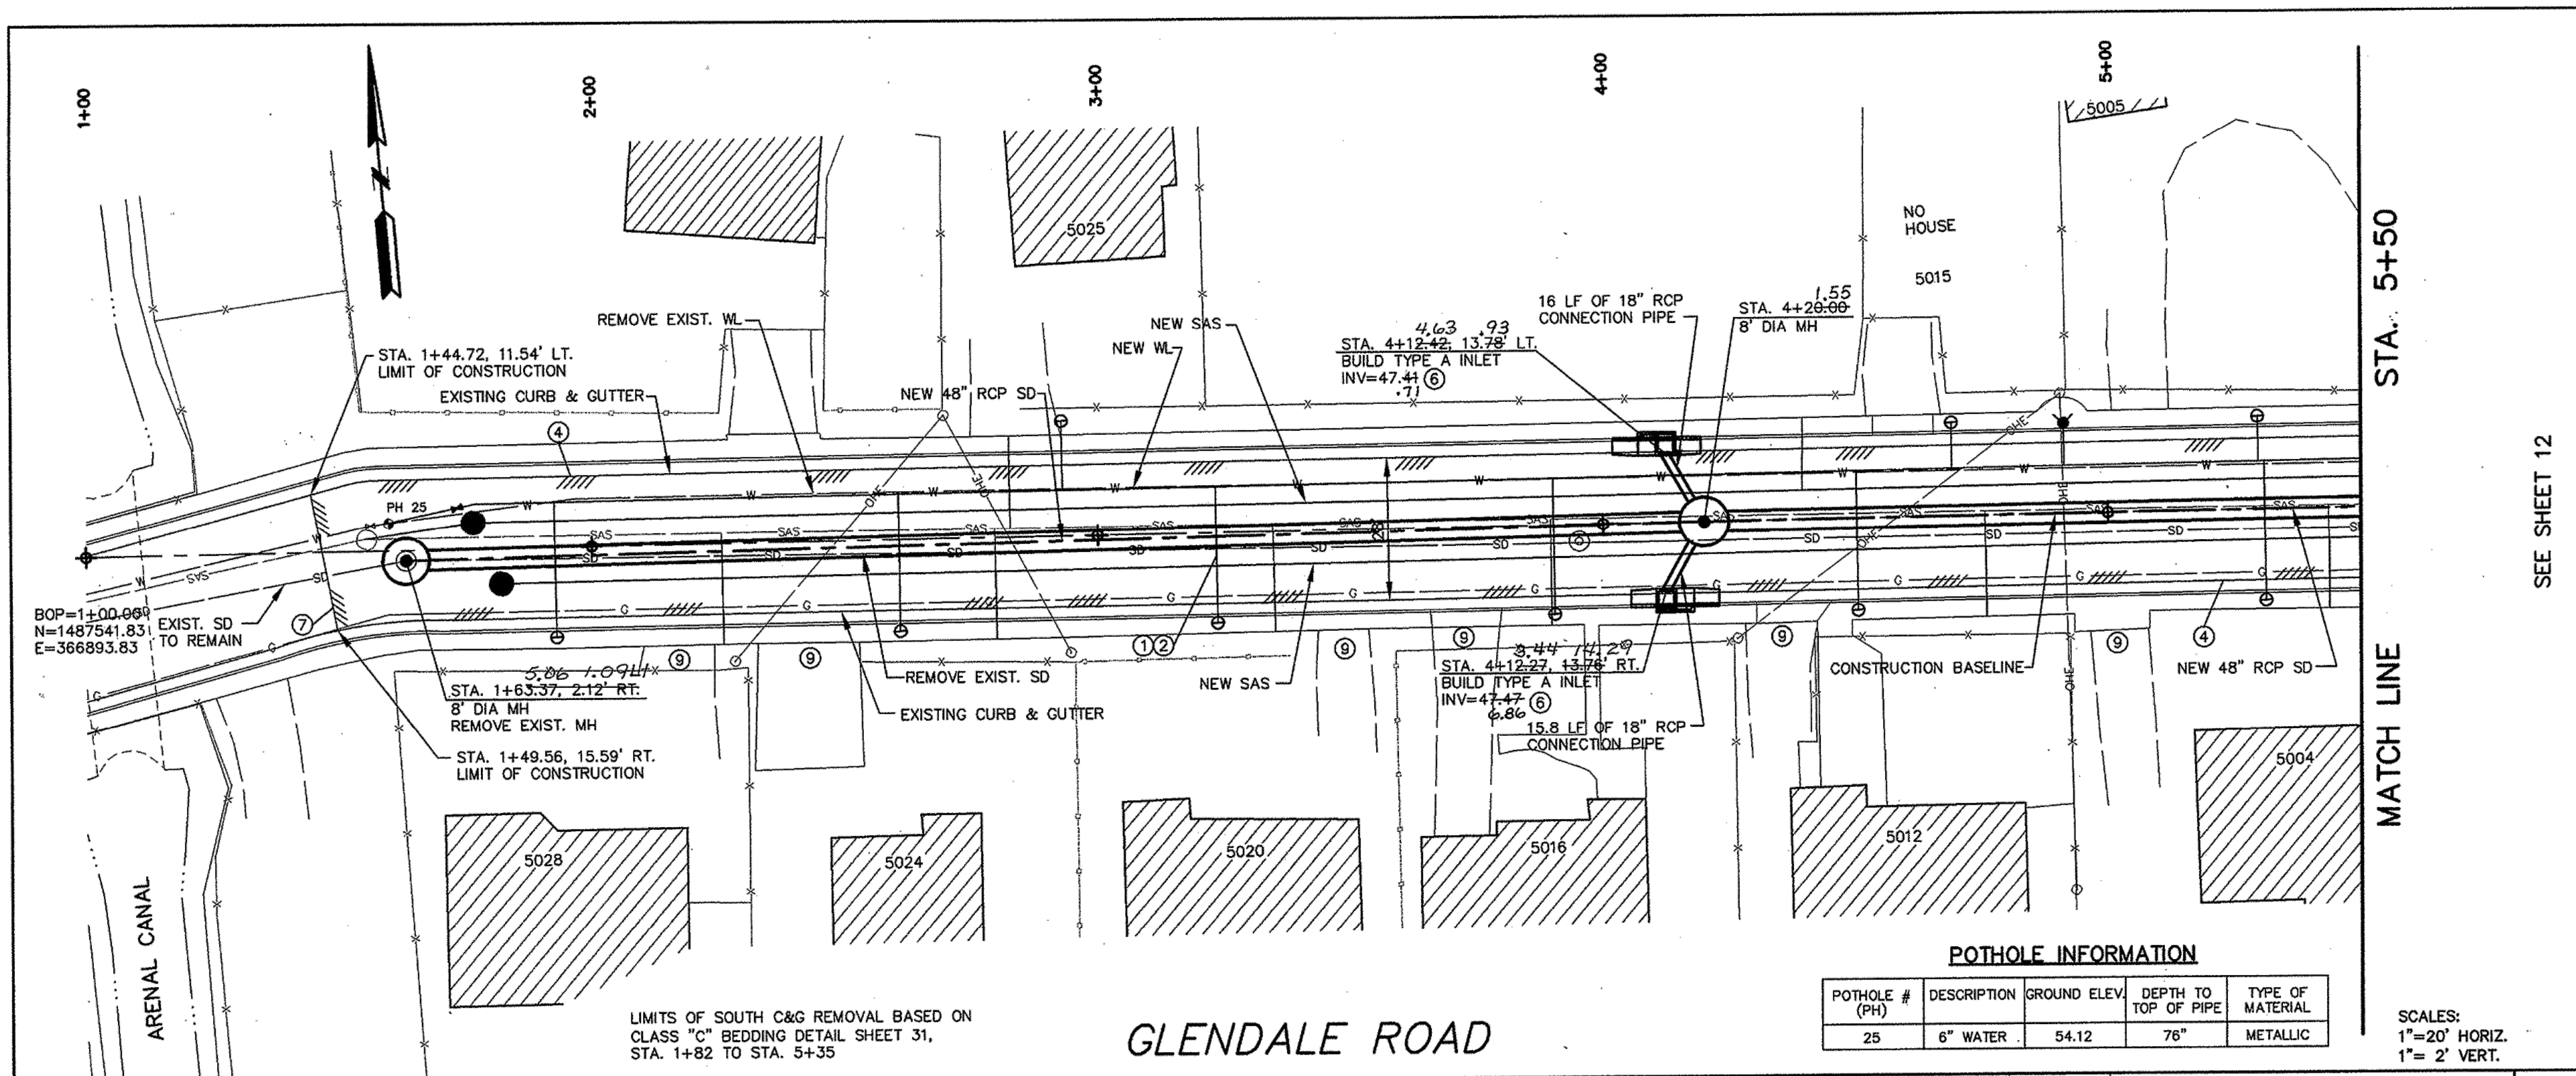

KEYED NOTES

- REPLACED WATER SERVICE LINES SHALL BE REPLACED WITH COPPER TUBING WITH NO SPLICES FROM METER TO MAIN PER COA STD. DWG. 2362.
- ANY EXISTING UTILITIES EXPOSED DURING CONSTRUCTION SHALL BE SUPPORTED AND PROTECTED DURING CONSTRUCTION. THIS SUPPORT AND PROTECTION SHALL BE CONSIDERED INCIDENTAL TO PROJECT CONSTRUCTION AND NO SEPARATE PAYMENT WILL BE MADE.
- NOT USED THIS SHEET
- MAJOR LOCAL PAVEMENT SHALL BE REPLACED PER COA STD. DWG. 2405. SEE SHEET 31.
- CURB AND GUTTER REPLACEMENT SHALL BE PER COA STD. DWG. 2415A. SEE SHEET 2 NOTES.
- STORM DRAIN INLETS SHALL BE PER COA STD. DWG. 2201. INLET GRATES WILL BE PER COA STD. DWG. 2220.
- ALL PAVEMENT CUTS TO BE MADE PERPENDICULAR TO TRAFFIC FLOW. PAVEMENT CUTS AT CURB RADIUS WILL BE MADE RADIAL TO THE CURB.
- NOT USED THIS SHEET
- DRIVEPADS AFFECTED BY CONSTRUCTION SHALL BE RECONSTRUCTED PER COA STD. DWG. 2425.
- NOT USED THIS SHEET
- NOT USED THIS SHEET
- NOT USED THIS SHEET
- NOT USED THIS SHEET

AS BUILT INFORMATION

Connecticut New Mexico Underground
 STATIONED BY Terra Land Surveys DATE 9/06
 INSPECTED BY C.O.A. DATE 5/07
 VERIFIED BY Terra Land Surveys DATE 7/07
 CORRECTED BY Larkin Group INC. DATE 7/07
 MICRO-FILM INFORMATION
 RECORDED BY DATE
 RECORDED BY DATE

BENCH MARKS

CITY OF ALBUQUERQUE STATION 2-K12B
 BEING A 3 1/4" ALUMINUM TABLET SET IN
 THE TOP OF CURB AT THE SOUTHEAST
 QUADRANT OF CENTRAL & ATRISCO SW
 COORDINATES ARE MODIFIED GROUND VALUES
 BASED ON NAD 27 U.S. SURVEY FEET
 NORTHING=1487200.64 PROJECT GRID FACTOR
 EASTING=370304.57 GF=0.999681630
 ELEV.=4954.92 NGVD 29

SURVEY INFORMATION

NO.	DATE	BY
1		

ENGINEER'S SEAL

REGISTERED PROFESSIONAL ENGINEER
 STATE OF NEW MEXICO
 NO. 10000
 LARKIN GROUP INC.
 8500 MENAUL BLVD. NE #440
 ALBUQUERQUE, NEW MEXICO 87112
 (505) 275-7500 FAX (505) 275-0968

RECORD DRAWING
 JUNE 2007
 REV.11/17

2002-0021-28
LARKIN GROUP INC.
 CONSULTING ENGINEERS AND SURVEYORS
 8500 MENAUL BLVD. NE #440
 ALBUQUERQUE, NEW MEXICO 87112
 (505) 275-7500 FAX (505) 275-0968

CITY OF ALBUQUERQUE
 DEPARTMENT OF MUNICIPAL DEVELOPMENT
 STORM DRAINAGE DESIGN DIVISION

TITLE: **CENTRAL - ATRISCO DRAINAGE IMPROVEMENTS PHASE II**
 GLENDALE ROAD STA. 1+00 TO 5+50

DESIGNED BY: XX
 DRAWN BY: XX
 CHECKED BY: XX

APPROVED
 JUN 08 2006
 DESIGN REVIEW COMMITTEE

APPROVED
 JUN 08 2006
 CITY ENGINEER

Project No. 674903 Zone Map No. K-11-Z Sheet 11 of 32