
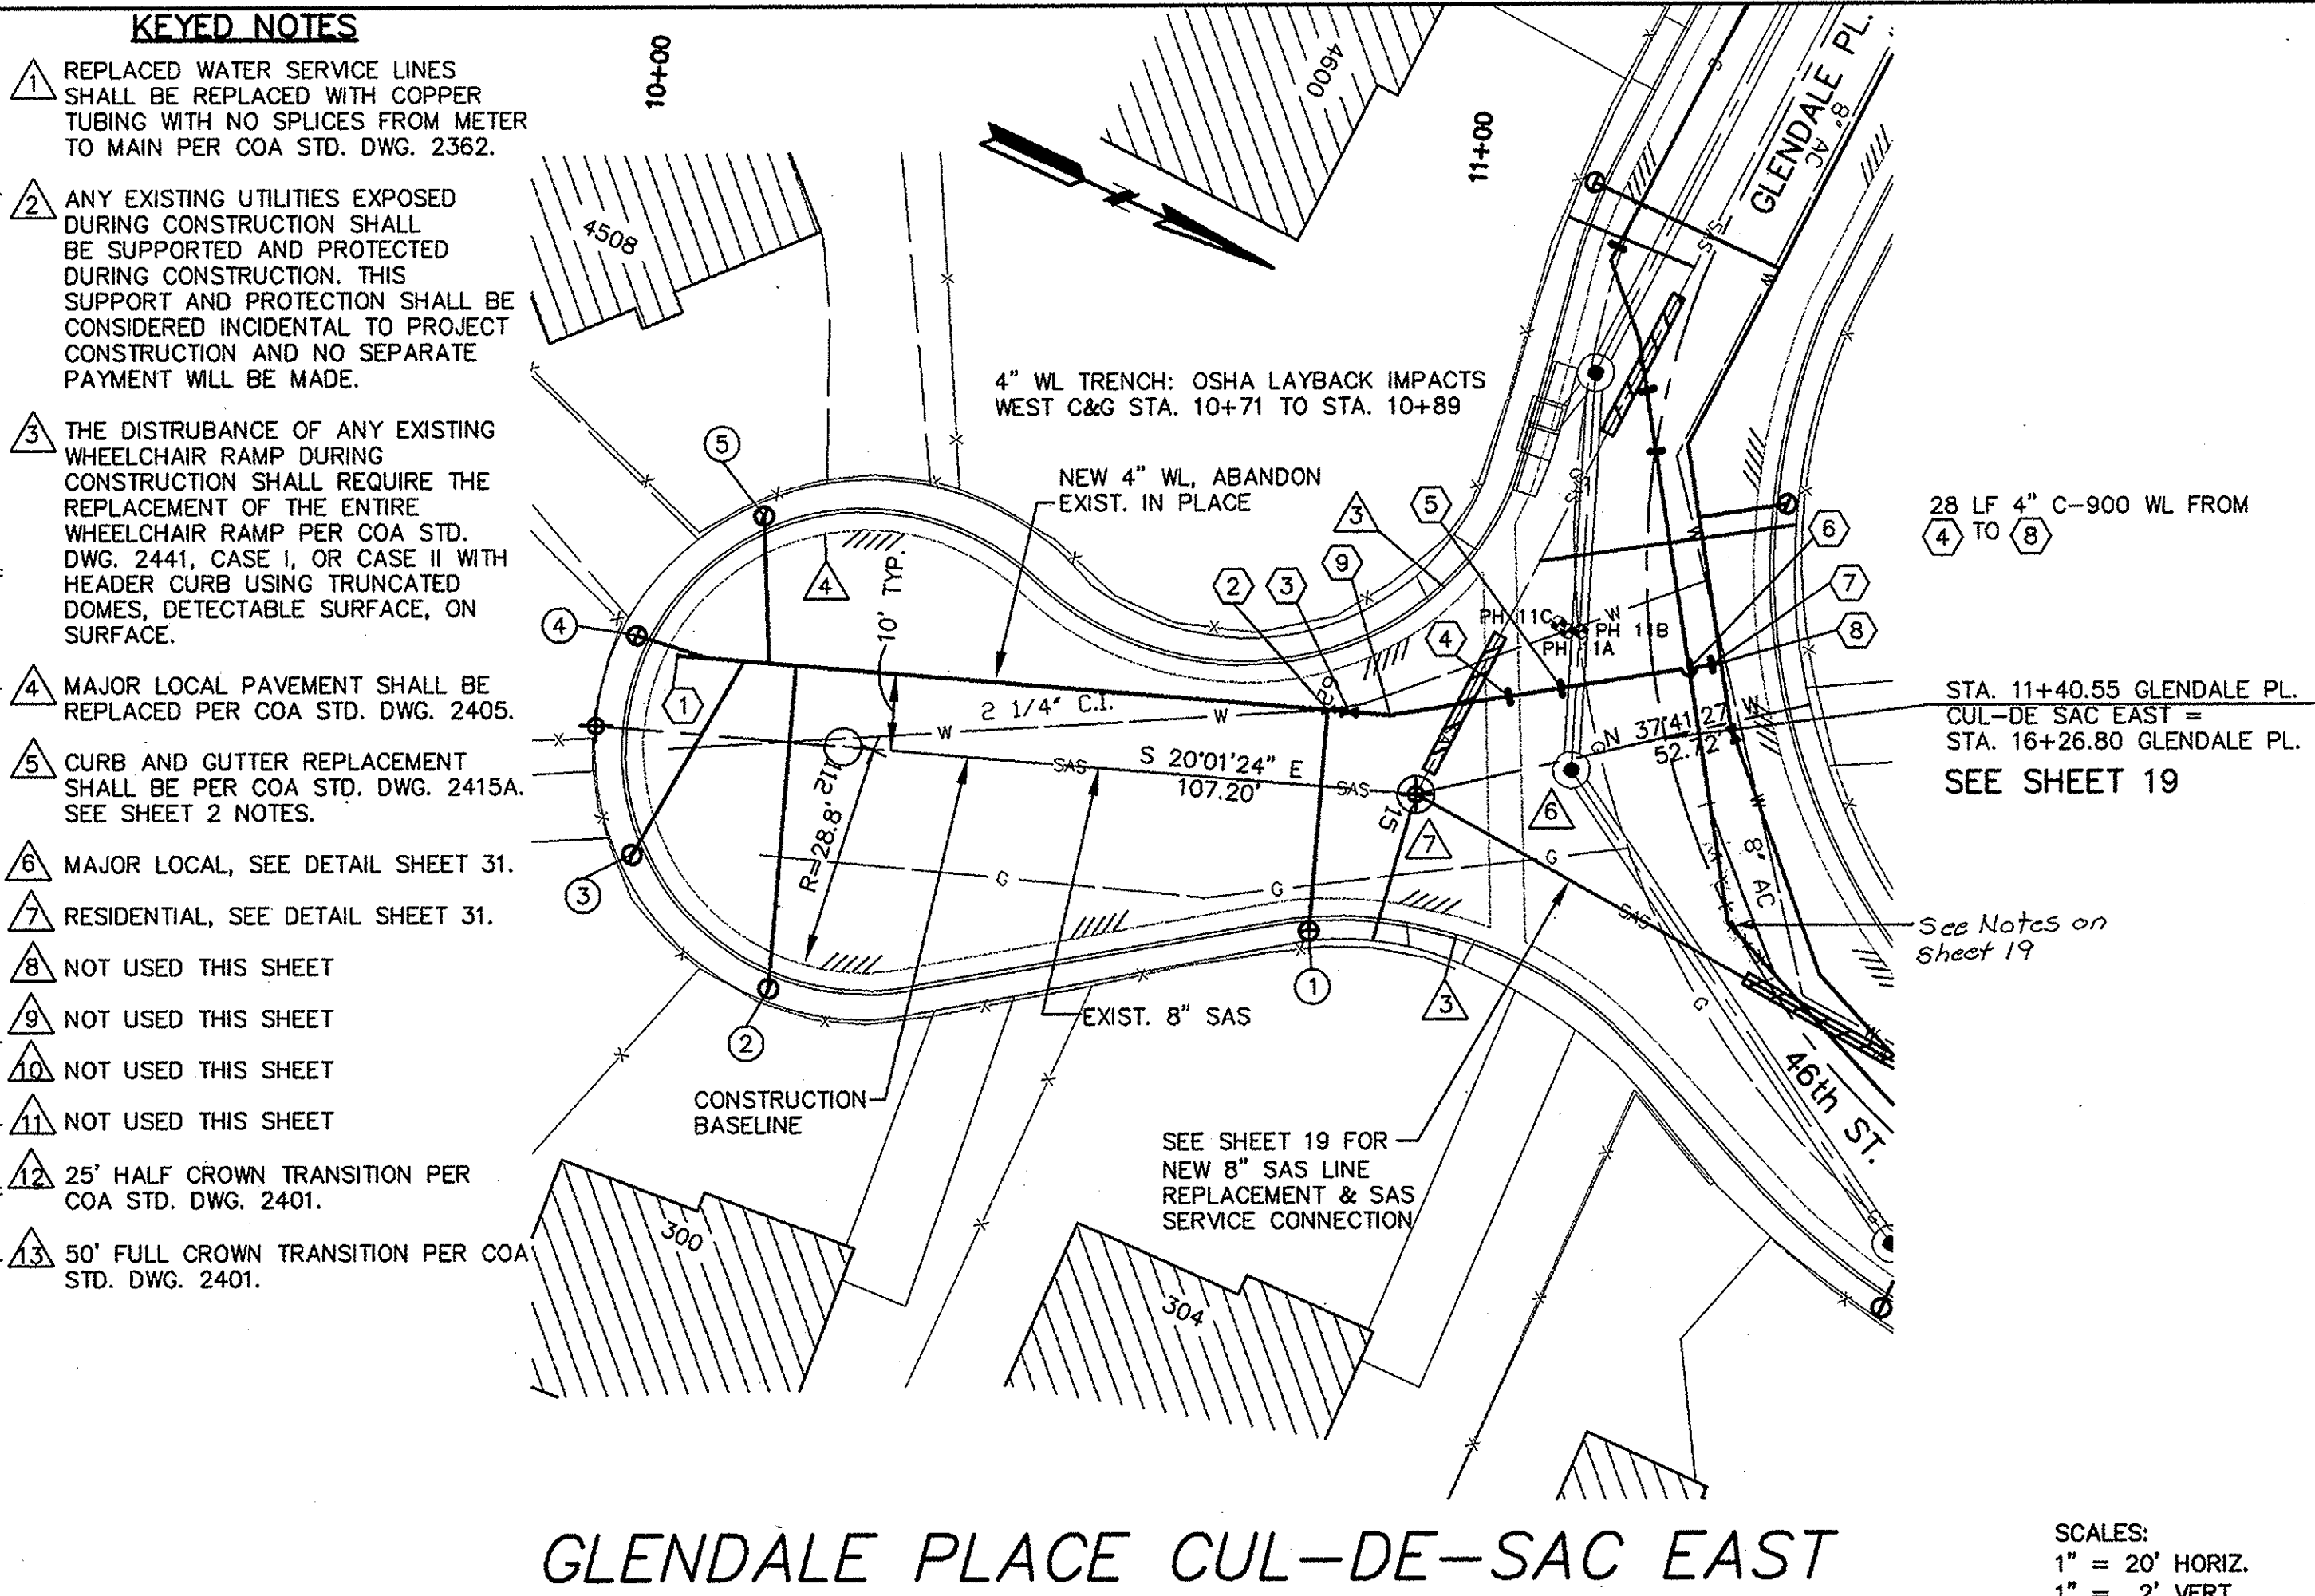


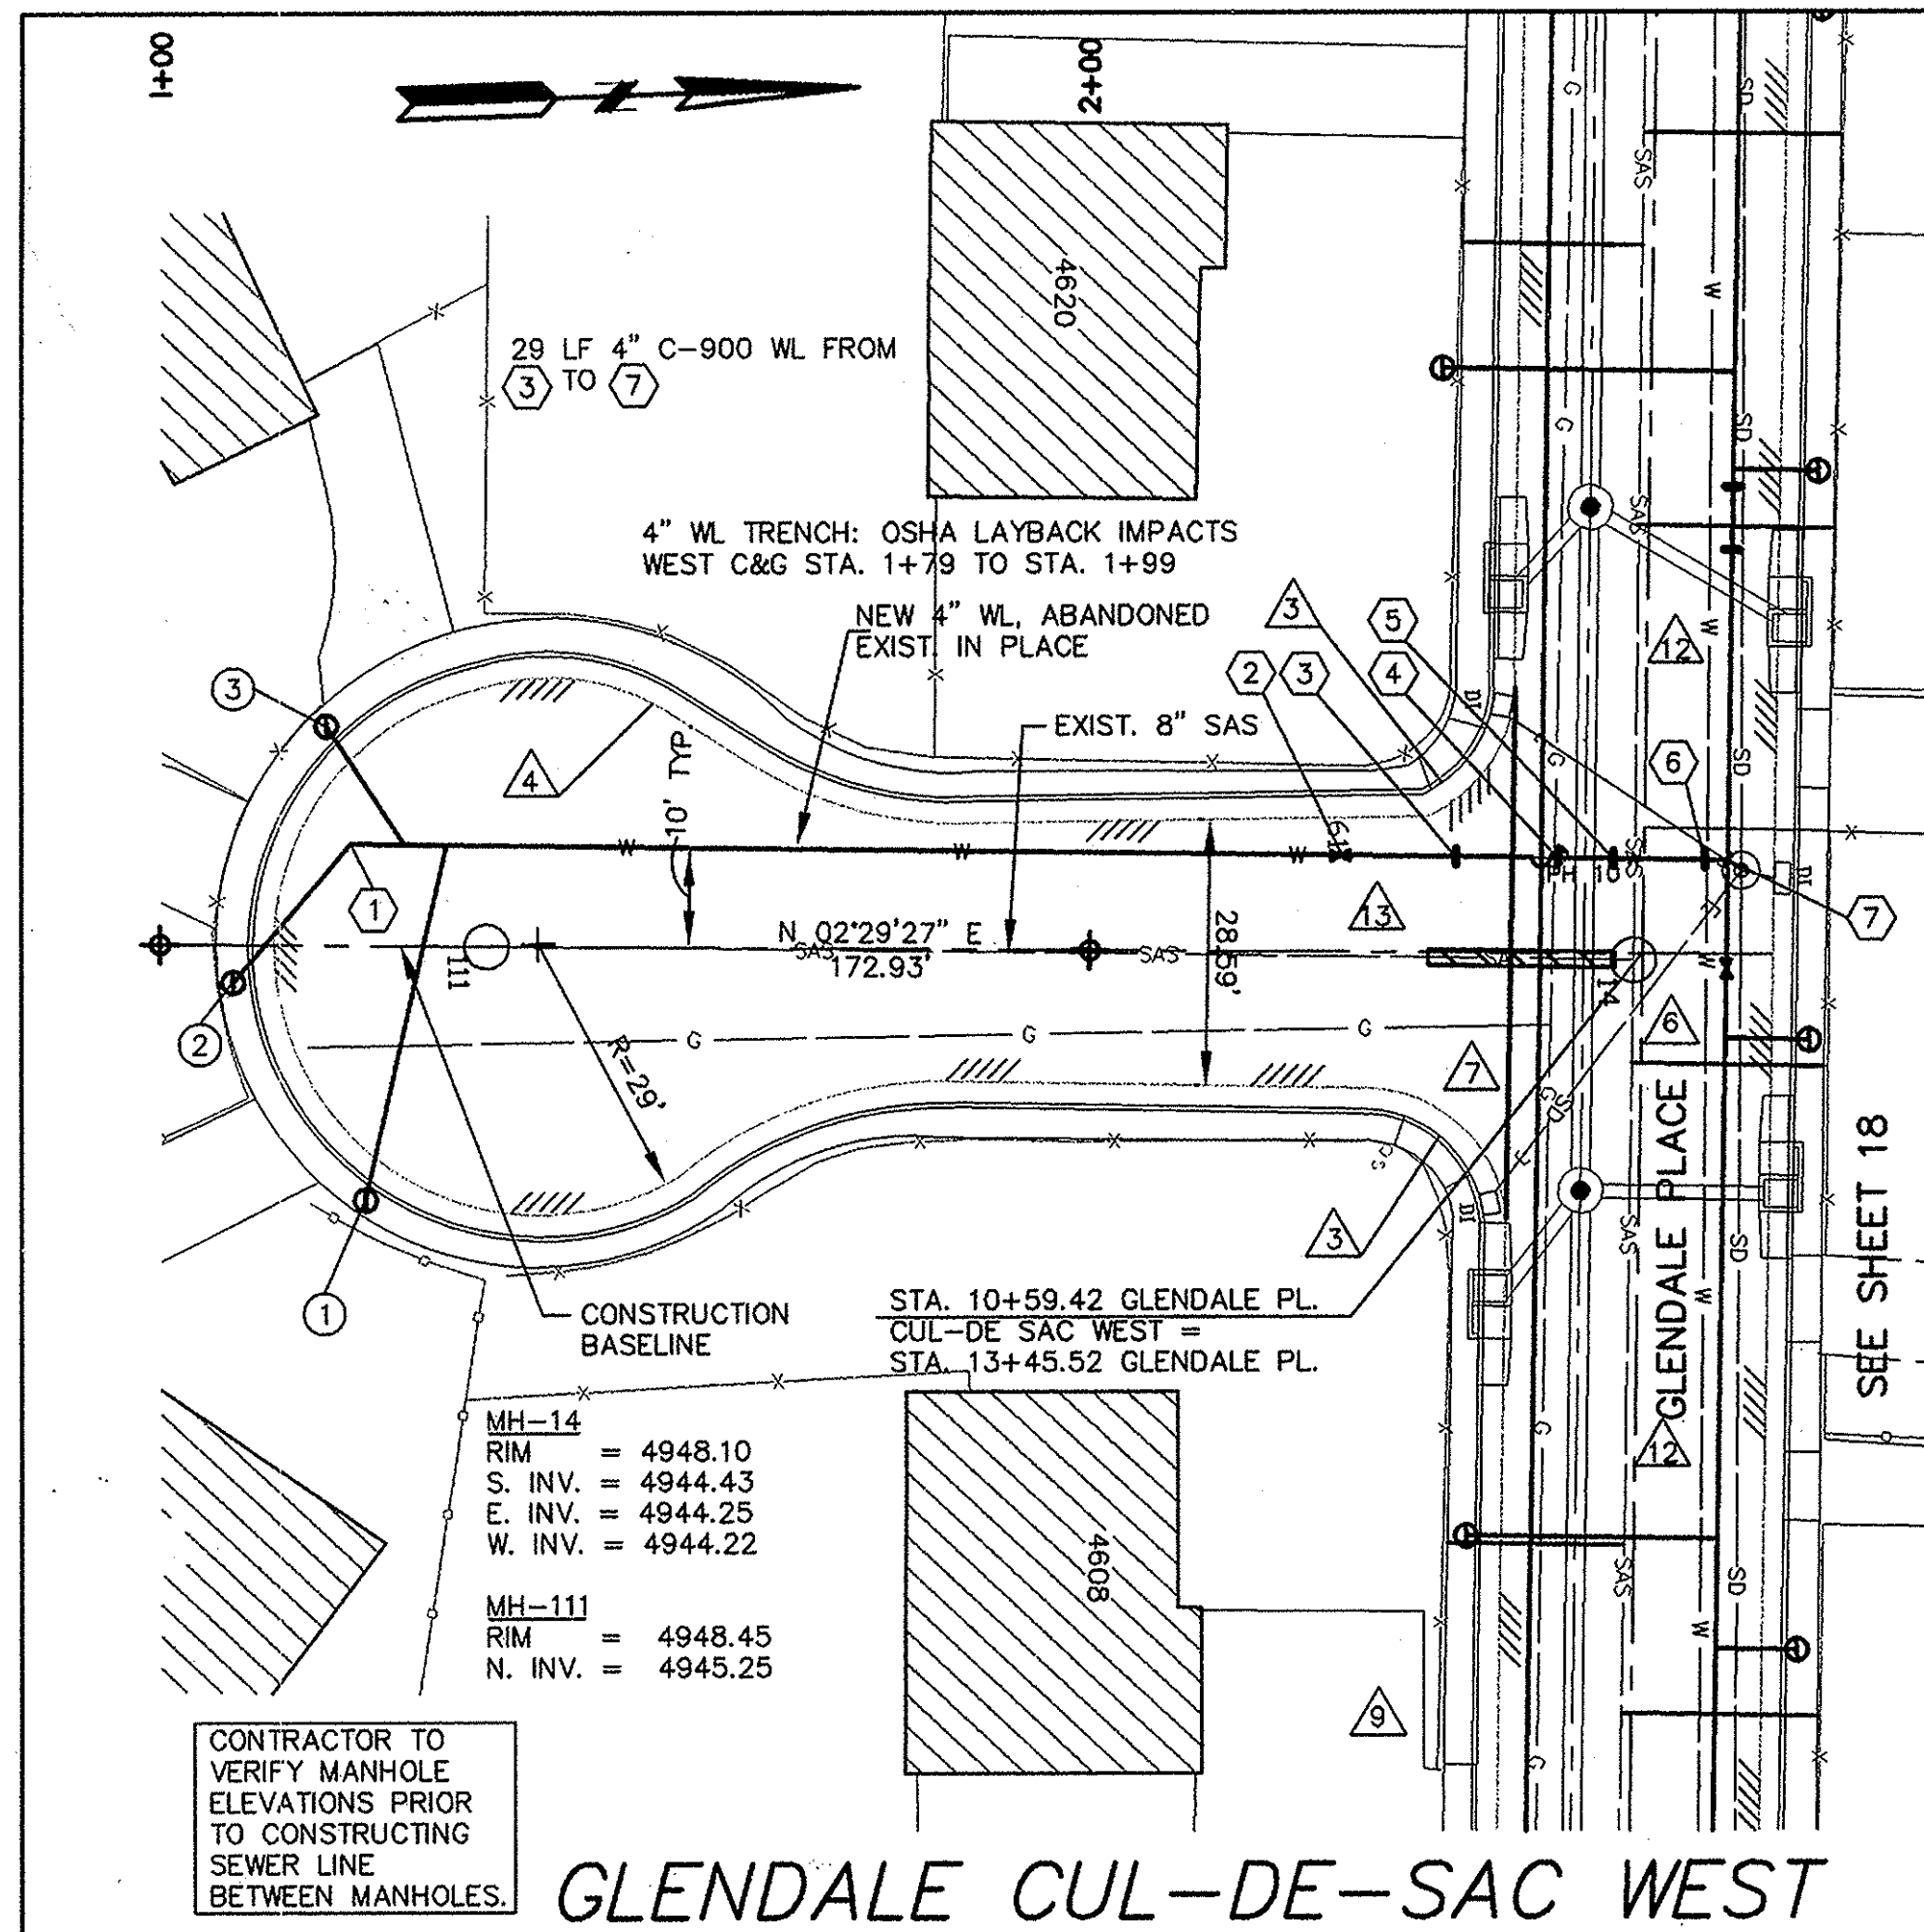

NOTES

- ALL FITTINGS SHALL BE RESTRAINED UNLESS NOTED OTHERWISE. SEE SHEET 30 FOR RESTRAINED JOINT TABLES.
- SEE SEWER AND WATER NOTES, SHEET 30.
- ALL SANITARY MANHOLES TO BE 4' DIAMETER, TYPE "C", UNLESS NOTED OTHERWISE. SEE MH DATA LISTINGS, THIS SHEET.
- ALL SEWER SERVICE CONNECTIONS TO BE 4". EXTEND SERVICE LINES TO PROPERTY LINE AND CONNECT TO EXISTING SERVICE.
- ALL WATER METERS ARE 3/4" UNLESS NOTED OTHERWISE.

GLENDALE PL. CUL-DE-SAC WEST WATERLINE KEYED NOTES

- STA. 1+20.60, 10.97' LT. BEGIN 4" WL, CAP
- STA. 2+26.93, 10.39' LT. 4" GATE VALVE & BOX PER COA STD. DWG. 2326 AND 2328
- STA. 2+39.32, 10.35' LT. PVI 4" WL, 22.5' BEND
- STA. 2+50.22, 10.25' LT. PVI 4" WL, 22.5' BEND
- STA. 2+56.22, 10.28' LT. PVI 4" WL, 22.5' BEND
- STA. 2+66.06, 10.17' LT. PVI 4" WL, 22.5' BEND
- STA. 2+68.43, 10.19' LT. 8"x8"x4" TEE. SEE SHEET 18

WATER METER KEYED NOTES

- STA. 1+22.54, 27.30' RT.
- STA. 1+08.03, 4.06' RT.
- STA. 1+17.87, 23.71' LT.

GLENDALE PL. CUL-DE-SAC EAST WATERLINE KEYED NOTES

- STA. 10+09.86, 2.17' RT. BEGIN 4" WL, CAP
- STA. 10+95.17, 8.08' LT. PVI 4" WL, 11.25' BEND
- STA. 10+97.61, 8.68' LT. 4" GATE VALVE & BOX PER COA STD. DWG. 2326 AND 2328
- STA. 11+21.84, 9.74' LT. PVI 4" WL, 22.5' BEND
- STA. 11+28.75, 9.28' LT. PVI 4" WL, 22.5' BEND
- STA. 11+45.78, 8.48' LT. PVI 4" WL, 45' BEND
- STA. 11+48.52, 7.99' LT. PVI 4" WL, 45' BEND
- STA. 11+49.77, 7.85' LT. 8"x8"x4" TEE. SEE SHEET 19
- STA. 11+03.0, 10.00' LT. PVI 4" WL 11.25' BEND

EXIST. WATER METER KEYED NOTES

- STA. 10+94.80, 18.80' RT.
- STA. 10+25.33, 32.09' RT.
- STA. 10+06.17, 16.31' RT.
- STA. 10+04.35, 12.21' LT.
- STA. 10+19.49, 29.18' LT.

ENGINEER'S SEAL

LARKIN GROUP, INC.
CONSULTING ENGINEERS AND SURVEYORS
8500 MENAUL BLVD. NE A-440
ALBUQUERQUE, NEW MEXICO 87112
(505) 275-7500 FAX (505) 275-0748

CITY OF ALBUQUERQUE
DEPARTMENT OF MUNICIPAL DEVELOPMENT
STORM DRAINAGE DESIGN DIVISION

TITLE: CENTRAL - ATRISCO DRAINAGE IMPROVEMENTS PHASE II
WATER & SANITARY SEWER, GLENDALE CUL-DE-SAC WEST & GLENDALE PL. CUL-DE-SAC

DESIGN REVIEW COMMITTEE
APPROVED JUN 8 2006
DESIGN REVIEW COMMITTEE

RECORD DRAWING
JUNE 2007

Project No. 674903
Zone Map No. K-12-Z
Sheet 21 OF 32