


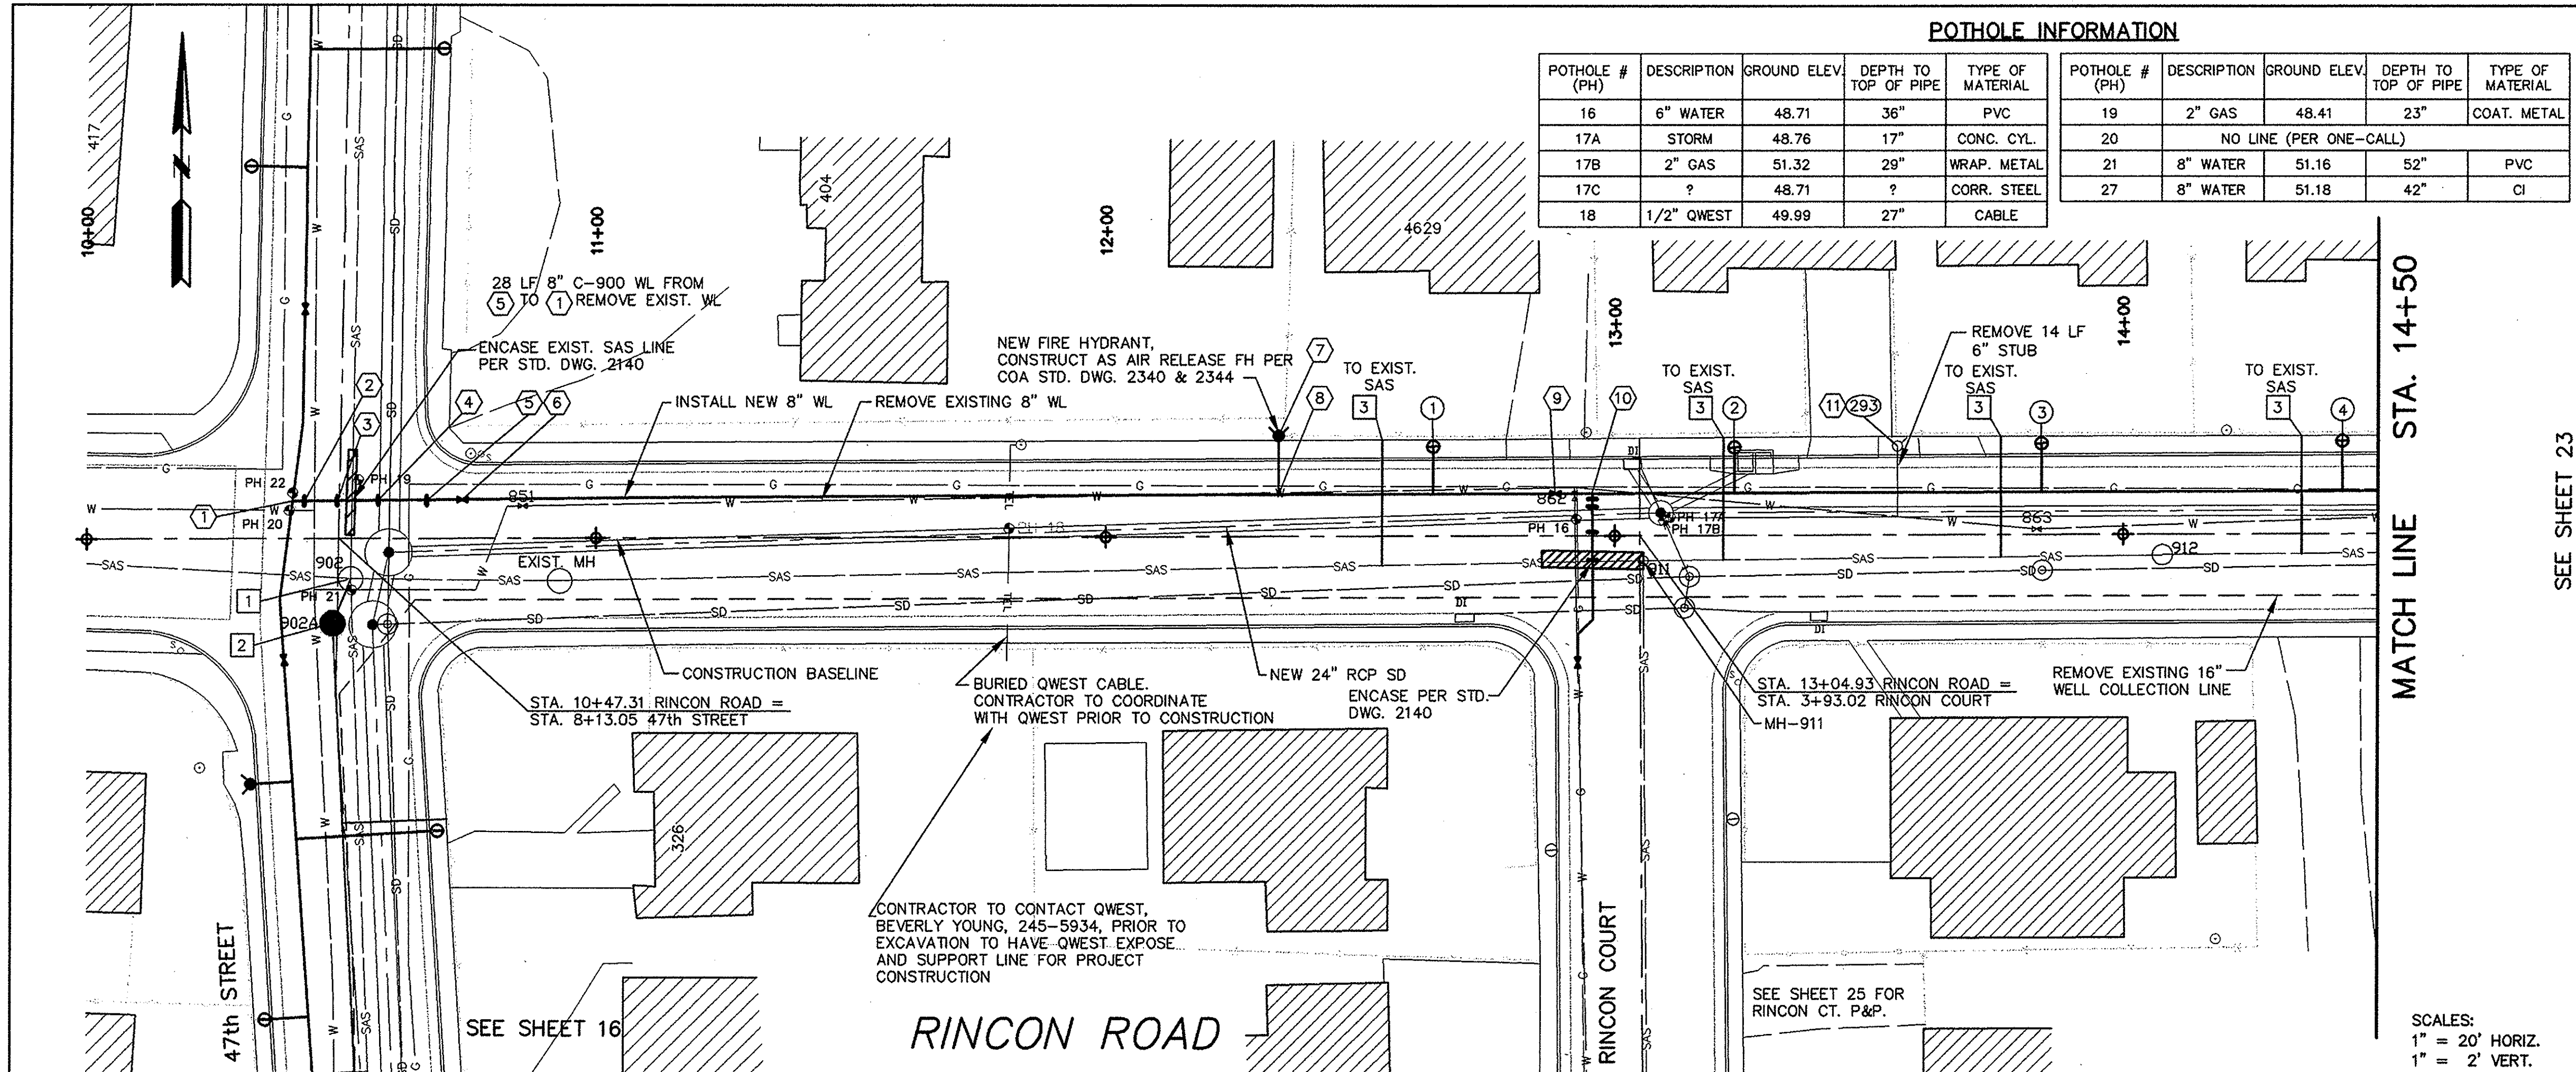

POT HOLE INFORMATION

POT HOLE #	DESCRIPTION	GROUND ELEV.	DEPTH TO TOP OF PIPE	TYPE OF MATERIAL
16	6" WATER	48.71	36"	PVC
17A	STORM	48.76	17"	CONC. CYL.
17B	2" GAS	51.32	29"	WRAP. METAL
17C	?	48.71	?	CORR. STEEL
18	1/2" QWEST	49.99	27"	CABLE

POT HOLE #	DESCRIPTION	GROUND ELEV.	DEPTH TO TOP OF PIPE	TYPE OF MATERIAL
19	2" GAS	48.41	23"	COAT. METAL
20	NO LINE (PER ONE-CALL)			
21	8" WATER	51.16	52"	PVC
27	8" WATER	51.18	42"	CI

NOTES

- ALL FITTINGS SHALL BE RESTRAINED UNLESS NOTED OTHERWISE. SEE SHEET 30 FOR RESTRAINED JOINT TABLES.
- SEE SEWER AND WATER NOTES, SHEET 30.
- ALL SANITARY MANHOLES TO BE 4' DIAMETER, TYPE "C", UNLESS NOTED OTHERWISE. SEE MH DATA LISTINGS, THIS SHEET.
- ALL SEWER SERVICE CONNECTIONS TO BE 4". EXTEND SERVICE LINES TO PROPERTY LINE AND CONNECT TO EXISTING SERVICE.
- ALL WATER METERS ARE 3/4" UNLESS NOTED OTHERWISE.

EXIST. WATER METER KEYED NOTES


- 12+64.33, 17.61' LT.
- 13+23.50, 17.29' LT.
- 13+83.94, 17.88' LT.
- 14+42.99, 18.28' LT.

WATERLINE KEYED NOTES

- STA. 10+39.39, 7.36' LT. TEE, SEE SHEET 16
- STA. 10+44.04, 7.40' LT. PVI 8" WL, 45' BEND
- STA. 10+49.39, 7.44' LT. PVI 8" WL, 45' BEND
- STA. 10+57.39, 7.50' LT. PVI 8" WL, 22.5' BEND
- STA. 10+66.89, 7.58' LT. PVI 8" WL, 22.5' BEND
- STA. 10+73.88, 7.63' LT. 8" GATE VALVE & VALVE BOX PER COA STD. DWG. 2326 AND 2328
- STA. 12+34.01, 19.86' LT. 11 LF OF 6" WL, REPLACE & RELOCATE FIRE HYDRANT 293, PER COA STD. DWG. 2340 AND 2344
- STA. 12+33.98, 8.28' LT. 8"x8"x6" TEE
- STA. 12+88.31, 8.31' LT. 8" GATE VALVE & VALVE BOX PER COA STD. DWG. 2326 AND 2328
- STA. 12+95.51, 8.31' LT. 8"x8"x6" TEE
- STA. 13+55.59, 17.45' LT. REMOVE EXIST. FIRE HYDRANT 293

SAS KEYED NOTES

- STA. 10+48.43, 16.61' RT. INV EL = 4951.38 NEW 4" MH-902A
- STA. 10+51.99, 7.91' RT. MH-902A
- 4" SEWER SERVICE CONNECTION TO PROPERTY LINE, CONTRACTOR LOCATE & CONNECT TO EXISTING SERVICE, TAP INTO EXISTING SAS.

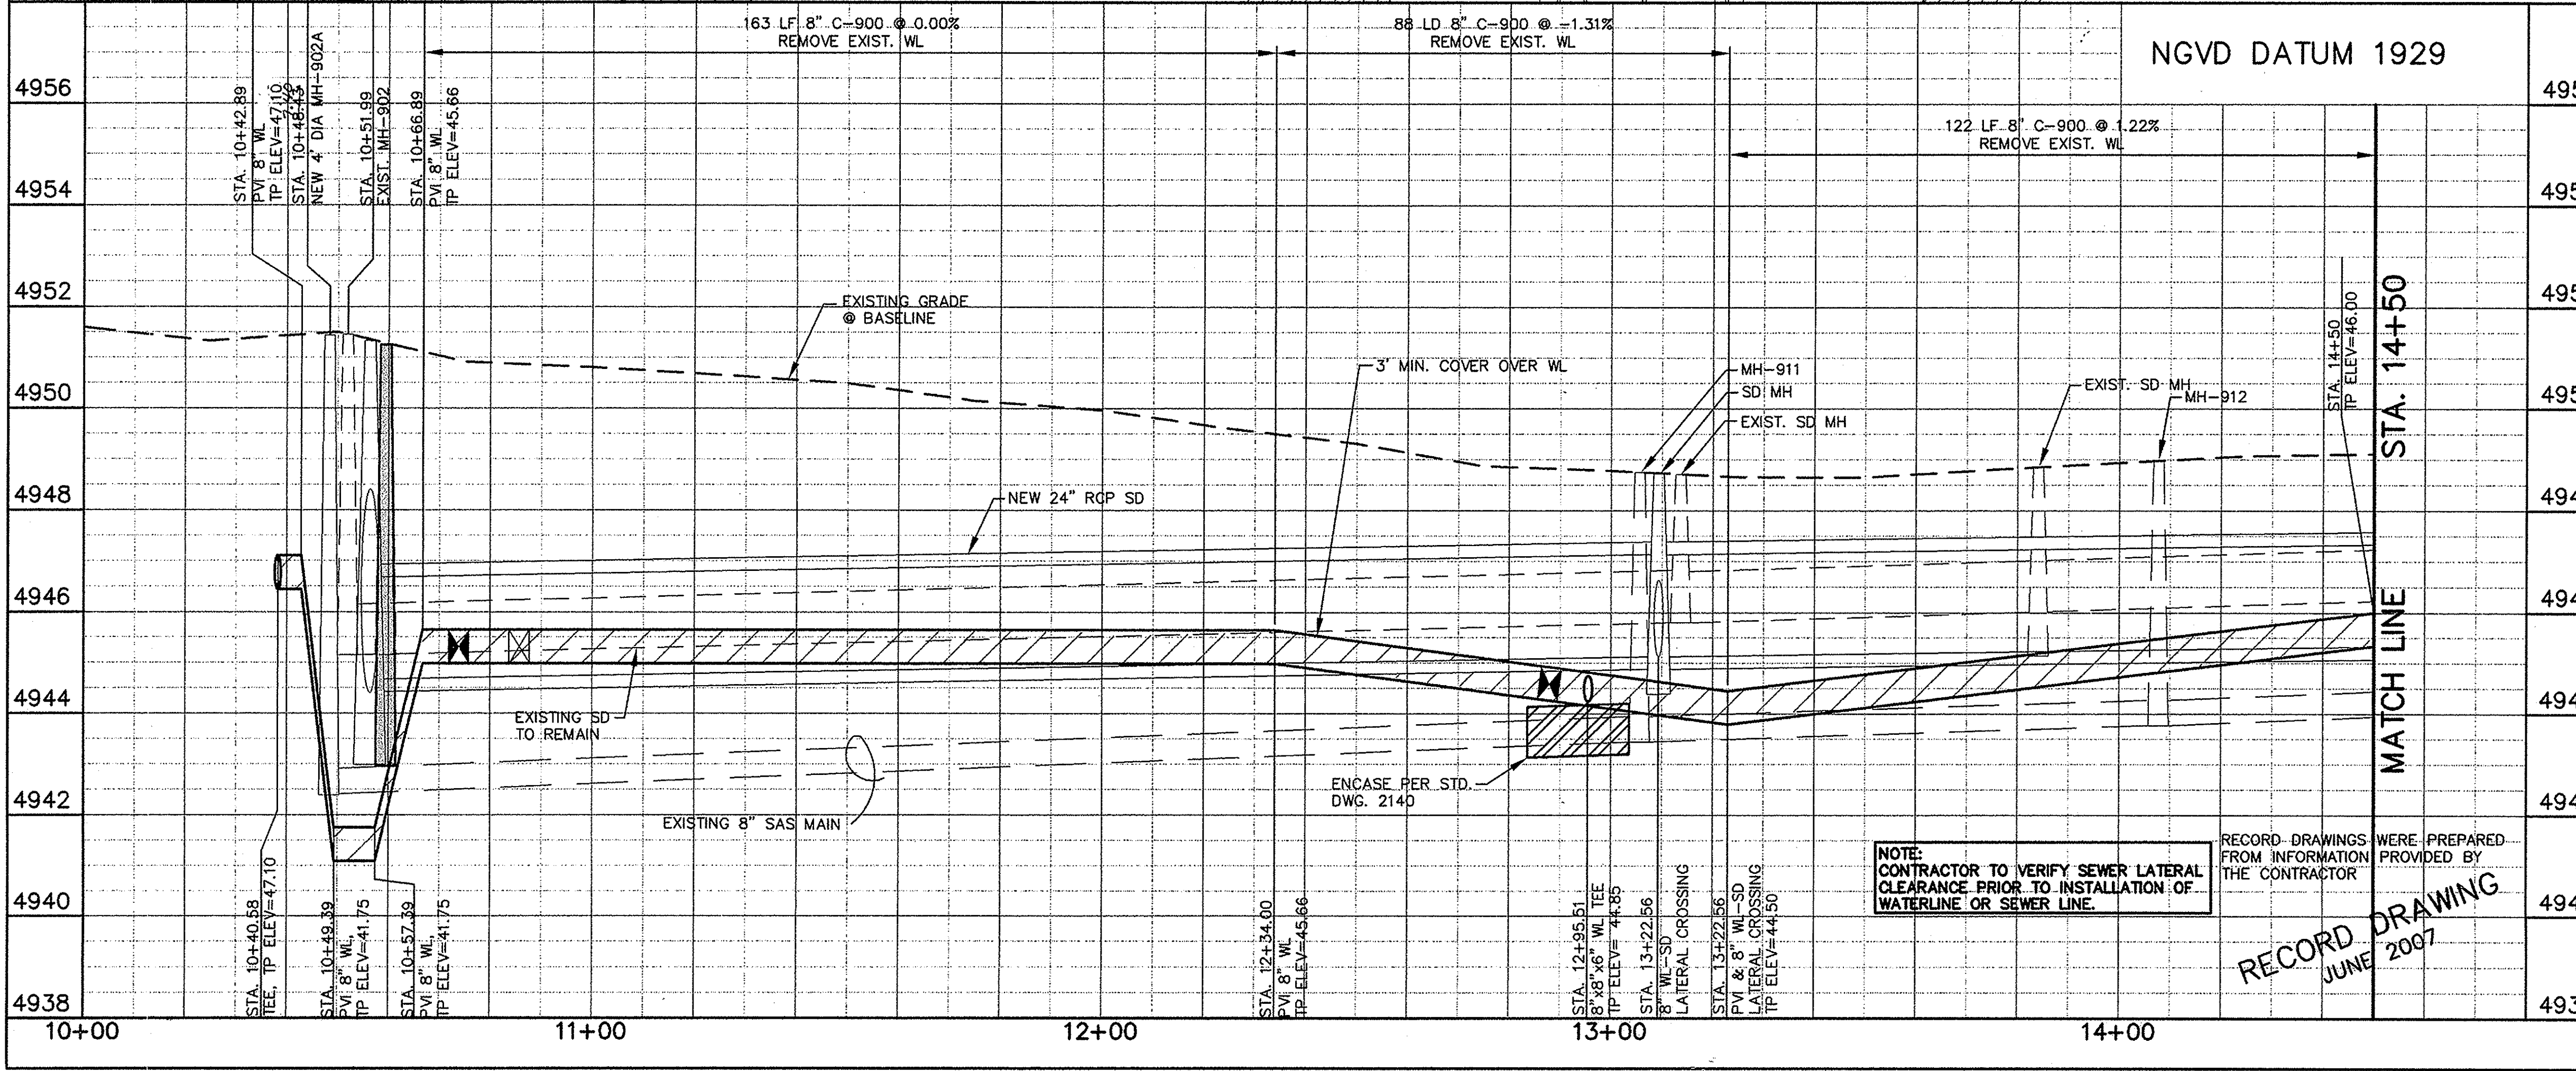

CITY OF ALBUQUERQUE DEPARTMENT OF MUNICIPAL DEVELOPMENT STORM DRAINAGE DESIGN DIVISION	
TITLE: CENTRAL - ATRISCO DRAINAGE IMPROVEMENTS PHASE II WATER & SANITARY SEWER RINCON ROAD STA 10+00 TO 14+50	
DESIGN REVIEW COMMITTEE APPROVED JUN 08 2006	CITY ENGINEER APPROVAL APPROVED JUN 08 2006
DESIGNED BY: XX DRAWN BY: XX CHECKED BY: XX	REMARKS DESIGN NO. DATE
Project No. 674903	Zone Map No. J-12-Z
Sheet 22 OF 32	

RECORD DRAWING
JUNE 2007