


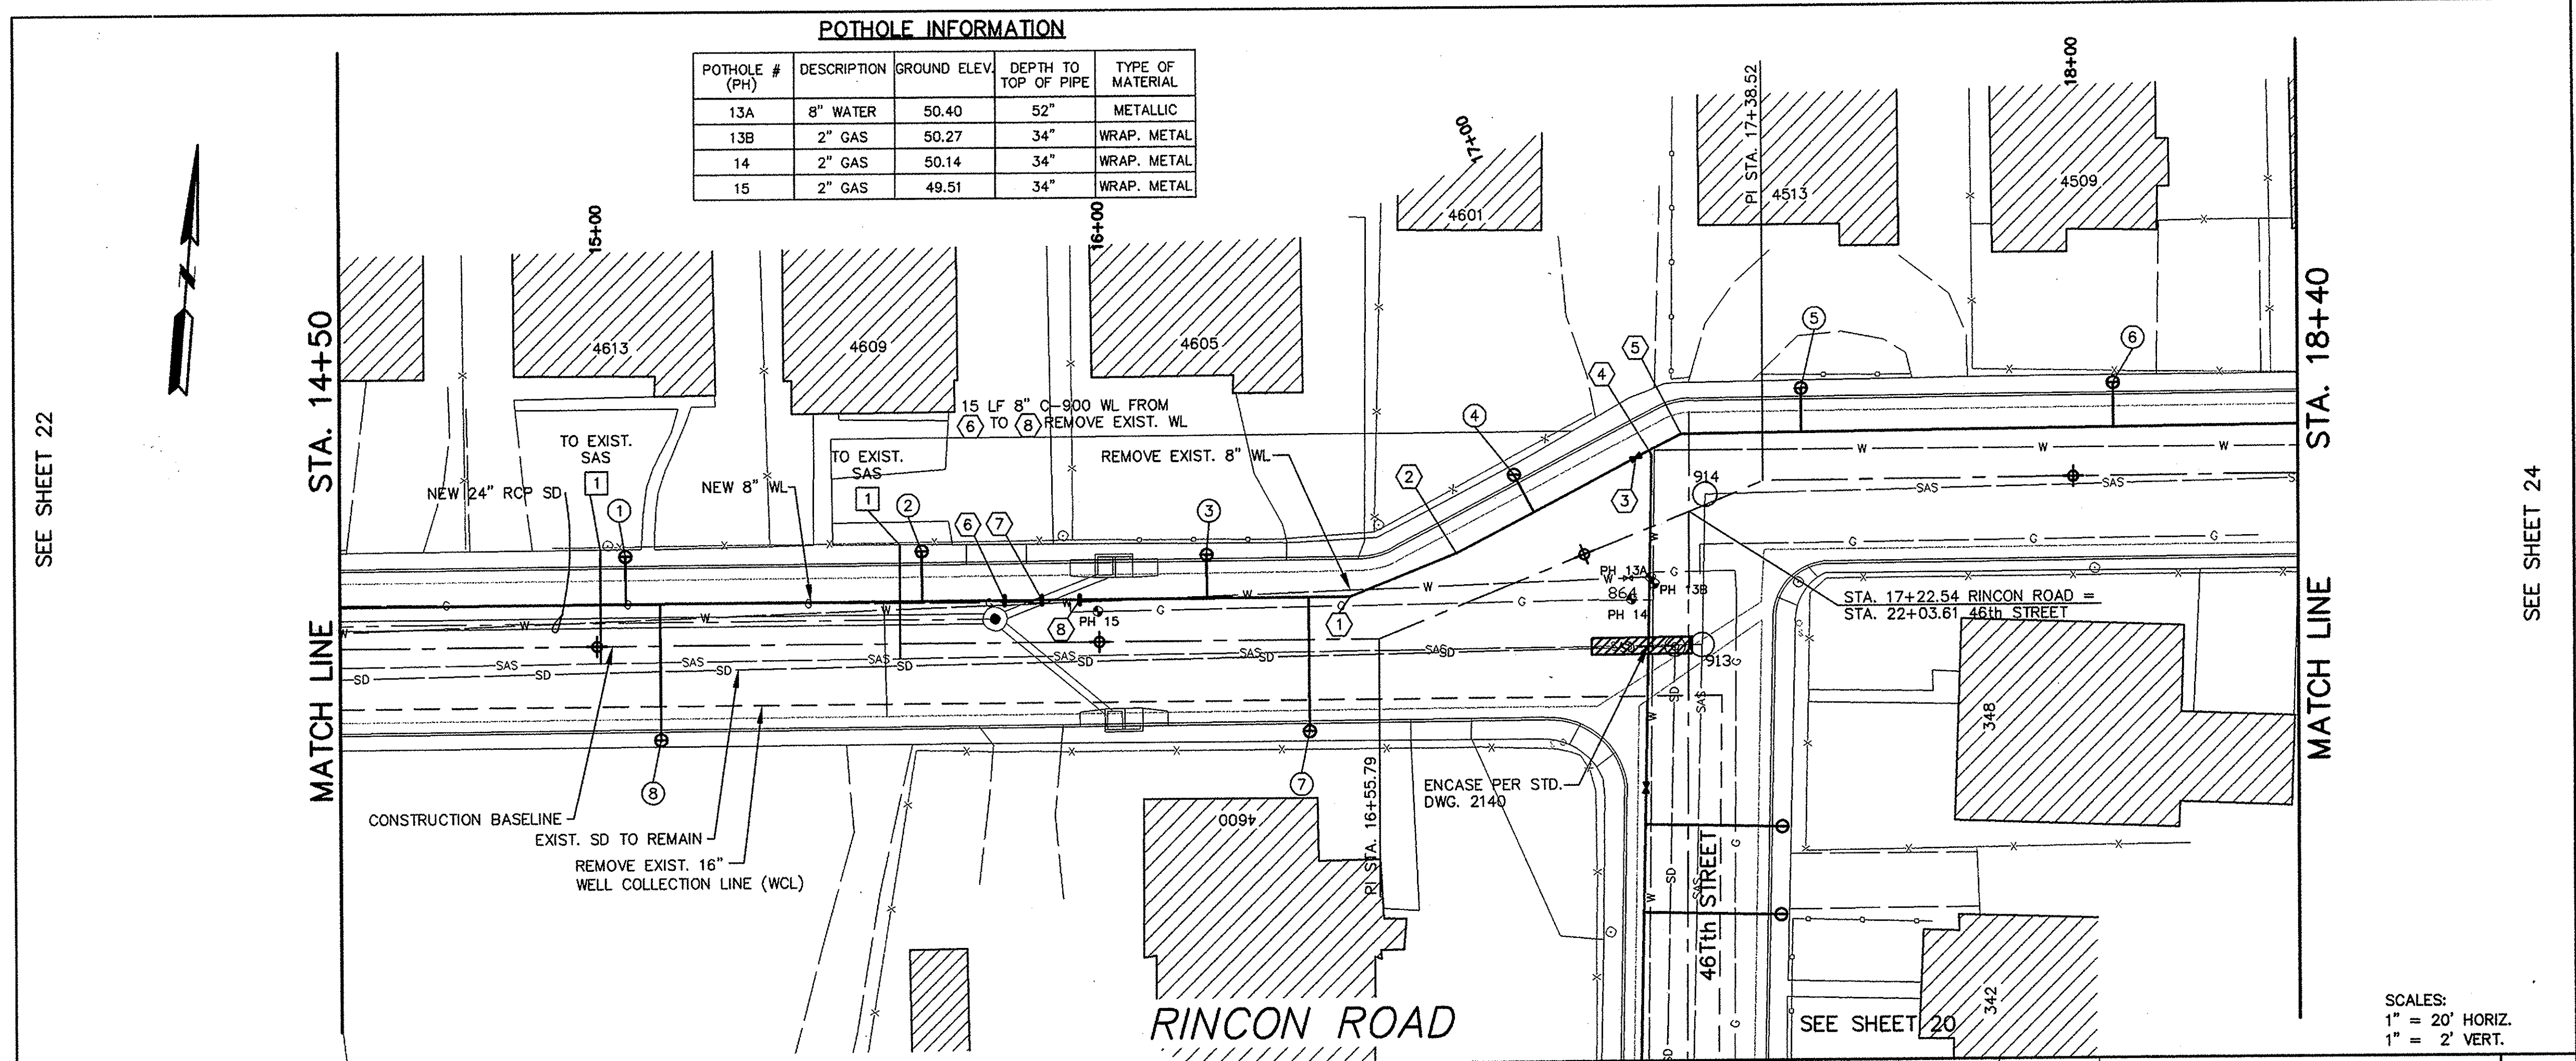

POTHOLE INFORMATION				
POTHOLE #	DESCRIPTION	GROUND ELEV.	DEPTH TO TOP OF PIPE	TYPE OF MATERIAL
13A	8" WATER	50.40	52"	METALLIC
13B	2" GAS	50.27	34"	WRAP. METAL
14	2" GAS	50.14	34"	WRAP. METAL
15	2" GAS	49.51	34"	WRAP. METAL

- NOTES**
1. ALL FITTINGS SHALL BE RESTRAINED UNLESS NOTED OTHERWISE. SEE SHEET 30 FOR RESTRAINED JOINT TABLES.
 2. SEE SEWER AND WATER NOTES, SHEET 30.
 3. ALL SANITARY MANHOLES TO BE 4' DIAMETER, TYPE "C", UNLESS NOTED OTHERWISE. SEE MH DATA LISTINGS, THIS SHEET.
 4. ALL SEWER SERVICE CONNECTIONS TO BE 4". EXTEND SERVICE LINES TO PROPERTY LINE AND CONNECT TO EXISTING SERVICE.
 5. ALL WATER METERS ARE 3/4" UNLESS NOTED OTHERWISE.

- EXIST. WATER METER KEYED NOTES**
- 1 STA. 15+05.8, 18.0' LT.
 - 2 STA. 15+64.8, 18.5' LT.
 - 3 STA. 16+21.6, 17.2' LT.
 - 4 STA. 17+43.0, 20.0' LT.
 - 5 STA. 17+46.3, 18.3' LT.
 - 6 STA. 18+08.5, 18.6' LT.
 - 7 STA. 16+43.8 18.3' LT.
 - 8 STA. 15+12.7 18.8' LT.

- WATERLINE KEYED NOTES**
- 1 STA. 16+50.05, 8.47' LT.
PI 8" WL, 22.5' BEND
 - 2 STA. 16+76.46, 10.00' LT.
PI 8" WL BEND, DELTA=5'31'53"
 - 3 STA. 17+16.83, 13.92 LT.
8" GATE VALVE & VALVE BOX
PER COA STD. DWG. 2326 AND 2328
 - 4 STA. 17+19.79, 14.20' LT.
8"x8"x8" TEE,
8" 22.5' & 8" 11.25' BEND
 - 5 STA. 17+26.95, 14.89' LT.
PI 8" WL, 22.5' BEND
 - 6 STA. 15+81.23, 8.44' RT.
PVI 8" WL, 11.25' BEND
 - 7 STA. 15+88.73, 8.44' RT.
PVI 8" WL, 22.5' BEND
 - 8 STA. 15+96.23, 8.44' RT.
PVI 8" WL, 11.25' BEND

- SAS KEYED NOTES**
- 1 4" SEWER SERVICE CONNECTION TO PROPERTY LINE, CONTRACTOR LOCATE & CONNECT TO EXISTING SERVICE, TAP INTO EXISTING SAS.

RECORD DRAWING
JUNE 2007



CITY OF ALBUQUERQUE
DEPARTMENT OF MUNICIPAL DEVELOPMENT
STORM DRAINAGE DESIGN DIVISION

TITLE: **CENTRAL - ATRISCO DRAINAGE IMPROVEMENTS PHASE II**
WATER & SANITARY SEWER RINCON ROAD STA 14+50 TO 18+500

DESIGN REVIEW COMMITTEE
APPROVED
JUN 08 2006

CITY ENGINEER
APPROVED
JUN 08 2006

Mo./Day/Yr.
Mo./Day/Yr.

