
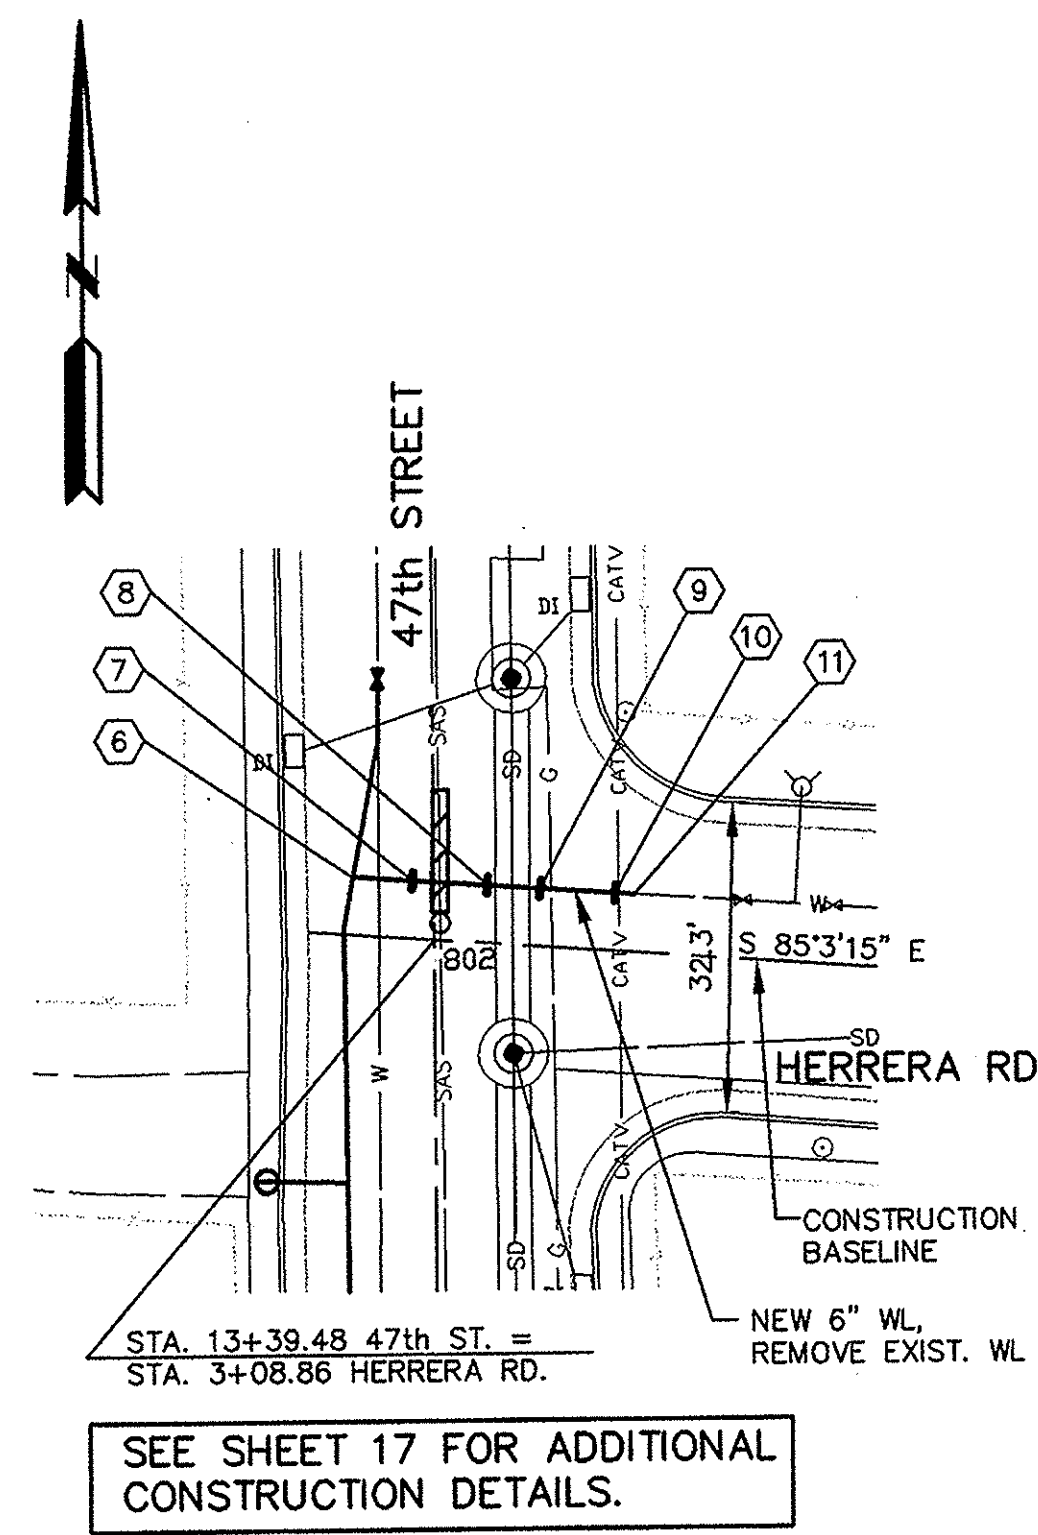
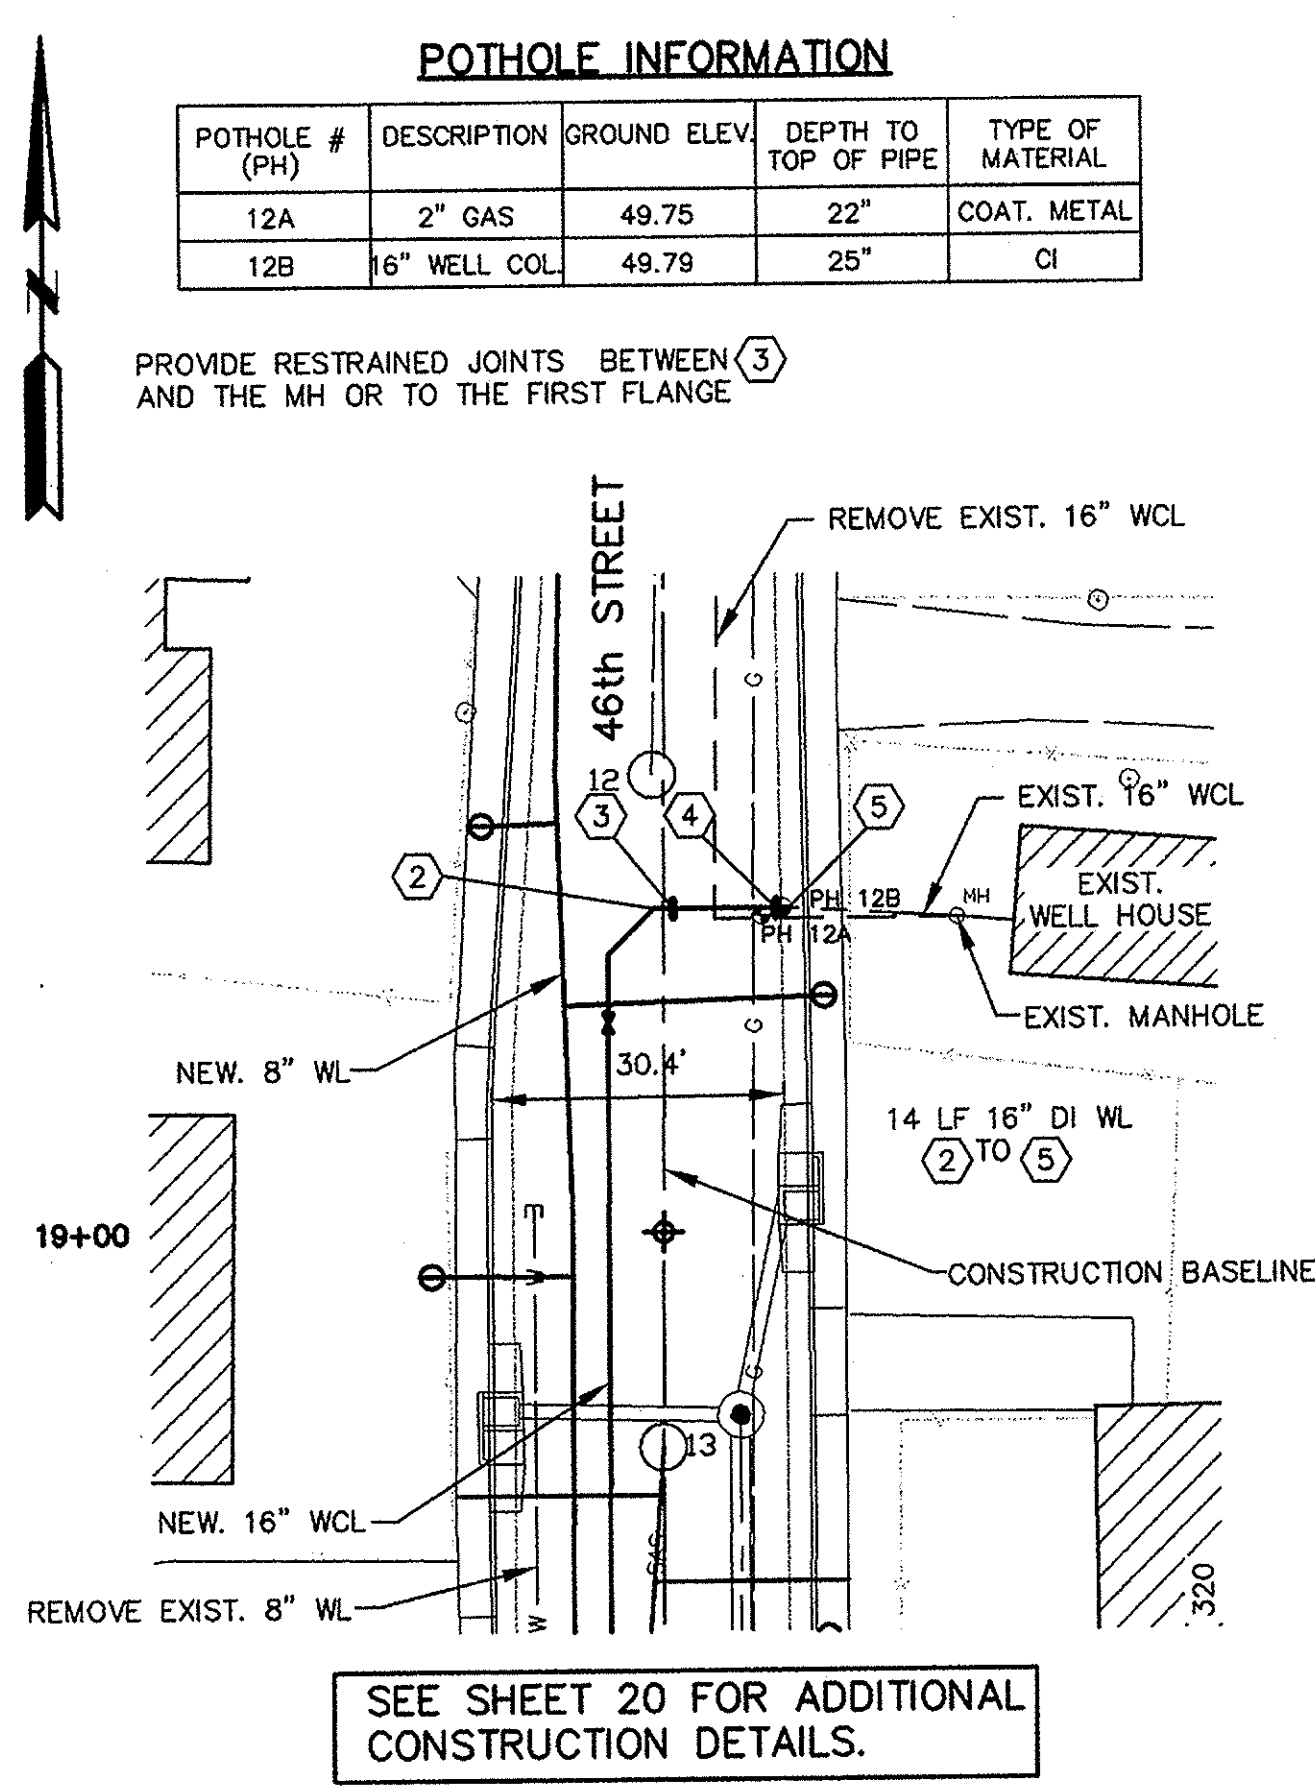


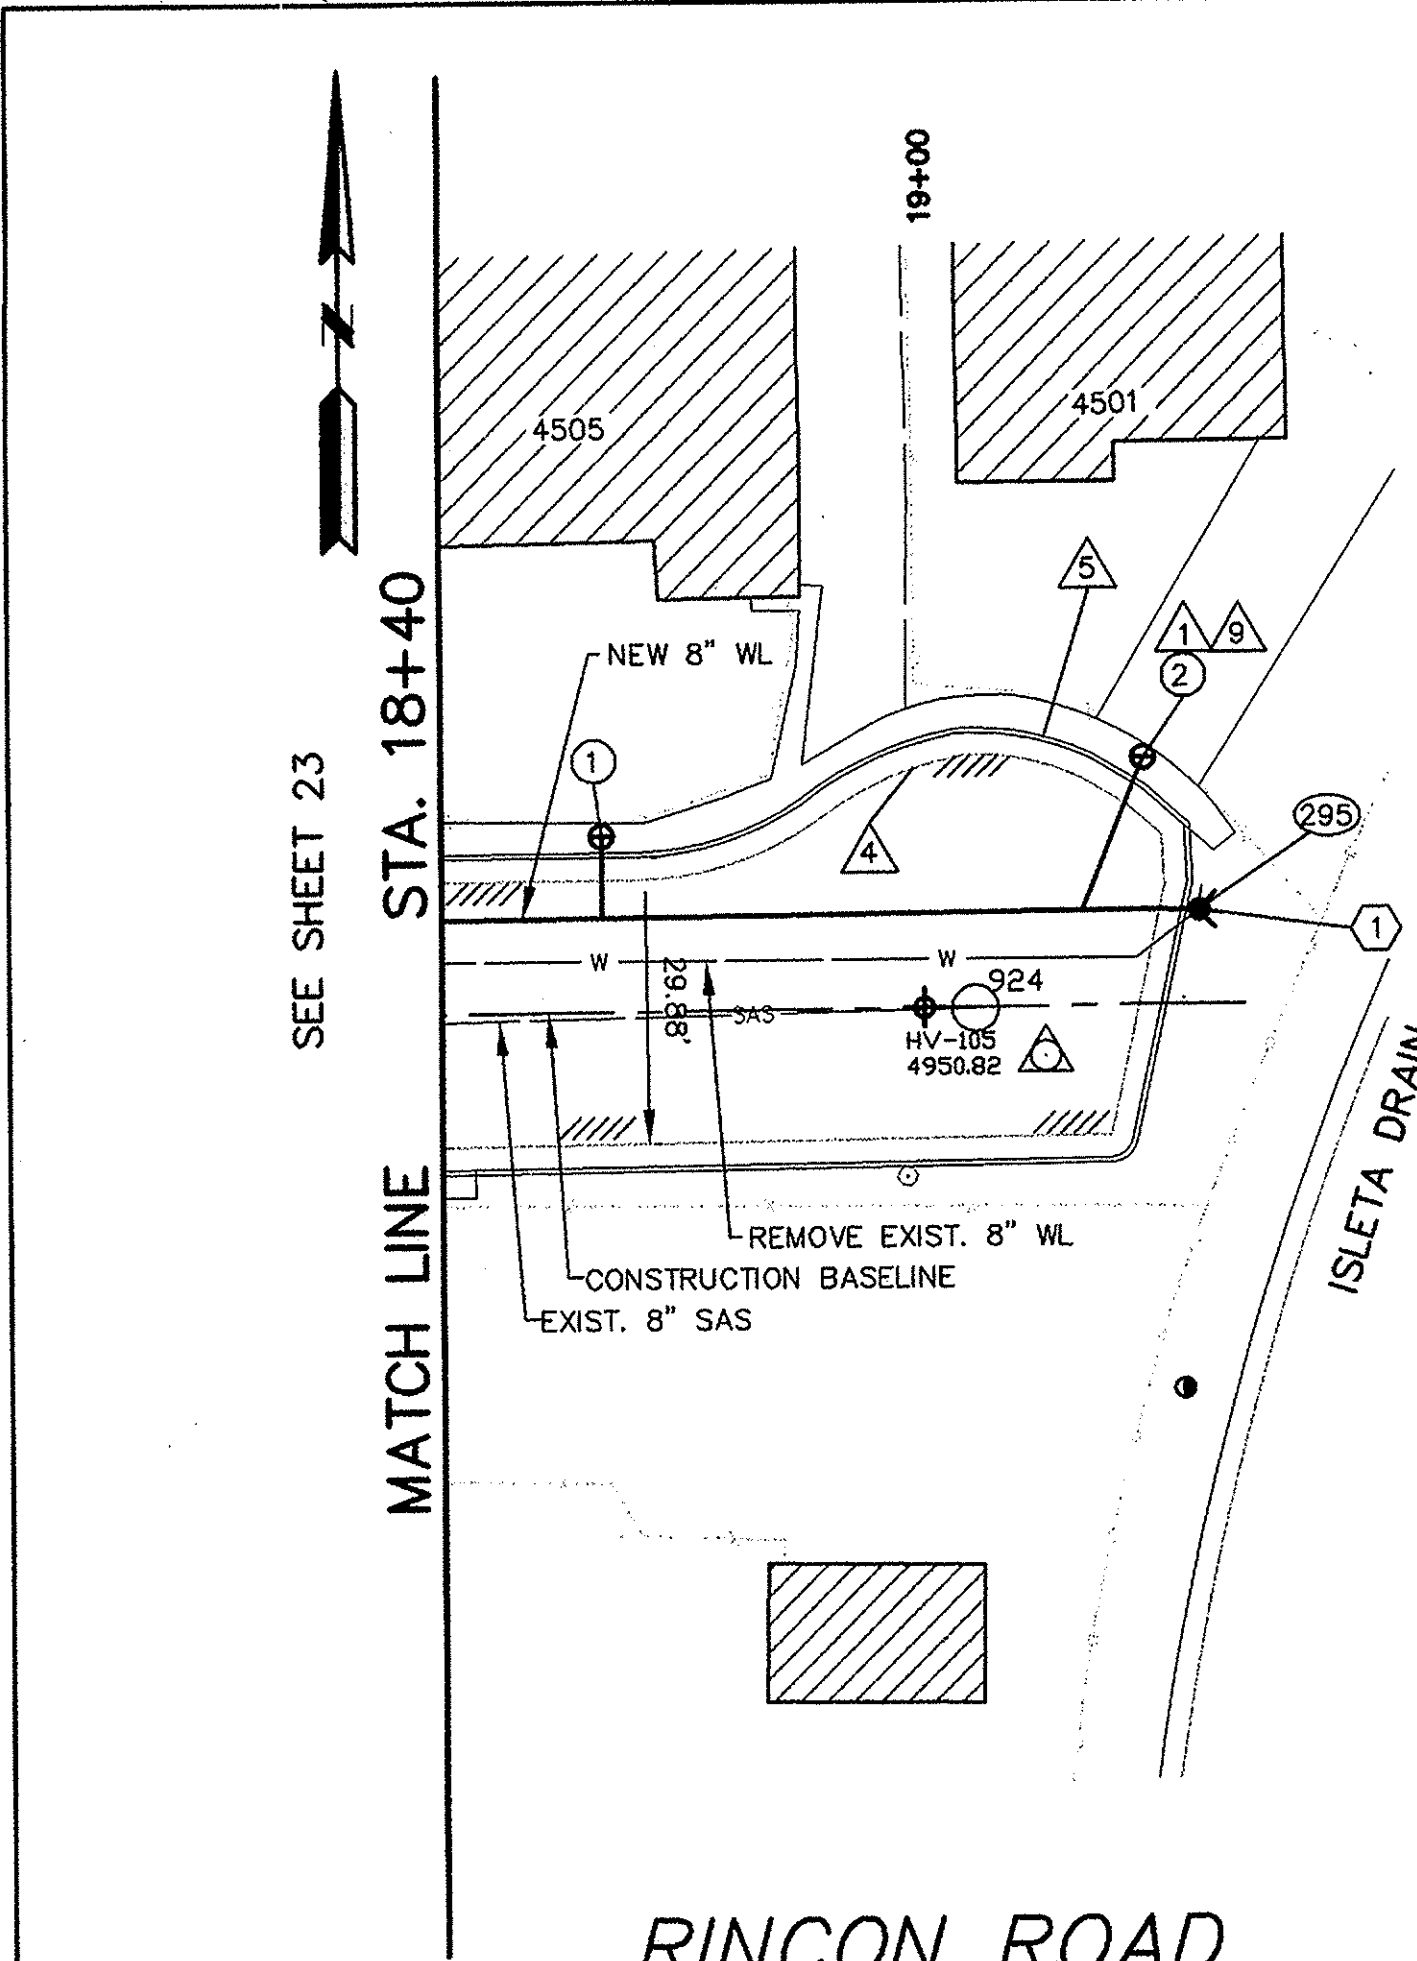

POTHOLE INFORMATION

POTHOLE # (PH)	DESCRIPTION	GROUND ELEV.	DEPTH TO TOP OF PIPE	TYPE OF MATERIAL
12A	2" GAS	49.75	22"	COAT. METAL
12B	16" WELL COL.	49.79	25"	CI

- KEYED NOTES**
1. REPLACED WATER SERVICE LINES SHALL BE REPLACED WITH COPPER TUBING WITH NO SPLICES FROM METER TO MAIN PER COA STD. DWG. 2362.
 2. ANY EXISTING UTILITIES EXPOSED DURING CONSTRUCTION SHALL BE SUPPORTED AND PROTECTED DURING CONSTRUCTION. THIS SUPPORT AND PROTECTION SHALL BE CONSIDERED INCIDENTAL TO PROJECT CONSTRUCTION AND NO SEPARATE PAYMENT WILL BE MADE.
 3. NOT USED THIS SHEET
 4. MAJOR LOCAL PAVEMENT SHALL BE REPLACED PER COA STD. DWG. 2405. SEE SHEET 31.
 5. CURB AND GUTTER REPLACEMENT SHALL BE PER COA STD. DWG. 2415A. SEE SHEET 2 NOTES.
 6. NOT USED THIS SHEET
 7. NOT USED THIS SHEET
 8. NOT USED THIS SHEET
 9. DRIVEPADS AFFECTED BY CONSTRUCTION SHALL BE RECONSTRUCTED PER COA STD. DWG. 2425.
 10. NOT USED THIS SHEET
 11. NOT USED THIS SHEET
 12. NOT USED THIS SHEET
 13. NOT USED THIS SHEET

NOTES

1. ALL FITTINGS SHALL BE RESTRAINED UNLESS NOTED OTHERWISE. SEE SHEET 30 FOR RESTRAINED JOINT TABLES.
2. SEE SEWER AND WATER NOTES, SHEET 30.
3. ALL SANITARY MANHOLES TO BE 4' DIAMETER, TYPE "C", UNLESS NOTED OTHERWISE. SEE MH DATA LISTINGS, THIS SHEET.
4. ALL SEWER SERVICE CONNECTIONS TO BE 4". EXTEND SERVICE LINES TO PROPERTY LINE AND CONNECT TO EXISTING SERVICE.
5. ALL WATER METERS ARE 3/4" UNLESS NOTED OTHERWISE.

EXIST. WATER METER KEYED NOTES

1. STA. 18+66.79, 18.36' LT.
2. STA. 19+22.95, 25.76' LT.

RINCON WATERLINE KEYED NOTES


1. STA. 19+28.60, 9.83' LT.
6"x8" REDUCER & REMOVE & REPLACE EXIST. FIRE HYDRANT 295, PER COA STD. DWG. 2340, CASE 1

46TH ST WATERLINE KEYED NOTES

2. STA. 19+33.64, 1.03' LT.
PI 16" WCL, 45' BEND
3. STA. 19+33.65, 0.96' RT.
PVI 16" WCL, 11.25' BEND
4. STA. 19+33.72, 11.06' RT.
PVI 16" WCL, 11.25' BEND W/ THRUST BLOCKS PER COA STD. DWG. 2320
5. STA. 19+33.73, 13.06' RT.
16" TRANSITION COUPLING & NON-PRESSURE CONNECTION PER COA STD. DWG. 2320

HERRERA WATERLINE KEYED NOTES

6. STA. 3+00.00, 5.96' LT.
8"x8"x6" TEE & 6" 11.25' BEND. SEE SHEET 17.
7. STA. 3+06.14, 5.98' LT.
PVI 6" WL 22.5' BEND
8. STA. 3+13.91, 6.00' LT.
PVI 6" WL 22.5' BEND
9. STA. 3+19.49, 6.00' LT.
PVI 6" WL 22.5' BEND
10. STA. 3+28.18, 6.03' LT.
PVI 6" WL 22.5' BEND
11. STA. 3+29.19, 6.03' LT.
6" TRANSITION COUPLING & NON-PRESSURE CONNECTION PER COA STD. DWG. 2320

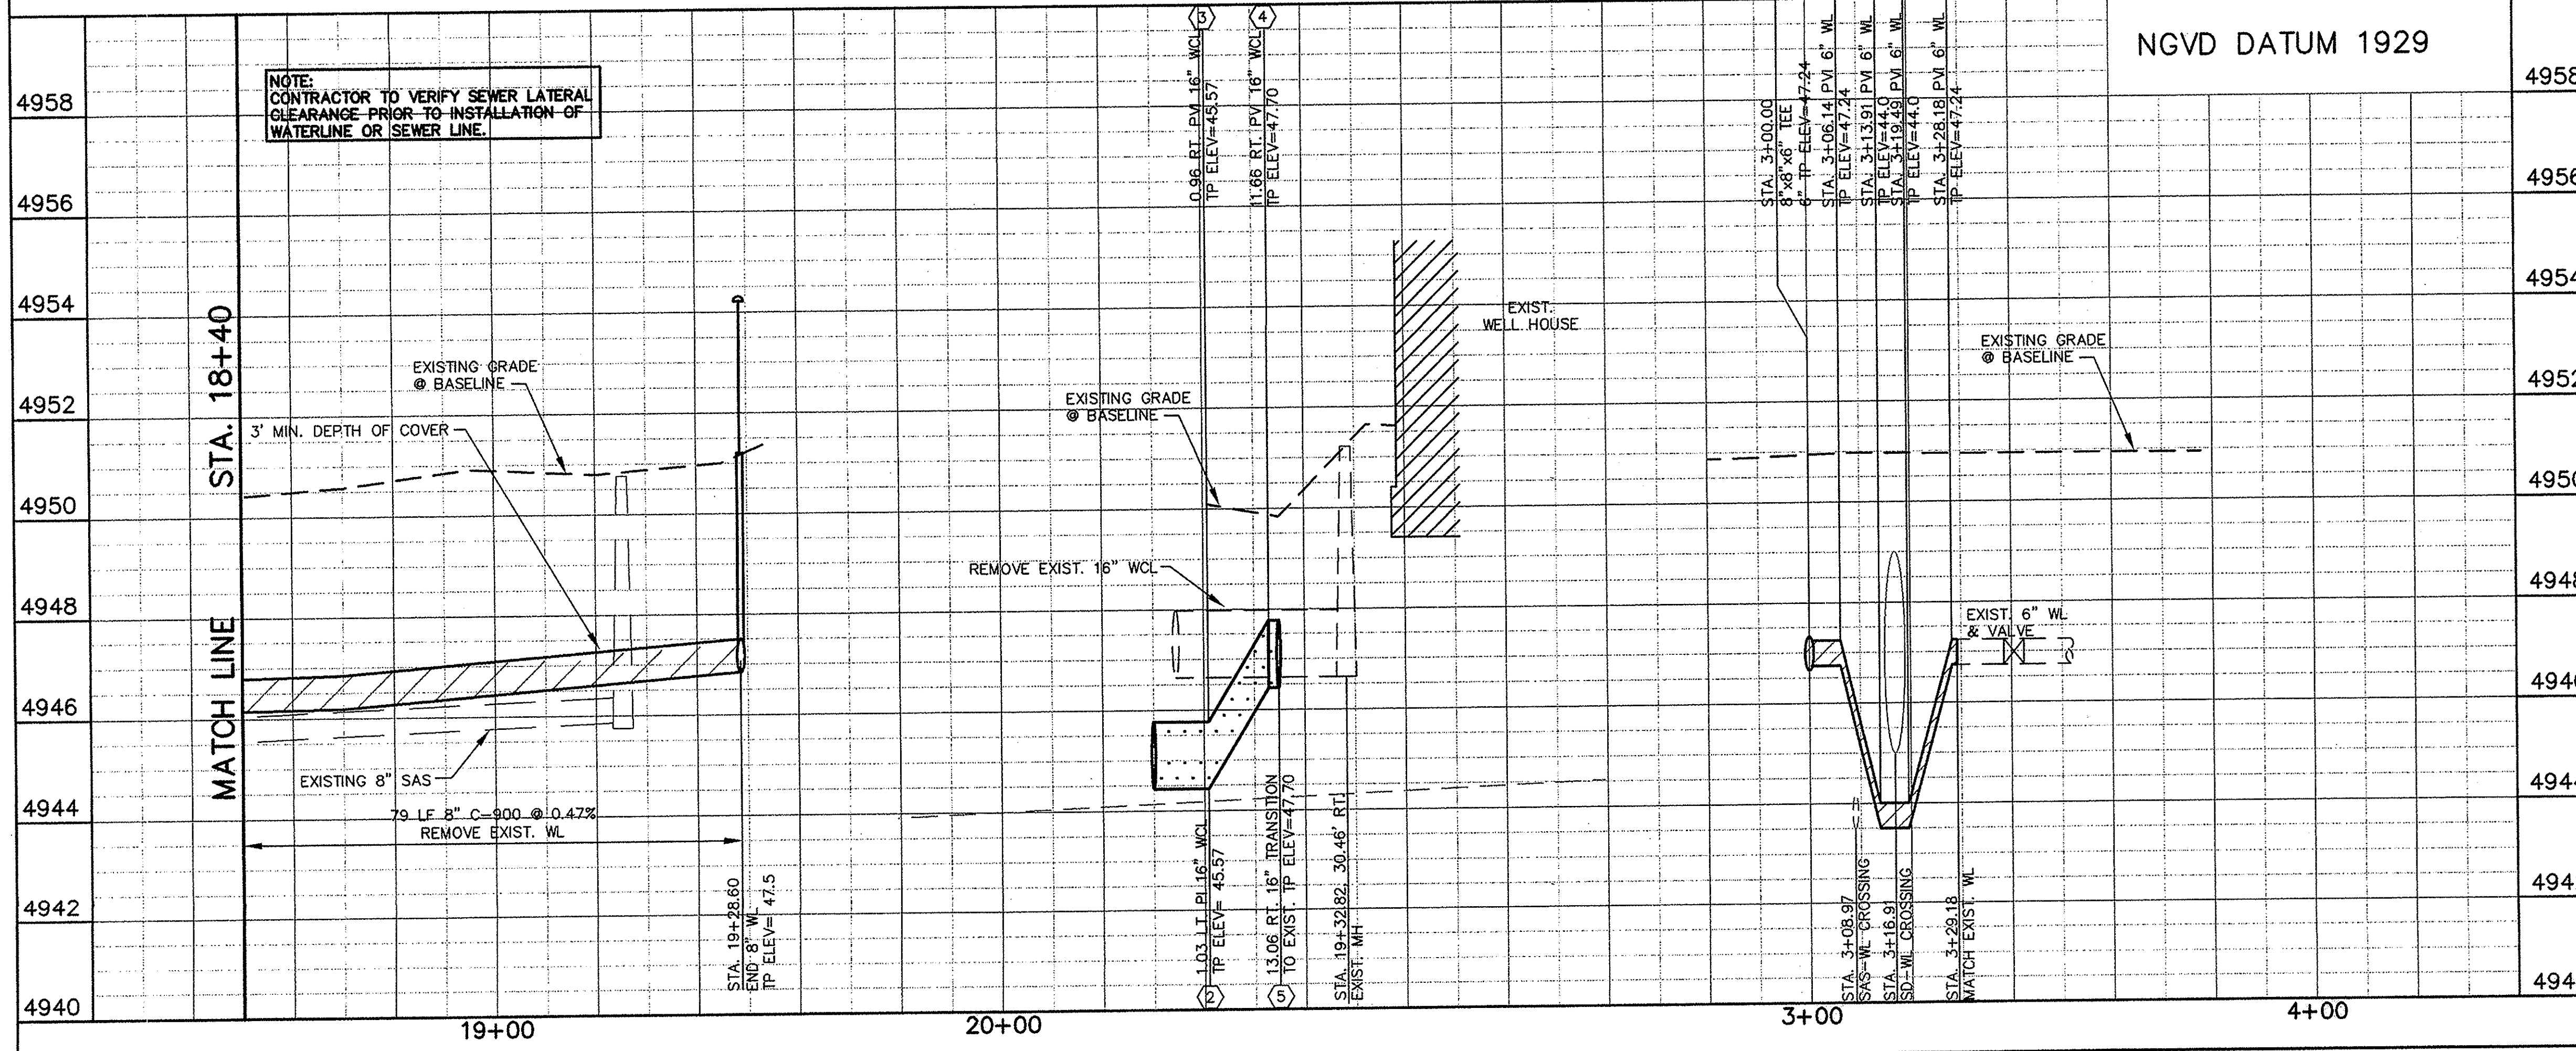

RECORD DRAWING
JUNE 2007

LARKIN GROUP, INC.
CONSULTING ENGINEERS AND SURVEYORS
8000 MENAUL BLVD., NE AL-440
ALBUQUERQUE, NEW MEXICO 87112
(505) 275-7500 FAX (505) 275-0748

CITY OF ALBUQUERQUE
DEPARTMENT OF MUNICIPAL DEVELOPMENT
STORM DRAINAGE DESIGN DIVISION

TITLE: CENTRAL - ATRISCO DRAINAGE IMPROVEMENTS PHASE II
WATER & SANITARY SEWER, RINCON ROAD STA. 18+50 TO 20+00,
16" WELL COLLECTION LINE, 46TH ST. TO ATRISCO WELL #4, 6" WATER LINE, HERRERA RD.

NO.	DATE	REMARKS	BY
1		DESIGN	
2			
3			
4			

DESIGNED BY: XX
DRAWN BY: XX
CHECKED BY: XX

Project No. 674903 Zone Map No. J-12-Z Sheet 24 OF 32